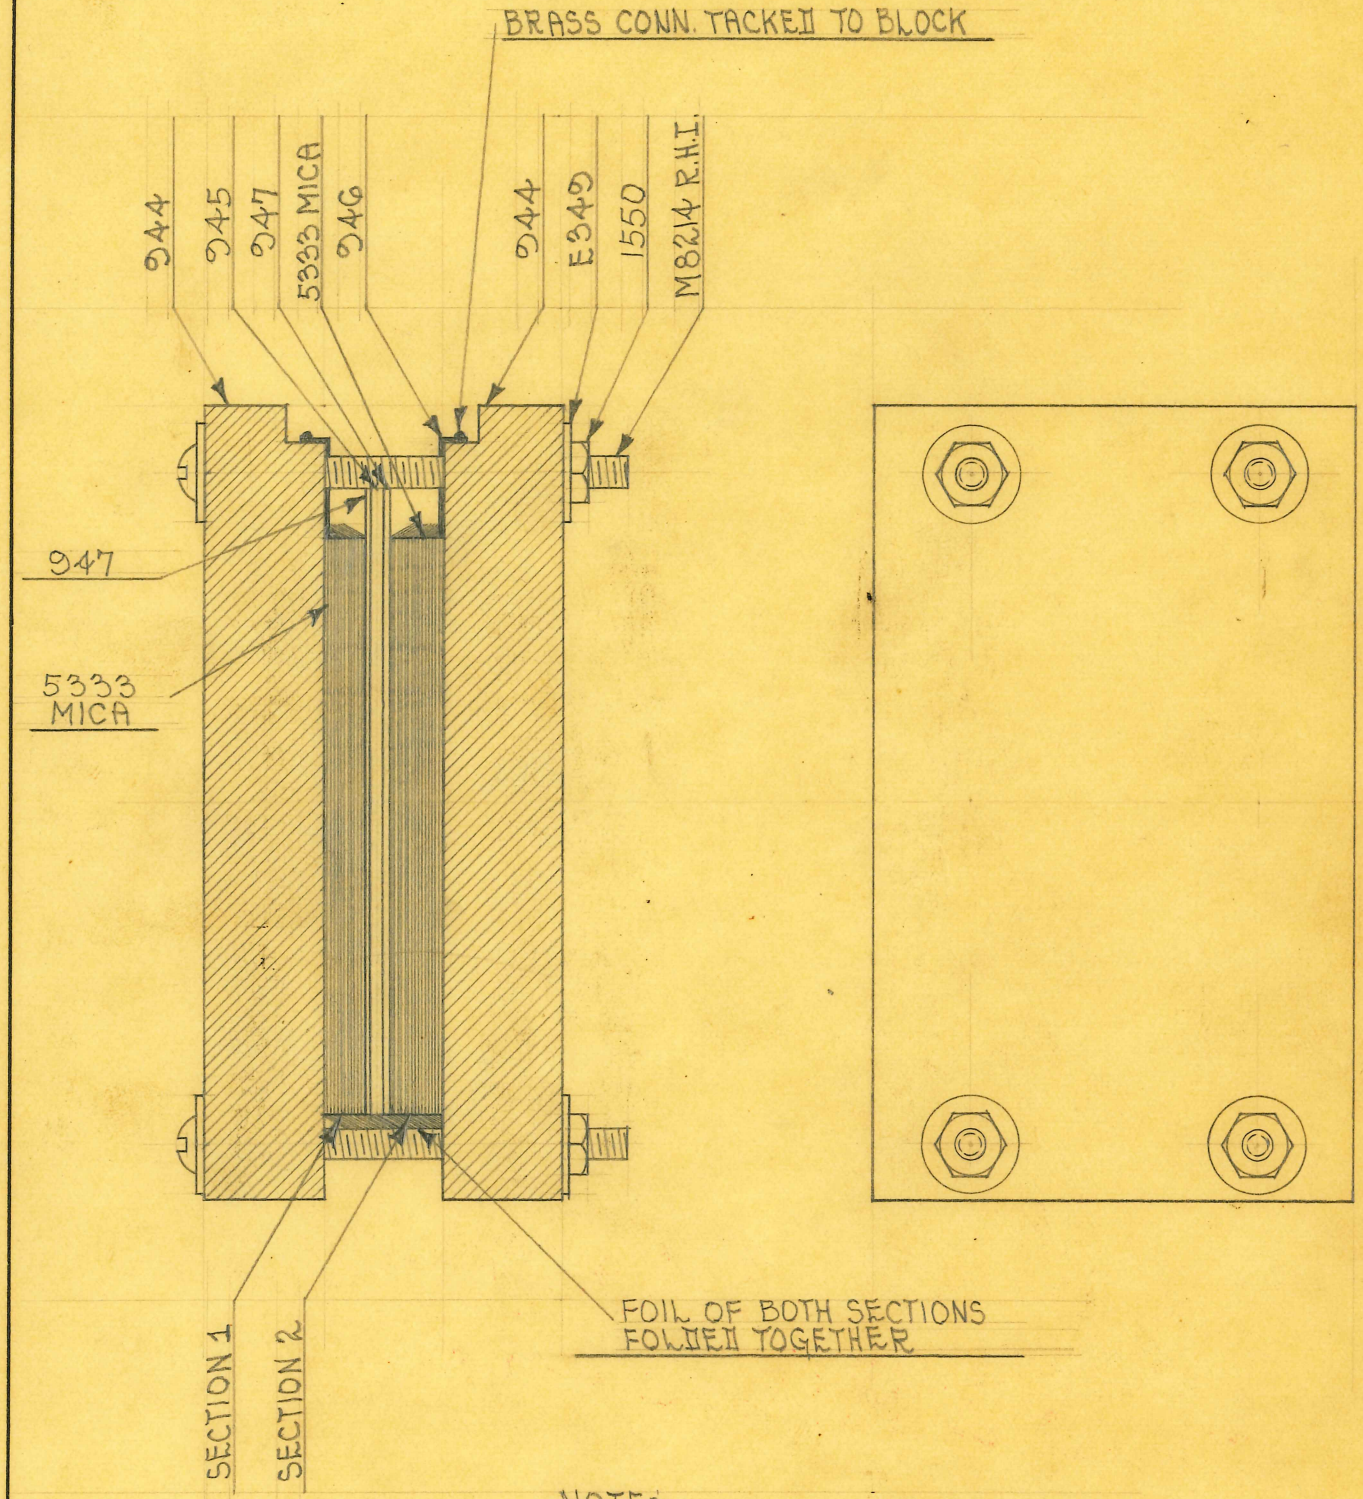

OBSOLETE

NOTE:-

SECT. 1- 18 SHEETS OF 948 FOIL. 9 ON EACH SIDE.

SECT. 2- 26 SHEETS OF 948 FOIL. 13 ON EACH SIDE.

MICA SPLIT TO .012 (4-7 SHEETS)

SIZE		ISSUE 3-1-32	A.E.	**TITLE:** "K" CONDENSER		
KIND		CHANGED				
SHAPE		" "				
FINISH		" "				
TEMP.		" "		H. G. FISCHER & CO. 2335 WABANSIA AVE. CHICAGO, ILL.	CAT. NO.	PART NO. 943G
PATT.		" "				

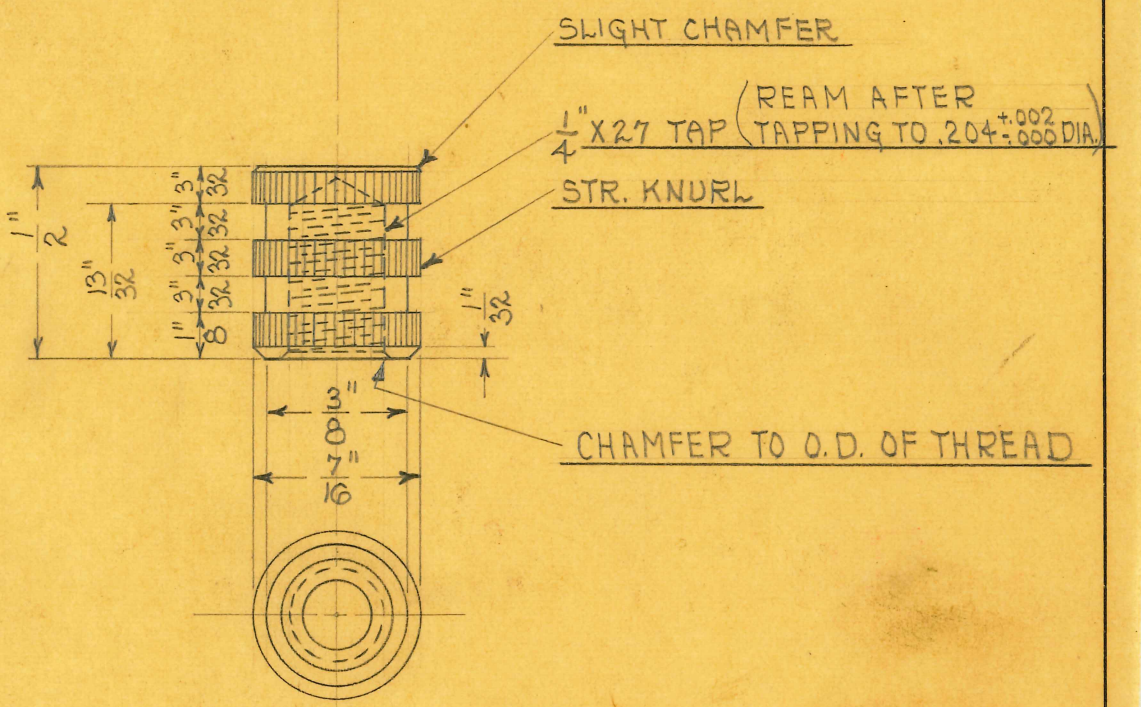

SCALE ~ 2 DIAMETERS

NOTE ~

MUST BE CLEAN & FREE
OF CHIPS, BURRS & OIL.

OBSOLETE

SIZE	7/16"	ISSUE 6-3-31	2.6.	TITLE: SPARK GAP REG. SCREW HEAD INSERT
KIND	BRASS ROD	CHANGED		
SHAPE		" "		
FINISH		" "		
TEMP.		" "		H. G. FISCHER & CO. 2335 WABANSIA AVE. CHICAGO, ILL. — CAT. NO. — PART NO. 932 3/8
PATT.		" "		

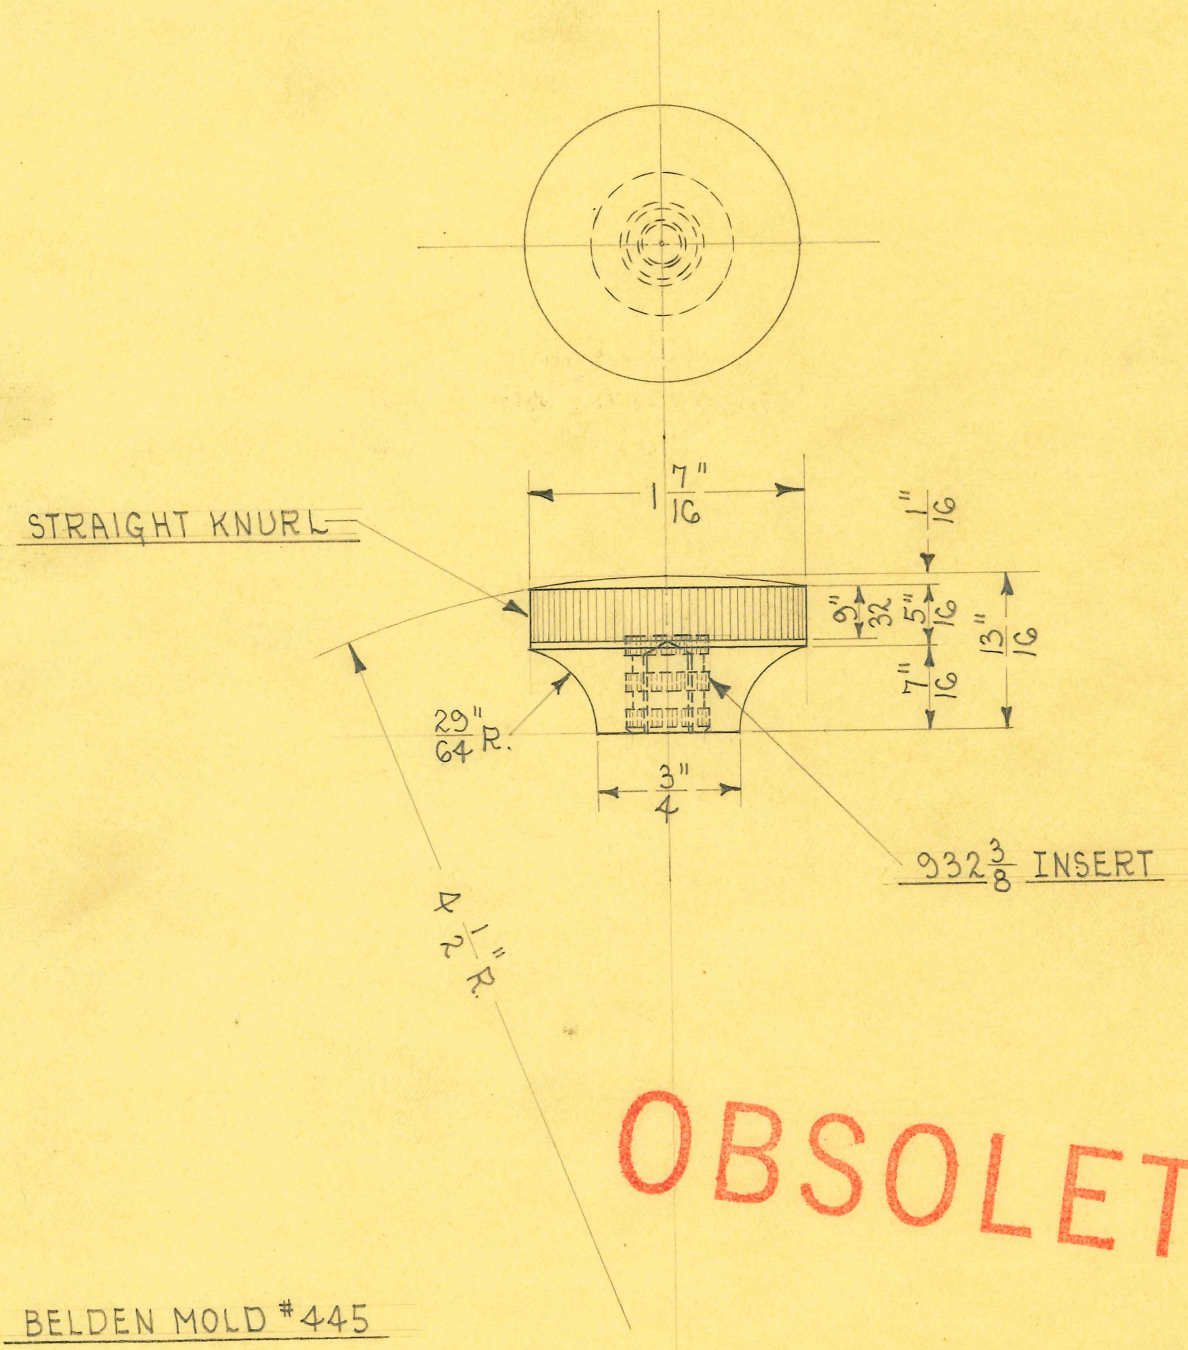

OBSOLETE

BELDEN MOLD #445

SIZE		ISSUE 4-2-35	A.E.	**TITLE:** SPARK GAP REGULATING SCREW HEAD
KIND	MOLDED	CHANGED		
~~SHAPE~~	BAKELITE	"		
FINISH		"		
TEMP.		"		
PATT.		"		

H. G. FISCHER & CO.
2335 WABANSIA AVE.
CHICAGO, ILL.

CAT. NO.

PART NO. 932 1/8 G

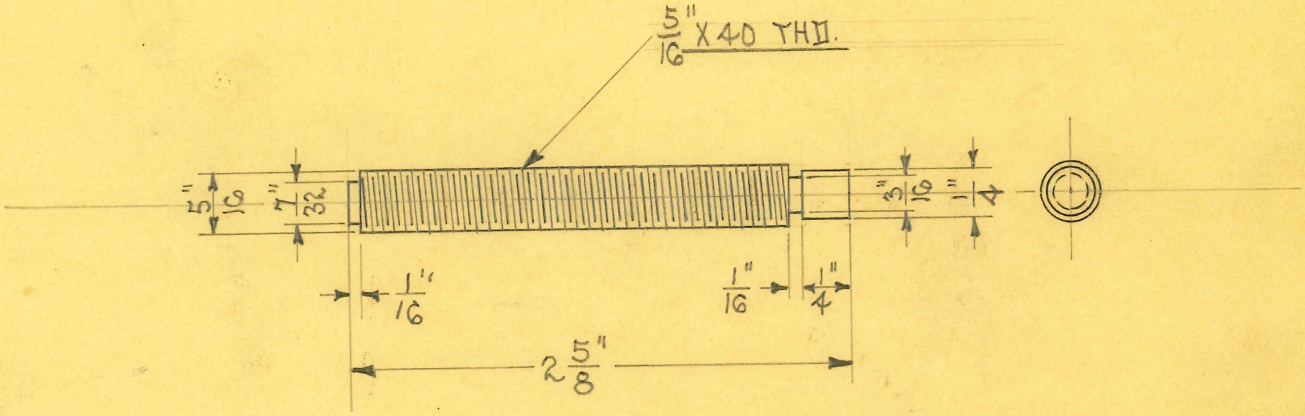

SCALE ~ FULL SIZE

OBSOLETE

SIZE	11/32"	ISSUE 1-13-32	A.E.
KIND	BRASS ROD	CHANGED	
SHAPE		" "	
FINISH	W.P.	" "	
TEMP.		" "	
PATT.		" "	

TITLE: SPARK GAP REGULATING SCREW

H. G. FISCHER & CO.
2335 WABANSIA AVE.
CHICAGO, ILL.

CAT. NO.

PART NO. 931A

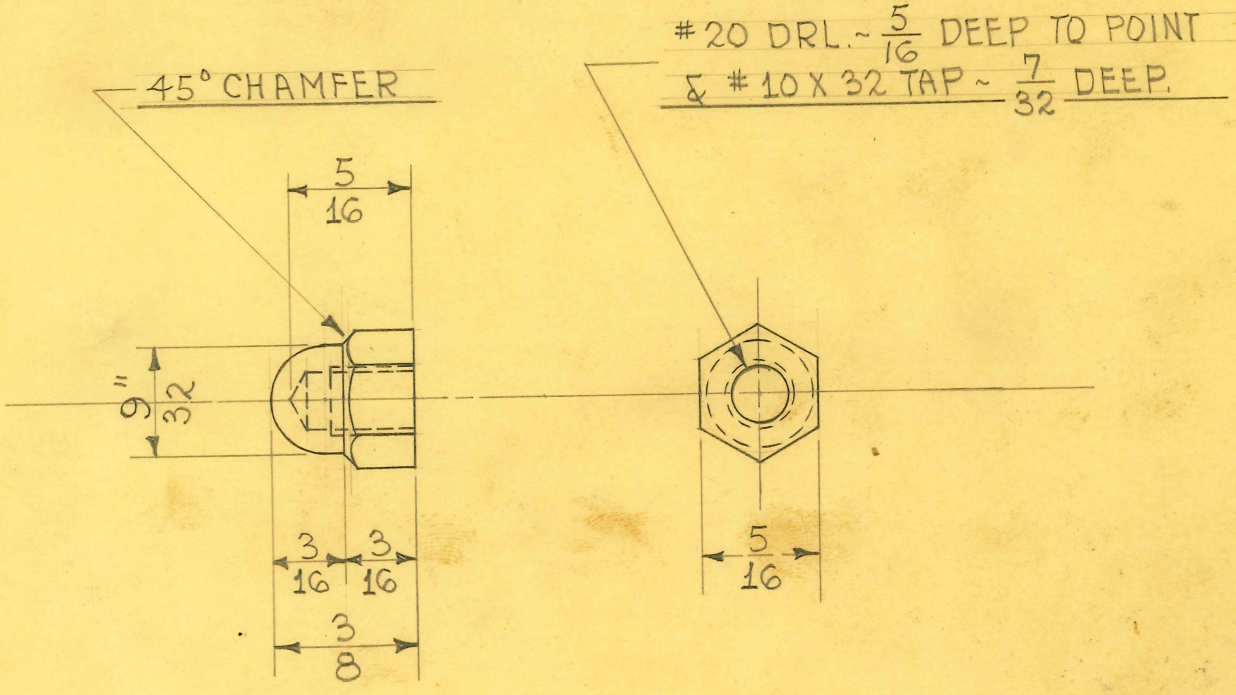

SCALE ~ DOUBLE SIZE

OBSOLETE

OBSOLETE

FORMING TOOL #10,091

SIZE	5/16" HEX.	ISSUE 5-28-45	HE.
KIND	BRASS ROD	CHANGED	
SHAPE		"	
FINISH	N.P. #	"	
TEMP.		"	
PATT.		"	

TITLE: "K" ACORN NUT

H. G. FISCHER & CO.
2335 WABANSIA AVE.
CHICAGO, ILL.

CAT. NO.

PART NO. 914

STEEL SIZES

PC. NO. 5043

CORES - CUT 6 1/2" X 1" BUILT UP TO 1 1/8".
END PIECES - CUT 2 1/2" X 1"
BIND CORES WITH FRICTION TAPE.

WINDING DATA

PRIMARY

3 LAYERS OF 5021 1/2 FIBROID PAPER ON CORE. USE #24 ENAMEL WIRE. ANCHOR LEAD #1 WITH FRICTION TAPE AND WIND 1090 TURNS WITH 1 LAYER OF 5021 1/2 FIBROID BETWEEN EACH LAYER OF WIRE. ANCHOR END WITH FRICTION TAPE - LEAD #2. COVER WITH 3 LAYERS OF 5021 1/2 FIBROID PAPER.

SINUSOIDAL

ANCHOR LEAD #3 WITH FRICTION TAPE & WIND 20 TURNS OF #26 COTENAMEL WIRE. ANCHOR END WITH FRICTION TAPE - LEAD #4.

CAUTERY & DIAGNOSTIC

ANCHOR LEAD #5 WITH FRICTION TAPE AND WIND, WITH #16 COTENAMEL WIRE, 3 TURNS & TAP - LEAD #6. WIND 1 TURNS & TAP - LEAD #7. WIND 2 TURNS & TAP - LEAD #8. WIND 1 TURN & TAP - LEAD #9. WIND 2 TURNS & TAP - LEAD #10. WIND 2 TURNS & TAP - LEAD #11. WIND 3 TURNS & TAP - LEAD #12. WIND 4 TURNS & TAP - LEAD #13. WIND 5 TURNS & TAP - LEAD #14. WIND 6 TURNS & TAP - LEAD #15. WIND 6 TURNS & ANCHOR END WITH FRICTION TAPE - LEAD #16. TAPS #6 TO #15 INCL. EACH INSULATED WITH 1 - 959 FIBRE SEPARATOR. LEADS #1 TO #16 INCL. ARE 1603 - #18 STRANDED WIRE.

SINUSOIDAL

USE #26 C.E. WIRE. ANCHOR LEAD #17 WITH FRICTION TAPE & WIND 8 TURNS & BRING OUT TAP #18. ANCHOR WITH LINEN TAPE. WIND 9 TURNS & BRING OUT TAP #19. ANCHOR WITH LINEN TAPE. WIND 10 TURNS & BRING OUT TAP #20. ANCHOR WITH LINEN TAPE. WIND 11 TURNS & BRING OUT TAP #21. ANCHOR WITH LINEN TAPE. WIND 12 TURNS & BRING OUT TAP #22. ANCHOR WITH LINEN TAPE. WIND 15 TURNS & BRING OUT TAP #23. ANCHOR WITH LINEN TAPE. WIND 17 TURNS & BRING OUT TAP #24. ANCHOR WITH LINEN TAPE. WIND 20 TURNS & ANCHOR END WITH LINEN TAPE - LEAD #25. SHELLAC WINDING.

SECONDARY

3 LAYERS OF 5021 1/2 FIBROID PAPER ON OTHER CORE. WIND 8000 TURNS #32 ENAMEL WIRE.
(SEE DRAWING No. 956G)

OBSOLETE

SIZE		ISSUE 11-19-32	A.E.	TITLE: "K" TRANSFORMER 230 V. - 50 CYCLE
KIND		CHANGED		
SHAPE		" "		
FINISH		" "		
TEMP.		" "		
PATT.		" "		

H. G. FISCHER & CO.
2335 WABANSIA AVE.
CHICAGO, ILL.

CAT. NO.

PART NO. 230-50 956G

STEEL SIZES

PC. NO. 5043

CUT SAME AS FOR 9566-"K" TRANSFORMER.
(SEE DRAWING No. 9566)

WINDING DATA

PRIMARY

3 LAYER OF 5021½ FIBROID PAPER ON CORE. USE #24 ENAMEL WIRE. ANCHOR LEAD #1 WITH FRICTION TAPE AND WIND 1000 TURNS, WITH 1 LAYER OF FIBROID BETWEEN EACH LAYER OF WIRE. ANCHOR END WITH FRICTION TAPE-LEAD #2. COVER WITH 3 LAYERS OF FIBROID.

SINUSOIDAL

ANCHOR LEAD #3 WITH FRICTION TAPE AND WIND 18 TURNS OF #26 COTENAMEL WIRE. ANCHOR END WITH FRICTION TAPE-LEAD #4.

CAUTERY & DIAGNOSTIC

ANCHOR LEAD #5 WITH FRICTION TAPE AND WIND, WITH #16 COTENAMEL WIRE, 3 TURNS & TAP-LEAD #6. WIND 1 TURN & TAP-LEAD #7. WIND 2 TURNS & TAP-LEAD #8. WIND 1 TURN & TAP-LEAD #9. WIND 1 TURN & TAP-LEAD #10. WIND 2 TURNS & TAP-LEAD #11. WIND 3 TURNS & TAP-LEAD #12. WIND 4 TURNS & TAP-LEAD #13. WIND 4 TURNS & TAP-LEAD #14. WIND 5 TURNS & TAP-LEAD #15. WIND 6 TURNS & ANCHOR END WITH FRICTION TAPE-LEAD #16. TAPS #6 TO #15 INCL. EACH INSULATED WITH 1-959 FIBRE SEPARATOR. LEADS #1 TO #16 INCL. ARE 1603-#18 STRANDED WIRE.

SINUSOIDAL

USE #26 C.E. WIRE. ANCHOR LEAD #17 WITH FRICTION TAPE & WIND 7 TURNS & BRING OUT TAP #18. ANCHOR WITH LINEN TAPE. WIND 8 TURNS & BRING OUT TAP #19. ANCHOR WITH LINEN TAPE. WIND 9 TURNS & BRING OUT TAP #20. ANCHOR WITH LINEN TAPE. WIND 10 TURNS & BRING OUT TAP #21. ANCHOR WITH LINEN TAPE. WIND 11 TURNS & BRING OUT TAP #22. ANCHOR WITH LINEN TAPE. WIND 13 TURNS & BRING OUT TAP #23. ANCHOR WITH LINEN TAPE. WIND 15 TURNS & BRING OUT TAP #24. ANCHOR WITH LINEN TAPE. WIND 18 TURNS & ANCHOR END WITH LINEN TAPE-LEAD #25. SHELLAC WINDING.

SECONDARY

3 LAYERS OF 5021½ FIBROID PAPER ON OTHER CORE. WIND 8000 TURNS #32 ENAMEL WIRE SAME AS FOR 9566.

OBSOLETE

SIZE		ISSUE 11-21-32	A.E.	TITLE: "K" TRANSFORMER 220 V. - 50 CYCLE		
KIND		CHANGED				
SHAPE		" "				
FINISH		" "				
TEMP.		" "		H. G. FISCHER & CO. 2335 WABANSIA AVE. CHICAGO, ILL.	CAT. NO.	PART NO. 220-50 9566
PATT.		" "				

STEEL SIZES

PC. NO. 5043

CORES - CUT 6½" X 1" BUILT UP TO 1⅛".

END PIECES - CUT 2½" X 1".

BIND CORES WITH FRICTION TAPE.

WINDING DATA

PRIMARY

3 LAYERS OF 5021½ FIBROID PAPER ON CORE. USE #22 ENAMEL WIRE. ANCHOR LEAD #1 WITH FRICTION TAPE AND WIND 800 TURNS WITH 1 LAYER OF FIBROID BETWEEN EACH LAYER OF WIRE. ANCHOR END WITH FRICTION TAPE - LEAD #2. COVER WITH 3 LAYERS OF FIBROID.

SINUSOIDAL

ANCHOR LEAD #3 WITH FRICTION TAPE AND WIND 48 TURNS OF #26 COTENAMEL WIRE. ANCHOR END WITH FRICTION TAP - LEAD #4.

CAUTERY & DIAGNOSTIC

ANCHOR LEAD #5 WITH FRICTION TAPE AND WIND, WITH #16 COTENAMEL WIRE, 5 TURNS & TAP - LEAD #6. WIND 2 TURNS & TAP - LEAD #7. WIND 3 TURNS & TAP - LEAD #8. WIND 2 TURNS & TAP - LEAD #9. WIND 2 TURNS & TAP - LEAD #10. WIND 3 TURNS & TAP - LEAD #11. WIND 4 TURNS & TAP - LEAD #12. WIND 7 TURNS & TAP - LEAD #13. WIND 8 TURNS & TAP - LEAD #14. WIND 10 TURNS & TAP - LEAD #15. WIND 11 TURNS & ANCHOR END WITH FRICTION TAPE - LEAD #16. TAPS #6 TO #15 INCL. EACH INSULATED WITH 1-959 FIBRE SEPARATOR. LEAD #1 TO #16 INCL. ARE 1603 - #18 STRANDED WIRE.

SINUSOIDAL

USE #26 C.E. WIRE. ANCHOR LEAD #17 WITH FRICTION TAPE & WIND 13 TURNS & BRING OUT TAP #18. ANCHOR WITH LINEN TAPE. WIND 15 TURNS & BRING OUT TAP #19. ANCHOR WITH LINEN TAPE. WIND 17 TURNS & BRING OUT TAP #20. ANCHOR WITH LINEN TAPE. WIND 18 TURNS & BRING OUT TAP #21. ANCHOR WITH LINEN TAPE. WIND 14 TURNS & BRING OUT TAP # 22. ANCHOR WITH LINEN TAPE. WIND 18 TURNS & BRING OUT TAP #23. ANCHOR WITH LINEN TAPE. WIND 24 TURNS & BRING OUT TAP #24. ANCHOR WITH LINEN TAPE. WIND 28 TURNS & ANCHOR END WITH LINEN TAPE - LEAD #25. SHELLAC WINDING.

SECONDARY

3 LAYERS OF 5021½ FIBROID PAPER ON CORE. USE #32 ENAMEL WIRE. ANCHOR LEAD #26 WITH FRICTION TAPE AND WIND 12800 TURNS (NO DEFINITE NUMBER OF TURNS PER LAYER). ANCHOR END WITH FRICTION TAPE - LEAD #27. 1 LAYER OF 5021½ FIBROID PAPER BETWEEN EACH LAYER OF WIRE. COVER WITH 5004 OILED TAPE AND SHELLAC. LEADS ARE 1603 - #18 STRANDED WIRE.

(SEE DRAWING No. 956G)

OBSOLETE

SIZE		ISSUE 11-25-32	A.E.	TITLE: "K" TRANSFORMER 110 V. - 25 CYCLE	
KIND		CHANGED			
SHAPE		" "			
FINISH		" "			
TEMP.		" "			
PATT.		" "			
H. G. FISCHER & CO. 2335 WABANSIA AVE. CHICAGO, ILL.		CAT. NO.		PART NO. 110-25 956G	

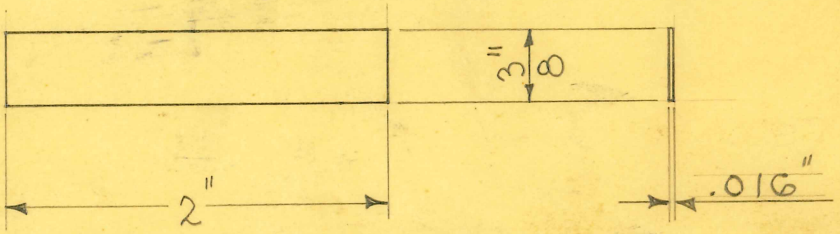

2 REQUIRED

OBSOLETE

SIZE	.016"	ISSUE 8-17-45	HE.
KIND	SHEET BRASS	CHANGED	
SHAPE		"	
FINISH		"	
TEMP.		"	
PATT.		"	

TITLE: CONDENSER CONNECTING STRIP

H. G. FISCHER & CO.
2335 WABANSIA AVE.
CHICAGO, ILL.

CAT. NO.

PART NO. 946

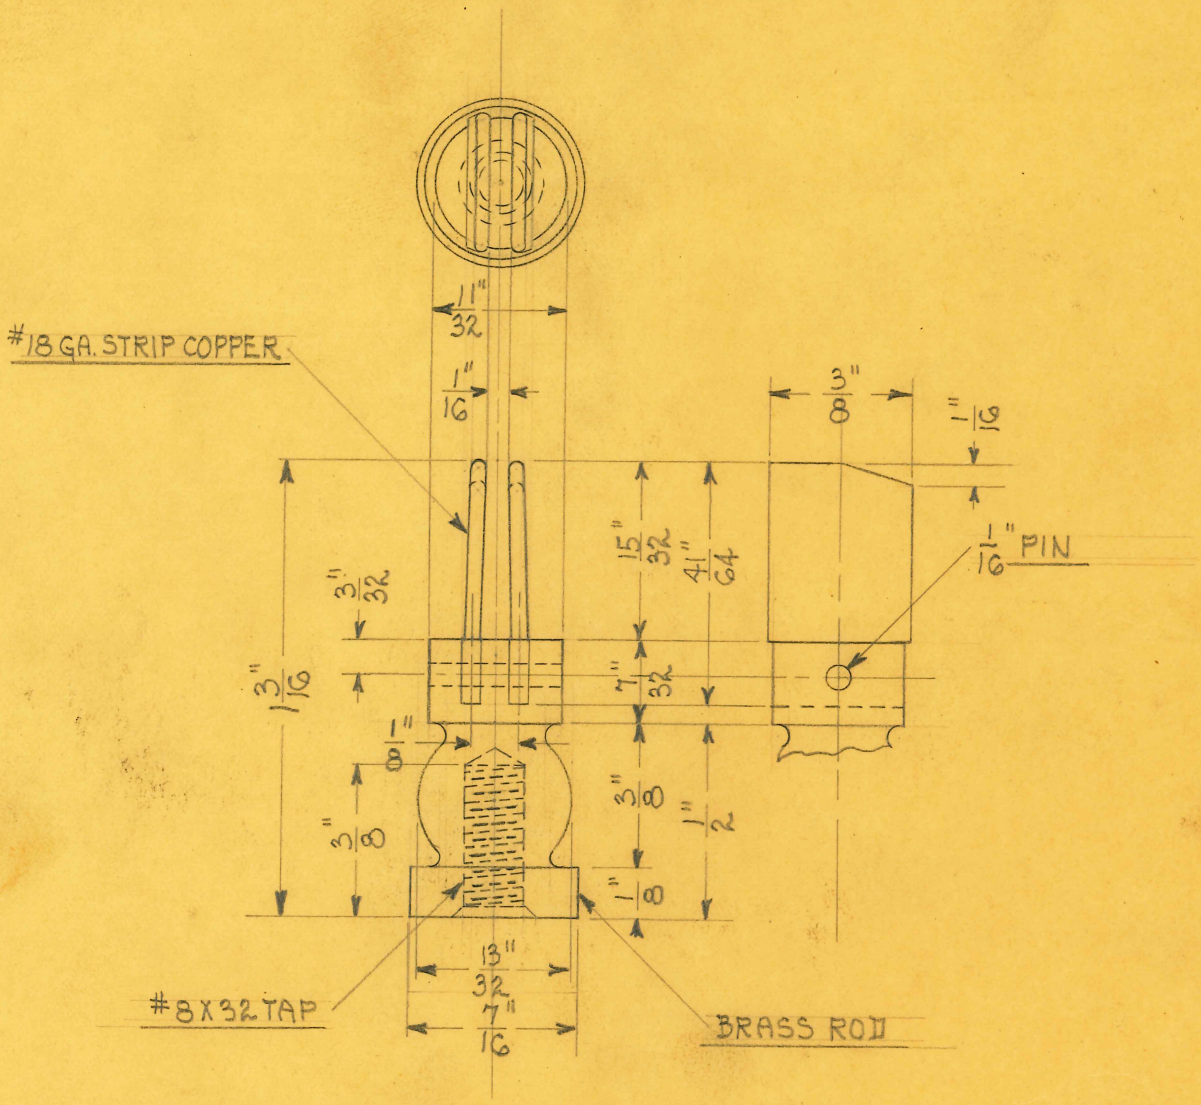

2 REQUIRED

SCALE ≈ 2 DIAMETERS

OBSOLETE

SIZE		ISSUE 1-22-31	J.H.E.	**TITLE:** KNIFE SWITCH CLIP
KIND		CHANGED		
SHAPE		" "		
FINISH	N.P.	" "		
TEMP.		" "		H. G. FISCHER & CO. 2335 WABANSIA AVE. CHICAGO, ILL. — CAT. NO. — PART NO. E338 1/4
PATT.		" "		

STEEL SIZES

PC. NO. 5043

CUT SAME AS FOR CC39G-"K" LINE CHOKE
(SEE DRAWING No. CC39G)

WINDING DATA

3 LAYERS OF 5021 FIBROID PAPER ON CORE. ANCHOR LEAD #1 WITH FRICTION TAPE & WIND 150 TURNS #24 ENAMEL WIRE & BRING OUT TAP #2. WIND 280 TURNS & ANCHOR END OF #24 E. WIRE & START OF #26 E. WIRE WITH LINEN TAPE-TAP #3. WIND 420 TURNS & BRING OUT TAP #4. WIND 420 TURNS & BRING OUT TAP #5. WIND 210 TURNS & ANCHOR END WITH LINEN TAPE-LEAD #6. 1 LAYER OF FIBROID BETWEEN EACH LAYER OF WIRE. LEADS #1 & #6 ARE 1603-#18 STRANDED WIRE. SHELLAC WINDING.

OBSOLETE

SIZE		ISSUE 11-15-32	H.E.
KIND		CHANGED	
SHAPE		" "	
FINISH		" "	
TEMP.		" "	
PATT.		" "	

TITLE: "K" LINE CHOKE 220 V. 50 CYCLE

H. G. FISCHER & CO.
2335 WABANSIA AVE.
CHICAGO, ILL.

CAT. NO.

PART NO. 220-50 CC39G

STEEL SIZES

PC. NO. 5043

CUT SAME AS FOR C639G-"K" LINE CHOKE.
(SEE DRAWING C639G)

WINDING DATA

3 LAYERS OF 5021 FIBROID PAPER ON CORE.
ANCHOR LEAD #1 WITH FRICTION TAPE & WIND
245 TURNS #22 ENAMEL WIRE & BRING OUT TAP #2.
WIND 165 TURNS & ANCHOR END OF #22 E. WIRE &
START OF #24 E. WIRE WITH LINEN TAPE - TAP #3.
WIND 300 TURNS & BRING OUT TAP #4. WIND 300 TURNS
& BRING OUT TAP #5. WIND 160 TURNS & ANCHOR END
WITH LINEN TAPE - LEAD #6. 1 LAYER OF FIBROID
BETWEEN EACH LAYER OF WIRE. LEADS #1 & #6 ARE
1603 - #18 STRANDED WIRE. SHELLAC WINDING.

OBSOLETE

SIZE		ISSUE 11-15-32	2.E.	TITLE: "K" LINE CHOKE 110 V. 25 CYCLE	
KIND		CHANGED			
SHAPE		" "			
FINISH		" "			
TEMP.		" "		H. G. FISCHER & CO. 2335 WABANSIA AVE. CHICAGO, ILL.	CAT. NO.
PATT.		" "			PART NO. 110-25 C639G

STEEL SIZES

PC. NO. 5043

CUT SAME AS FOR CG39G - "K" LINE CHOKE.
(SEE DRAWING No. CG39G)

WINDING DATA

3 LAYERS OF 5021 FIBROID PAPER ON CORE. ANCHOR LEAD #1 WITH FRICTION TAPE & WIND 330 TURNS #22 ENAMEL WIRE & ANCHOR END & START OF #24 ENAMEL WIRE WITH LINEN TAPE - TAP #2. WIND 300 TURNS & BRING OUT TAP #3. WIND 160 TURNS & ANCHOR END OF #24 E. & START OF #22 E. WITH LINEN TAPE - TAP #4. WIND 165 TURNS & ANCHOR END OF #22 E. & START OF #24 E. WITH LINEN TAPE - TAP #5. WIND 300 TURNS & ANCHOR END WITH LINEN TAPE - LEAD #6. 1 LAYER OF FIBROID BETWEEN EACH LAYER OF WIRE. LEADS #1 & #6 ARE 1603 - #18 STRANDED WIRE. SHELLAC WINDING.

OBSOLETE

SIZE		ISSUE 11-15-32	J.E.	TITLE: "K" LINE CHOKE 110 V. 40 CYCLE
KIND		CHANGED		
SHAPE		" "		
FINISH		" "		
TEMP.		" "		
PATT.		" "		

H. G. FISCHER & CO.
2335 WABANSIA AVE.
CHICAGO, ILL.

CAT. NO.

PART NO. 110-40 CG39G

STEEL SIZES

PC. NO. 5043

CUT SAME AS FOR CG39G - "K" LINE CHOKE.
(SEE DRAWING No. CG39G)

WINDING DATA

3 LAYER OF 5021 FIBROID PAPER ON CORE. ANCHOR LEAD #1 WITH FRICTION TAPE & WIND 150 TURNS #24 ENAMEL WIRE & BRING OUT TAP #2. WIND 280 TURNS & ANCHOR END OF #24 E. WIRE & START OF #26 E. WIRE WITH LINEN TAPE - TAP #3. WIND 420 TURNS & BRING OUT TAP #4. WIND 420 TURNS & BRING OUT TAP #5. WIND 210 TURNS & ANCHOR END WITH LINEN TAPE - LEAD #6. 1 LAYER OF FIBROID BETWEEN EACH LAYER OF WIRE. LEADS #1 & #6 ARE 1603 - #18 STRANDED WIRE. SHELLAC WINDING.

OBSOLETE

SIZE		ISSUE 11-15-32	A.E.	TITLE: "K" LINE CHOKE 220V.-60~ OR 230V.-60~
KIND		CHANGED		
SHAPE		" "		
FINISH		" "		
TEMP.		" "		H. G. FISCHER & CO. 2335 WABANSIA AVE. CHICAGO, ILL. / CAT. NO. / PART NO. 220-60 CG39G
PATT.		" "		

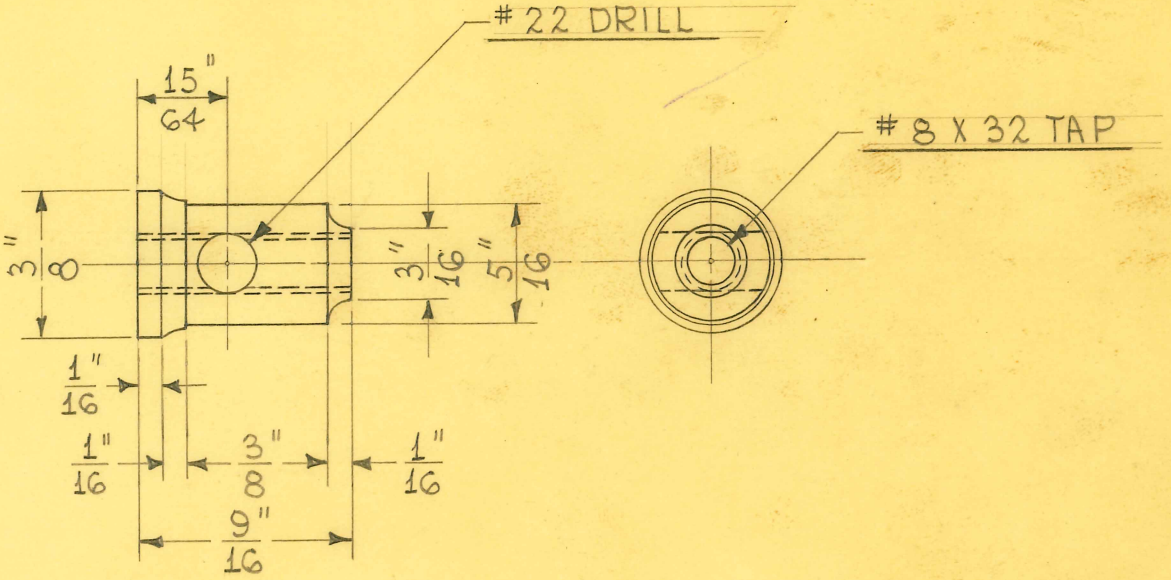

SCALE ÷ 1" = 1/2"

FULL SIZE

OBSOLETE

SIZE	3/8" DIAM.	ISSUE 5-7-45	HE.
KIND	BRASS ROD	CHANGED	
SHAPE		"	
FINISH	N.P. #12	"	
TEMP.		"	
PATT.		"	

TITLE: BINDING POST

H. G. FISCHER & CO.
2335 WABANSIA AVE.
CHICAGO, ILL.

CAT. NO.

PART NO. E 331 A

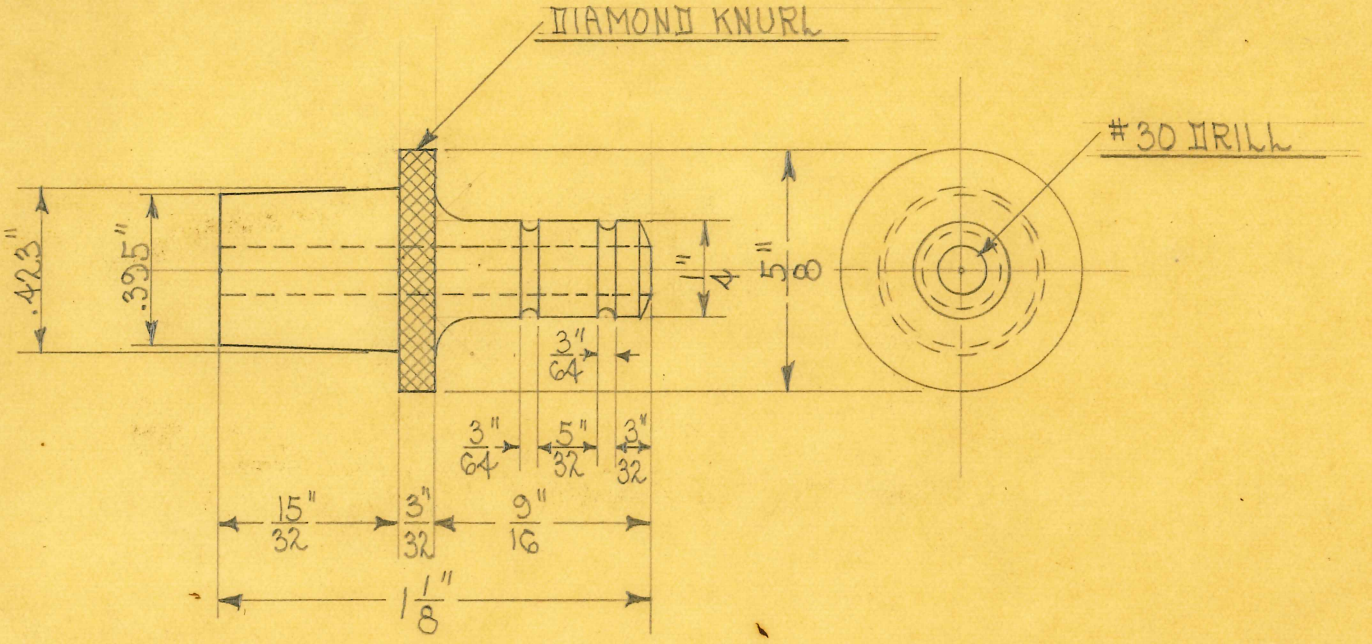

SCALE ~ 2 DIAMETERS

OBSOLETE

SIZE	5/8"	ISSUE 6-16-32	A.E.	TITLE: METAL ADAPTER
KIND	BRASS ROD	CHANGED		
SHAPE		" "		
FINISH	W. P.	" "		
TEMP.		" "		
PATT.		" "		

H. G. FISCHER & CO.
2335 WABANSIA AVE.
CHICAGO, ILL.

CAT. NO.

PART NO. 1322

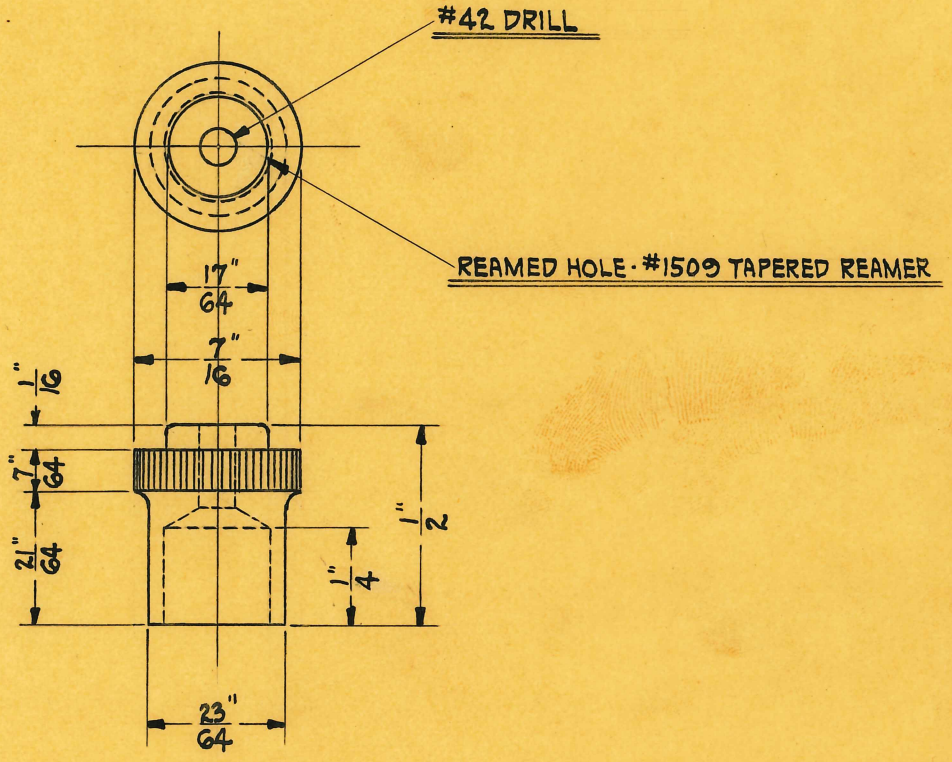

SCALE ~ 2 DIAMETERS

OBSOLETE

SIZE	7/16"	ISSUE H.E.	3-13-30	TITLE: NEW STYLE SUCTION BOTTLE SILVER TUBE TIP
KIND	BRASS ROD	CHANGED		
SHAPE	ROUND	" "		
FINISH	N.P.	" "		
TEMP.		" "		H. G. FISCHER & CO. 2335 WABANSIA AVE. CHICAGO, ILL.
PATT.		" "		CAT. NO. / PART NO. 1489

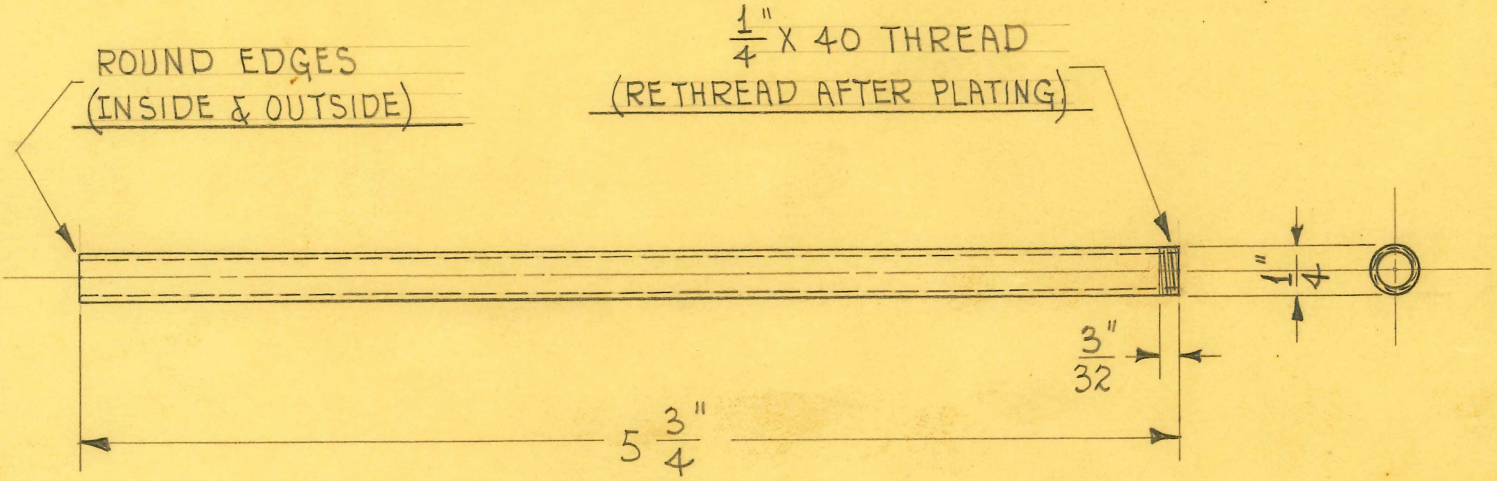

1 REQUIRED

OBSOLETE

SIZE	1/4" O.D. X #22GA	ISSUE 5-9-45	HE.
KIND	BRASS TUBING	CHANGED	
SHAPE		"	
FINISH	N.P. #12	"	
TEMP.		"	
PATT.		"	

TITLE: DIAGNOSTIC LAMP HANDLE TUBE

H. G. FISCHER & CO.
2335 WABANSIA AVE.
CHICAGO, ILL.

CAT. NO.

PART NO. 1284A

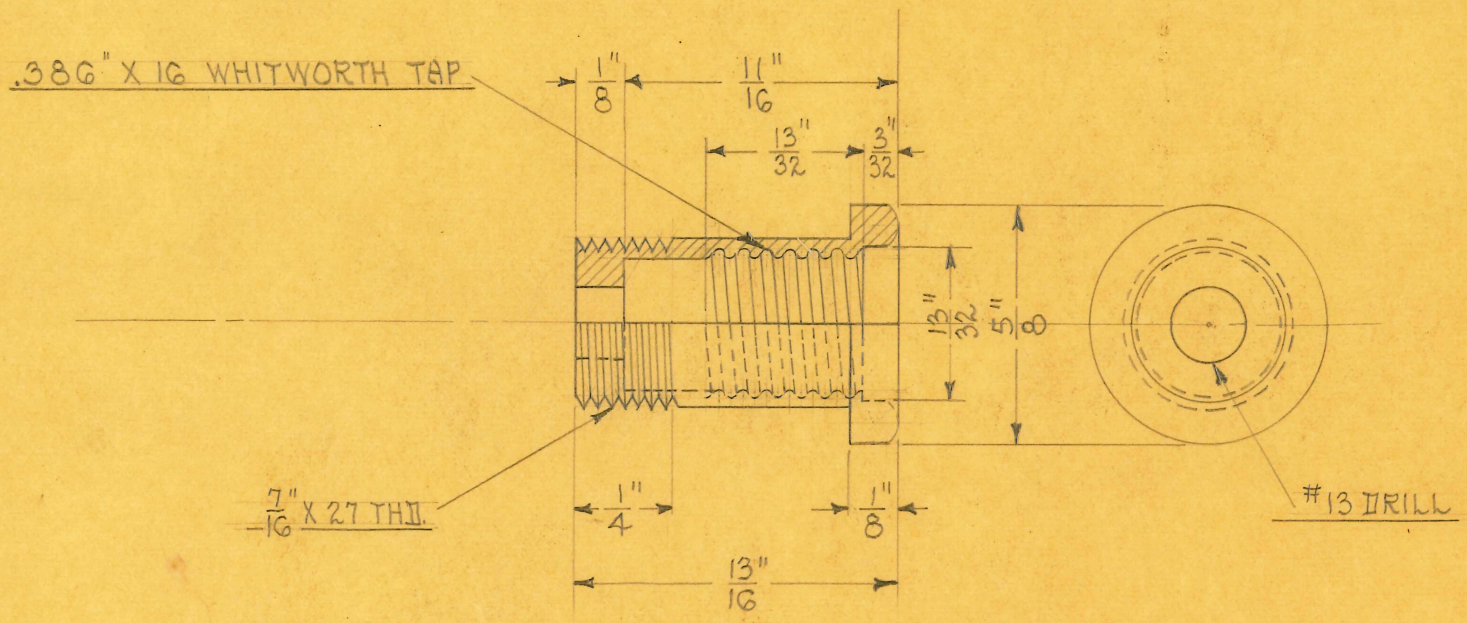

SCALE ~ 2 DIAMETERS

OBSOLETE

SIZE	5/8"	ISSUE 6-23-31	A.E.	TITLE: PILOT LIGHT SOCKET
KIND	BRASS ROD	CHANGED		
SHAPE		" "		
FINISH	N.P.	" "		
TEMP.		" "		
PATT.		" "		

H. G. FISCHER & CO.
2335 WABANSIA AVE.
CHICAGO, ILL.

CAT. NO.

PART NO. E444

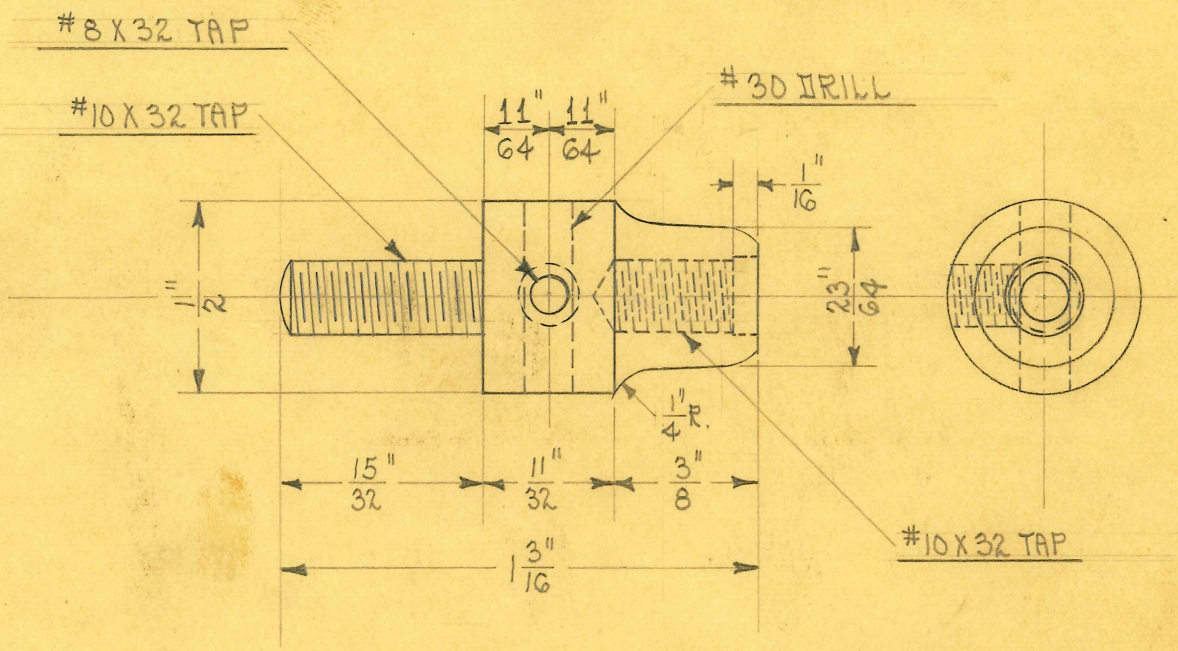

SCALE ~ 2 DIAMETERS

OBSOLETE

SIZE	1/2"	ISSUE 1-13-32	H.E.	TITLE: SINU. SPONGIO DISC ELECTRODE HANDLE STUD		
KIND	BRASS ROD	CHANGED				
SHAPE		" "				
FINISH	N.P.	" "				
TEMP.		" "		H. G. FISCHER & CO. 2335 WABANSIA AVE. CHICAGO, ILL.	CAT. NO.	PART NO. 1331
PATT.		" "				

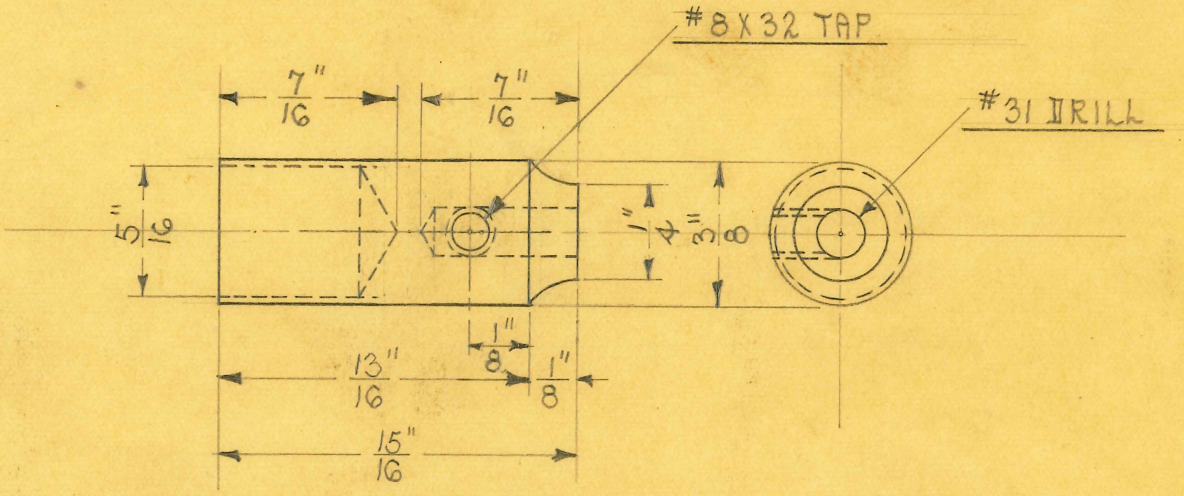

SCALE ÷ 2 DIAMETERS

OBSOLETE

SIZE	3/8"	ISSUE 1-22-32	A.E.	TITLE: AUTO PAD BINDING POST
KIND	BRASS ROD	CHANGED		
SHAPE		" "		
FINISH	N.P.	" "		
TEMP.		" "		
PATT.		" "		

H. G. FISCHER & CO.
2335 WABANSIA AVE.
CHICAGO, ILL.

CAT. NO.

PART NO. 1282

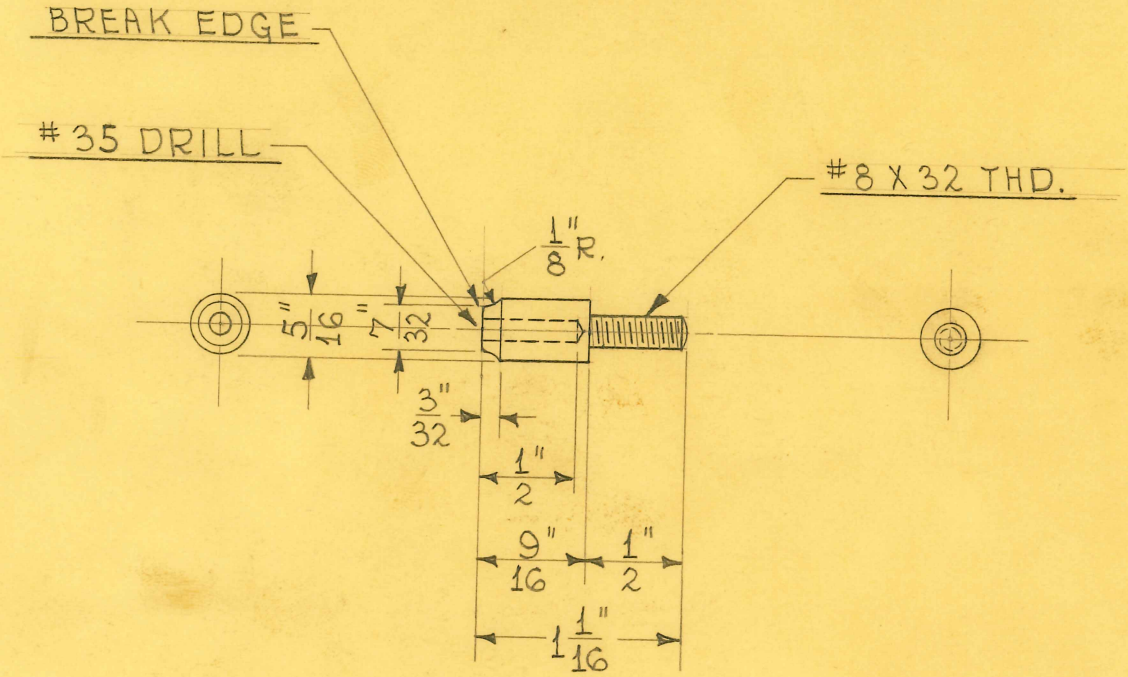

1 REQUIRED

OBSOLETE

SIZE	5/16" DIAM.	ISSUE 11-30-44	HE.
KIND	BRASS ROD	CHANGED	
SHAPE		"	
FINISH	NICKEL #12	"	
TEMP.		"	
PATT.		"	

TITLE: FULGURATION HANDLE BINDING POST

H. G. FISCHER & CO.
2335 WABANSIA AVE.
CHICAGO. ILL.

CAT. NO.

PART NO. 1231

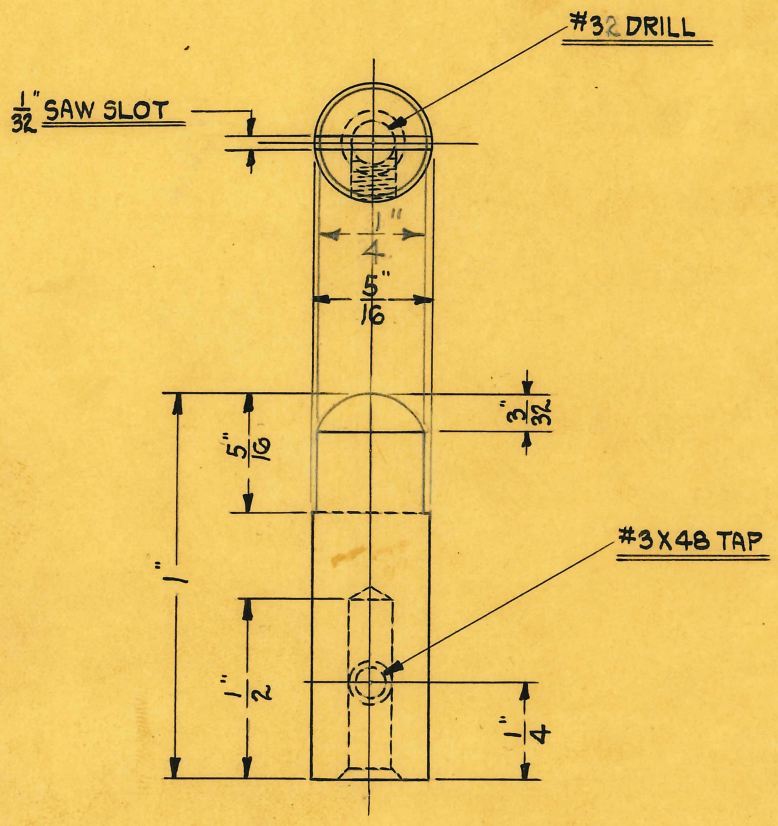

SCALE ~ 2 DIAMETERS

OBSOLETE

SIZE	5/16"	ISSUE H.E.	4-9-30	TITLE: BLOCK TIN CLAMP BINDING POST
KIND	BRASS ROD	CHANGED H.E.	3-13-33	
SHAPE	ROUND	" "		
FINISH	W.P.	" "		
TEMP.		" "		
PATT.		" "		

H. G. FISCHER & CO.
2335 WABANSIA AVE.
CHICAGO, ILL.

CAT. NO.

PART NO. 1494

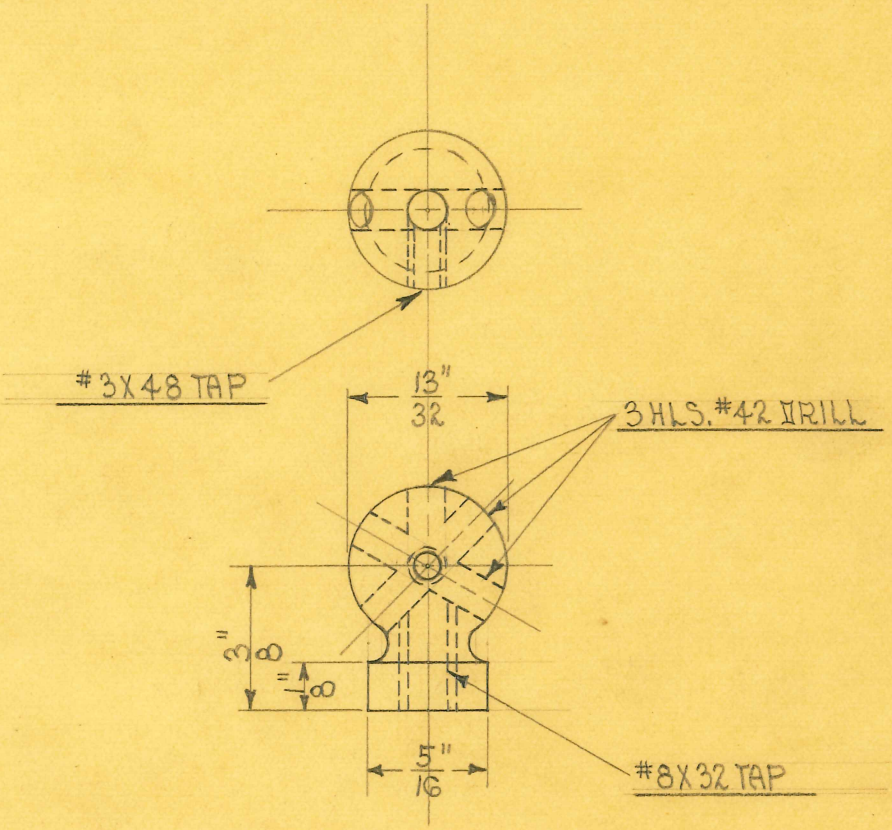

SCALE ~ DOUBLE SIZE

DRILL JIG # C3107

OBSOLETE

SIZE	7/16"	ISSUE 11-25-32	A.E.
KIND	BRASS ROD	CHANGED	
SHAPE		" "	
FINISH	N.P.	" "	
TEMP.		" "	
PATT.		" "	

TITLE: CAUTERY HANDLE BALL BINDING POST (RIGHT)

H. G. FISCHER & CO.
2335 WABANSIA AVE.
CHICAGO, ILL.

CAT. NO.

PART NO. 1242

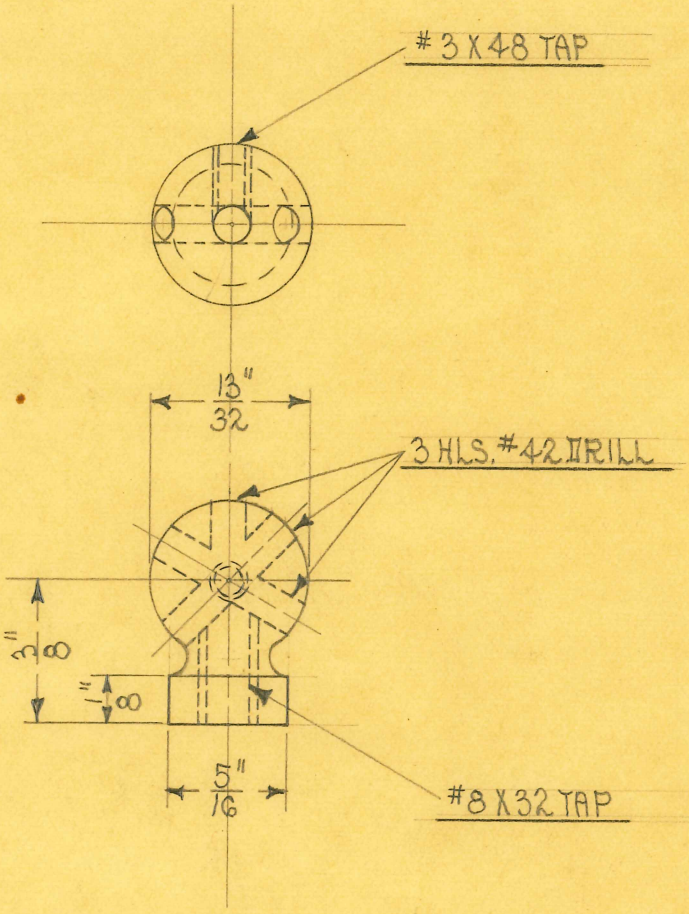

SCALE ÷ DOUBLE SIZE

DRILL JIG # C3197

OBSOLETE

SIZE	7/16"	ISSUE 11-26-32	A.E.
KIND	BRASS ROD	CHANGED	
SHAPE		" "	
FINISH	N.P.	" "	
TEMP.		" "	
PATT.		" "	

TITLE: CAUTERY HANDLE BALL BINDING POST (LEFT)

H. G. FISCHER & CO.
2335 WABANSIA AVE.
CHICAGO, ILL.

CAT. NO.

PART NO. 1243

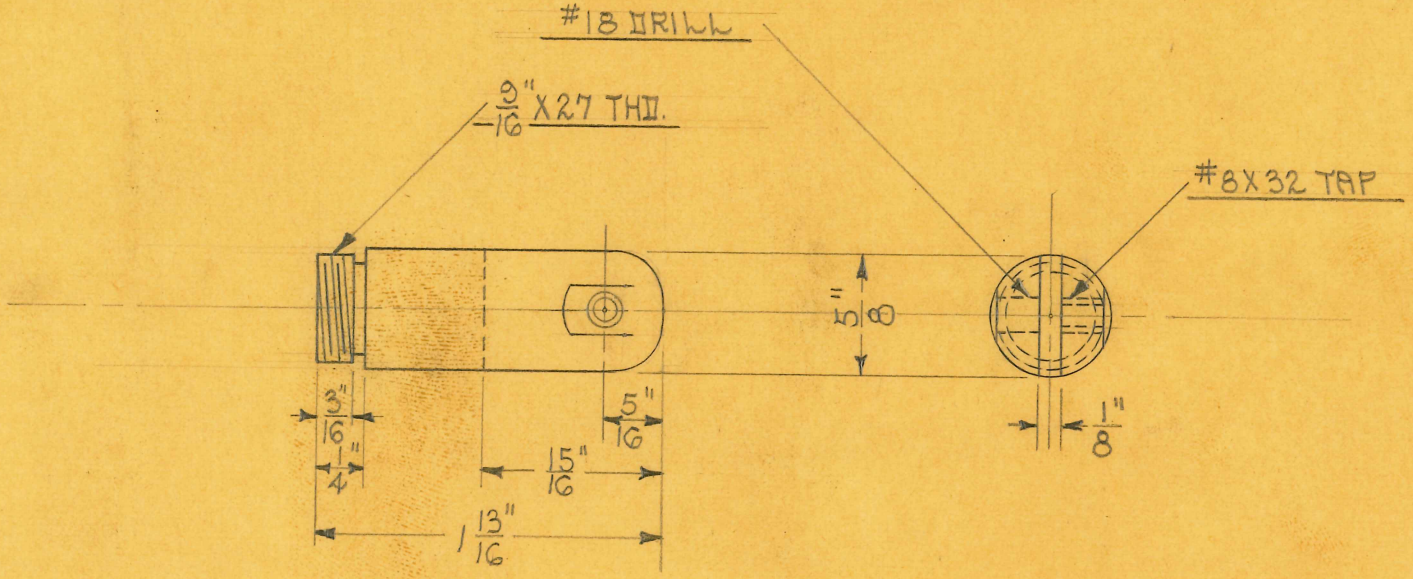

SCALE ½ FULL SIZE
1 REQUIRED

OBSOLETE

SIZE	5/8"	ISSUE 7-31-31	H.E.	TITLE: ADJUSTABLE HIGH FREQ. HANDLE FIBRE TOP	
KIND	BK. FIBRE ROD	CHANGED			
SHAPE		" "			
FINISH		" "			
TEMP.		" "		H. G. FISCHER & CO. 2335 WABANSIA AVE. CHICAGO, ILL.	CAT. NO.
PATT.		" "			PART NO. 1251 3/4

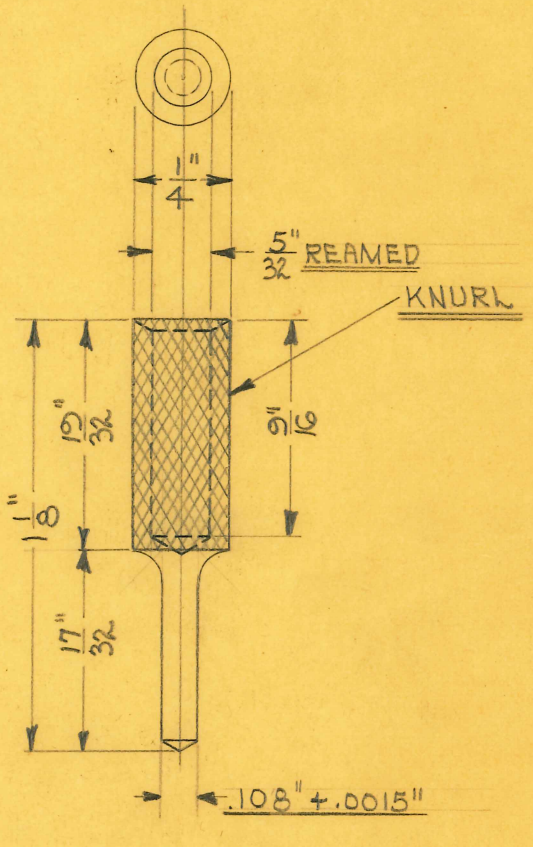

SCALE ~ 2 DIAMETERS

OBSOLETE

SIZE	1/4"	ISSUE 10-15-30	A.E.	TITLE: CORD TIP ADAPTER DECREASES SIZE OF 5/32" TIP TO 3/32"	
KIND	BRASS ROD	CHANGED			
SHAPE	ROUND	" "			
FINISH	W.P.	" "			
TEMP.		" "		H. G. FISCHER & CO. 2335 WABANSIA AVE. CHICAGO, ILL.	CAT. NO.
PATT.		" "			PART NO. 699 1/2

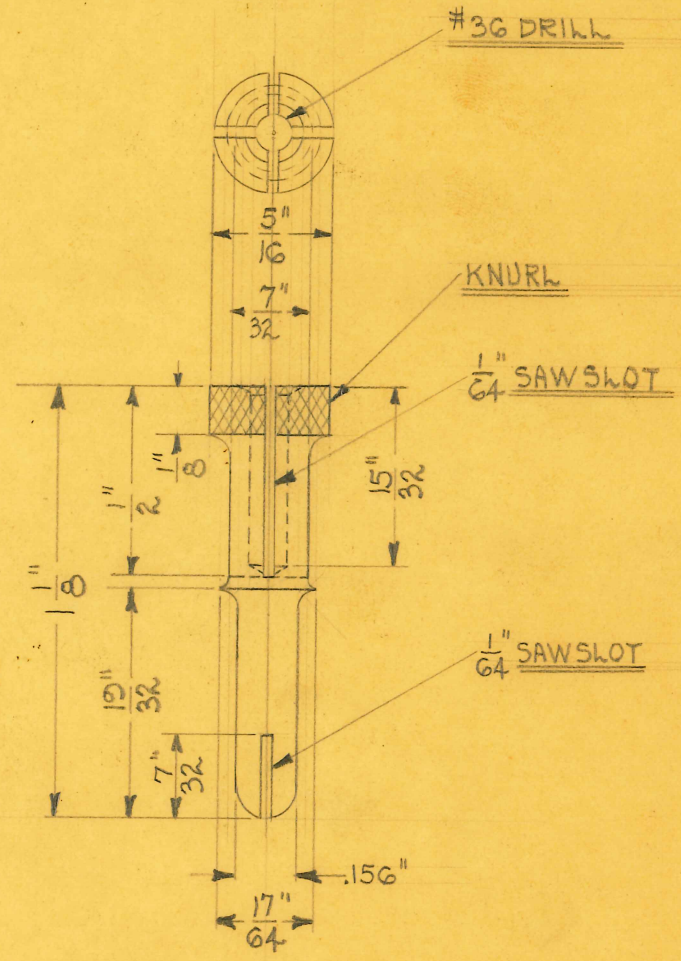

SCALE ~ 2 DIAMETERS

OBSOLETE

SIZE	5/16"	ISSUE 10-15-30	H.E.
KIND	BRASS ROD	CHANGED	
SHAPE	ROUND	" "	
FINISH	W. P.	" "	
TEMP.		" "	
PATT.		" "	

TITLE: CORD TIP ADAPTER
INCREASES SIZE OF 3/32" TIP TO 5/32"

H. G. FISCHER & CO.
2335 WABANSIA AVE.
CHICAGO, ILL.

CAT. NO.

PART NO. 699

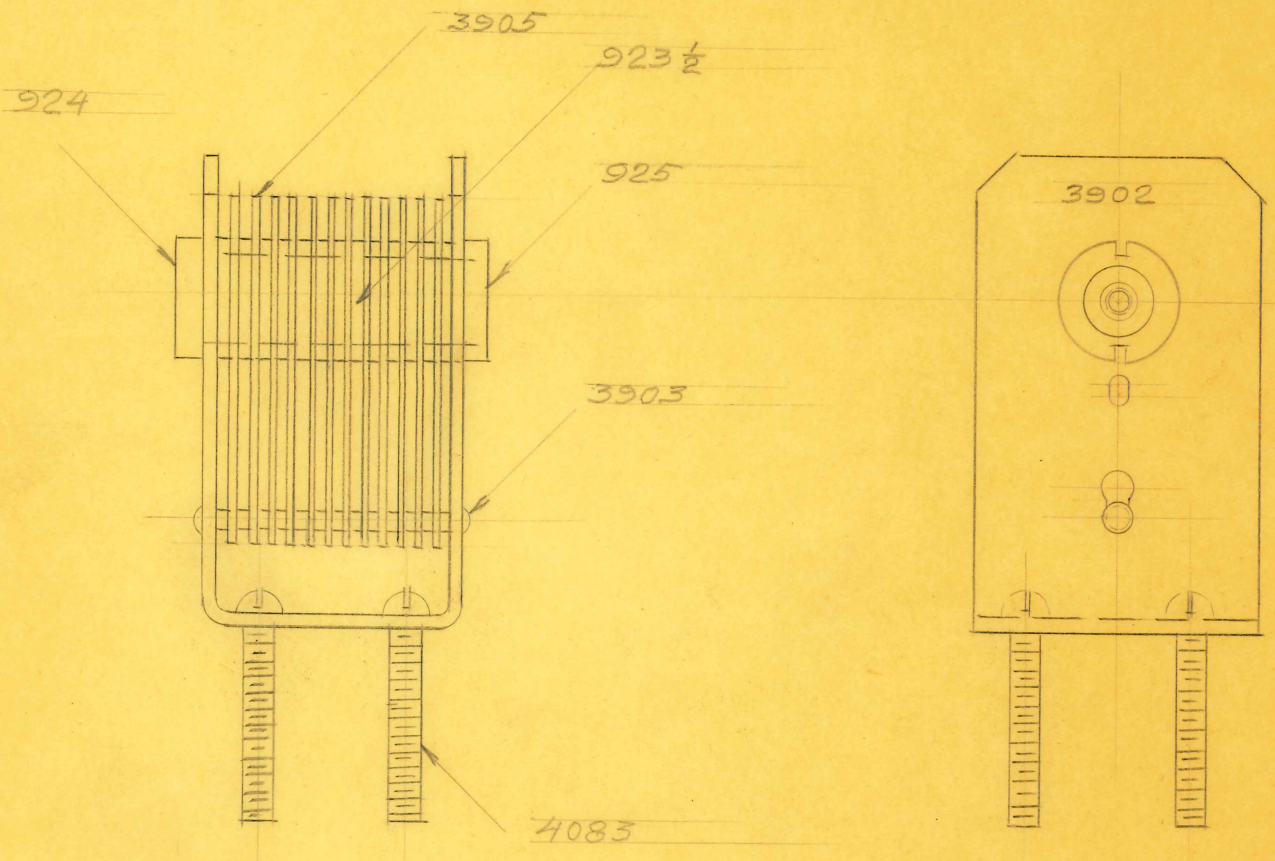

OBSOLETE

(2)

SIZE		ISSUE 9-15-26		TITLE: NEW - ALOE - OUTFIT GAP (2 SET)
KIND		CHANGED		
SHAPE		" "		
FINISH		" "		
TEMP.		" "		H. G. FISCHER & CO. 2335 WABANSIA AVE. CHICAGO, ILL. — CAT. NO. — PART NO. 3902 G
PATT.		" "		

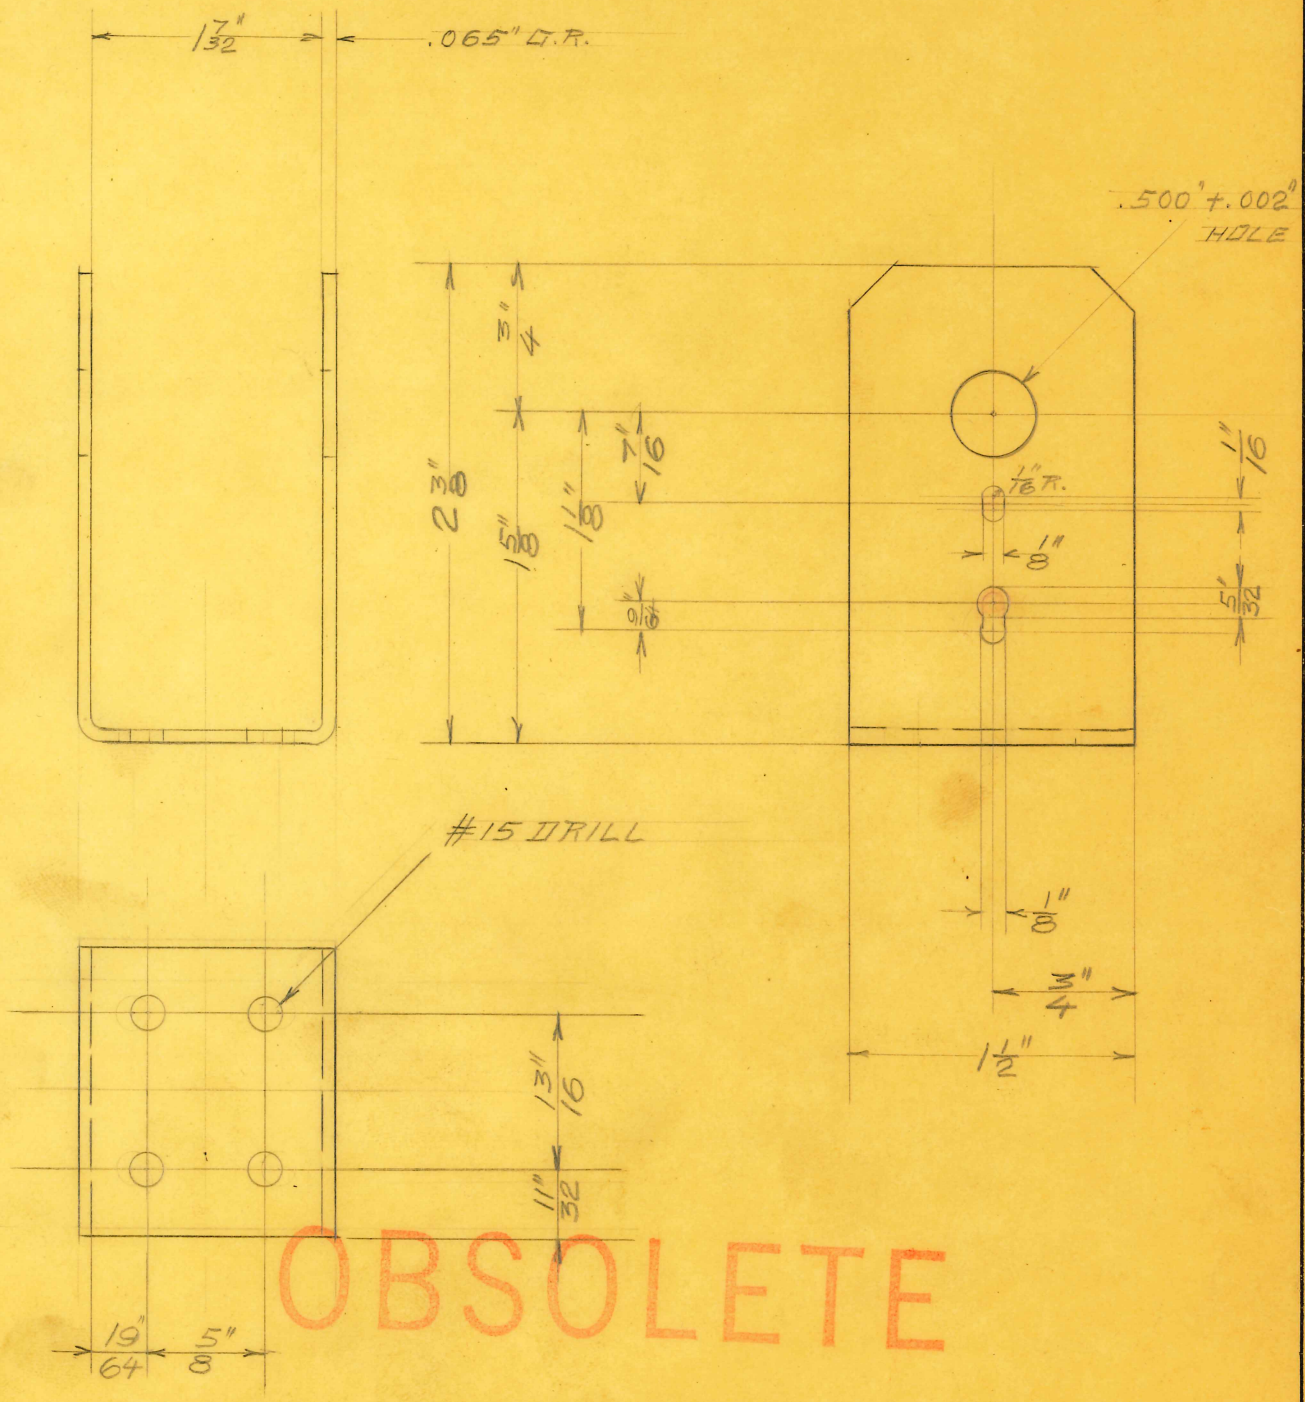

OBSOLETE

(2)

SIZE		ISSUE 9-15-26	C.P.
KIND	C.R. STEEL	CHANGED	
SHAPE		" "	
FINISH	N.P.	" "	
TEMP.		" "	
PATT.		" "	

TITLE: NEW ALOE OUTFIT
GAP FRAME

H. G. FISCHER & CO.
2335 WABANSIA AVE.
CHICAGO, ILL.

CAT. NO.

PART NO. 3902

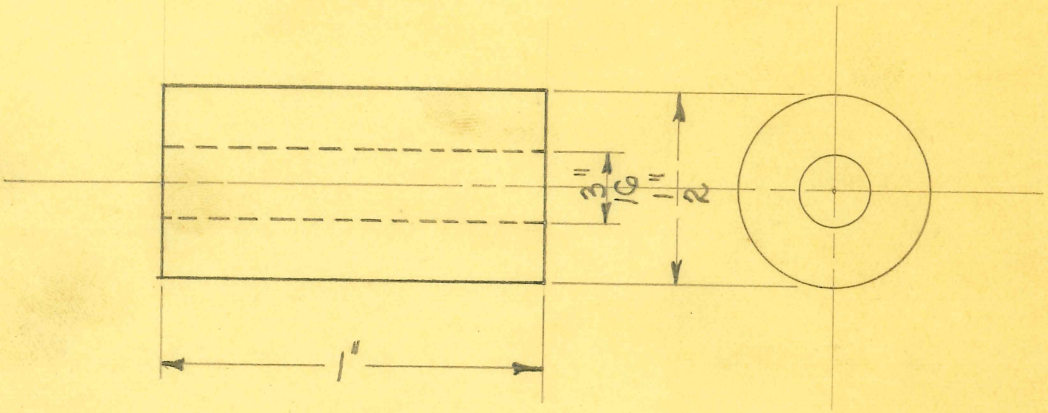

SCALE ~ 2 DIAMETERS
1 REQUIRED

OBSOLETE

SIZE		ISSUE 12-28-31	A.E.	TITLE: "Y" OUTFIT SPACER
KIND	H.RUB.TUBING	CHANGED		
SHAPE		" "		
FINISH		" "		
TEMP.		" "		H. G. FISCHER & CO. 2335 WABANSIA AVE. CHICAGO, ILL. — CAT. NO. — PART NO. 3934
PATT.		" "		

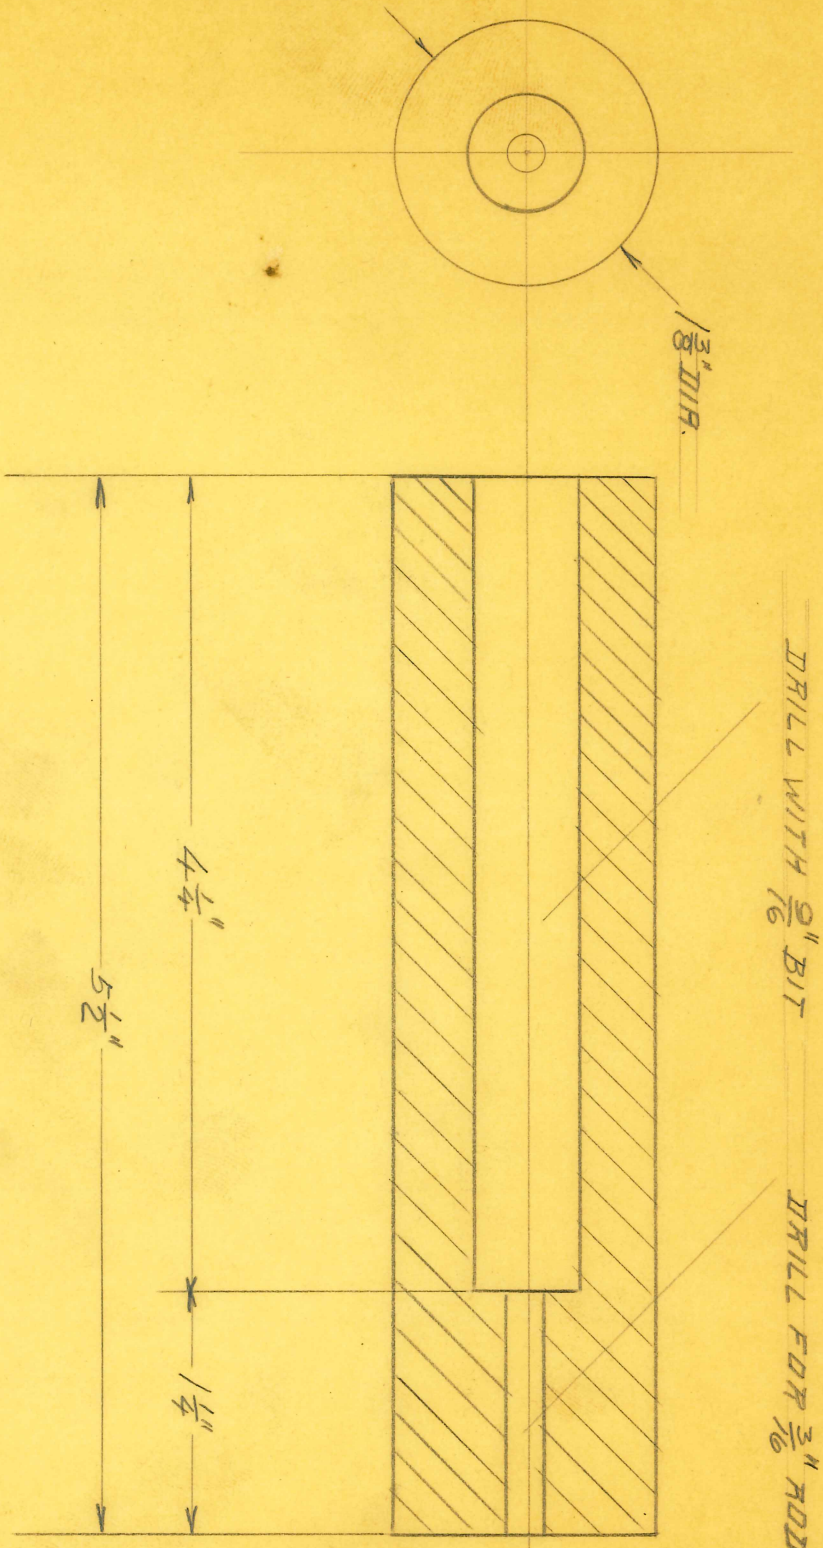

OBSOLETE

(1)

SIZE		ISSUE 8-4-26 CP	TITLE: TESLA COIL SECONDARY DOWEL ALDE NEW LIGHTNING	
KIND	WOOD	CHANGED		
SHAPE		" "		
FINISH		" "		
TEMP.		" "	H. G. FISCHER & CO. 2335 WABANSIA AVE. CHICAGO, ILL.	CAT. NO.
PATT.		" "		PART NO. 3930

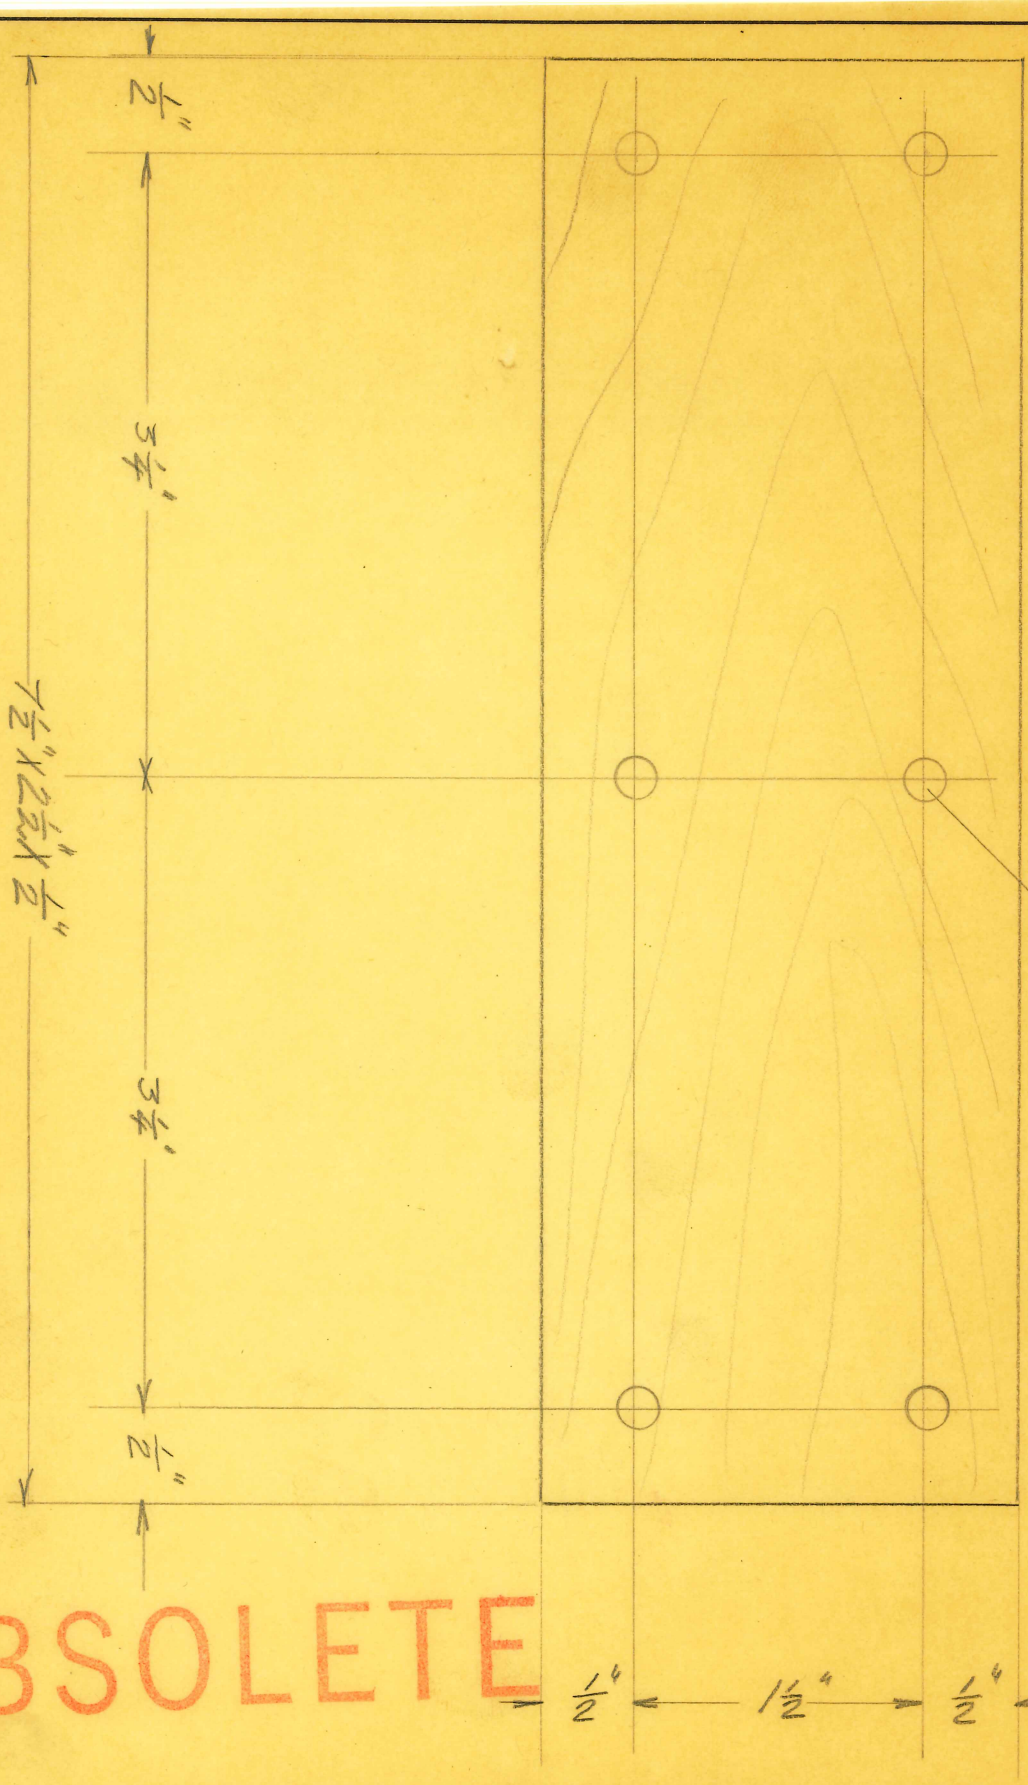

OBSOLETE

(2)

SIZE		ISSUE 7-26-26	Q.
KIND	WOOD	CHANGED	
SHAPE		" "	
FINISH		" "	
TEMP.		" "	
PATT.		" "	

TITLE: CONDENSER BLOCK
ALOE NEW LIGHTNING

H. G. FISCHER & CO.
2335 WABANSIA AVE.
CHICAGO, ILL.

CAT. NO.

PART NO. 3928F.

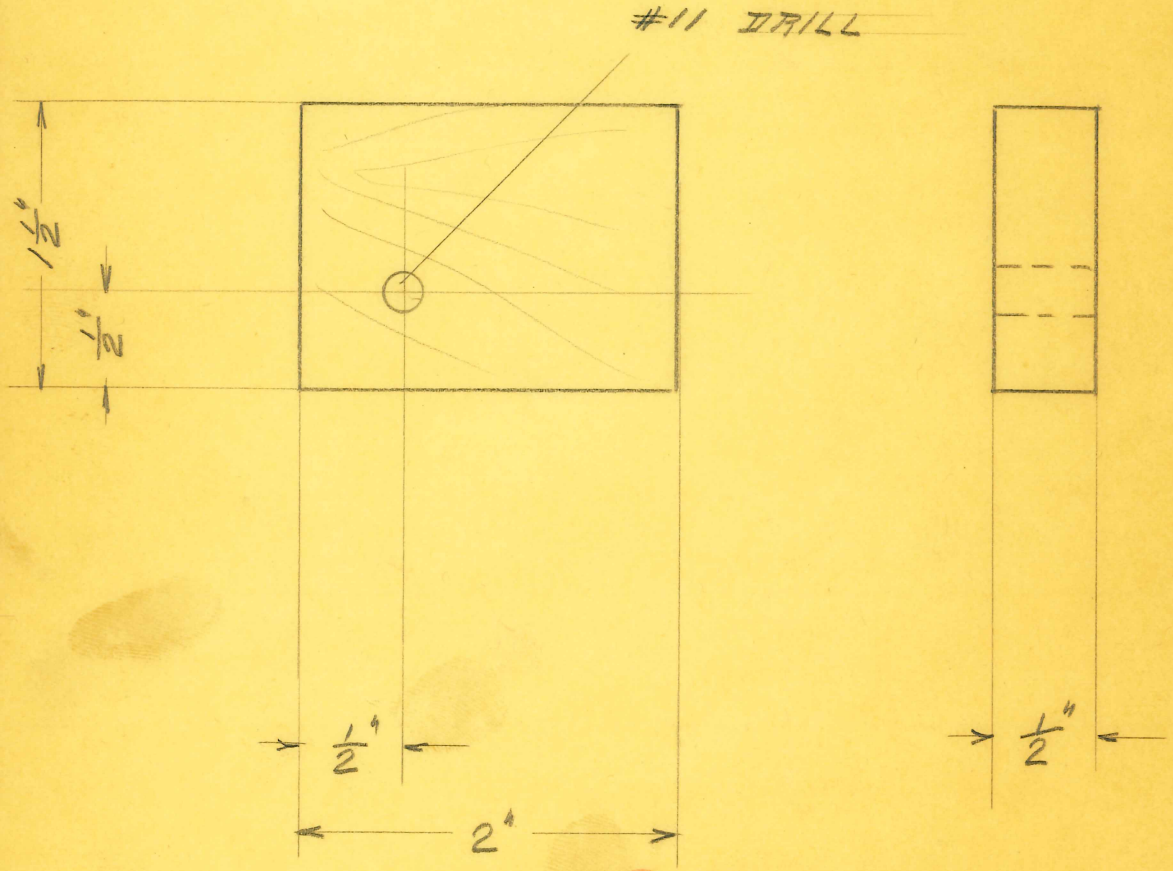

OBSOLETE

(2)

SIZE		ISSUE 7-26-26	(2)
KIND	WOOD	CHANGED	
SHAPE		" "	
FINISH		" "	
TEMP.		" "	
PATT.		" "	

TITLE: RESISSTANCE COIL SUPPORT
ALOE NEW LIGHTNING

H. G. FISCHER & CO.
2335 WABANSIA AVE.
CHICAGO, ILL.

CAT. NO.

PART NO. 3925 F.

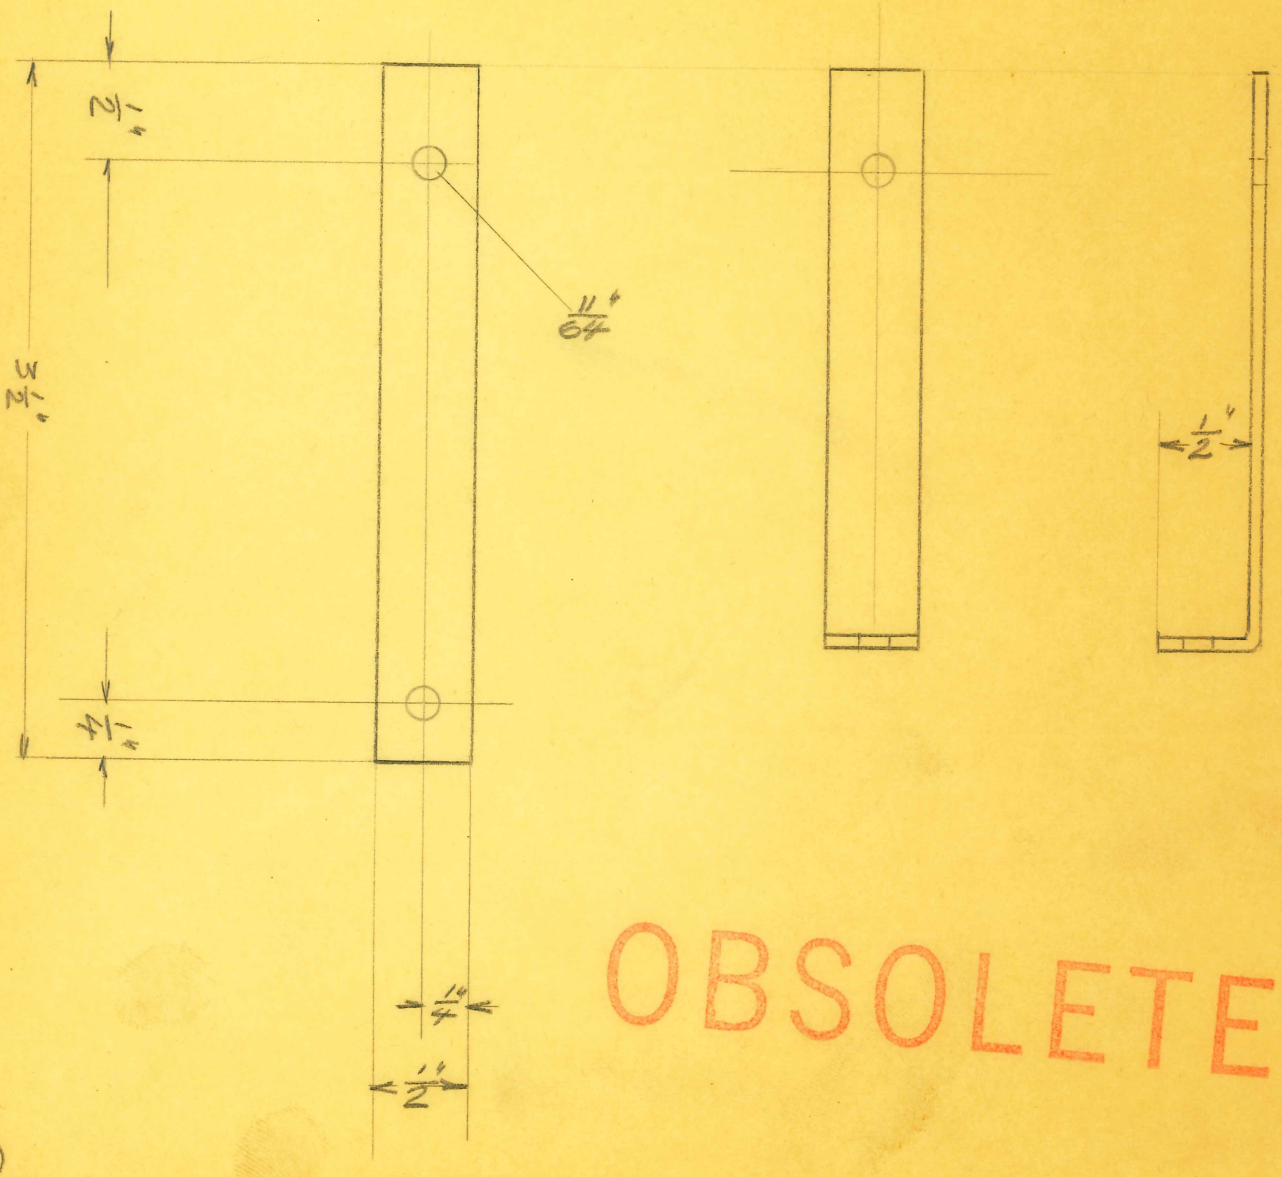

OBSOLETE

(1)

SIZE		ISSUE 7-26-26	(2)	TITLE: CONDENSER SUPPORT (SHORT) ALOE NEW LIGHTNING
KIND	L. R. STEEL	CHANGED		
SHAPE		" "		
FINISH		" "		
TEMP.		" "		H. G. FISCHER & CO. 2335 WABANSIA AVE. CHICAGO, ILL. — CAT. NO. — PART NO. 3923
PATT.		" "		

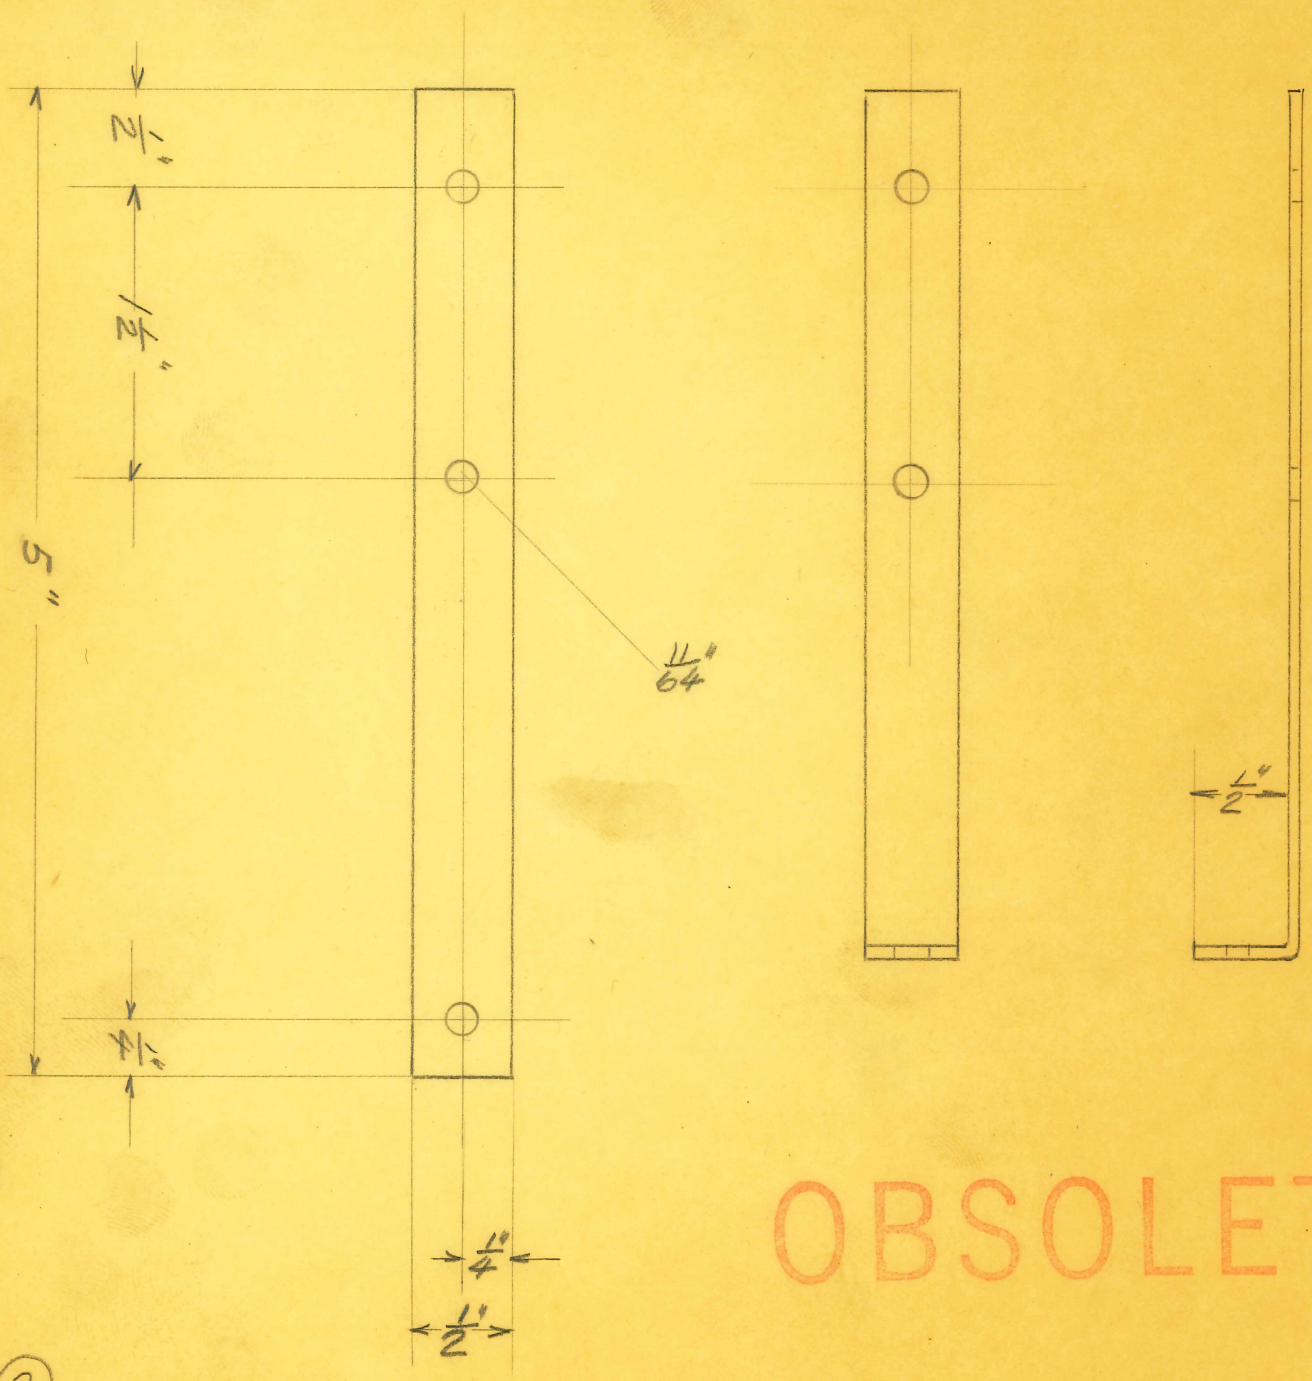

OBSOLETE

(2)

SIZE		ISSUE 7-26-26	Q.
KIND	C.R. STEEL	CHANGED	
SHAPE		" "	
FINISH		" "	
TEMP.		" "	
PATT.		" "	

TITLE: CONDENSER SUPPORT (LONG)
ALDE NEW LIGHTNING

H. G. FISCHER & CO.
2335 WABANSIA AVE.
CHICAGO, ILL.

CAT. NO.

PART NO. 3922

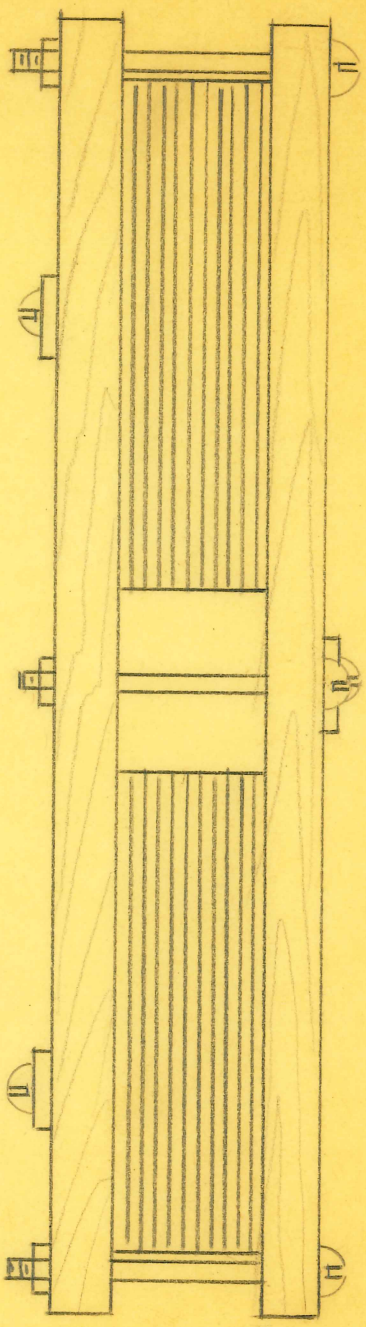

OBSOLETE

16 AND 17 COPPER SHEETS IN EACH CONDENSER

(1)

SIZE		ISSUE 7-26-26	C.	TITLE: CONDENSER COMPLET ALOE NEW LIGHTNING
KIND		CHANGED		
SHAPE		" "		
FINISH		" "		
TEMP.		" "		H. G. FISCHER & CO. 2335 WABANSIA AVE. CHICAGO, ILL.
PATT.		" "		CAT. NO.

PART NO. 3920G

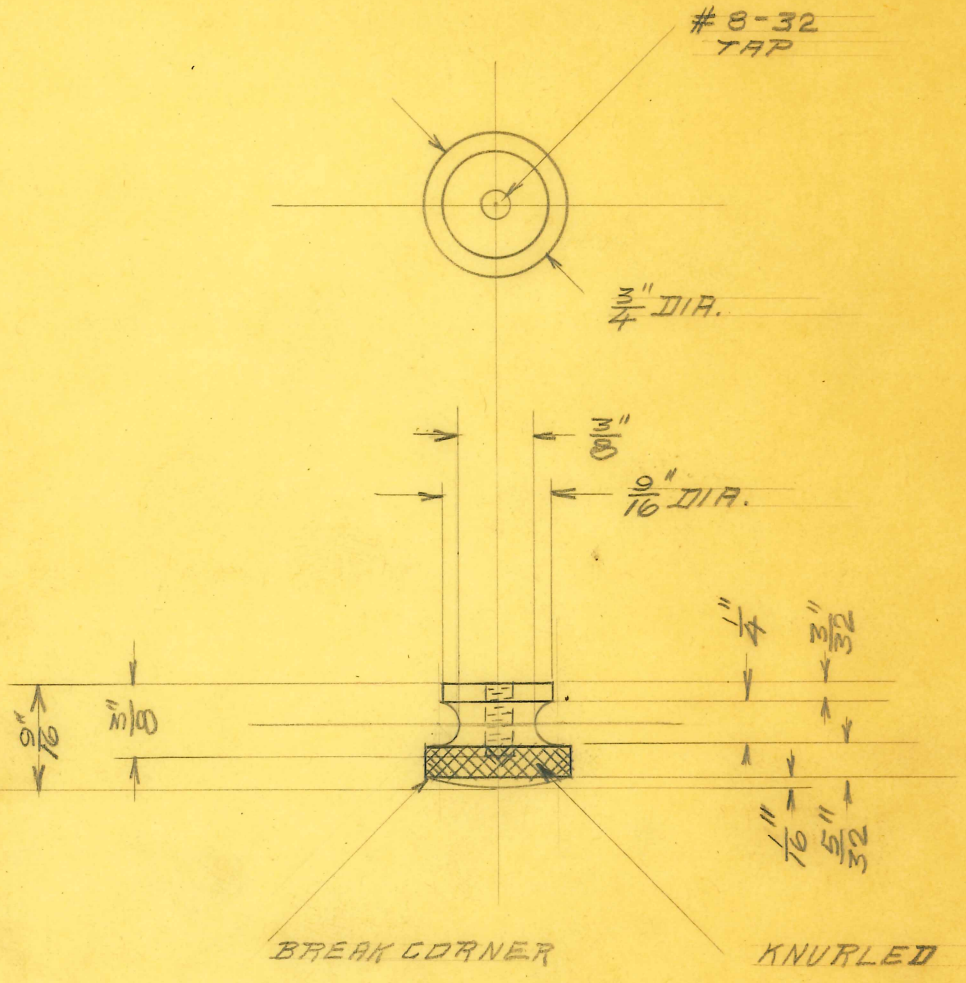

OBSOLETE

(3)

SIZE		ISSUE 8-6-26	CP
KIND	BRASS	CHANGED	
SHAPE		" "	
FINISH	N.R	" "	
TEMP.		" "	
PATT.		" "	

TITLE: BINDING POST THUMB NUT
ALDE NEW LIGHTNING

H. G. FISCHER & CO.
2335 WABANSIA AVE.
CHICAGO, ILL.

CAT. NO.

PART NO. 3914

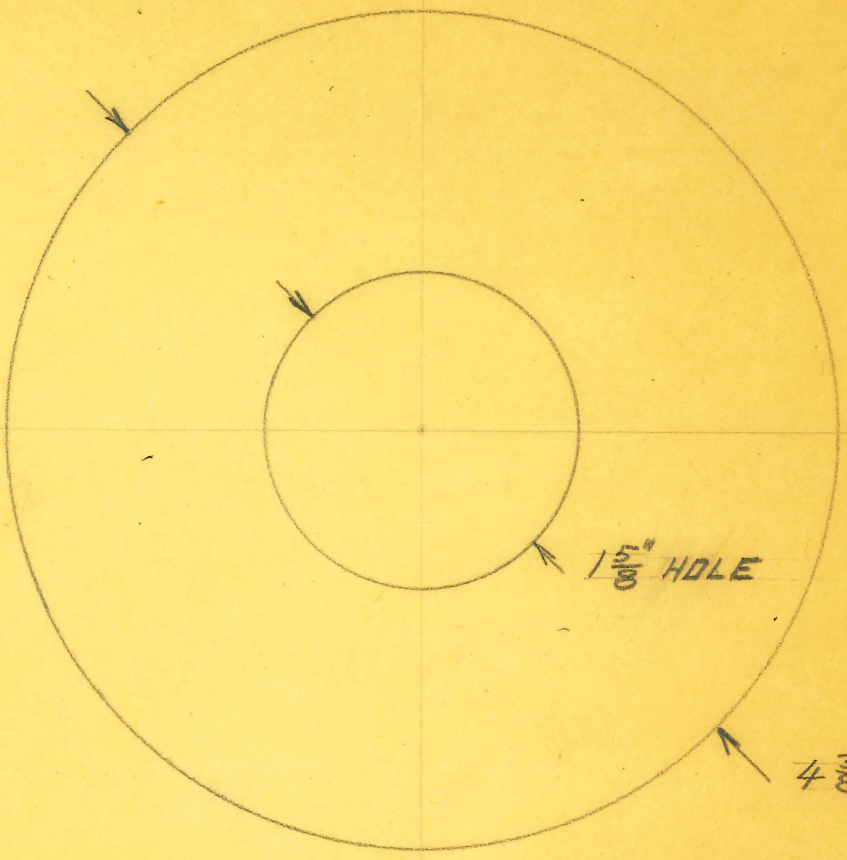

OBSOLETE

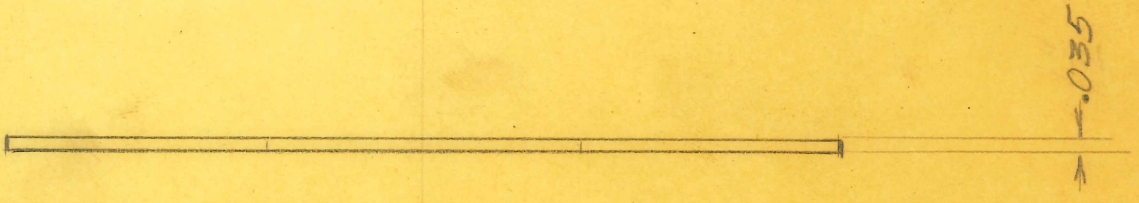

(8)

SIZE		ISSUE	
KIND	FULLERB.	CHANGED	
SHAPE		" "	
FINISH		" "	
TEMP.		" "	
PATT.		" "	

TITLE: FULLERBOARD WASHER
ALOE NEW LIGHTNING

H. G. FISCHER & CO.
2335 WABANSIA AVE.
CHICAGO, ILL.

CAT. NO.

PART NO. 3911

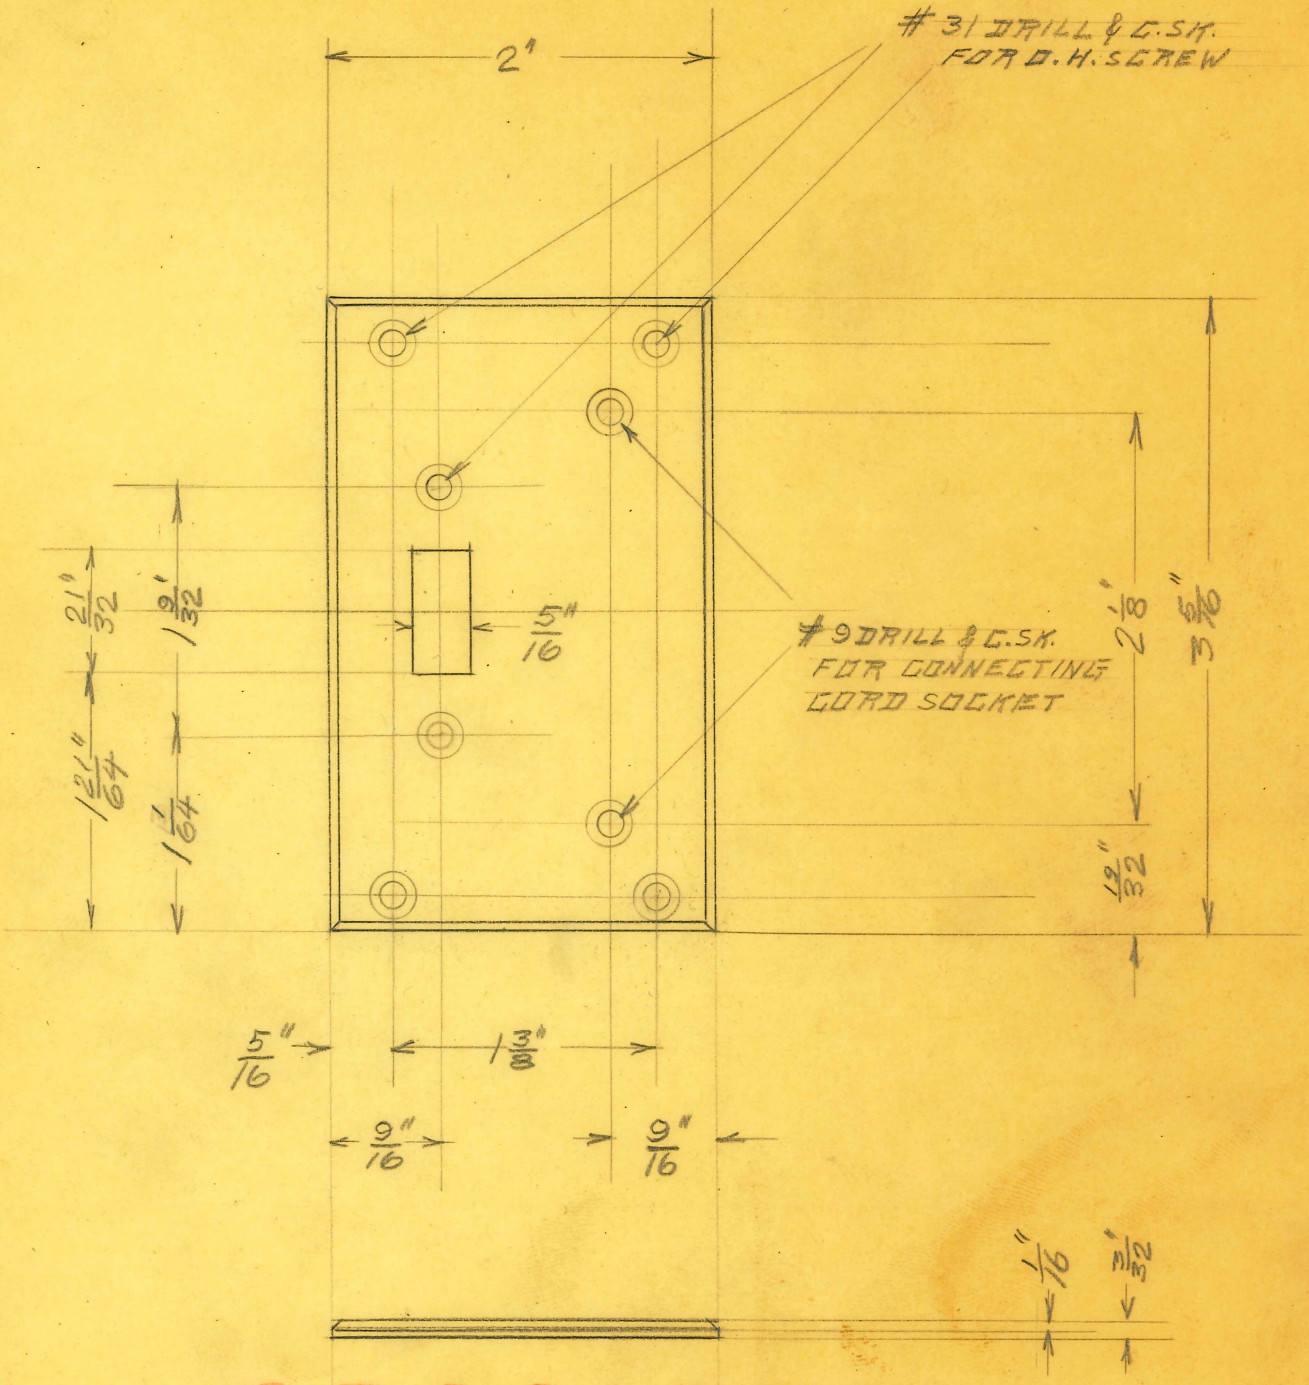

OBSOLETE

SIZE		ISSUE 7-24-26	Q.	TITLE: SWITCH PLATE ALOE NEW LIGHTNING	
KIND	B. FIBRE	CHANGED			
SHAPE		" "			
FINISH		" "			
TEMP.		" "		H. G. FISCHER & CO. 2335 WABANSIA AVE. CHICAGO, ILL.	CAT. NO.
PATT.		" "			PART NO. 3907

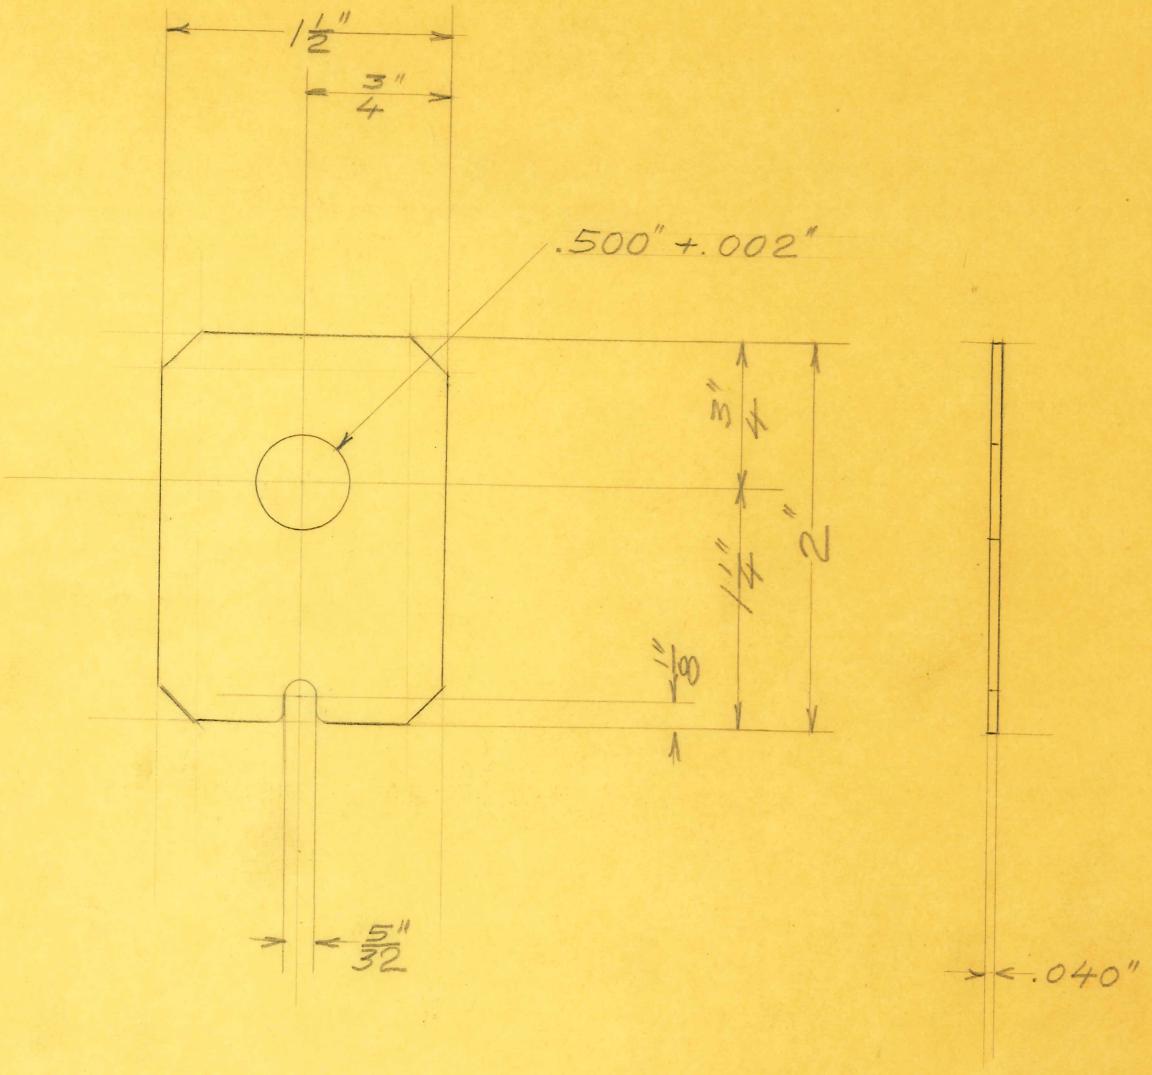

OBSOLETE

(24)

SIZE		ISSUE 9-15-26	GP
KIND	COPPER	CHANGED	
SHAPE		" "	
FINISH		" "	
TEMP.		" "	
PATT.		" "	

TITLE: NEW ALOE OUTFIT
GAP FLANGE

H. G. FISCHER & CO.
2335 WABANSIA AVE.
CHICAGO, ILL.

CAT. NO.

PART NO. 3905

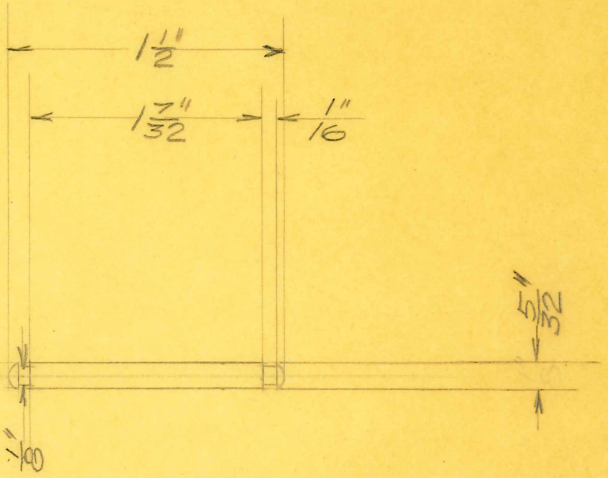

OBSOLETE

(2)

SIZE		ISSUE 9-15-26	CP	TITLE: NEW ALOE OUTFIT FRAME PIN	
KIND	BRASS	CHANGED			
SHAPE		" "			
FINISH	N.P.	" "			
TEMP.		" "			
PATT.		" "			

H. G. FISCHER & CO.
2335 WABANSIA AVE.
CHICAGO, ILL.

CAT. NO.

PART NO. 3903

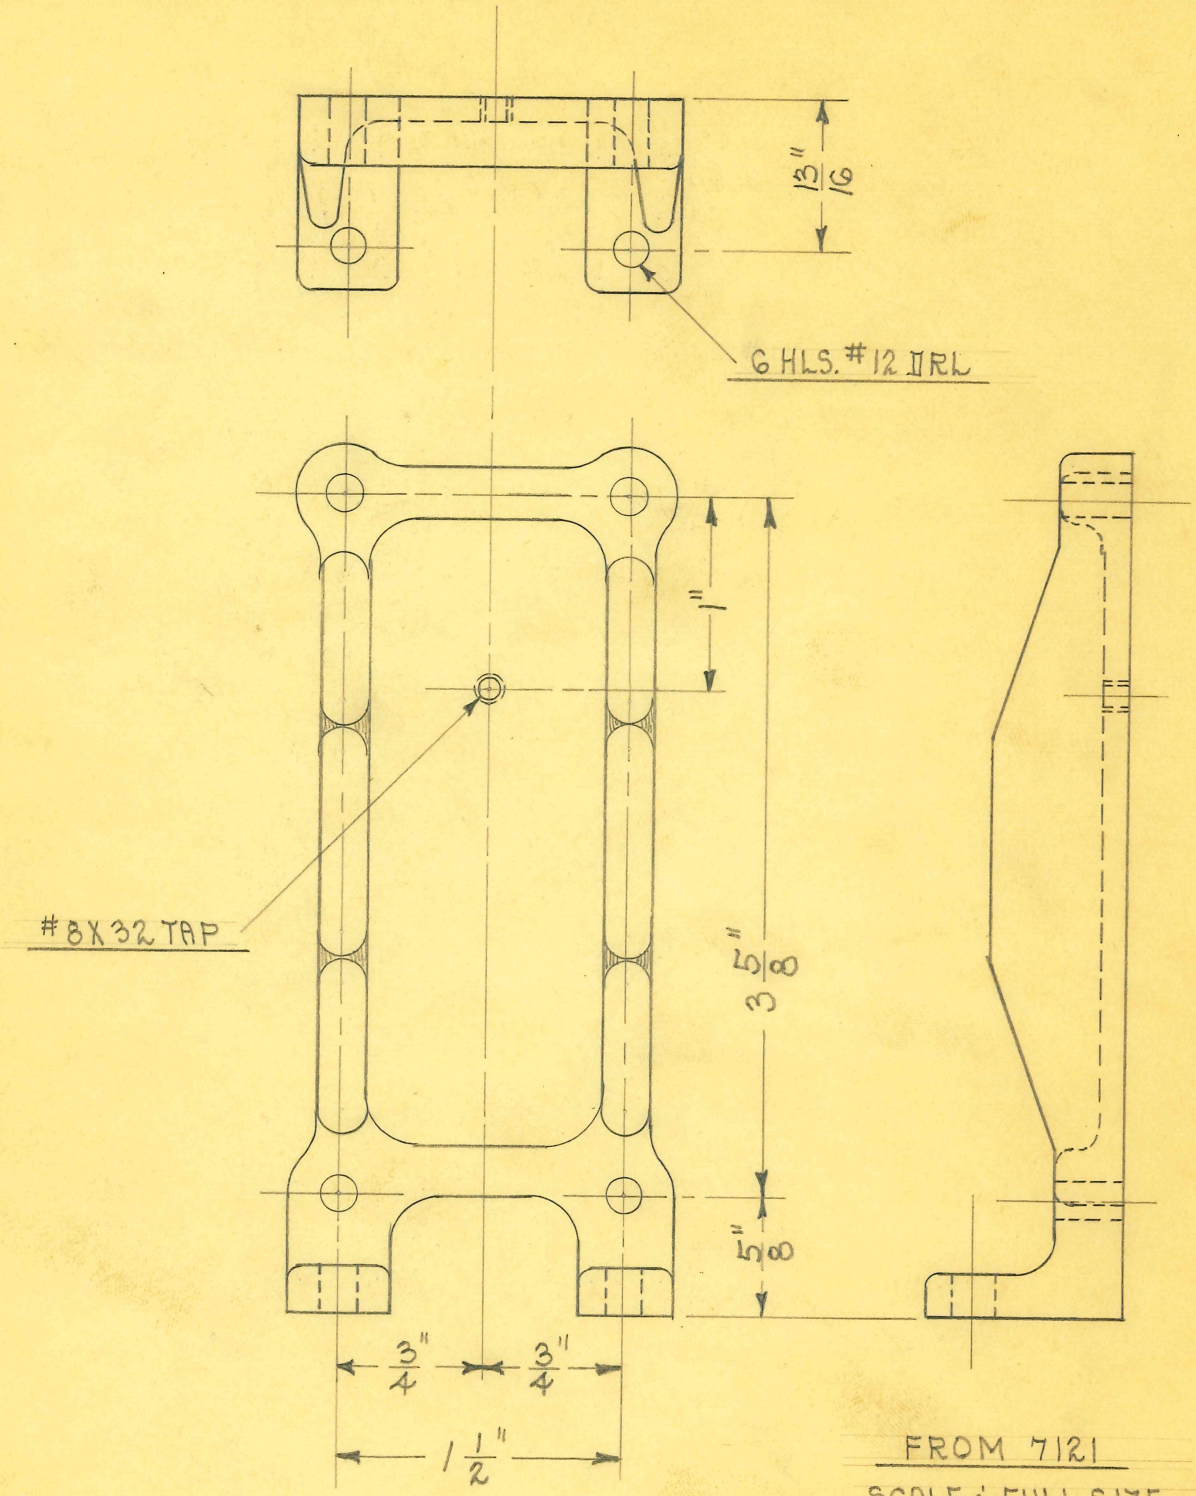

FROM 7121

SCALE ½ FULL SIZE

1 REQUIRED

OBSOLETE

SIZE		ISSUE 12-28-31	A.E.	**TITLE:** COMBINATION "Y" CONDENSER BRACKET		
KIND		CHANGED				
SHAPE		" "				
FINISH		" "				
TEMP.		" "		H. G. FISCHER & CO. 2335 WABANSIA AVE. CHICAGO, ILL.	CAT. NO.	PART NO. 3920½
PATT.		" "				

OBSOLETE

(4)

SIZE		ISSUE 6-16-26	C.	TITLE: INSIDE WOOD SEPARATORS TYPE "G" PORT. DIA.	
KIND	H. WOOD	CHANGED			
SHAPE		" "			
FINISH		" "			
TEMP.		" "		H. G. FISCHER & CO. 2335 WABANSIA AVE. CHICAGO, ILL.	CAT. NO.
PATT.		" "			PART NO. 3351F.

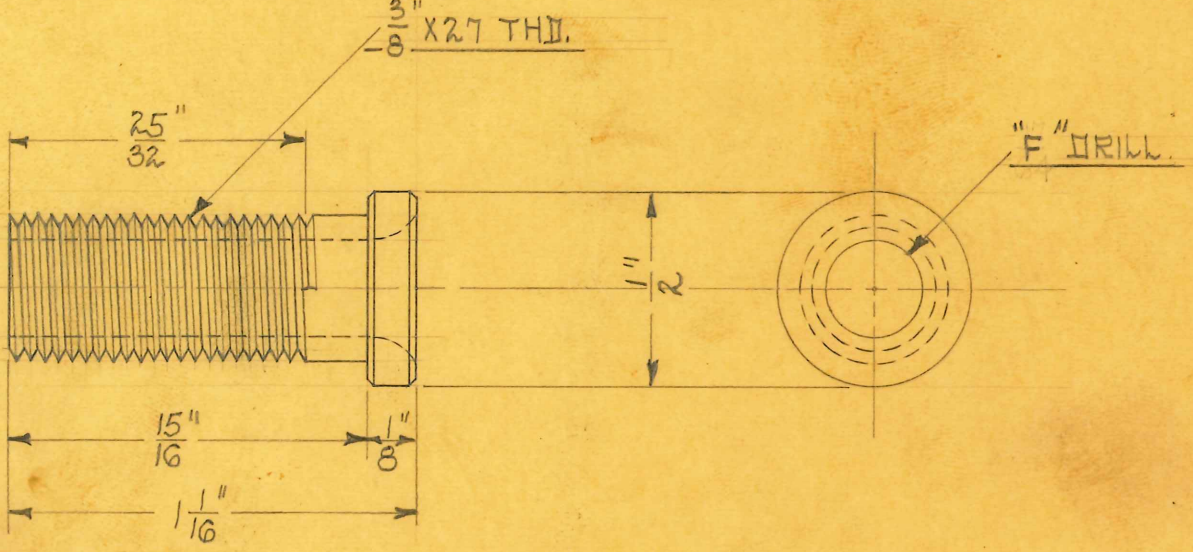

SCALE ~ 2 DIAMETERS
3 REQUIRED

OBSOLETE

SIZE	1/2"	ISSUE 7-27-31	A.E.	TITLE: PORTABLE DIATHERMY METER SOCKET
KIND	BRASS ROD	CHANGED		
SHAPE		" "		
FINISH	W.P	" "		
TEMP.		" "		H. G. FISCHER & CO. 2335 WABANSIA AVE. CHICAGO, ILL. / CAT. NO. / PART NO. 3312
PATT.		" "		

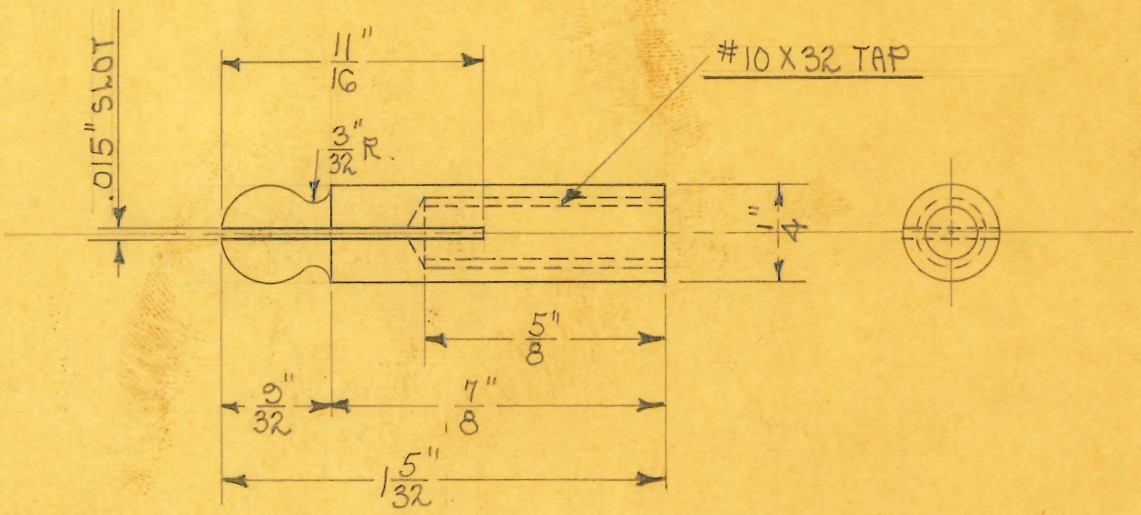

SCALE ~ 2 DIAMETERS

OBSOLETE

SIZE	1/4"	ISSUE 9-3-31	29.8.	TITLE: PORTABLE DIATHERMY METER PLUG
KIND	BRASS ROD	CHANGED		
SHAPE		" "		
FINISH	W.P.	" "		
TEMP.		" "		
PATT.		" "		

H. G. FISCHER & CO.
2335 WABANSIA AVE.
CHICAGO, ILL.

CAT. NO.

PART NO. 3313

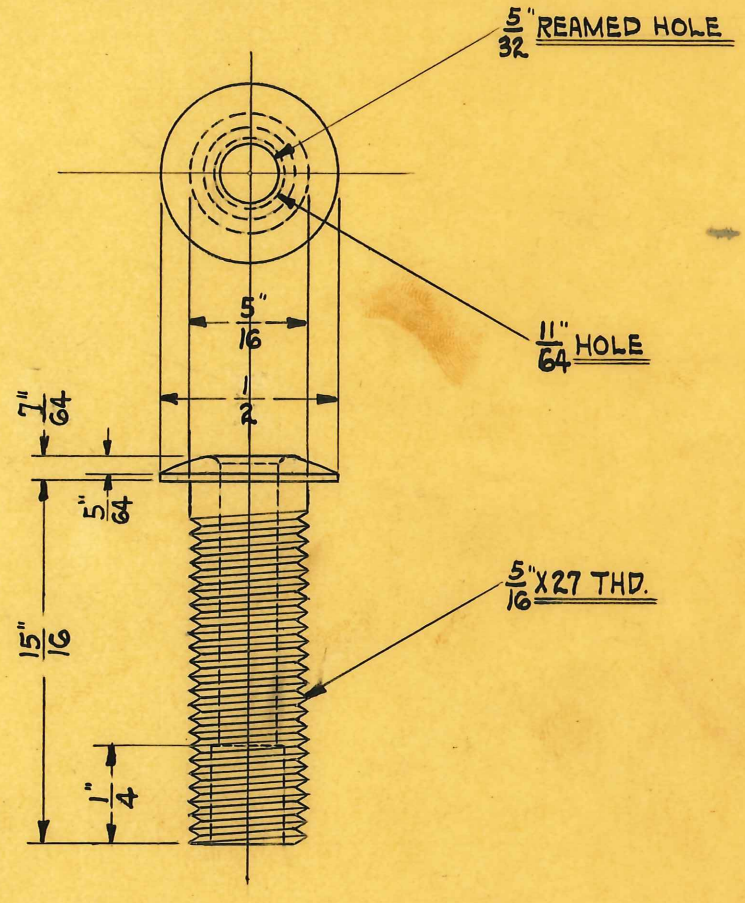

SCALE ~ 2 DIAMETERS

OBSOLETE

Obsolete

SIZE	1/2"	ISSUE H.E.	3-12-30	TITLE: PORTABLE DIATHERMY CONNECTING CORD SOCKET
KIND	BRASS ROD	CHANGED		
SHAPE	ROUND	" "		
FINISH	N.P.	" "		
TEMP.		" "		
PATT.		" "		

H. G. FISCHER & CO.
2335 WABANSIA AVE.
CHICAGO, ILL.

CAT. NO.

PART NO. 3315

NOTE:

5/32" REAMED HOLE - AFTER PLATING

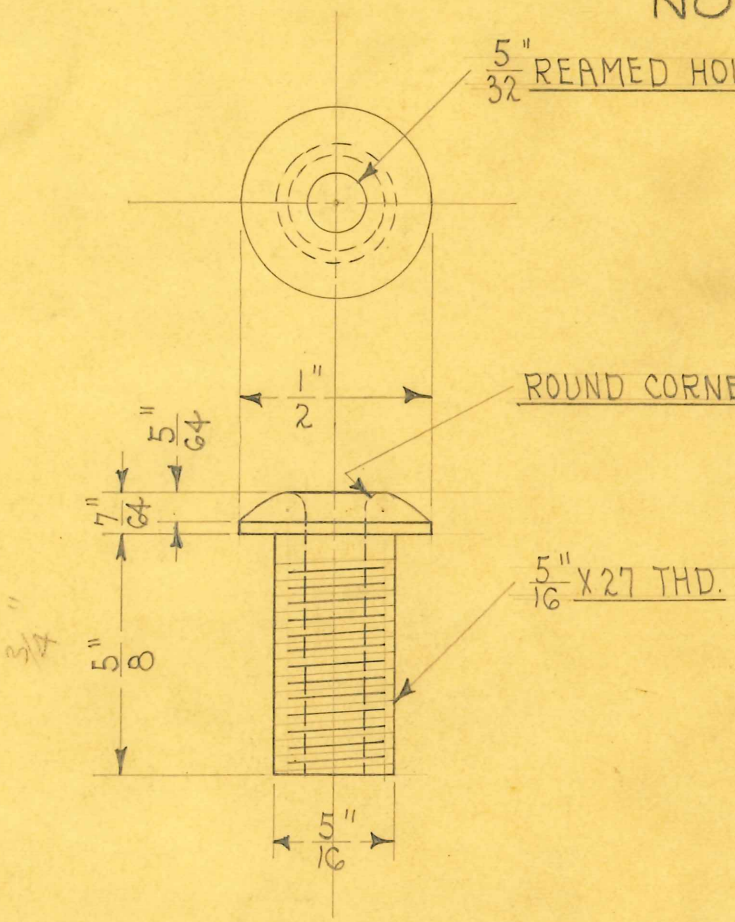

SCALE ~ 2 DIAMETERS

OBSOLETE

OBSOLETE
SEE Bulletin #606
6/24/68 bzz

SIZE	1/2"	ISSUE 6-13-35	A.E.
KIND	BRASS ROD	CHANGED	
SHAPE		"	
FINISH	CAD. #23	"	
TEMP.		"	
PATT.		"	

TITLE: PORTABLE DIATHERMY CONNECTING CORD SOCKET

H. G. FISCHER & CO.
2335 WABANSIA AVE.
CHICAGO, ILL.

CAT. NO.

PART NO. 3315A

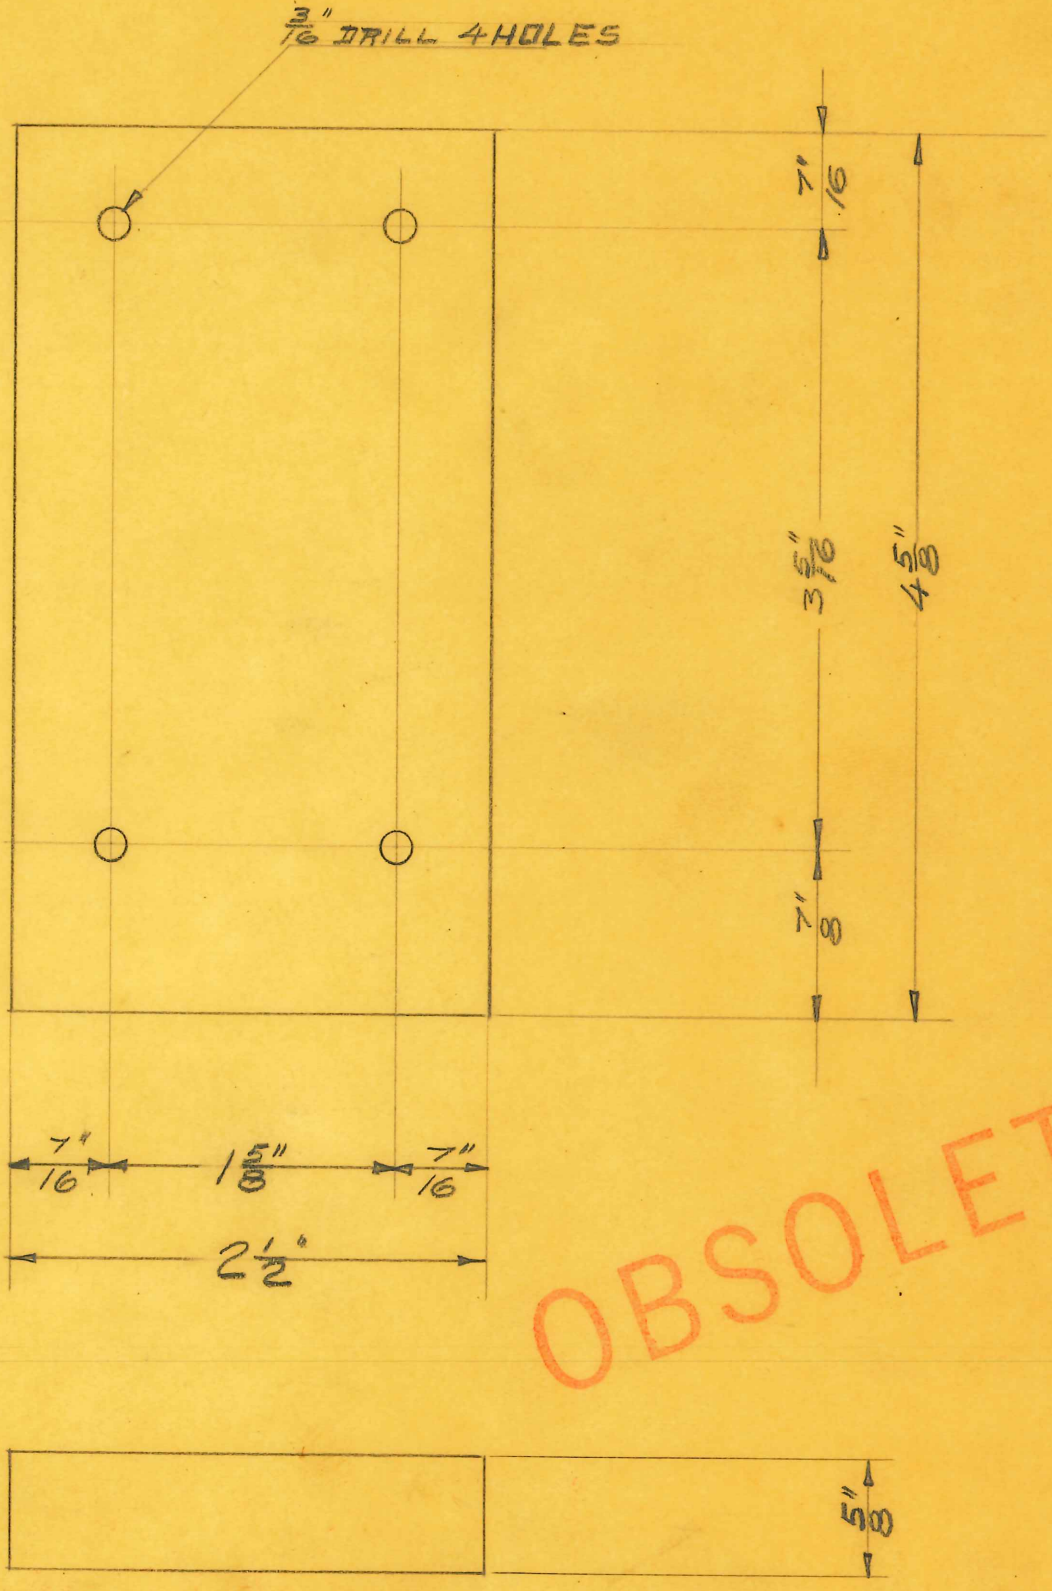

OBSOLETE

2.

SIZE		ISSUE 11-5-26	EP	TITLE: PORTABLE DIATHERMY CONDENSER BLOCK
KIND	WOOD	CHANGED		
SHAPE		" "		
FINISH		" "		
TEMP.		" "		H. G. FISCHER & CO. 2335 WABANSIA AVE. CHICAGO, ILL. — CAT. NO. — PART NO. 3333F
PATT.		" "		

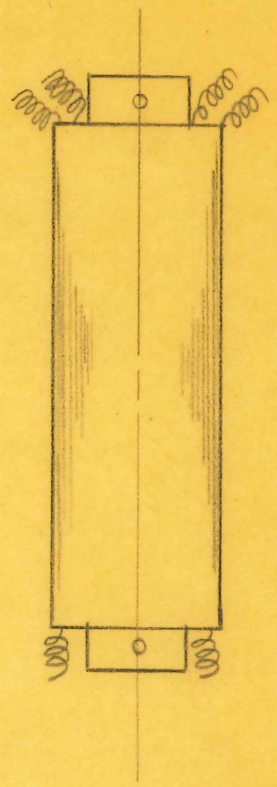

CORE PIECES 5¼"x1" - 6¼"x1"			
BUILD UP TO 1"			
LAYER	TURNS	WIRE # CATT. E.	TAP
			1
2		14	1
2		16	1
2		18	1
3		20	1
3		20	1

OBSOLETE

SIZE		ISSUE 2-2-27	R.J.L.	TITLE: LINE CHOKE FOR 110V.-60 CYCLES PORT.-DIATHERM TYPE "G"		
KIND		CHANGED				
SHAPE		" "				
FINISH		" "				
TEMP.		" "		H. G. FISCHER & CO. 2335 WABANSIA AVE. CHICAGO, ILL.	CAT. NO.	PART NO. 3340 G.
PATT.		" "				

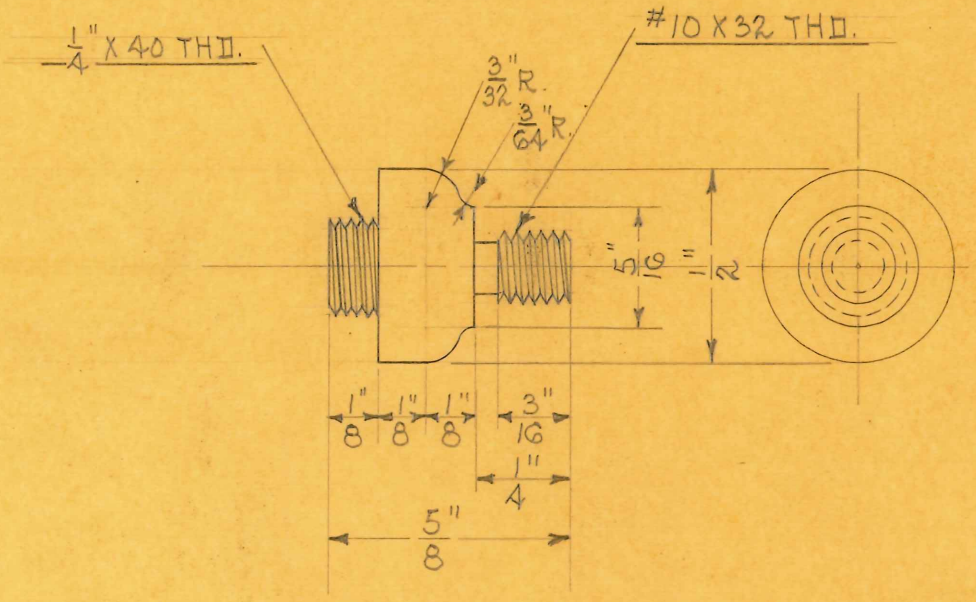

SCALE ~ 2 DIAMETERS

OBSOLETE

SIZE	1/2"	ISSUE 6-25-31	A.E.	TITLE: DIATHERMY DISC HOLDER - 2" & 3"		
KIND	BRASS ROD	CHANGED				
SHAPE		" "				
FINISH		" "				
TEMP.		" "		H. G. FISCHER & CO. 2335 WABANSIA AVE. CHICAGO, ILL.	CAT. NO.	PART NO. 3005
PATT.		" "				

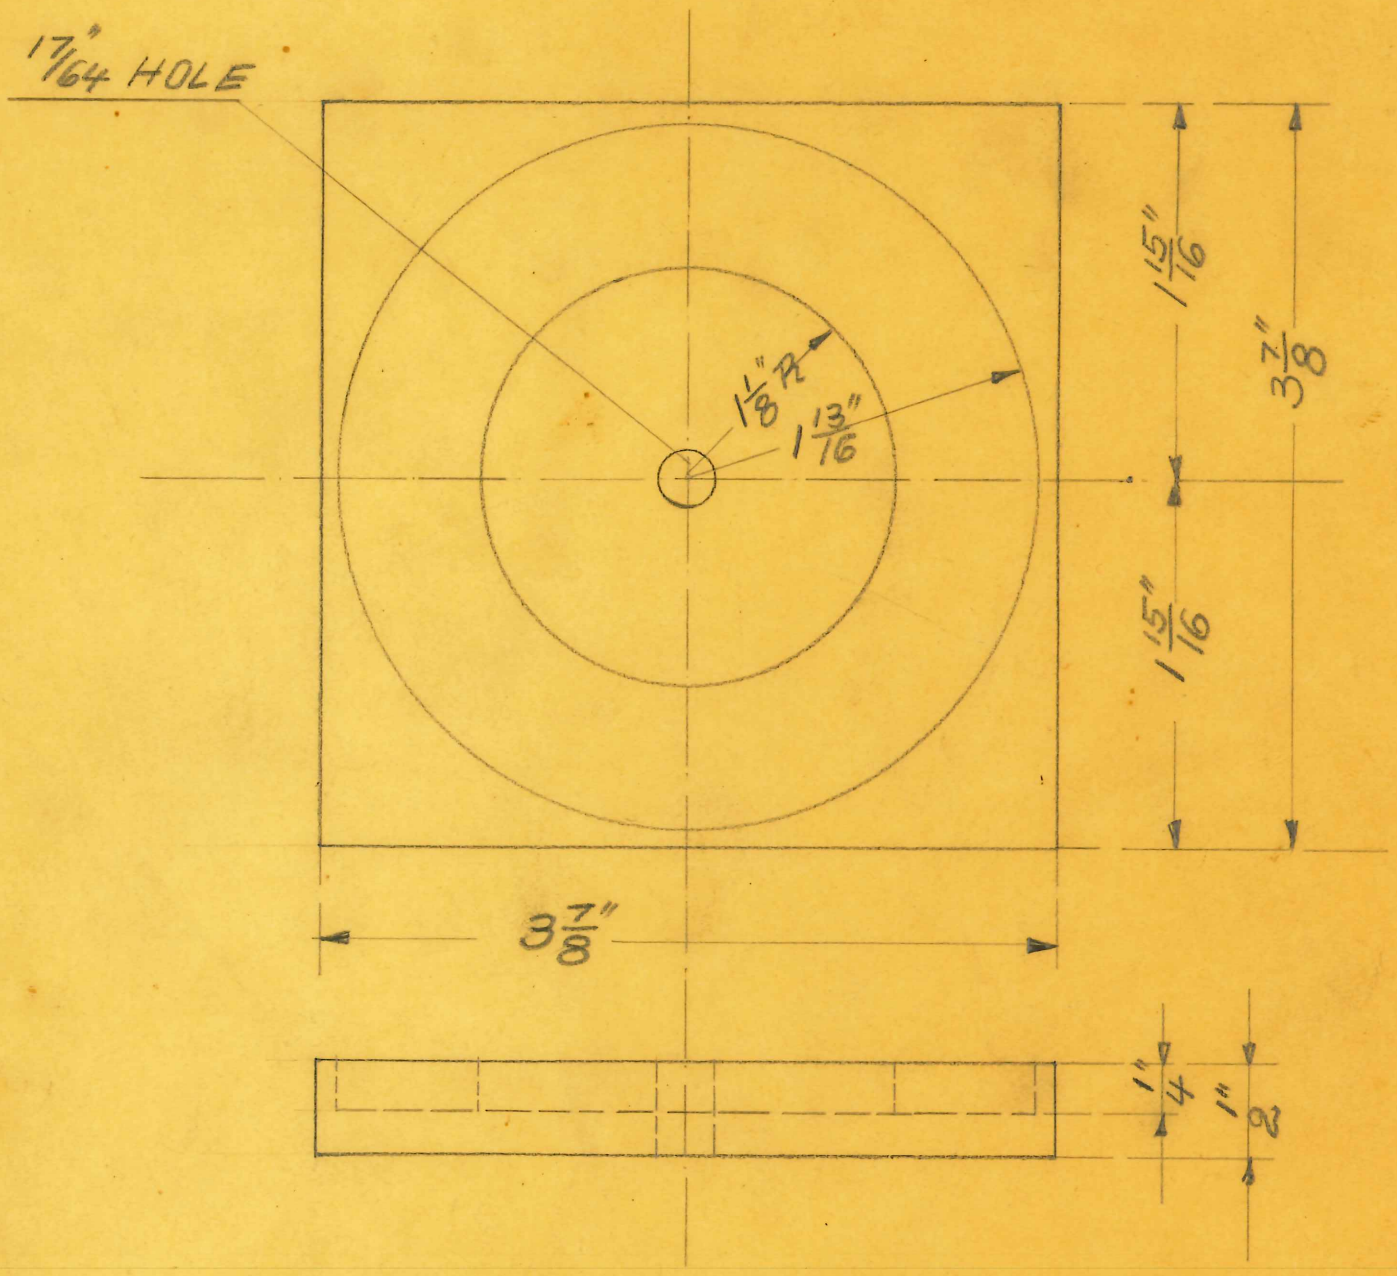

OBSOLETE

SIZE		ISSUE	
KIND	BIRCH-W.	CHANGED	
SHAPE		" "	
FINISH		" "	
TEMP.		" "	
PATT.		" "	

TITLE: PORT. DIATH. TESLA ENDBL. G'

H. G. FISCHER & CO.
2335 WABANSIA AVE.
CHICAGO, ILL.

CAT. NO.

PART NO. 3368

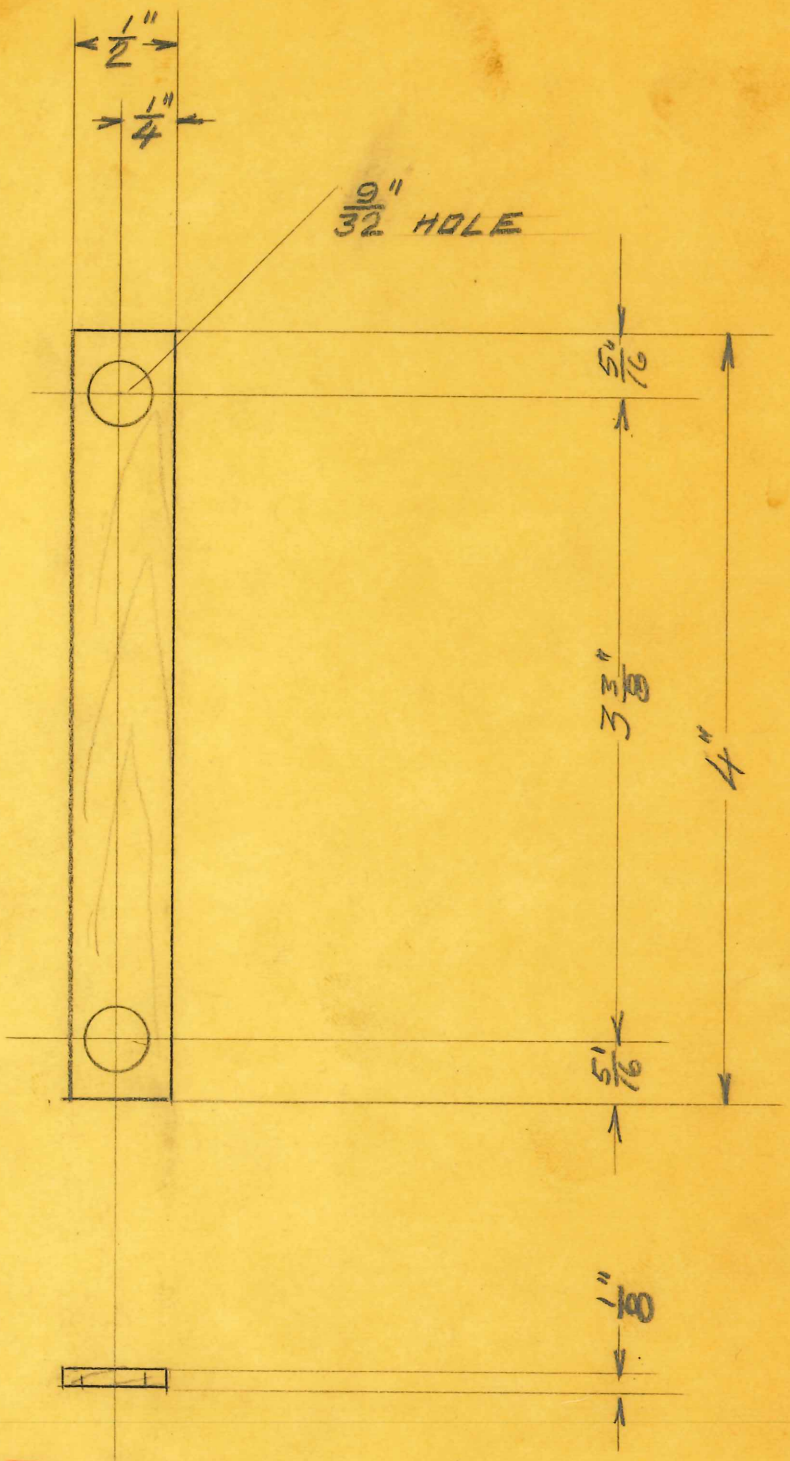

OBSOLETE

(4)

SIZE		ISSUE 6-16-26	C.
KIND	H. WOOD	CHANGED	
SHAPE		" "	
FINISH		" "	
TEMP.		" "	
PATT.		" "	

TITLE: END WOOD SEPARATORS - LIGHT TYPE "G" PORT. DIA.

H. G. FISCHER & CO.
2335 WABANSIA AVE.
CHICAGO, ILL.

CAT. NO.

PART NO. 3352F

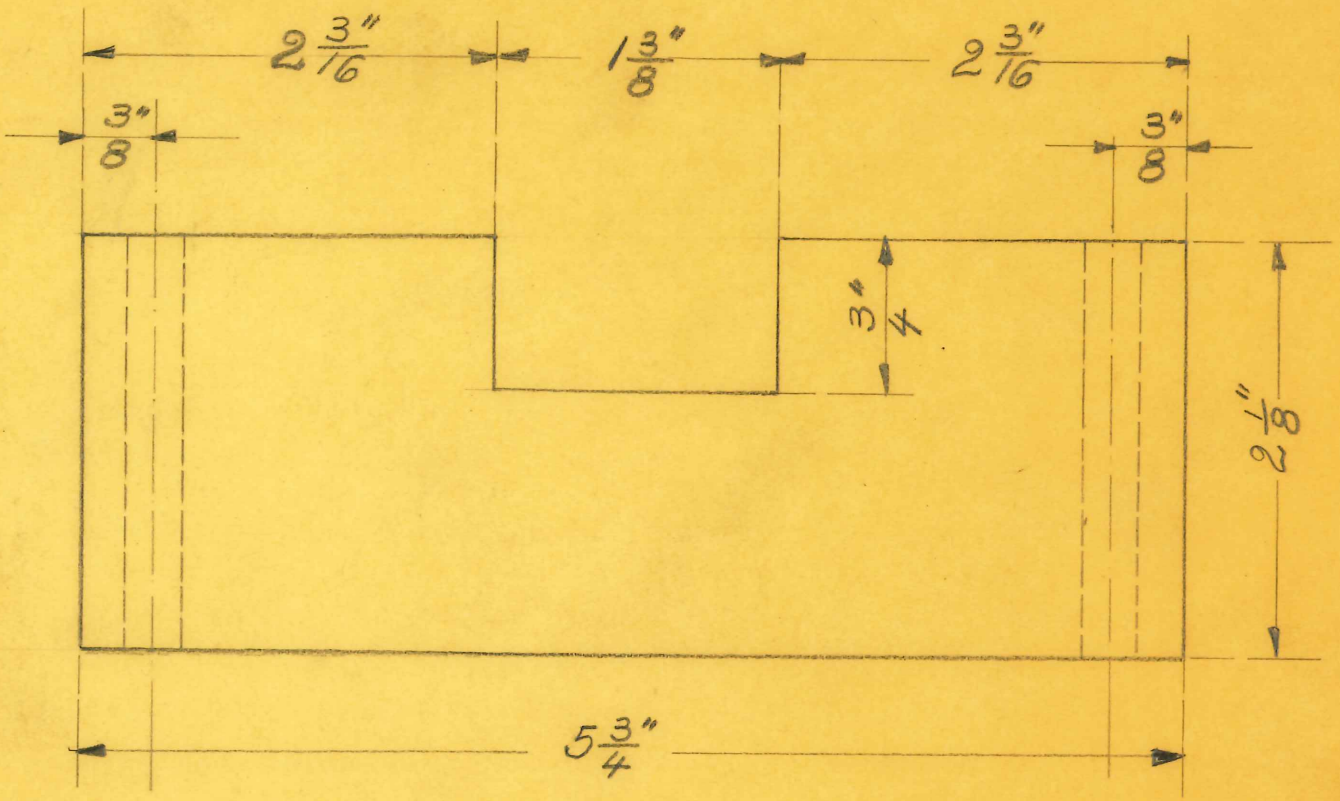

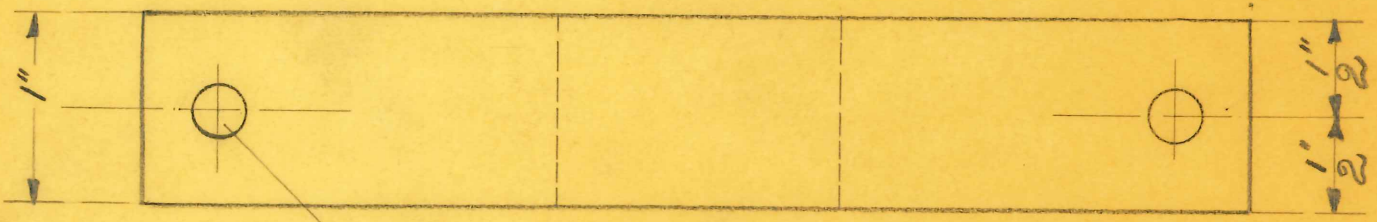

2 HOLES 5/16"

OBSOLETE

(2)

SIZE		ISSUE	
KIND	BIRCH-W.	CHANGED	
SHAPE		" "	
FINISH		" "	
TEMP.		" "	
PATT.		" "	

TITLE: TRANSF. SUPPORT "G"

H. G. FISCHER & CO.
2335 WABANSIA AVE.
CHICAGO, ILL.

CAT. NO.

PART NO. 3357 F

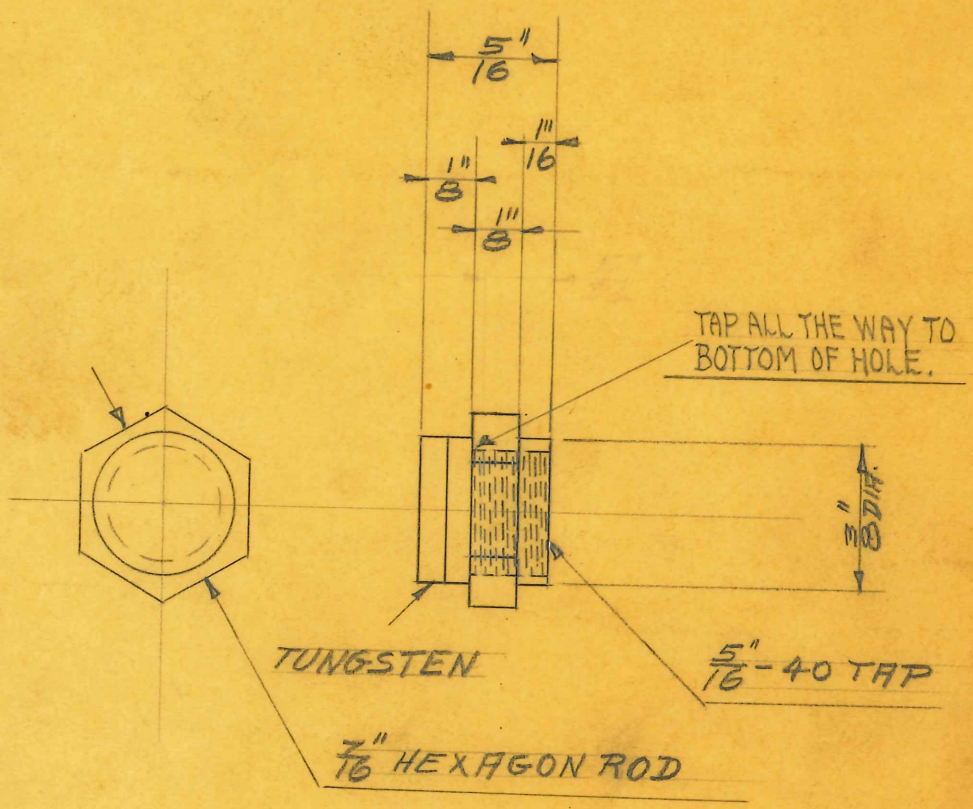

NOTE:

DRAWN DOUBLE SCALE

OBSOLETE

SIZE		ISSUE 11-26-26 CP	TITLE: TYPE "G" (FEMALE) TUNGSTEN TIP BODY
KIND		CHANGED	
SHAPE		" "	
FINISH		" "	
TEMP.		" "	
PATT.		" "	

H. G. FISCHER & CO.
2335 WABANSIA AVE.
CHICAGO, ILL.

CAT. NO.

PART NO. 1313 G. F.

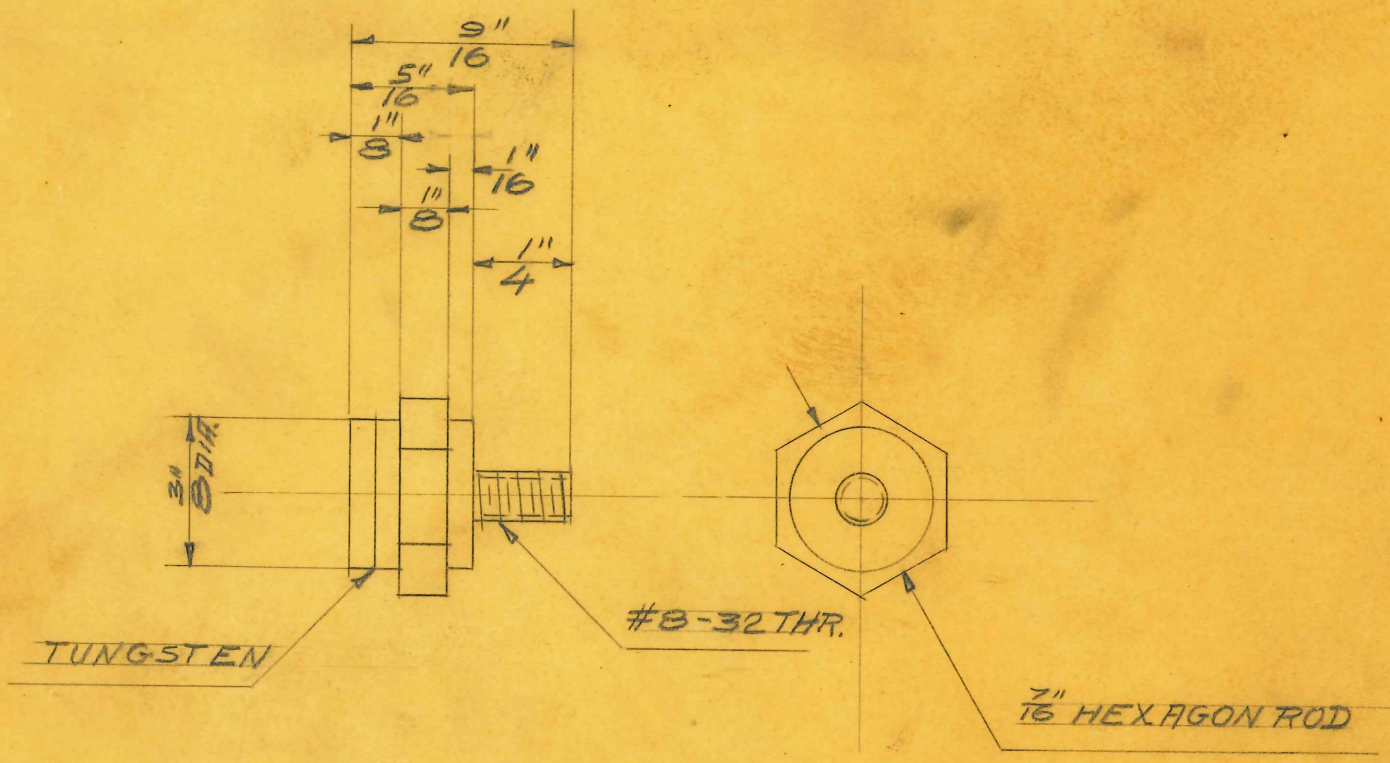

OBSOLETE

NOTE
DRAWN DOUBLE SCALE.

SIZE		ISSUE 11-29-26	CP
KIND		CHANGED	
SHAPE		" "	
FINISH		" "	
TEMP.		" "	
PATT.		" "	

TITLE:
TYPE "G" (MALE)
TUNGSTEN-TIP BODY

H. G. FISCHER & CO.
2335 WABANSIA AVE.
CHICAGO, ILL.

CAT. NO.

PART NO. K309 G.A.

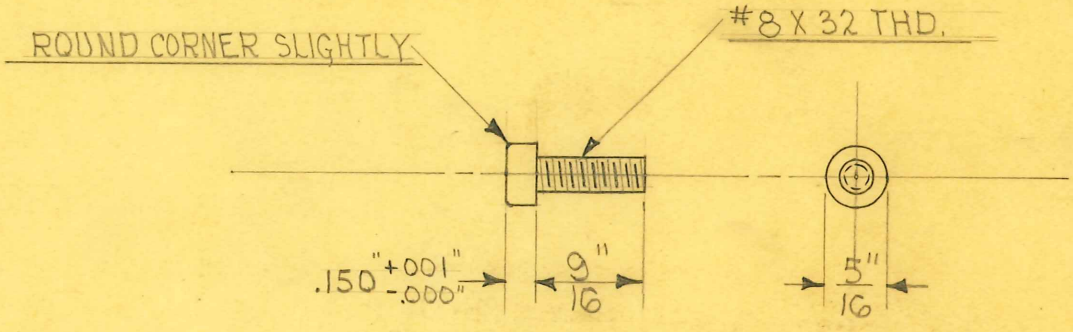

OBSOLETE

SIZE	5/16" DIAM.	ISSUE 3-17-36	A.E.
MAND	BRASS ROD	CHANGED	
SHAPE		"	
FINISH	NICKEL #12	"	
SHIP.		"	
WT.		"	

TITLE: PORTABLE DIATHERMY CONTACT POINTS

H. G. FISCHER & CO.
2335 WABANSIA AVE.
CHICAGO, ILL.

CAT. NO.

PART NO. E322 1/2

OBSOLETE

SIZE		ISSUE 6-16-26	E.	TITLE: END WOOD SEPARATORS-HEAVY TYPE "E" PORT. DIA.
KIND	H. WOOD	CHANGED		
SHAPE		" "		
FINISH		" "		
TEMP.		" "		H. G. FISCHER & CO. 2335 WABANSIA AVE. CHICAGO, ILL.
PATT.		" "		CAT. NO.
				PART NO. 3350F.

STEEL SIZES

PC. NO. 5043

$5\frac{3}{8}$" X $1\frac{1}{2}$" BUILT UP TO 2" (PRI. CORE)

$5\frac{3}{8}$" X $1\frac{7}{8}$" BUILT UP TO $1\frac{1}{16}$"

$5\frac{3}{8}$" X $1\frac{1}{2}$" BUILT UP TO $\frac{7}{16}$" } SEC. CORE

$5\frac{3}{8}$" X $1\frac{1}{16}$" BUILT UP TO $\frac{5}{16}$"

END PCS. - $4\frac{13}{16}$" X $1\frac{1}{2}$" & $5\frac{1}{8}$" X $1\frac{1}{2}$"

BIND CORES WITH FRICTION TAPE.

WINDING DATA

PRIMARY

USE #14 COTENAMEL WIRE

4 LAYERS OF 5026 $\frac{1}{4}$ OILED CLOTH ON CORE. ANCHOR LEAD #1 WITH LINEN TAPE AND WIND TO 407 TURNS AND BRING OUT TAP #2. WIND 18 TURNS MORE AND ANCHOR END WITH LINEN TAPE - LEAD #3. TOTAL 425 TURNS. NO DEFINITE NUMBER OF TURNS TO EACH LAYER BUT INSULATE WITH 2 LAYERS OF 5026 $\frac{1}{4}$ BETWEEN EACH LAYER OF WIRE. COVER LAST LAYER OF WIRE WITH 5004 OILED TAPE AND SHELLAC.

SECONDARY

USE #29 ENAMEL WIRE

WIND STRIP OF 5005 OILED PAPER ON BAKELITE TUBE - $2\frac{1}{4}$" I.D. X $2\frac{1}{2}$" O.D. X $1\frac{3}{4}$" LONG. ANCHOR LEAD #4 (SEC. LEADS ARE APPROX. 7" OF 1631) AND WIND 98 LAYERS, 94 TURNS PER LAYER. INSULATE BETWEEN EACH LAYER OF WIRE WITH 1 LAYER OF 5005 OILED PAPER. TOTAL 9212 TURNS. COVER 98 TH LAYER WITH 1 LAYER OF 5005 OILED PAPER AND FINISH WITH 1 LAYER (NO DEFINITE NUMBER OF TURNS) OF #22 ENAMEL WIRE, ANCHORING LEAD #4 WITH LINEN TAPE. END OF #29 E. WIRE CONNECTED TO START OF #22 E. WIRE. SHELLAC LAST LAYER.

SEE DRAWING No. 3343G

OBSOLETE

SIZE		ISSUE 11-18-32	A.E.	TITLE: PORTABLE DIATHERMY TRANSFORMER - 110V. - 25~
KIND		CHANGED		
SHAPE		" "		
FINISH		" "		
TEMP.		" "		H. G. FISCHER & CO. 2335 WABANSIA AVE. CHICAGO, ILL.
PATT.		" "		CAT. NO.

PART NO. 110-25 3343G

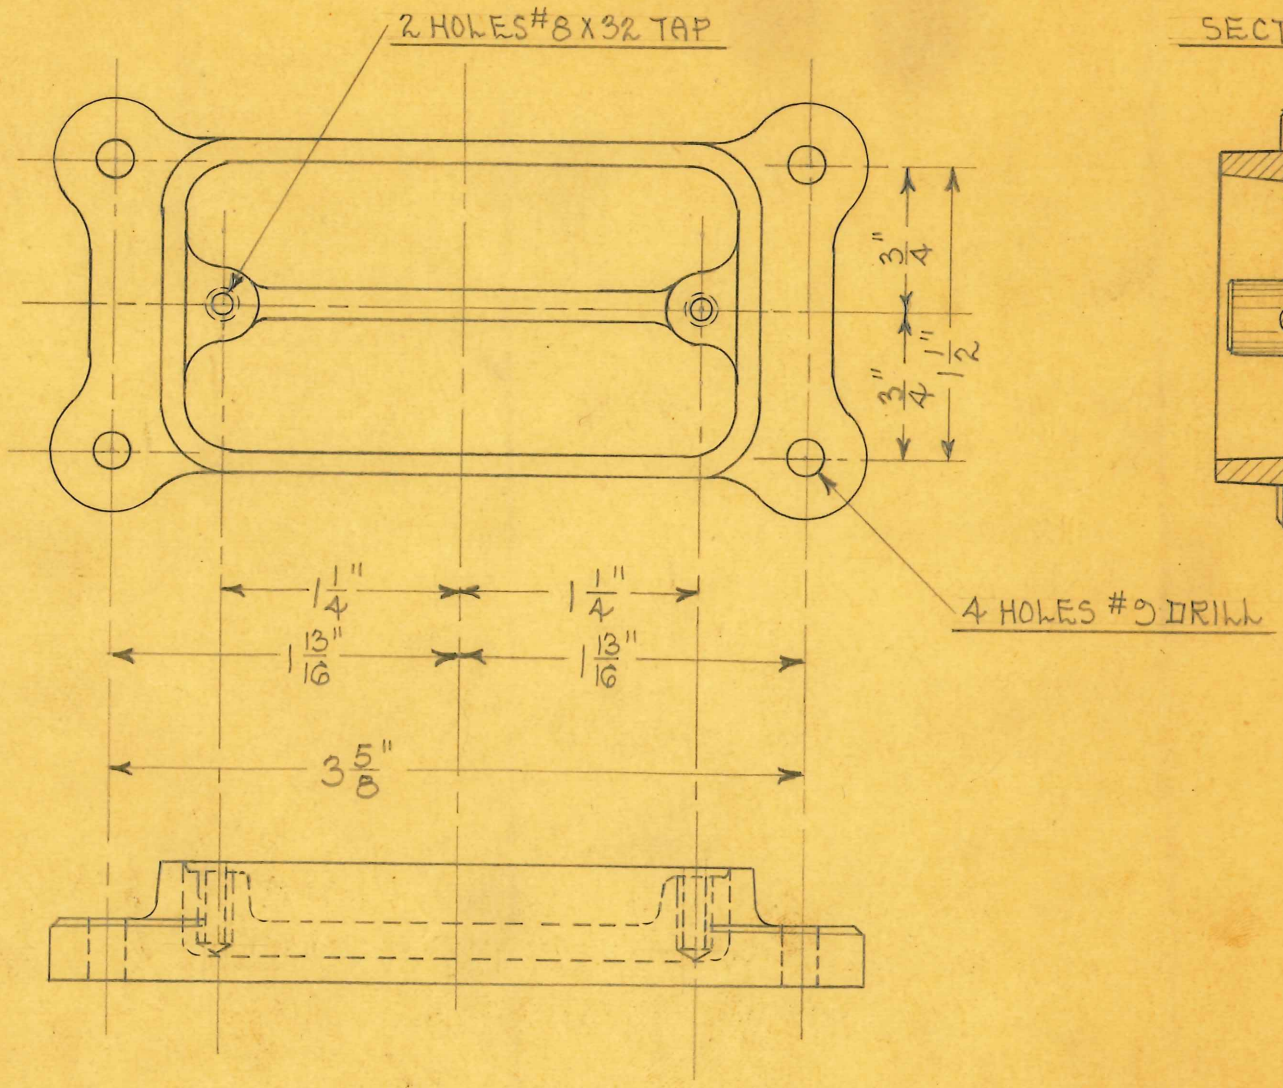

SCALE ~ FULL SIZE

2 REQUIRED

OBSOLETE

SIZE		ISSUE 6-10-31	J.E.	TITLE: COMBINATION "G" CONDENSER BRACKET	
KIND	IRON CAST'G.	CHANGED			
SHAPE		" "			
FINISH	BL. ENAMEL	" "			
TEMP.		" "		H. G. FISCHER & CO. 2335 WABANSIA AVE. CHICAGO, ILL.	CAT. NO.
PATT.		" "			PART NO. 5687F

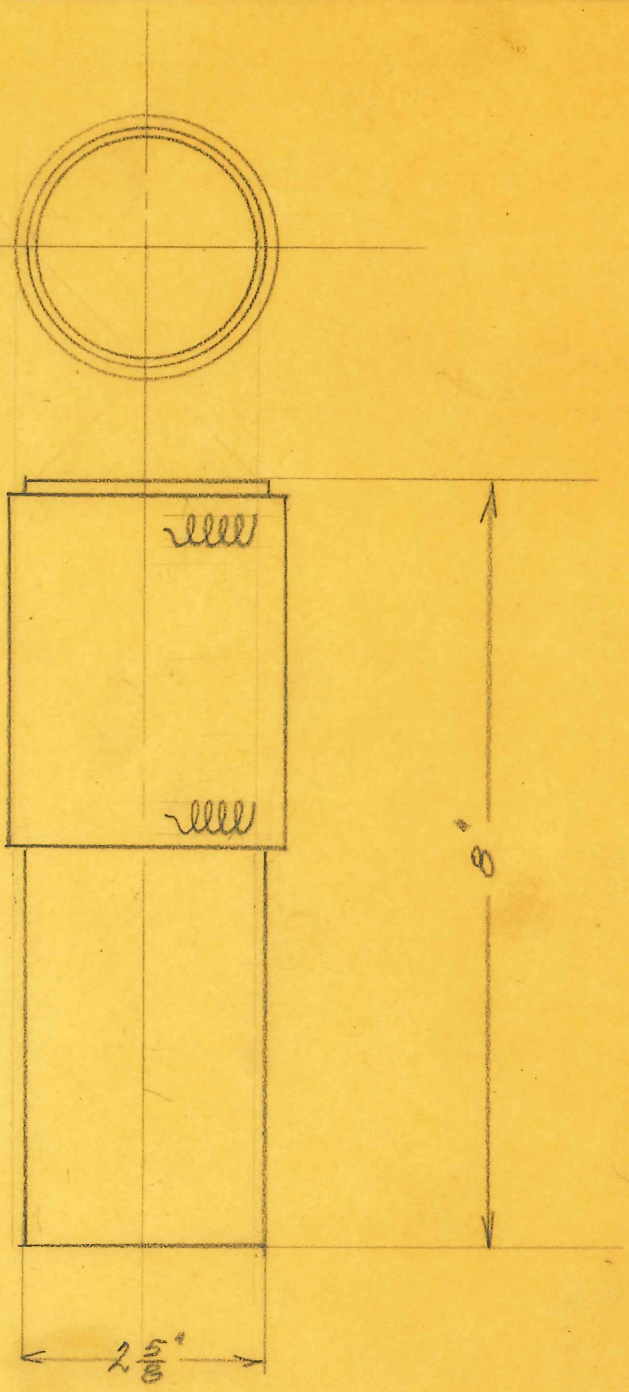

LAYER	TURNS.	WIRE # COTT, E.
1	90.	20.

OBSOLETE

(1)

SIZE		ISSUE Feb 23-26 W.P.	TITLE: DUDIN TESLA SECONDARY PORT. DIATH. TYPE "G"		
KIND		CHANGED			
SHAPE		" "			
FINISH		" "			
TEMP.		" "	H. G. FISCHER & CO. 2335 WABANSIA AVE. CHICAGO, ILL.	CAT. NO.	PART NO. 3366 G
PATT.		" "			

SIZE		ISSUED	
KIND		CHANGED	
SHAPE		" "	
FINISH		" "	
TEMP.		" "	
PAT.		" "	

H. C. FISCHER & CO.
CHICAGO, ILL.

CAT. NO.

PART NO.

TITLE:

OBSOLETE

	PIECES	COPPER	NICK.
CONDENSER	#0		
GROUND	3		
CONDENSER	4		

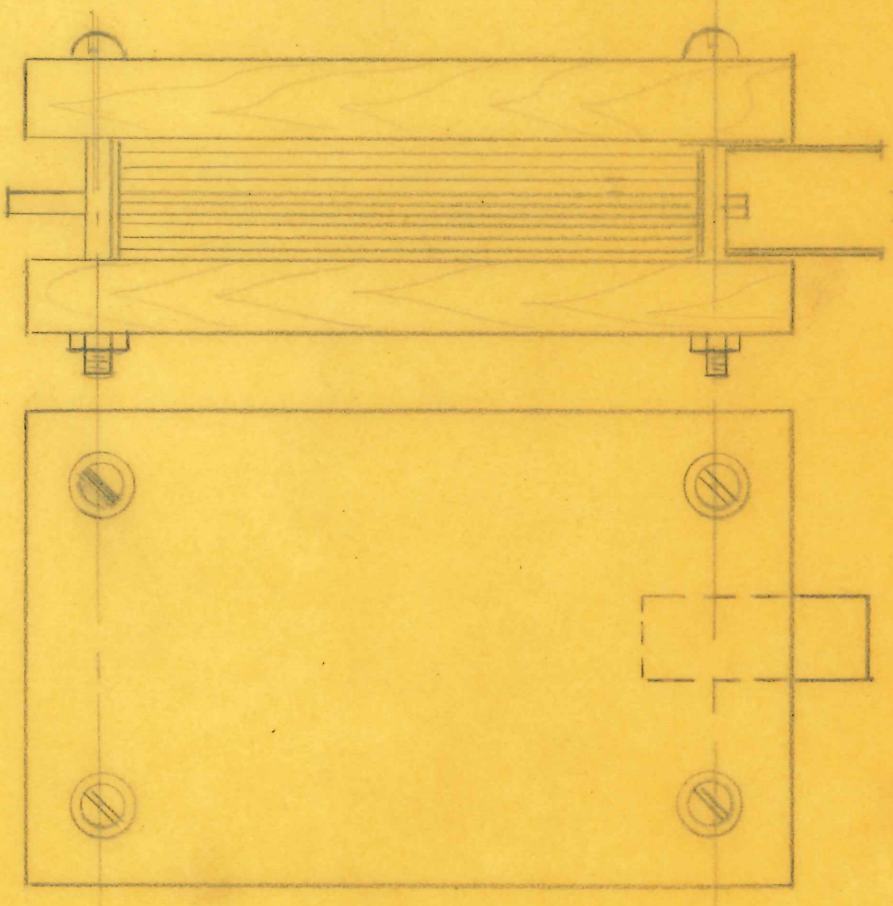

OBSOLETE

(4)

SIZE		ISSUE 6-16-26	
KIND	H. WOOD	CHANGED	
SHAPE		" "	
FINISH		" "	
TEMP.		" "	
PATT.		" "	

TITLE: INSIDE WOOD SEPARATORS TYPE "G" PORT. DIA.

H. G. FISCHER & CO.
2335 WABANSIA AVE.
CHICAGO, ILL.

CAT. NO.

PART NO. 3351F

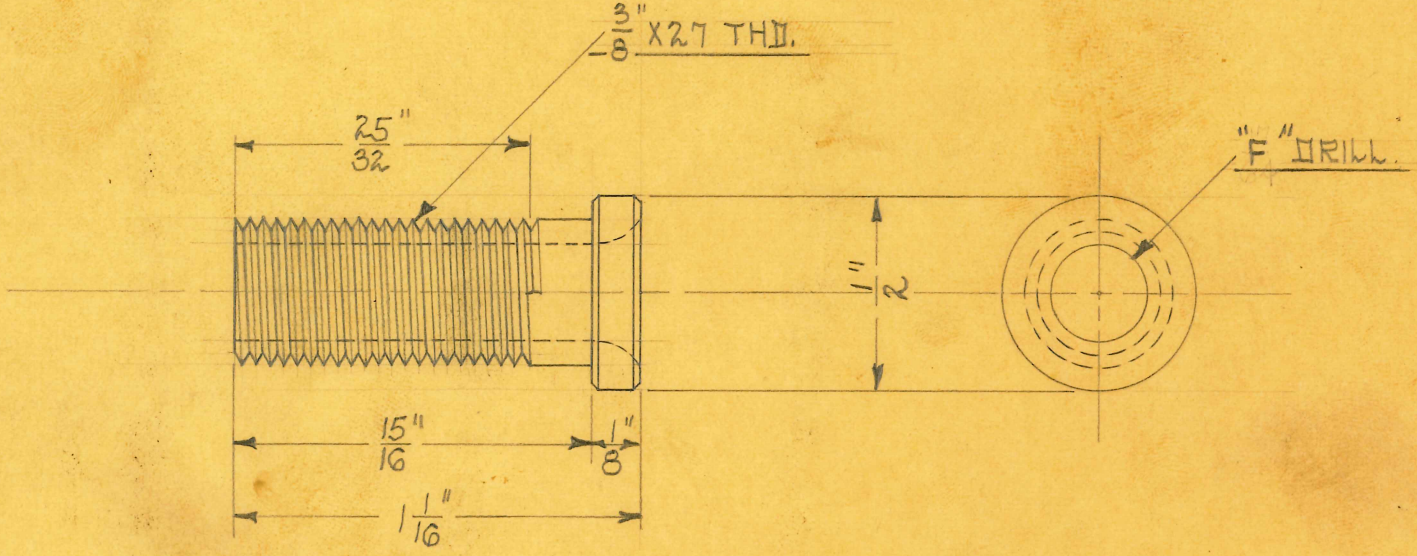

SCALE ~ 2 DIAMETERS
3 REQUIRED

OBSOLETE

SIZE	1/2"	ISSUE 7-27-31	A.E.	TITLE: PORTABLE DIATHERMY METER SOCKET
KIND	BRASS ROD	CHANGED		
SHAPE		" "		
FINISH	W.P	" "		
TEMP.		" "		H. G. FISCHER & CO. 2335 WABANSIA AVE. CHICAGO, ILL. — CAT. NO. — PART NO. 3312
PATT.		" "		

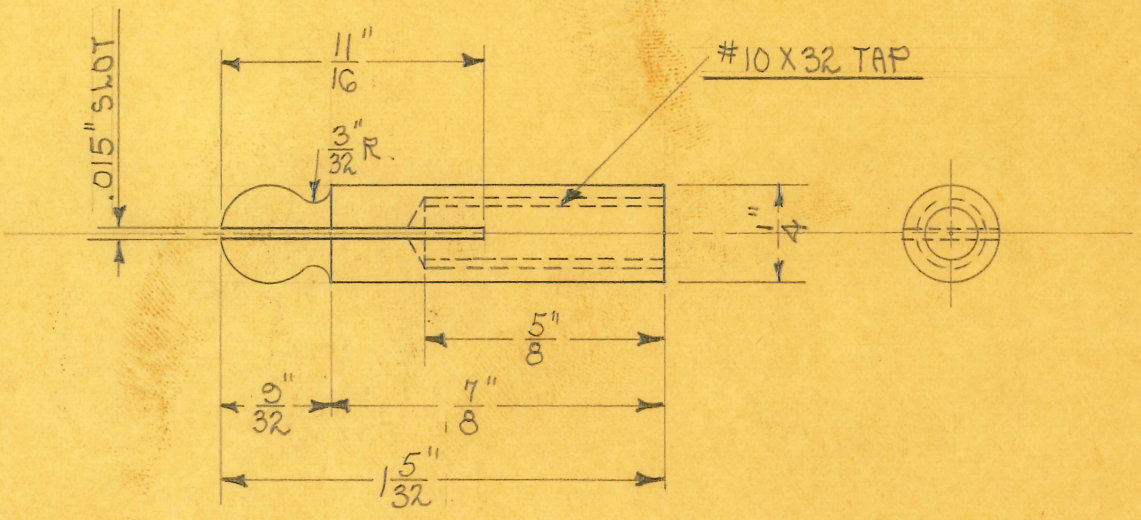

SCALE ~ 2 DIAMETERS

OBSOLETE

SIZE	1/4"	ISSUE 9-3-31	29.8.	TITLE: PORTABLE DIATHERMY METER PLUG
KIND	BRASS ROD	CHANGED		
SHAPE		" "		
FINISH	W.P.	" "		
TEMP.		" "		
PATT.		" "		

H. G. FISCHER & CO.
2335 WABANSIA AVE.
CHICAGO, ILL.

CAT. NO.

PART NO. 3313

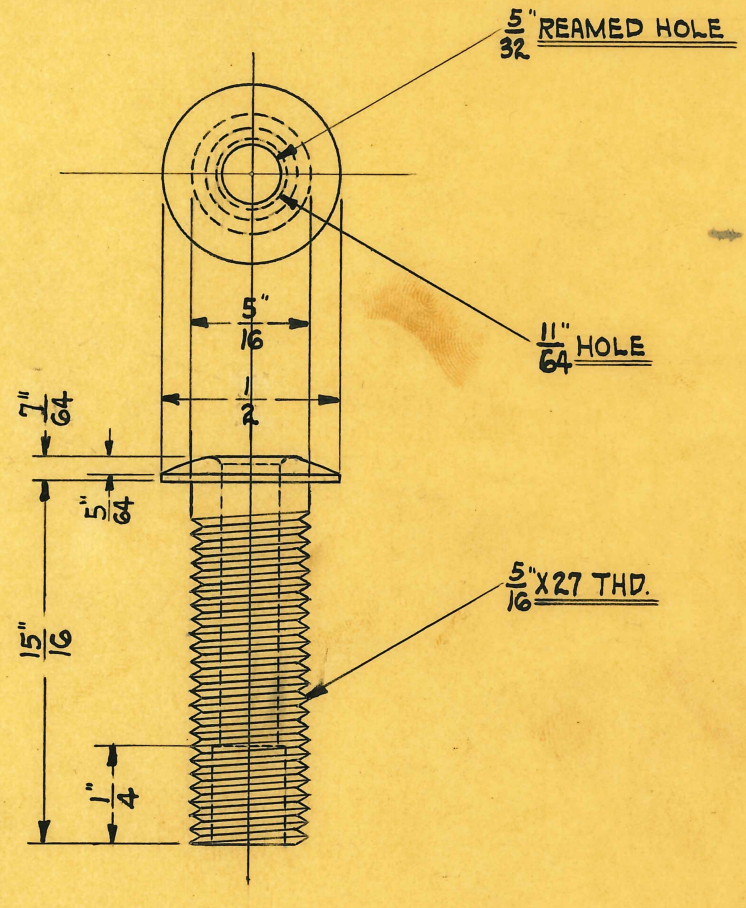

SCALE ~ 2 DIAMETERS

OBSOLETE

Obsolete

SIZE	1/2"	ISSUE H.E.	3-12-30	TITLE: PORTABLE DIATHERMY CONNECTING CORD SOCKET
KIND	BRASS ROD	CHANGED		
SHAPE	ROUND	" "		
FINISH	N.P.	" "		
TEMP.		" "		H. G. FISCHER & CO. 2335 WABANSIA AVE. CHICAGO, ILL. / CAT. NO. / PART NO. 3315
PATT.		" "		

NOTE:

5/32" REAMED HOLE - AFTER PLATING

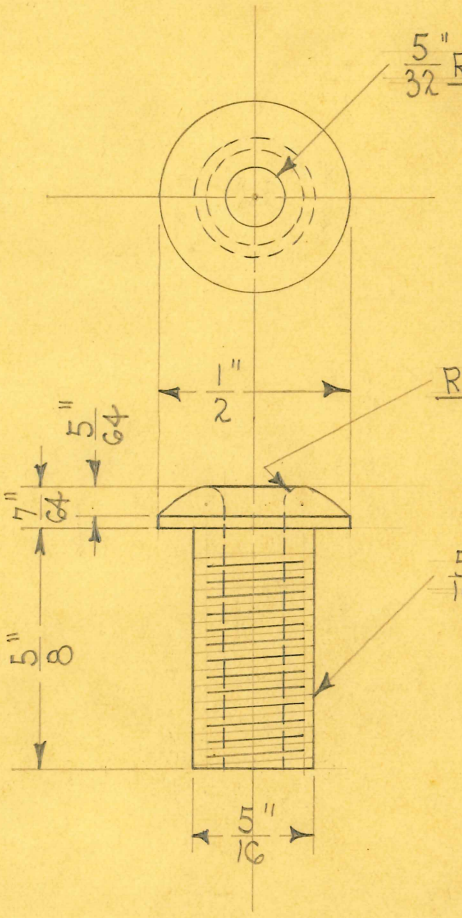

SCALE ~ 2 DIAMETERS

OBSOLETE

OBSOLETE
SEE Bulletin #606
6/24/68 BZZ

SIZE	1/2"	ISSUE 6-13-35	A.E.
KIND	BRASS ROD	CHANGED	
SHAPE		"	
FINISH	CAD. #23	"	
TEMP.		"	
PATT.		"	

TITLE: PORTABLE DIATHERMY CONNECTING CORD SOCKET

H. G. FISCHER & CO.
2335 WABANSIA AVE.
CHICAGO, ILL.

CAT. NO.

PART NO. 3315A

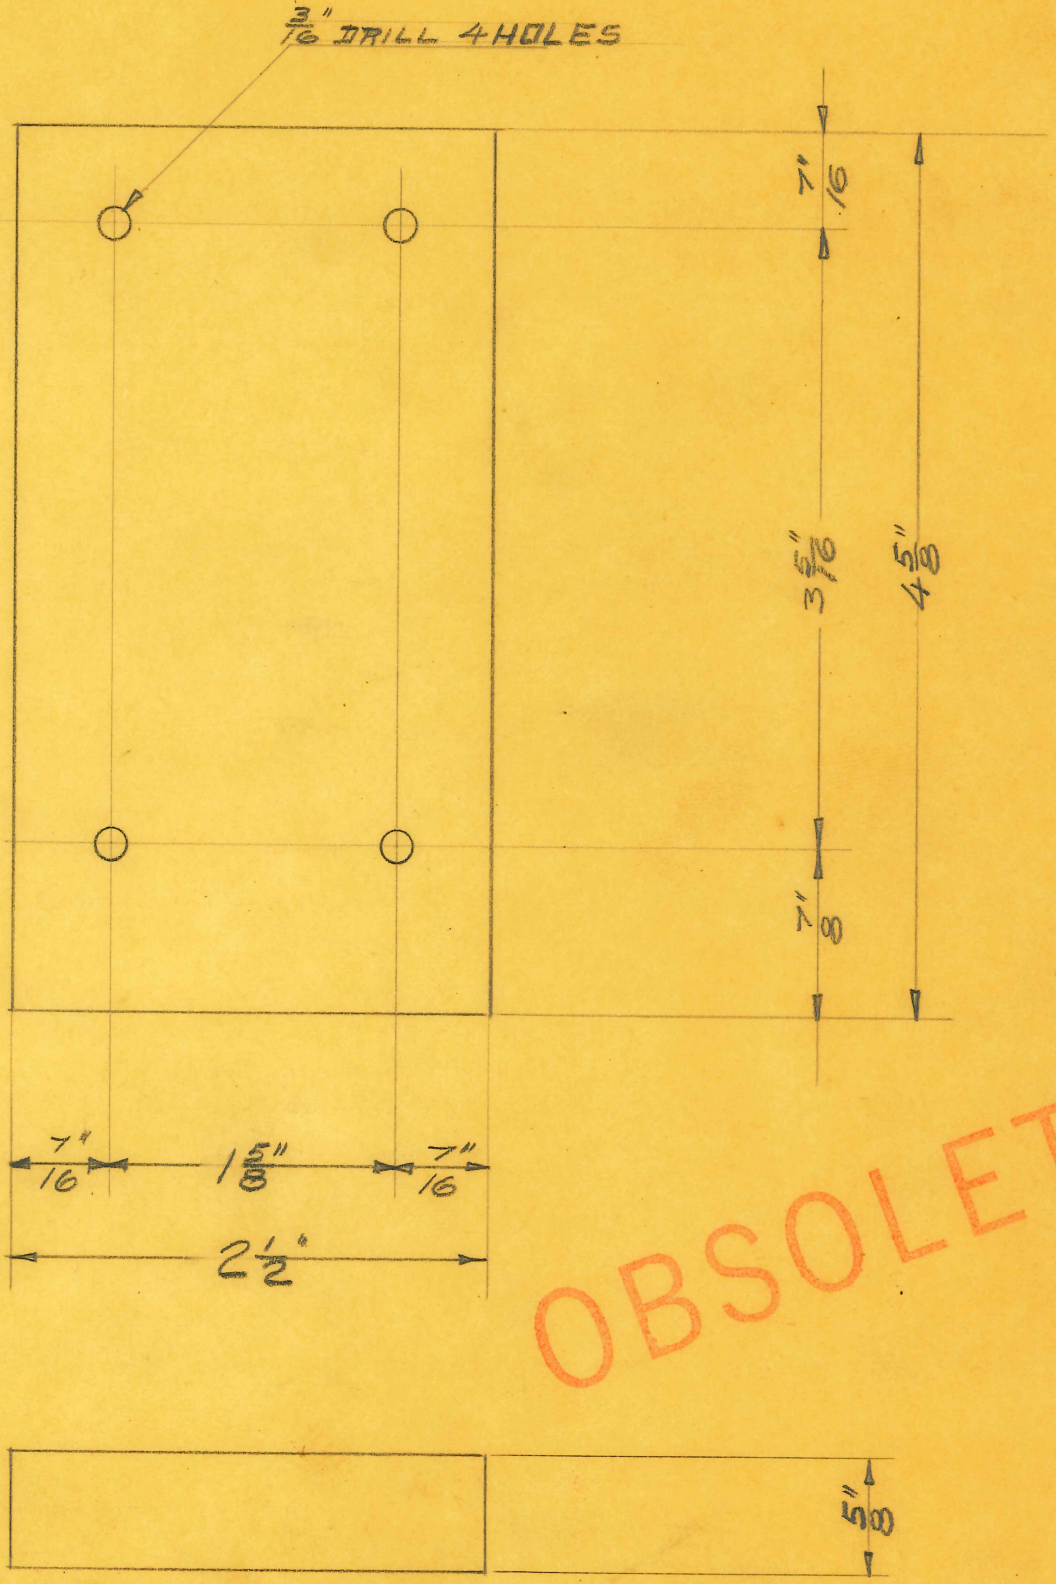

OBSOLETE

2.

SIZE		ISSUE 11-5-26	E.P.
KIND	WOOD	CHANGED	
SHAPE		" "	
FINISH		" "	
TEMP.		" "	
PATT.		" "	

TITLE: PORTABLE DIATHERMY CONDENSER BLOCK

H. G. FISCHER & CO.
2335 WABANSIA AVE.
CHICAGO, ILL.

CAT. NO.

PART NO. 3333F

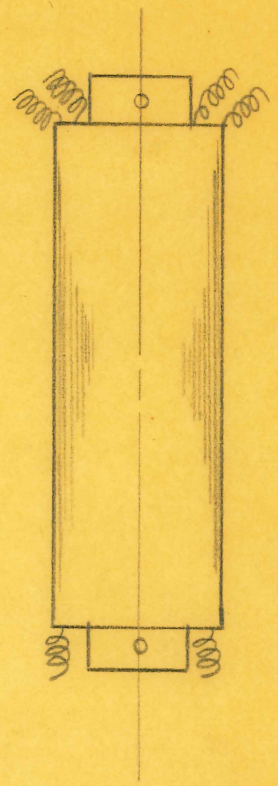

CORE PIECES 5¼"x1" - 6¼"x1"			
BUILD UP TO 1"			
LAYER	TURNS	WIRE # CATT. E.	TAP
			1
2		14	1
2		16	1
2		18	1
3		20	1
3		20	1

OBSOLETE

SIZE		ISSUE 2-2-27	R.J.L.
KIND		CHANGED	
SHAPE		" "	
FINISH		" "	
TEMP.		" "	
PATT.		" "	

TITLE: LINE CHOKE FOR 110V.-60 CYCLES PORT.-DIATHERM TYPE "G"

H. G. FISCHER & CO.
2335 WABANSIA AVE.
CHICAGO, ILL.

CAT. NO.

PART NO. 3340 G.

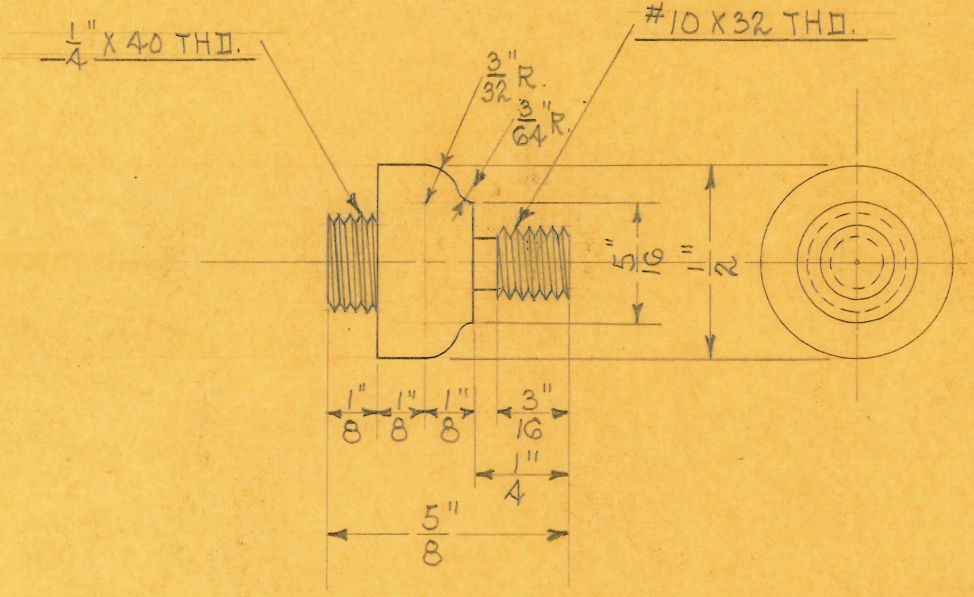

SCALE ~ 2 DIAMETERS

OBSOLETE

SIZE	1/2"	ISSUE 6-25-31	A.E.	TITLE: DIATHERMY DISC HOLDER - 2" & 3"		
KIND	BRASS ROD	CHANGED				
SHAPE		" "				
FINISH		" "				
TEMP.		" "		H. G. FISCHER & CO. 2335 WABANSIA AVE. CHICAGO, ILL.	CAT. NO.	PART NO. 3005
PATT.		" "				

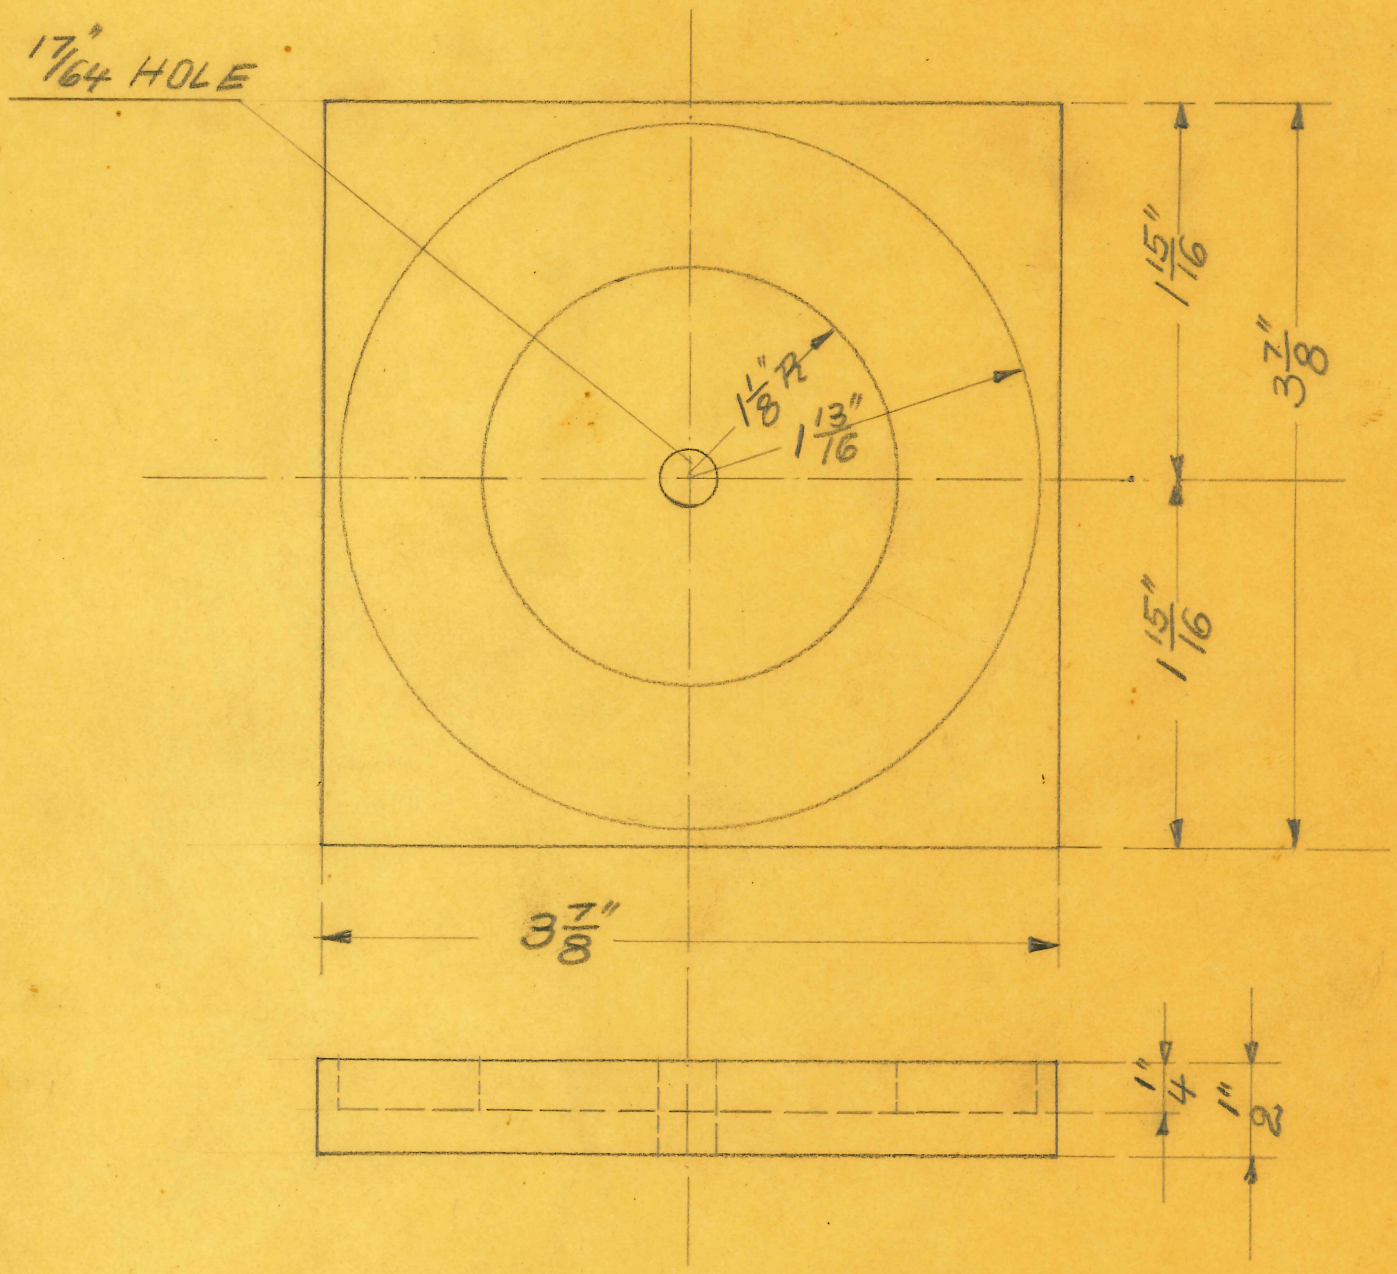

OBSOLETE

SIZE		ISSUE	
KIND	BIRCH-W.	CHANGED	
SHAPE		" "	
FINISH		" "	
TEMP.		" "	
PATT.		" "	

TITLE: PORT. DIATH. TESLA END BL. G'

H. G. FISCHER & CO.
2335 WABANSIA AVE.
CHICAGO, ILL.

CAT. NO.

PART NO. 3368

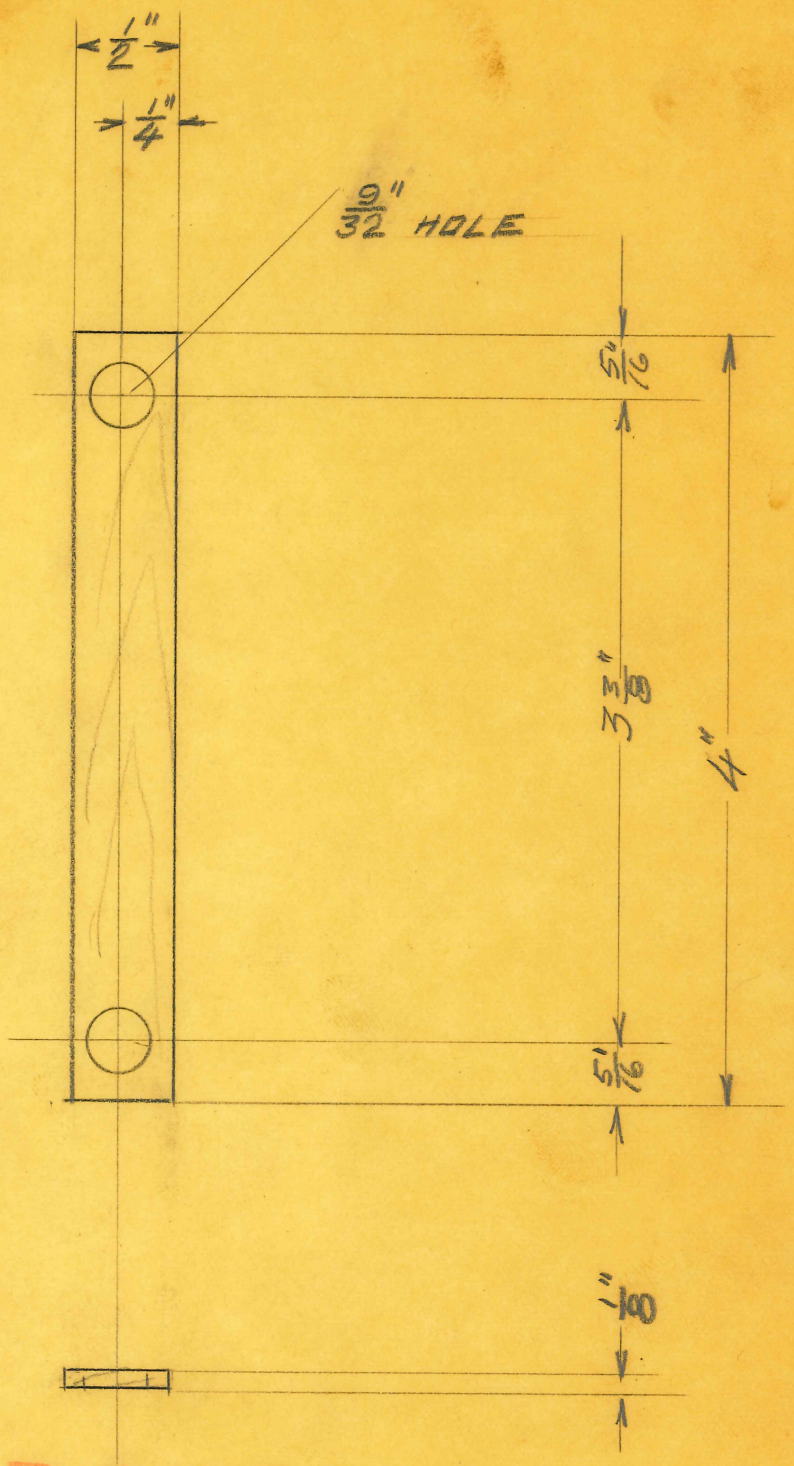

OBSOLETE

(4)

SIZE		ISSUE 6-16-26	C.
KIND	H. WOOD	CHANGED	
SHAPE		" "	
FINISH		" "	
TEMP.		" "	
PATT.		" "	

TITLE: END WOOD SEPARATORS - LIGHT TYPE "G" PART. DIA.

H. G. FISCHER & CO.
2335 WABANSIA AVE.
CHICAGO, ILL.

CAT. NO.

PART NO. 3352F

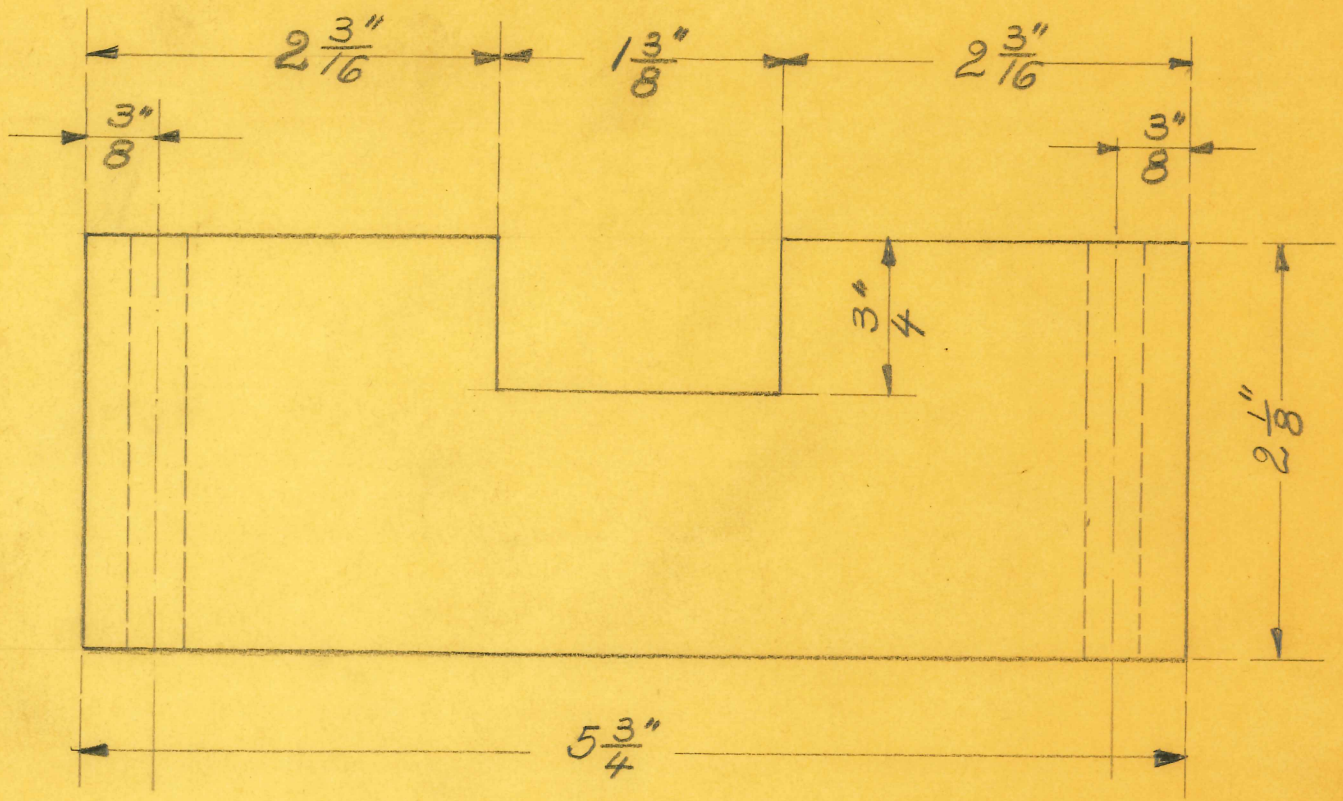

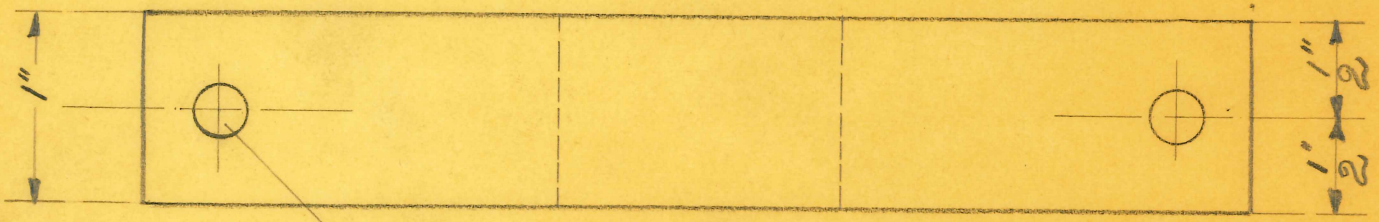

2 HOLES 5/16"

OBSOLETE

(2)

SIZE		ISSUE	
KIND	BIRCH-W.	CHANGED	
SHAPE		" "	
FINISH		" "	
TEMP.		" "	
PATT.		" "	

TITLE: TRANSF. SUPPORT "G"

H. G. FISCHER & CO.
2335 WABANSIA AVE.
CHICAGO, ILL.

CAT. NO.

PART NO. 3357 F

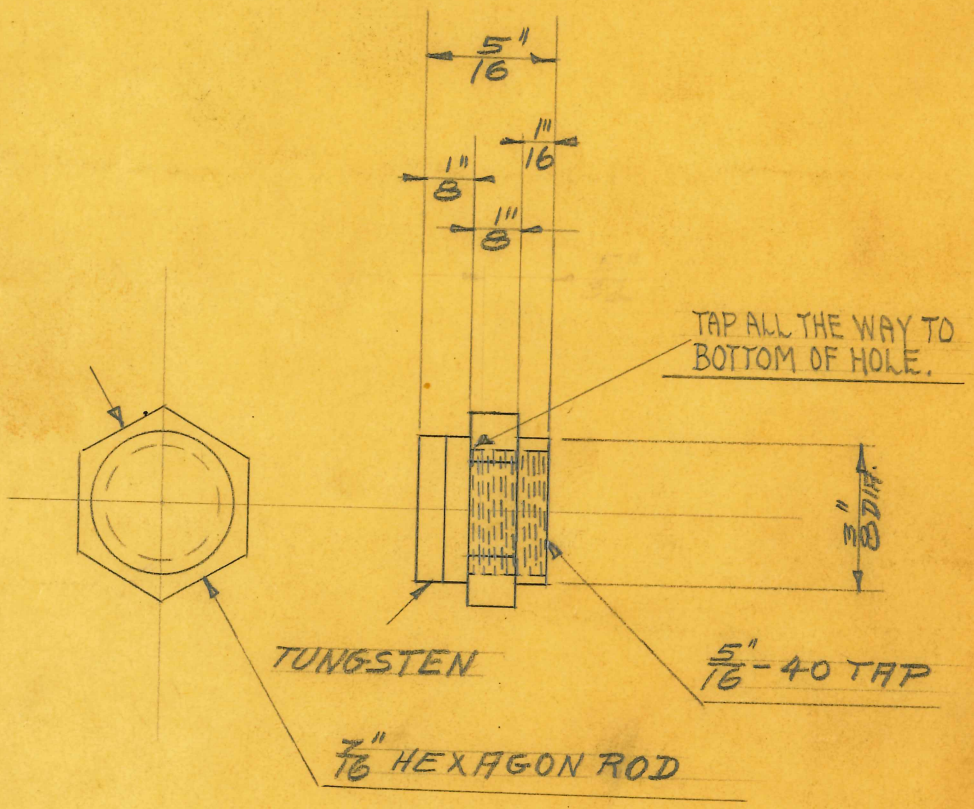

NOTE:
DRAWN DOUBLE SCALE

OBSOLETE

SIZE		ISSUE 11-26-26	
KIND		CHANGED	
SHAPE		" "	
FINISH		" "	
TEMP.		" "	
PATT.		" "	

TITLE:
TYPE "G" (FEMALE)
TUNGSTEN TIP BODY

H. G. FISCHER & CO.
2335 WABANSIA AVE.
CHICAGO, ILL.

CAT. NO.

PART NO. K313G.F.

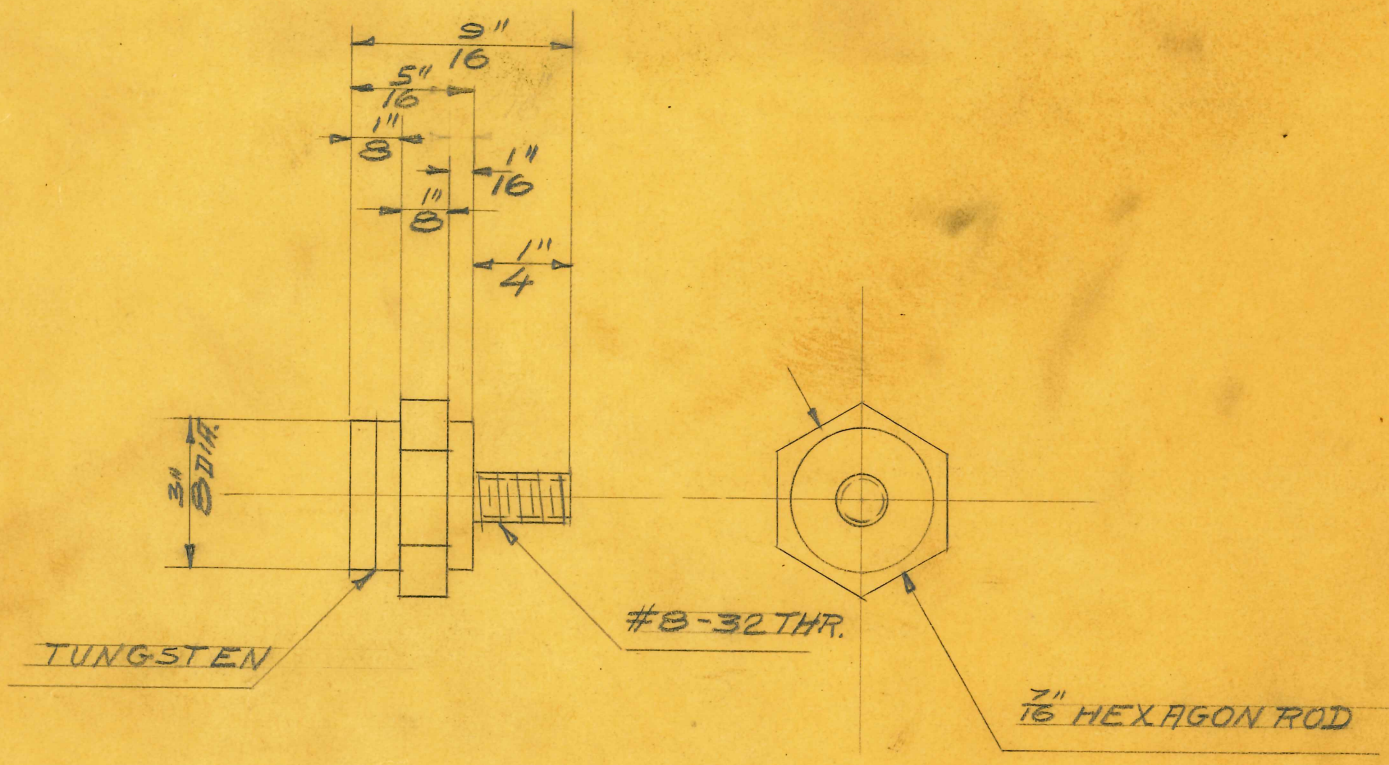

OBSOLETE

NOTE
DRAWN DOUBLE SCALE.

SIZE		ISSUE 11-29-26	WP	TITLE: TYPE "G" (MALE) TUNGSTEN-TIP BODY		
KIND		CHANGED				
SHAPE		" "				
FINISH		" "				
TEMP.		" "		H. G. FISCHER & CO. 2335 WABANSIA AVE. CHICAGO, ILL.	CAT. NO.	PART NO. K309G.A.
PATT.		" "				

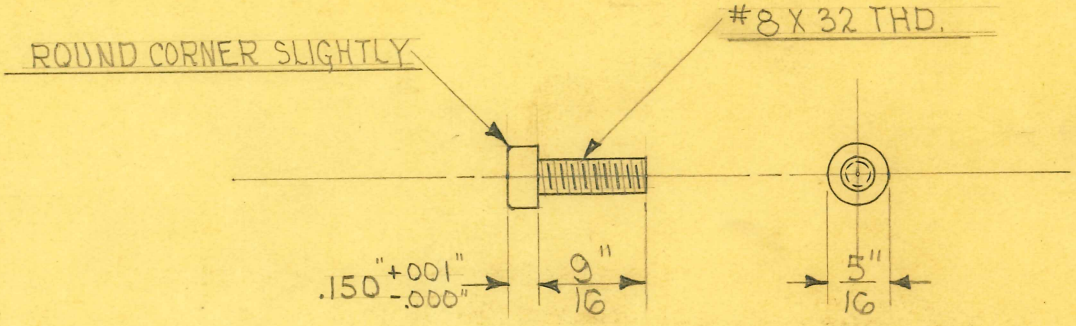

OBSOLETE

ZE	5/16" DIAM.	ISSUE 3-17-36	A.E.
ND	BRASS ROD	CHANGED	
APE		"	
ISH	NICKEL #12	"	
IP.		"	
T.		"	

TITLE: PORTABLE DIATHERMY CONTACT POINTS

H. G. FISCHER & CO.
2335 WABANSIA AVE.
CHICAGO, ILL.

CAT. NO.

PART NO. E322 1/2

OBSOLETE

(4)

SIZE		ISSUE 6-16-26	(2)	TITLE: END WOOD SEPARATORS-HEAVY TYPE "G" PORT. DIA.	
KIND	H. WOOD	CHANGED			
SHAPE		" "			
FINISH		" "			
TEMP.		" "		H. G. FISCHER & CO. 2335 WABANSIA AVE. CHICAGO, ILL.	CAT. NO.
PATT.		" "			PART NO. 3350F.

STEEL SIZES

PC. NO. 5043

$5\frac{3}{8}$" X $1\frac{1}{2}$" BUILT UP TO 2" (PRI. CORE)

$5\frac{3}{8}$" X $1\frac{7}{8}$" BUILT UP TO $1\frac{1}{16}$"

$5\frac{3}{8}$" X $1\frac{1}{2}$" BUILT UP TO $\frac{7}{16}$" } SEC. CORE

$5\frac{3}{8}$" X $1\frac{1}{16}$" BUILT UP TO $\frac{5}{16}$"

END PCS. - $4\frac{13}{16}$" X $1\frac{1}{2}$" & $5\frac{1}{8}$" X $1\frac{1}{2}$"

BIND CORES WITH FRICTION TAPE.

WINDING DATA

PRIMARY

USE #14 COTENAMEL WIRE

4 LAYERS OF 5026 $\frac{1}{4}$ OILED CLOTH ON CORE. ANCHOR LEAD #1 WITH LINEN TAPE AND WIND TO 407 TURNS AND BRING OUT TAP #2. WIND 18 TURNS MORE AND ANCHOR END WITH LINEN TAPE - LEAD #3. TOTAL 425 TURNS. NO DEFINITE NUMBER OF TURNS TO EACH LAYER BUT INSULATE WITH 2 LAYERS OF 5026 $\frac{1}{4}$ BETWEEN EACH LAYER OF WIRE. COVER LAST LAYER OF WIRE WITH 5004 OILED TAPE AND SHELLAC.

SECONDARY

USE #29 ENAMEL WIRE

WIND STRIP OF 5005 OILED PAPER ON BAKELITE TUBE - $2\frac{1}{4}$" I.D. X $2\frac{1}{2}$" O.D. X $1\frac{3}{4}$" LONG. ANCHOR LEAD #4 (SEC. LEADS ARE APPROX. 7" OF 1631) AND WIND 98 LAYERS, 94 TURNS PER LAYER. INSULATE BETWEEN EACH LAYER OF WIRE WITH 1 LAYER OF 5005 OILED PAPER. TOTAL 9212 TURNS. COVER 98 TH LAYER WITH 1 LAYER OF 5005 OILED PAPER AND FINISH WITH 1 LAYER (NO DEFINITE NUMBER OF TURNS) OF #22 ENAMEL WIRE, ANCHORING LEAD #4 WITH LINEN TAPE. END OF #29 E. WIRE CONNECTED TO START OF #22 E. WIRE. SHELLAC LAST LAYER.

SEE DRAWING No. 3343G

OBSOLETE

SIZE		ISSUE 11-18-32	A.E.
KIND		CHANGED	
SHAPE		" "	
FINISH		" "	
TEMP.		" "	
PATT.		" "	

TITLE: PORTABLE DIATHERMY TRANSFORMER - 110V. - 25~

H. G. FISCHER & CO.
2335 WABANSIA AVE.
CHICAGO, ILL.

CAT. NO.

PART NO. 110-25 3343G

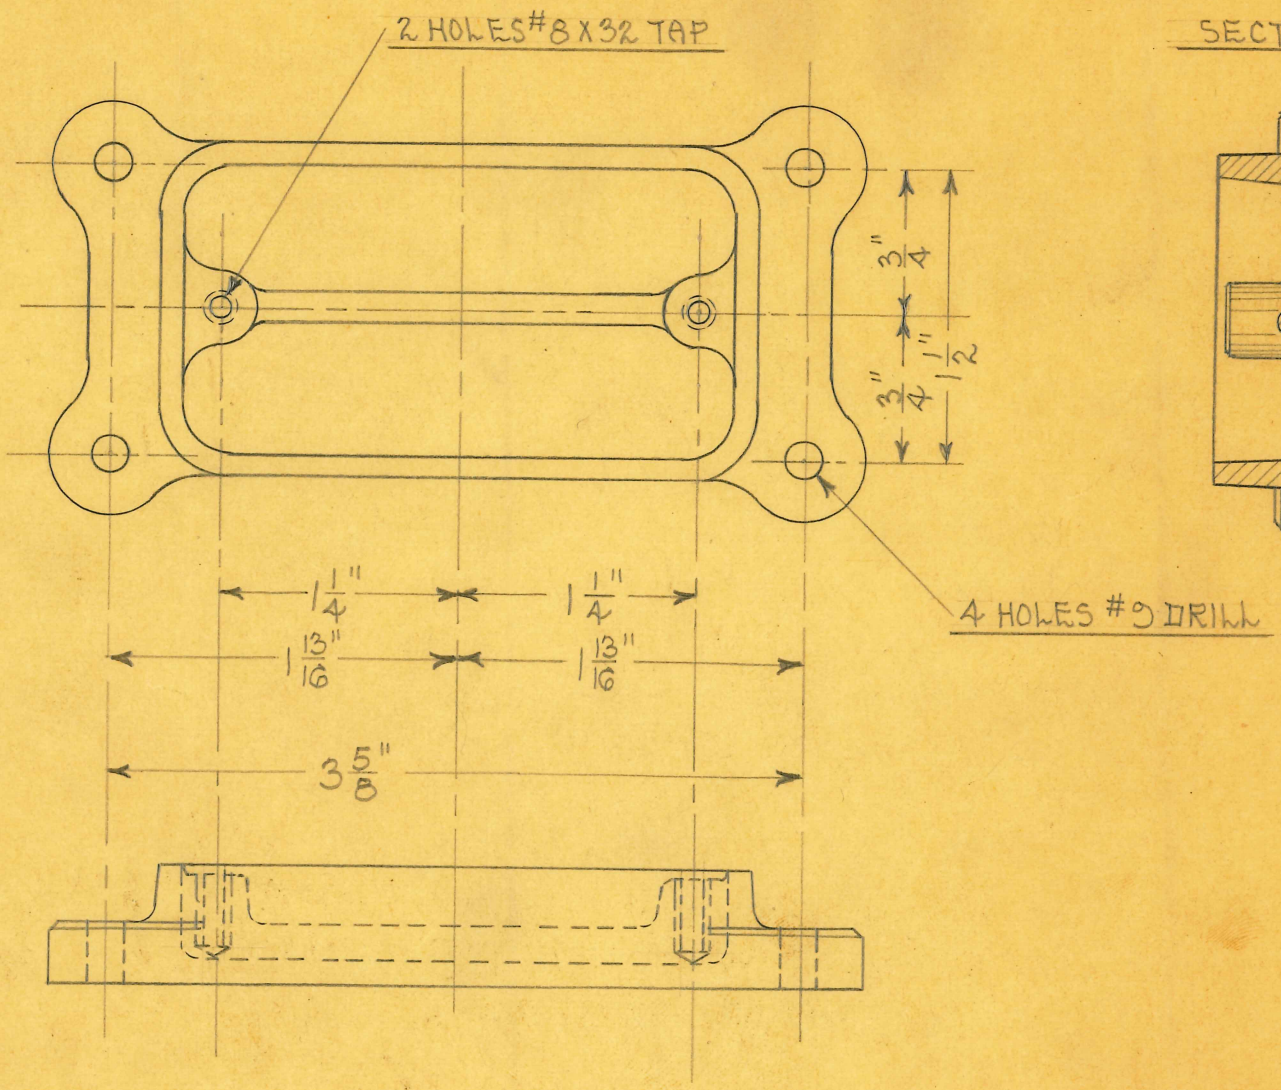

SCALE ~ FULL SIZE

2 REQUIRED

OBSOLETE

SIZE		ISSUE 6-10-31	J.E.	TITLE: COMBINATION "G" CONDENSER BRACKET
KIND	IRON CAST G.	CHANGED		
SHAPE		" "		
FINISH	BL. ENAMEL	" "		
TEMP.		" "		
PATT.		" "		

H. G. FISCHER & CO.
2335 WABANSIA AVE.
CHICAGO, ILL.

CAT. NO.

PART NO. 5687F

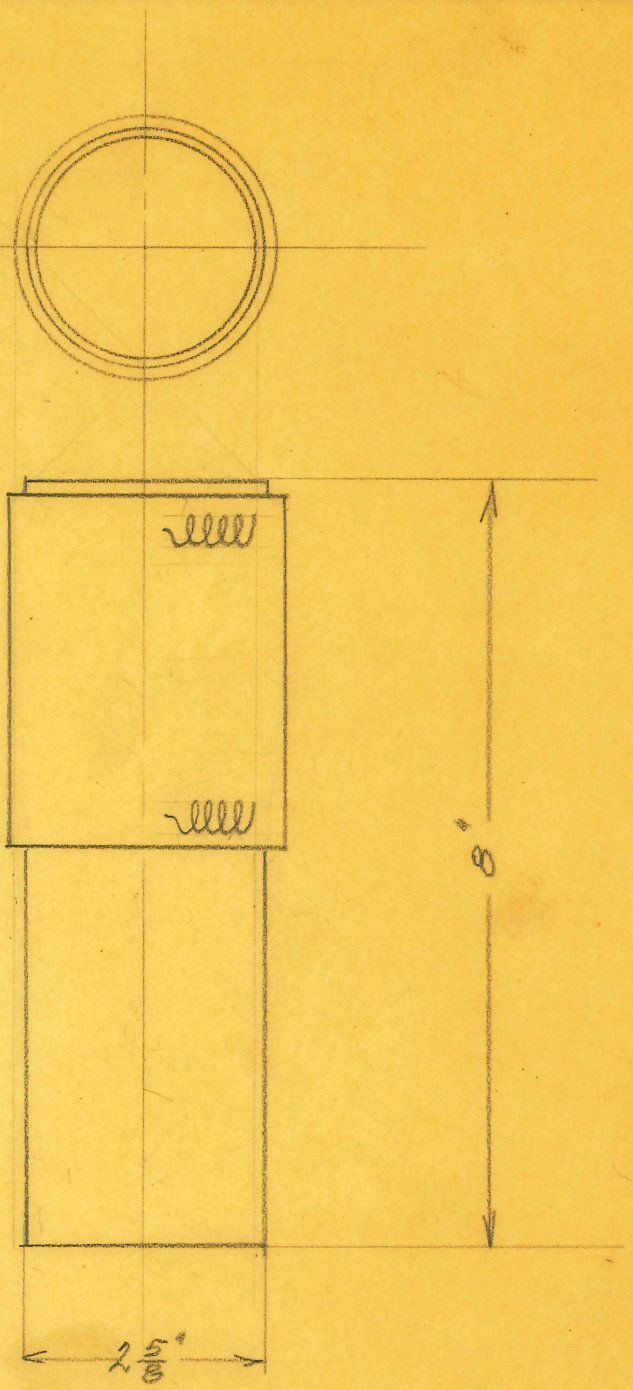

LAYER	TURNS.	WIRE # COTT. E.
1	90.	20.

OBSOLETE

(1)

SIZE		ISSUE Feb 23-26 W.P.	
KIND		CHANGED	
SHAPE		" "	
FINISH		" "	
TEMP.		" "	
PATT.		" "	

TITLE: DUDIN TESLA SECONDARY PORT. DIATH. TYPE "G"

H. G. FISCHER & CO.
2335 WABANSIA AVE.
CHICAGO, ILL.

CAT. NO.

PART NO. 3366 G

SIZE		ISSUED	
KIND		CHANGED	
SHAPE		" "	
FINISH		" "	
TEMP.		" "	
PATT.		" "	

H. C. FISCHER & CO.
3333 WABANSIA AVE.
CHICAGO, ILL.

CAT.

NO.

PART 3333 C.A.

TITLE: CONDENSER FAN.

PART-DIAPHRAM. TYPE C.

OBSOLETE

CONDENSER.	4		
GROUND.	3	1 1/2 X 1/2	
CONDENSER	40		3 X 1 1/2
	38	1 1/2 X 1/2	
	PIECES	COPPER	MICA.

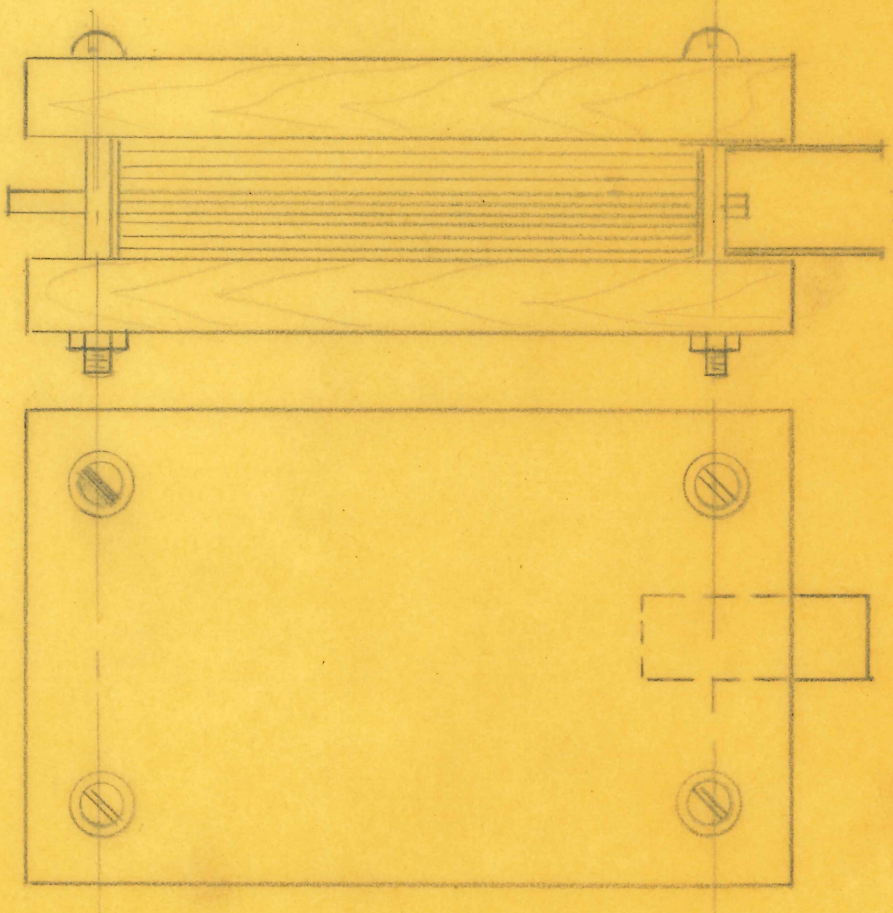

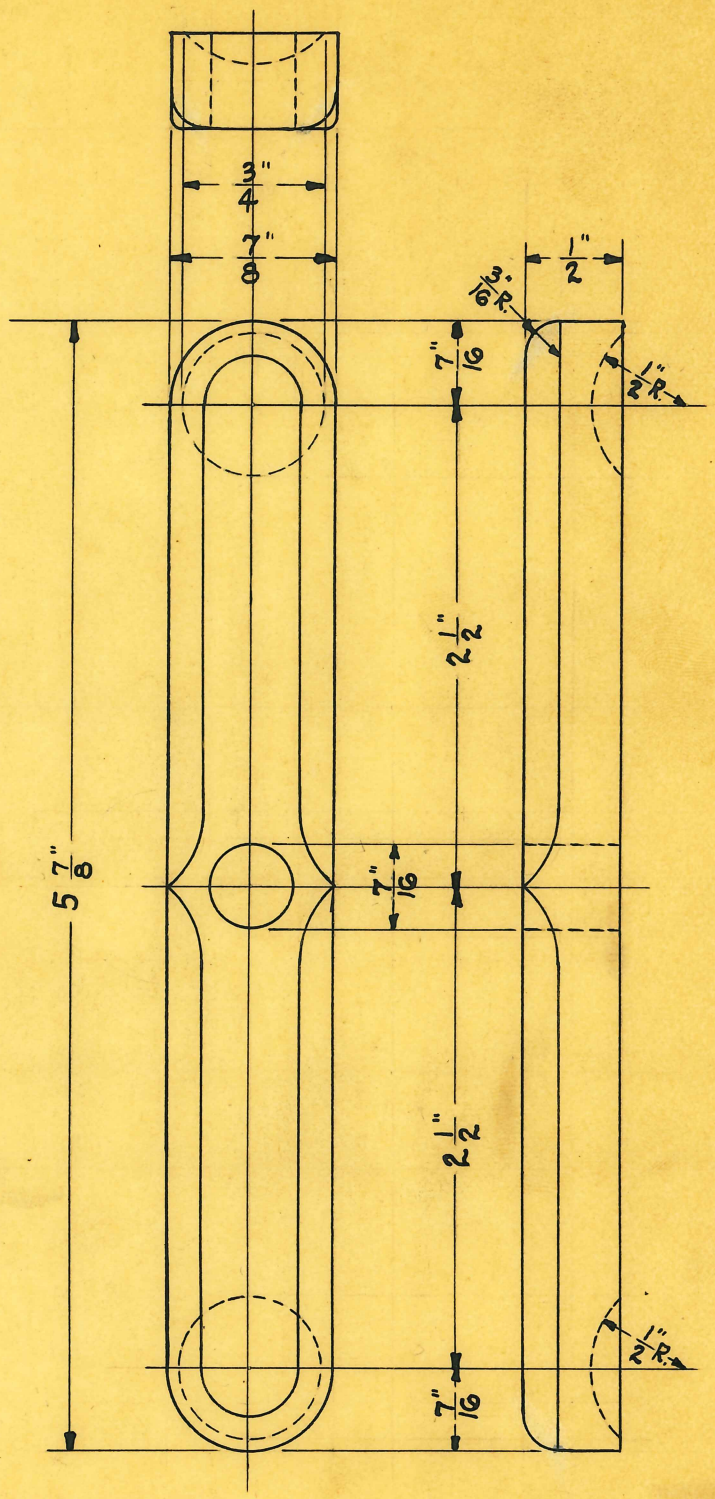

BOUGHT OUTSIDE

OBSOLETE

SIZE		ISSUE H.E.	3-5-30	TITLE: FISCHER ADJ. ELEC. SUPPORT WOOD CLAMP		
KIND		CHANGED				
SHAPE		" "				
FINISH		" "				
TEMP.		" "		H. G. FISCHER & CO. 2335 WABANSIA AVE. CHICAGO, ILL.	CAT. NO.	PART NO. 3977
PATT.		" "				

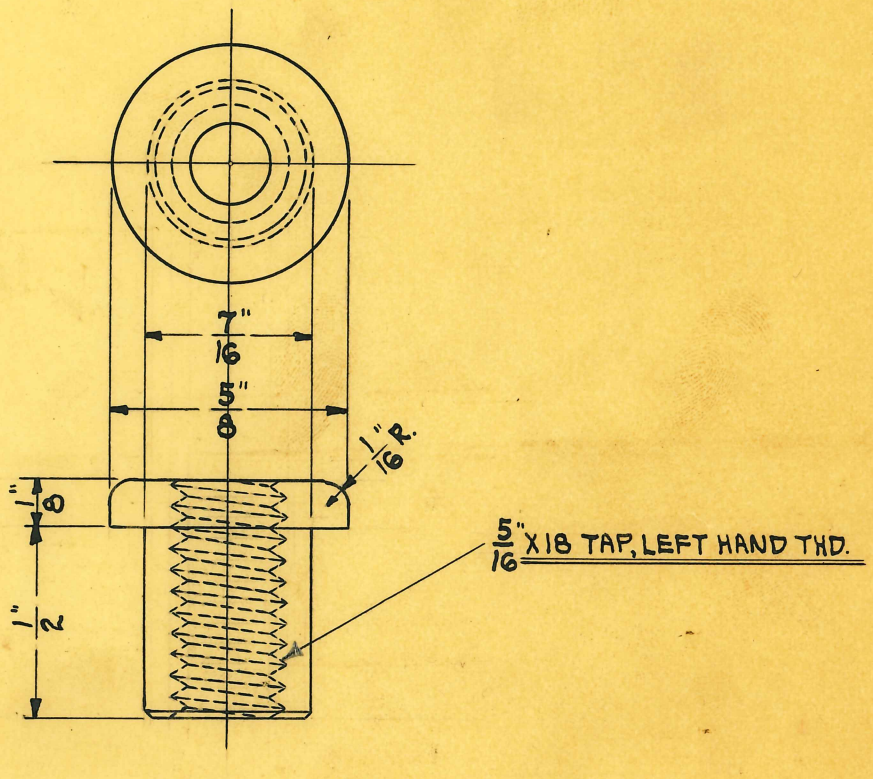

SCALE ~ 2 DIAMETERS

ALUMINUM ROD

OBSOLETE

SIZE	5/8"	ISSUE H.E.	3-5-30	TITLE: FISCHER ADJ. ELEC. SUPP. WOOD CLAMP BUSHING (LEFT)
~~KIND~~	~~POL. RUBBER ROD~~	CHANGED		
SHAPE	ROUND	" "		
FINISH		" "		
TEMP.		" "		H. G. FISCHER & CO. 2335 WABANSIA AVE. CHICAGO, ILL. / CAT. NO. / PART NO. 3978A
PATT.		" "		

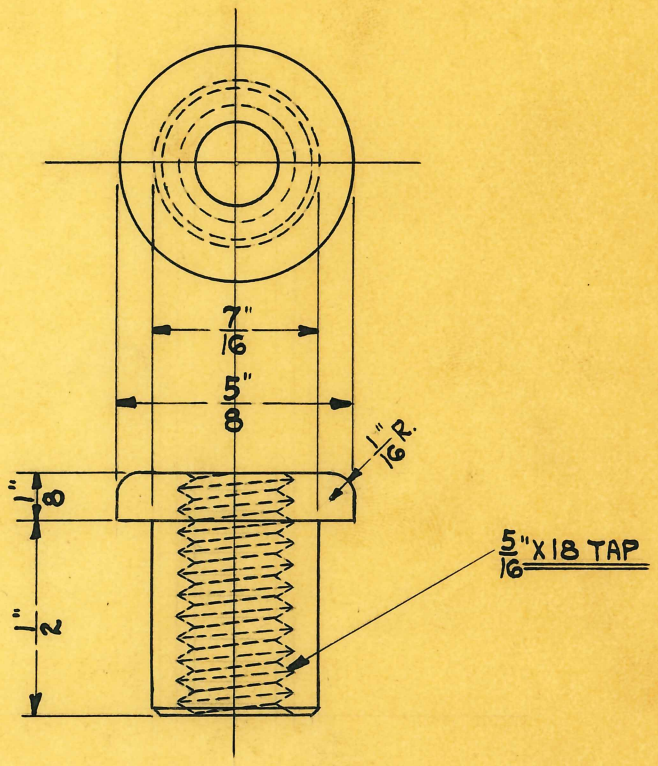

SCALE ~ 2 DIAMETERS

ALUMINUM ROD

OBSOLETE

SIZE	5/8"	ISSUE H.E.	3-5-30	TITLE: FISCHER ADJ. ELEC. SUPP. WOOD CLAMP BUSHING (RIGHT)
~~KIND~~	~~POL. RUBBER ROD~~	CHANGED		
SHAPE	ROUND	" "		
FINISH		" "		
TEMP.		" "		
PATT.		" "		

H. G. FISCHER & CO.
2335 WABANSIA AVE.
CHICAGO, ILL.

CAT. NO.

PART NO. 3980A

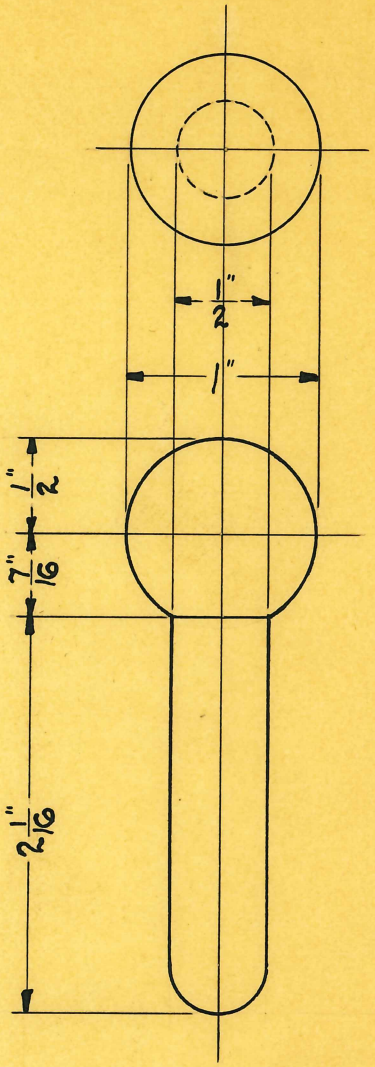

BOUGHT OUTSIDE

OBSOLETE

SIZE		ISSUE H.E.	3-3-30	TITLE: FISCHER ADJ. ELEC. SUPPORT WOOD SPACER	
KIND		CHANGED			
SHAPE		" "			
FINISH		" "			
TEMP.		" "		H. G. FISCHER & CO. 2335 WABANSIA AVE. CHICAGO, ILL.	CAT. NO.
PATT.		" "			PART NO. 3981

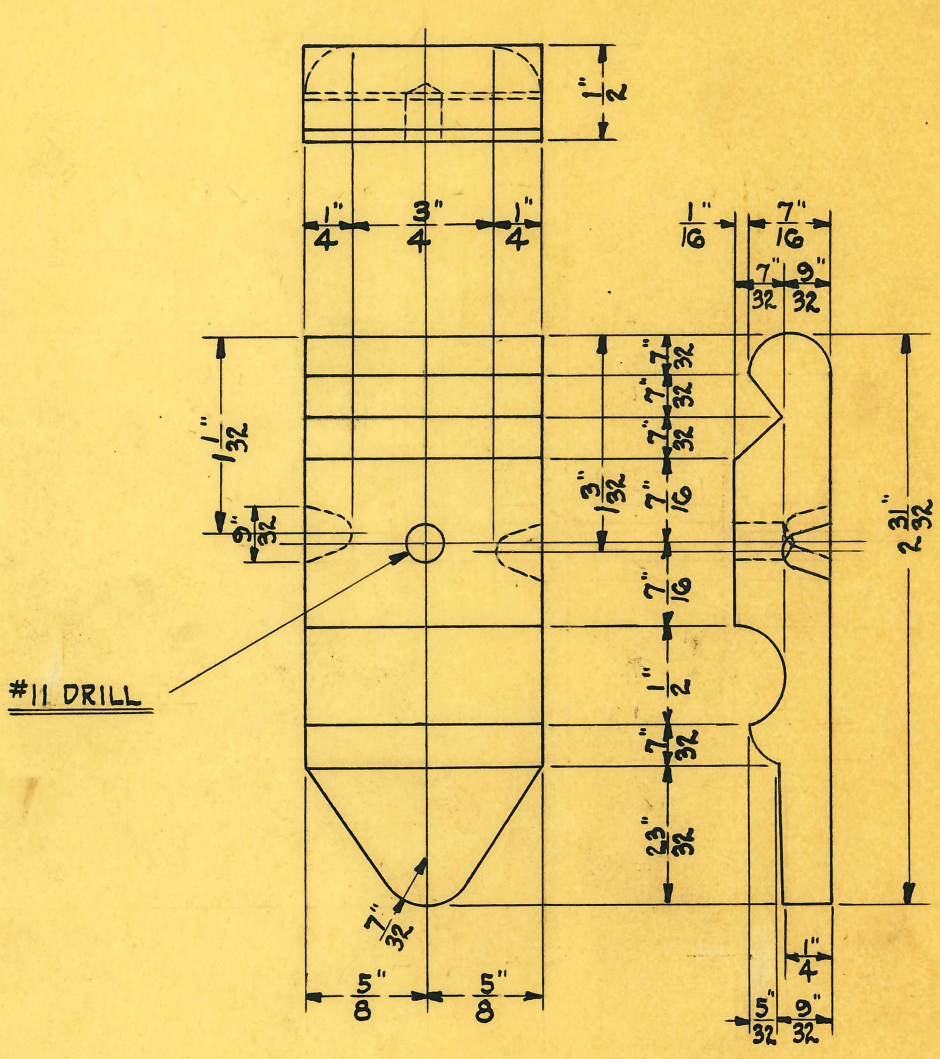

OBSOLETE

SIZE	1/2"	ISSUE H.E.	3-4-30	TITLE: FISCHER ADJ. ELEC. SUPPORT RUBBER CLAMP
KIND	SHEET RUBBER	CHANGED		
SHAPE	SHEET	" "		
FINISH		" "		
TEMP.		" "		H. G. FISCHER & CO. 2335 WABANSIA AVE. CHICAGO, ILL. — CAT. NO. — PART NO. 3982
PATT.		" "		

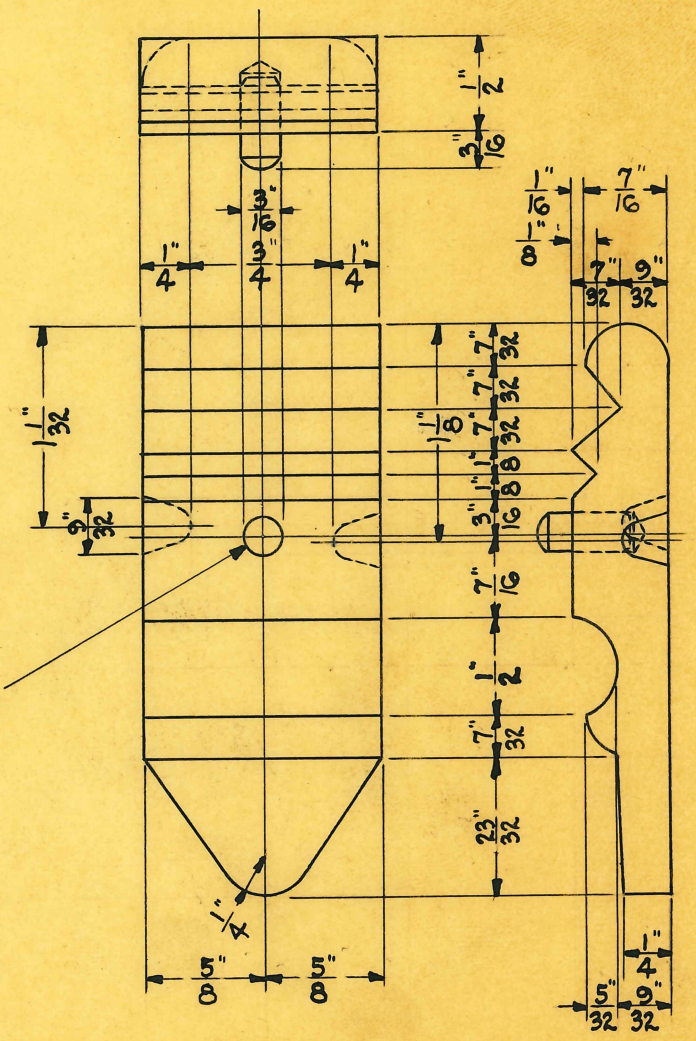

OBSOLETE

SIZE	1/2"	ISSUE H.E.	3-4-30	TITLE: FISCHER ADJ. ELEC. SUPPORT RUBBER CLAMP
KIND	SHEET RUBBER	CHANGED		
SHAPE	SHEET	" "		
FINISH		" "		
TEMP.		" "		H. G. FISCHER & CO. 2335 WABANSIA AVE. CHICAGO, ILL.
PATT.		" "		CAT. NO.
				PART NO. 3982

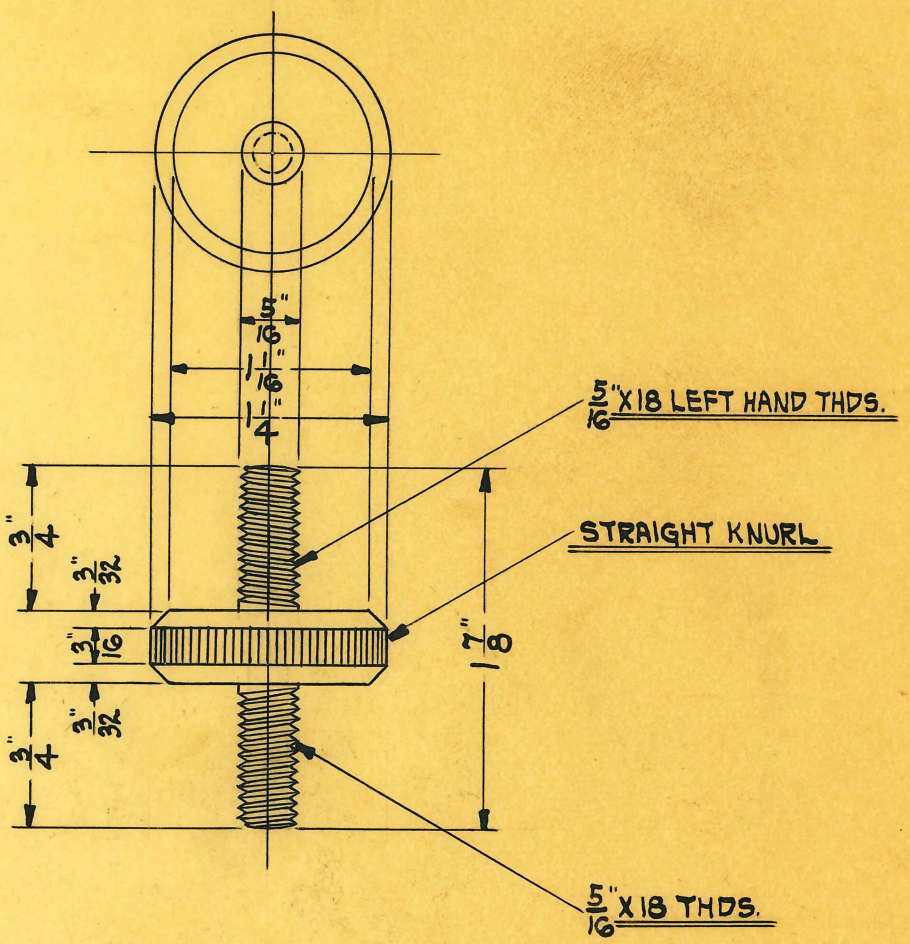

OBSOLETE

SIZE	1 1/4"	ISSUE H.E.	3-5-30	TITLE: FISCHER ADJ. ELEC. SUPPORT CLAMP SCREW
KIND	POL. RUBBER ROD	CHANGED		
SHAPE	ROUND	" "		
FINISH		" "		
TEMP.		" "		
PATT.		" "		

H. G. FISCHER & CO.
2335 WABANSIA AVE.
CHICAGO, ILL.

CAT. NO.

PART NO. 3983

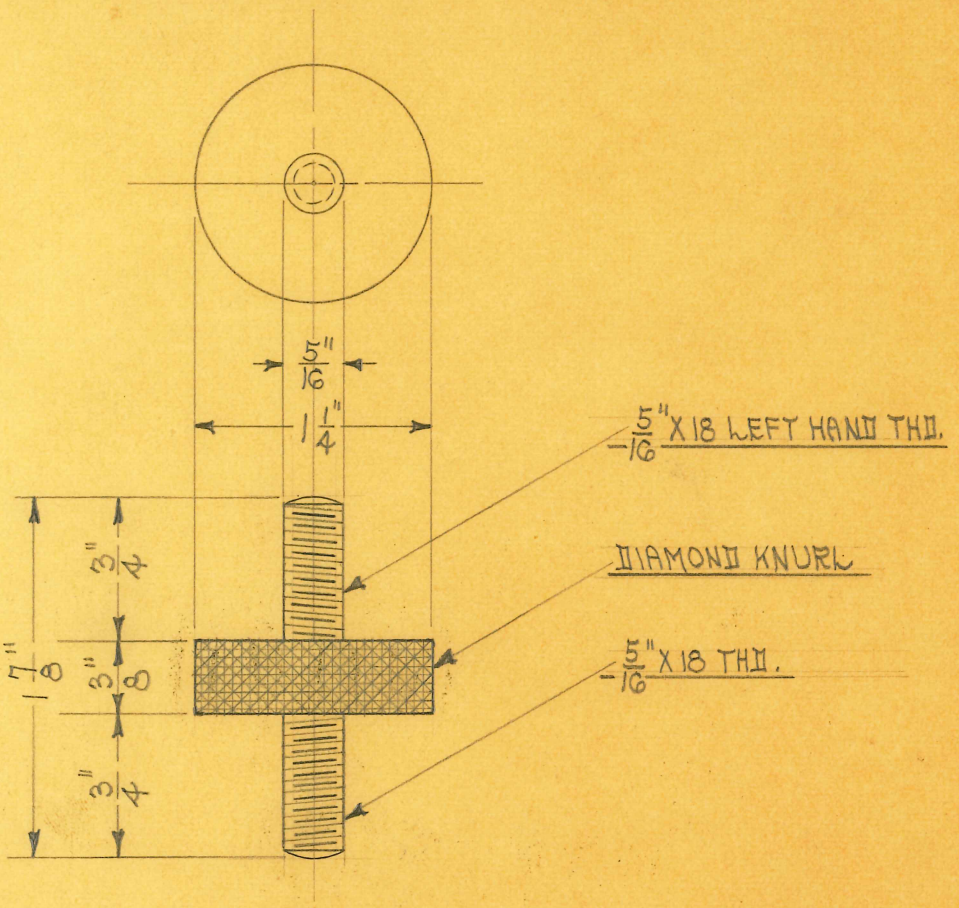

OBSOLETE

SIZE	1 1/4"	ISSUE 11-20-31	A.E.	**TITLE:** FISCHER ADJ. ELEC. SUPPORT CLAMP SCREW
KIND	ALUMINUM ROD	CHANGED		
SHAPE		" "		
FINISH		" "		
TEMP.		" "		H. G. FISCHER & CO. 2335 WABANSIA AVE. CHICAGO, ILL. — CAT. NO. — PART NO. 3983A
PATT.		" "		

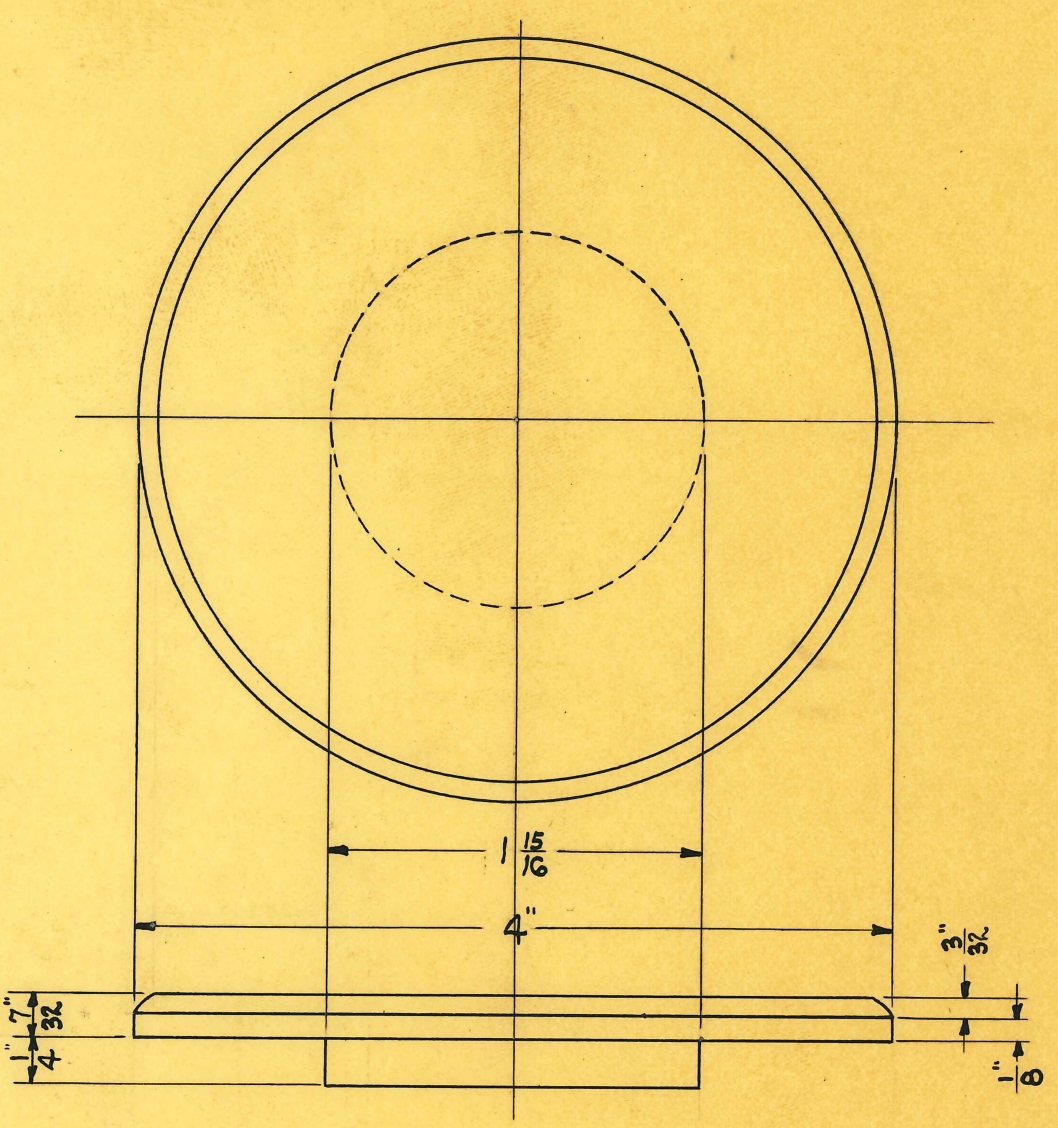

OBSOLETE

SIZE		ISSUE H.E.	3-6-30	TITLE: FISCHER ADJ. ELEC. SUPPORT LEAD BASE
KIND	SCRAP LEAD	CHANGED		
SHAPE		" "		
FINISH		" "		
TEMP.		" "		
PATT.		" "		

H. G. FISCHER & CO.
2335 WABANSIA AVE.
CHICAGO, ILL.

CAT. NO.

PART NO. 3985

TITLE

FISCHER MODEL "400" DELUXE DIATHERMY VACUUM CONDENSER SUPPORT CLIP

H. G. FISCHER & CO.
FRANKLIN PARK, ILLINOIS

DATE 10-4-48 | DR. BY J.B.G. | CH'K'D J.V.W

PART NO. 10914F

REVISION	DATE	BY

PATTERN	FINISH	SCALE
	SILVER #6 1/2	

TOOLS

MATERIAL
FROM 10914

DIMENSIONS
FRACTIONAL ± .015
DECIMAL ± .005
ANGULAR ± ½°
UNLESS OTHERWISE SPECIFIED

REMOVE TIPS FROM
BOTTOM OF CLIP ON SANDER

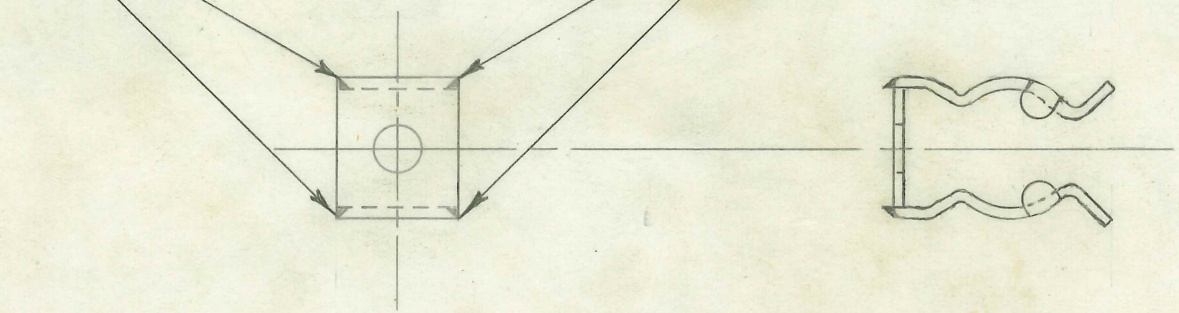

OBSOLETE
1-22-50

4-REQUIRED

FOLDER #128

TITLE

PORTABLE DIATHERMY
METER SOCKET NUT

H. G. FISCHER & CO.
FRANKLIN PARK, ILLINOIS

PART NO. 3314

DATE 3-31-50 | DR. BY W.J. | CH'K'D. J.V.W.

REVISION	DATE	BY

PATTERN | FINISH | SCALE FULL

TOOLS | MATERIAL 1/2" HEX. BRASS ROD

DIMENSIONS
FRACTIONAL ± .015
DECIMAL ± .005
ANGULAR ± ½°
UNLESS OTHERWISE SPECIFIED

3 REQUIRED

OBSOLETE
4-22-80

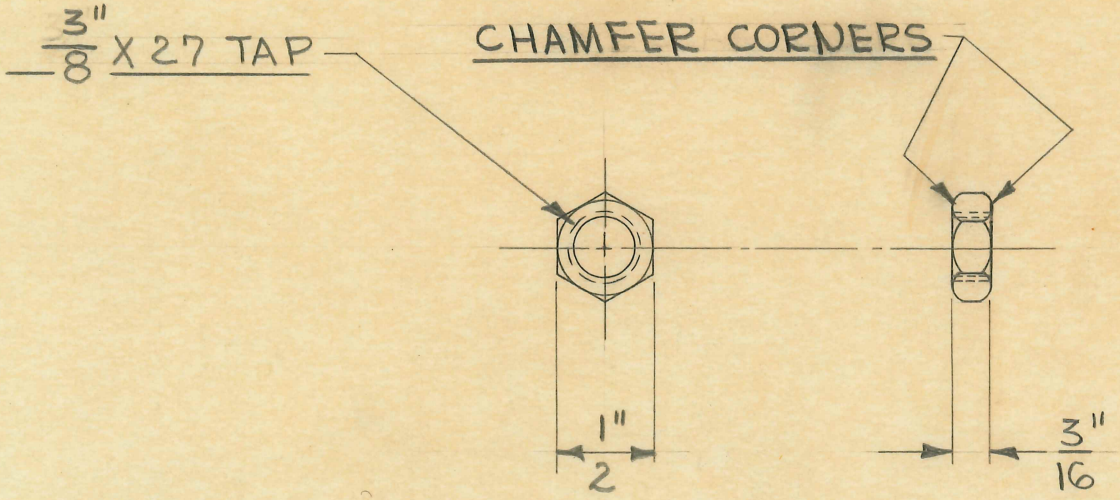

TITLE: TYPE "R" HEX. BRASS NUT 1/4" X 27	H. G. FISCHER & CO. FRANKLIN PARK, ILLINOIS		PART NO. 2311
	DATE 10-22-48	DR. BY K.S.	CH'K'D. J.V.W.
PATTERN	FINISH	SCALE FULL	
TOOLS	MATERIAL 1/2" HEX. BRASS ROD		

DIMENSIONS
FRACTIONAL ± .015
DECIMAL ± .005
ANGULAR ± ½°
UNLESS OTHERWISE SPECIFIED

REVISION	DATE	BY

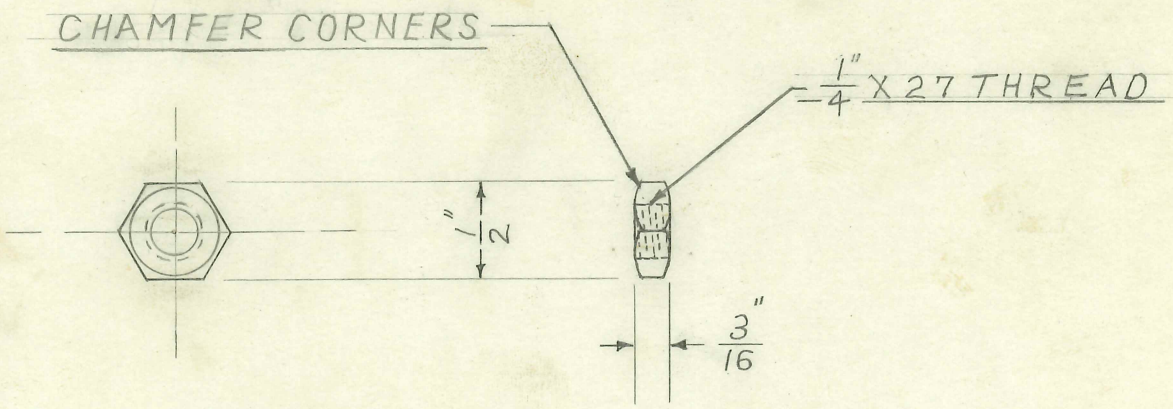

OBSOLETE
4-22-80

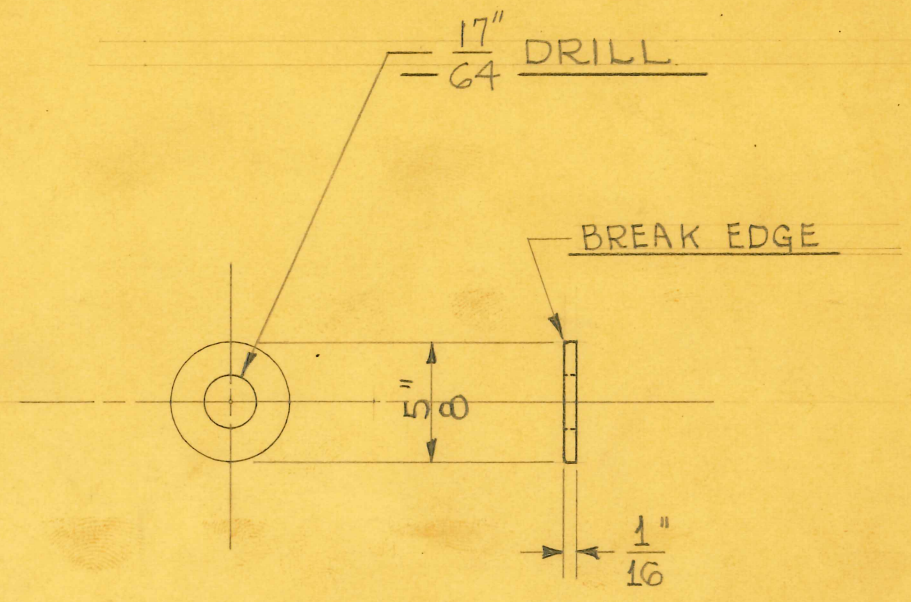

OBSOLETE
4-22-80

SIZE	5/8" DIAM.	ISSUE 2-15-45	HE.
KIND	BRASS ROD	CHANGED	
SHAPE		"	
FINISH	N.P. # 12 OR	"	
TEMP.	CHROME #2	"	
PATT.		"	

TITLE: TYPE "R" CONTROL BOX WASHER

H. G. FISCHER & CO.
2335 WABANSIA AVE.
CHICAGO. ILL.

CAT. NO.

PART NO. 2360

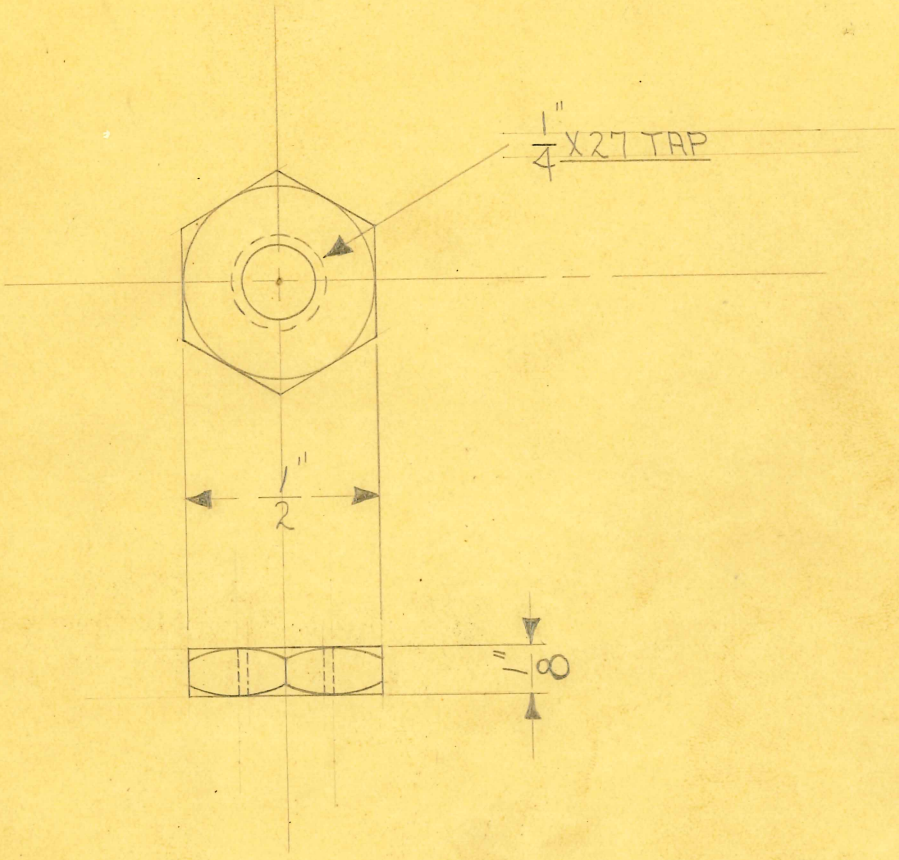

SCALE: 1/2" = 1"

OBSOLETE
4-22-80

SIZE	1/2" HEX.	ISSUE 8-20-35	J.W.	TITLE: 1/4" X 27 HEXAGON BRASS NUT
KIND	BRASS ROD	CHANGED		
SHAPE		"		
FINISH		"		
TEMP.		"		
PATT.		"		

H. G. FISCHER & CO.
2335 WABANSIA AVE.
CHICAGO, ILL.

CAT. NO.

PART NO. 2311 1/2

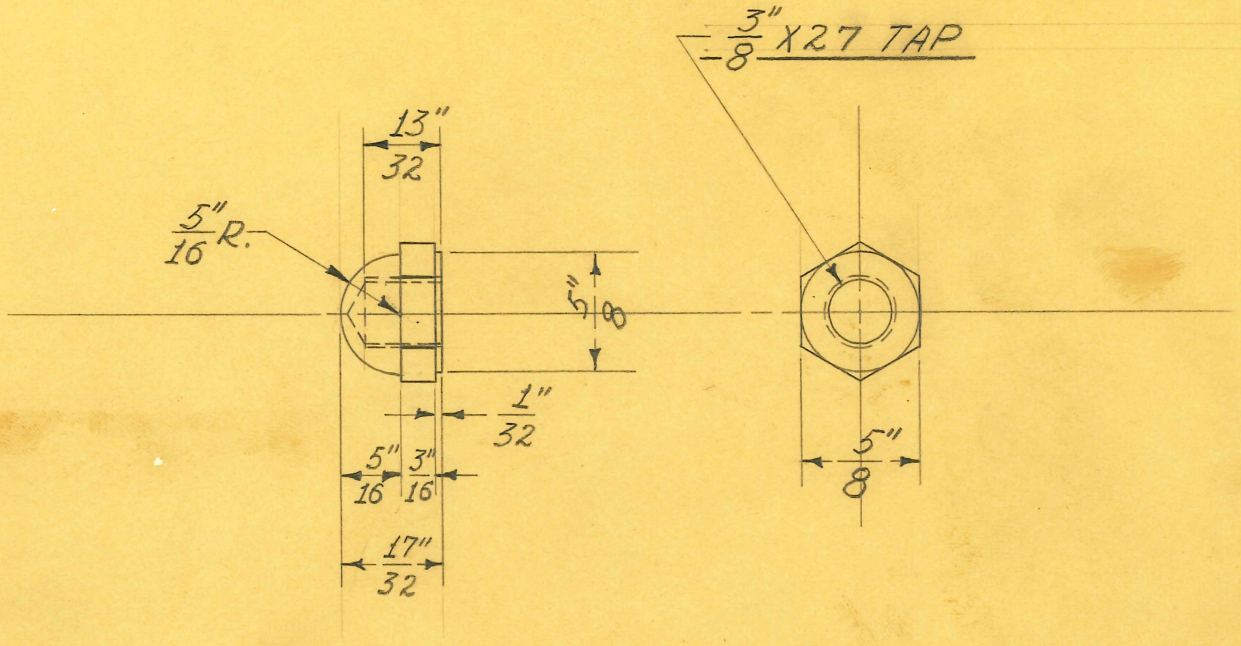

18 REQUIRED

OBSOLETE

4-22-80

SIZE	5/8" HEX.	ISSUE 2-24-39	J.W.	TITLE: 3/8"X27 ACORN NUT	
KIND	BRASS ROD	CHANGED			
SHAPE		"			
FINISH	CHROME #2	"			
TEMP.		"			
PATT.		"			

H. G. FISCHER & CO.
2335 WABANSIA AVE.
CHICAGO, ILL.

CAT. NO.

PART NO. 1835

TITLE 5/16" X 27 ACORN NUT

H. G. FISCHER & CO.
FRANKLIN PARK, ILLINOIS

PART NO. 1874

DATE 11-13-48 | DR. BY W.J. | CH'K'D. J.V.W.

REVISION	DATE	BY

PATTERN | FINISH CHROME #2 | SCALE FULL

TOOLS | MATERIAL 1/2" HEX. BRASS ROD

DIMENSIONS
FRACTIONAL ± .015
DECIMAL ± .005
ANGULAR ± ½°
UNLESS OTHERWISE SPECIFIED

CHAMFER CORNERS

TAP DRILL INCLUDING POINT
11/32" DEEP ~ 5/16" X 27 BOTTOM TAP

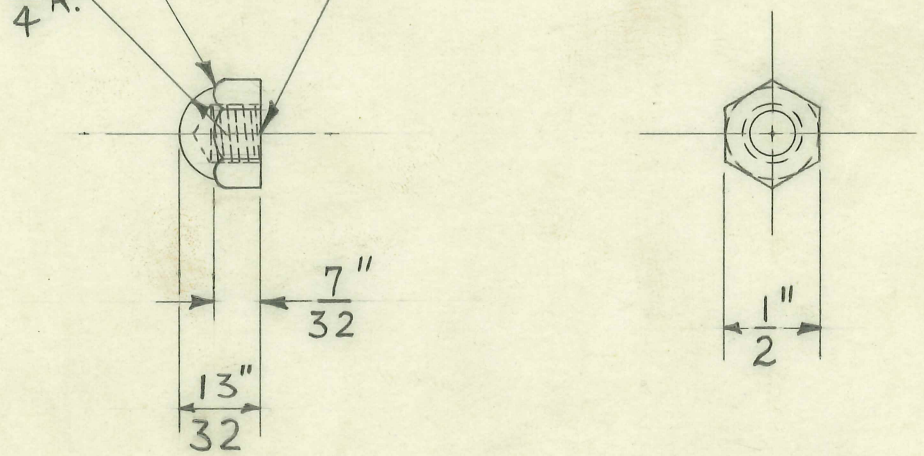

OBSOLETE
4-22-80

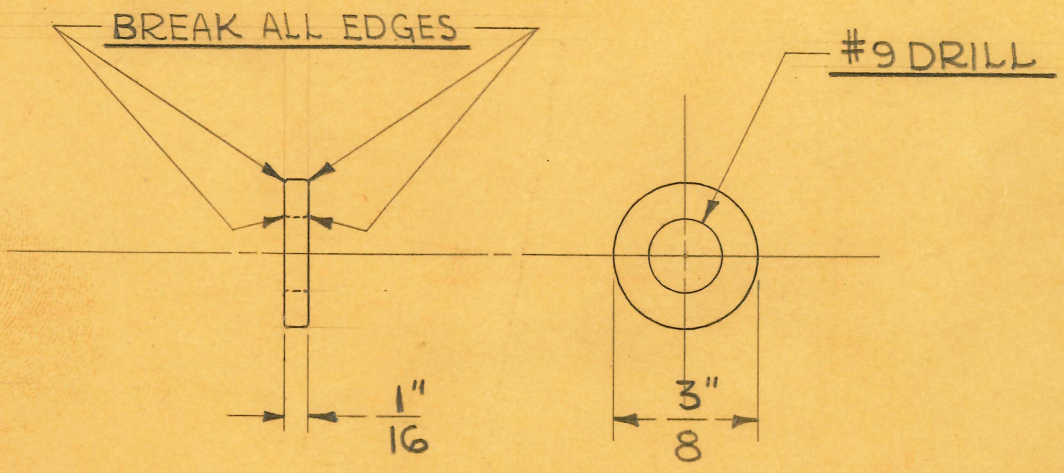

SCALE ÷ DOUBLE SIZE

OBSOLETE

4-22-80

SIZE	3/8" DIA.	ISSUE 12-6-45	J.V.W.
KIND	BRASS ROD	CHANGED	
SHAPE		"	
FINISH	CHROME #2	"	
TEMP.		"	
PATT.		"	

TITLE: "K" ACORN NUT WASHER

H. G. FISCHER & CO.
2335 WABANSIA AVE.
CHICAGO, ILL.

CAT. NO.

PART NO. 915

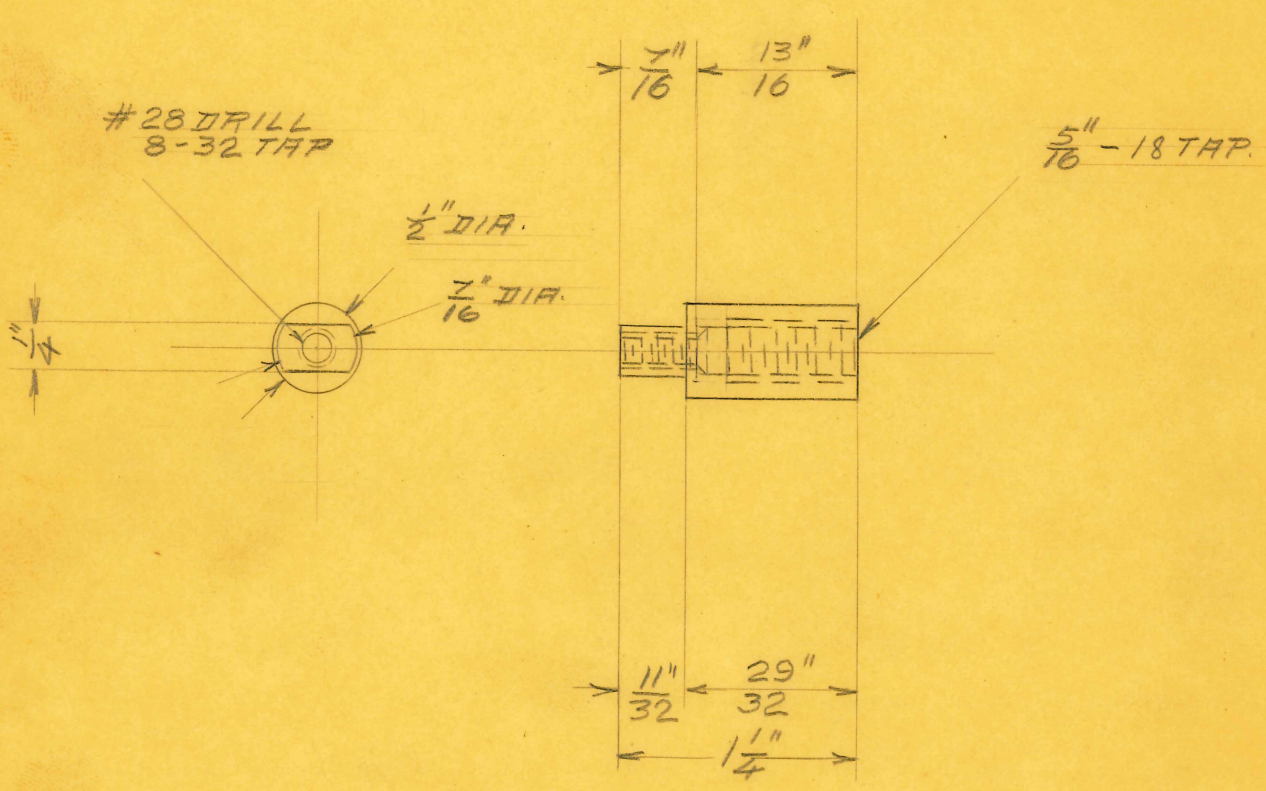

OBSOLETE
4-22-80

(1)

SIZE	1/2"	ISSUE 8-12-26		TITLE: SUPERIOR LAMP TUBE SUPPORT CLAMP BODY	
KIND	BRASS	CHANGED			
SHAPE		" "			
FINISH	N.P.	" "			
TEMP.		" "			
PATT.		" "			
				H. G. FISCHER & CO. 2335 WABANSIA AVE. CHICAGO, ILL.	CAT. NO.
					PART NO. 3781

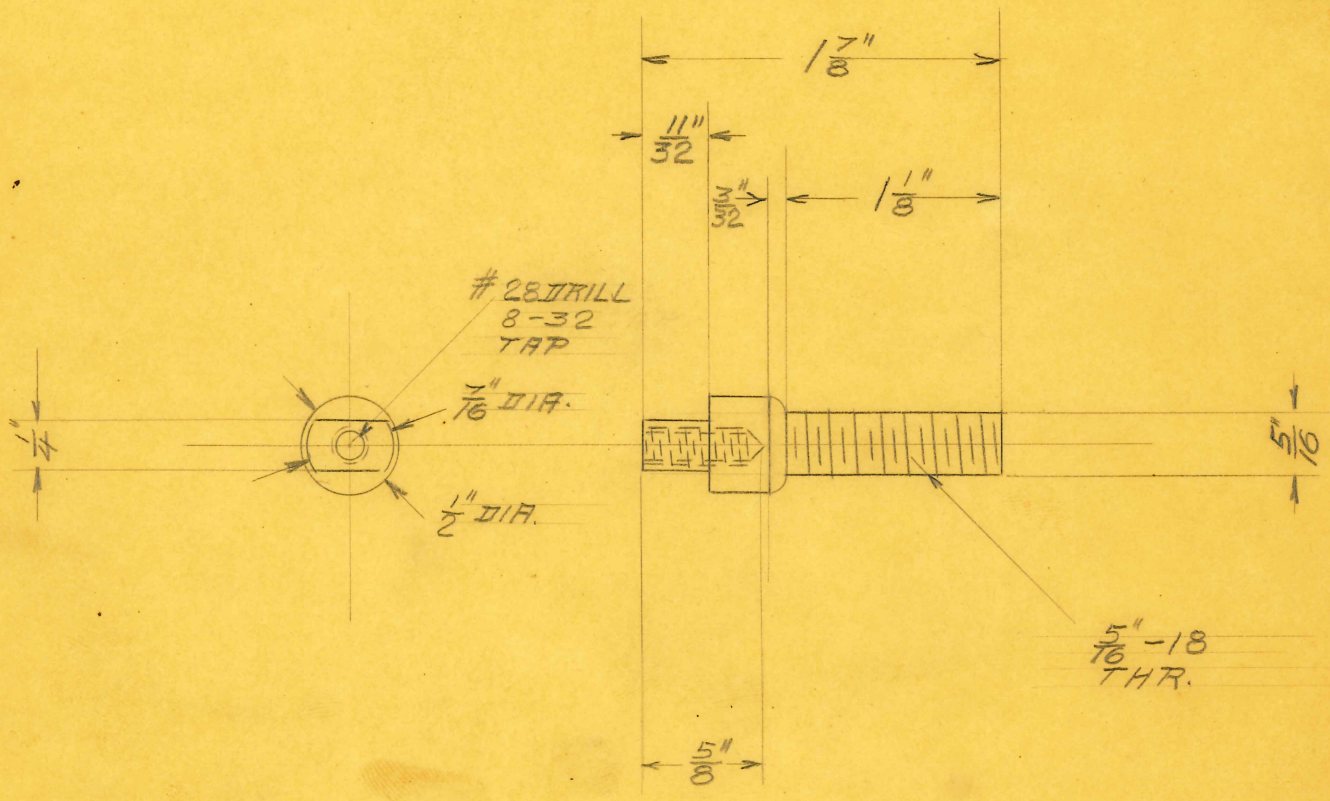

OBSOLETE
4-22-80

(3)

SIZE	1/2"	ISSUE 8-12-26	EP.	TITLE: SUPERIOR LAMP LAMP CLAMP STUD
KIND	BRASS	CHANGED		
SHAPE		" "		
FINISH	M.P.	" "		
TEMP.		" "		H. G. FISCHER & CO. 2335 WABANSIA AVE. CHICAGO, ILL. — CAT. NO. — PART NO. 3777
PATT.		" "		

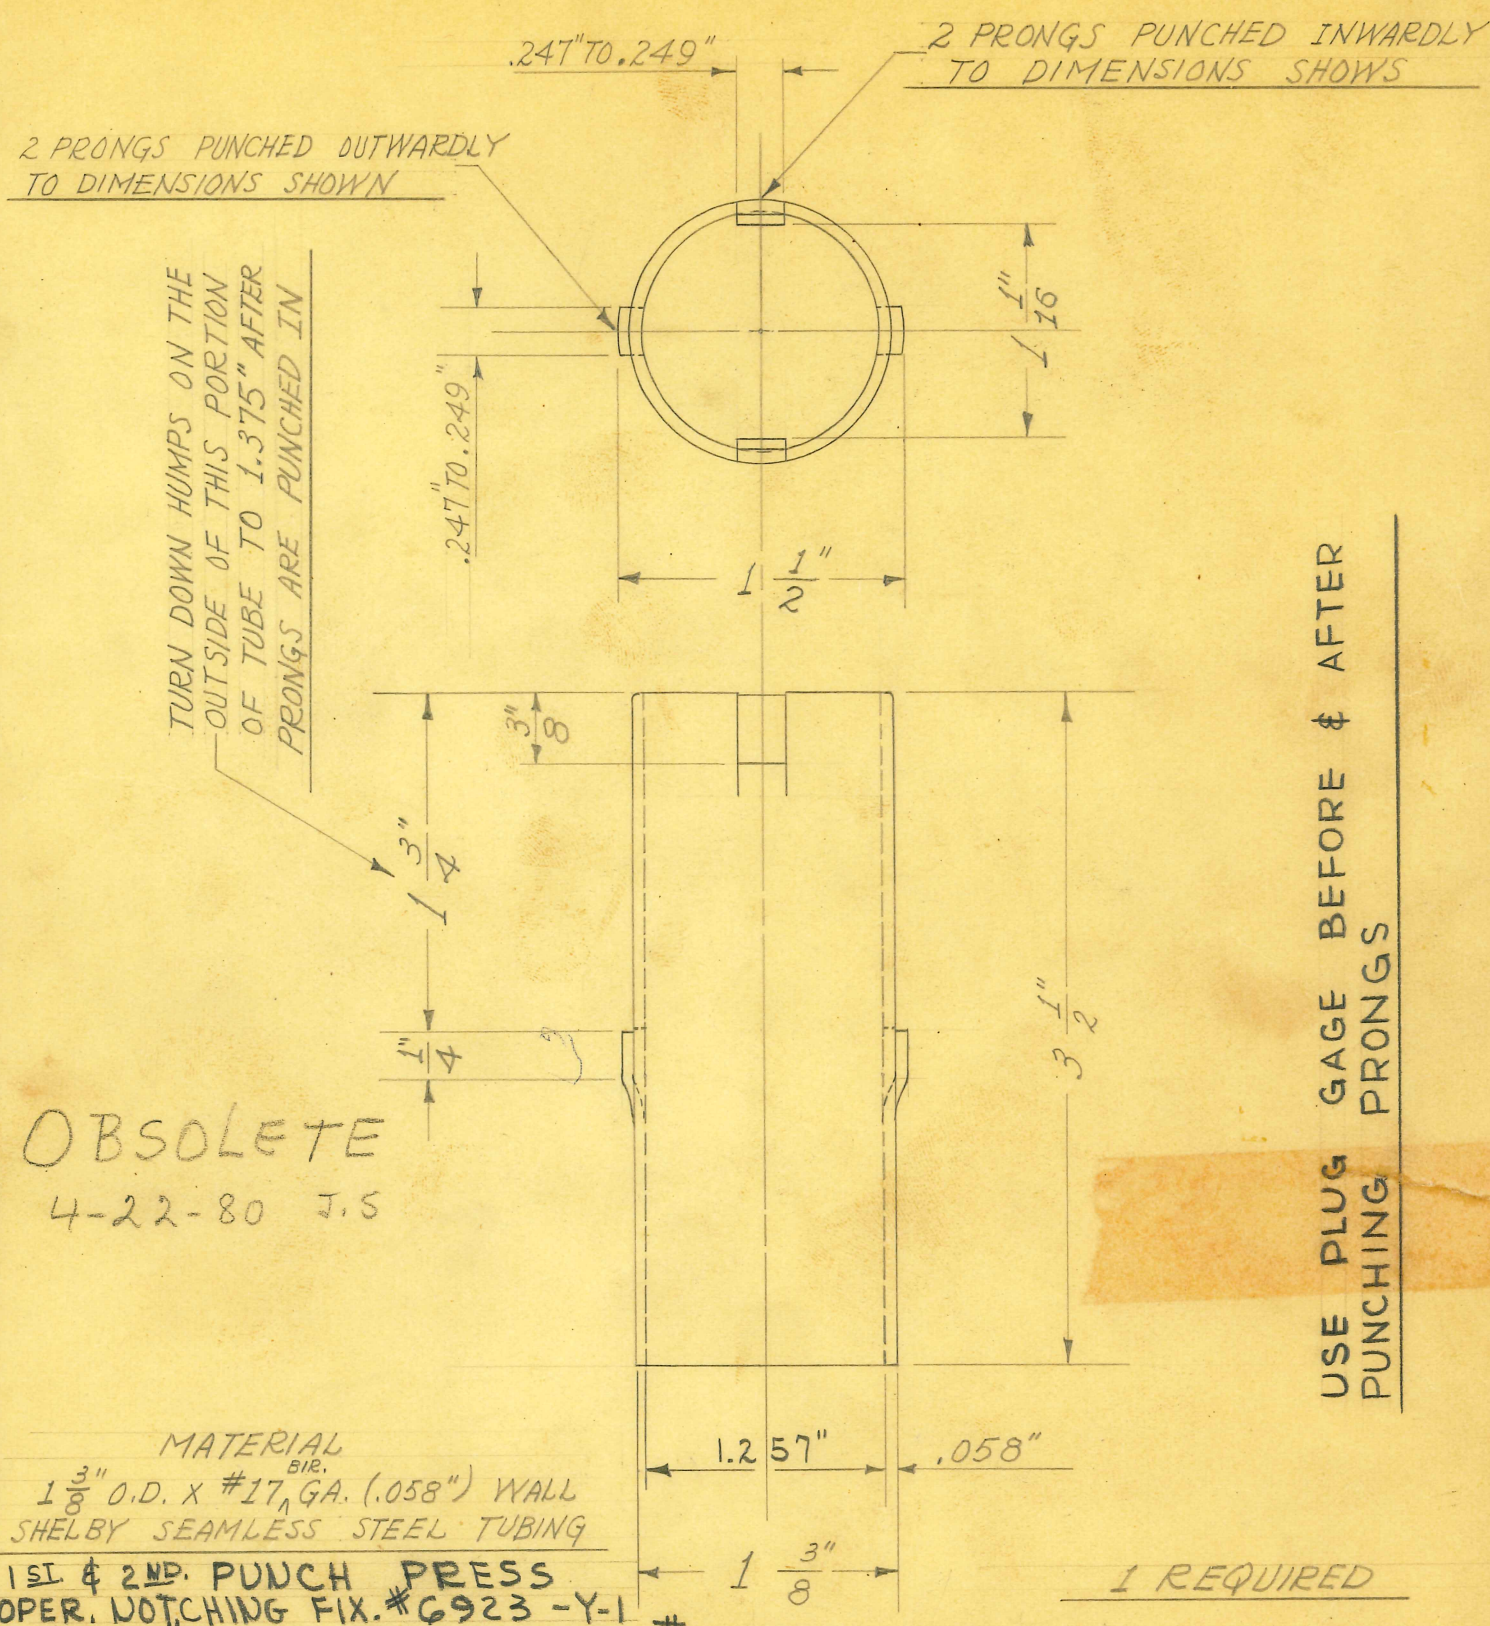

USE PLUG GAGE BEFORE & AFTER PUNCHING PRONGS

OBSOLETE
4-22-80 J.S

MATERIAL
1 3/8" O.D. X #17 BIR. GA. (.058") WALL
SHELBY SEAMLESS STEEL TUBING

1 REQUIRED

1ST & 2ND. PUNCH PRESS
OPER. NOTCHING FIX. #6923-Y-1
1.257" PLUG GAGE TOOL #11,015

SIZE		ISSUE 7-20-38	J.W.
KIND		CHANGED	
SHAPE		"	
FINISH		"	
TEMP.		"	
PATT.		"	

TITLE:
SHORT WAVE INDUCTION COIL ELECT. ARM-RETAINING TUBE

H. G. FISCHER & CO.
2335 WABANSIA AVE.
CHICAGO, ILL.

CAT. NO.

PART NO. 12000

TITLE
SHORT WAVE INDUCTION COIL ELECT.
ARM — PIN

H. G. FISCHER & CO.
FRANKLIN PARK, ILLINOIS

DATE 12-18-65 | DR BY KTK | CH'K'D. RS.

PART NO. 120012

REVISION	DATE	BY
—		

PATTERN

FINISH # 123 CAD.

SCALE DOUBLE

TOOLS

MATERIAL
3/32" DIA. C.R.S. ROD

DIMENSIONS
FRACTIONAL ± .015
DECIMAL ± .005
ANGULAR ± ½°
UNLESS OTHERWISE SPECIFIED

USED ON	QTY.
12001 GA	1

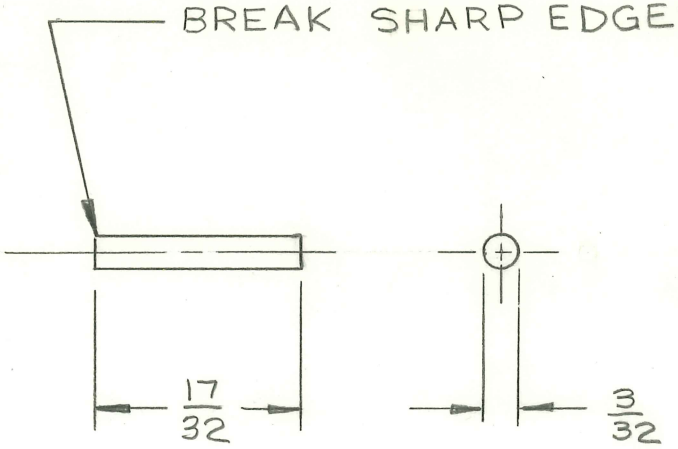

OBSOLETE
4-22-80 J.S.

TITLE	H. G. FISCHER & CO.	PART NO.
SHORT WAVE INDUCTION COIL ELECT. ARM-SWIVEL CLAMP BOLT	FRANKLIN PARK, ILLINOIS	12001.1
	DATE 12-18-65 DR BY KTK CH'K'D. RS	REVISION / DATE / BY
PATTERN	FINISH #2 CHROME	SCALE FULL
TOOLS	MATERIAL 11/16 DIA. C.R.S. ROD	DIMENSIONS: FRACTIONAL ± .015; DECIMAL ± .005; ANGULAR ± ½°; UNLESS OTHERWISE SPECIFIED

USED ON	QTY.
12001 GA	1

NOTE: POLISH HEADS & END

OBSOLETE
4-22-80 J.S

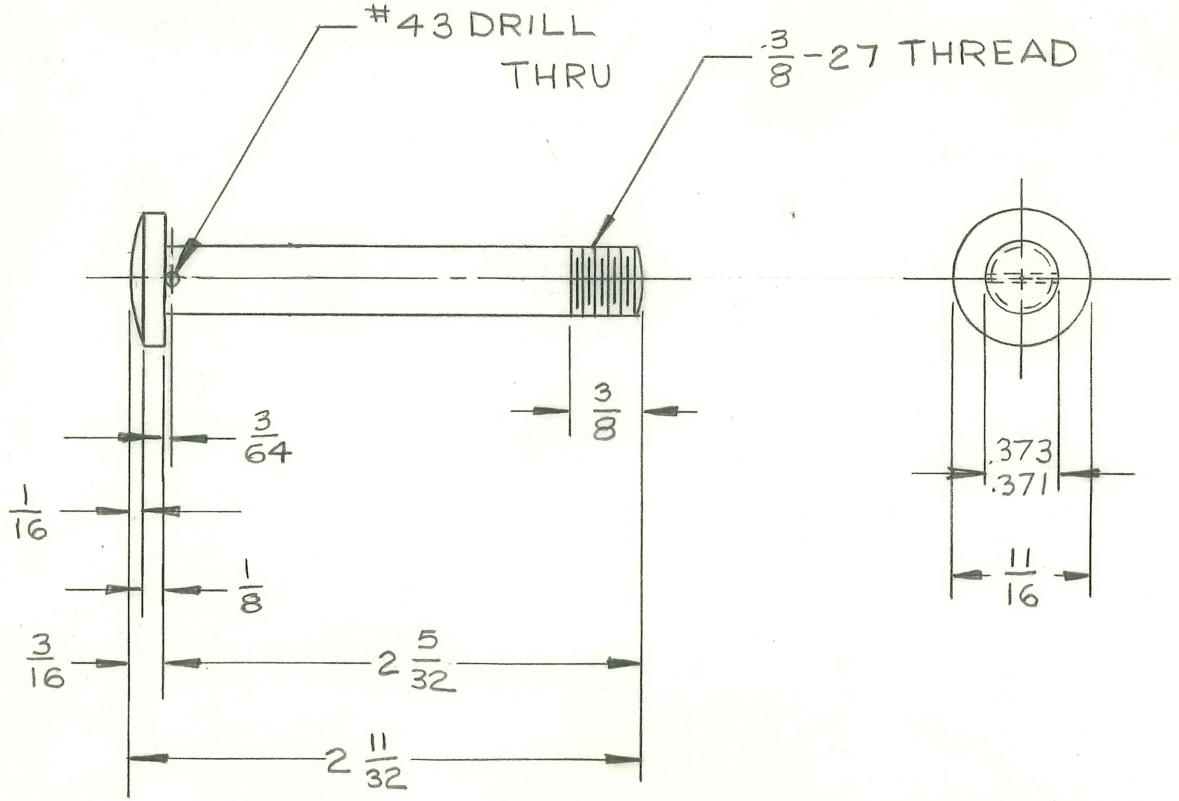

TITLE
SHORT WAVE INDUCTION COIL ELECT.
ARM SWIVEL CLAMP BOLT ASSM.

H. G. FISCHER & CO.
FRANKLIN PARK, ILLINOIS

DATE 12-18-65 | DR BY KTK | CH'K'D. RS.

PART NO. 120016A

REVISION	DATE	BY

PATTERN | FINISH | SCALE FULL

TOOLS | MATERIAL AS SHOWN

DIMENSIONS
FRACTIONAL ± .015
DECIMAL ± .005
ANGULAR ± ½°
UNLESS OTHERWISE SPECIFIED

USED ON	QTY.

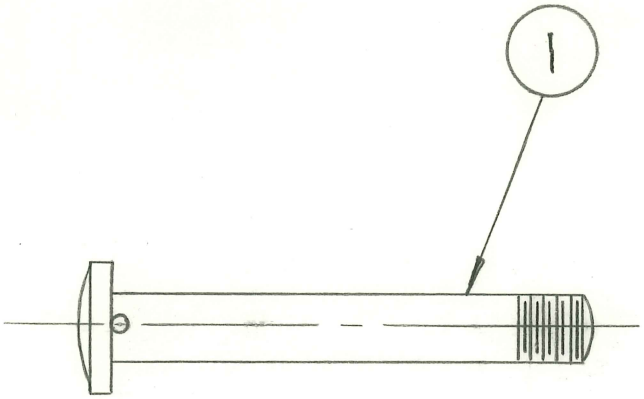

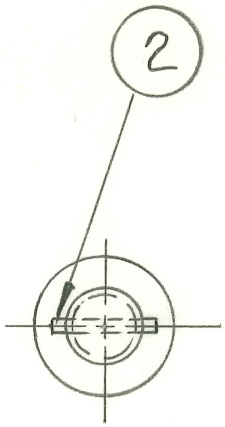

OBSOLETE
4-22-80 J.S

DEPT	AMT.	ITEM NO.	NAME	PART NO.
	1	2	PIN	120012
	1	1	CLAMP BOLT	120011

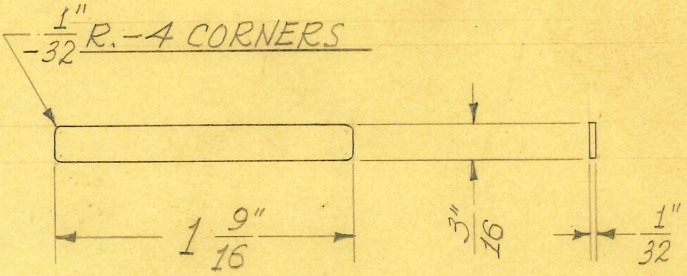

SCALE ~ FULL SIZE

OBSOLETE
4-22-80 J.S

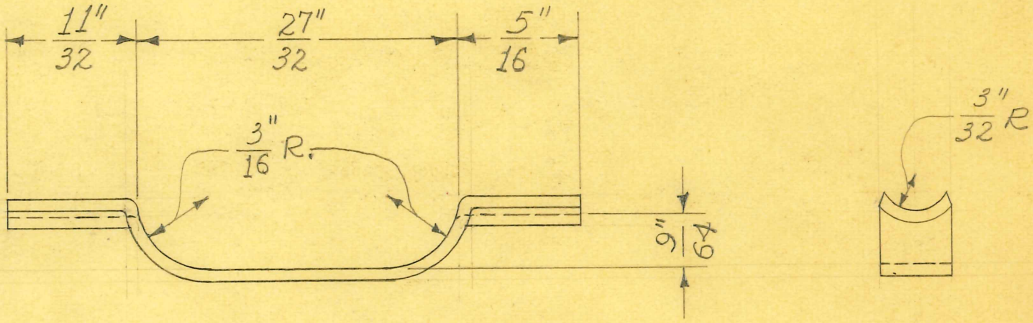

SCALE ~ DOUBLE SIZE

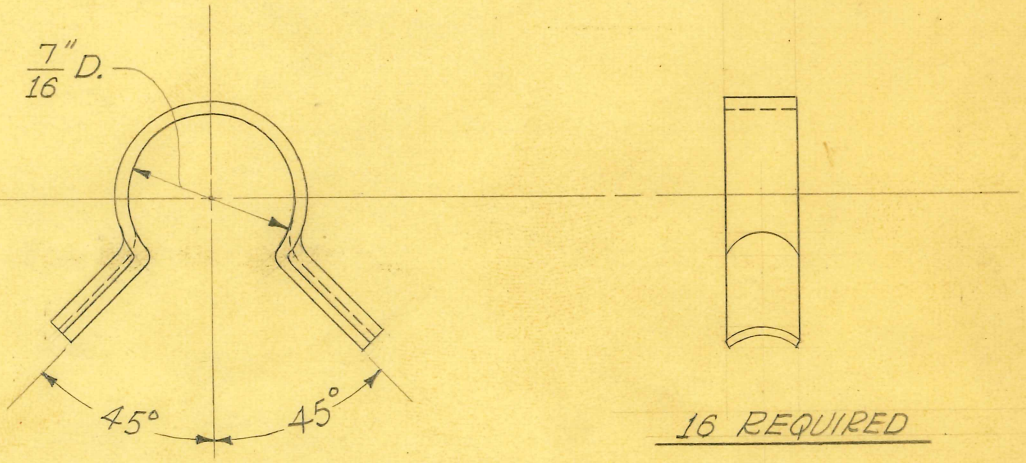

SCALE ~ DOUBLE SIZE

16 REQUIRED

SIZE	1/32 H.H.	ISSUE 8-24-38	J.W.
KIND	SHEET BRASS	CHANGED	
SHAPE		"	
FINISH	DIP #7	"	
TEMP.		"	
PATT.		"	

TITLE: SHORT WAVE INDUCTION COIL ELECTRODE - COIL CLIP

H. G. FISCHER & CO.
2335 WABANSIA AVE.
CHICAGO, ILL.

CAT. NO.

PART NO. 12008

.005" LESS THAN SLOTS
ON OUR DRAWING # 12003.

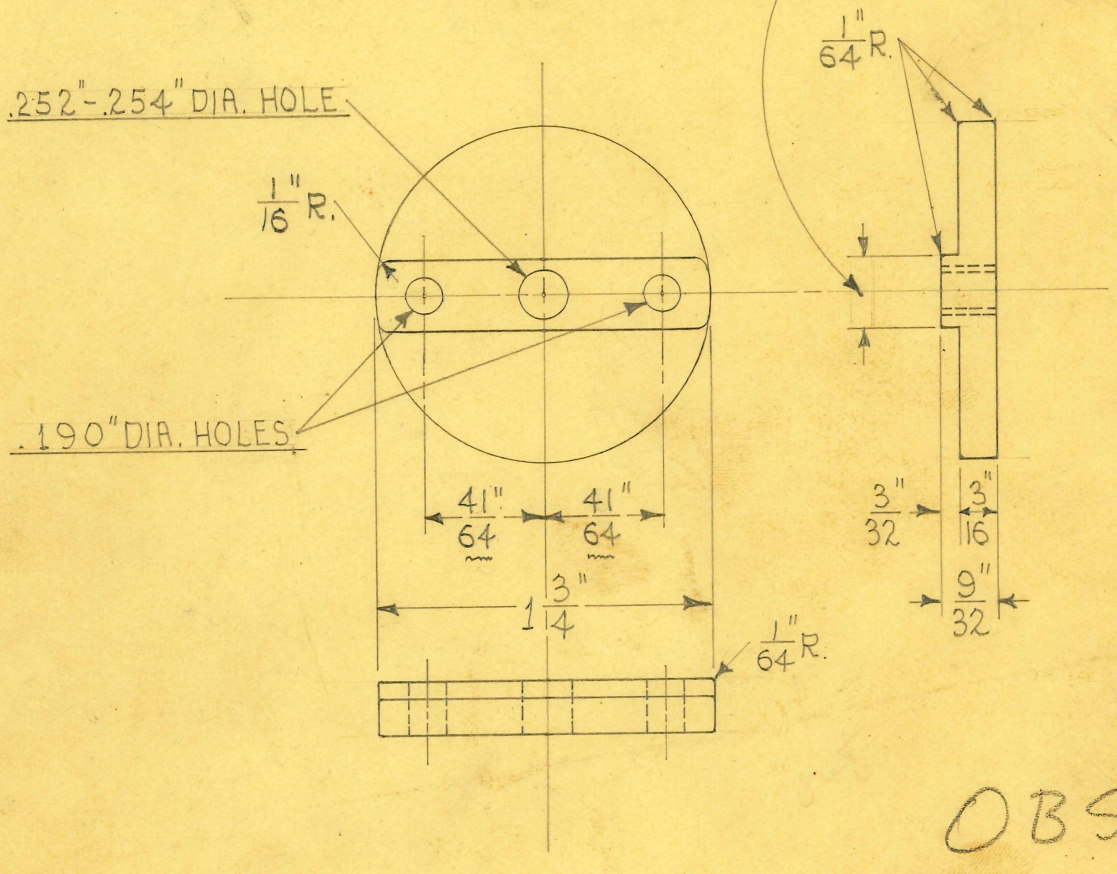

OBSOLETE
4-22-80 J.S.

2 REQUIRED

MOLD # 1804 MOLD MARKED M2411

SIZE	MOLDED	ISSUE 8-2-38	HE.
KIND	BAKELITE	CHANGED	
SHAPE		"	
FINISH		"	
TEMP.		"	
PATT.		"	

TITLE: SHORT WAVE INDUCTION COIL ELECTRODE-
FRICTION WASHER CLAMP PIECE

H. G. FISCHER & CO.
2335 WABANSIA AVE.
CHICAGO, ILL.

CAT. NO.

PART NO. 12009

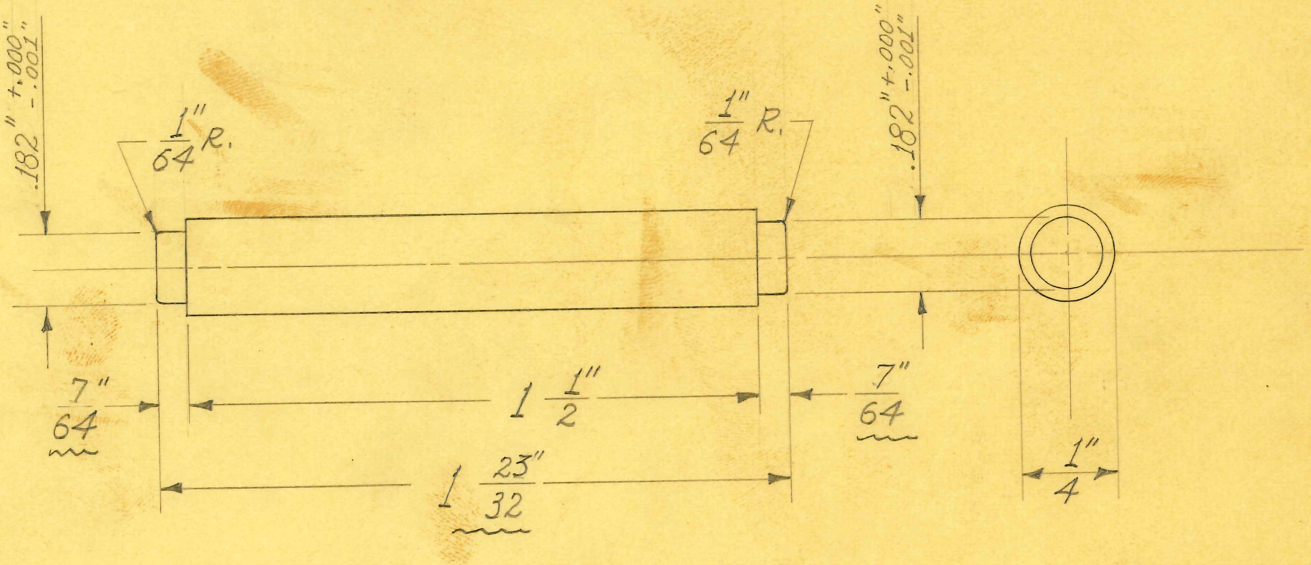

SCALE ÷ 2 DIAMETERS

1 REQUIRED

OBSOLETE
H-22-80 J.S.

SIZE	1/4" DIAM.	ISSUE 8-16-38	J.W.	**TITLE:** SHORT WAVE INDUCTION COIL ELECT. ARM - ARM SWIVEL RETAINING SHAFT
KIND	BRASS ROD	CHANGED		
SHAPE		" 12-7-38	J.W.	
FINISH	CHROME #2	"		
TEMP.		"		
PATT.		"		

H. G. FISCHER & CO.
2335 WABANSIA AVE.
CHICAGO, ILL.

CAT. NO.

PART NO. 12010A

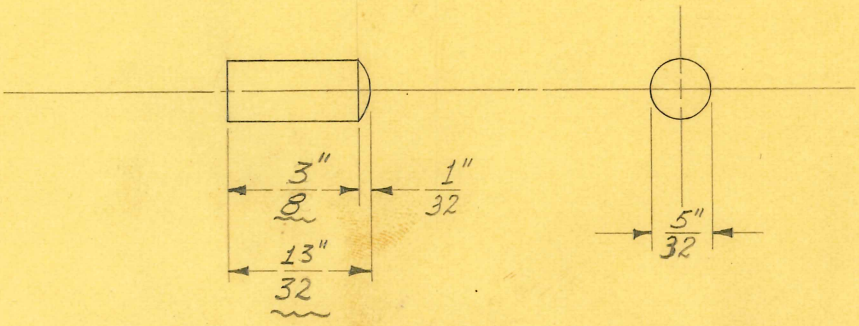

SCALE ÷ 2 DIAMETERS

4 REQUIRED

OBSOLETE
4-22-80 J.S

SIZE	5/32" DIAM.	ISSUE 8-19-38	J.W.
KIND	C.R. STEEL	CHANGED 12-13-38	J.W.
SHAPE	ROD	"	
FINISH		"	
TEMP.		"	
PATT.		"	

TITLE: SHORT WAVE INDUCTION COIL ELECT. ARM SWIVEL. SUPPORT PIN

H. G. FISCHER & CO.
2335 WABANSIA AVE.
CHICAGO, ILL.

CAT. NO.

PART NO. 12012A

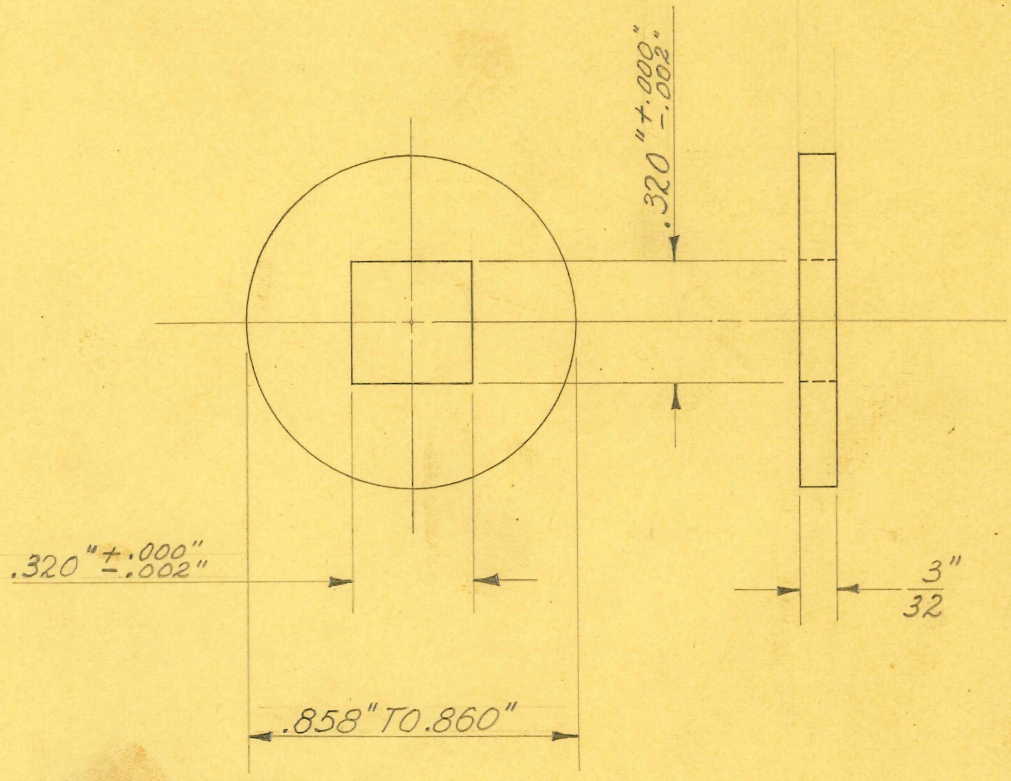

SCALE ÷ DOUBLE SIZE

1 REQUIRED

OBSOLETE
4-22-80 J.S

SIZE	3/32" SHEET	ISSUE 8-19-38	J.W.
KIND	C.R. STEEL	CHANGED	
SHAPE		"	
FINISH		"	
TEMP.		"	
PATT.		"	

TITLE: SHORT WAVE INDUCTION COIL ELECT. ARM SPRING TENSION ADJ. ROD LOCATING WASHER

H. G. FISCHER & CO.
2335 WABANSIA AVE.
CHICAGO, ILL.

CAT. NO.

PART NO. 12013

TITLE
SHORT WAVE INDUCTION COIL
ELECTRODE ARM SWIVEL BASE

H. G. FISCHER & CO.
FRANKLIN PARK, ILLINOIS

PART NO. 12015 AF

PATTERN	FINISH	SCALE
		FULL

MATERIAL

TOOLS
CINT. AIR VISE JAWS # 12015

DATE 12-14-67 | DR. BY RSB | CH'K'D. RCT

DIMENSIONS—UNLESS OTHERWISE SPECIFIED:

FRACTIONAL	± .015	THREAD CHAMFER
DECIMAL	± .005	UP TO 5/16 D.-1/32 X 45°
ANGULAR	± 1/2°	3/8 D. & OVER - 1/16 X 45°

REMOVE ALL BURRS & SHARP CORNERS

USED ON	QTY.	USED ON	QTY.
12023 G	1		

	REVISION	DATE	BY
A	29 (.136) DRILL THROUGH 8-32 TAP BULL. #438 ORIGINAL DWG LOST MADE NEW DWG.	12-14-67	RSB

OBSOLETE
4-22-80 J.S.

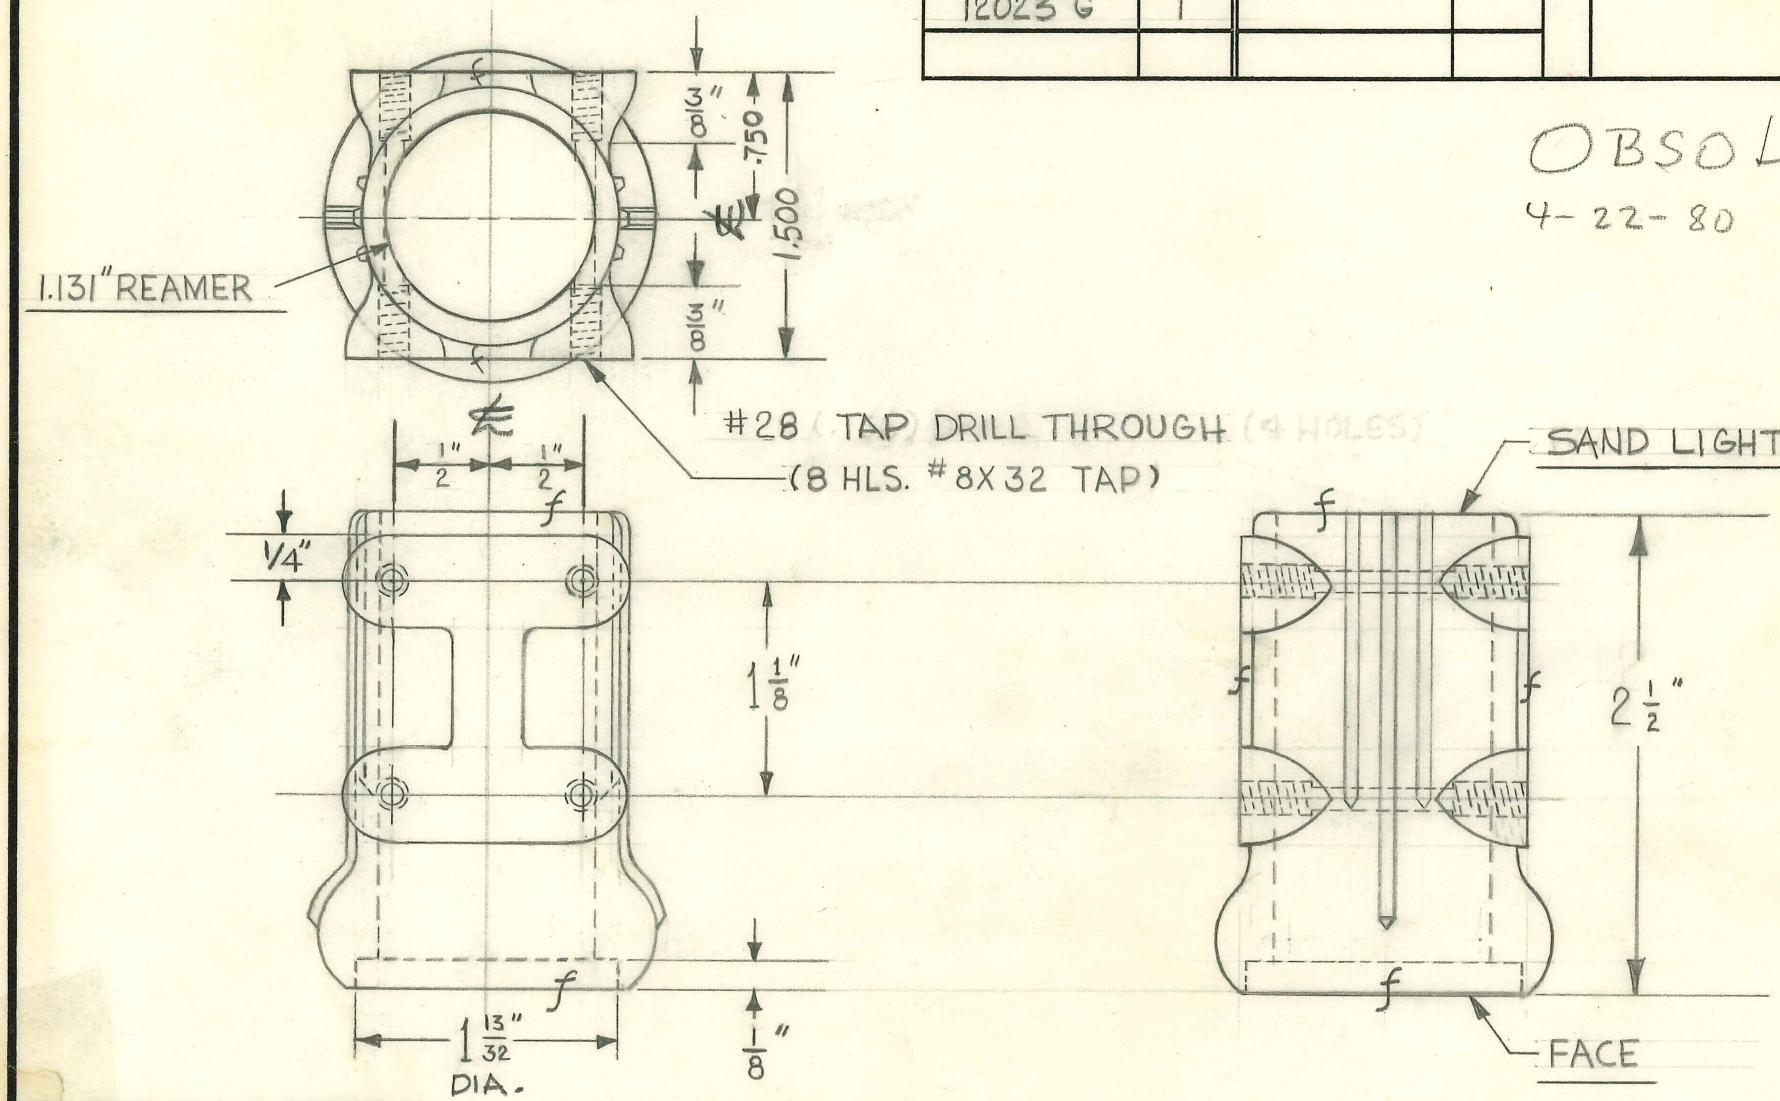

DO NOT SCALE DRAWING.

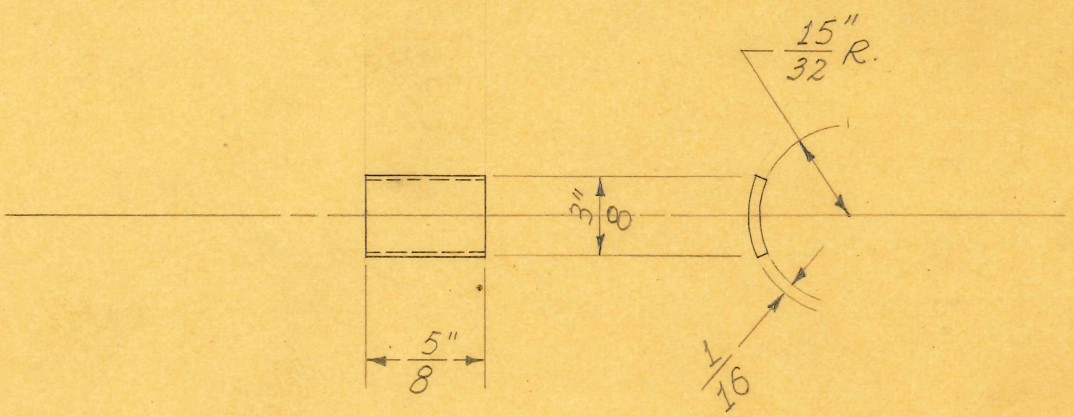

2 REQUIRED

OBSOLETE
4-22-80

#16 GA. (.060") C.R. STEEL (BLANK SIZE .363" X 5/8")

SIZE	~~1/16 O.D. x .932 I.D.~~	ISSUE 7-22-38	J.W.
KIND	~~SHELBY STEEL~~	CHANGED	
SHAPE	~~TUBING~~	"	
FINISH		"	
TEMP.		"	
PATT.		"	

TITLE: SHORT WAVE INDUCTION COIL ELECTRODE ARM. SPRING RETAINING TUBE LOCATING PIECE

H. G. FISCHER & CO.
2335 WABANSIA AVE.
CHICAGO, ILL.

CAT. NO.

PART NO. 12017

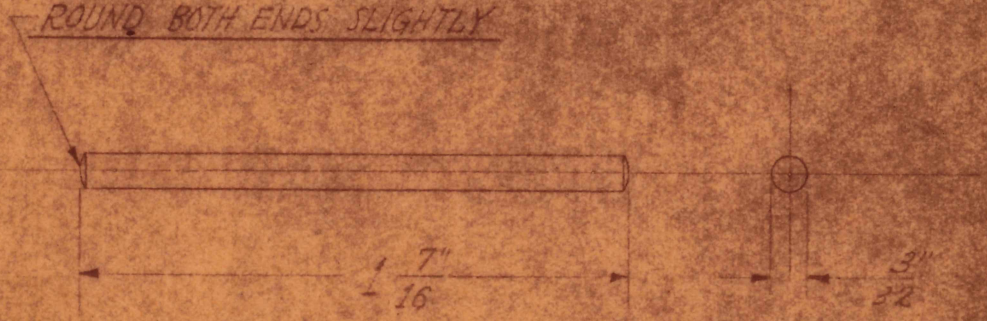

OBSOLETE
4-22-80 J.S.

SCALE ~ 2 DIAMETERS

1 REQUIRED

SIZE	3/32 DIAM.	ISSUED 5-30-39	J.W.
KIND	C.R. STEEL	CHANGED	
SHAPE	ROD	"	
FINISH	CAD. #23	"	
TEMP.		"	
PATT.		"	

TITLE: SHORT WAVE INDUCTION COIL ELECT. ARM CHAIN SUPPORT PIN

H. G. FISCHER & CO.
2336 WABANSIA AVE.
CHICAGO, ILL.

CAT. NO.

PART NO. 12029

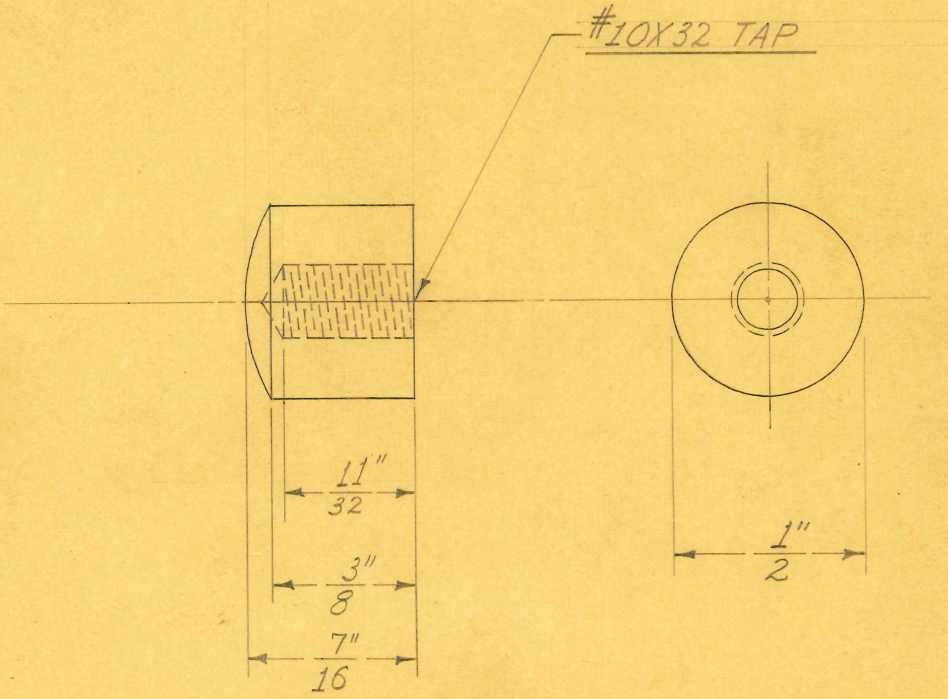

SCALE ÷ 2 DIAMETERS

1 REQUIRED

OBSOLETE

4-22-80 J.S

KS.

SIZE	½" DIAM.	ISSUE 8-31-38	J.W.	**TITLE:** SHORT WAVE INDUCTION COIL ELECTRODE ARM HEAD SWIVEL SCREW-END CAP
KIND	BLK. BAKELITE	CHANGED		
SHAPE	ROD	"		
FINISH	POL. & BUFF	"		
TEMP.		"		
PATT.		"		

H. G. FISCHER & CO.
2335 WABANSIA AVE.
CHICAGO, ILL.

CAT. NO.

PART NO. 12022

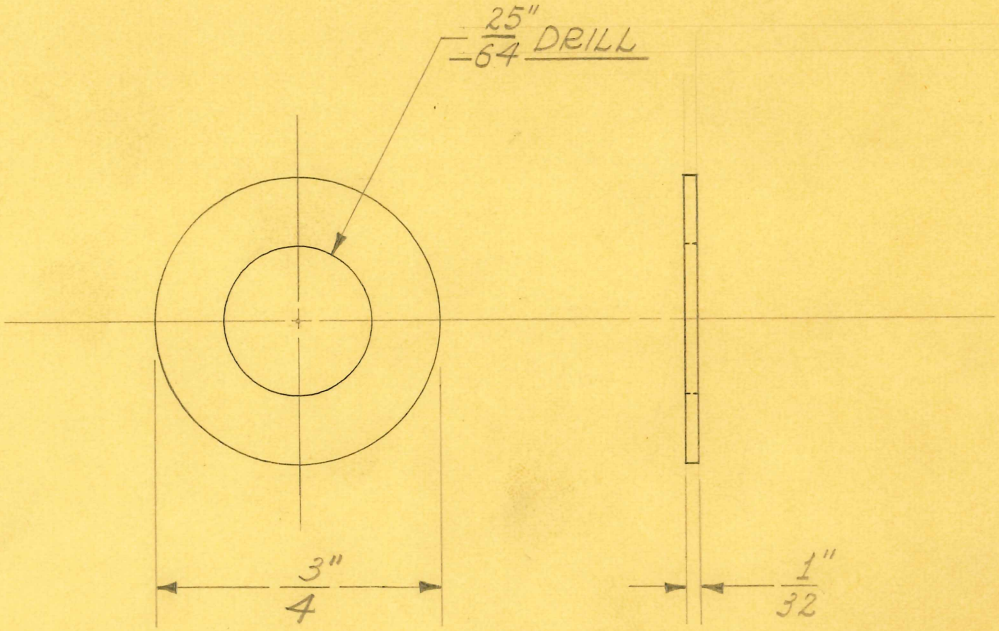

SCALE ÷ 2 DIAMETERS

1 REQUIRED

OBSOLETE
4-22-80 J.S.

BLANK & PERF. DIE #1384

1/32" SHEET STAINLESS STEEL

SIZE	2½" DIAM.	ISSUE 9-1-38	J.W.
KIND	BLANK	CHANGED	
SHAPE	FOR	"	
FINISH	USE	"	
TEMP.	ON	"	
PATT.	LY	"	

TITLE:
SHORT WAVE INDUCTION COIL ELECTRODE ARM
SWIVEL CLAMP WASHER

H. G. FISCHER & CO.
2335 WABANSIA AVE.
CHICAGO, ILL.

CAT. NO.

PART NO. 12024

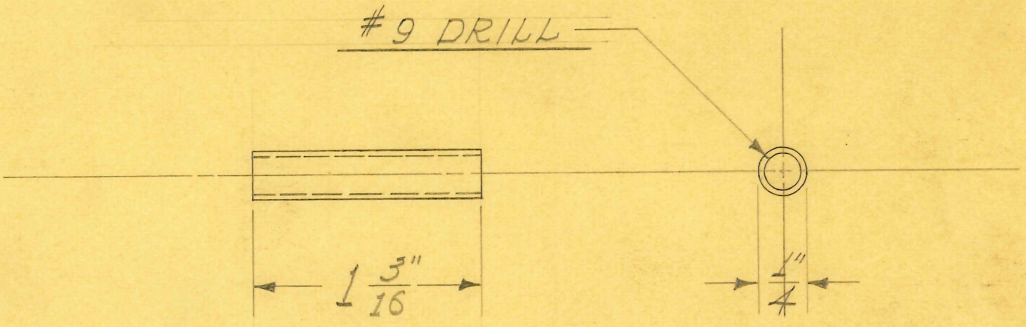

1 REQUIRED

OBSOLETE

4-22-80 J.S

SIZE	1/4" O.D. X 3/16" I.D.	ISSUE 9-7-38	J.W.
KIND	BRASS TUBING	CHANGED	
SHAPE		"	
FINISH		"	
TEMP.		"	
PATT.		"	

TITLE: SHORT WAVE INDUCTION COIL ELECT. ARM HEAD SWIVEL-BUSHING

H. G. FISCHER & CO.
2335 WABANSIA AVE.
CHICAGO, ILL.

CAT. NO.

PART NO. 12030

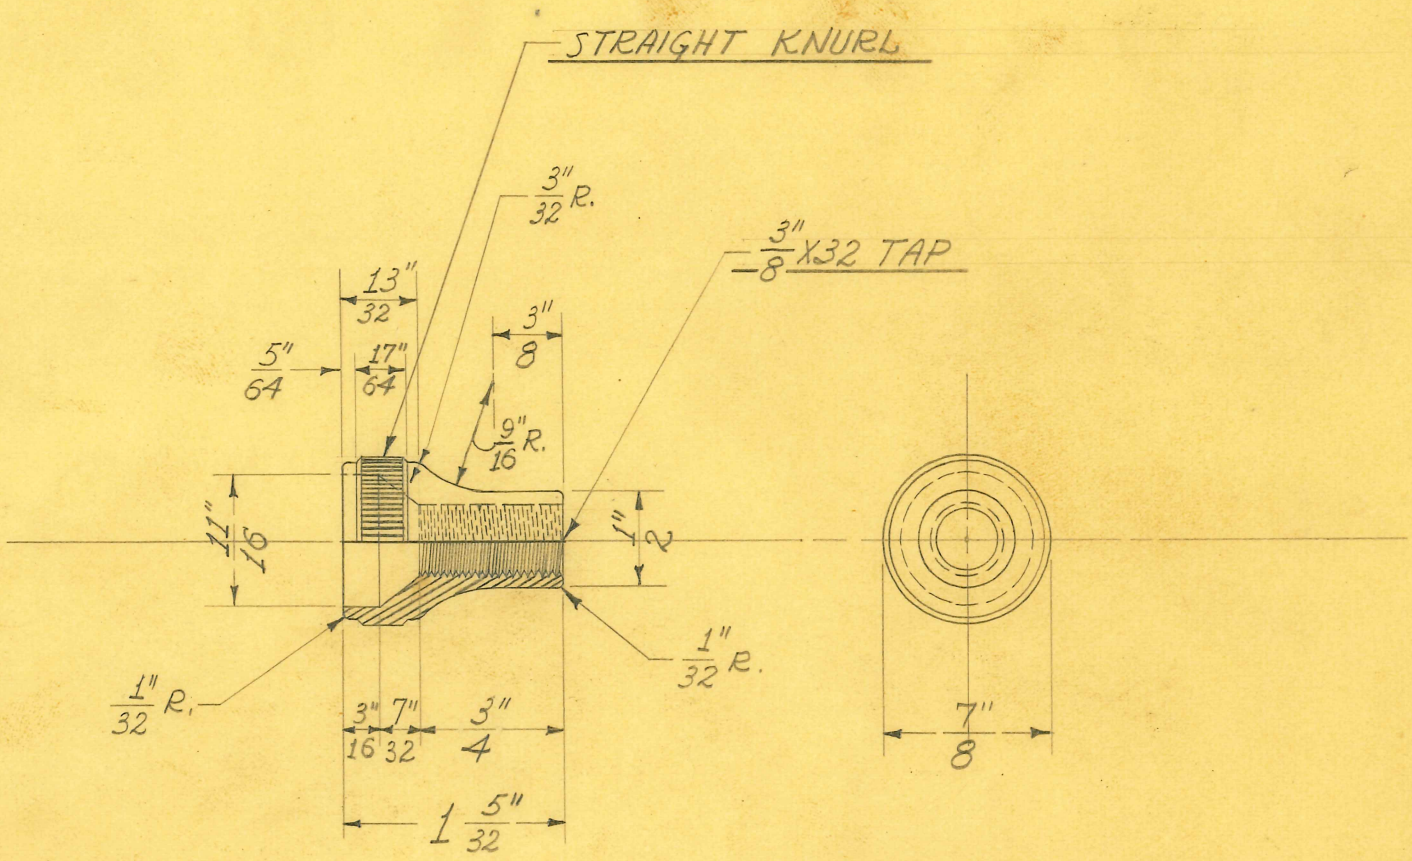

2 REQUIRED

OBSOLETE

4-22-80 J.S.

SIZE	7/8" DIAM.	ISSUE 9-12-38	J.W.	**TITLE:** SHORT WAVE INDUCTION COIL ELECTRODE CORD TIP SLEEVE
KIND	HARD RUBBER	CHANGED		
SHAPE	ROD	"		
FINISH	POL. & BUFF	"		
TEMP.		"		
PATT.		"		

H. G. FISCHER & CO.
2335 WABANSIA AVE.
CHICAGO, ILL.

CAT. NO.

PART NO. 12033

TITLE: SHORT WAVE IND. COIL ELECT. ARM HEAD SWIVEL WASHER	H. G. FISCHER & CO. FRANKLIN PARK, ILLINOIS	PART NO. 12035	
	DATE 9-16-48 DR. BY J.V.W. CH'K'D.	REVISION	DATE BY
PATTERN	FINISH CAD. # 23	SCALE FULL	DIMENSIONS: FRACTIONAL ± .015; DECIMAL ± .005; ANGULAR ± ½°; UNLESS OTHERWISE SPECIFIED
TOOLS: BLANKING & PERF. DIE #8484	MATERIAL: #18GA.(.048") SHEET C.R. STEEL		

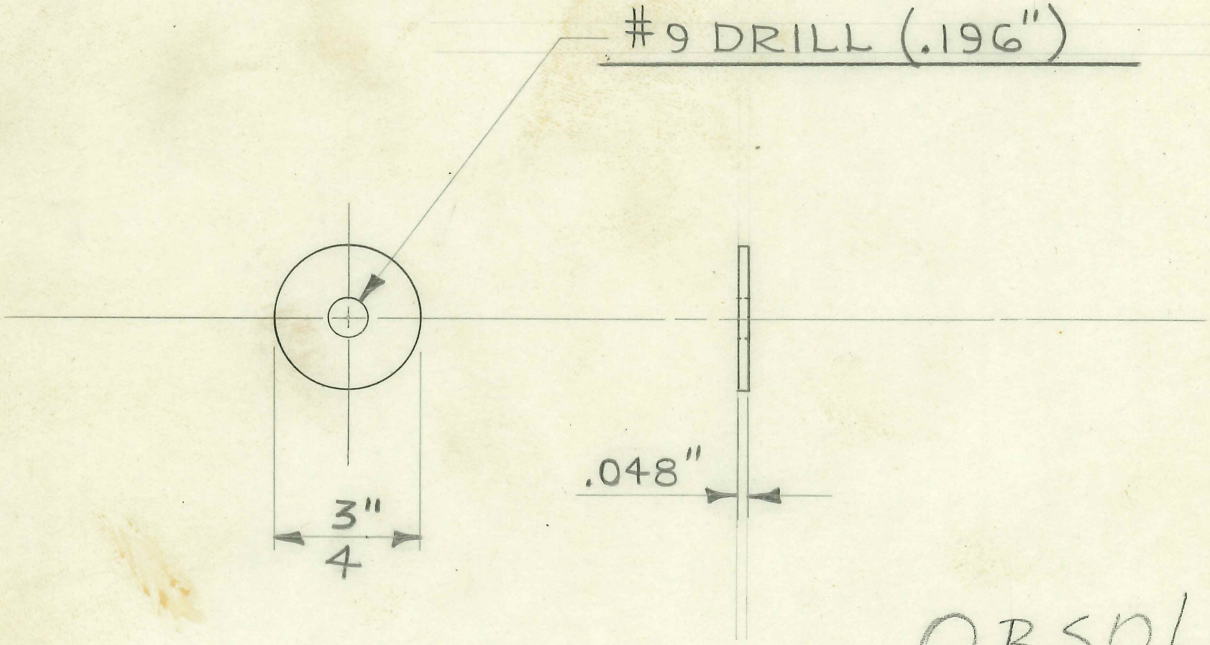

OBSOLETE
4-22-80 J.S.

1 REQUIRED

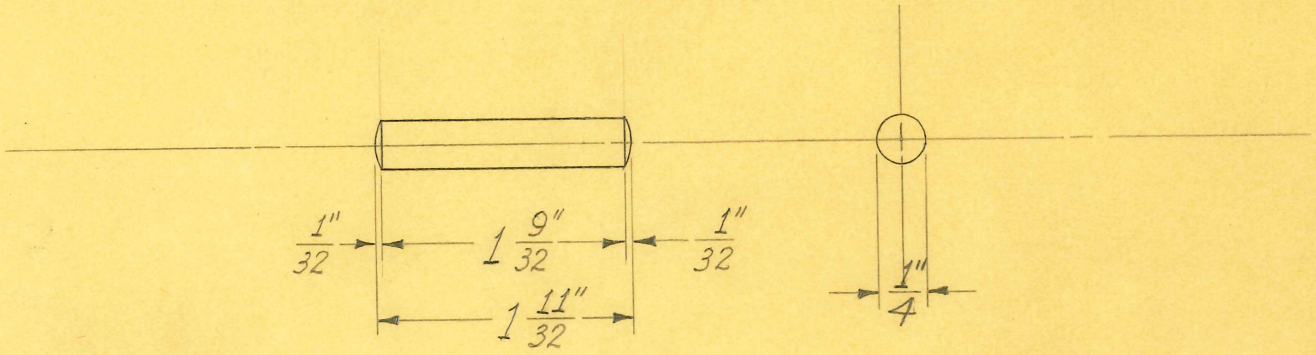

1 REQUIRED

OBSOLETE
4-22-80 J.S

SIZE	1/4" DIAM.	ISSUE 9-21-38	J.W.
KIND	BAKELITE ROD	CHANGED	
SHAPE		"	
FINISH	POL. & BUFF BOTH ENDS	"	
TEMP.		"	
PATT.		"	

TITLE: SHORT WAVE INDUCTION COIL ELECT. ARM HEAD SWIVEL PIN

H. G. FISCHER & CO.
2338 WABANSIA AVE.
CHICAGO, ILL.

CAT. NO.

PART NO. 12036

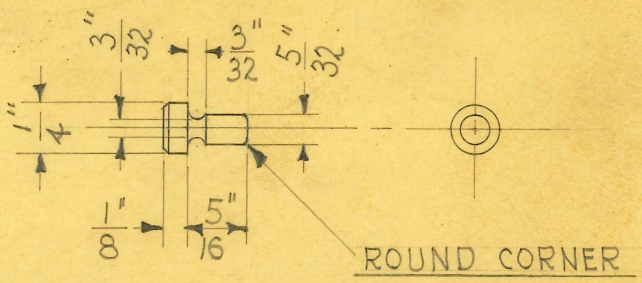

1 REQUIRED

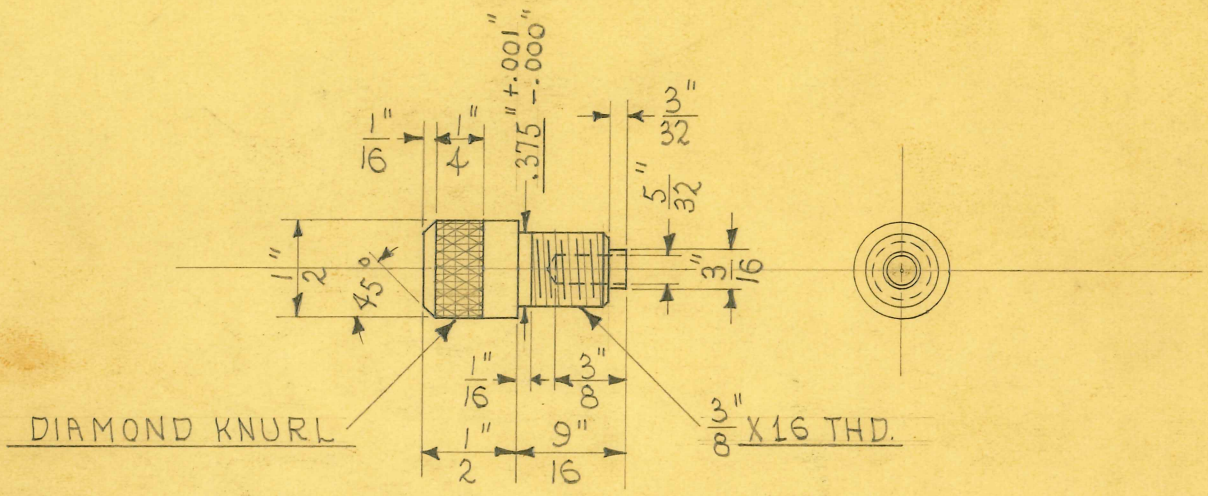

1 REQUIRED

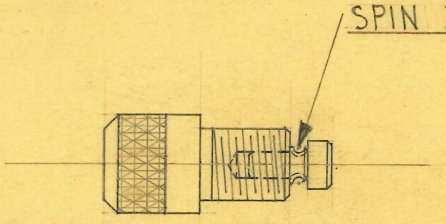

OBSOLETE
4-22-80 J.S

1 REQUIRED

SIZE	1/2" & 1/4"	ISSUE 9-26-38	H.E.
KIND	BRASS ROD	CHANGED	
SHAPE		"	
FINISH	CAD.#23	"	
TEMP.		"	
PATT.		"	

TITLE: SHORT WAVE INDUCTION COIL ELECT. ARM-UPRIGHT TUBE CLAMP KNOB-INSERT

H. G. FISCHER & CO.
2335 WABANSIA AVE.
CHICAGO, ILL.

CAT. NO.

PART NO. 12037G

TITLE
SHORT WAVE IND. COIL ELECT. ARM
HEAD SWIVEL SHAFT

H. G. FISCHER & CO.
FRANKLIN PARK, ILLINOIS

DATE 9-16-48 DR. BY J.V.W. CH'K'D.

PART NO. 12040

REVISION	DATE	BY

PATTERN | FINISH | SCALE FULL

TOOLS | MATERIAL $\frac{1}{4}$" DIA. SCREW STOCK

DIMENSIONS
FRACTIONAL ± .015
DECIMAL ± .005
ANGULAR ± ½°
UNLESS OTHERWISE SPECIFIED

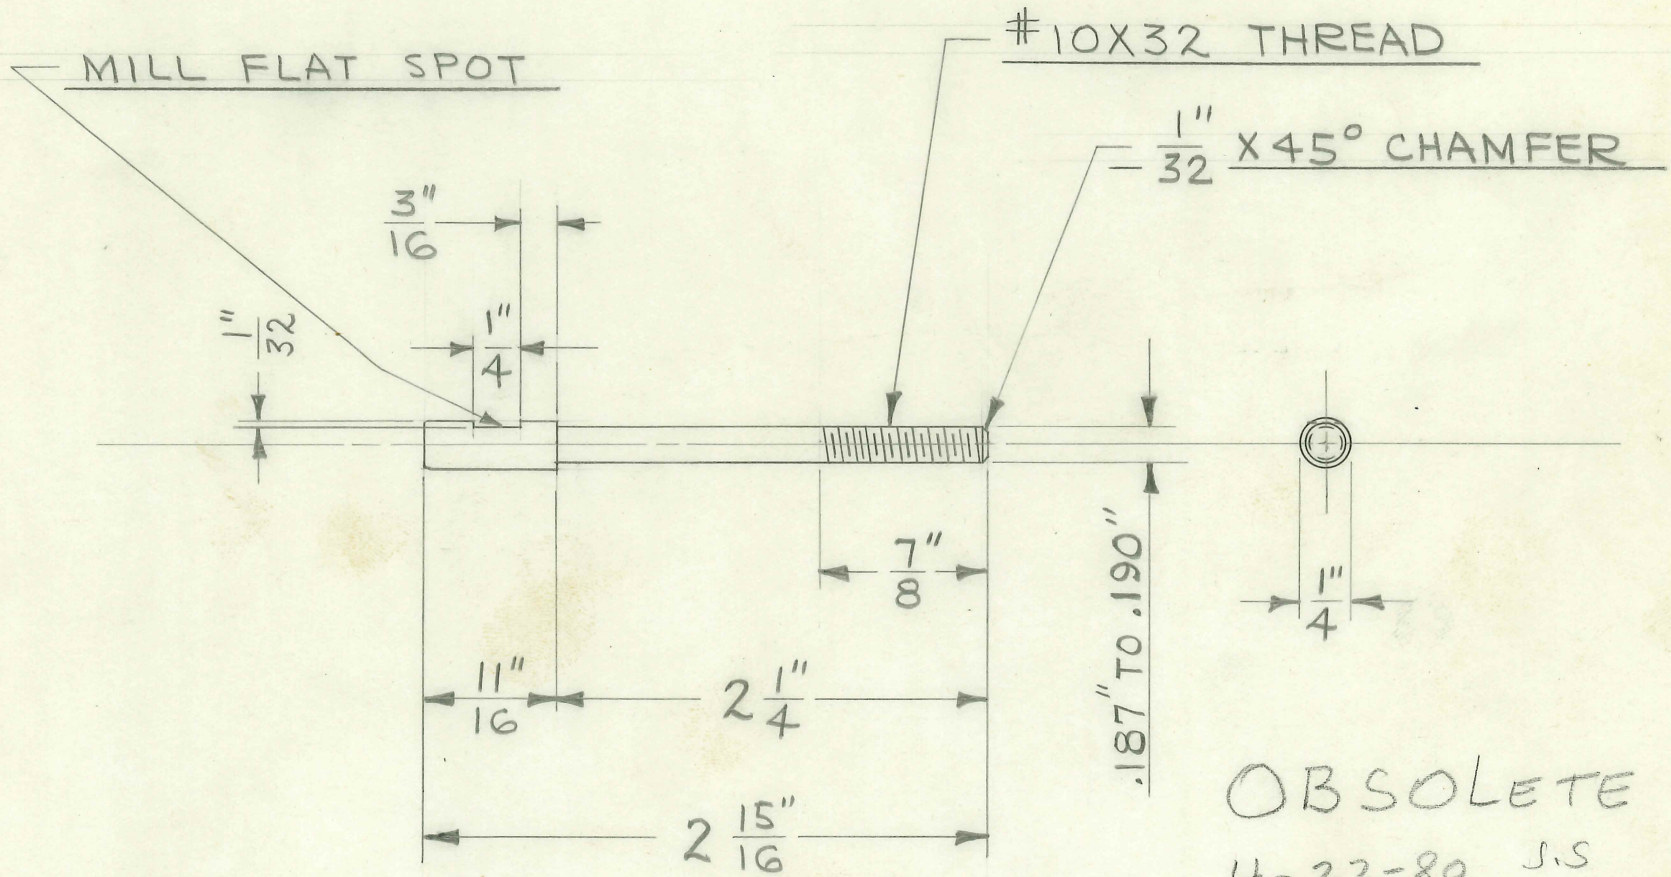

OBSOLETE
4-22-80 J.S

1 REQUIRED

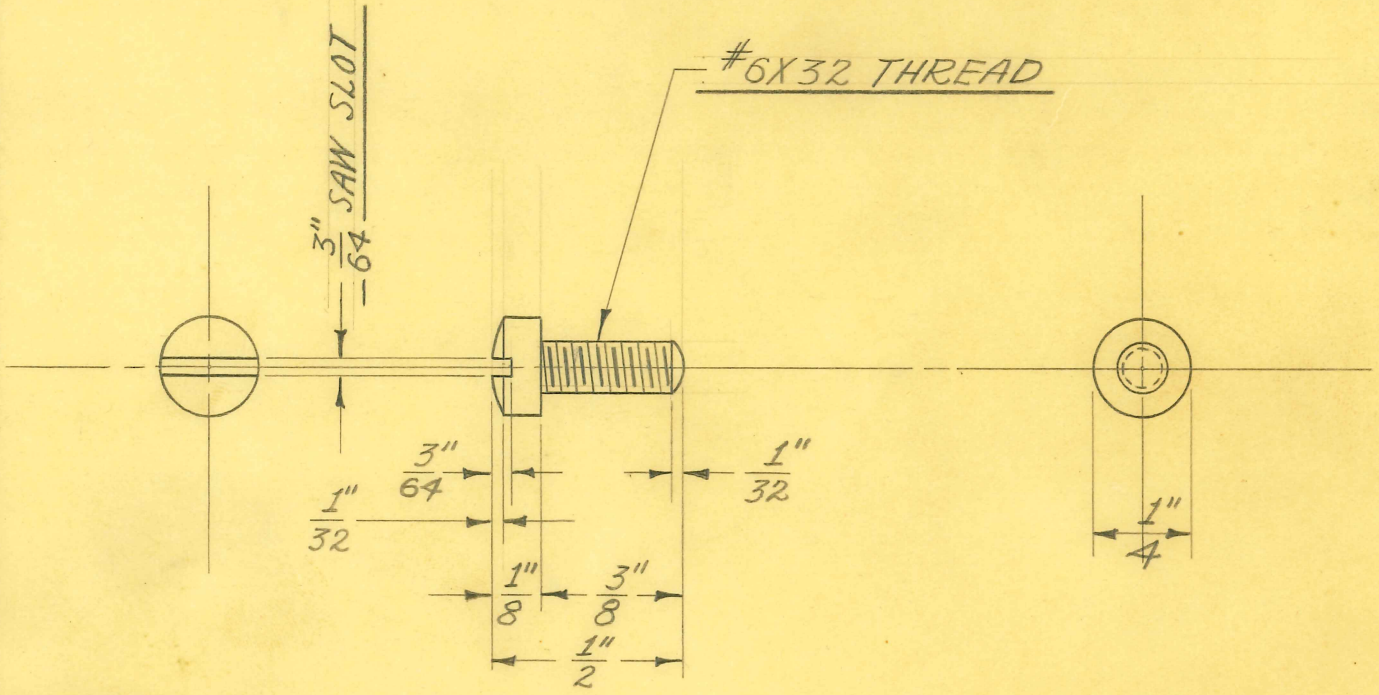

SCALE ~ DOUBLE SIZE

OBSOLETE

4-22-80 J.S.

RWS

SIZE	1/4" DIAM.	ISSUE 5-16-39	J.W.
KIND	BLK. FIBRE	CHANGED	
SHAPE	ROD	"	
FINISH		"	
TEMP.		"	
PATT.		"	

TITLE: FISCHER SHORT WAVE IND. COIL ELECTRODE HOUSING - FIBRE SCREW

H. G. FISCHER & CO.
2335 WABANSIA AVE.
CHICAGO, ILL.

CAT. NO.

PART NO. 12042

TITLE SHORT WAVE INDUCTION COIL
FRICTION BODY

H. G. FISCHER & CO.
FRANKLIN PARK, ILLINOIS

PART NO. 12045

DATE 4-28-65 | DR BY T. T | CH'K'D. RS

REVISION	DATE	BY

PATTERN | FINISH NONE | SCALE FULL

DIMENSIONS
FRACTIONAL ± .015
DECIMAL ± .005
ANGULAR ± ½°
UNLESS OTHERWISE SPECIFIED

TOOLS | MATERIAL 1" DIA. RD. BRASS ROD

SAE 72

USED ON	QTY.
11996G	1

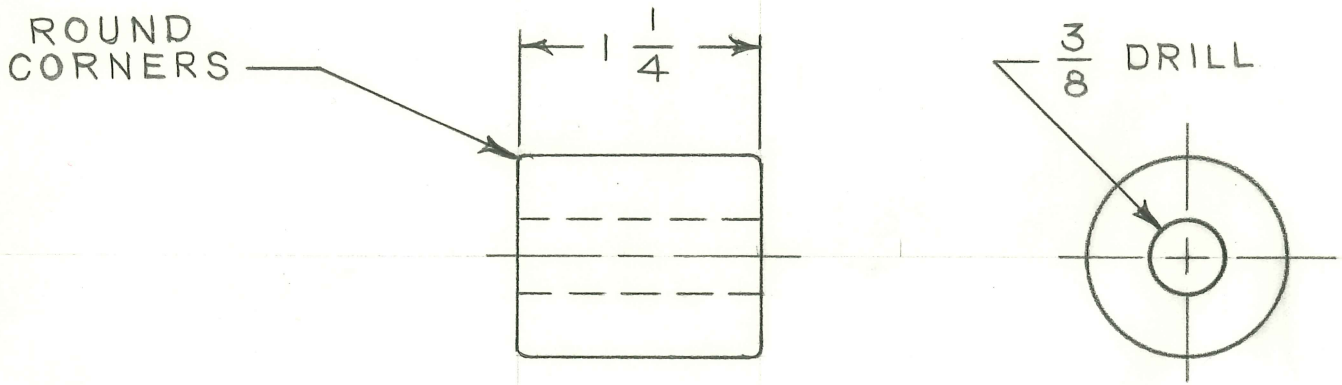

OBSOLETE
4-22-80 J.S.

TITLE

SHORT WAVE INDUCTION COIL

FRICTION BODY STUD

H. G. FISCHER & CO.
FRANKLIN PARK, ILLINOIS

PART NO. 12046

DATE	DR BY	CH'K'D.
4-28-65	T. T.	RS

REVISION	DATE	BY

PATTERN	FINISH	SCALE
	NONE	FULL

DIMENSIONS
FRACTIONAL ± .015
DECIMAL ± .005
ANGULAR ± ½°
UNLESS OTHERWISE SPECIFIED

TOOLS

MATERIAL
3/8 SQ. BRASS ROD
S.A.E. 72

USED ON	QTY.
11996G	1

OBSOLETE
4-22-80 JS

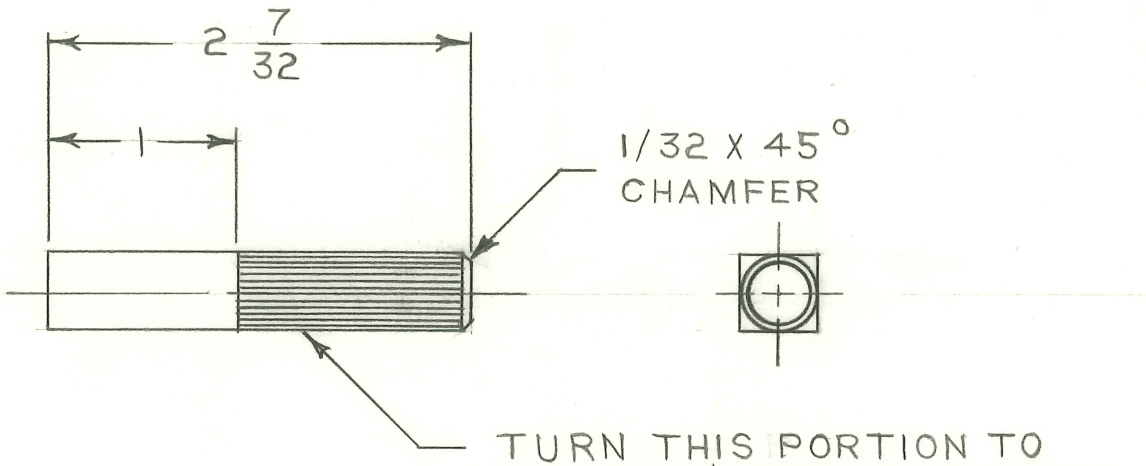

REMOVE ALL BURRS

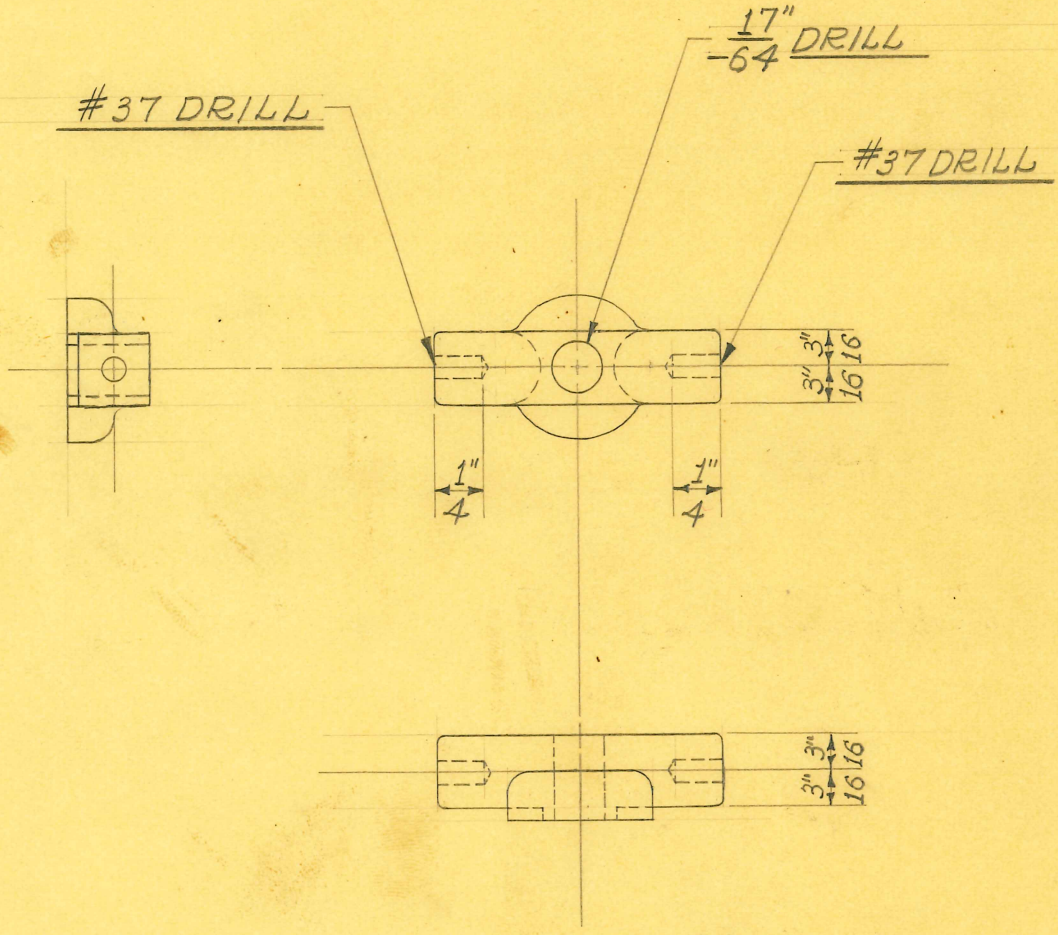

2 REQUIRED

OBSOLETE
4-22-80 d.s.

SIZE		ISSUE 9-20-38	J.W.
KIND	BRASS CASTING	CHANGED	
SHAPE		"	
FINISH	DIP #7	"	
TEMP.		"	
PATT.	6848-802	"	

TITLE:
FISCHER MOD. "M" SHORT WAVE
GRID COIL SUPPORT

H. G. FISCHER & CO.
2335 WABANSIA AVE.
CHICAGO, ILL.

CAT. NO.

PART NO. 12073

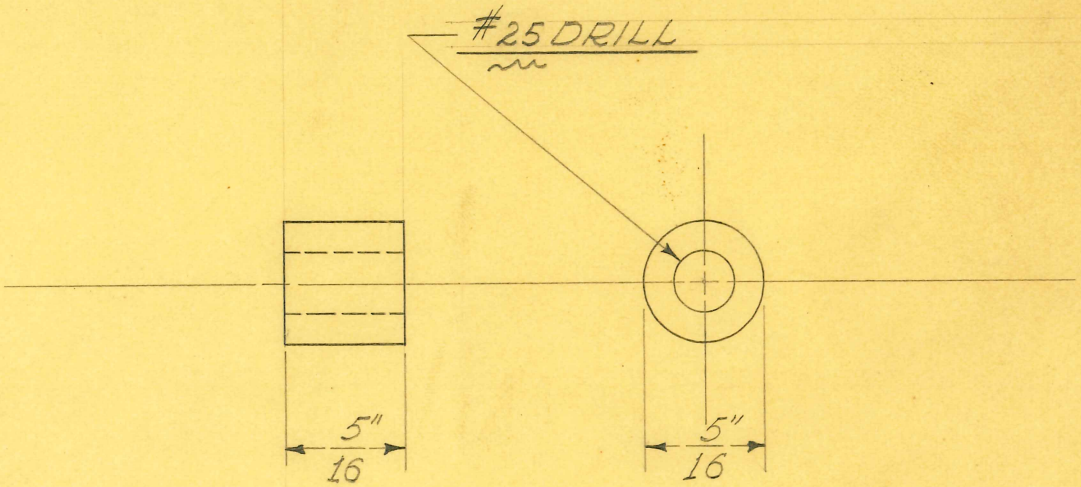

SCALE ~ 2 DIAMETERS

10 REQUIRED

ONE

OBSOLETE
4-22-80 JS

SIZE	5/16" DIAM.	ISSUE 10-24-38	J.W.	TITLE: FISCHER MOD. "M" – BY-PASS CONDENSER STATOR PLATE SPACER – LARGE
KIND	BRASS ROD	CHANGED		
SHAPE		"		
FINISH	DIP #7	"		
TEMP.		"		
PATT.		"		

H. G. FISCHER & CO.
2335 WABANSIA AVE.
CHICAGO, ILL.

CAT. NO.

PART NO. 12081

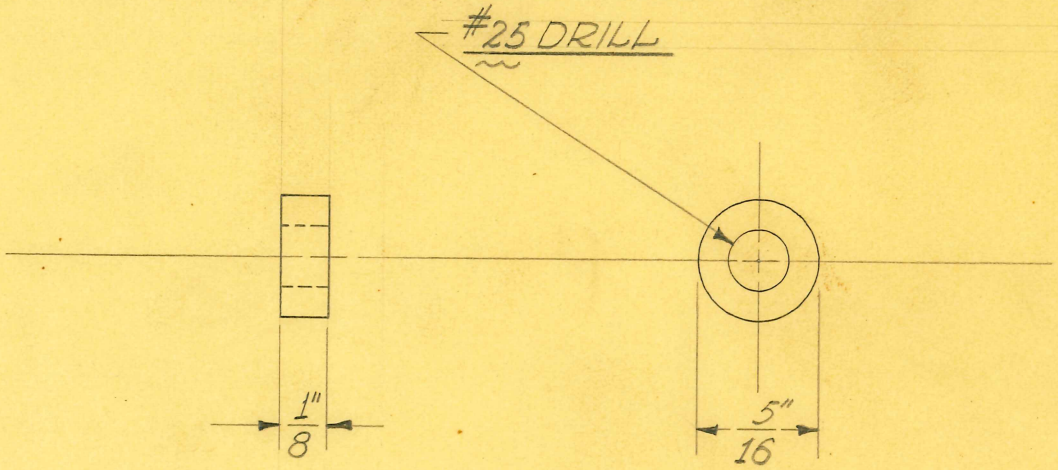

SCALE ~ 2 DIAMETERS

6 REQUIRED

OBSOLETE
4-22-86 JS.

SIZE	5/16" DIAM.	ISSUE 10-24-38	J.W.
KIND	BRASS ROD	CHANGED	
SHAPE		"	
FINISH	DIP #7	"	
TEMP.		"	
PATT.		"	

TITLE: FISCHER MOD. "M" - BY-PASS CONDENSER STATOR PLATE SPACER - SHORT

H. G. FISCHER & CO.
2335 WABANSIA AVE.
CHICAGO, ILL.

CAT. NO.

PART NO. 12082

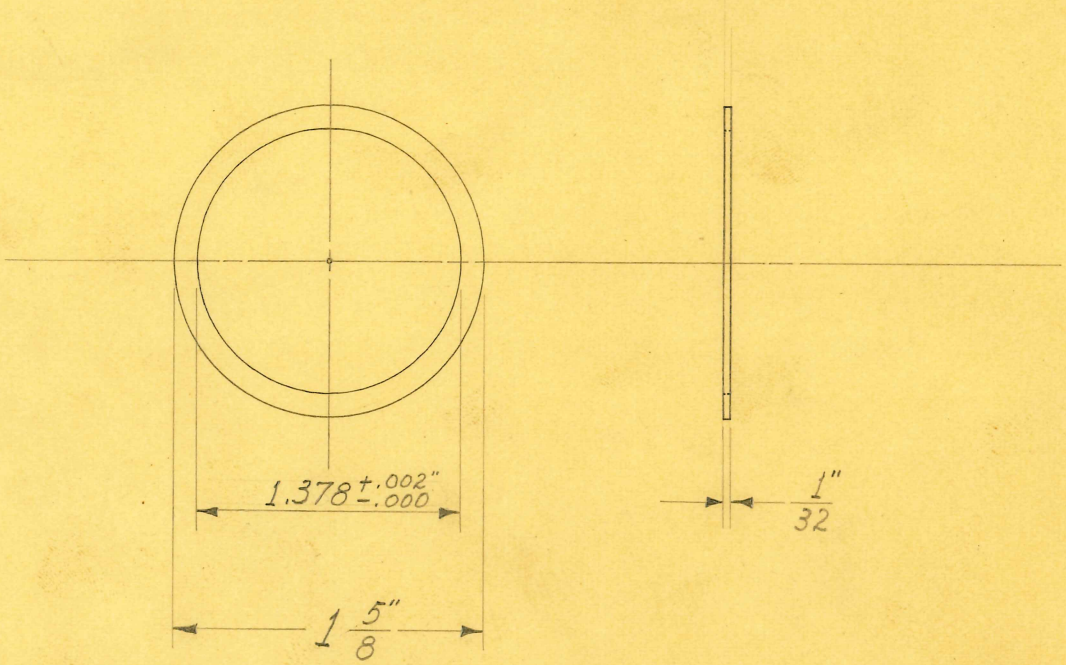

1 REQUIRED

OBSOLETE
4-22-80 J.S

SIZE	1/32" SHEET	ISSUE 8-19-38	J.W.
KIND	BLACK FIBRE	CHANGED	
SHAPE		"	
FINISH		"	
TEMP.		"	
PATT.		"	

TITLE:
SHORT WAVE INDUCTION COIL ELECT. ARM
UPRIGHT TUBE CUSHION WASHER

H. G. FISCHER & CO.
2335 WABANSIA AVE.
CHICAGO, ILL.

CAT. NO.

PART NO. 12011

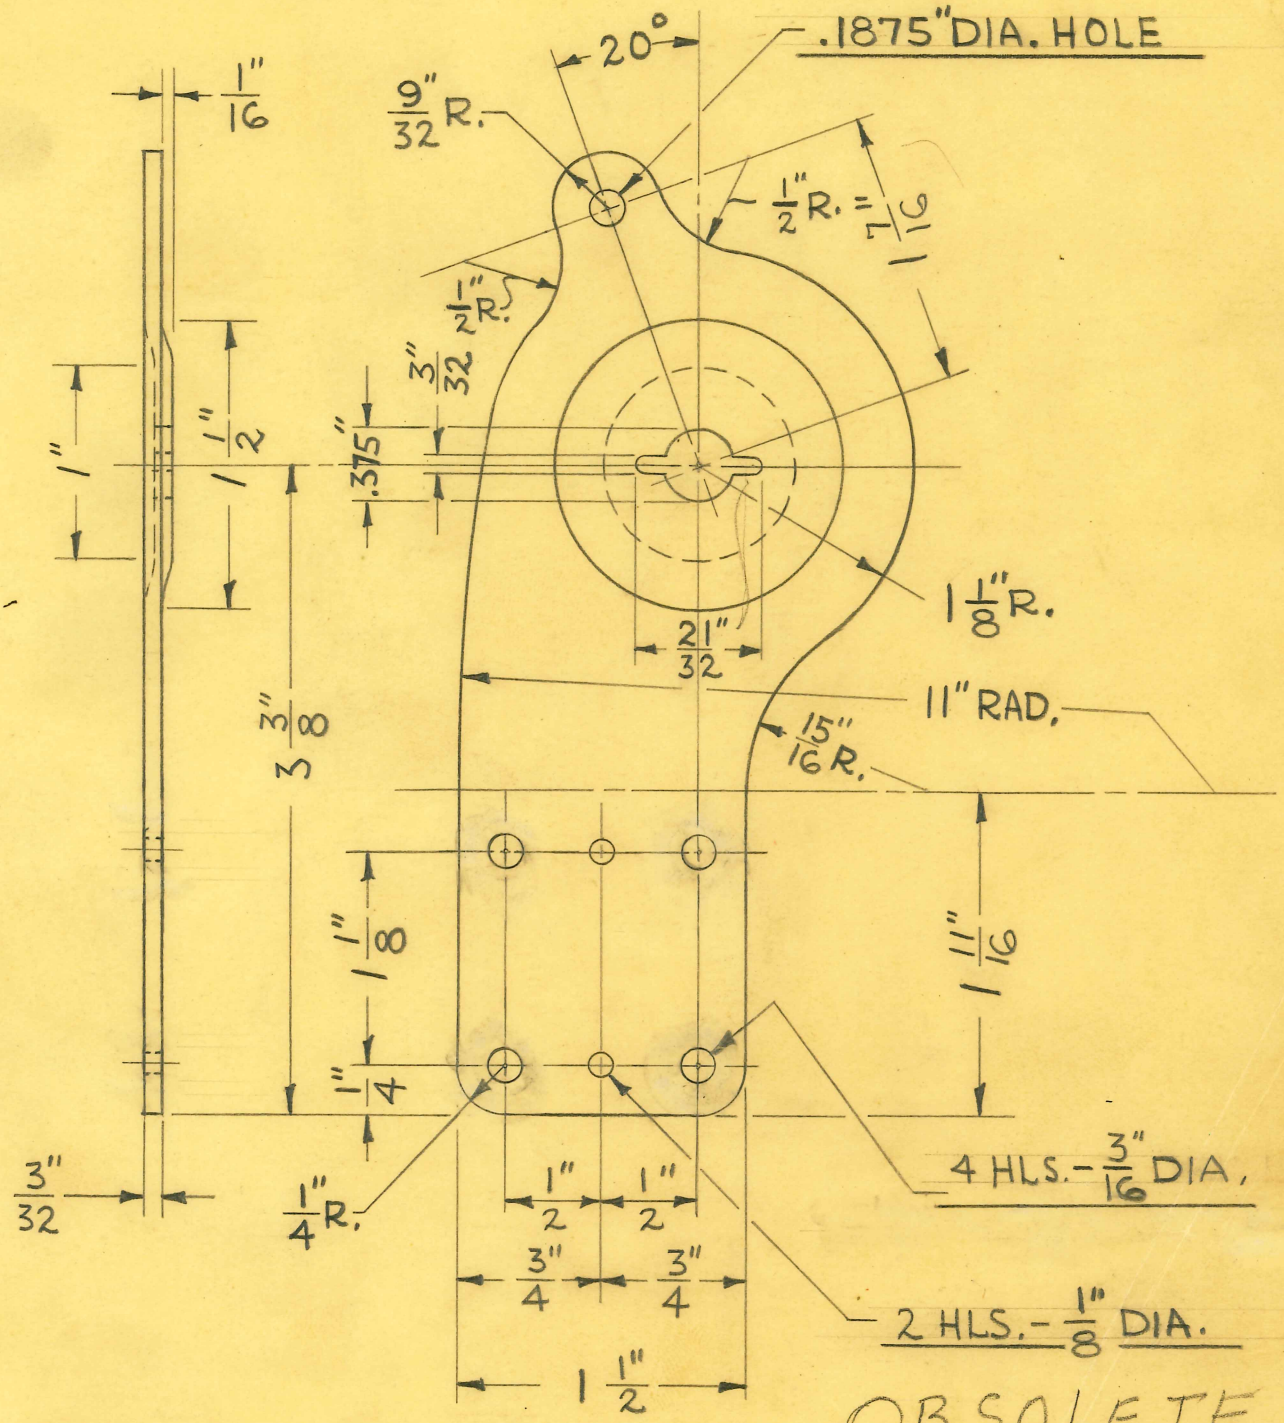

OBSOLETE
4-22-80 J.S.

1 REQUIRED

SIZE	3/32" SHEET	ISSUE 4-5-46	J.V.W.
KIND	H.H.C.R. STEEL	CHANGED	
SHAPE		"	
FINISH		"	
TEMP.		"	
PATT.		"	

TITLE:
SHORT WAVE INDUCTION COIL ELECT. ARM SWIVEL SUPP.-LEFT

H. G. FISCHER & CO.
2335 WABANSIA AVE.
CHICAGO, ILL.

CAT. NO.

PART NO. 11981A

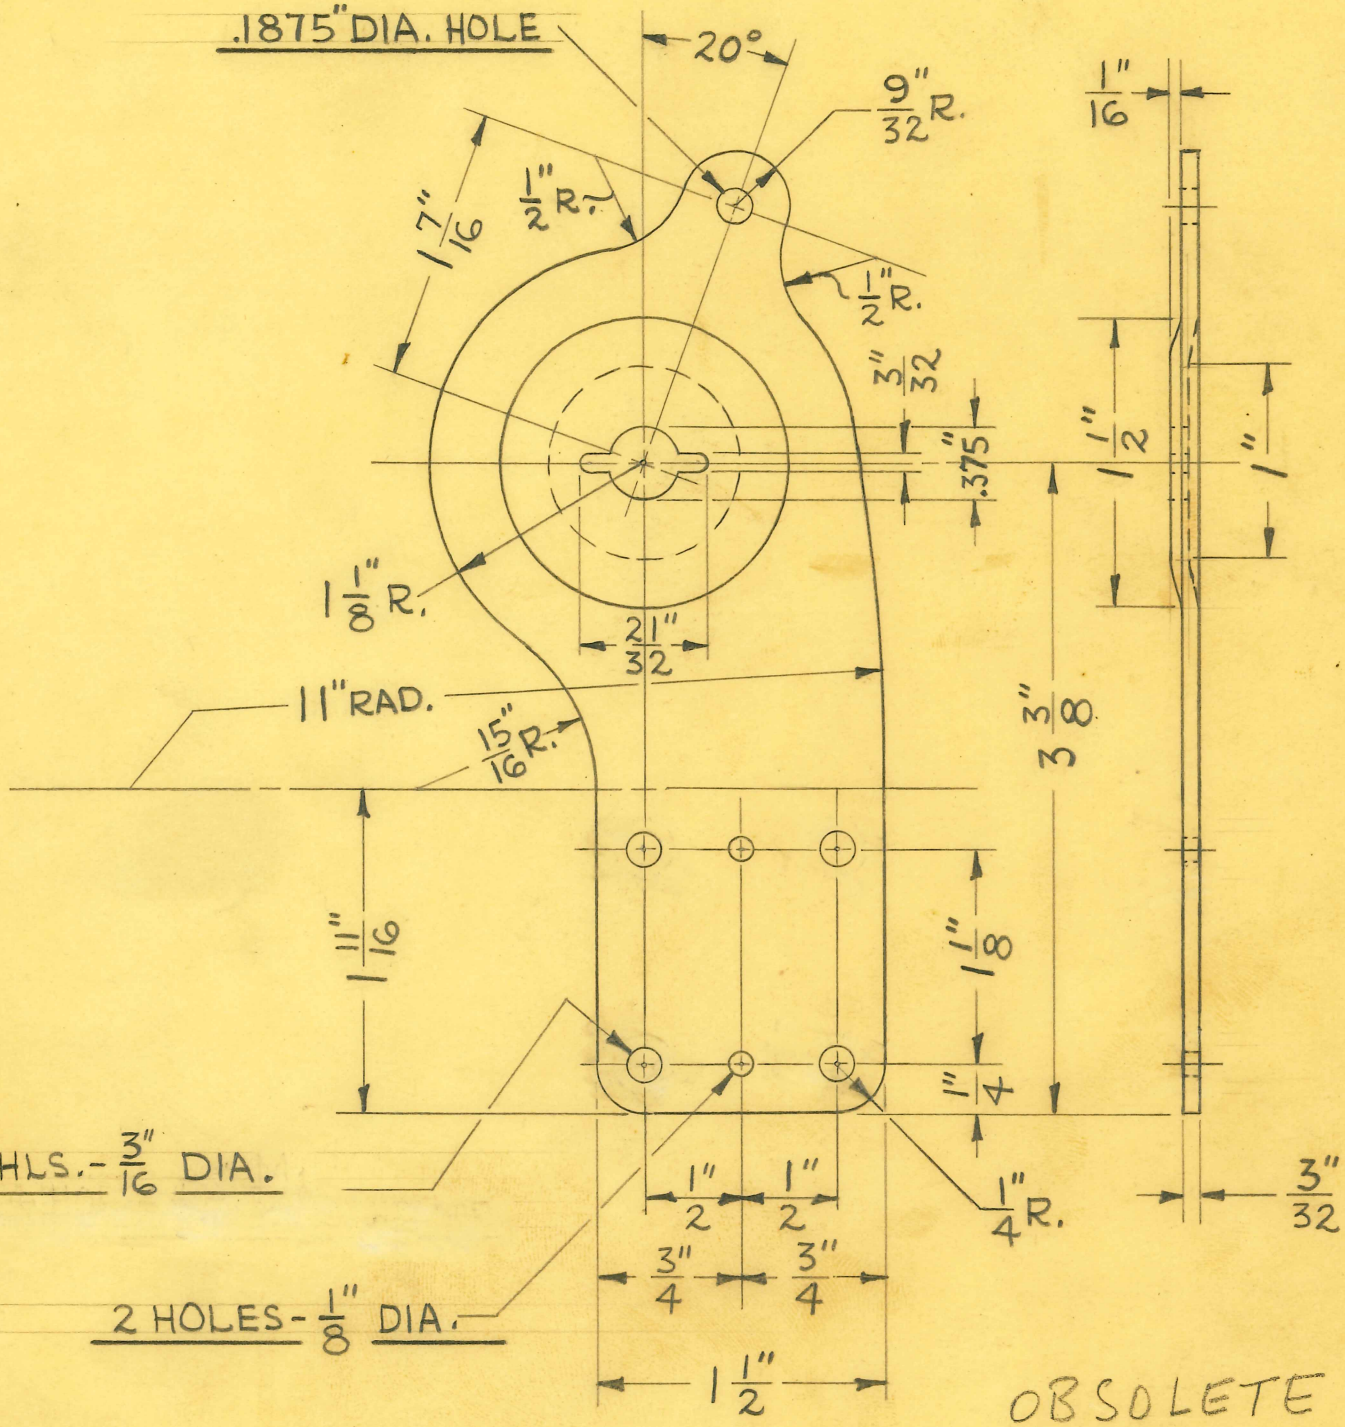

OBSOLETE
4-22-80

1 REQUIRED

SIZE	3/32" SHEET	ISSUE 4-5-46	J.V.W.
KIND	H.H. C.R. STEEL	CHANGED	
SHAPE		"	
FINISH		"	
TEMP.		"	
PATT.		"	

TITLE:
SHORT WAVE INDUCTION COIL ELECTRODE
SWIVEL SUPPORT - RIGHT

H. G. FISCHER & CO.
2335 WABANSIA AVE.
CHICAGO, ILL.

CAT. NO.

PART NO. 11982A

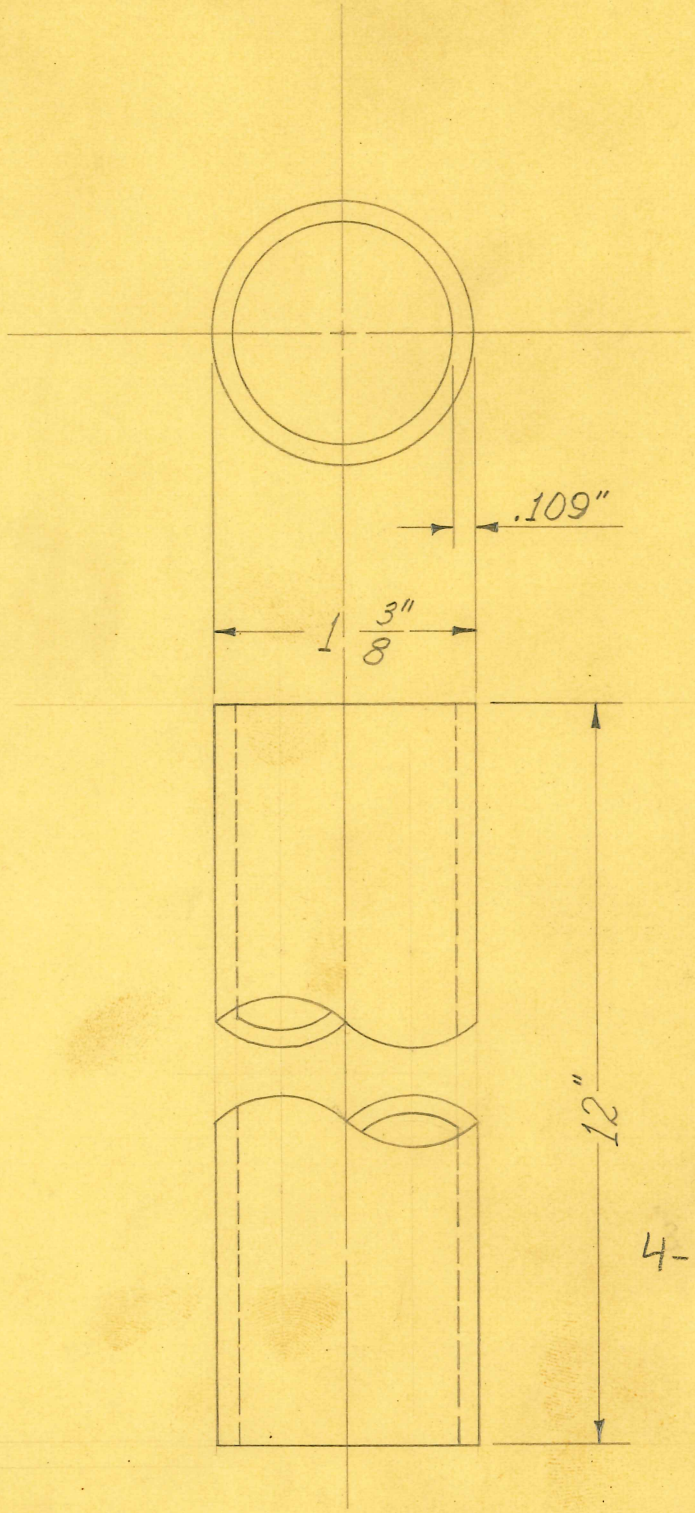

OBSOLETE
4-22-80 J.S.

1 REQUIRED

1 3/8" O.D. X #12 BIR. GA. (.109") WALL SHELBY SEAMLESS STEEL TUBING

SIZE		ISSUE 7-21-38	J.W.
KIND		CHANGED	
SHAPE		"	
FINISH	CHROME #2	"	
TEMP.		"	
PATT.		"	

TITLE: SHORT WAVE INDUCTION COIL ELECT. ARM-UPRIGHT TUBE

H. G. FISCHER & CO.
2335 WABANSIA AVE.
CHICAGO, ILL.

CAT. NO.

PART NO. 11983

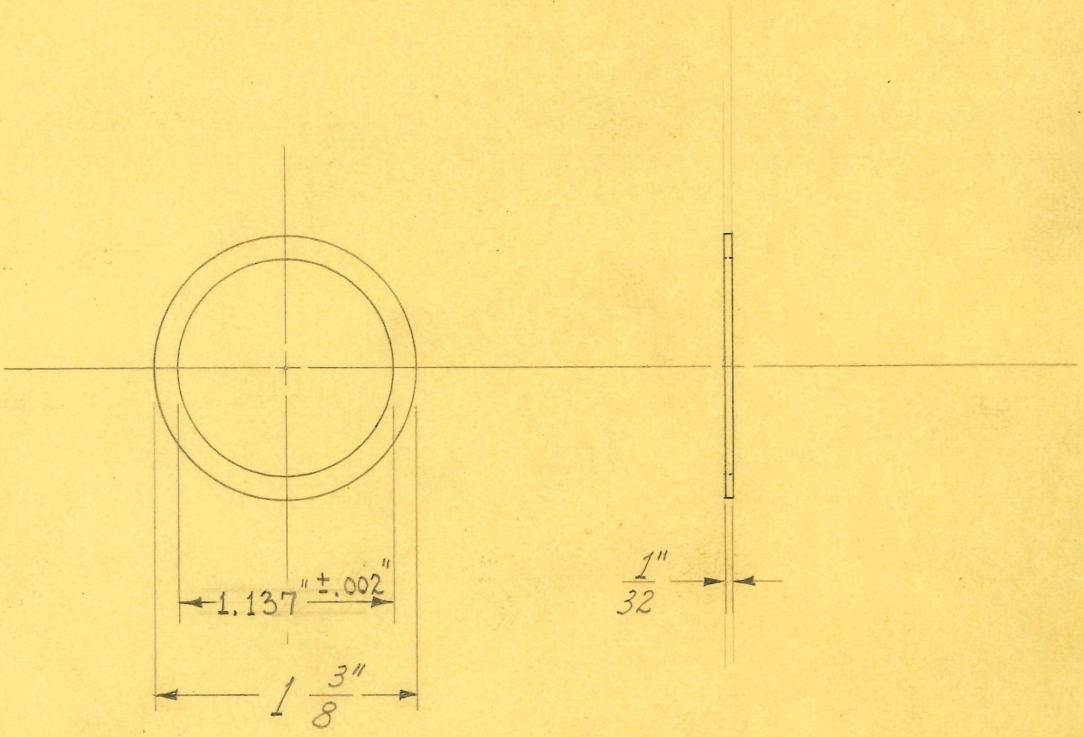

1 REQUIRED

OBSOLETE
4-22-80 J.S

SIZE	1/32" SHEET	ISSUE 7-22-38	J.W.
KIND	BLACK FIBRE	CHANGED	
SHAPE		"	
FINISH		"	
TEMP.		"	
PATT.		"	

TITLE: SHORT WAVE INDUCTION COIL ELECT. ARM-UPRIGHT TUBE FRICTION WASHER-UPPER

H. G. FISCHER & CO.
2338 WABANSIA AVE.
CHICAGO, ILL.

CAT. NO.

PART NO. 11984

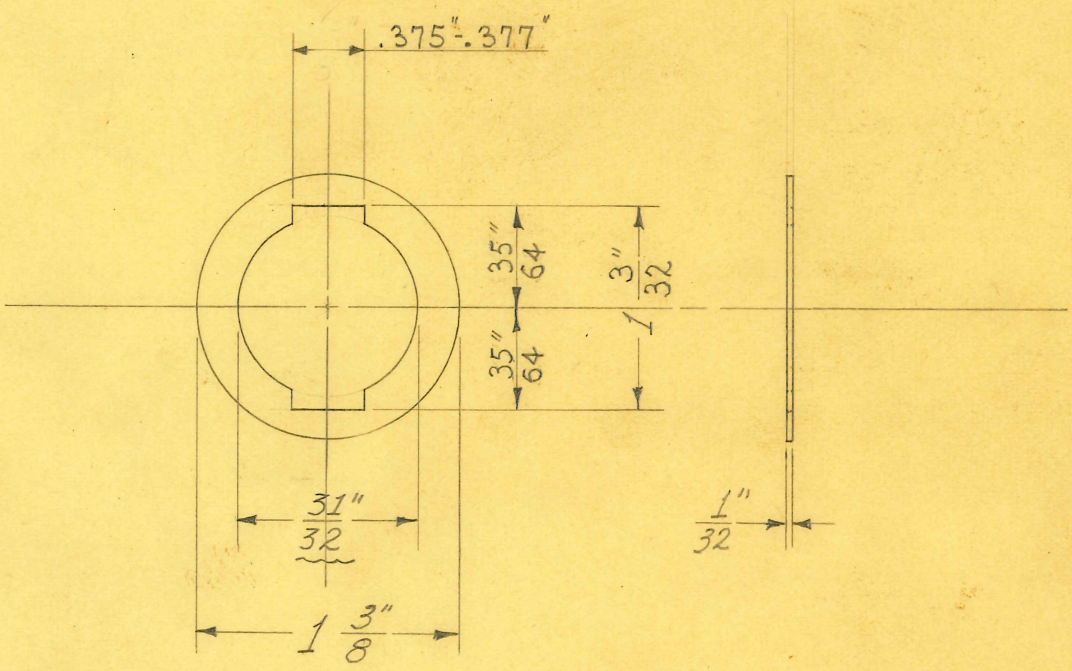

1 REQUIRED

OBSOLETE
4-22-80 J.S

SIZE	1/32" SHEET	ISSUE 7-22-38	J.W.
KIND	BLACK FIBRE	CHANGED 12-15-38	J.W.
SHAPE		"	
FINISH		"	
TEMP.		"	
PATT.		"	

TITLE: SHORT WAVE INDUCTION COIL ELECT. ARM-UPRIGHT TUBE FRICTION WASHER-LOWER

H. G. FISCHER & CO.
2335 WABANSIA AVE.
CHICAGO, ILL.

CAT. NO.

PART NO. 11985

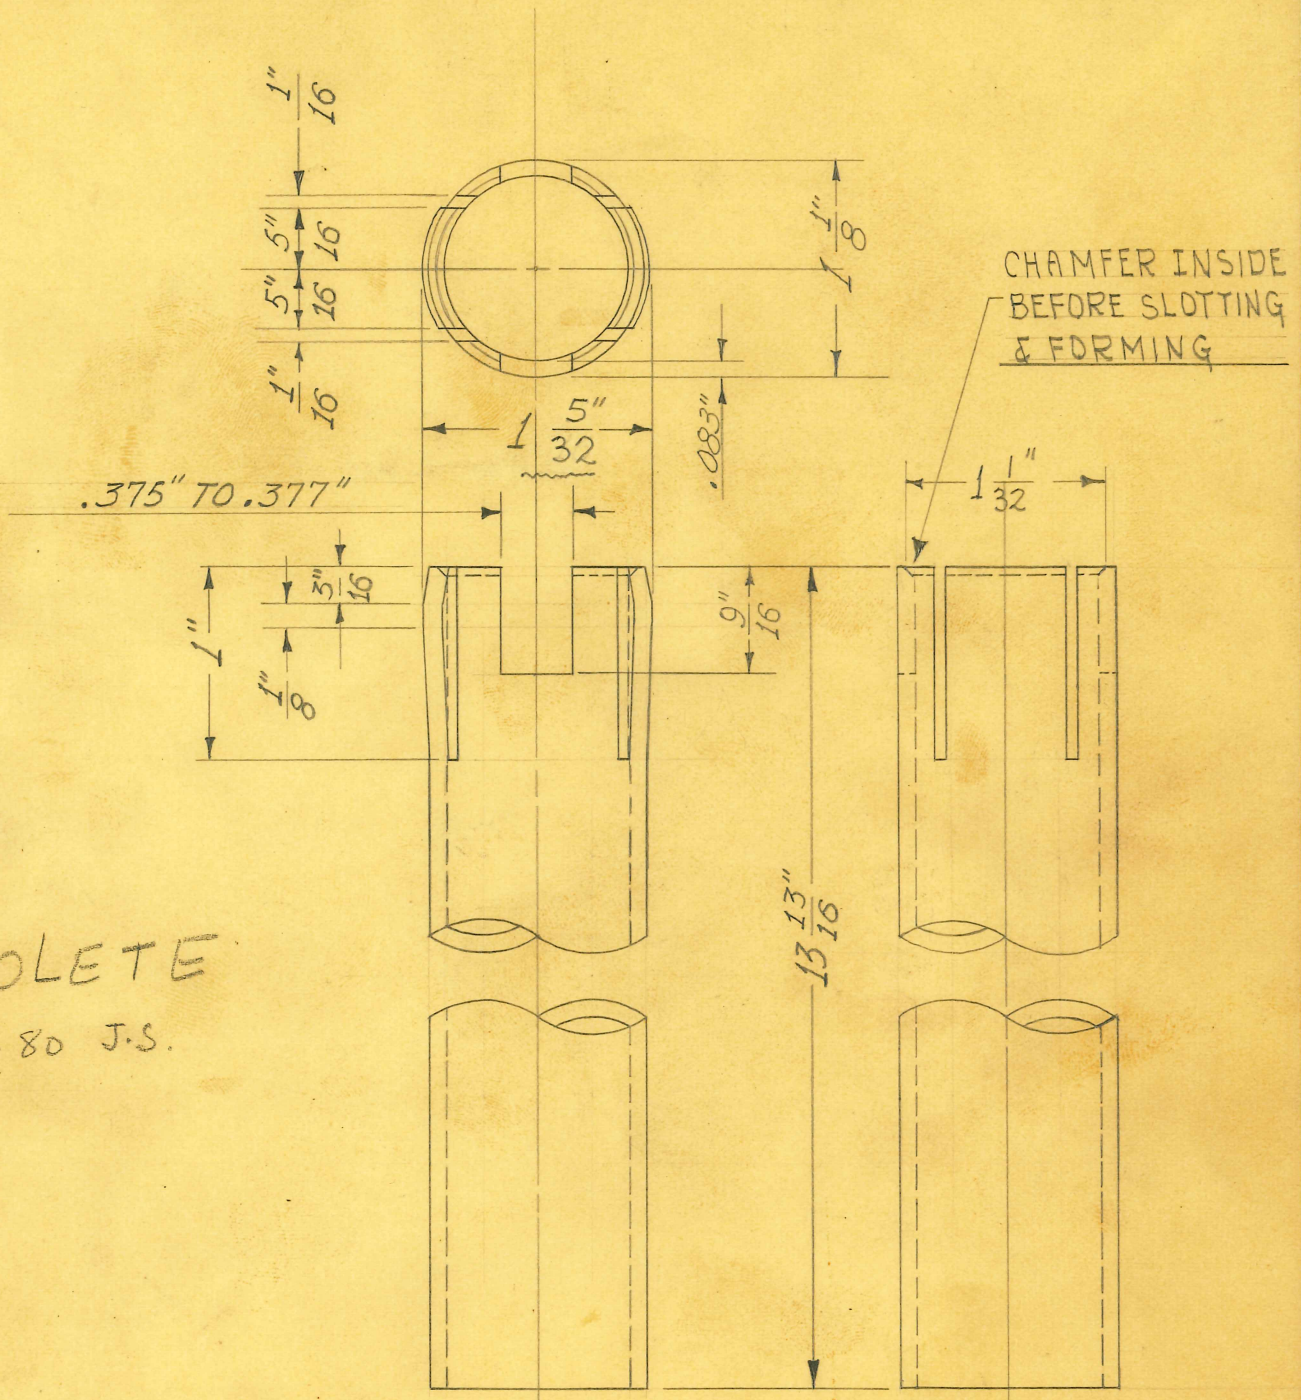

OBSOLETE

4-22-80 J.S.

1 REQUIRED

1 1/8" O.D. X #14 BIR. GA. (.083") WALL SHELBY SEAMLESS STEEL TUBING

RS.

SIZE		ISSUE 7-21-38	J.W.
KIND		CHANGED	
SHAPE		"	
FINISH		"	
TEMP.		"	
PATT.		"	

TITLE:
SHORT WAVE INDUCTION COIL ELECT. ARM-
UPRIGHT SWIVEL TUBE

H. G. FISCHER & CO.
2335 WABANSIA AVE.
CHICAGO, ILL.

CAT. NO.

PART NO. 11986A

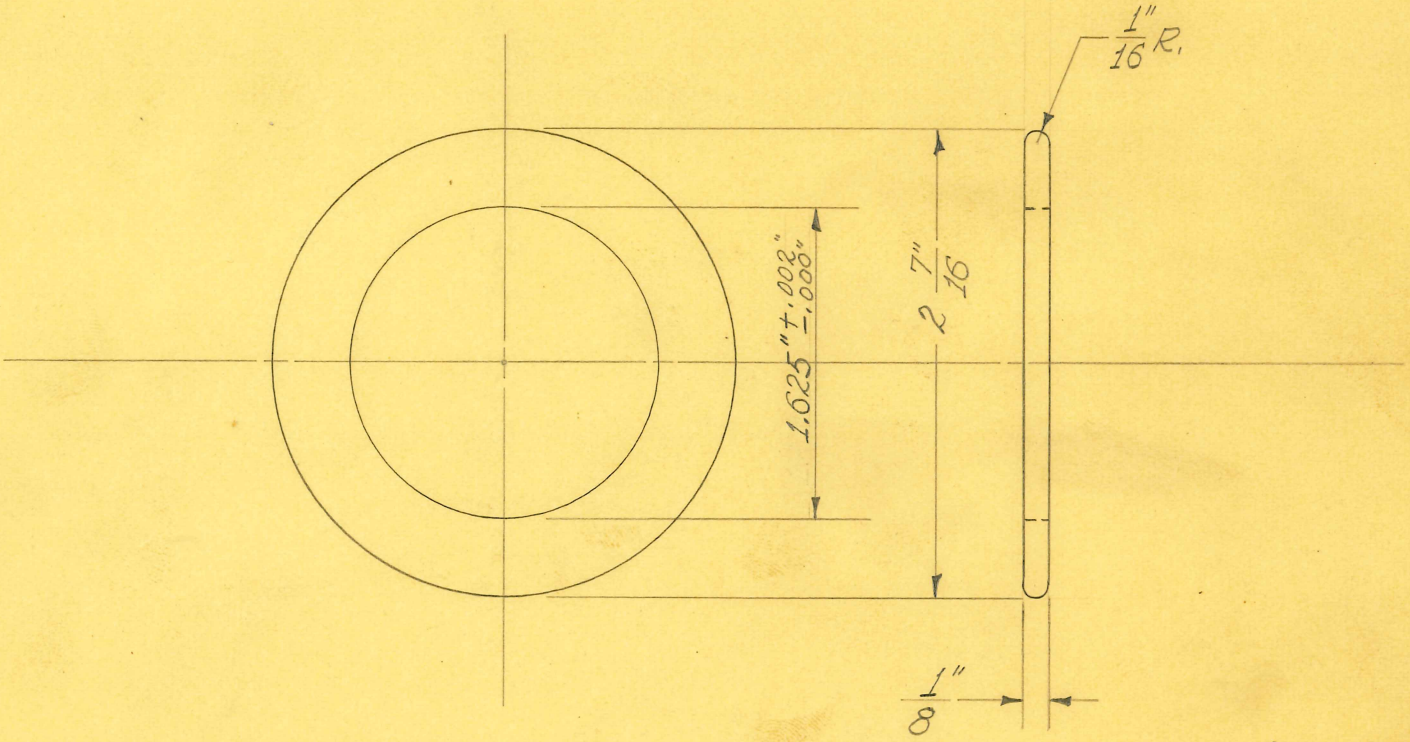

2 REQUIRED

OBSOLETE
4-22-80 J.S

SIZE	1/8" SHEET	ISSUE 7-21-38	J.W.
KIND	BLACK FIBRE	CHANGED	
SHAPE		"	
FINISH		"	
TEMP.		"	
PATT.		"	

TITLE: SHORT WAVE INDUCTION COIL. ELECT. ARM-SWIVEL FRICTION WASHER

H. G. FISCHER & CO.
2335 WABANSIA AVE.
CHICAGO, ILL.

CAT. NO.

PART NO. 11987

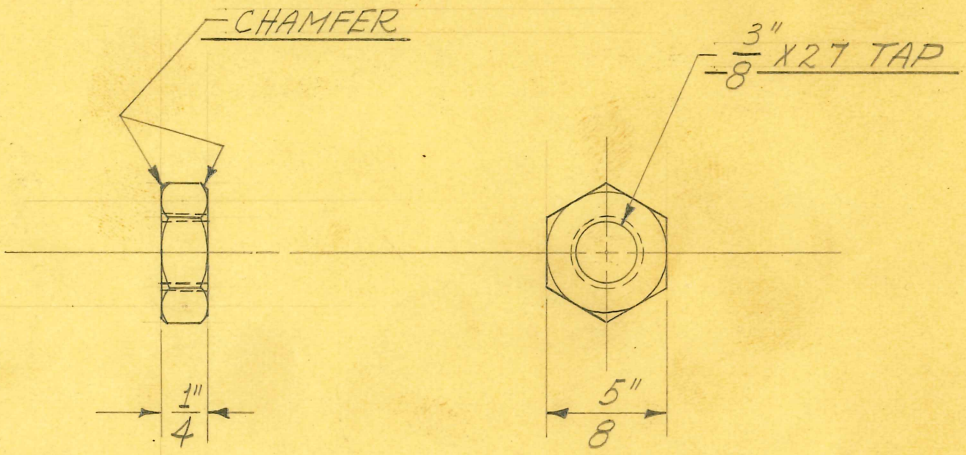

1 REQUIRED

OBSOLETE
4-22-80 J.S

SIZE	5/8" HEX.	ISSUE 7-21-38	J.W.
KIND	C.R. STEEL	CHANGED	
SHAPE		"	
FINISH	CHROME #2	"	
TEMP.		"	
PATT.		"	

TITLE: SHORT WAVE INDUCTION COIL ELECT. ARM-SWIVEL CLAMP NUT

H. G. FISCHER & CO.
2335 WABANSIA AVE.
CHICAGO, ILL.

CAT. NO.

PART NO. 11988

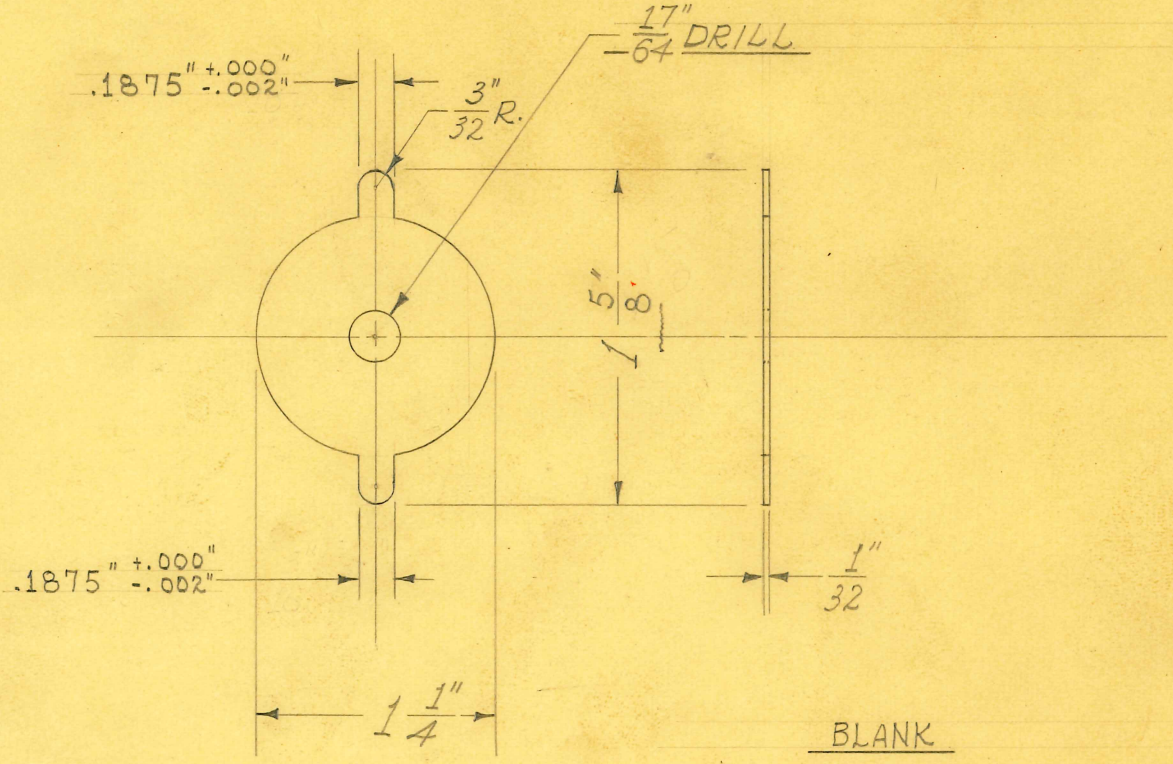

BLANK

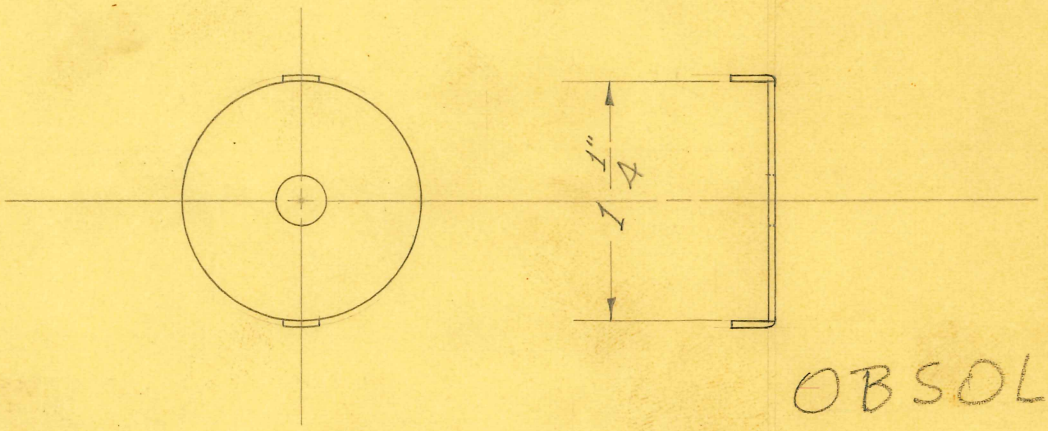

OBSOLETE

4-22-80 J.S

4 REQUIRED

SIZE	1/32" SHEET	ISSUE 7-25-38	J.W.
KIND	C.R. STEEL	CHANGED	
SHAPE		"	
FINISH		"	
TEMP.		"	
PATT.		"	

TITLE: SHORT WAVE INDUCTION COIL ELECTRODE-HEAD SWIVEL WASHER

H. G. FISCHER & CO.
2335 WABANSIA AVE.
CHICAGO, ILL.

CAT. NO.

PART NO. 11991

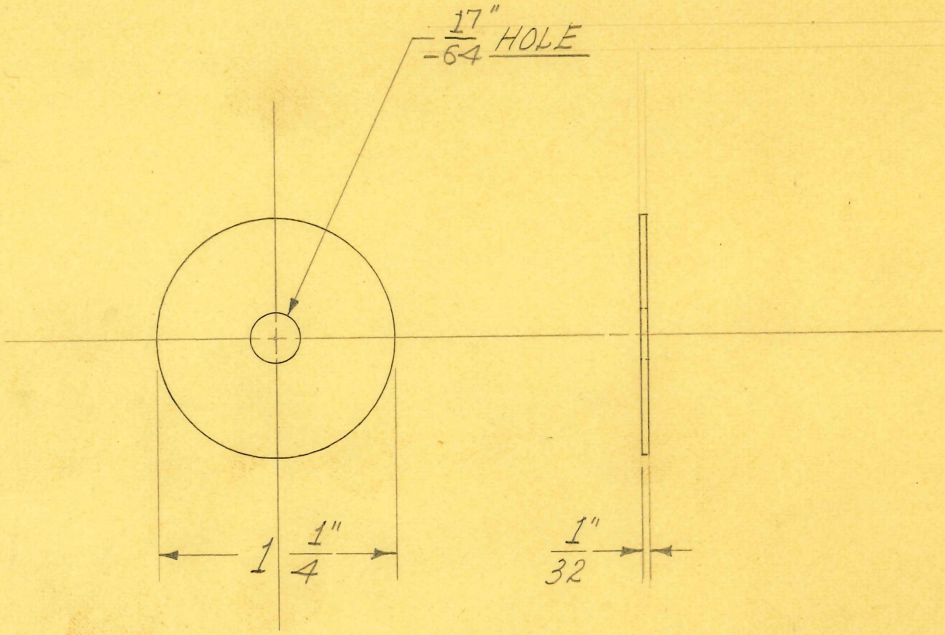

4 REQUIRED

OBSOLETE
4-22-80 J.S.

SIZE	1/32" SHEET	ISSUE 7-25-38	J.W.
KIND	BLACK FIBRE	CHANGED	
SHAPE		"	
FINISH		"	
TEMP.		"	
PATT.		"	

TITLE: SHORT WAVE INDUCTION COIL ELECT.- HEAD SWIVEL FRICTION WASHER

H. G. FISCHER & CO.
2335 WABANSIA AVE.
CHICAGO, ILL.

CAT. NO.

PART NO. 11992

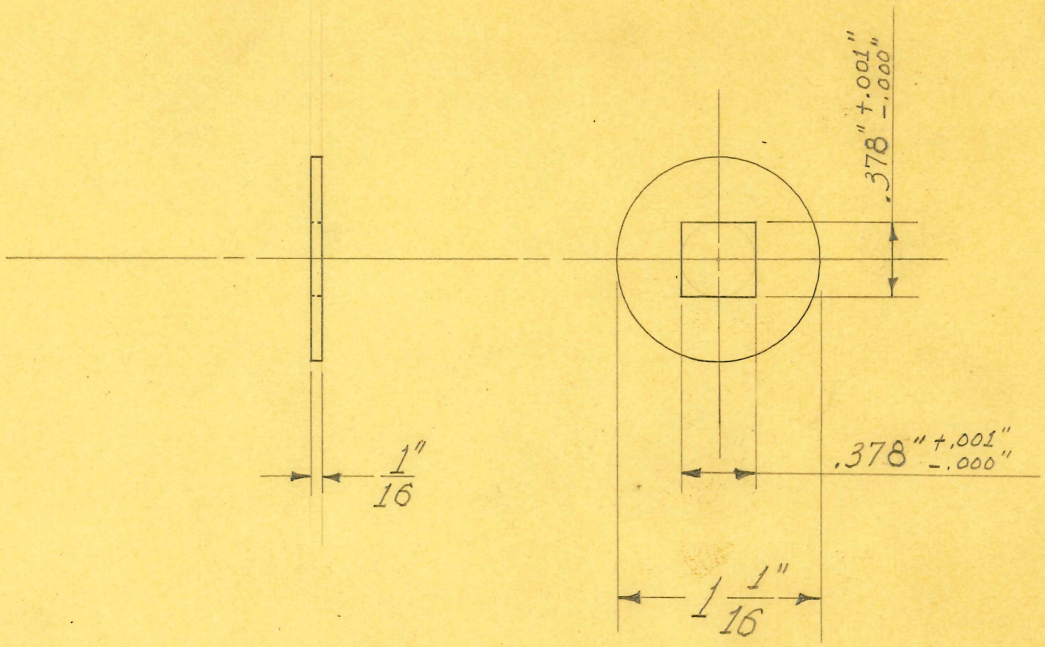

2 REQUIRED

OBSOLETE
4-22-80 J.S.

SIZE	1/16" SHEET	ISSUE 7-20-38	J.W.
KIND	C.R. STEEL	CHANGED	
SHAPE		"	
FINISH		"	
TEMP.		"	
PATT.		"	

TITLE:
SHORT WAVE INDUCTION COIL ELECT. ARM - ROTATING SWIVEL FRICTION BODY - FRICTION DISC

H. G. FISCHER & CO.
2335 WABANSIA AVE.
CHICAGO, ILL.

CAT. NO.

PART NO. 11993

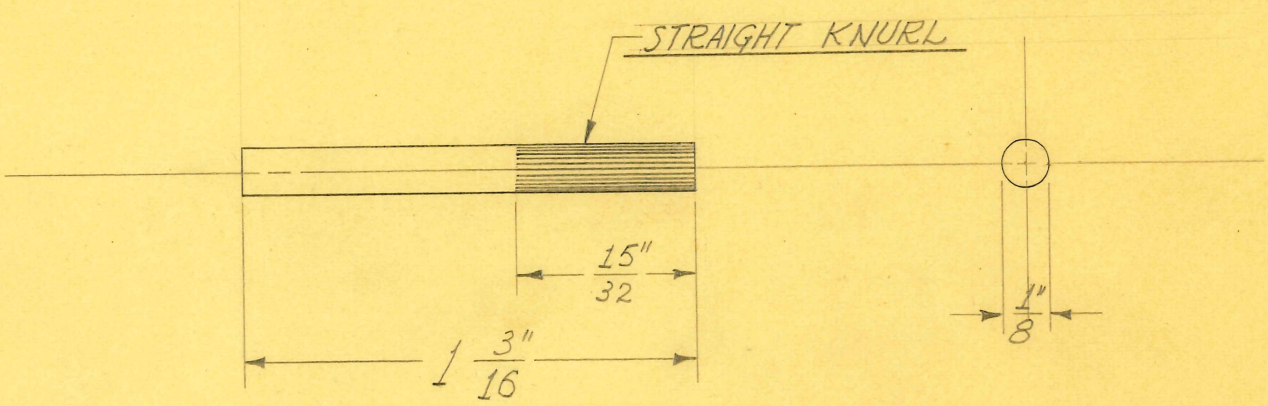

1 REQUIRED

SCALE ÷ DOUBLE SIZE

OBSOLETE
4-22-80 J.S

SIZE	1/8" DIAM.	ISSUE 7-21-38	J.W.
KIND	C.R. STEEL	CHANGED	
SHAPE	ROD	"	
FINISH		"	
TEMP.		"	
PATT.		"	

TITLE: SHORT WAVE INDUCTION COIL ELECT. ARM-ROTATING SWIVEL FRICTION BODY LOCK PIN.

H. G. FISCHER & CO.
2335 WABANSIA AVE.
CHICAGO, ILL.

CAT. NO.

PART NO. 11994

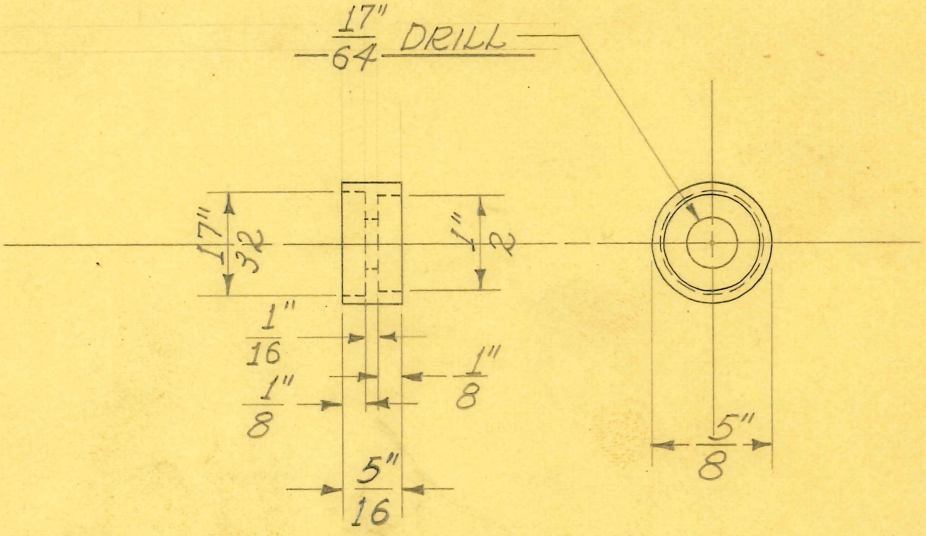

1 REQUIRED

OBSOLETE

4-22-80 J.S

SIZE	5/8" DIAM.	ISSUE 7-21-38	J.W.
KIND	BRASS ROD	CHANGED	
SHAPE		"	
FINISH	CAD. #23	"	
TEMP.		"	
PATT.		"	

TITLE: SHORT WAVE INDUCTION COIL ELECT. ARM-ROTATING SWIVEL FRICTION BODY ADJ. SPG. CUP

H. G. FISCHER & CO.
2335 WABANSIA AVE.
CHICAGO, ILL.

CAT. NO.

PART NO. 11995

TITLE

SHORT WAVE INDUCTION COIL ELECT.
ARM ROTATING SWIVEL FRICTION BODY ASS'Y.

H. G. FISCHER & CO.
FRANKLIN PARK, ILLINOIS

PART NO. 11996 G

DATE 4-28-65 | DR BY T. T. | CH'K'D. RS

REVISION	DATE	BY

PATTERN | FINISH | SCALE FULL

TOOLS | MATERIAL AS SHOWN

DIMENSIONS
FRACTIONAL ± .015
DECIMAL ± .005
ANGULAR ± ½°
UNLESS OTHERWISE SPECIFIED

USED ON	QTY.

NOTE:
DRIVE (ITEM # 2) INTO (ITEM # 1)
AS SHOWN. MACHINE TO DIMENSION
AS SHOWN.

OBSOLETE
4-22-80 J.S

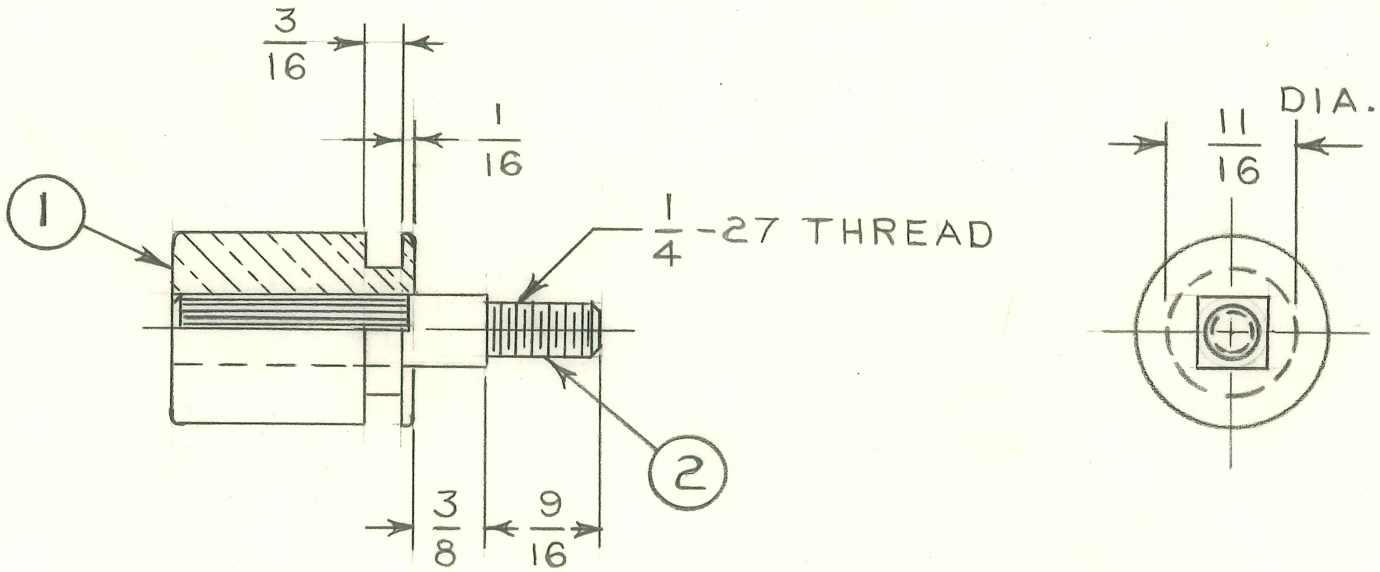

DEPT.	AMT.	ITEM NO.	NAME OF PART	PART NO.
M. S.	1	1	FRICTION BODY	12045
M. S.	1	2	FRICTION BODY STUD	12046

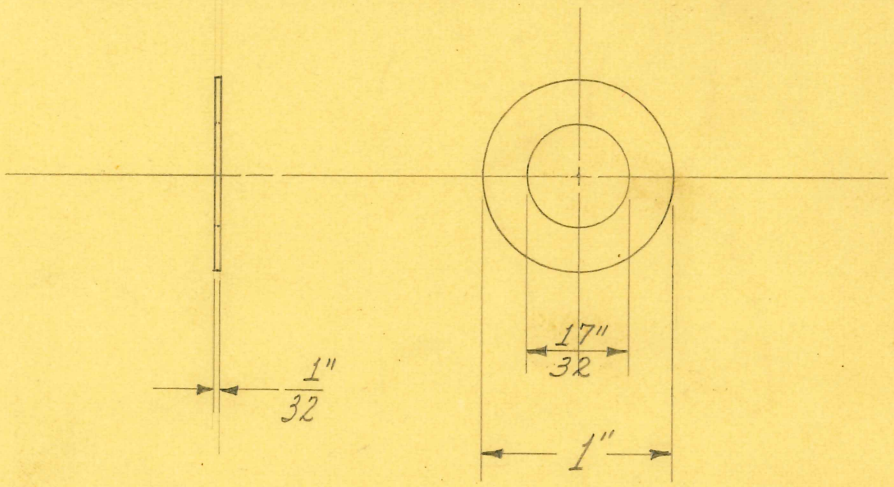

4 REQUIRED

OBSOLETE
4-22-80 J.S

SIZE	1/32" SHEET	ISSUE 7-20-38	J.W.
KIND	BLACK FIBRE	CHANGED	
SHAPE		"	
FINISH		"	
TEMP.		"	
PATT.		"	

TITLE: SHORT WAVE INDUCTION COIL ELECT. ARM-
ROTATING SWIVEL FRICTION BODY FRICTION WASHER

H. G. FISCHER & CO.
2335 WABANSIA AVE.
CHICAGO, ILL.

CAT. NO.

PART NO. 11997

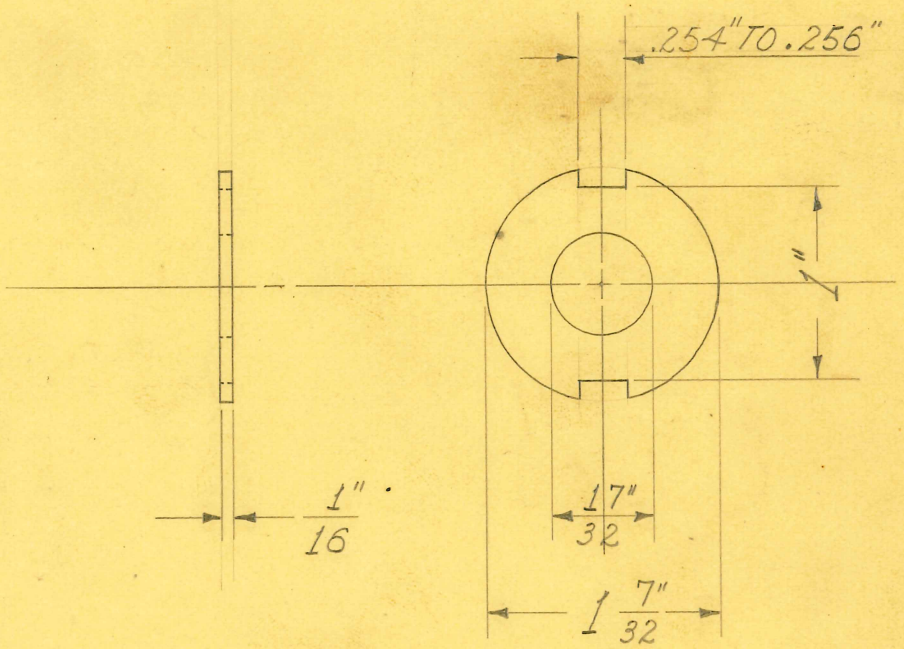

2 REQUIRED

OBSOLETE
4-22-80 J.S.

SIZE	1/16" SHEET	ISSUE 7-20-38	J.W.
KIND	C.R. STEEL	CHANGED	
SHAPE		"	
FINISH		"	
TEMP.		"	
PATT.		"	

TITLE: SHORT WAVE INDUCTION COIL ELECT. ARM-
ROTATING SWIVEL FRICTION BODY LOCK WASHER

H. G. FISCHER & CO.
2335 WABANSIA AVE.
CHICAGO, ILL.

CAT. NO.

PART NO. 11998

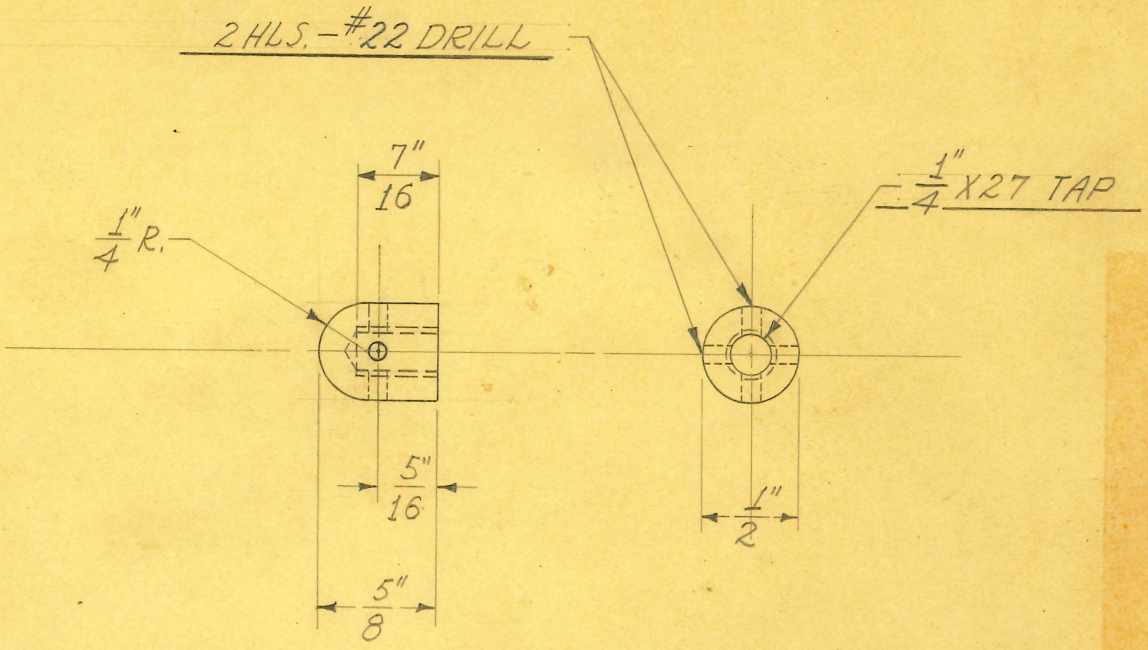

1 REQUIRED

OBSOLETE
4-22-80 J.S

SIZE	1/2" DIAM.	ISSUE 7-20-38	J.W.
KIND	BRASS ROD	CHANGED	
SHAPE		"	
FINISH	CHROME #2	"	
TEMP.		"	
PATT.		"	

TITLE:
SHORT WAVE INDUCTION COIL ELECT. ARM - ROTATING SWIVEL FRICTION BODY ADJ. SPG. CLAMP NUT.

H. G. FISCHER & CO.
2335 WABANSIA AVE.
CHICAGO, ILL.

CAT. NO.

PART NO. 11999

CUT OFF AS CLOSE AS POSSIBLE - PERPENDICULAR TO TIT AS SHOWN

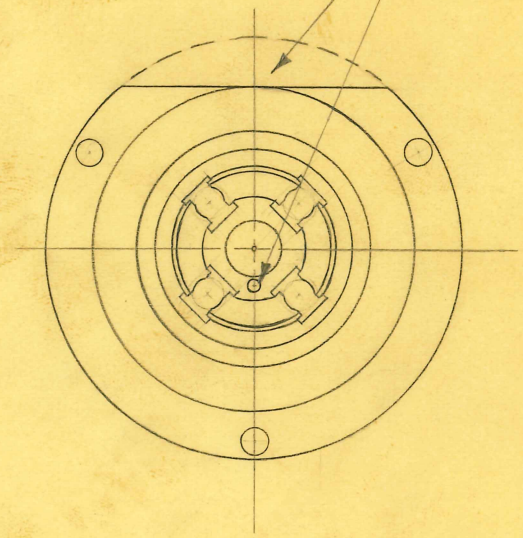

2 REQUIRED

OBSOLETE

SIZE		ISSUE	
KIND	FROM 9659GA	CHANGED	
SHAPE		"	
FINISH		"	
TEMP.		"	
PATT.		"	

TITLE: FISCHER MOD. PORT. "C" SHORT WAVE RECTIFYING TUBE SOCKET

H. G. FISCHER & CO.
2335 WABANSIA AVE.
CHICAGO, ILL.

CAT. NO.

PART NO. 11102G

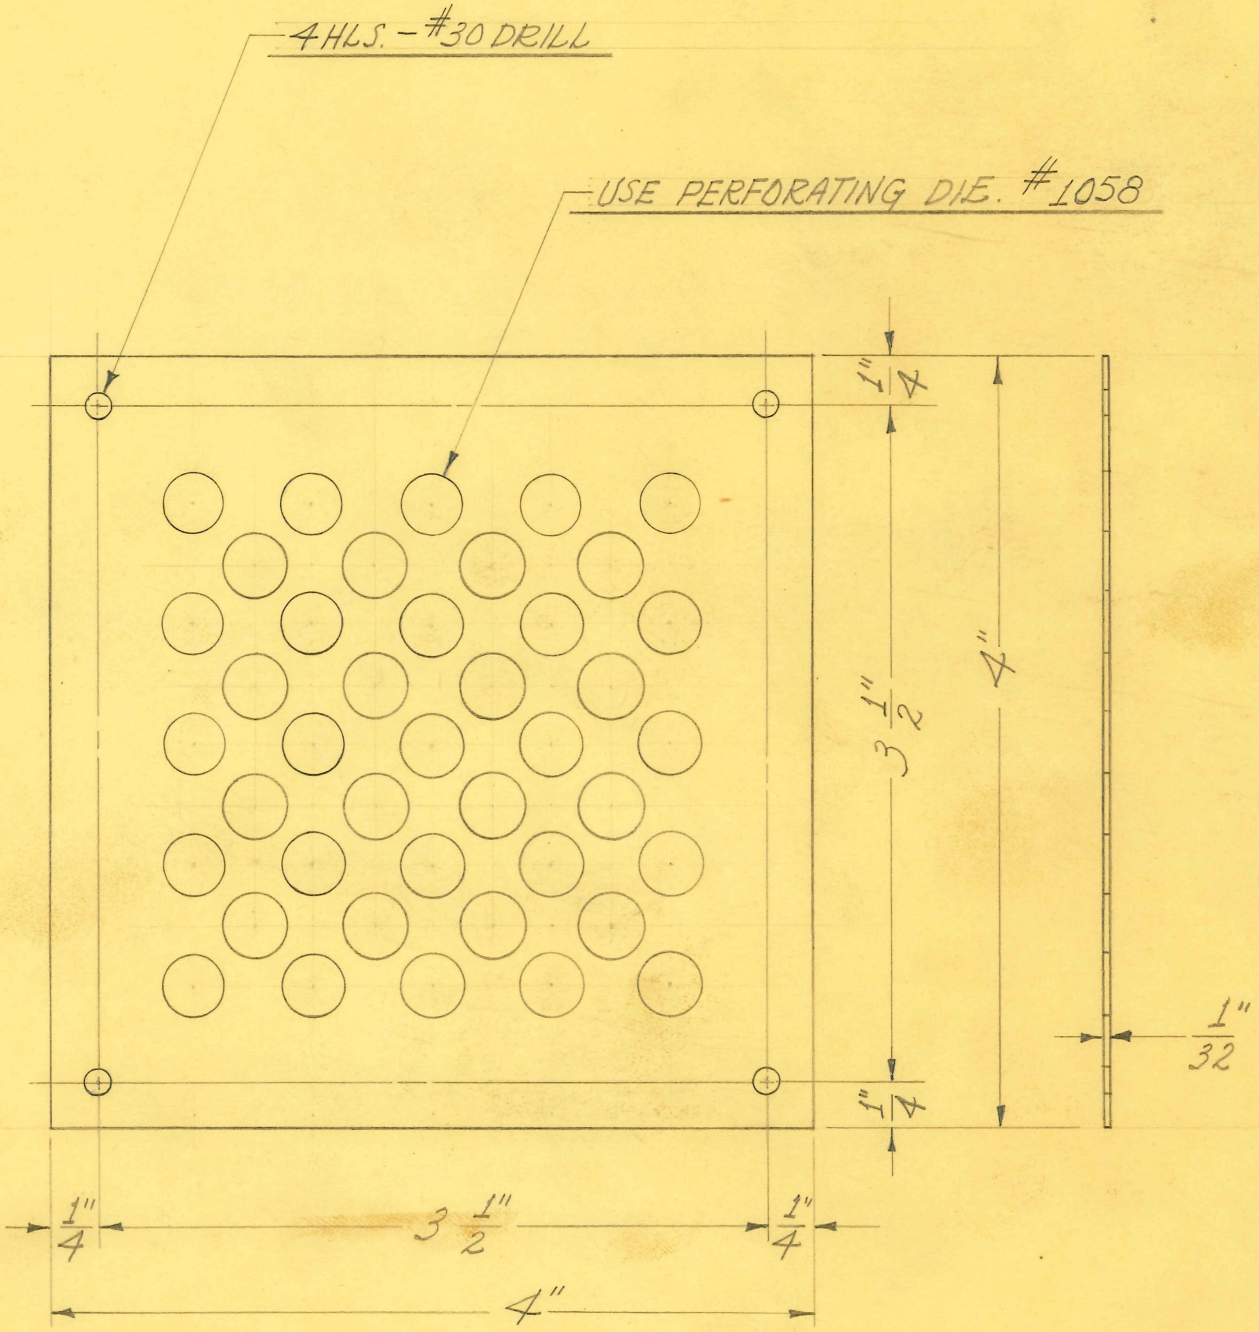

1 REQUIRED

OBSOLETE

SIZE	1/32" SHEET	ISSUE 5-9-38	J.W.
KIND	C.R. STEEL	CHANGED	
SHAPE		"	
FINISH	BLK. #80	"	
TEMP.		"	
PATT.		"	

TITLE:
FISCHER MOD. PORT. "C" CARRYING CASE
VENT. PLATE – BOTTOM

H. G. FISCHER & CO.
2338 WABANSIA AVE.
CHICAGO, ILL.

CAT. NO.

PART NO. 11103

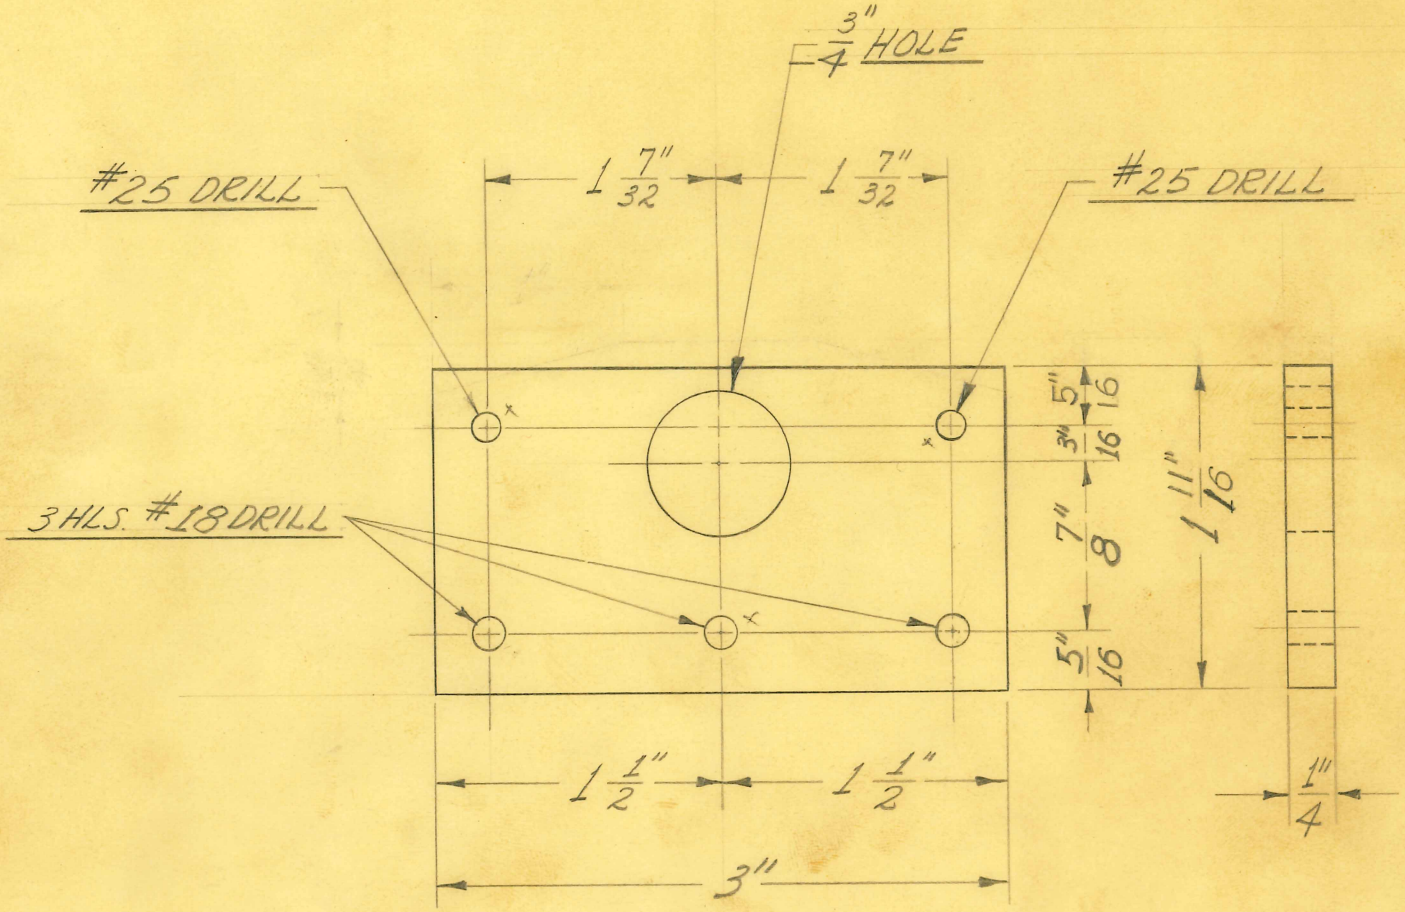

1 REQUIRED

OBSOLETE

obsolete

SIZE	1/4" SHEET	ISSUE 1-27-38	J.W.
KIND	BAKELITE	CHANGED	
SHAPE		" 10-20-41	J.W.
FINISH		"	
TEMP.		"	
PATT.		"	

TITLE: MOD. "PC" CONDENSER MOUNTING BOARD

H. G. FISCHER & CO.
2335 WABANSIA AVE.
CHICAGO, ILL.

CAT. NO.

PART NO. 11106A

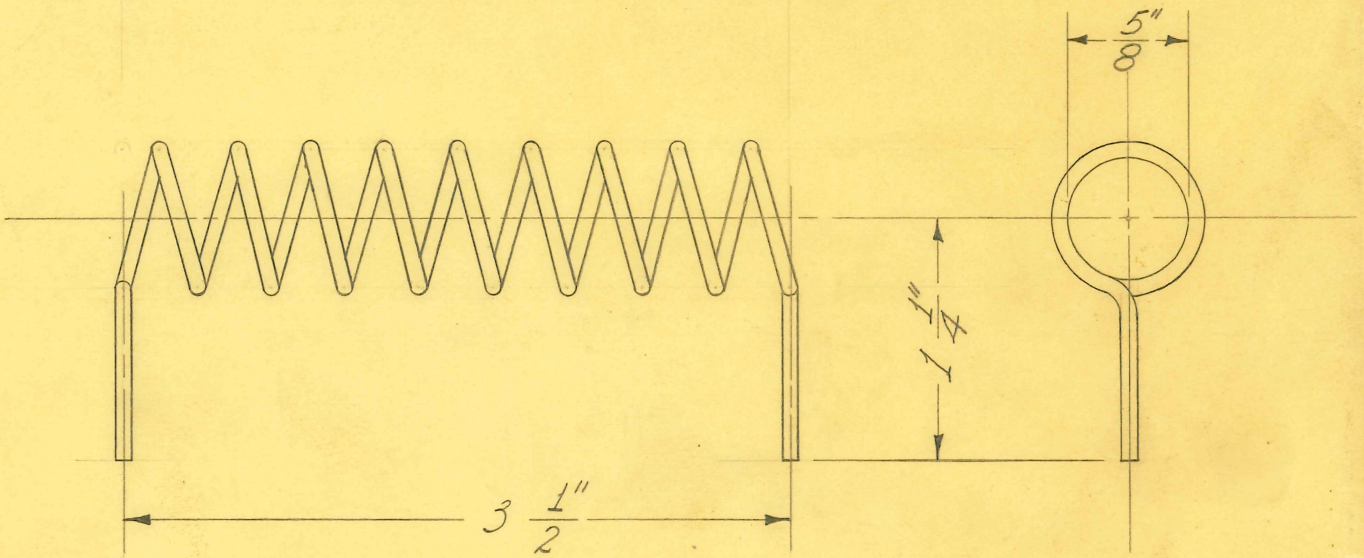

9 TURNS

1 REQUIRED

OBSOLETE

SIZE	#12 TINNED	ISSUE 2-3-38	J.W.
KIND	COPPER WIRE	CHANGED	
SHAPE		"	
FINISH		"	
TEMP.		"	
PATT.		"	

TITLE: MOD. PORT. "C-6" GRID COIL

H. G. FISCHER & CO.
2335 WABANSIA AVE.
CHICAGO, ILL.

CAT. NO.

PART NO. 11108

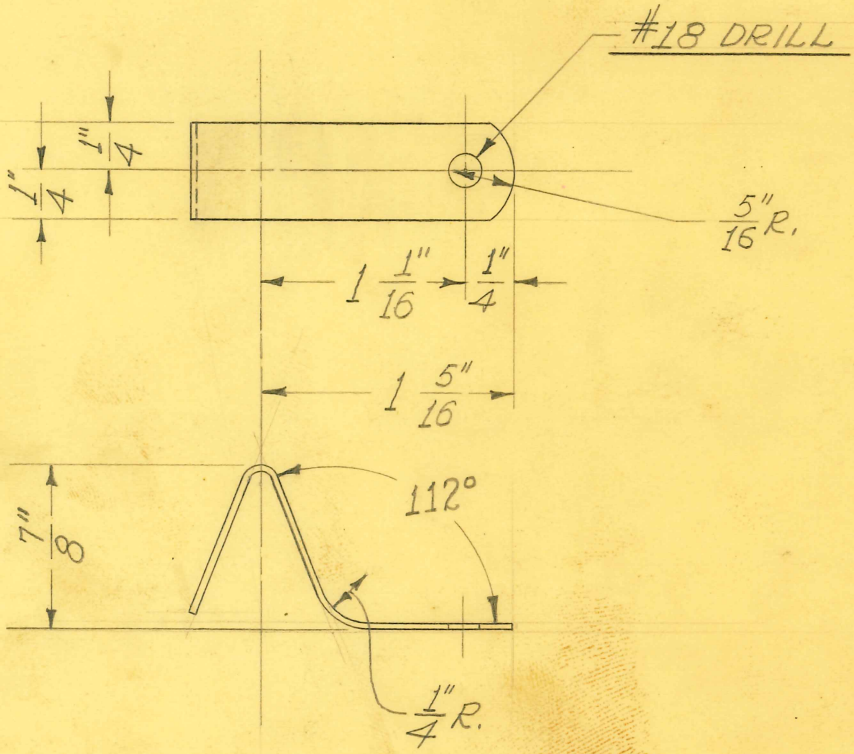

FROM 11109

2 REQUIRED

OBSOLETE

SIZE		ISSUE 2-4-38	J.W.
KIND		CHANGED	
SHAPE		"	
FINISH		"	
TEMP.		"	
PATT.		"	

TITLE: FISCHER MOD. PORT. "C-6" 500 OHM RESISTOR BRACKET - UPPER

H. G. FISCHER & CO.
2335 WABANSIA AVE.
CHICAGO, ILL.

CAT. NO.

PART NO. 11109F

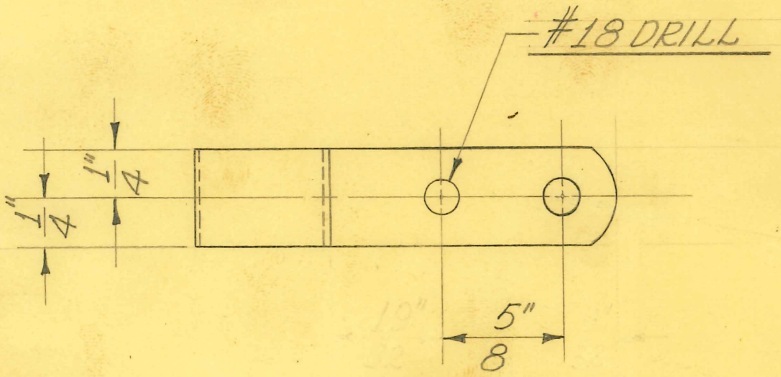

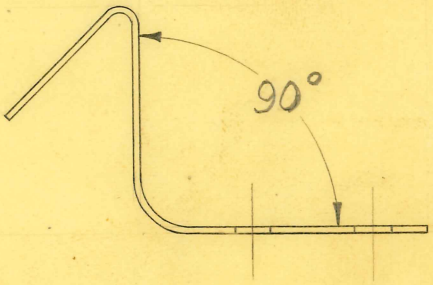

FROM 11109

2 REQUIRED

OBSOLETE

SIZE		ISSUE 2-4-38	J.W.	**TITLE:** FISCHER MOD. PORT. "C-6" 500 OHM RESISTOR BRACKET - LOWER
KIND		CHANGED		
SHAPE		"		
FINISH		"		
TEMP.		"		
PATT.		"		

H. G. FISCHER & CO.
2335 WABANSIA AVE.
CHICAGO, ILL.

CAT. NO.

PART NO. 11109 1/2

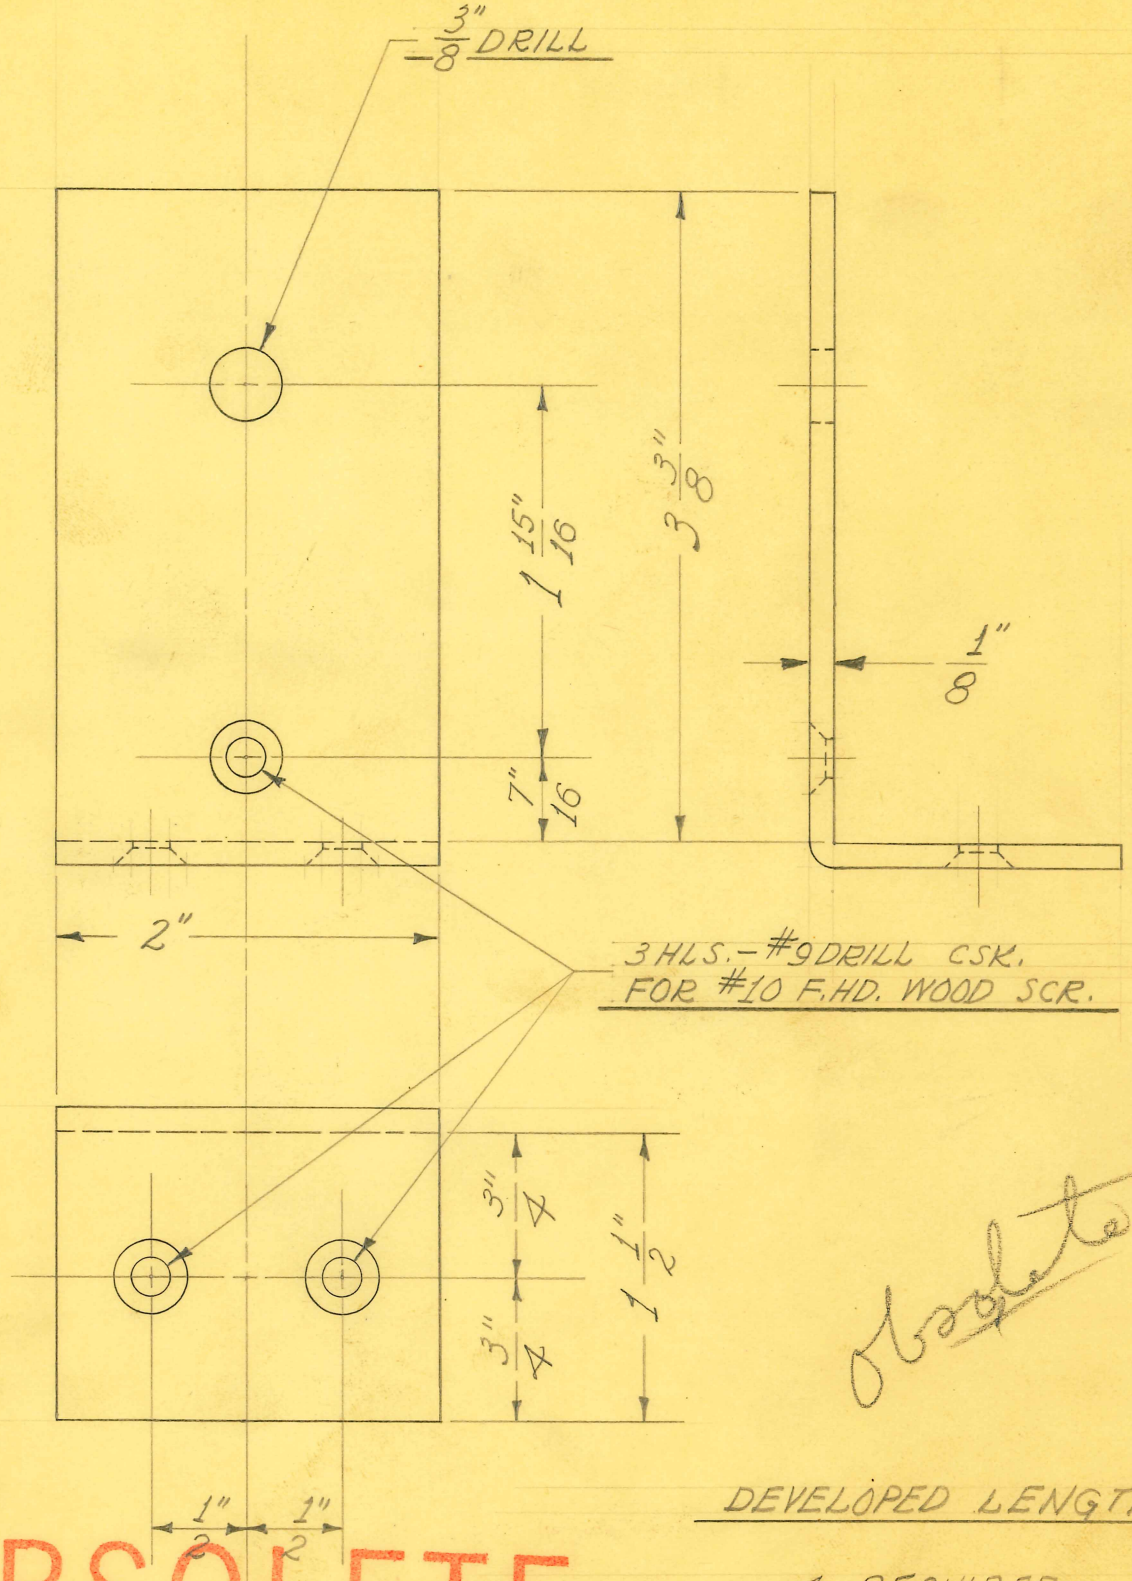

Noble

DEVELOPED LENGTH = 4 15/16"

4 REQUIRED

OBSOLETE

SIZE	2" X 1/8" STRIP	ISSUE 4-7-38	J.W.
KIND	C.R. STEEL	CHANGED	
SHAPE		"	
FINISH		"	
TEMP.		"	
PATT.		"	

TITLE: DELUXE "SWDI" CABINET - PACKING CLAMP - BOTTOM

H. G. FISCHER & CO.
2335 WABANSIA AVE.
CHICAGO, ILL.

CAT. NO.

PART NO. 11117

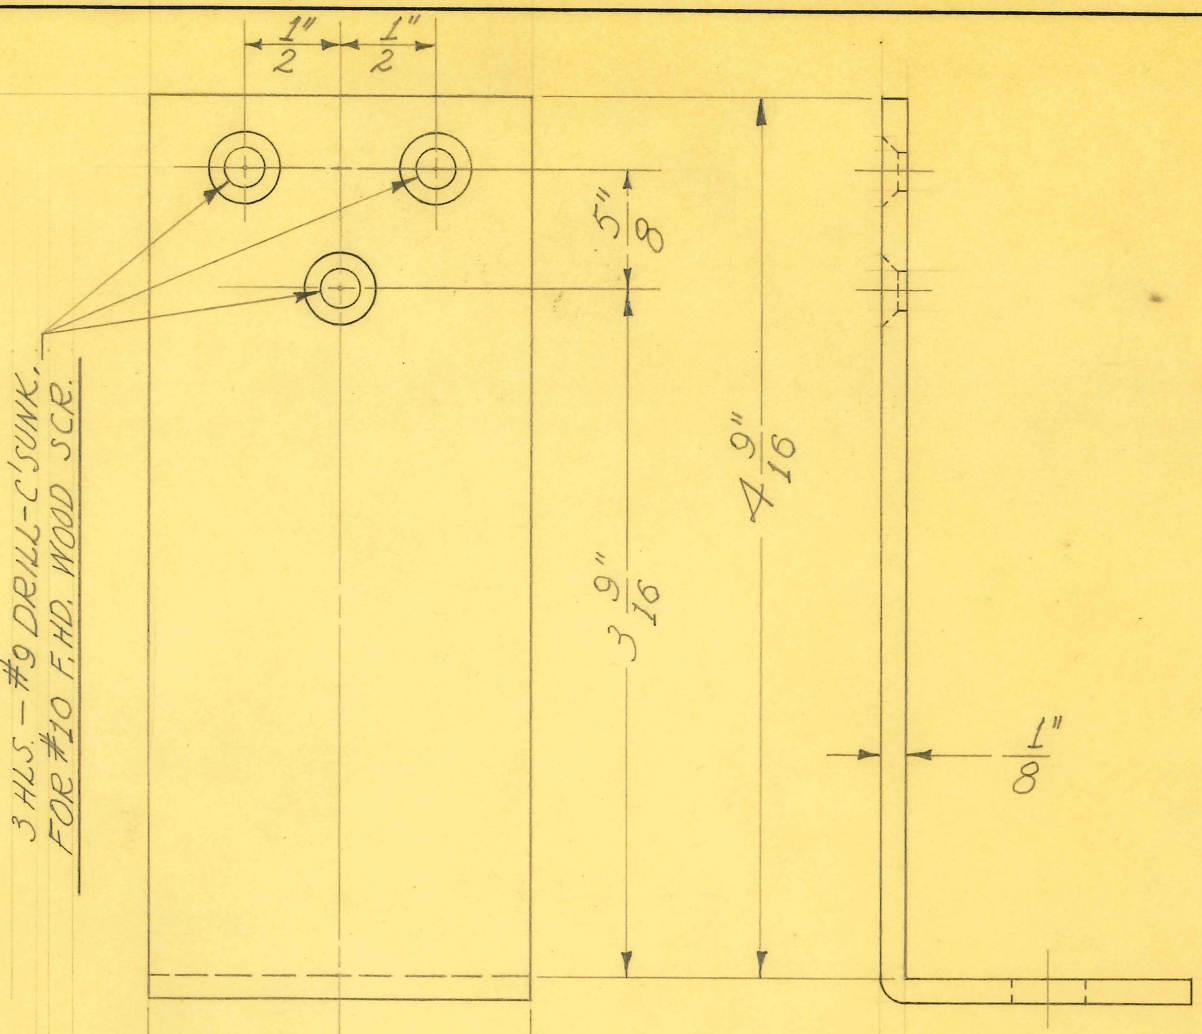

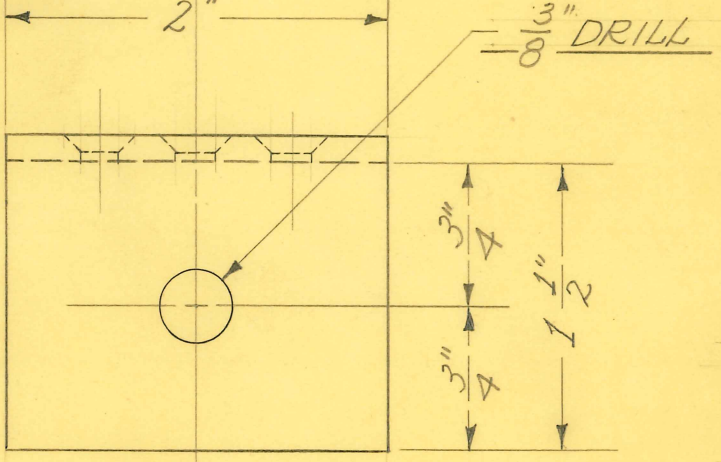

obsolete

DEVELOPED LENGTH= 6 1" 8

2 REQUIRED

OBSOLETE

SIZE	2" X 1/8" STRIP	ISSUE 4-7-38	J.W.
KIND	C.R. STEEL	CHANGED	
SHAPE		"	
FINISH		"	
TEMP.		"	
PATT.		"	

TITLE: DELUXE "SWDI" CABINET - PACKING CLAMP - TOP

H. G. FISCHER & CO.
2335 WABANSIA AVE.
CHICAGO, ILL.

CAT. NO.

PART NO. 11118

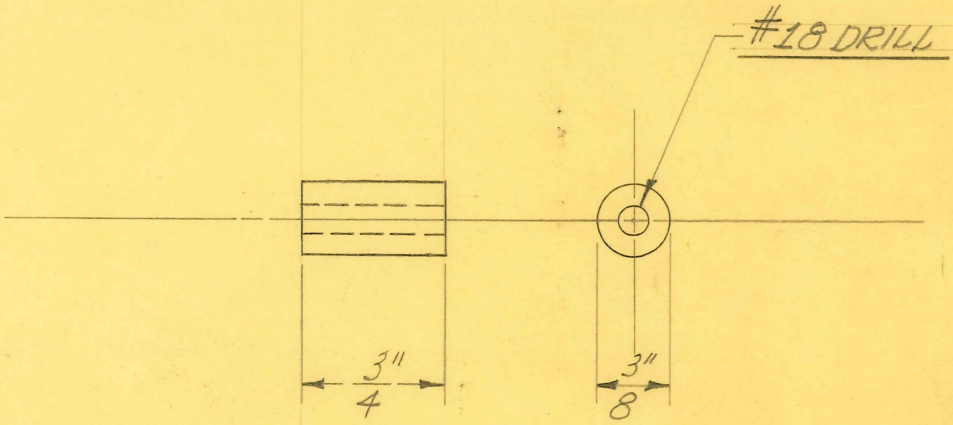

2 REQUIRED

OBSOLETE

SIZE	3/8" DIAM.	ISSUE 5-5-38	J.W.
KIND	ALUM. ROD	CHANGED	
SHAPE		"	
FINISH	ACID. #41	"	
TEMP.		"	
PATT.		"	

TITLE:
FISCHER MOD. "6-24-72" SHORT WAVE
PATIENT'S TUNING COND. -INSULATOR BAR SPACER -REAR

H. G. FISCHER & CO.
2335 WABANSIA AVE.
CHICAGO, ILL.

CAT. NO.

PART NO. 11613

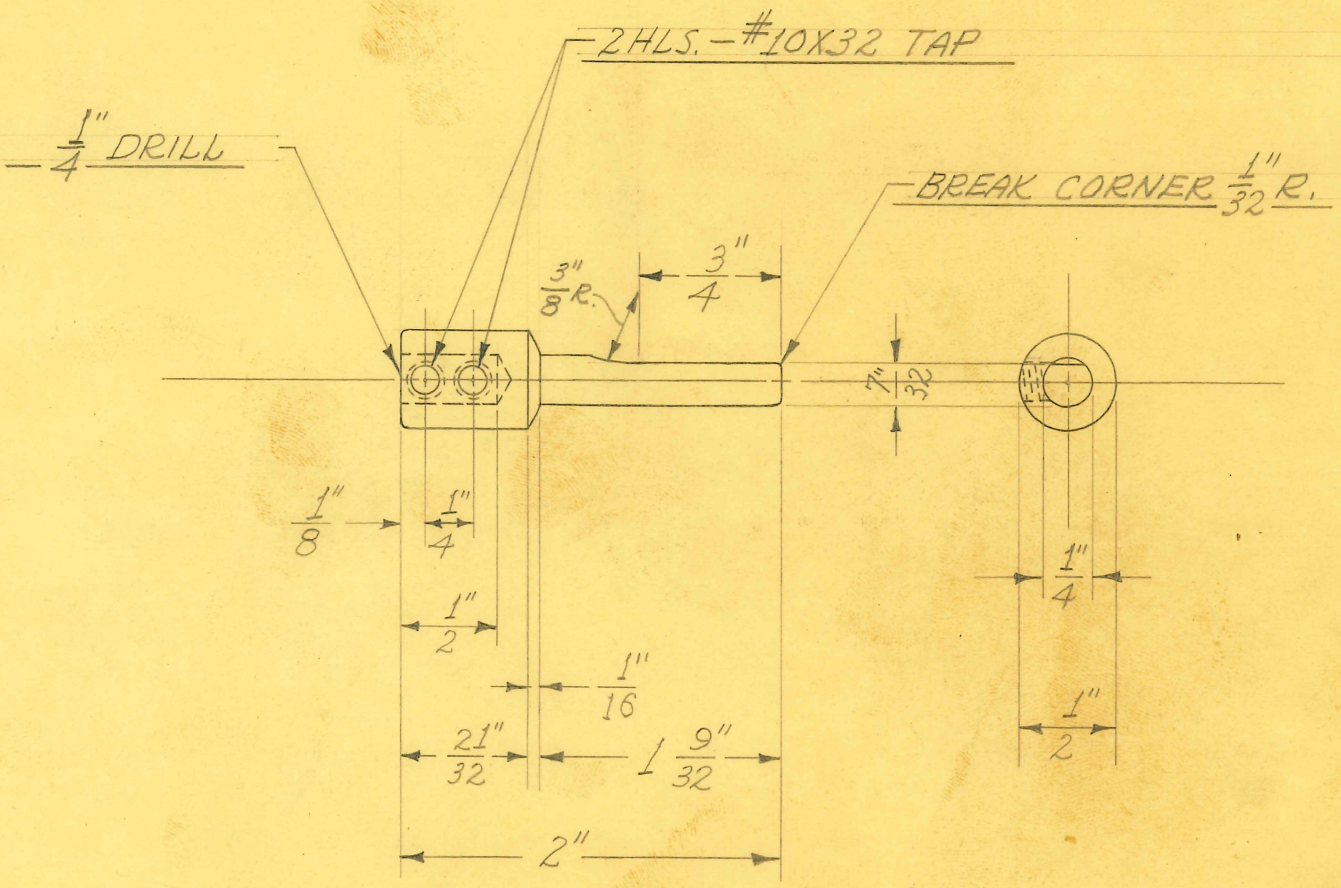

1 REQUIRED

OBSOLETE

Obsolete

SIZE	1/2" DIAM.	ISSUE 5-4-38	J.W.
KIND	SCREW STOCK	CHANGED	
SHAPE		"	
FINISH	CAD. #23	"	
TEMP.		"	
PATT.		"	

TITLE: MOD. "6-24-72" SHORT WAVE – ROTOR SHAFT EXTENSION (PATIENT'S TUNING COND.)

H. G. FISCHER & CO.
2335 WABANSIA AVE.
CHICAGO, ILL.

CAT. NO.

PART NO. 11614

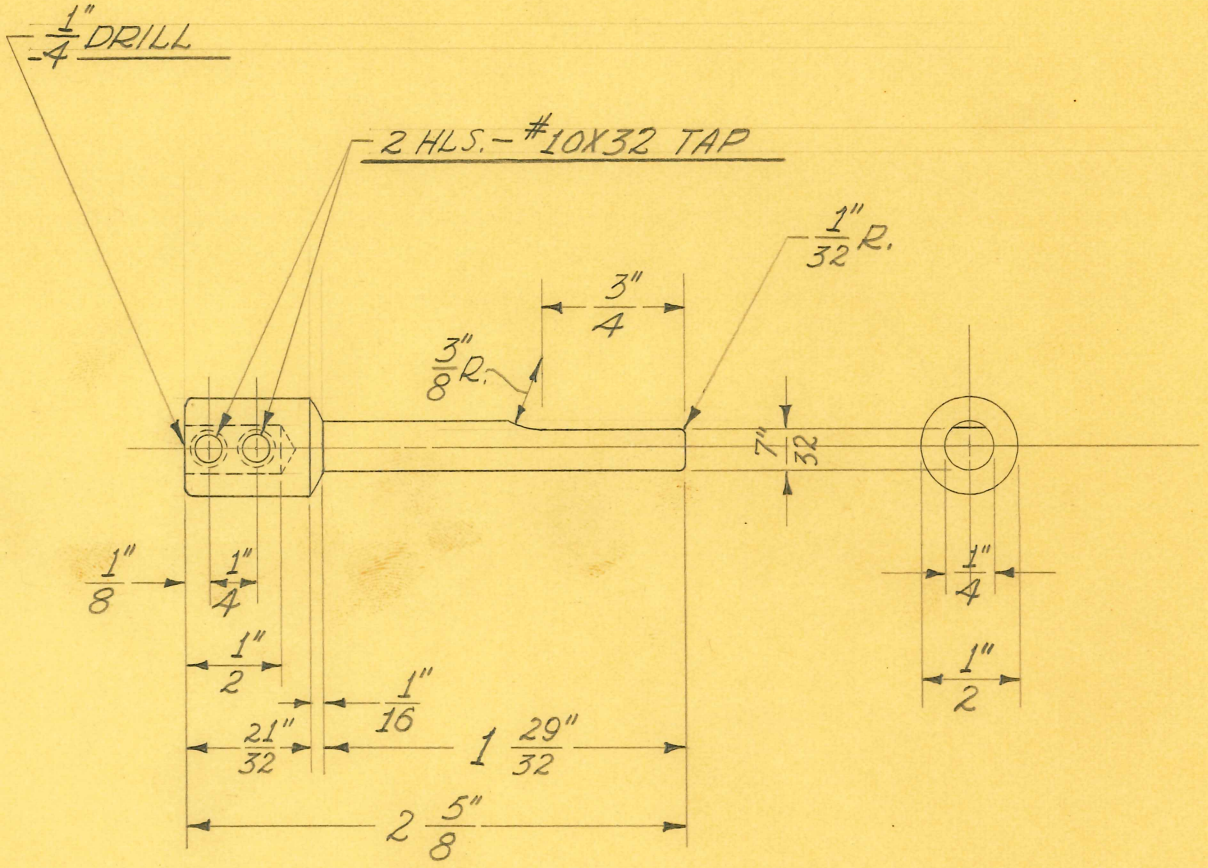

1 REQUIRED

OBSOLETE

SIZE	1/2" DIAM.	ISSUE 10-20-38	J.W.
KIND	SCREW STOCK	CHANGED	
SHAPE		"	
FINISH	CAD. #23	"	
TEMP.		"	
PATT.		"	

TITLE: MOD. "6-24-72" SHORT WAVE - PATIENT'S TUNING CONDENSER - ROTOR SHAFT EXTENSION

H. G. FISCHER & CO.
2335 WABANSIA AVE.
CHICAGO, ILL.

CAT. NO.

PART NO. 11614A

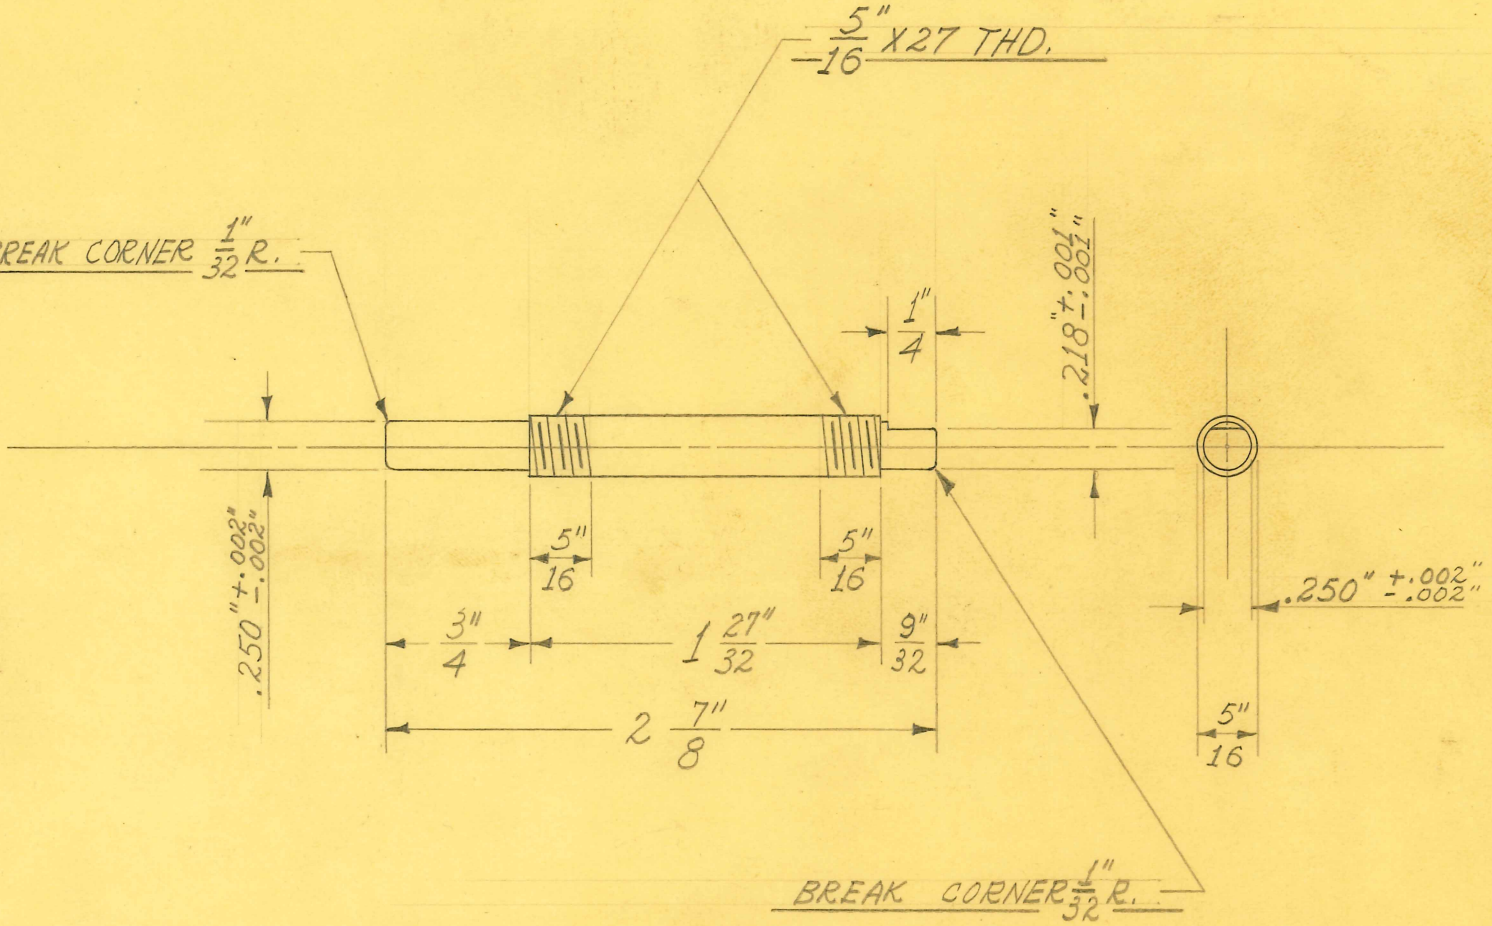

1 REQUIRED

OBSOLETE

SIZE	5/16" DIAM.	ISSUE 5-5-38	J.W.
KIND	SCREW STOCK	CHANGED	
SHAPE		"	
FINISH	CAD. #23	"	
TEMP.		"	
PATT.		"	

TITLE:
FISCHER MOD. "6-24-72" SHORT WAVE
PATIENT'S TUNING COND. - ROTOR SHAFT - REAR

H. G. FISCHER & CO.
2335 WABANSIA AVE.
CHICAGO, ILL.

CAT. NO.

PART NO. 11615

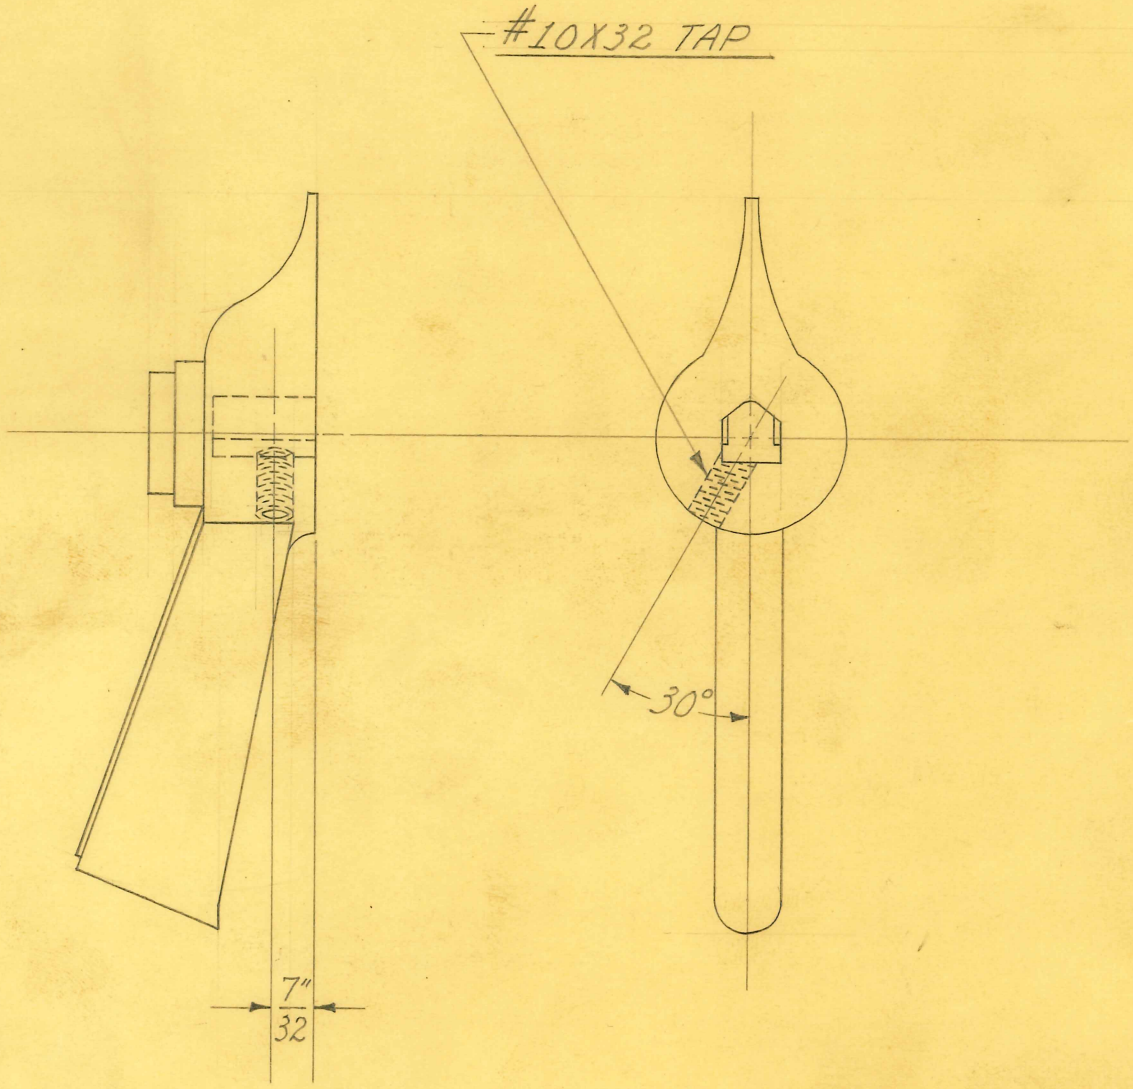

1 REQUIRED

OBSOLETE

SIZE		ISSUE 5-4-38	J.W.
KIND	FROM 9813G	CHANGED	
SHAPE		"	
FINISH		"	
TEMP.		"	
PATT.		"	

TITLE: FISCHER MOD. "6-24-72" SHORT WAVE PATIENT'S TUNING CONDENSER KNOB

H. G. FISCHER & CO.
2335 WABANSIA AVE.
CHICAGO, ILL.

CAT. NO.

PART NO. 11616

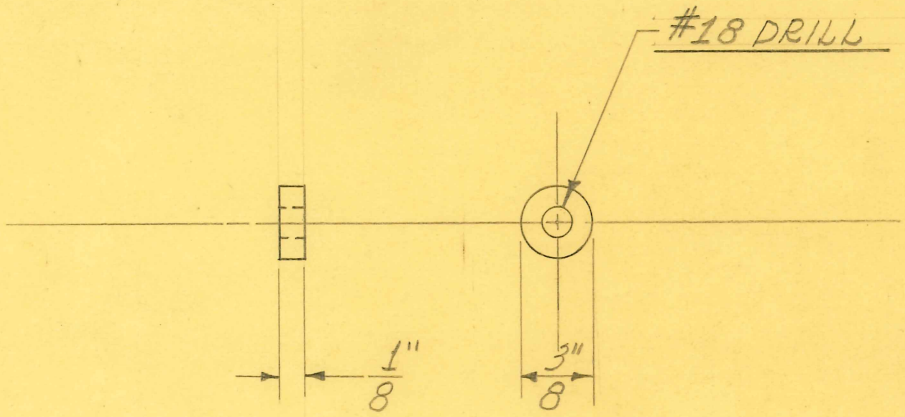

2 REQUIRED

OBSOLETE

SIZE	3/8" DIAM.	ISSUE 5-5-38	J.W.
KIND	ALUM. ROD	CHANGED	
SHAPE		"	
FINISH	ACID. #41	"	
TEMP.		"	
PATT.		"	

TITLE: FISCHER MOD. "6-24-72" SHORT WAVE PATIENT'S TUNING COND.-INSULATOR BAR SPACER -FRONT

H. G. FISCHER & CO.
2335 WABANSIA AVE.
CHICAGO, ILL.

CAT. NO.

PART NO. 11617

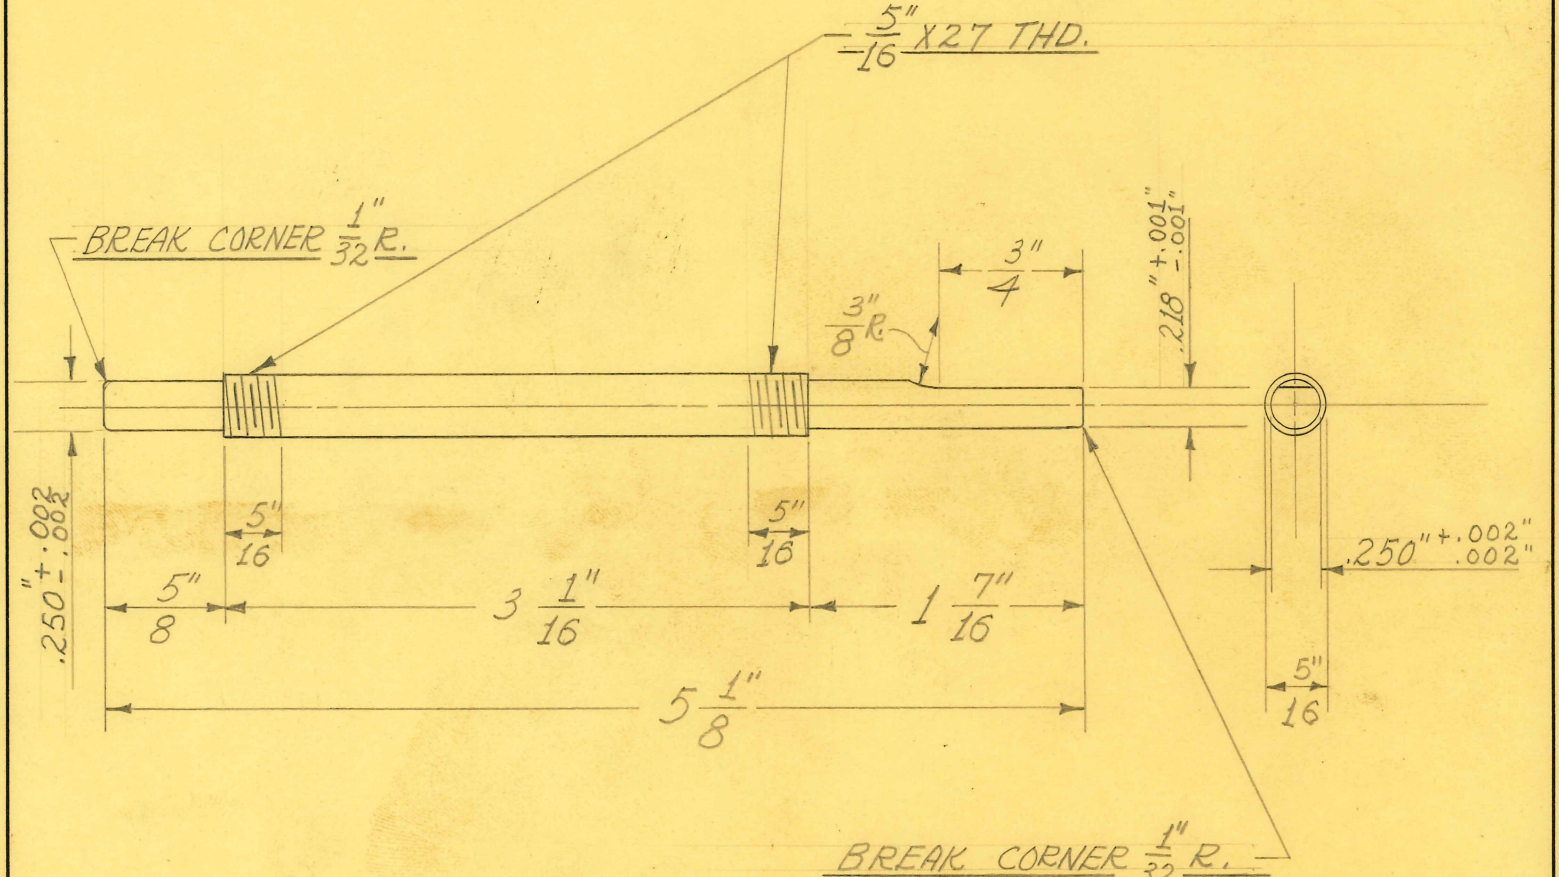

1 REQUIRED

OBSOLETE

SIZE	5/16" DIAM.	ISSUE 5-4-38	J.W.
KIND	SCREW STOCK	CHANGED	
SHAPE		"	
FINISH	CAD. #23	"	
TEMP.		"	
PATT.		"	

TITLE: FISCHER MOD. "6-24-72" PATIENT'S TUNING CONDENSER ROTOR SHAFT - FRONT

H. G. FISCHER & CO.
2335 WABANSIA AVE.
CHICAGO, ILL.

CAT. NO.

PART NO. 11618

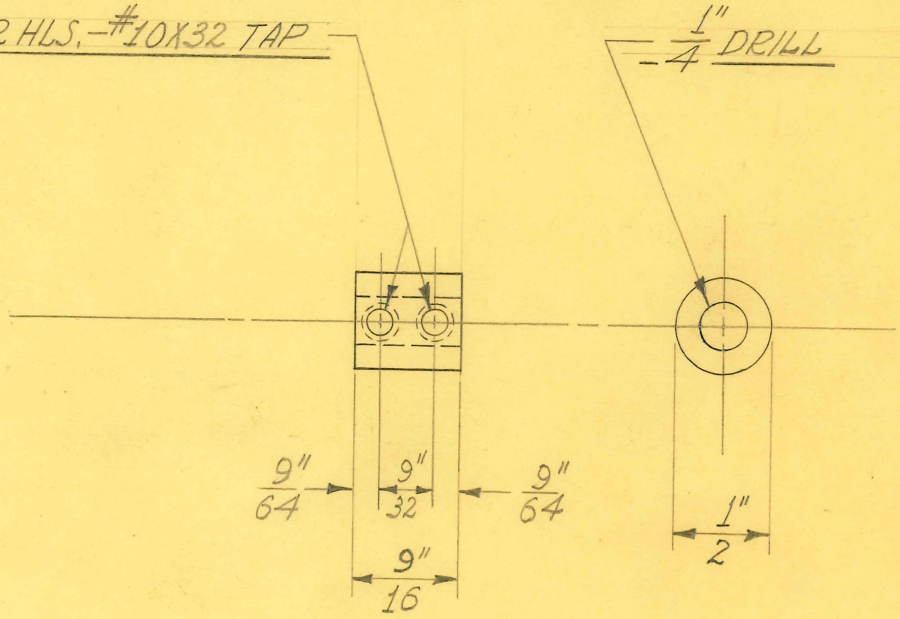

1 REQUIRED

OBSOLETE

SIZE	1/2" DIAM.	ISSUE 5-5-38	J.W.
KIND	SCREW STOCK	CHANGED	
SHAPE		"	
FINISH	CAD.# 23	"	
TEMP.		"	
PATT.		"	

TITLE: FISCHER MOD. "6-24-72" SHORT WAVE PATIENT'S TUNING COND.-ROTOR SHAFT COUPLING

H. G. FISCHER & CO.
2335 WABANSIA AVE.
CHICAGO, ILL.

CAT. NO.

PART NO. 11619

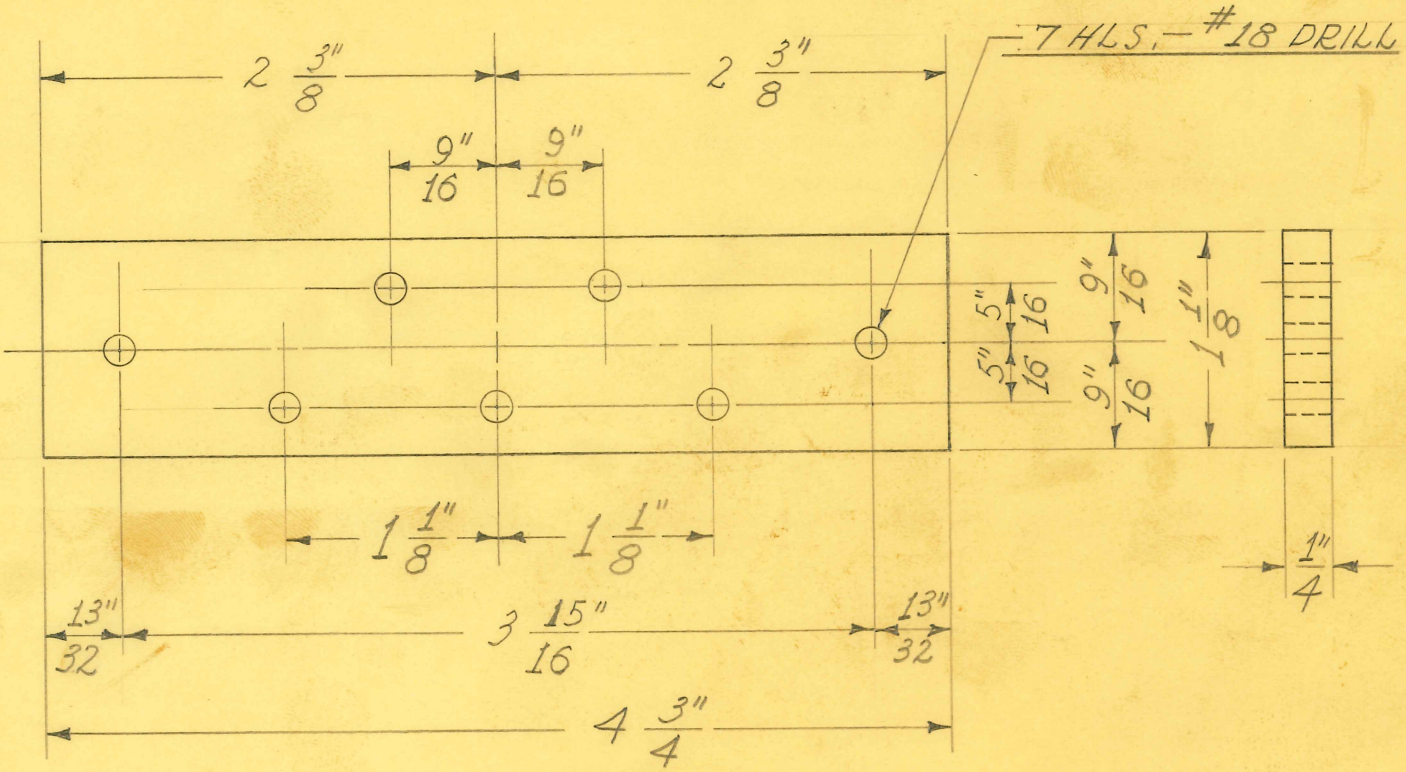

2 REQUIRED

OBSOLETE

SIZE	1/4" SHEET	ISSUE 5-6-38	J.W.
KIND	BAKELITE	CHANGED	
SHAPE		"	
FINISH		"	
TEMP.		"	
PATT.		"	

TITLE: FISCHER MOD. "6-24-72" SHORT WAVE FILAMENT TRANSF. TERMINAL SUPP.-BOARD

H. G. FISCHER & CO.
2335 WABANSIA AVE.
CHICAGO, ILL.

CAT. NO.

PART NO. 11626

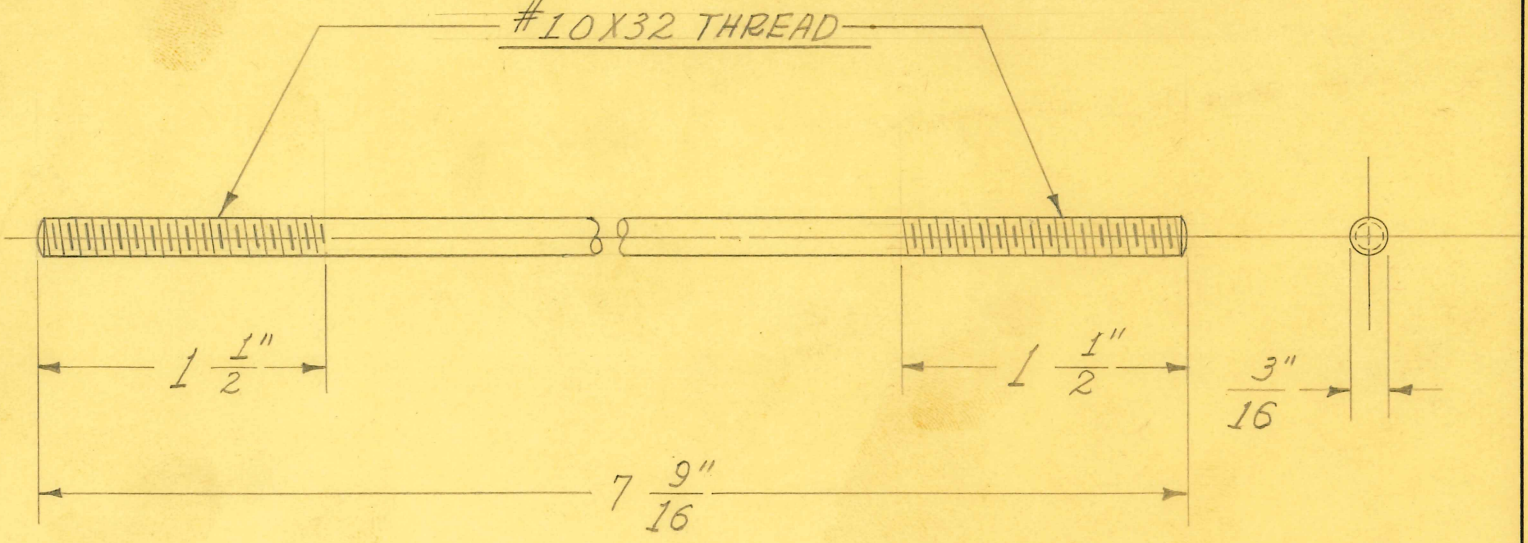

3 REQUIRED

OBSOLETE

SIZE	3/16" DIAM.	ISSUE 5-3-38	J.W.
KIND	BRASS ROD	CHANGED	
SHAPE		"	
FINISH		"	
TEMP.		"	
PATT.		"	

TITLE: FISCHER MOD. "6-24-72" SHORT WAVE FILAMENT CHOKE MOUNTING STUD

H. G. FISCHER & CO.
2335 WABANSIA AVE.
CHICAGO, ILL.

CAT. NO.

PART NO. 11628

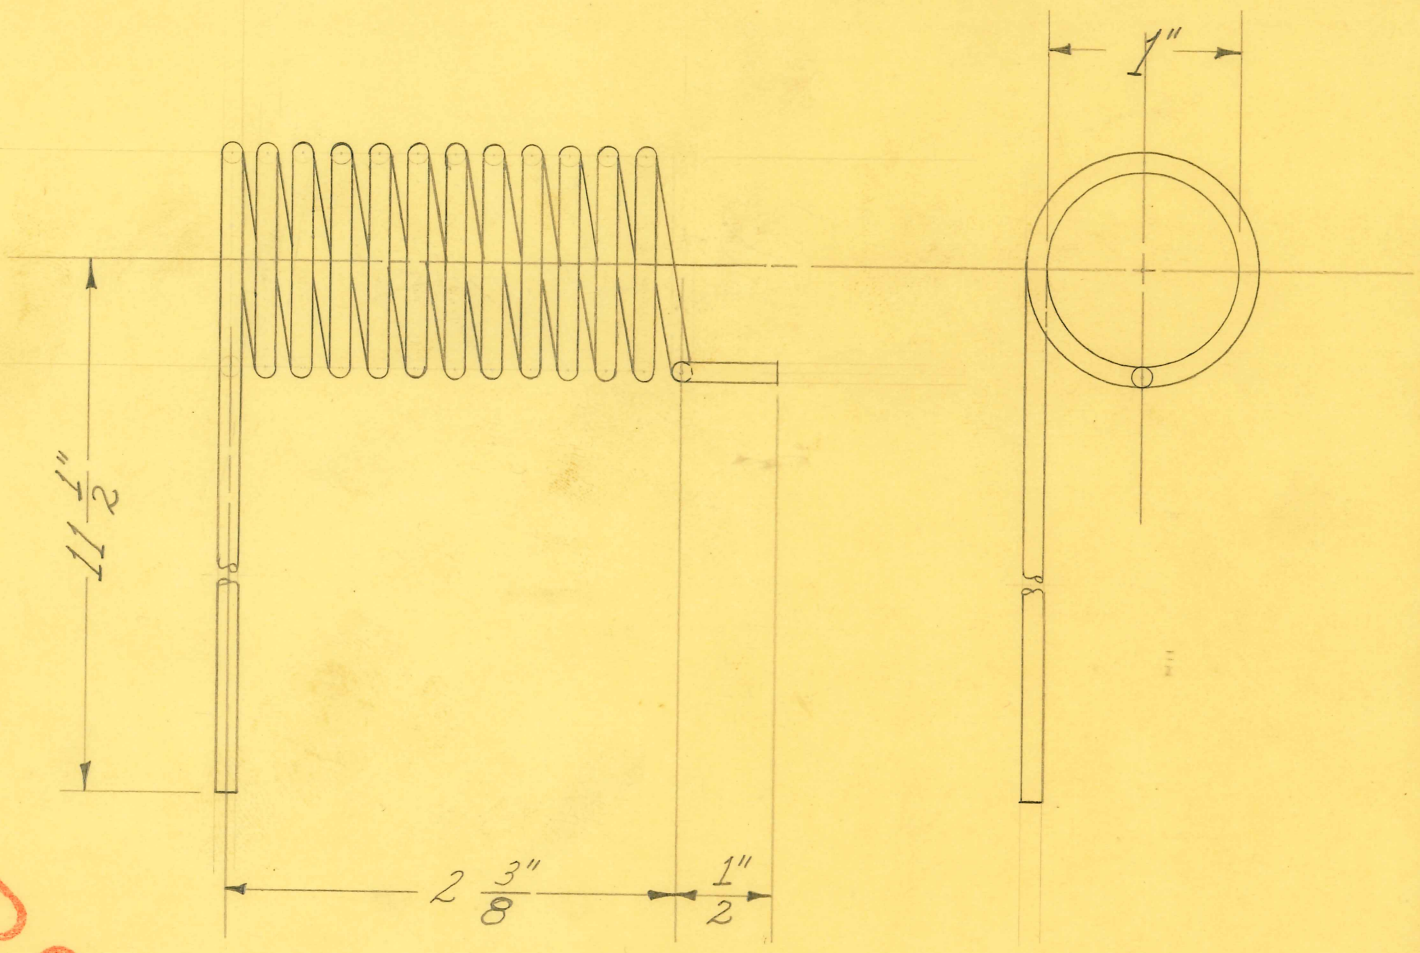

OBSOLETE

12 TURNS

1 REQUIRED

SIZE	#10 TINNED	ISSUE 5-10-38	J.W.
KIND	COPPER WIRE	CHANGED	
SHAPE		"	
FINISH		"	
TEMP.		"	
PATT.		"	

TITLE: FISCHER MOD. "6-24-72" SHORT WAVE 24 METER PATIENT'S TUNING COIL - RIGHT

H. G. FISCHER & CO.
2335 WABANSIA AVE.
CHICAGO, ILL.

CAT. NO.

PART NO. 11633

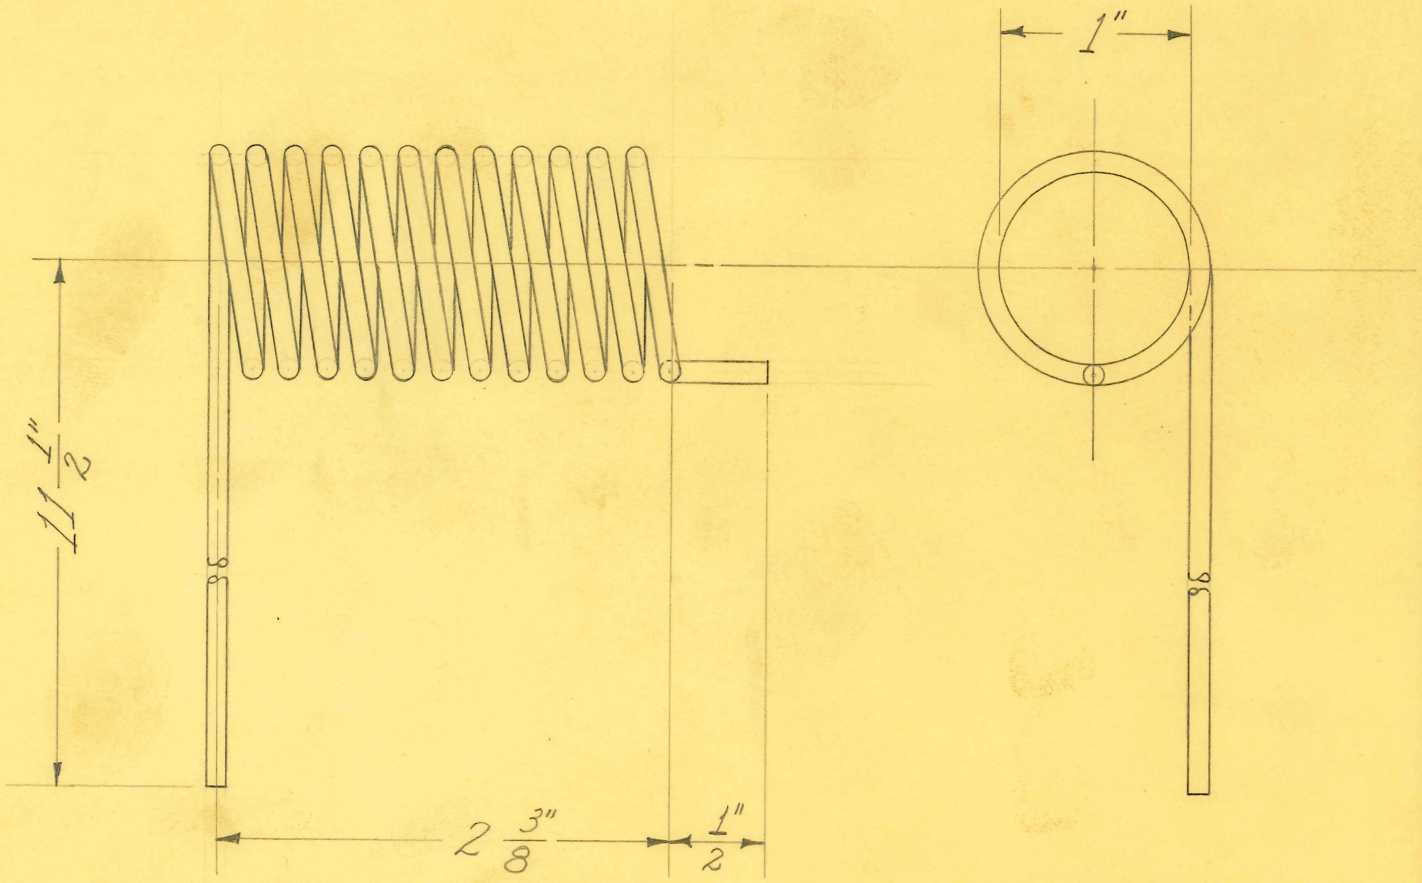

1 REQUIRED

12 TURNS

OBSOLETE

SIZE	#10 TINNED	ISSUE 5-9-38	J.W.	TITLE: FISCHER MOD. "6-24-72" SHORT WAVE 24 METER PATIENT'S TUNING COIL-LEFT
KIND	COPPER WIRE	CHANGED		
SHAPE		"		
FINISH		"		
TEMP.		"		
PATT.		"		

H. G. FISCHER & CO.
2338 WABANSIA AVE.
CHICAGO, ILL.

CAT. NO.

PART NO. 11634

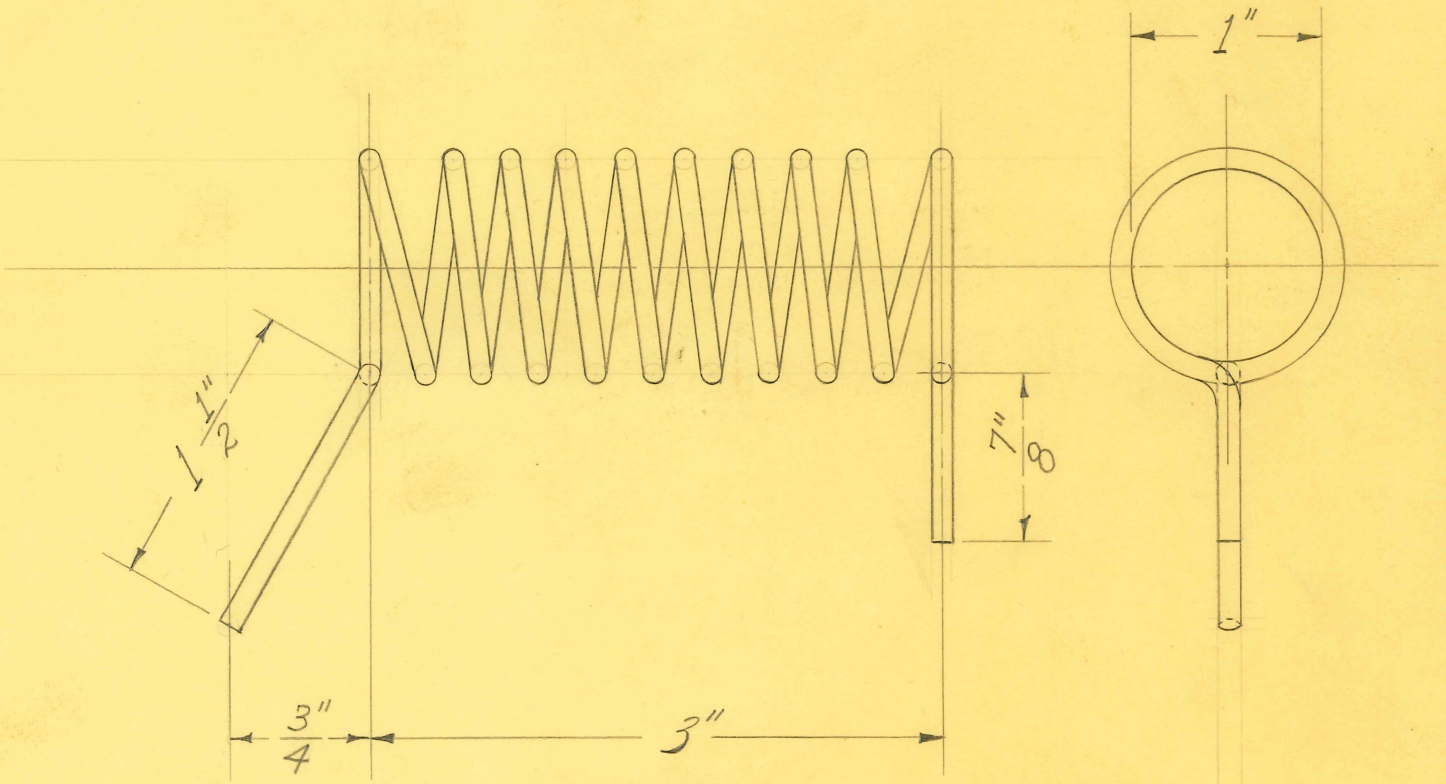

10 TURNS

1 REQUIRED

OBSOLETE

SIZE	#10 TINNED	ISSUE 5-10-38	J.W.	TITLE: FISCHER MOD. "6-24-72" SHORT WAVE 6 METER PATIENT'S TUNING COIL - RIGHT
KIND	COPPER WIRE	CHANGED		
SHAPE		"		
FINISH		"		
TEMP.		"		
PATT.		"		

H. G. FISCHER & CO.
2335 WABANSIA AVE.
CHICAGO, ILL.

CAT. NO.

PART NO. 11636

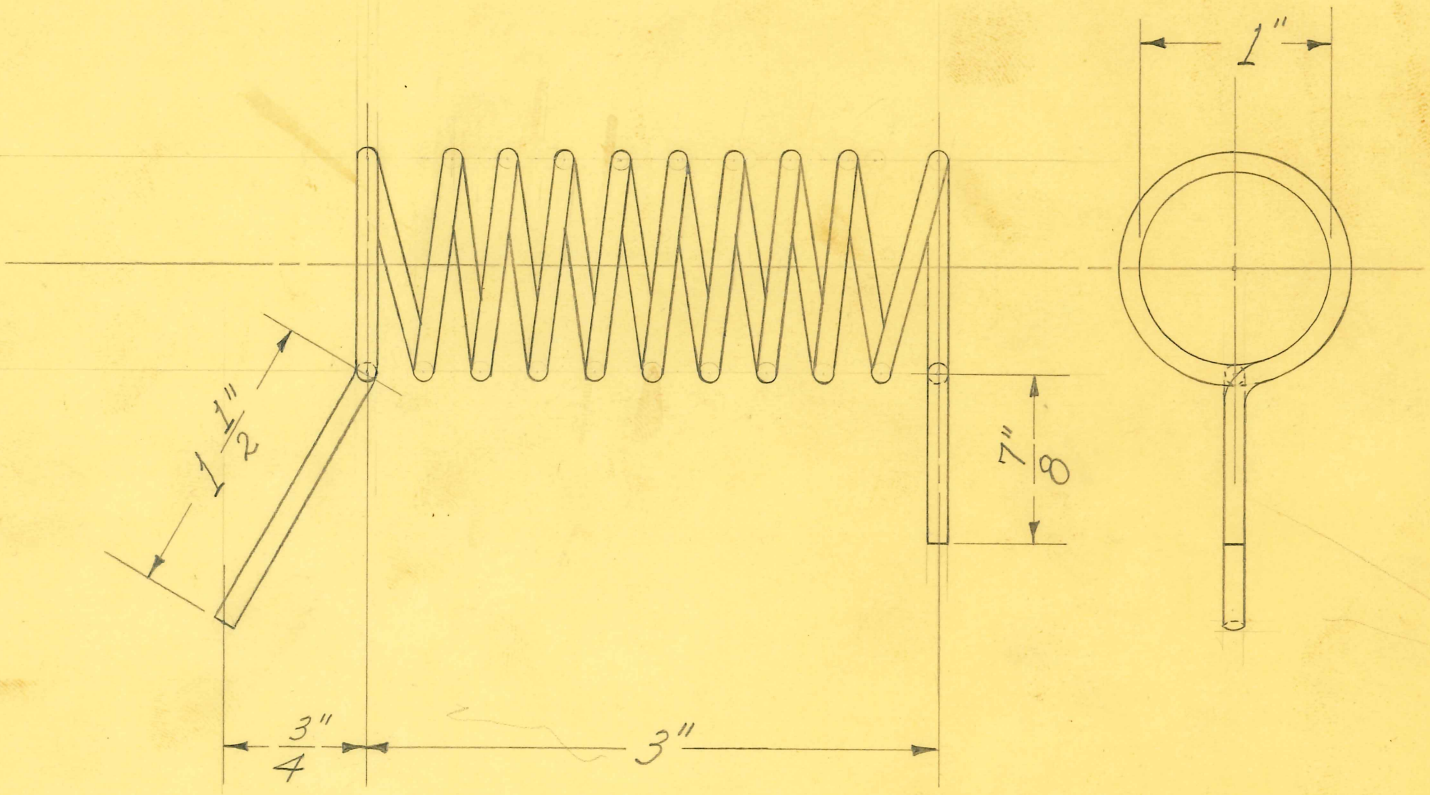

10 TURNS

1 REQUIRED

OBSOLETE

SIZE	#10 TINNED	ISSUE 5-10-38	J.W.
KIND	COPPER WIRE	CHANGED	
SHAPE		"	
FINISH		"	
TEMP.		"	
PATT.		"	

TITLE: FISCHER MOD. "6-24-72" SHORT WAVE 6 METER PATIENT'S TUNING COIL - LEFT

H. G. FISCHER & CO.
2335 WABANSIA AVE.
CHICAGO, ILL.

CAT. NO.

PART NO. 11637

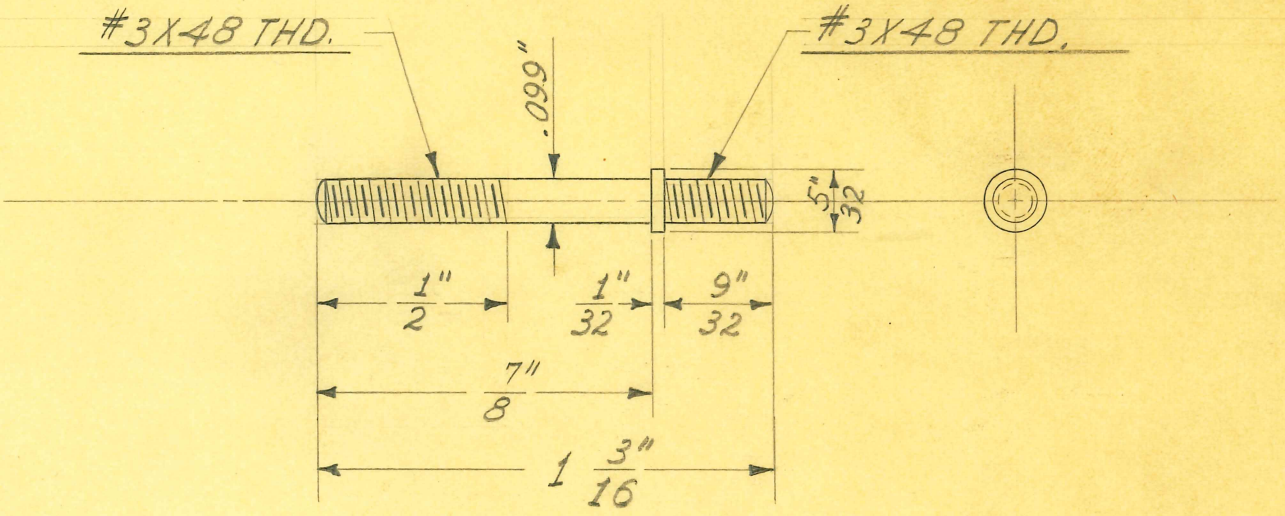

SCALE ÷ 2 DIAMETERS

OBSOLETE

SIZE	5/32" DIAM.	ISSUE 11-19-37	J.W.
KIND	ZINC ROD	CHANGED	
SHAPE		"	
FINISH		"	
TEMP.		"	
PATT.		"	

TITLE: DR. LINN ADJ. EAR ZINC ELECT. COTTON HOLDER ROD TIP

H. G. FISCHER & CO.
2335 WABANSIA AVE.
CHICAGO, ILL.

CAT. NO.

PART NO. 7861

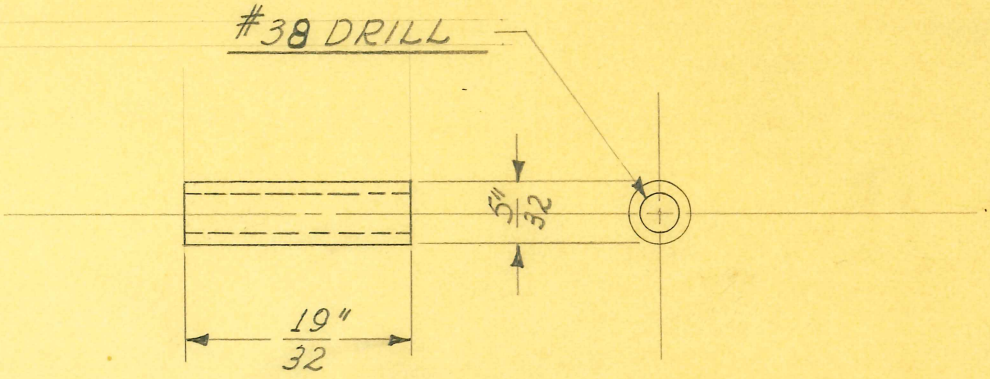

SCALE ÷ 2 DIAMETERS

OBSOLETE

SIZE	3/32" I.D. X 5/32" O.D.	ISSUE 11-19-37	J.W.
KIND	POL. RUB. TUBING	CHANGED	
SHAPE		"	
FINISH		"	
TEMP.		"	
PATT.		"	

TITLE: DR. LINN ADJ. EAR ZINC ELECT. COTTON HOLDER ROD TIP INSULATOR

H. G. FISCHER & CO.
2335 WABANSIA AVE.
CHICAGO, ILL.

CAT. NO.

PART NO. 7862

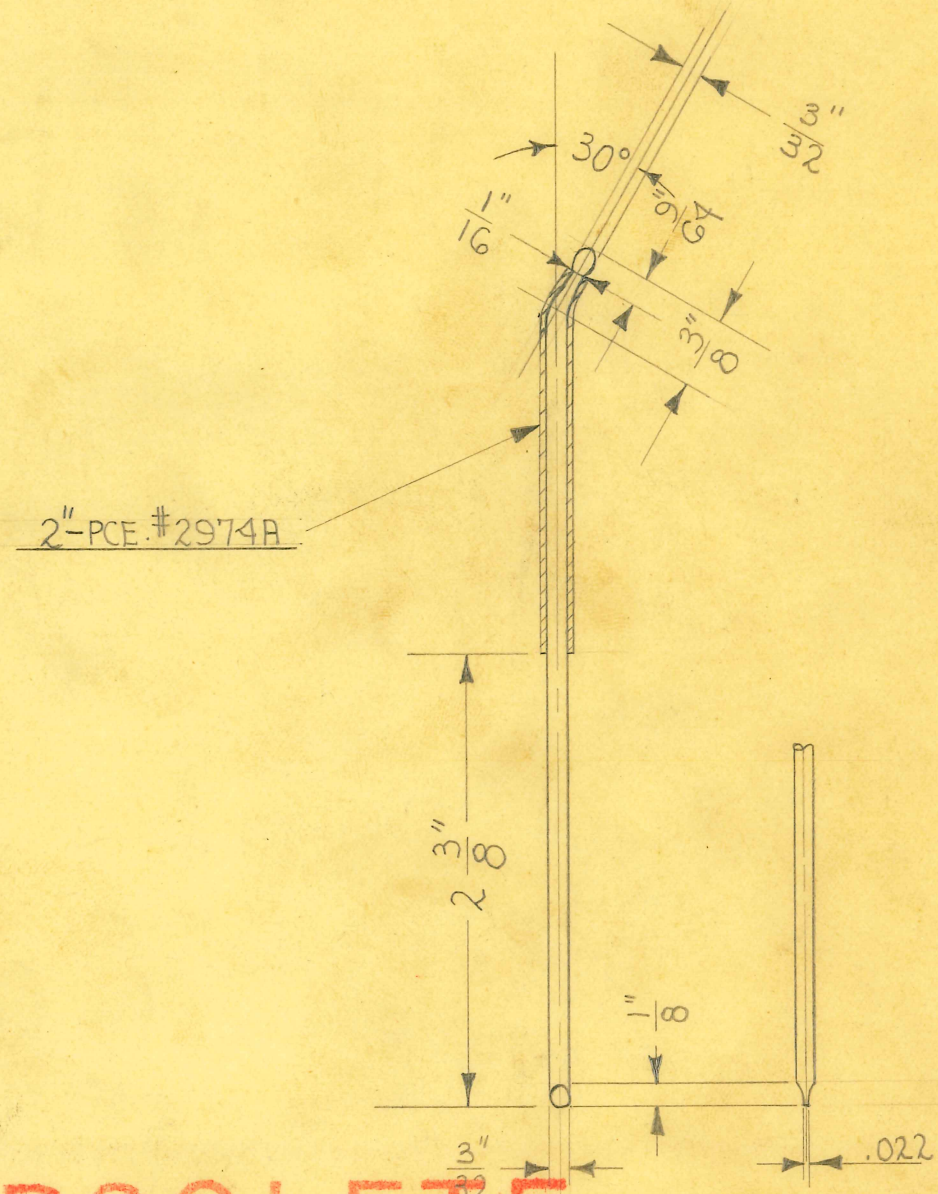

OBSOLETE

DEVELOPED LENGTH - 4 3/8" UNDER OLIVE

SIZE	3/32" ROD	ISSUE 9-6-35	J.W.
KIND	STAINLESS STEEL	CHANGED	
SHAPE		"	
FINISH	POL. & BUFF BALL END	"	
TEMP.		"	
PATT.		"	

TITLE: GROSS SHORT WAVE CORG. ELECTRODE

H. G. FISCHER & CO.
2335 WABANSIA AVE.
CHICAGO, ILL.

CAT. NO. 2847

PART NO. 7935G
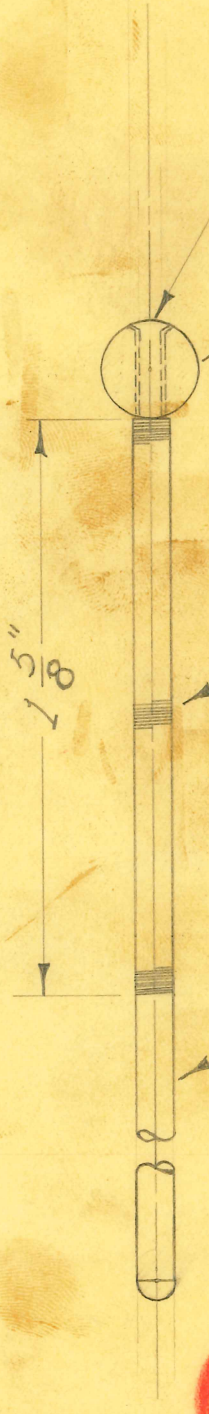
OBSOLETE

SIZE		ISSUE 10-30-36	J.W.
KIND		CHANGED	
SHAPE		"	
FINISH		"	
TEMP.		"	
PATT.		"	

TITLE: GROSS REVOLVING BALL SHORT WAVE DEHYDRATING ELECTRODE

H. G. FISCHER & CO.
2335 WABANSIA AVE.
CHICAGO, ILL.

CAT. NO.

PART NO. 7940G

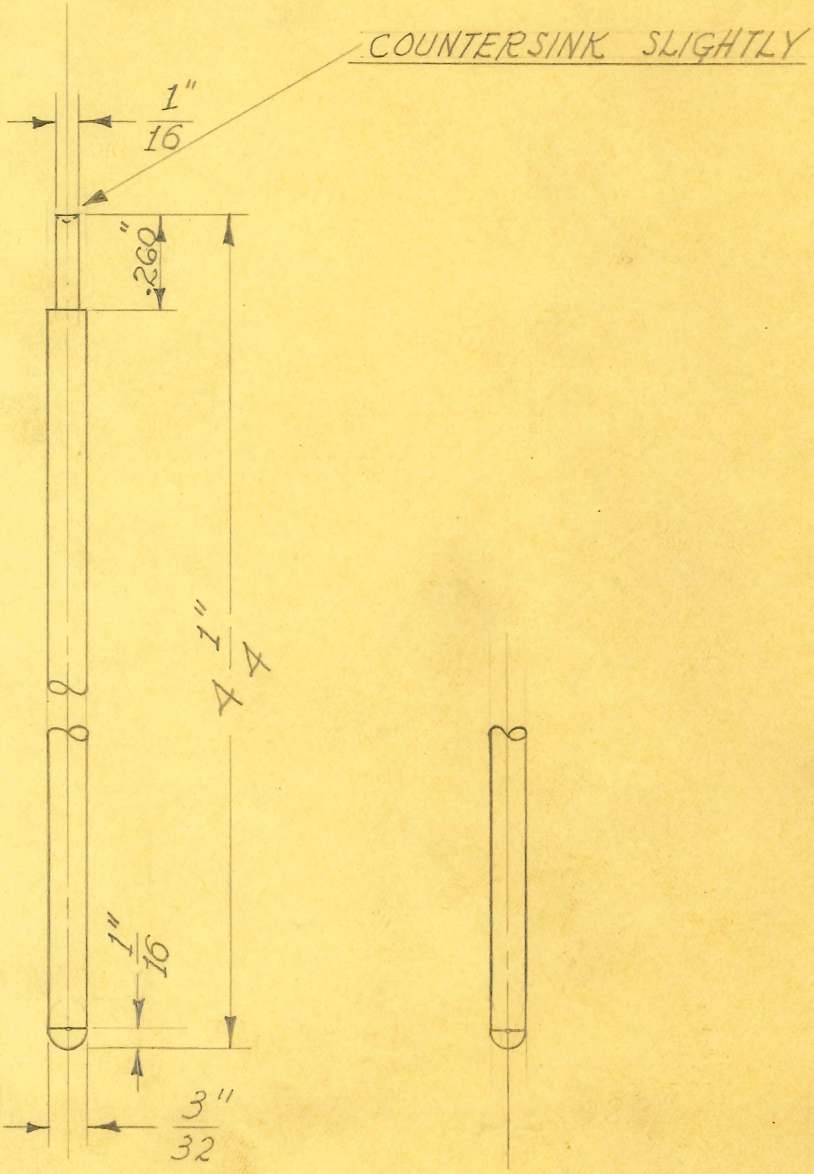

OBSOLETE

SCALE: 2 DIAM.

SIZE	3/32" DIAM.	ISSUE 10-30-36	J.W.
KIND	STAINLESS	CHANGED 11-20-36	J.W.
SHAPE	STEEL	"	
FINISH		"	
TEMP.		"	
PATT.		"	

TITLE: GROSS REVOLVING BALL SHORT WAVE DEHYDRATING ELECTRODE-SHAFT

H. G. FISCHER & CO.
2335 WABANSIA AVE.
CHICAGO, ILL.

CAT. NO.

PART NO. 7941

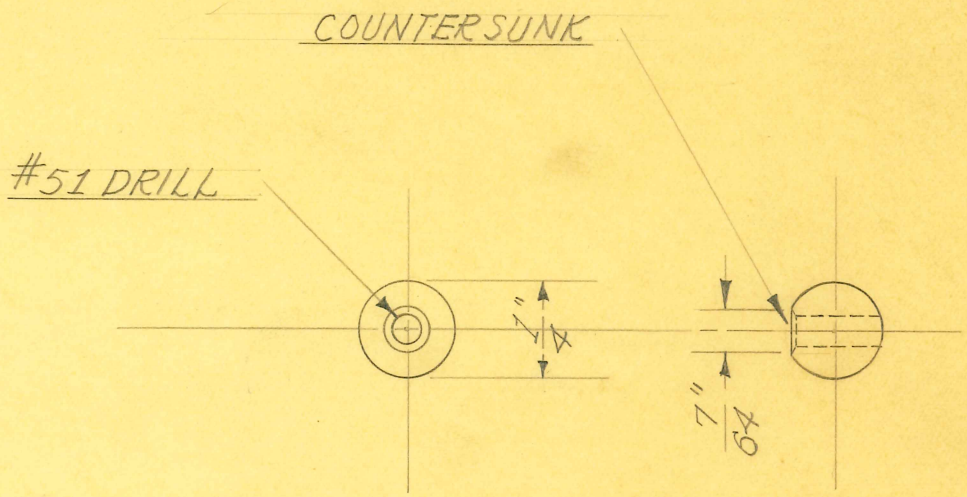

SCALE: 2 DIAM.

OBSOLETE

SIZE	1/4" DIAM.	ISSUE 10-30-36	J.W.
KIND	ALUMINUM	CHANGED	
SHAPE	ROD	"	
FINISH		"	
TEMP.		"	
PATT.		"	

TITLE: GROSS REVOLVING BALL SHORT WAVE DEHYDRATING ELECTRODE BALL

H. G. FISCHER & CO.
2335 WABANSIA AVE.
CHICAGO, ILL.

CAT. NO.

PART NO. 7942

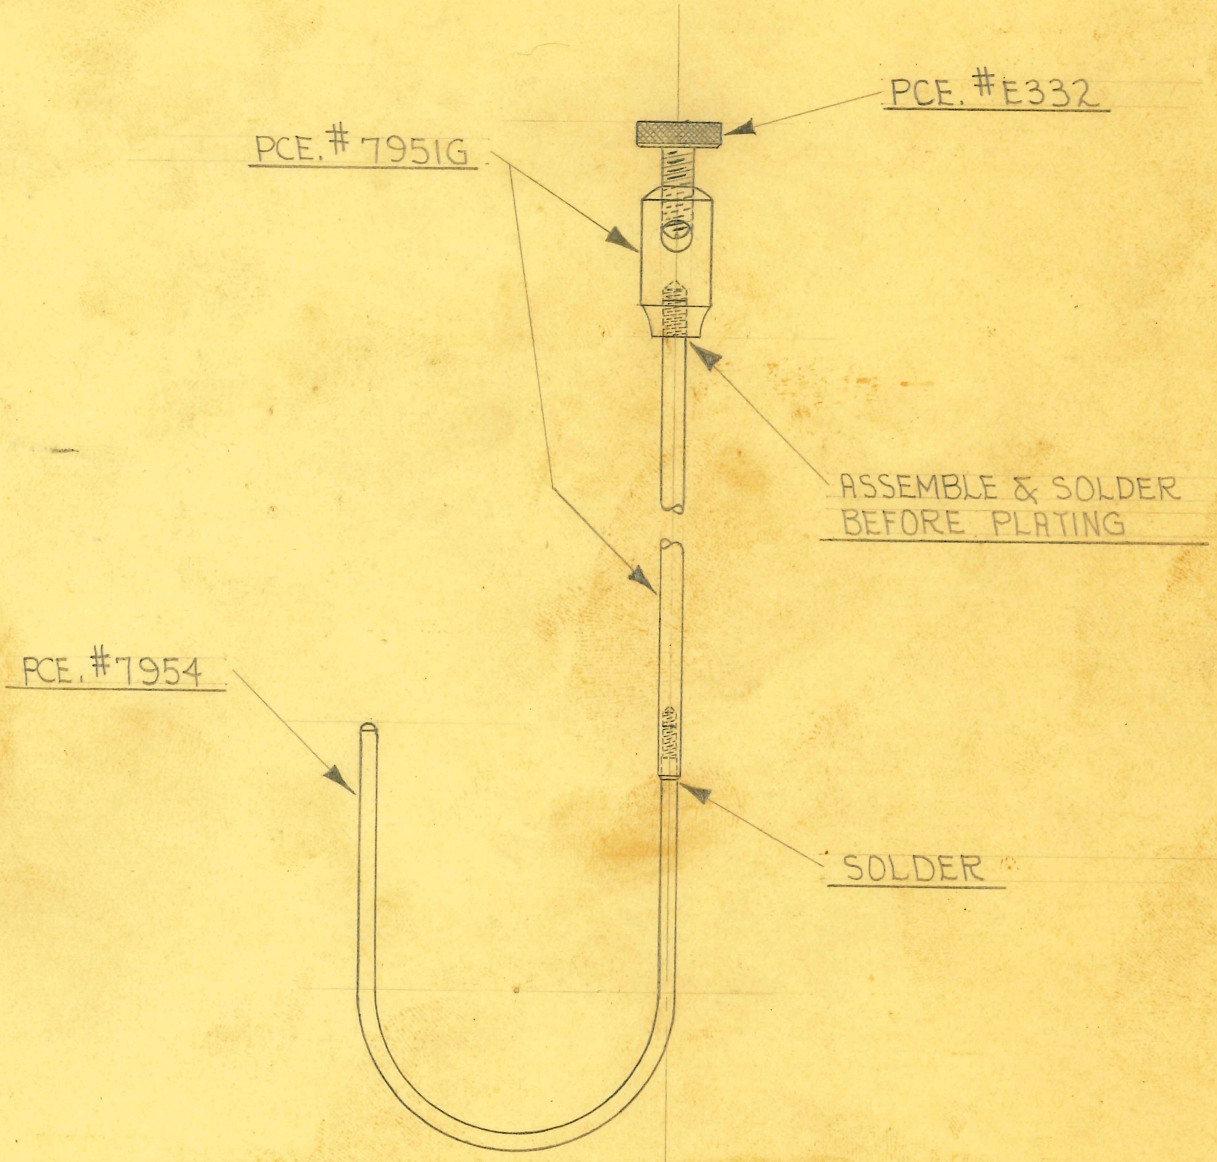

OBSOLETE

SIZE		ISSUE 8-29-35	J.W.
KIND		CHANGED	
SHAPE		"	
FINISH		"	
TEMP.		"	
PATT.		"	

TITLE: NASAL IONIZATION ZINC ELECTRODE ASSEMBLY

H. G. FISCHER & CO.
2335 WABANSIA AVE.
CHICAGO, ILL.

CAT. NO. 1357

PART NO. 7950G

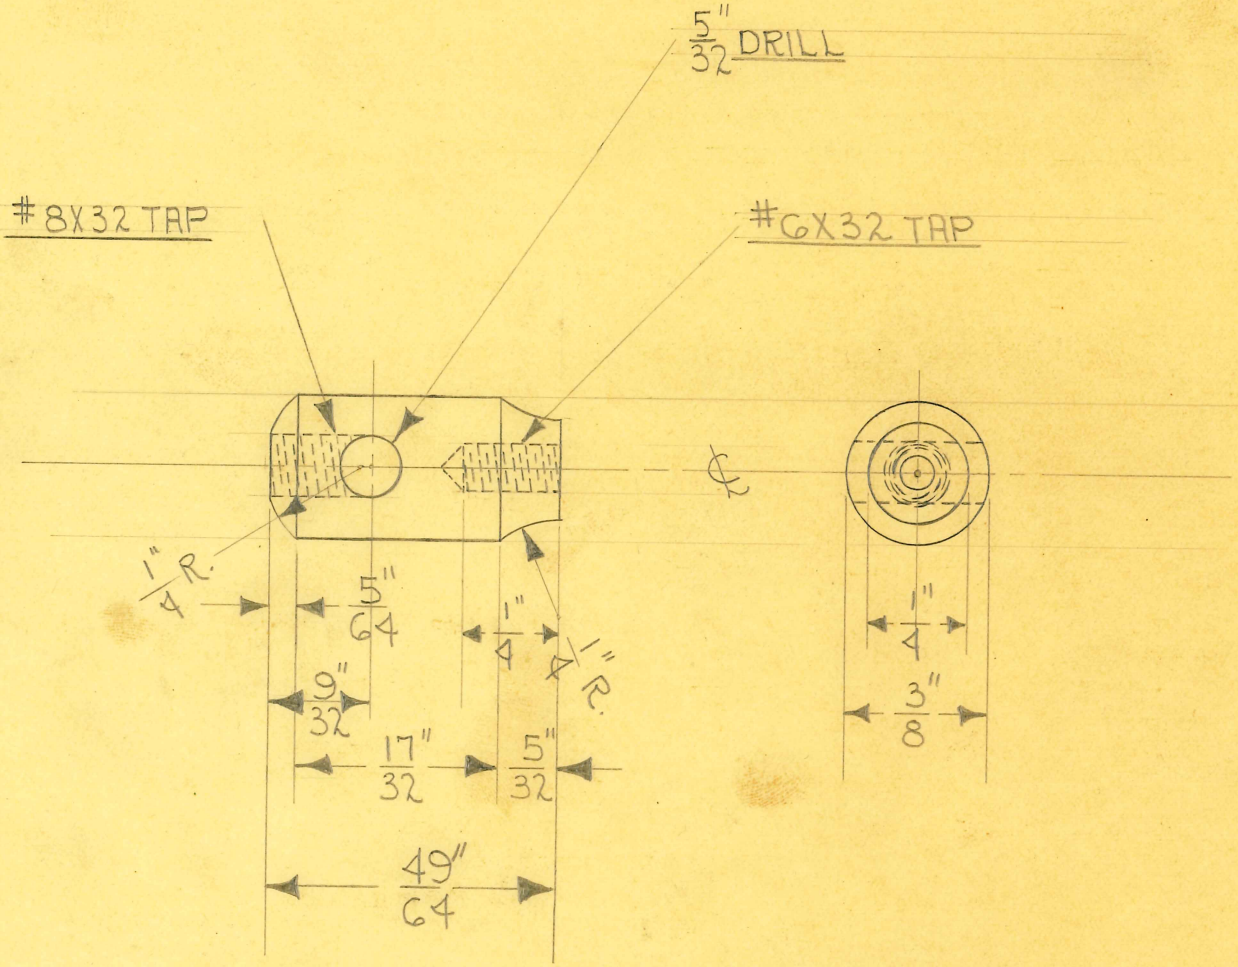

SCALE ~ 2 DIAM.

1 REQUIRED

OBSOLETE

SIZE	3/8 BRASS	ISSUE 8-30-35	J.W.
KIND	ROD	CHANGED	
SHAPE		"	
FINISH		"	
TEMP.		"	
PATT.		"	

TITLE: NASAL IONIZATION ZINC ELECTRODE BINDING POST

H. G. FISCHER & CO.
2335 WABANSIA AVE.
CHICAGO, ILL.

CAT. NO.

PART NO. 7952

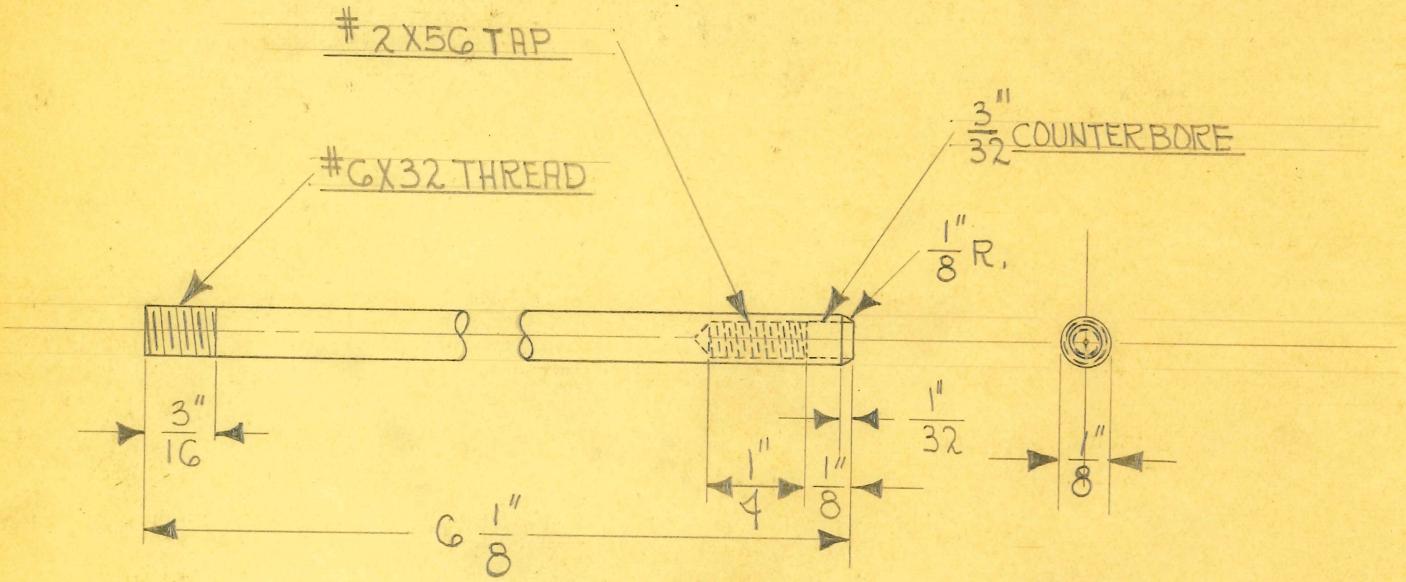

SCALE ÷ 2 DIAM.

1 REQUIRED

OBSOLETE

SIZE	1/8" BRASS	ISSUE 8-30-35	J.W.	TITLE: NASAL IONIZATION ZINC ELECTRODE ROD
KIND	ROD	CHANGED		
SHAPE		"		
FINISH		"		
TEMP.		"		
PATT.		"		

H. G. FISCHER & CO.
2335 WABANSIA AVE.
CHICAGO, ILL.

CAT. NO.

PART NO. 7953

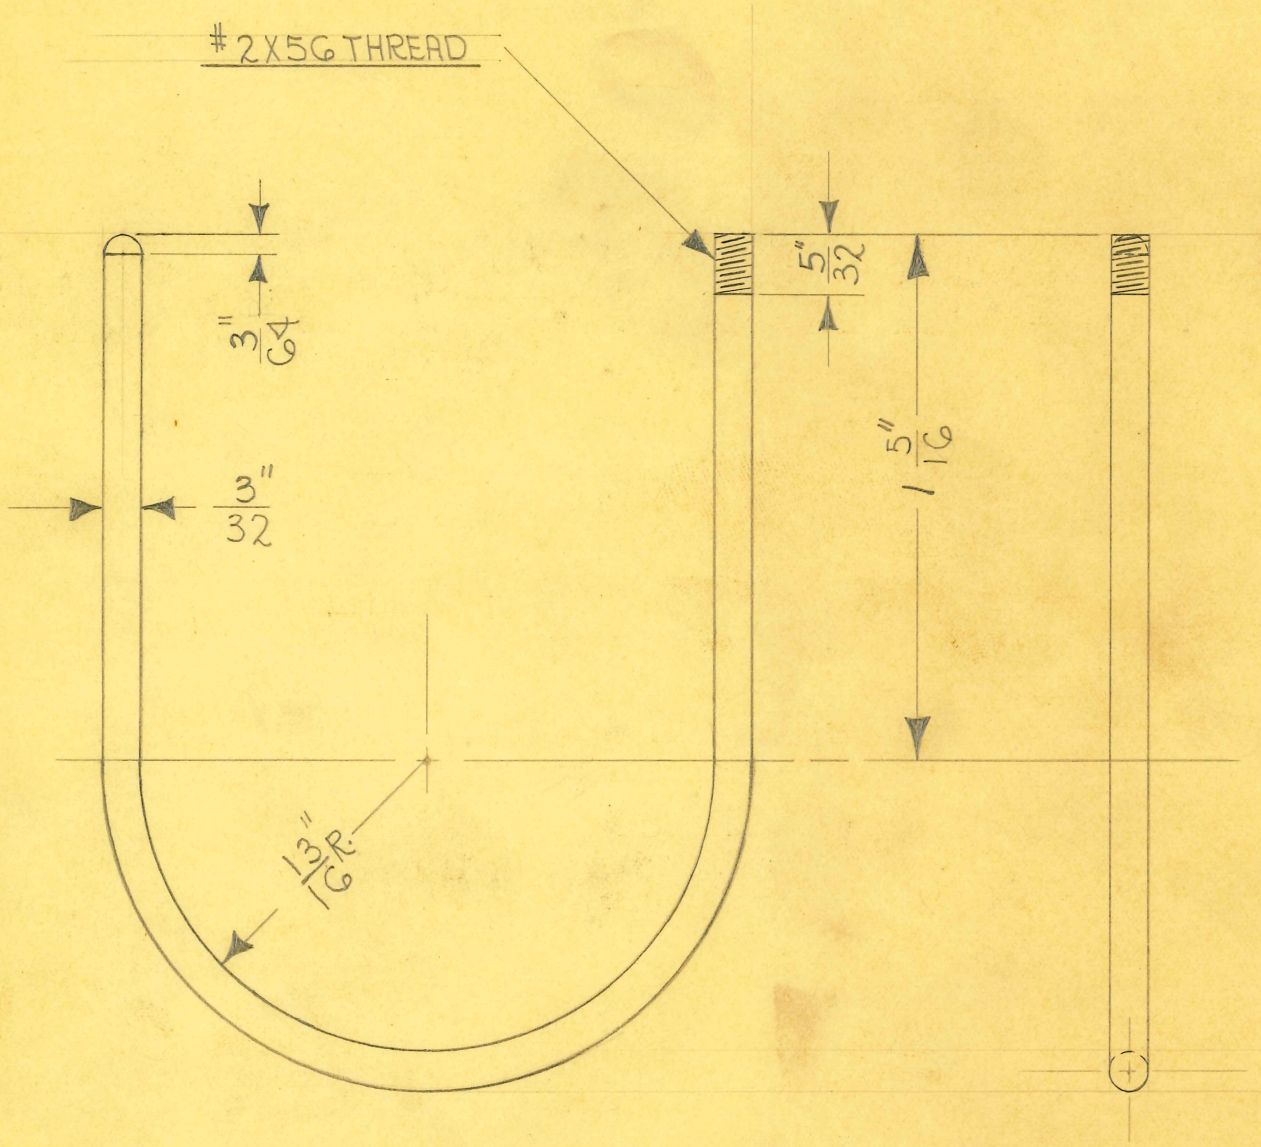

SCALE ~ 2 DIAM.

BEND OVER 1 1/2" ROD

OBSOLETE

1 REQUIRED

DEV. LENGTH 5 1/4"

SIZE	3/32" ZINC	ISSUE 8-30-35	J.W.	TITLE: NASAL IONIZATION ZINC ELECTRODE
KIND	ROD	CHANGED		
SHAPE		"		
FINISH		"		
TEMP.		"		
PATT.		"		

H. G. FISCHER & CO.
2335 WABANSIA AVE.
CHICAGO, ILL.

CAT. NO.

PART NO. 7954

SCREW & SOLDER
2-#3898 1/4 IN PLACE

M 814 F.H.B. SOLDERED IN PLACE
USE 5/32" HOLLOW MILL UP TO
PLATE. FOLLOW WITH #8X32 DIE

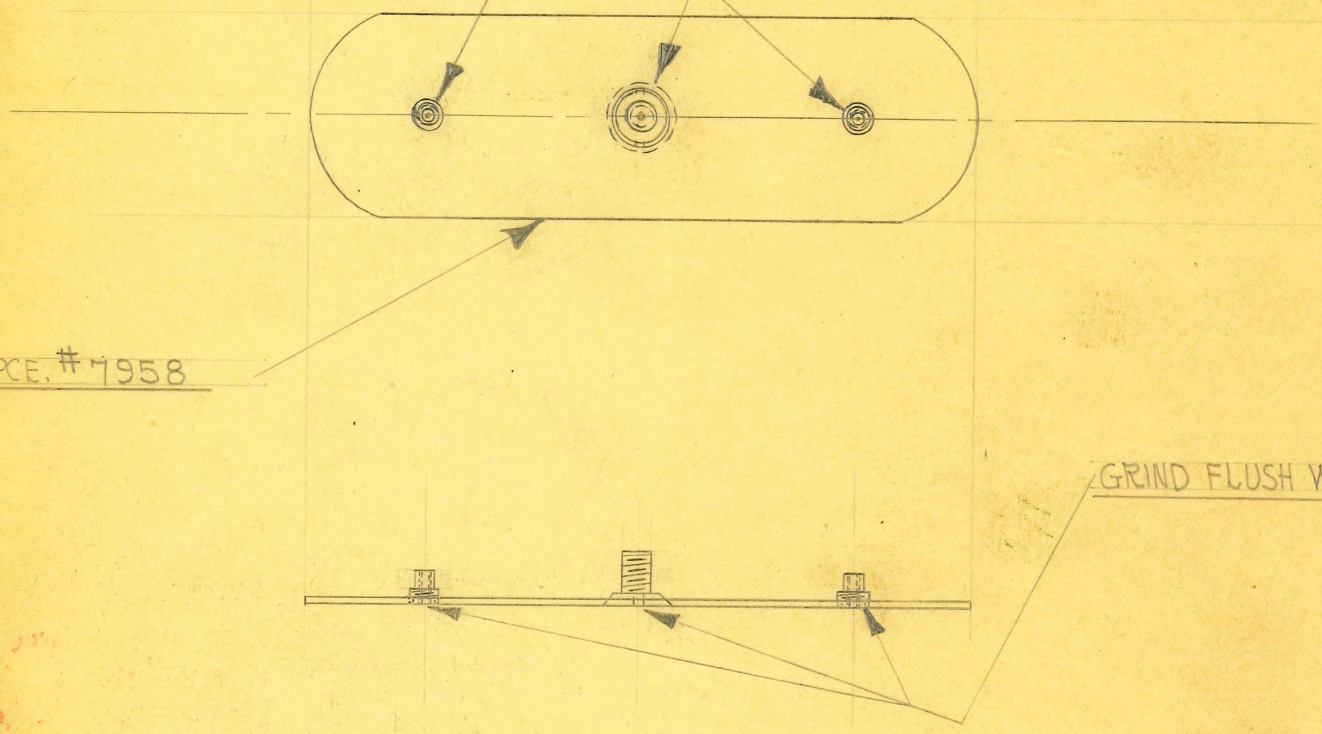

PCE. #7958

GRIND FLUSH WITH PLATE

1 REQUIRED

OBSOLETE

SIZE		ISSUE 9-17-35	J.W.
KIND		CHANGED	
SHAPE		"	
FINISH	WHITE PL. #13	"	
TEMP.		"	
PATT.		"	

TITLE: LEATHER HEADBAND PLATE ASSEMBLY

H. G. FISCHER & CO.
2335 WABANSIA AVE.
CHICAGO, ILL.

CAT. NO.

PART NO. 7957G

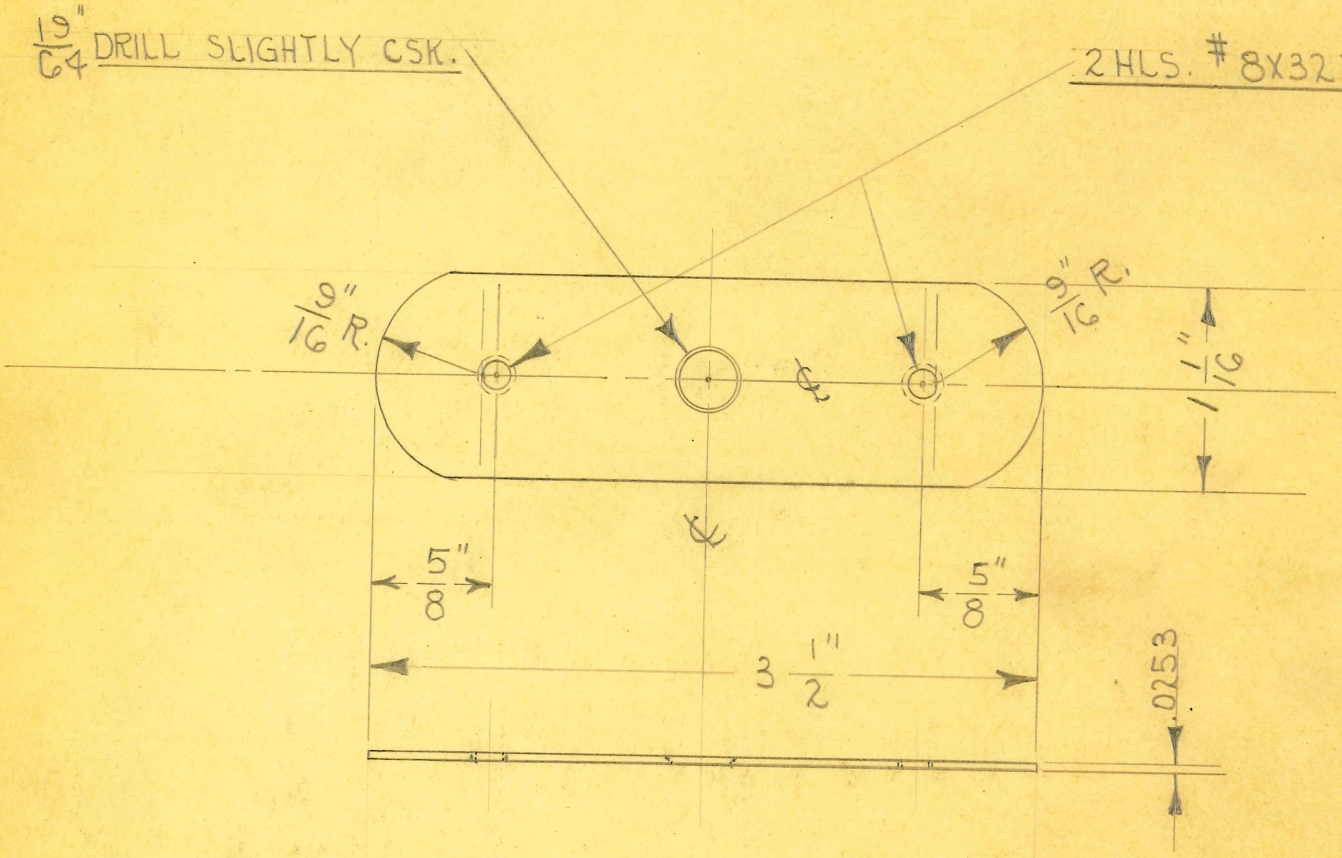

1 REQUIRED

OBSOLETE

SIZE	#22GA. DEAD	ISSUE 9-17-35	J.W.
KIND	SOFT SHEET BRASS	CHANGED	
SHAPE		"	
FINISH		"	
TEMP.		"	
PATT.		"	

TITLE: LEATHER HEADBAND PLATE

H. G. FISCHER & CO.
2335 WABANSIA AVE.
CHICAGO, ILL.

CAT. NO.

PART NO. 7958

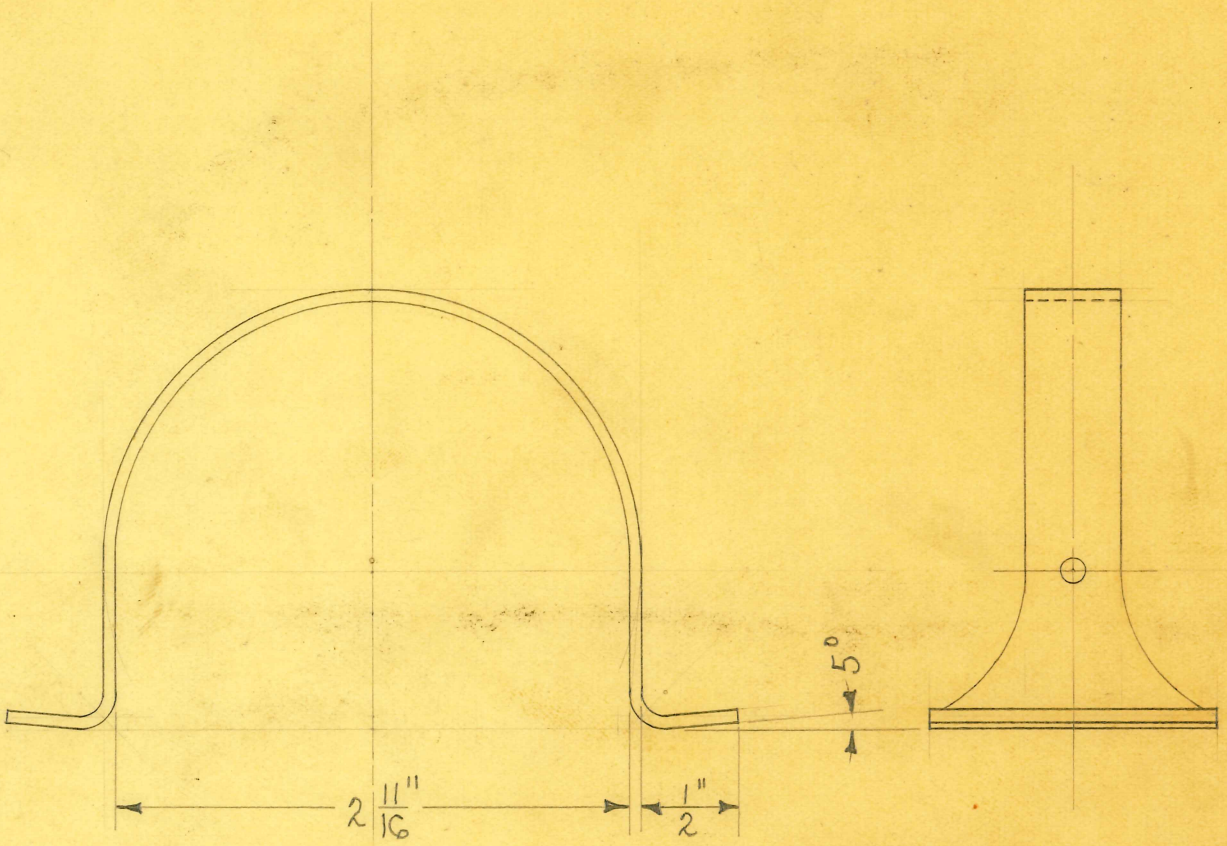

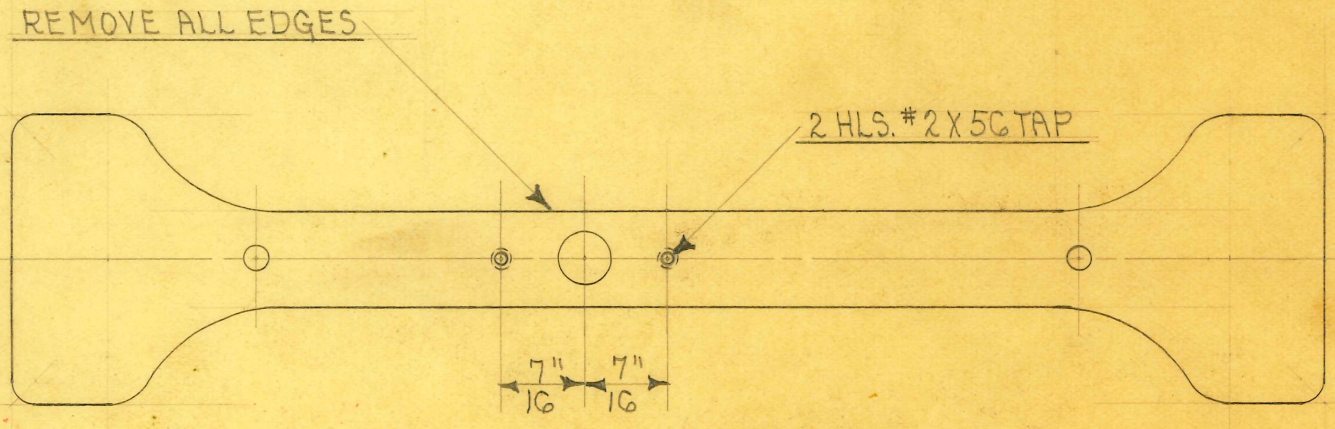

2 REQUIRED

1 - COMMERCIAL NICKEL #12

1 - COPPER POLISHED #32

OBSOLETE

SIZE		ISSUE 7-10-34	A.E.	**TITLE:** YAZUJIAN HEADBAND EAR ELECT. SUPPORT
KIND		CHANGED		
SHAPE		"		
FINISH		"		
TEMP.		"		
PATT.		"		

H. G. FISCHER & CO.
2335 WABANSIA AVE.
CHICAGO, ILL.

CAT. NO.

PART NO. 8957F

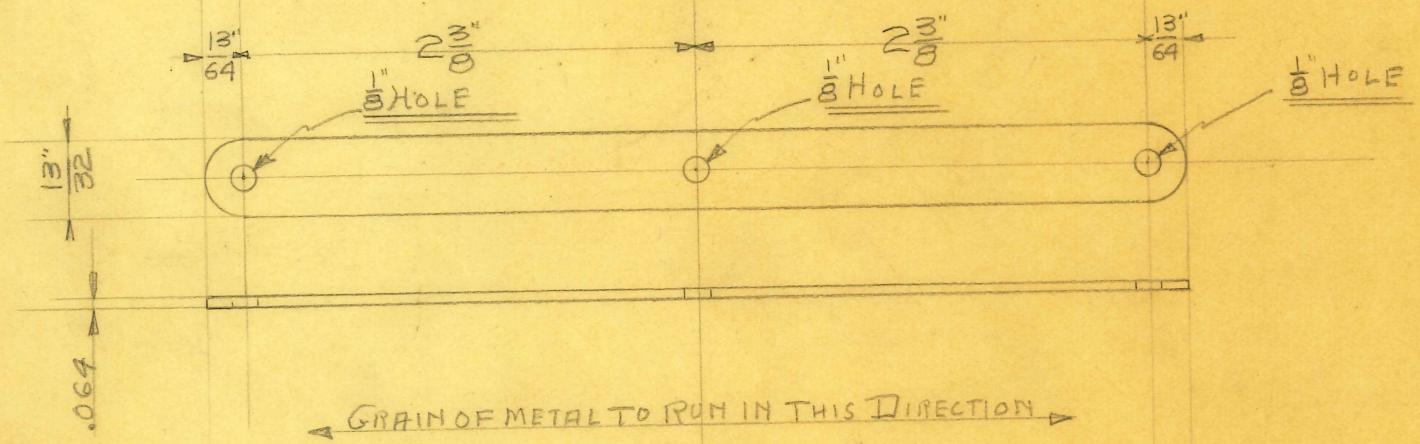

No. 19 B+S. GAUGE HALF HARD SHEET BRASS

2 REQUIRED

OBSOLETE

SIZE		ISSUE	
KIND		CHANGED	
SHAPE		"	
FINISH		"	
TEMP.		"	
PATT.		"	

TITLE: YAZUJIAN HEAD BAND EAR ELECTRODE SUPPORT BOW.

H. G. FISCHER & CO.
2335 WABANSIA AVE.
CHICAGO, ILL.

CAT. NO.

PART NO. 8958

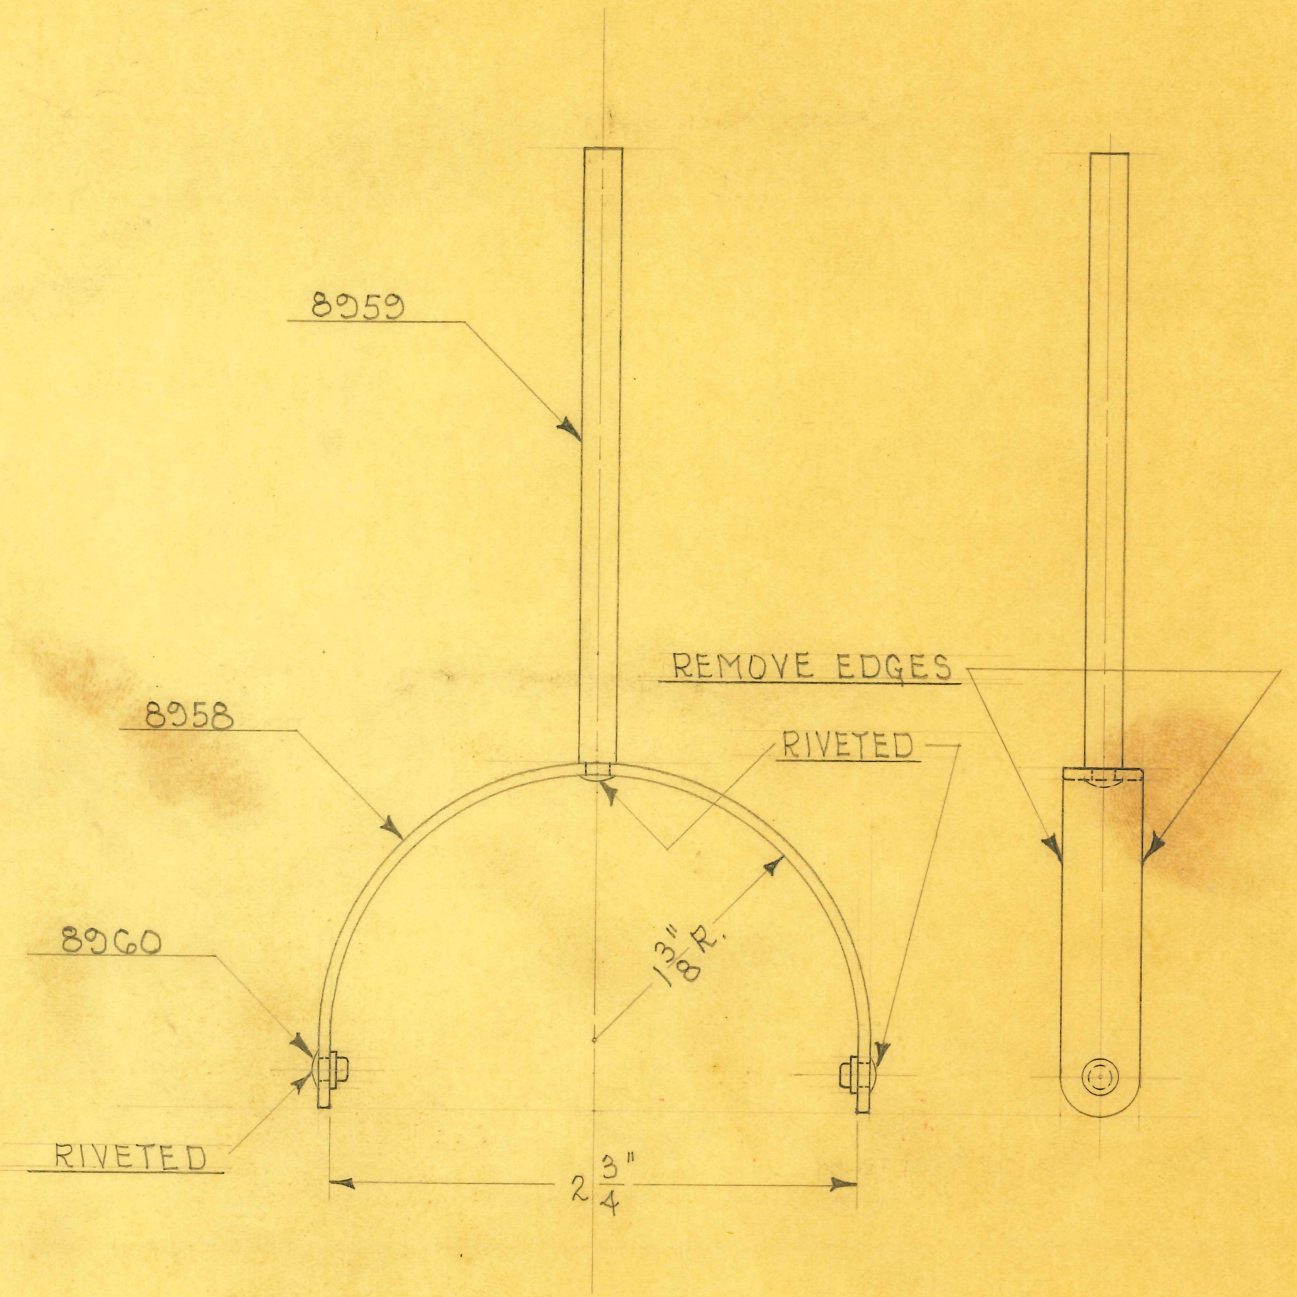

2 REQUIRED

OBSOLETE

SIZE		ISSUE 7-6-34	A.E.	**TITLE:** YAZUJIAN HEADBAND EAR ELECTRODE SUPPORT BOW ASSEMBLY
KIND		CHANGED		
SHAPE		"		
FINISH	NICKEL #12	"		
TEMP.		"		
PATT.		"		

H. G. FISCHER & CO.
2335 WABANSIA AVE.
CHICAGO, ILL.

CAT. NO.

PART NO. 8958G

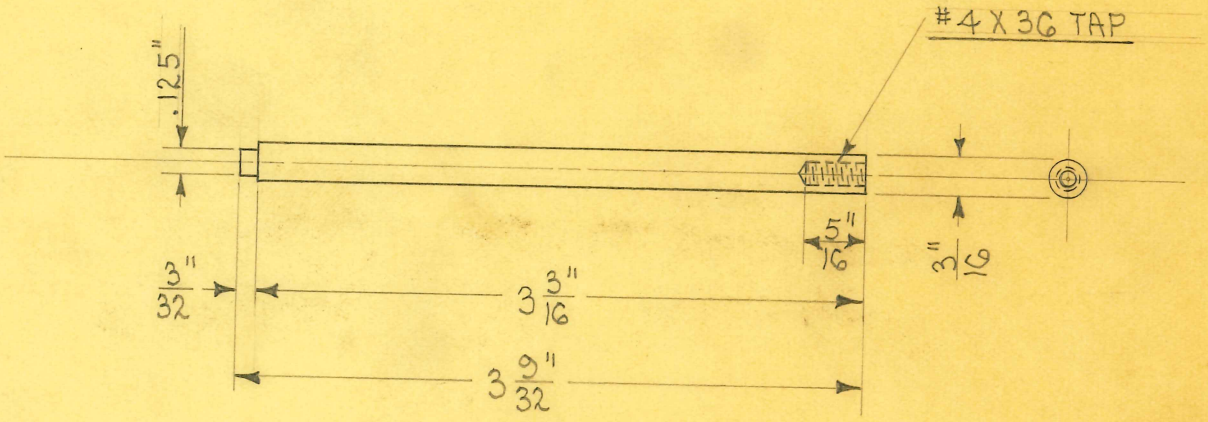

2 REQUIRED

OBSOLETE

SIZE	3/16"	ISSUE 7-9-34	A.E.	TITLE: YAZUJIAN HEADBAND EAR ELECT. SUPPORT BOW ROD	
KIND	BRASS ROD	CHANGED			
SHAPE		"			
FINISH		"			
TEMP.		"			
PATT.		"			
H. G. FISCHER & CO. 2335 WABANSIA AVE. CHICAGO, ILL.		CAT. NO.		PART NO. 8959	

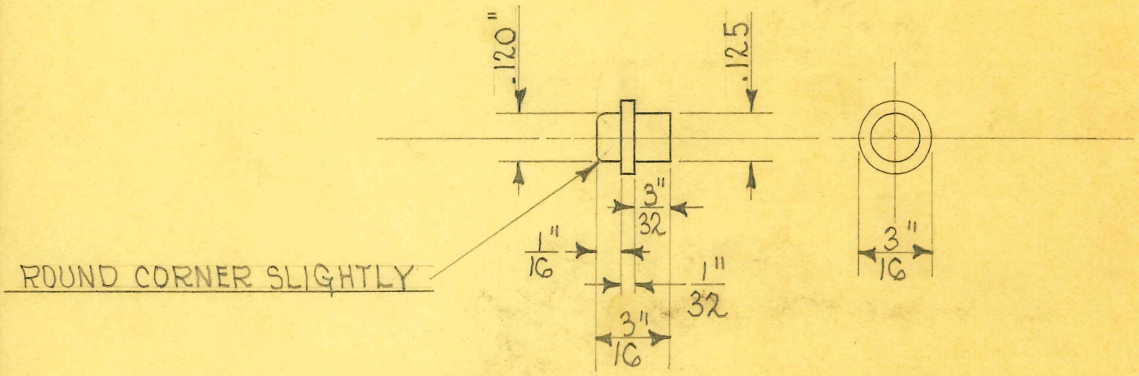

SCALE ~ 2 DIAMETERS

4 REQUIRED

OBSOLETE

SIZE	3/16"	ISSUE 7-9-34	A.E.
KIND	BRASS ROD	CHANGED	
SHAPE		"	
FINISH		"	
TEMP.		"	
PATT.		"	

TITLE: YAZUJIAN HEADBAND EAR ELECT. SUPPORT BOW PIN

H. G. FISCHER & CO.
2335 WABANSIA AVE.
CHICAGO, ILL.

CAT. NO.

PART NO. 8960

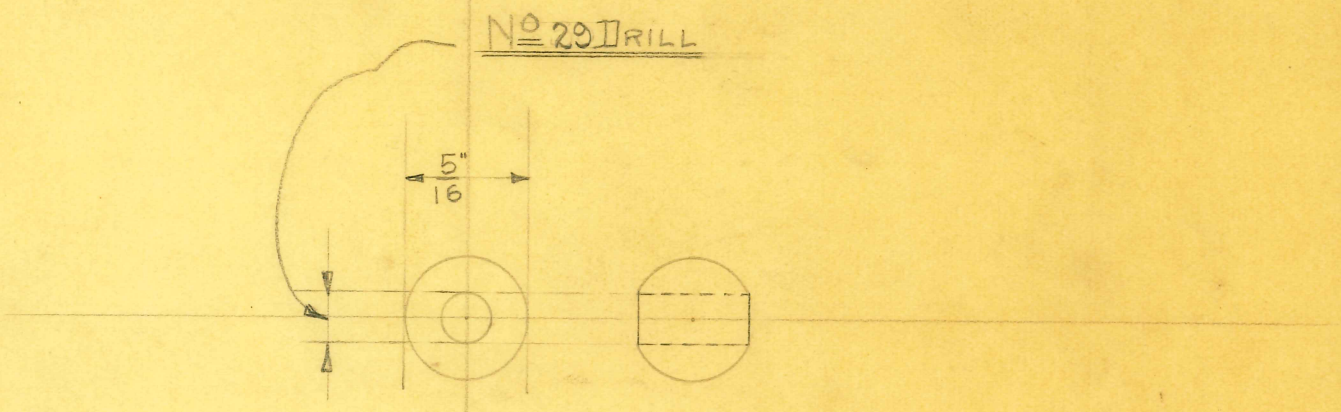

OBSOLETE

SIZE	5/16"	ISSUE	
KIND	BRASS ROD	CHANGED	
SHAPE		"	
FINISH	CHROME #2	"	
TEMP.		"	
PATT.		"	

TITLE: VAZUJIAN HEAD BAND EAR ELECTRODE SWIVEL

H. G. FISCHER & CO.
2335 WABANSIA AVE.
CHICAGO, ILL.

CAT. NO.

PART NO. 8961

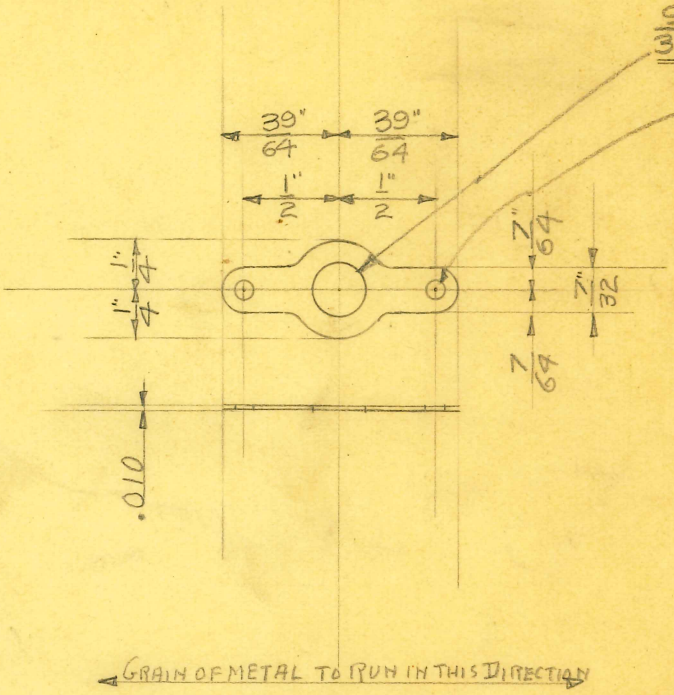

№ 30 B+S GAUGE SHEET PHOSPHOR BRONZE.

2 REQUIRED

1 - POLISHED

1 - COMMERCIAL NICKEL #12

OBSOLETE

SIZE		ISSUE		TITLE: YAZUJIAN HEAD BAND EAR ELECTRODE SWIVEL SPRING CLAMP			
KIND		CHANGED					
SHAPE		"					
FINISH		"					
TEMP.		"		H. G. FISCHER & CO. 2335 WABANSIA AVE. CHICAGO, ILL.	CAT. NO.	PART NO.	8962
PATT.		"					

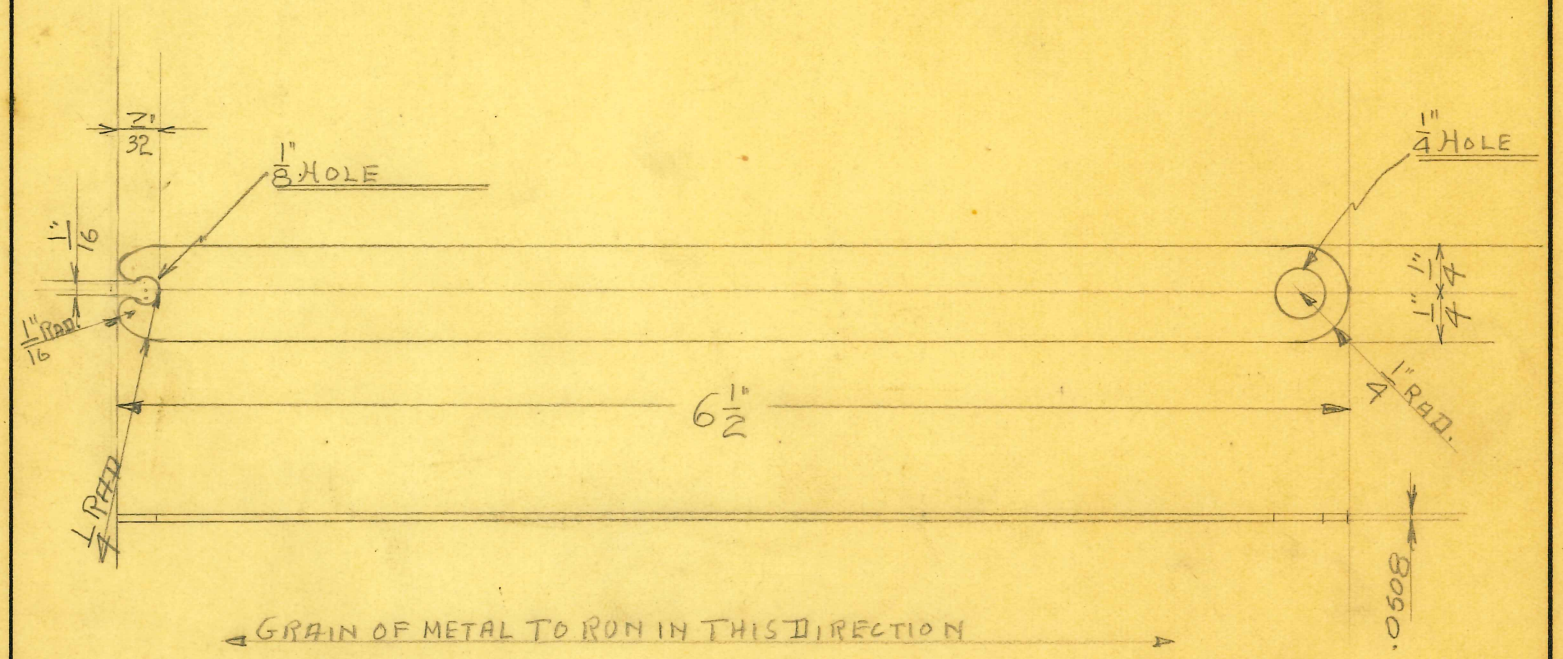

GRAIN OF METAL TO RUN IN THIS DIRECTION

No. 16 B+S. GAUGE SHEET PHOSPHOR BRONZE

1 REQUIRED

OBSOLETE

SIZE		ISSUE		TITLE: YAZUJIAN HEAD BAND CORD SUPPORT			
KIND		CHANGED					
SHAPE		"					
FINISH		"					
TEMP.		"		H. G. FISCHER & CO. 2335 WABANSIA AVE. CHICAGO, ILL.	CAT. NO.	PART NO.	8966
PATT.		"					

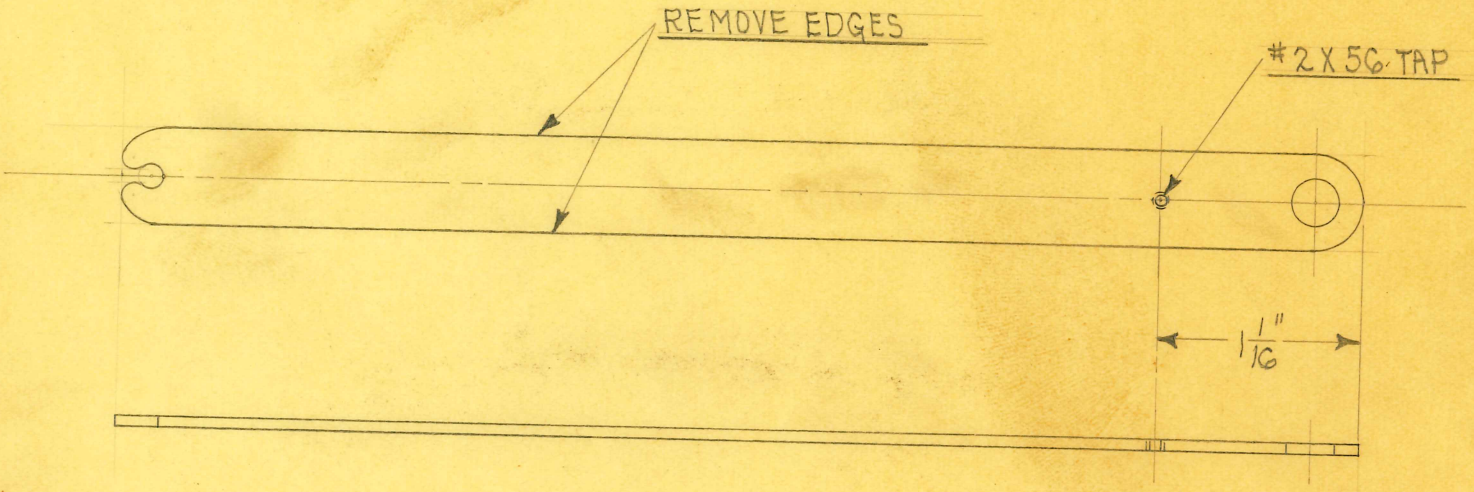

1 REQUIRED

OBSOLETE

SIZE		ISSUE 7-9-34	A.E.	**TITLE:** YAZUJIAN HEADBAND CORD SUPPORT
KIND		CHANGED		
SHAPE		"		
FINISH	NICKEL #12	"		
TEMP.		"		
PATT.		"		

H. G. FISCHER & CO.
2335 WABANSIA AVE.
CHICAGO, ILL.

CAT. NO.

PART NO. 8966F

ROUND SLIGHTLY

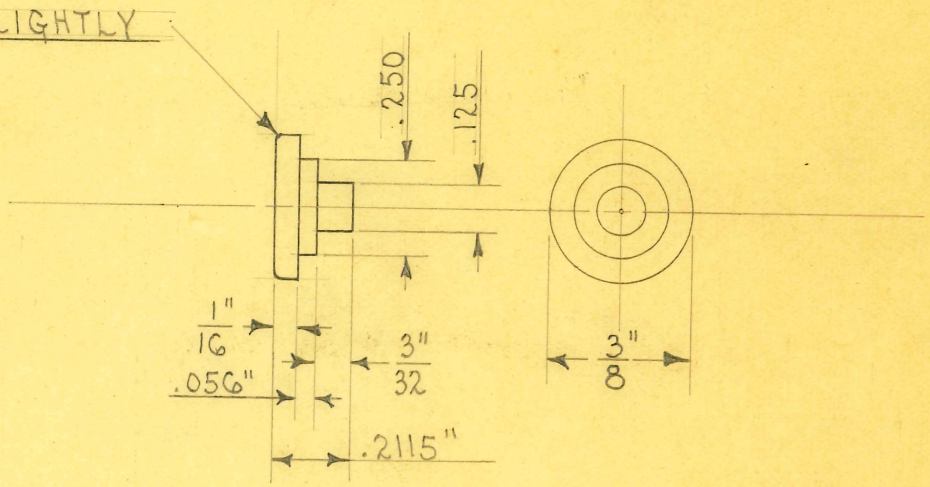

SCALE ~ 2 DIAMETERS

1 REQUIRED

OBSOLETE

SIZE	3/8"	ISSUE 7-10-34	7/8.	**TITLE:** YAZUJIAN HEADBAND CORD SUPPORT RIVET
KIND	BRASS ROD	CHANGED		
SHAPE		"		
FINISH	NICKEL #12	"		
~~TEMP.~~	(HEAD ONLY)	"		
PATT.		"		

H. G. FISCHER & CO.
2335 WABANSIA AVE.
CHICAGO, ILL.

CAT. NO.

PART NO. 8967

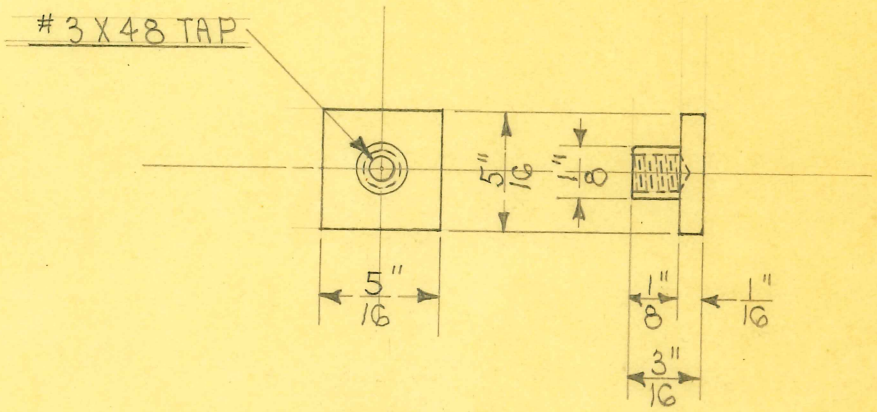

SCALE ~ 1" = 1/2"

OBSOLETE

SIZE	5/16" SQ.	ISSUE 5-27-36	A.E.
KIND	BRASS ROD	CHANGED	
SHAPE		"	
FINISH		"	
TEMP.		"	
PATT.		"	

TITLE: THOREK COAGULATING ELECTRODE - 5/16" SQUARE END

H. G. FISCHER & CO.
2335 WABANSIA AVE.
CHICAGO, ILL.

CAT. NO.

PART NO. 6953

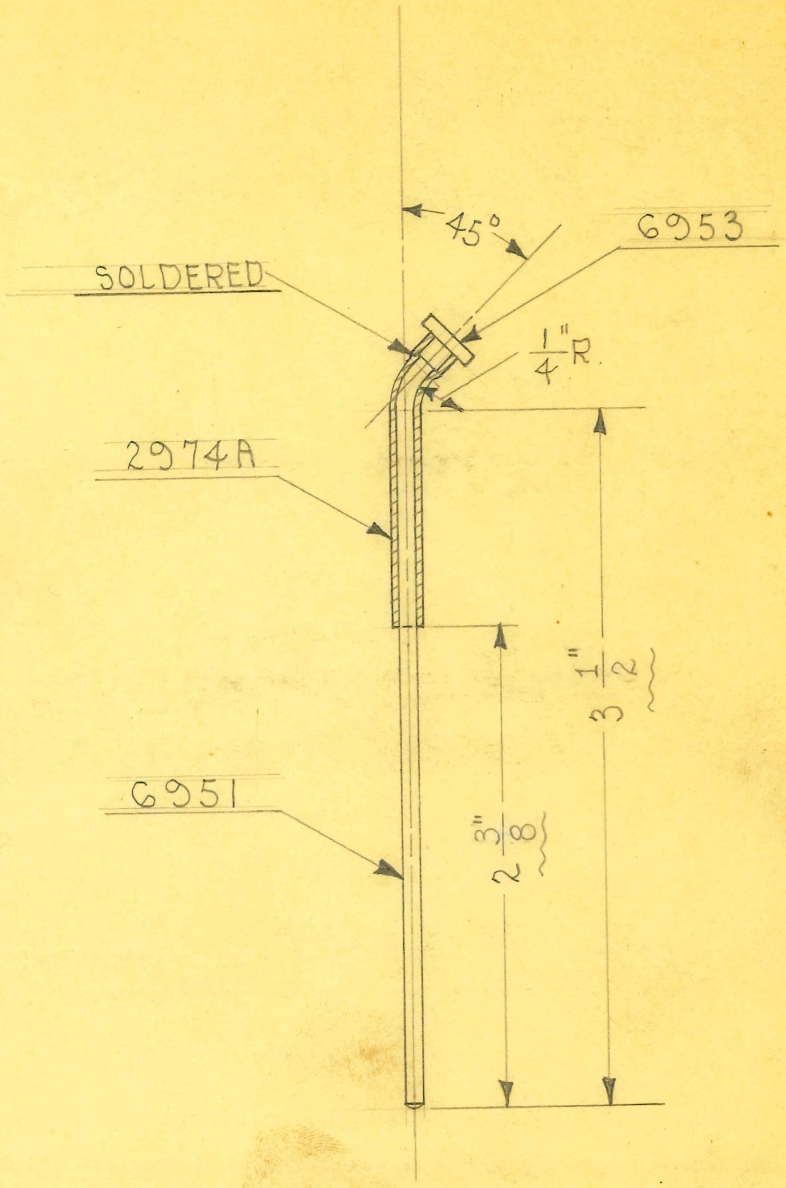

OBSOLETE

SIZE		ISSUE 5-27-36	2/8.
KIND		CHANGED	
SHAPE		"	
FINISH	NICKEL #12	"	
TEMP.	SQ. END ONLY	"	
PATT.		"	

TITLE: THOREK COAGULATING ELECTRODE - 5/16"

H. G. FISCHER & CO.
2335 WABANSIA AVE.
CHICAGO, ILL.

CAT. NO. 2087

PART NO. 6953G

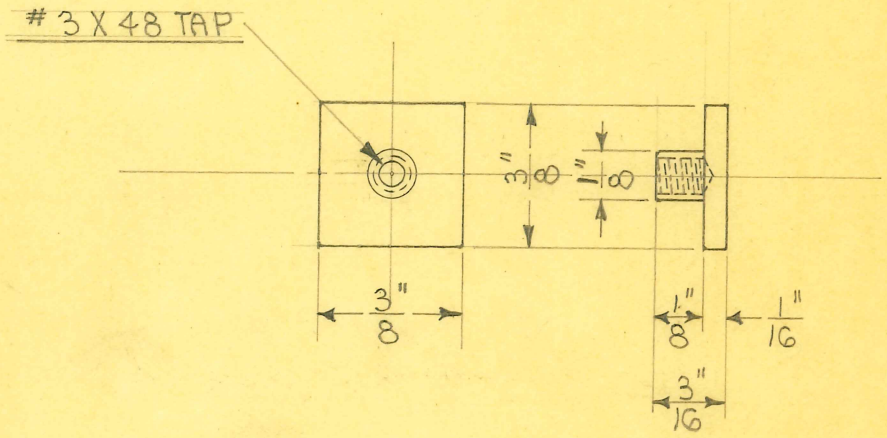

SCALE ~ 1" = 1/2"

OBSOLETE

SIZE	3/8" SQ.	ISSUE 5-27-36	A.E.
KIND	BRASS ROD	CHANGED	
SHAPE		"	
FINISH		"	
TEMP.		"	
PATT.		"	

TITLE: THOREK COAGULATING ELECTRODE - 3/8" SQUARE END

H. G. FISCHER & CO.
2335 WABANSIA AVE.
CHICAGO, ILL.

CAT. NO.

PART NO. 6954

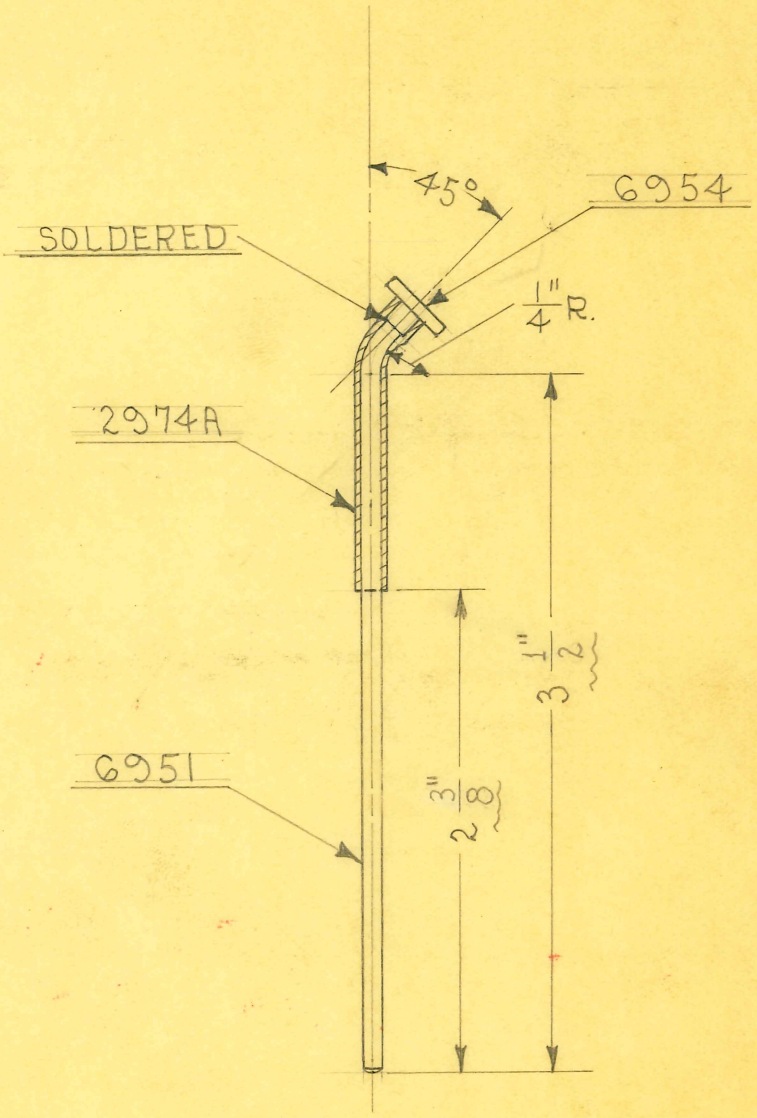

OBSOLETE

SIZE		ISSUE 5-27-36	A.B.
KIND		CHANGED	
SHAPE		"	
FINISH	NICKEL #12	"	
~~TEMP~~.	SQ. END ONLY	"	
PATT.		"	

TITLE: THOREK COAGULATING ELECTRODE - 3/8"

H. G. FISCHER & CO.
2335 WABANSIA AVE.
CHICAGO, ILL.

CAT. NO. 2088

PART NO. 6954G

DILLINGER BASE

MAYO INTESTINAL SURGICAL NEEDLE SIZE 5½

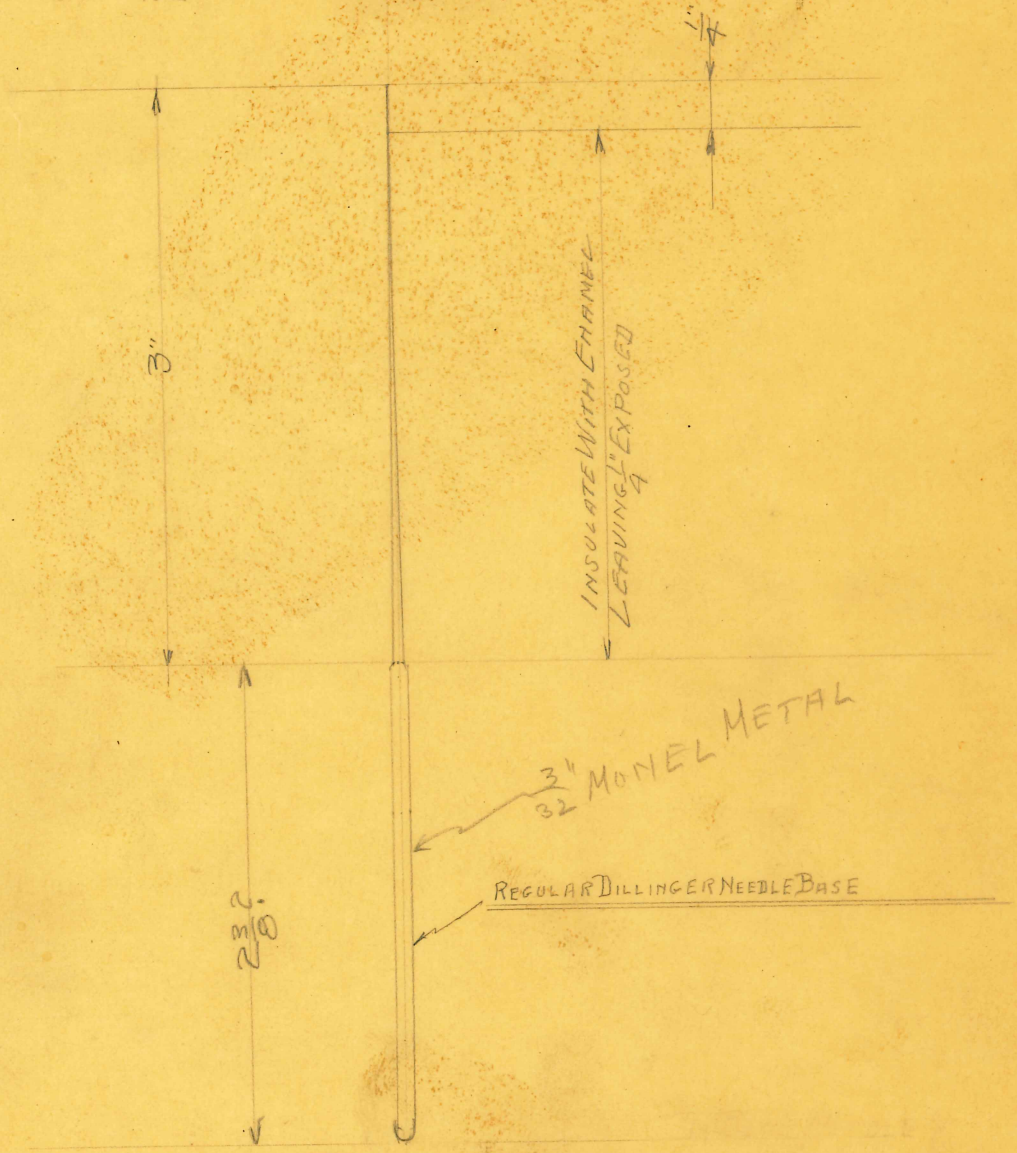

MADE FOR V. MUELLER & CO
ALSO DR GEO. A. SPENCER
ORDER No 7833 – 7-28-30

OBSOLETE

SIZE		ISSUE		TITLE: DR. BECK SPECIAL NEEDLE	
KIND		CHANGED			
SHAPE		" "			
FINISH		" "			
TEMP.		" "		H. G. FISCHER & CO. 2335 WABANSIA AVE. CHICAGO, ILL.	CAT. NO.
PATT.		" "			PART NO. 4545G

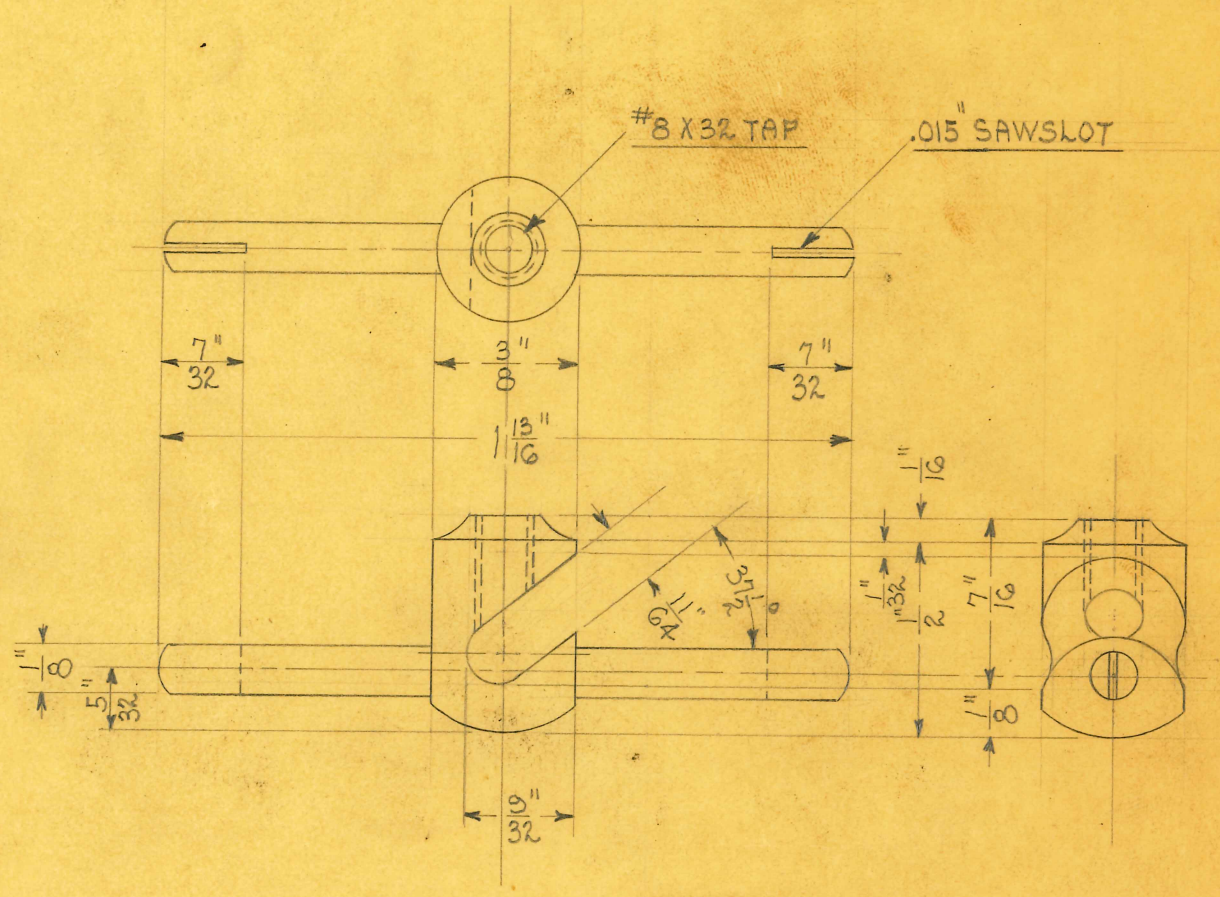

SCALE ~ 2 DIAMETERS

OBSOLETE

SIZE	1/8" & 3/8"	ISSUE 1-12-31	J.E.
KIND	BRASS ROD	CHANGED	
SHAPE		" "	
FINISH	N.P.	" "	
TEMP.		" "	
PATT.		" "	

TITLE: DR. LINN U-SHAPED EAR ELECT. BINDING POST

H. G. FISCHER & CO.
2335 WABANSIA AVE.
CHICAGO, ILL.

CAT. NO.

PART NO. 4553G

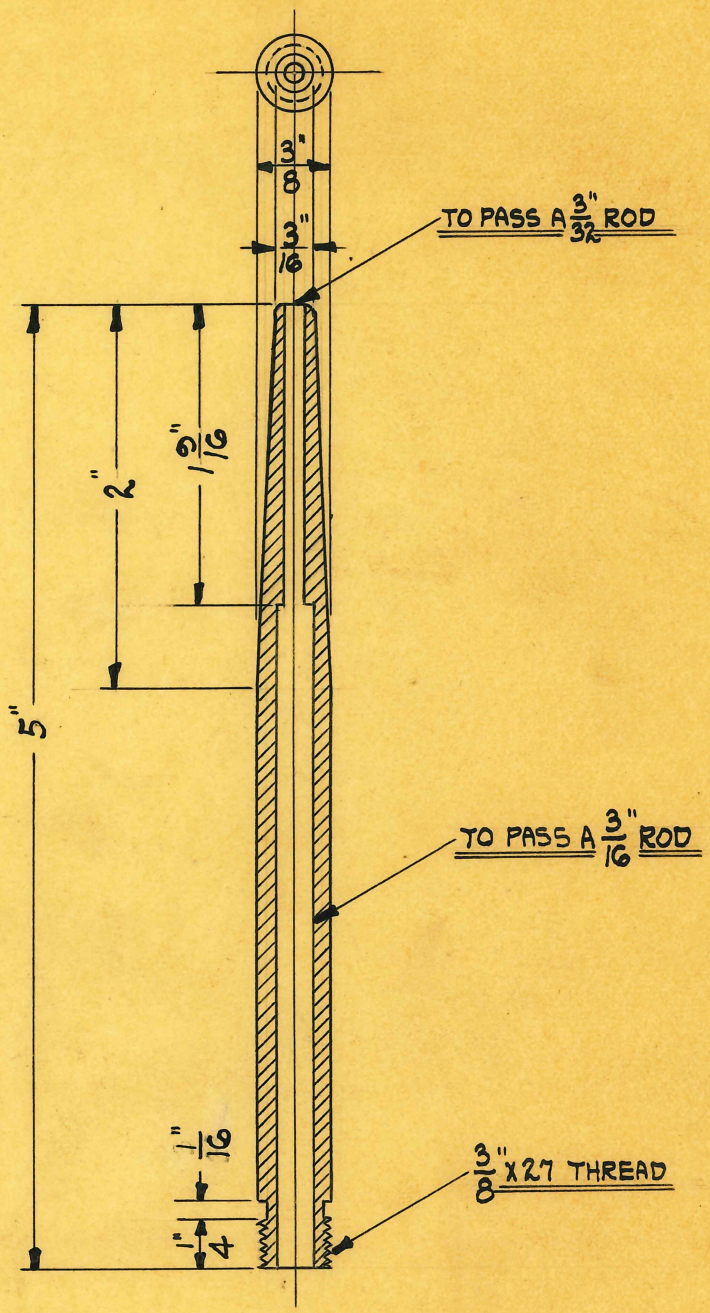

OBSOLETE

SIZE	3/8"	ISSUE H.E.	7-22-30	TITLE: SURGICAL DIATHERMY ELECTRODE HOLDER STEM
KIND	ISOLANTITE	CHANGED		
SHAPE		" "		
FINISH	GLAZED	" "		
TEMP.		" "		
PATT.		" "		

4556

H. G. FISCHER & CO.
2935 WABANSIA AVE.
CHICAGO, ILL.

CAT. NO.

PART NO. 4556

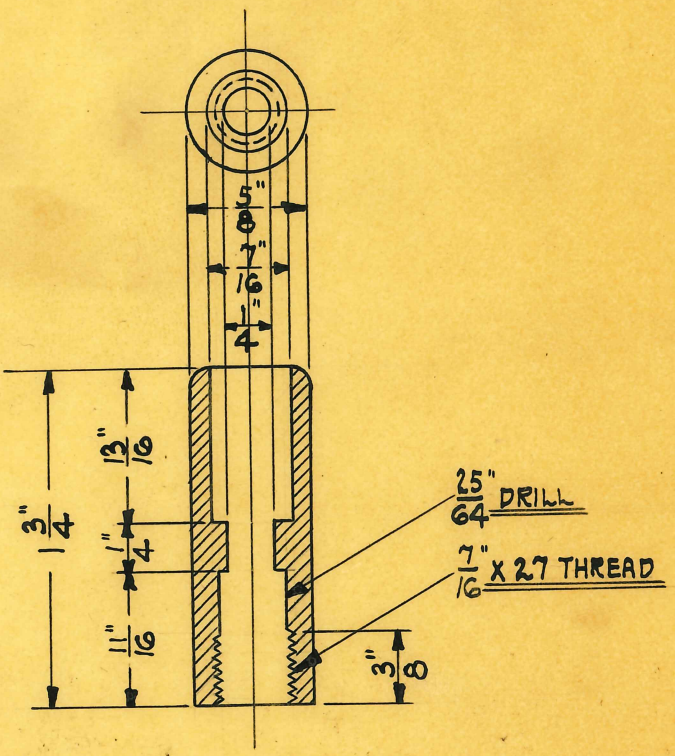

OBSOLETE

SIZE	5/8"	ISSUE H.E.	7-22-30	TITLE: SURGICAL DIATHERMY ELECTRODE HOLDER STEM RECEPTACLE
KIND	ISOLANTITE	CHANGED		
SHAPE	GLAZED	" "		
FINISH	GLAZED	" "		4557
TEMP.		" "		H. G. FISCHER & CO. 2935 WABANSIA AVE. CHICAGO, ILL. — CAT. NO. — PART NO. 4557
PATT.		" "		

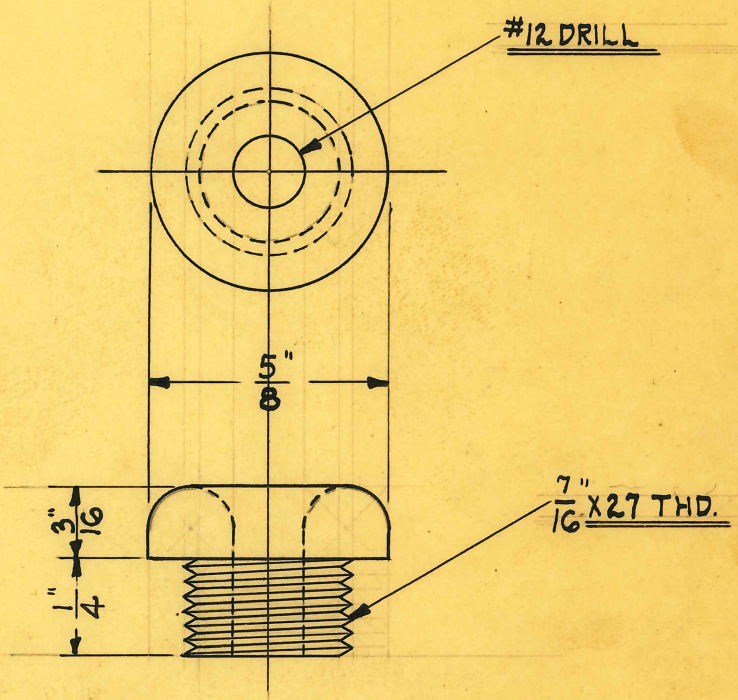

SCALE ~2 DIAMETERS

OBSOLETE

bakelite

SIZE	5/8"	ISSUE 9-4-30	H.E.
KIND	BAKELITE ROD	CHANGED	
SHAPE	ROUND	" "	
FINISH		" "	
TEMP.		" "	
PATT.		" "	

TITLE: SURGICAL DIATHERMY ELEC. CORD BUSHING

H. G. FISCHER & CO.
2335 WABANSIA AVE.
CHICAGO, ILL.

CAT. NO.

PART NO. 4558

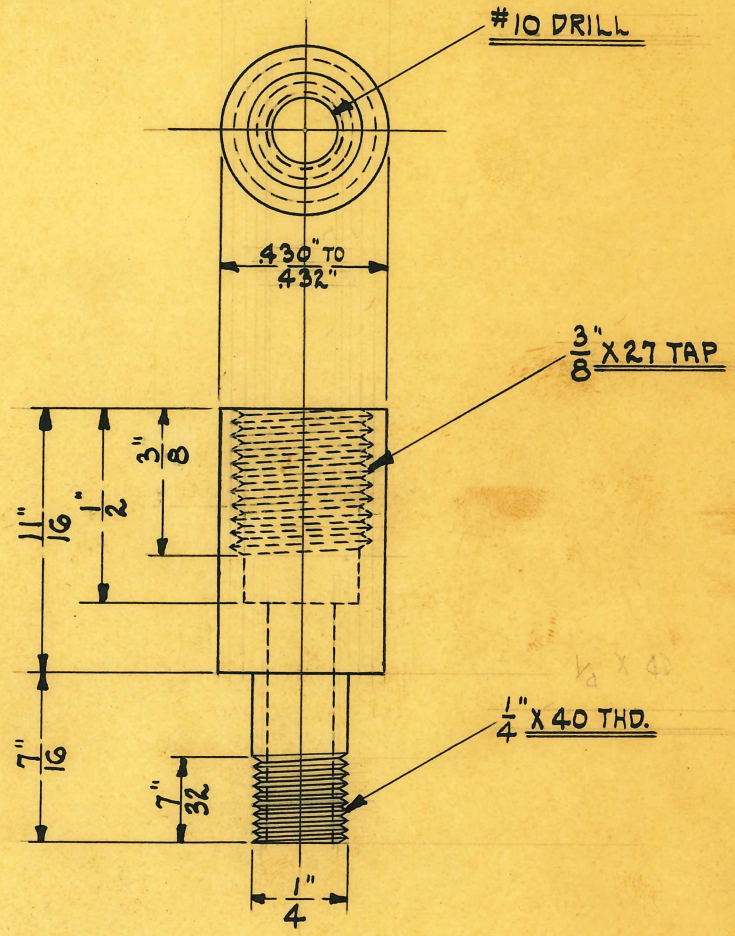

SCALE ÷ 2 DIAMETERS

OBSOLETE

SIZE	7/16"	ISSUE 9-4-30	W.E.	TITLE: SURGICAL DIA. ELEC. HOLDER STEM RECEPT. SOCKET
KIND	ALUM. ROD	CHANGED		
SHAPE	ROUND	" "		
FINISH		" "		
TEMP.		" "		H. G. FISCHER & CO. 2335 WABANSIA AVE. CHICAGO, ILL. — CAT. NO. — PART NO. 4559
PATT.		" "		

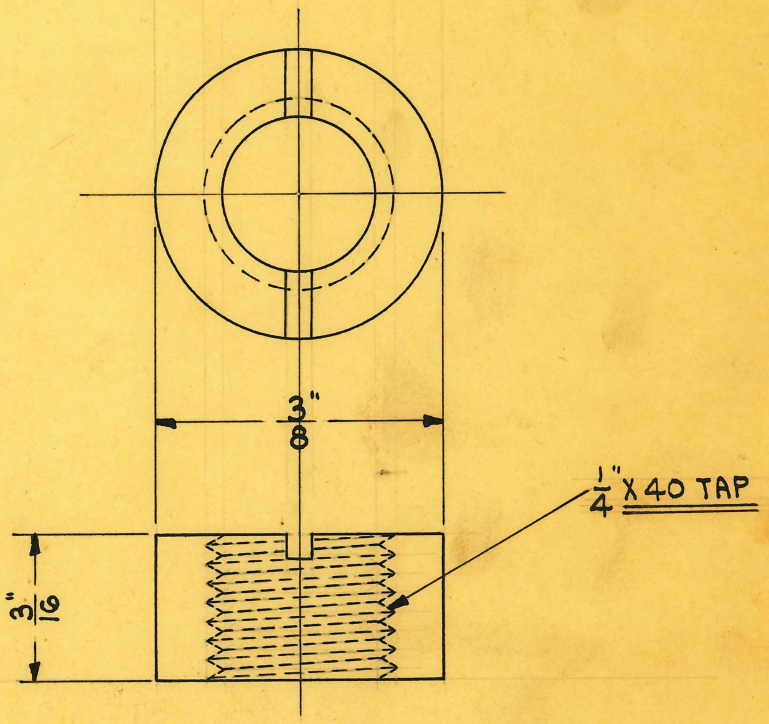

SCALE ÷ 4 DIAMETERS

OBSOLETE

SIZE	3/8"	ISSUE 9-4-30	A.E.	TITLE: SURGICAL DIA. ELEC. HOLDER STEM RECEPT. SOCKET NUT
KIND	BRASS ROD	CHANGED		
SHAPE	ROUND	" "		
FINISH		" "		
TEMP.		" "		H. G. FISCHER & CO. 2335 WABANSIA AVE. CHICAGO, ILL. — CAT. NO. — PART NO. 4560
PATT.		" "		

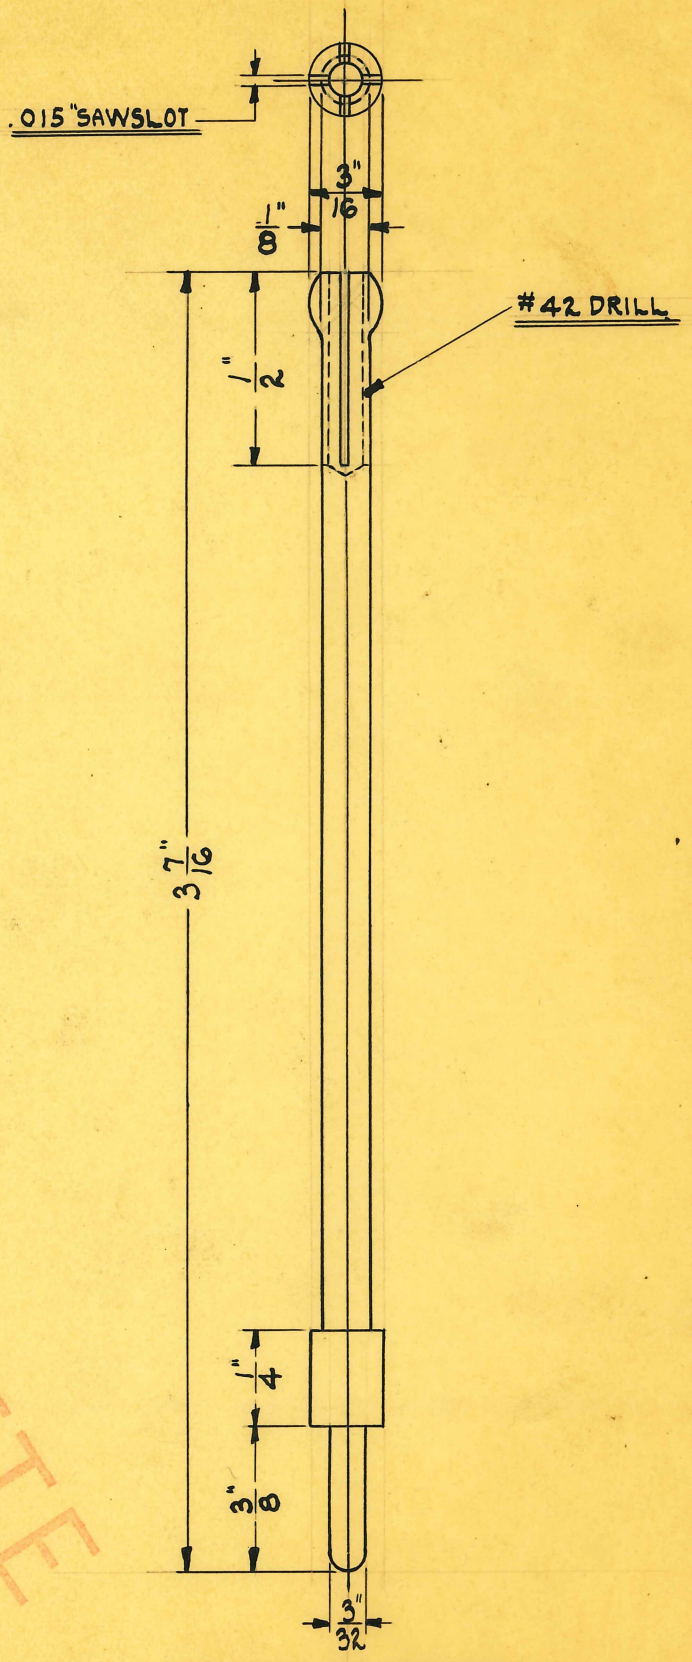

SCALE ~ 2 DIAMETERS

OBSOLETE

SIZE	3/16"	ISSUE 9-4-30	A.E.	TITLE: SURGICAL DIATHERMY ELECTRODE CHUCK
KIND	BRASS ROD	CHANGED		
SHAPE	ROUND	" "		
FINISH	W.P.	" "		
TEMP.		" "		H. G. FISCHER & CO. 2335 WABANSIA AVE. CHICAGO, ILL. — CAT. NO. — PART NO. 4561
PATT.		" "		

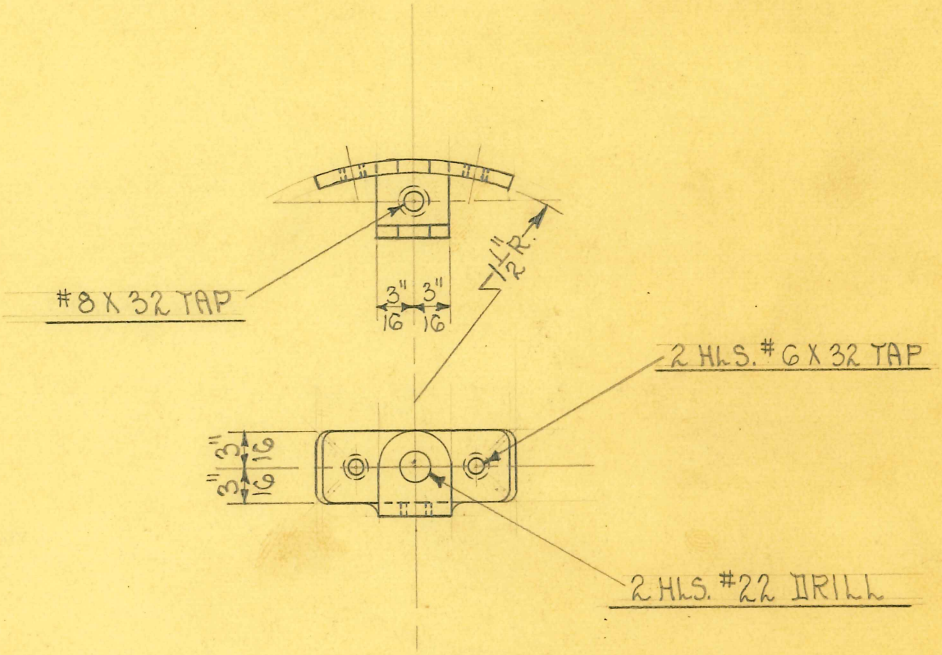

SCALE ~ FULL SIZE

OBSOLETE

SIZE		ISSUE 1-28-32	H.E.	**TITLE:** REVOLVING TUBE SHAFT SUPPORT		
KIND		CHANGED				
SHAPE		" "				
FINISH		" "				
TEMP.		" "		H. G. FISCHER & CO. 2335 WABANSIA AVE. CHICAGO, ILL.	CAT. NO.	PART NO. 2719
PATT.		" "				

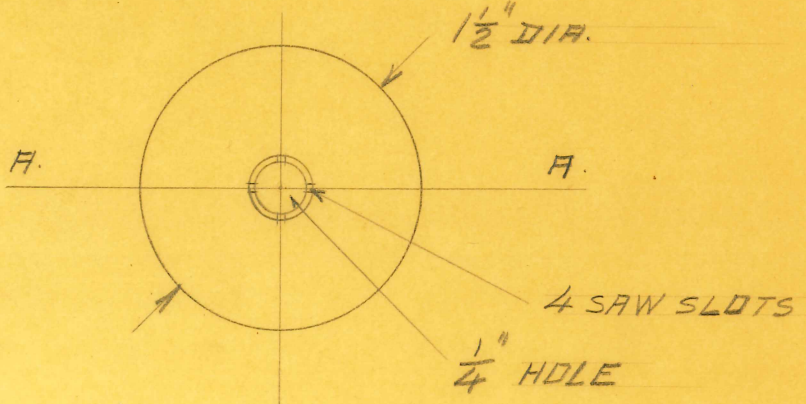

SOLDERED

SECTION A-A.

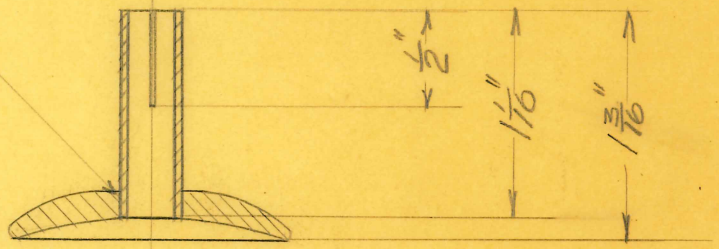

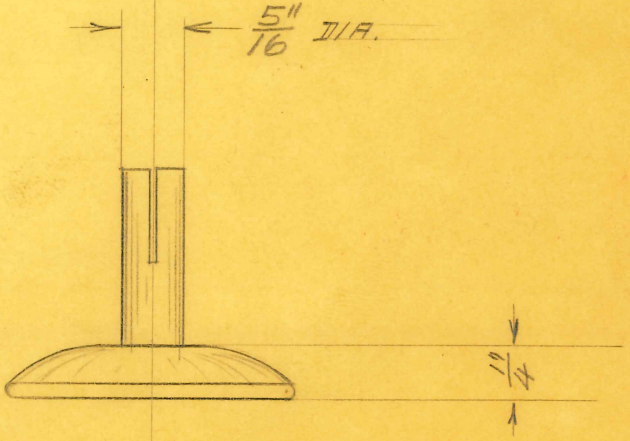

NOTE:
3 SIZES 1" - 1¼" - 1½"

OBSOLETE

SIZE		ISSUE 8-6-26	
KIND	BRASS	CHANGED	
SHAPE		" "	
FINISH	N.P.	" "	
TEMP.		" "	
PATT.		" "	

TITLE: CONCAVE DISC FOR CORBUS ELECTRODE

H. G. FISCHER & CO.
2335 WABANSIA AVE.
CHICAGO, ILL.

CAT. NO.

PART NO. 2759G.

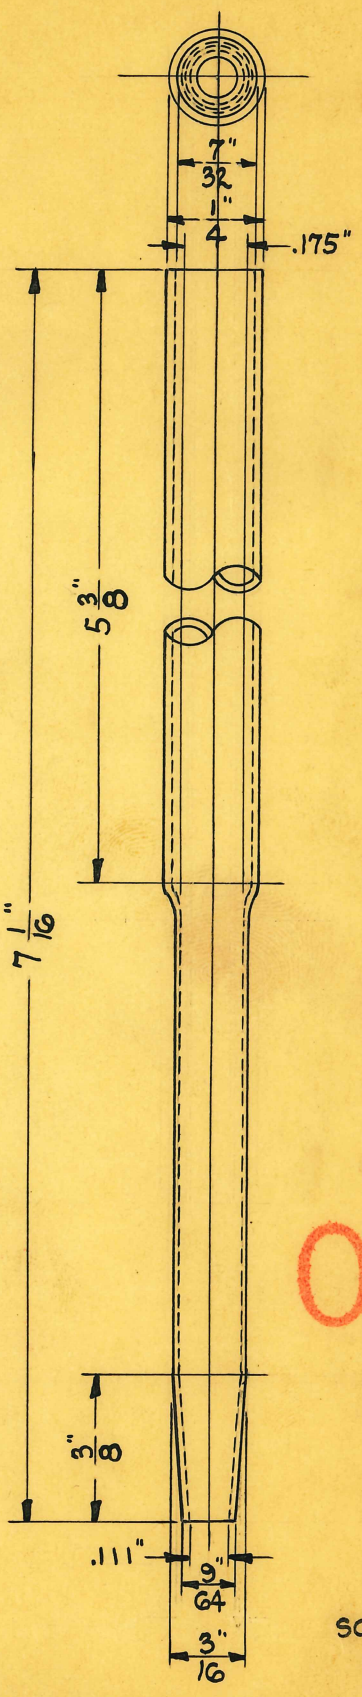

OBSOLETE

SCALE ~ 2 DIAMETERS

SIZE	7/32" I.D. X 1/4" O.D.	ISSUE H.E.	4-14-30
KIND	COPPER TUBING	CHANGED	
SHAPE	ROUND	" "	
FINISH		" "	
TEMP.		" "	
PATT.		" "	

TITLE: CORBUS ELECTRODE 3/16" THERMOMETER TUBE

H. G. FISCHER & CO.
2335 WABANSIA AVE.
CHICAGO, ILL.

CAT. NO.

PART NO. 2762 1/2

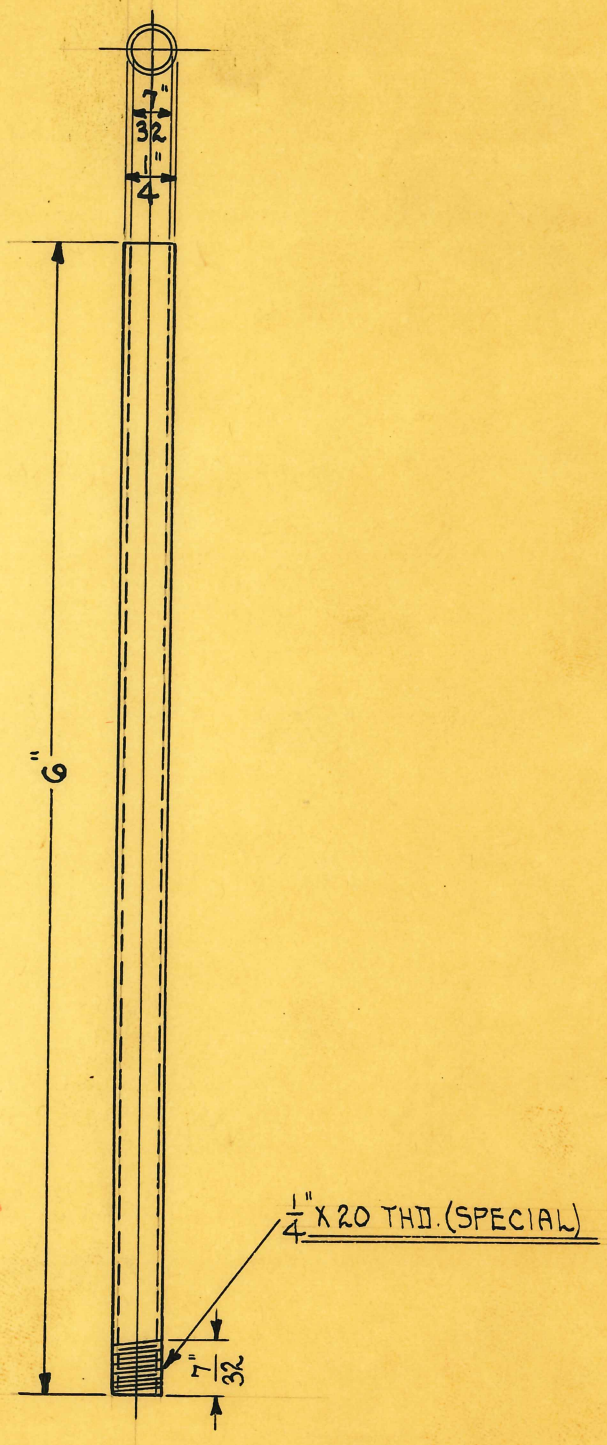

OBSOLETE

SIZE	7/32" X 1/4"	ISSUE 10-10-30	A.E.	TITLE: CORBUS CURVED ELECT. THER. TUBE
KIND	COPPER TUBING	CHANGED		
SHAPE	ROUND	" "		
FINISH		" "		
TEMP.		" "		
PATT.		" "		

H. G. FISCHER & CO.
2335 WABANSIA AVE.
CHICAGO, ILL.

CAT. NO.

PART NO. 2762 3/4

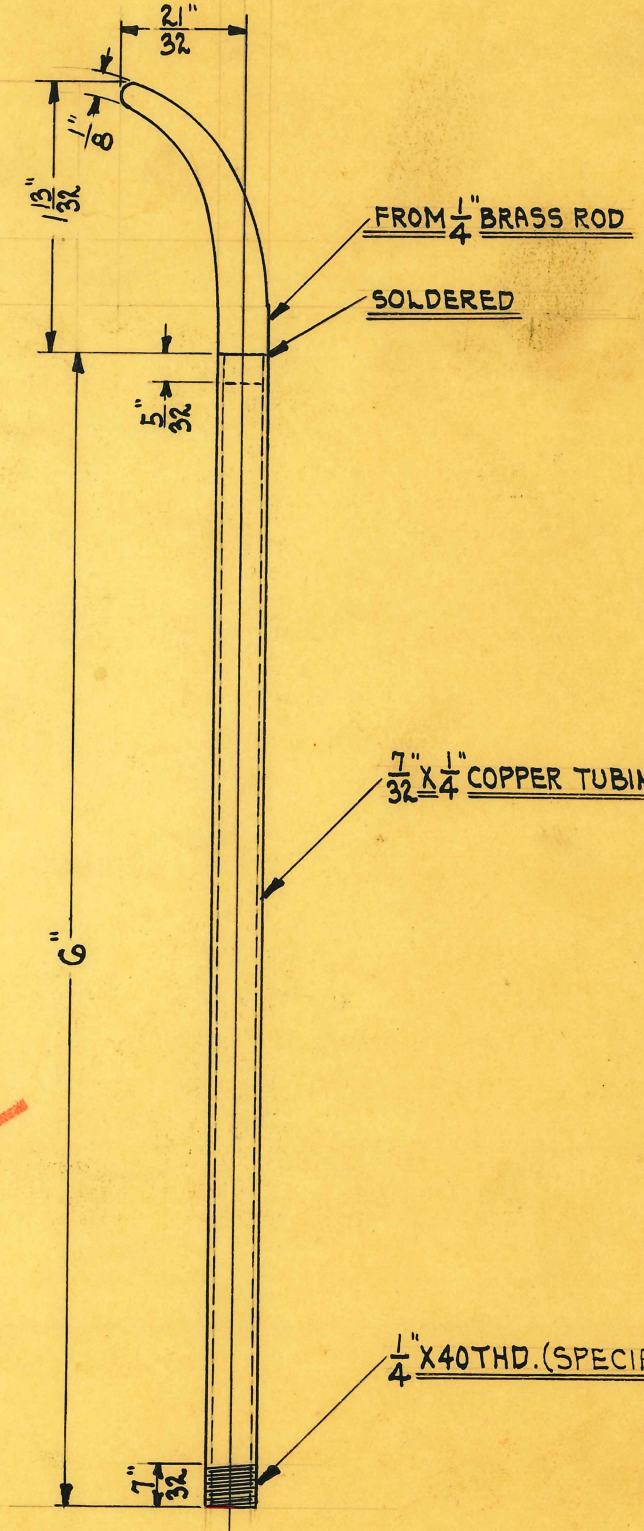

LENGTH OF TIP BEFORE FORMING - 1 25/32" OVERALL

OBSOLETE

SIZE		ISSUE 10-10-30	A.E.	TITLE: CORBUS CURVED ELECT. THER. TUBE
KIND		CHANGED		
SHAPE		" "		
FINISH	POL. & PLATE	" "		
TEMP.		" "		H. G. FISCHER & CO. 2335 WABANSIA AVE. CHICAGO, ILL. — CAT. NO. — PART NO. 2762 3/4 G
PATT.		" "		

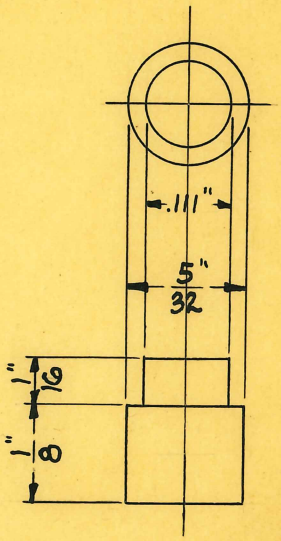

SCALE ~4 DIAMETERS

OBSOLETE

SIZE	5/32"	ISSUE H.E.	4-14-30	TITLE: CORBUS ELECTRODE 3/16" THERMOMETER TUBE TIP	
KIND	BRASS ROD	CHANGED			
SHAPE	ROUND	" "			
FINISH		" "			
TEMP.		" "		H. G. FISCHER & CO. 2335 WABANSIA AVE. CHICAGO, ILL.	CAT. NO.
PATT.		" "			PART NO. 2763 1/2

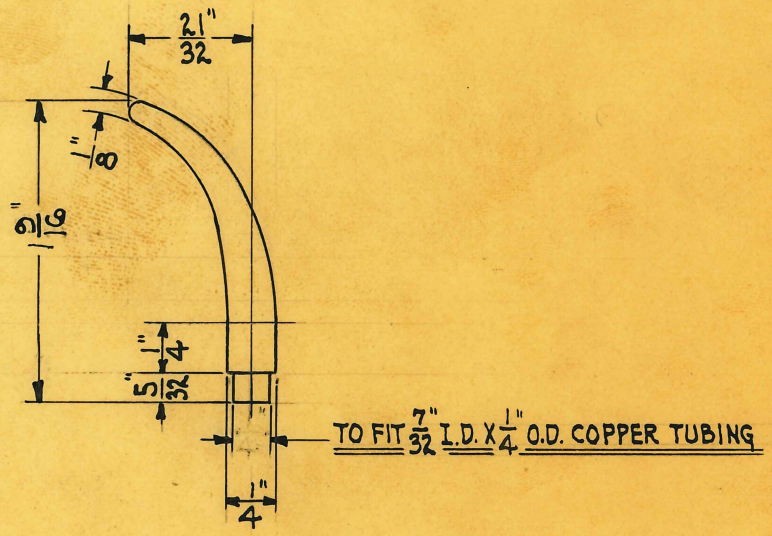

OBSOLETE

SIZE	1/4"	ISSUE 10-10-30	A.E.	TITLE: CORBUS CURVED ELECT. THER. TUBE CURVED TIP		
KIND	BRASS ROD	CHANGED				
SHAPE	ROUND	" "				
FINISH		" "				
TEMP.		" "		H. G. FISCHER & CO. 2335 WABANSIA AVE. CHICAGO, ILL.	CAT. NO.	PART NO. 2763 3/4
PATT.		" "				

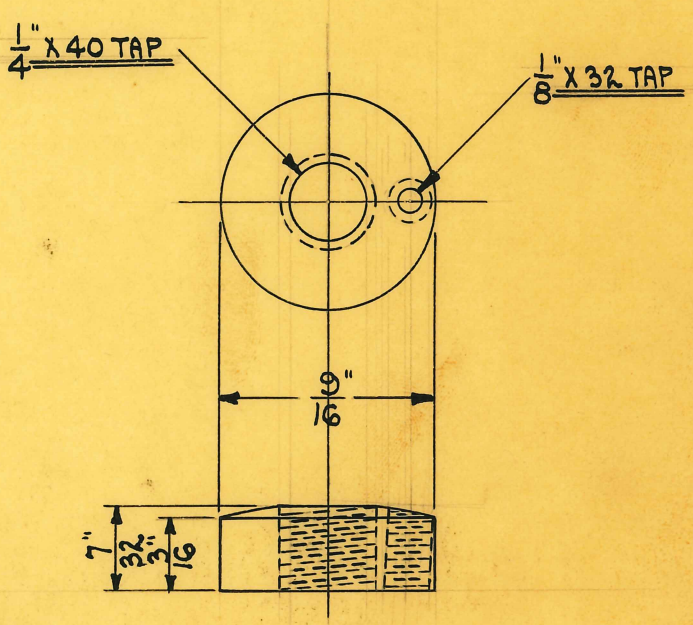

DRILL JIG. #1396

SCALE ~ 2 DIAMETERS

OBSOLETE

SIZE	5/8"	ISSUE 10-10-30	A.E.	TITLE: CORBUS CURVED ELECT. THER. TUBE COLLAR
KIND	BRASS ROD	CHANGED		
SHAPE	ROUND	" "		
FINISH	W.P.	" "		
TEMP.		" "		H. G. FISCHER & CO. 2335 WABANSIA AVE. CHICAGO, ILL. — CAT. NO. — PART NO. 2764 1/2
PATT.		" "		

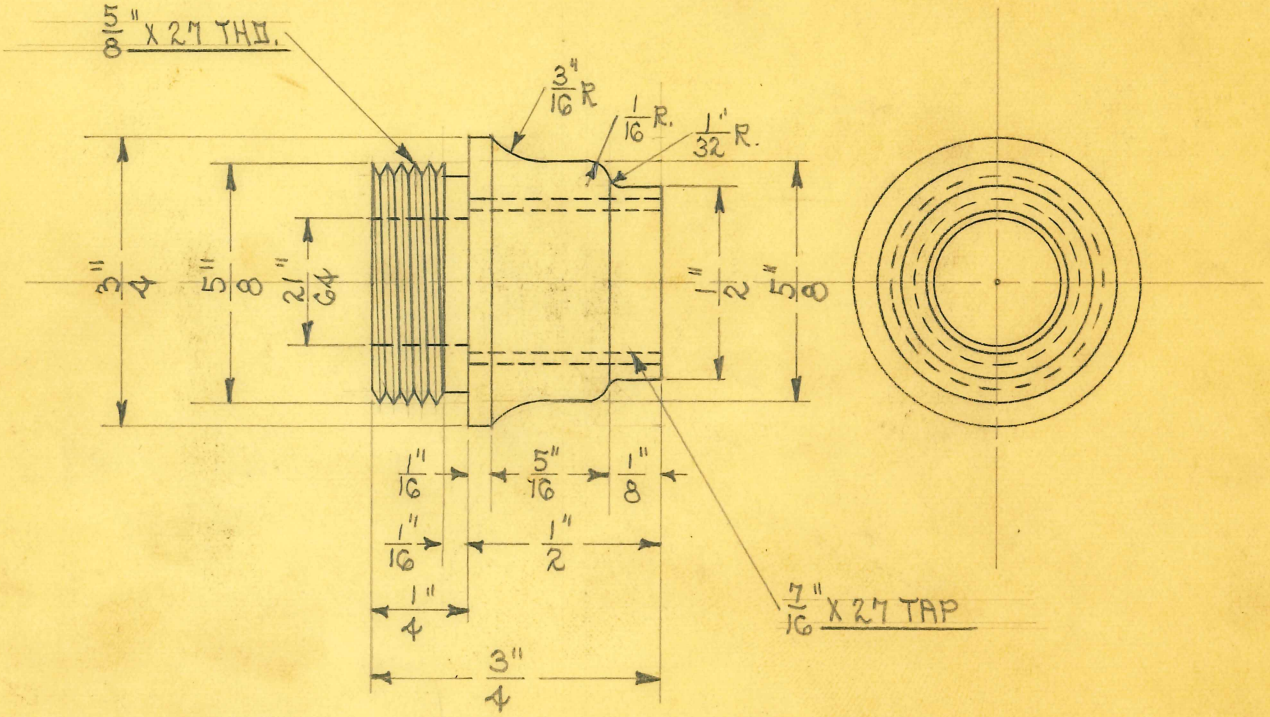

SCALE ~ 2 DIAMETERS

OBSOLETE

SIZE	3/4"	ISSUE 1-18-31	A.E.	**TITLE:** CORBUS THER. ELEC. RUB. TUBE COUPLING SMALL LARGE HOLE
KIND	POL. RUB. ROD	CHANGED		
SHAPE		" "		
FINISH		" "		
TEMP.		" "		H. G. FISCHER & CO. 2335 WABANSIA AVE. CHICAGO, ILL. — CAT. NO. — PART NO. 2767 1/2
PATT.		" "		

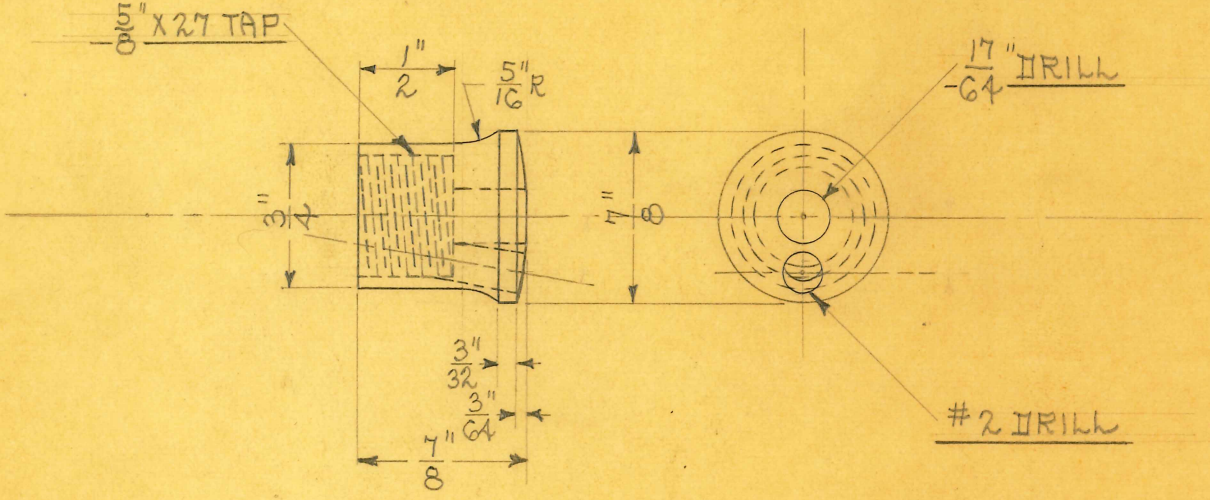

SCALE ½ FULL SIZE

DRILL JIG #1396

OBSOLETE

SIZE	7/8"	ISSUE 6-22-31	A.E.	**TITLE:** CORBUS ELECT. RUBBER TUBE COUPLING LARGE
KIND	POL. RUBBER	CHANGED		
SHAPE	ROD	" "		
FINISH		" "		
TEMP.		" "		H. G. FISCHER & CO. 2335 WABANSIA AVE. CHICAGO, ILL. — CAT. NO. — PART NO. 2768
PATT.		" "		

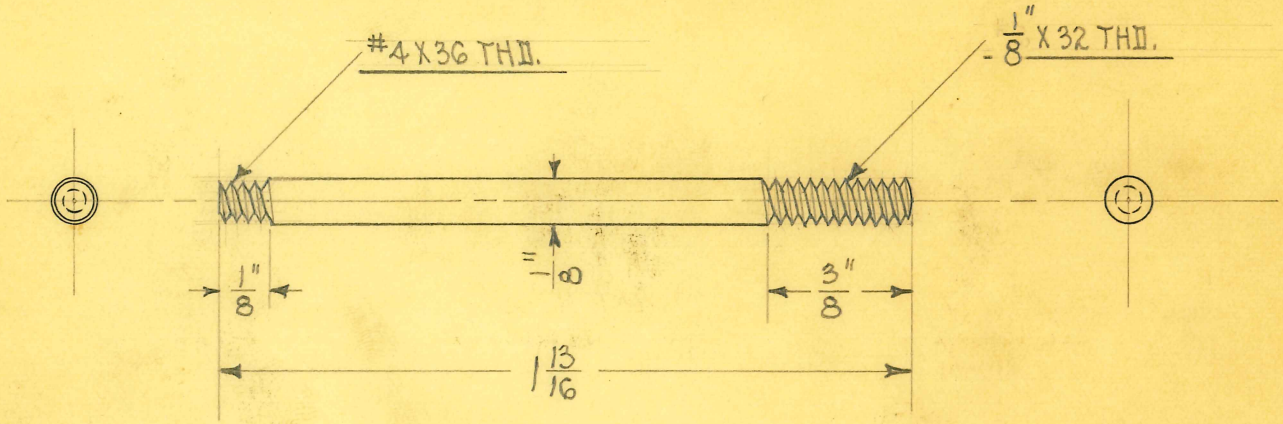

SCALE ~ 2 DIAMETERS

OBSOLETE

SIZE	1/8"	ISSUE 1-15-32	A.E.	TITLE: CORBUS ELECTRODE CONDUCTOR ROD
KIND	BRASS ROD	CHANGED		
SHAPE		" "		
FINISH		" "		
TEMP.		" "		
PATT.		" "		

H. G. FISCHER & CO.
2335 WABANSIA AVE.
CHICAGO, ILL.

CAT. NO.

PART NO. 2769

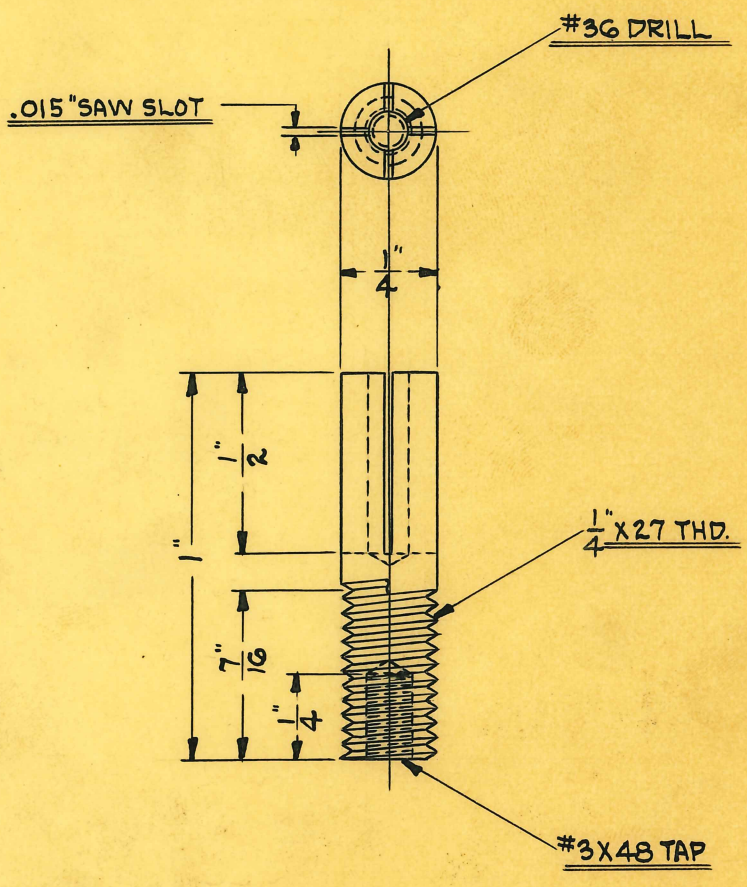

SCALE ~ 2 DIAMETERS

OBSOLETE

SIZE	1/4"	ISSUE H.E.	5-3-30	TITLE: VAGINAL ELECTRODE CONNECTION WIRE TIP
KIND	BRASS ROD	CHANGED		
SHAPE	ROUND	" "		
FINISH		" "		
TEMP.		" "		H. G. FISCHER & CO. 2335 WABANSIA AVE. CHICAGO, ILL.
PATT.		" "		CAT. NO. / PART NO. 2769 1/2

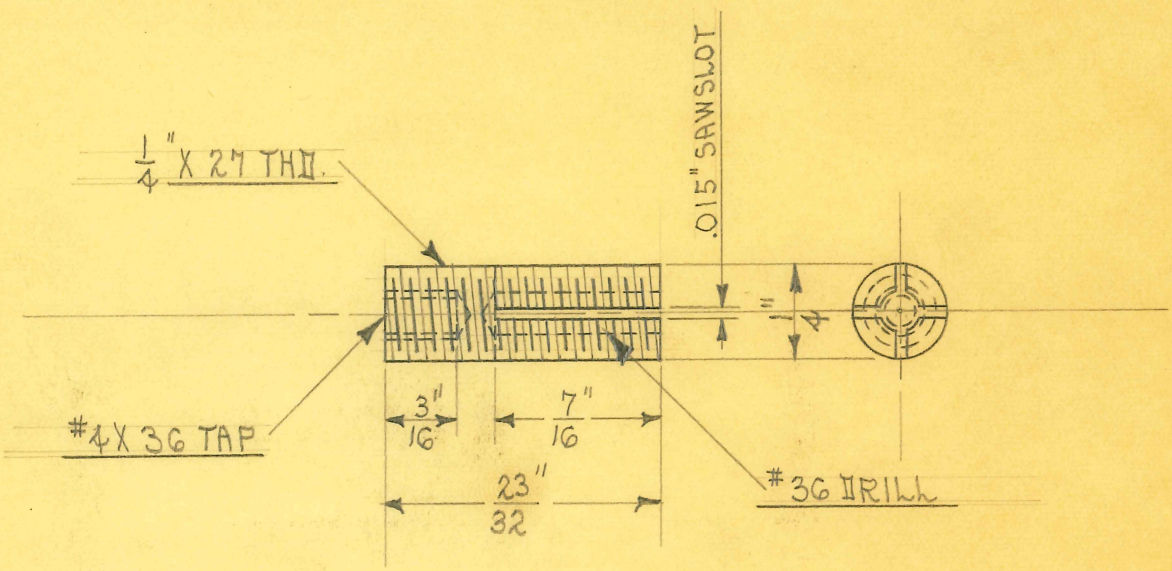

SCALE ~ 2 DIAMETERS

OBSOLETE

SIZE	1/4"	ISSUE 1-25-32	A.E.	TITLE: CORBUS ELECT. CONN. WIRE TIP		
KIND	BRASS ROD	CHANGED				
SHAPE		" "				
FINISH		" "				
TEMP.		" "		H. G. FISCHER & CO. 2335 WABANSIA AVE. CHICAGO, ILL.	CAT. NO.	PART NO. 2769 3/4
PATT.		" "				

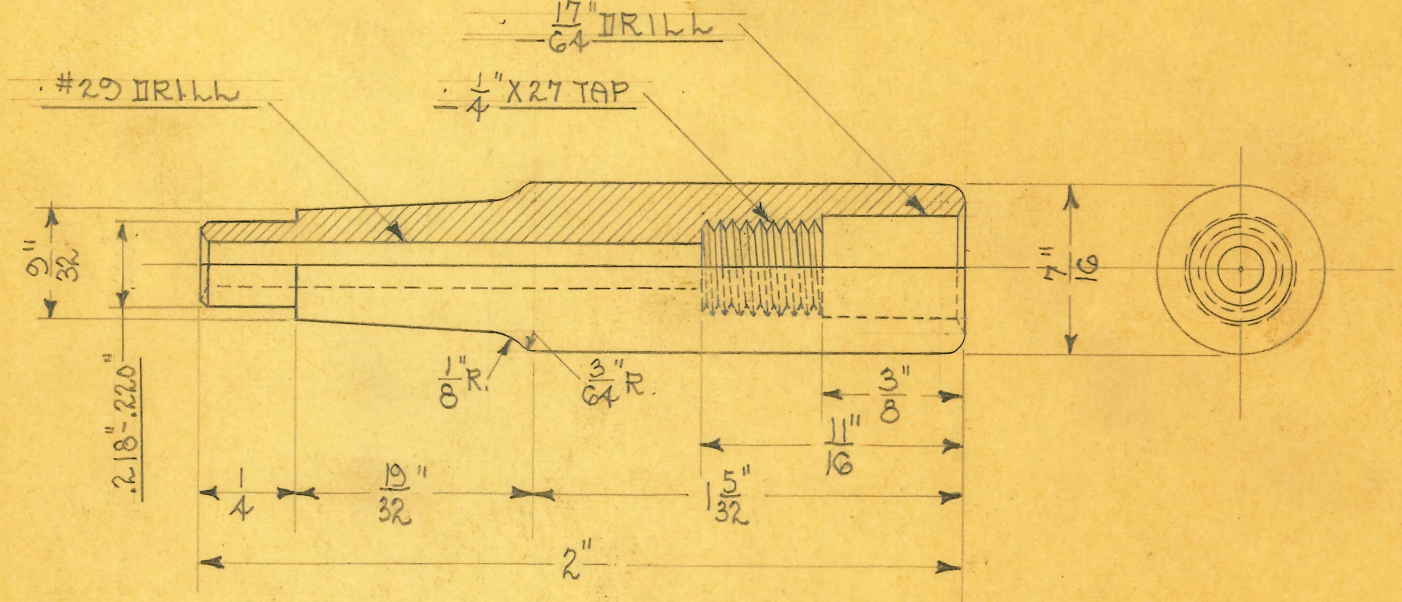

SCALE ~ 2 DIAMETERS

OBSOLETE

SIZE	7/16"	ISSUE 6-22-31	24.6.	TITLE: CORBUS ELECTRODE CONDUCTOR RUB. INS.
KIND	POL. RUBBER	CHANGED		
SHAPE	ROD	" "		
FINISH	POL. & BUFF	" "		
TEMP.		" "		H. G. FISCHER & CO. 2335 WABANSIA AVE. CHICAGO, ILL. / CAT. NO. / PART NO. 2770
PATT.		" "		

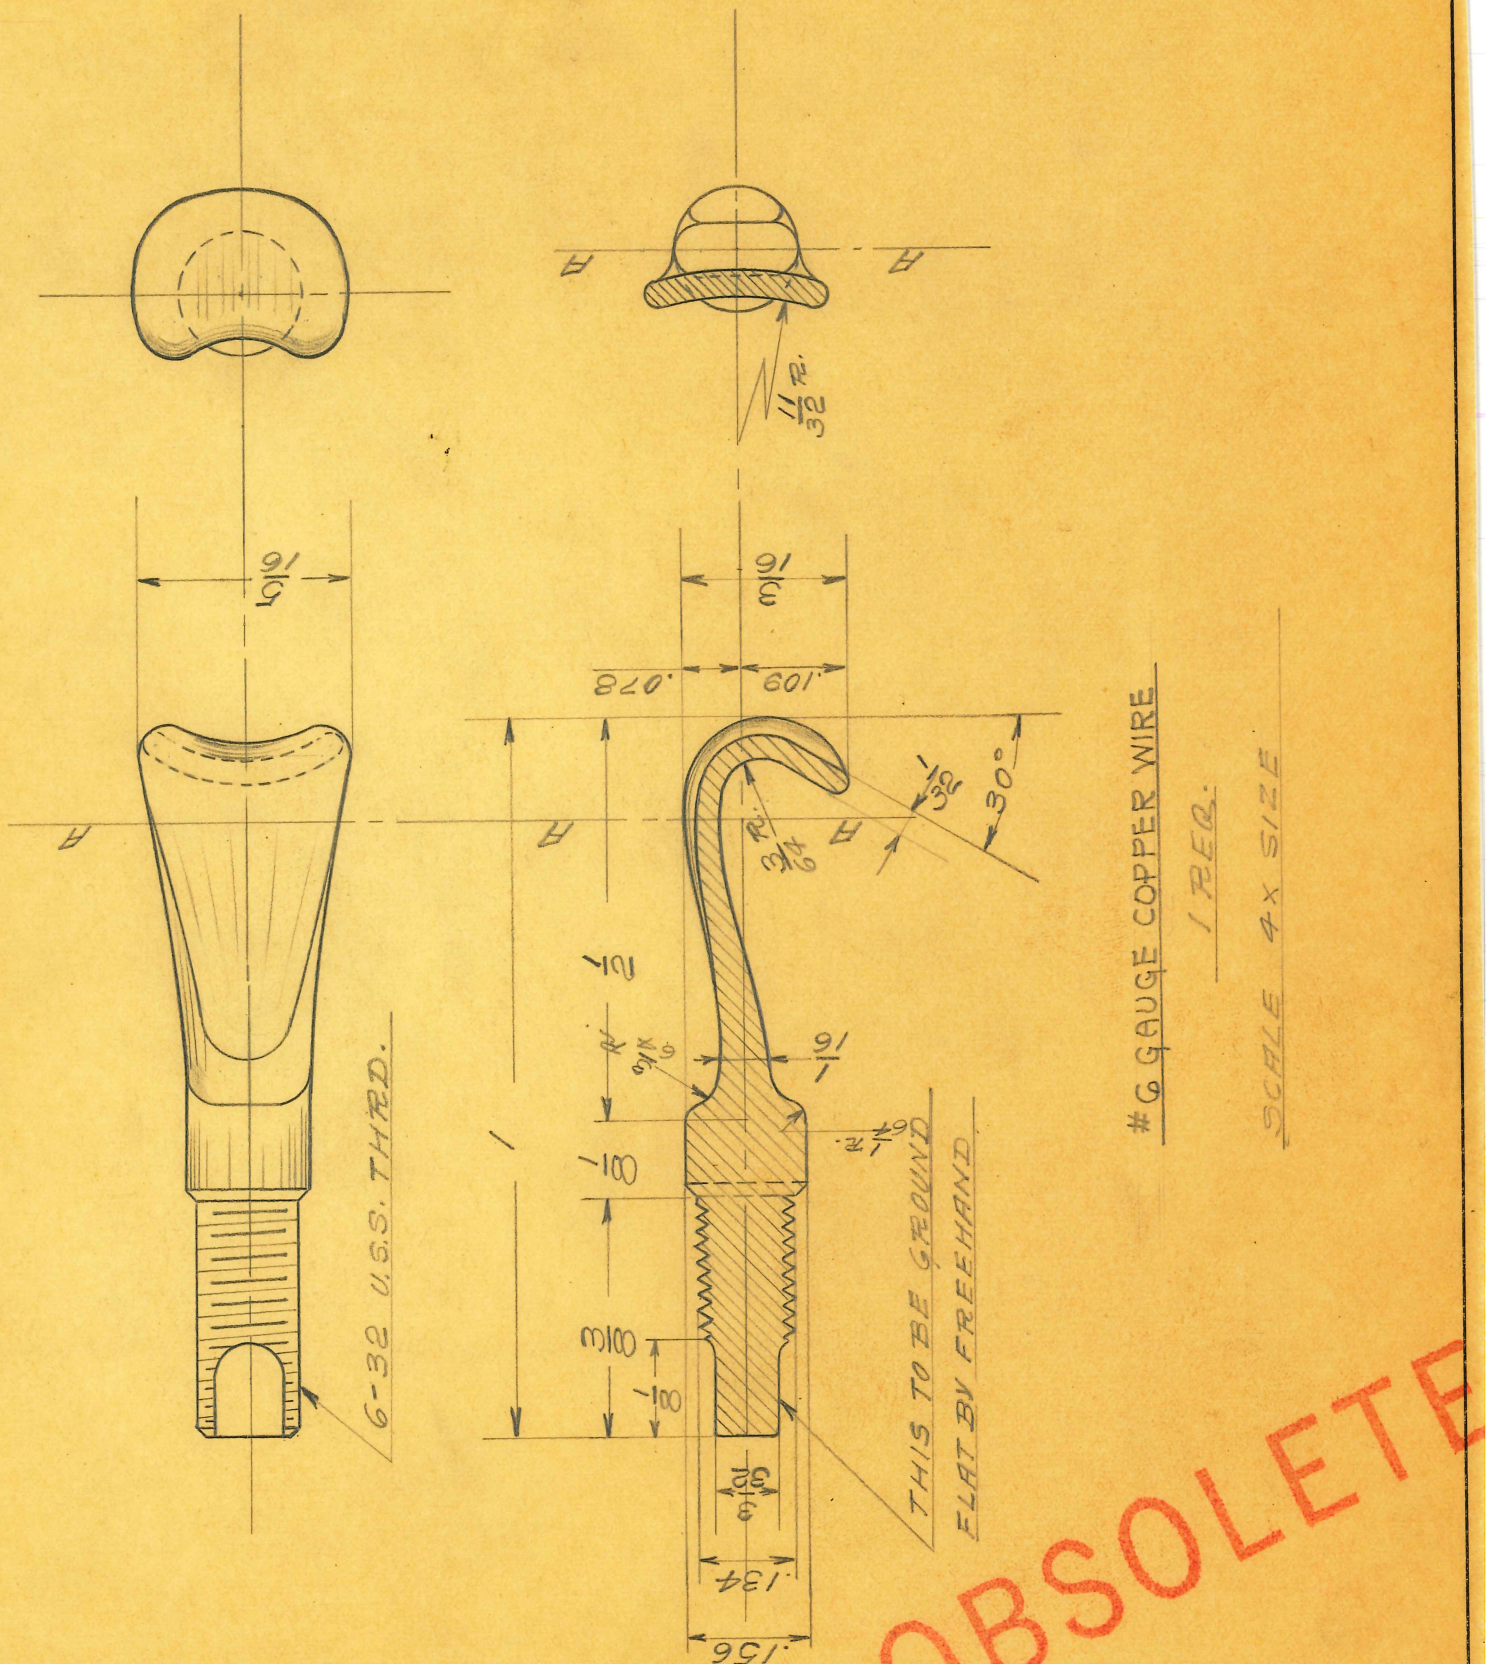

SIZE		ISSUE		TITLE: PILLAR RETRACTOR TIP - CURVED	
KIND		CHANGED			
SHAPE		" "			
FINISH	POL. & BUFF & CHROME PLATE	" "			
[illegible]P.		" "		H. G. FISCHER & CO. 2335 WABANSIA AVE. CHICAGO, ILL.	CAT. NO.
PATT.		" "			PART NO. 2787

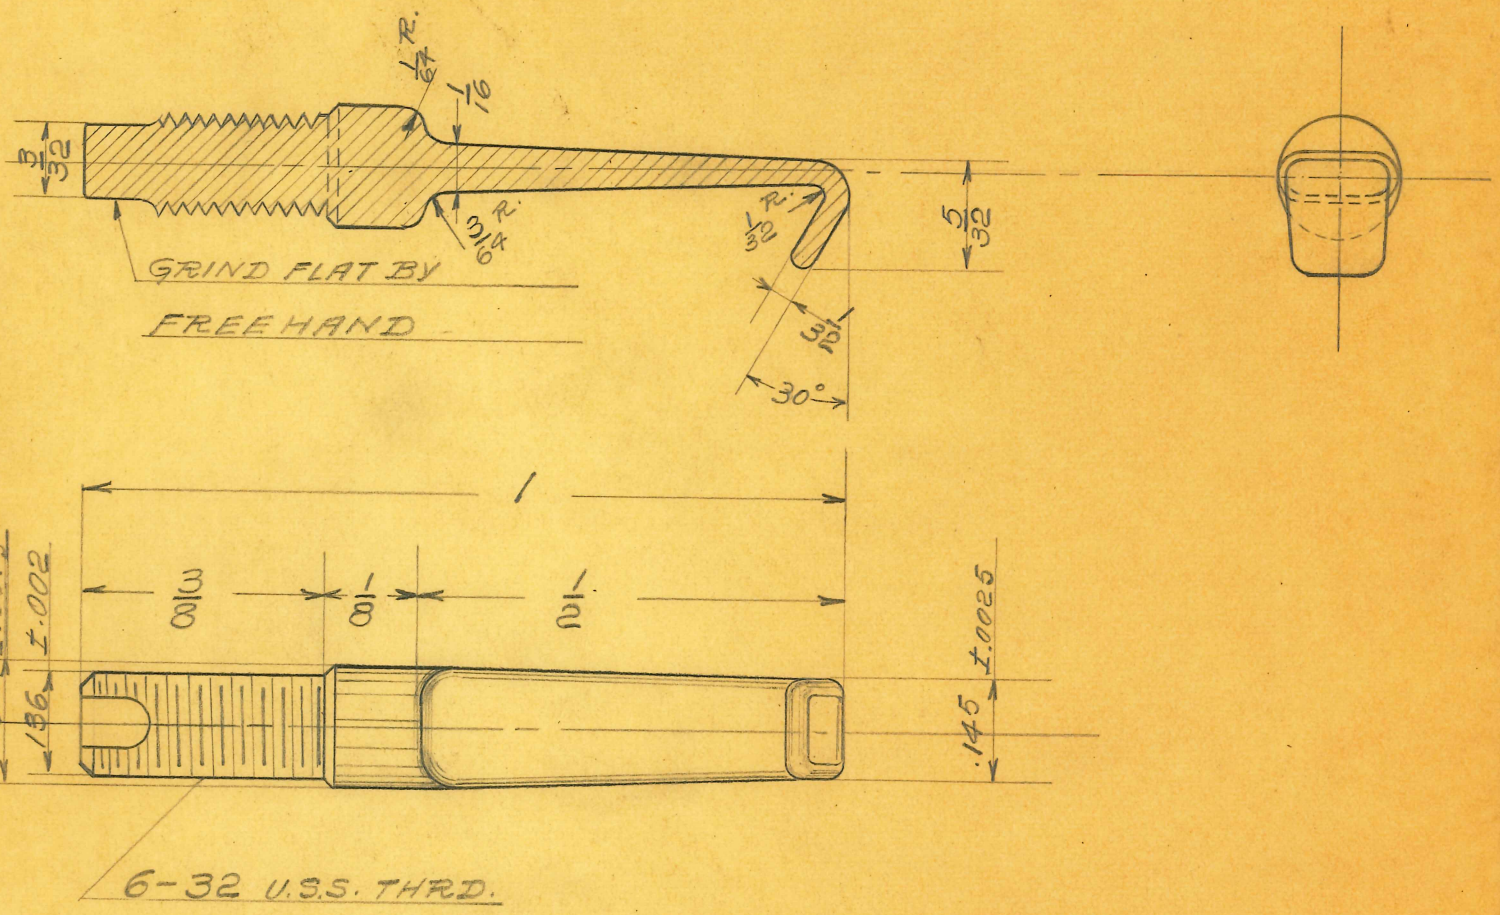

#6 GAUGE COPPER WIRE

1 REQ.

SCALE 4 × SIZE

OBSOLETE

SIZE		ISSUE	
KIND		CHANGED	
SHAPE		" "	
FINISH	POL. & BUFF & CHROME PLATE	" "	
[redacted]		" "	
PATT.		" "	

TITLE: PILLAR RETRACTOR TIP-FLAT

H. G. FISCHER & CO.
2335 WABANSIA AVE.
CHICAGO, ILL.

CAT. NO.

PART NO. 2788

OBSOLETE

SIZE		ISSUE Feb 4-26	E.P.	TITLE: HANDLE TONSIL - RETRACTOR. HANDLE	
KIND	HARD RUBBER.	CHANGED			
SHAPE		" "			
FINISH		" "			
TEMP.		" "		H. G. FISCHER & CO. 2335 WABANSIA AVE. CHICAGO, ILL.	CAT. NO.
PATT.		" "			PART NO. 2793.

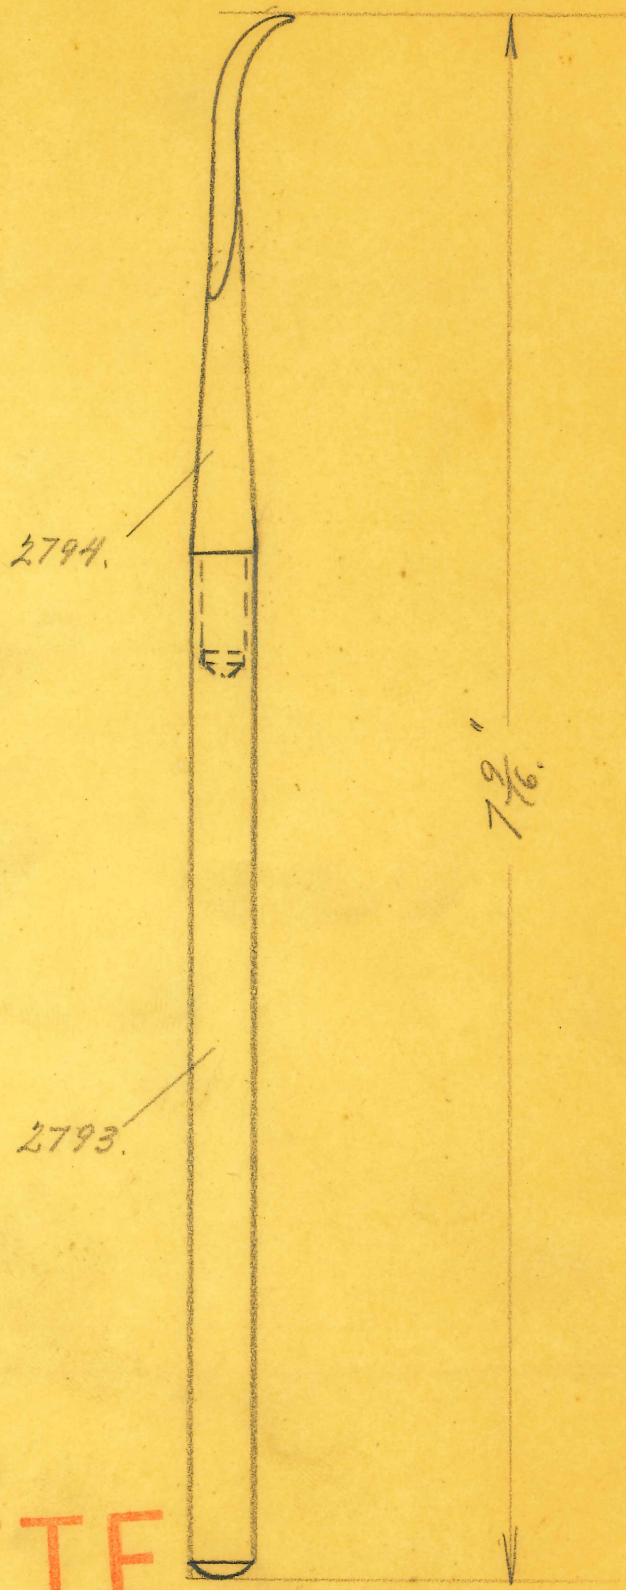

OBSOLETE

SIZE		ISSUE Feb. 1-26		TITLE: TONSIL - RETRACTOR. COMP.	
KIND		CHANGED			
SHAPE		" "			
FINISH		" "			
TEMP.		" "		H. G. FISCHER & CO. 2335 WABANSIA AVE. CHICAGO, ILL.	CAT. NO.
PATT.		" "			PART NO. 2793 G.

DRAWING No. 751

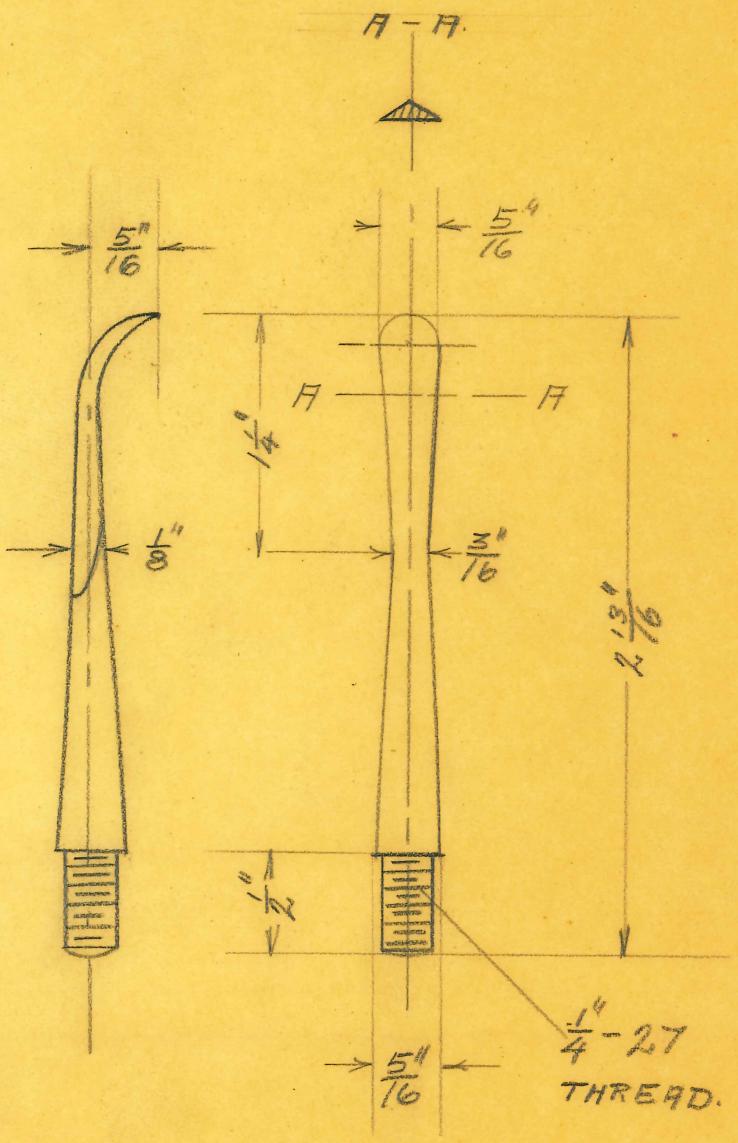

OBSOLETE

SIZE		ISSUE Feb 1-26	W.F.	TITLE: TIP TONSIL-RETRACTOR TIP	
KIND	IVORY	CHANGED			
SHAPE		" "			
FINISH		" "			
TEMP.		" "		H. G. FISCHER & CO. 2335 WABANSIA AVE. CHICAGO, ILL.	CAT. NO.
PATT.		" "			PART NO. 2794.

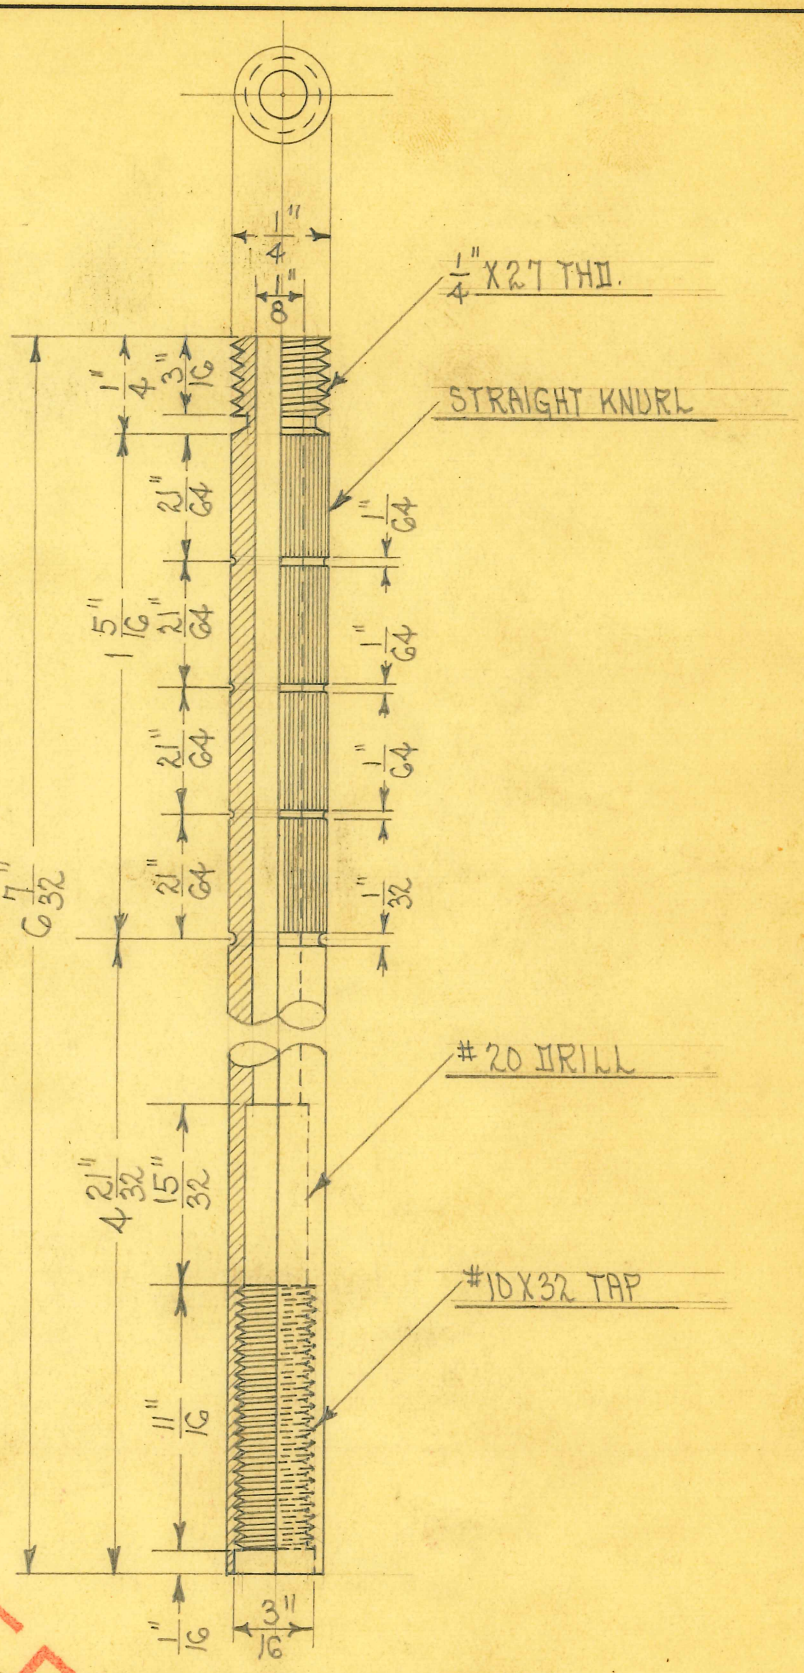

OBSOLETE

SCALE ~ 2 DIAMETERS

SIZE	1/8" X 1/4"	ISSUE 7-21-32	A.E.	TITLE: DR. OGDEN GALVANIC NEEDLE HOLDER BODY
KIND	POL. RUB. TUBING	CHANGED		
SHAPE		" "		
FINISH		" "		
TEMP.		" "		
PATT.		" "		

H. G. FISCHER & CO.
2335 WABANSIA AVE.
CHICAGO, ILL.

CAT. NO.

PART NO. 2870

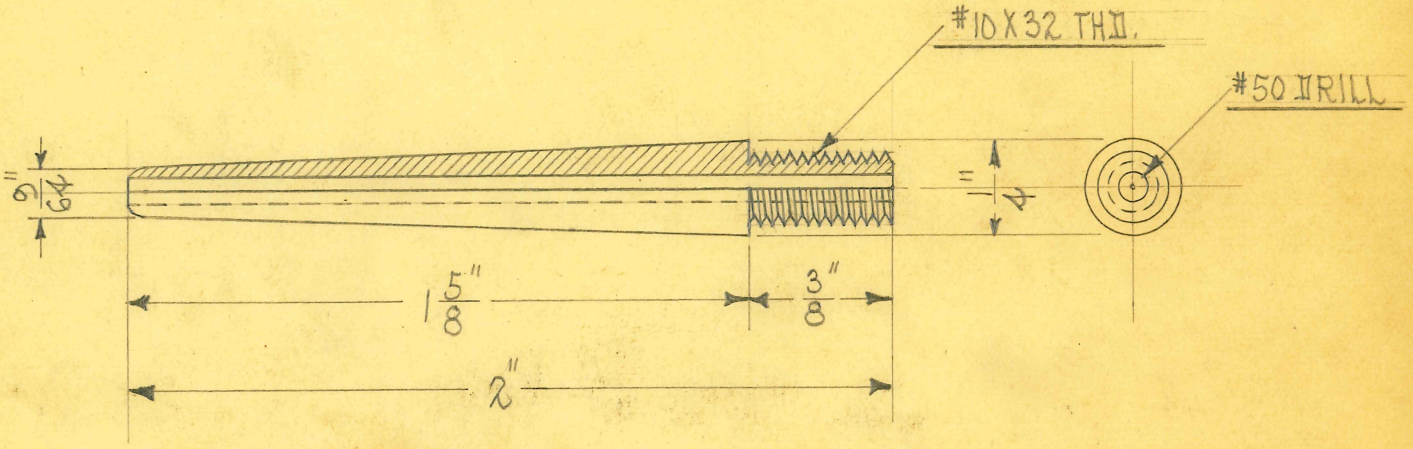

SCALE ~ 2 DIAMETERS

OBSOLETE

SIZE	1/4"	ISSUE 7-20-32	A.E.	TITLE: DR. OGDEN GALVANIC NEEDLE HOLDER BODY TIP
KIND	POL. RUB. ROD	CHANGED		
SHAPE		" "		
FINISH		" "		
TEMP.		" "		
PATT.		" "		

H. G. FISCHER & CO.
2335 WABANSIA AVE.
CHICAGO, ILL.

CAT. NO.

PART NO. 2871

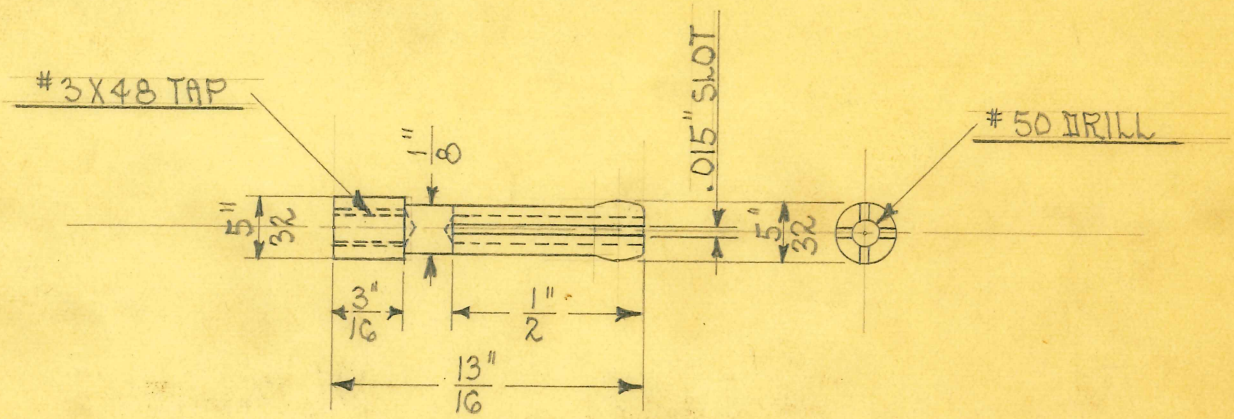

SCALE ~2 DIAMETERS

SIZE	5/32"	ISSUE	7-23-32	A.E.	TITLE: DR. OGDEN GALVANIC NEEDLE HOLDER CHUCK	
KIND	BRASS ROD	CHANGED				
SHAPE		" "				
FINISH		" "				
TEMP.		" "			H. G. FISCHER & CO. 2335 WABANSIA AVE. CHICAGO, ILL.	CAT. NO.
PATT.		" "				PART NO. 2872

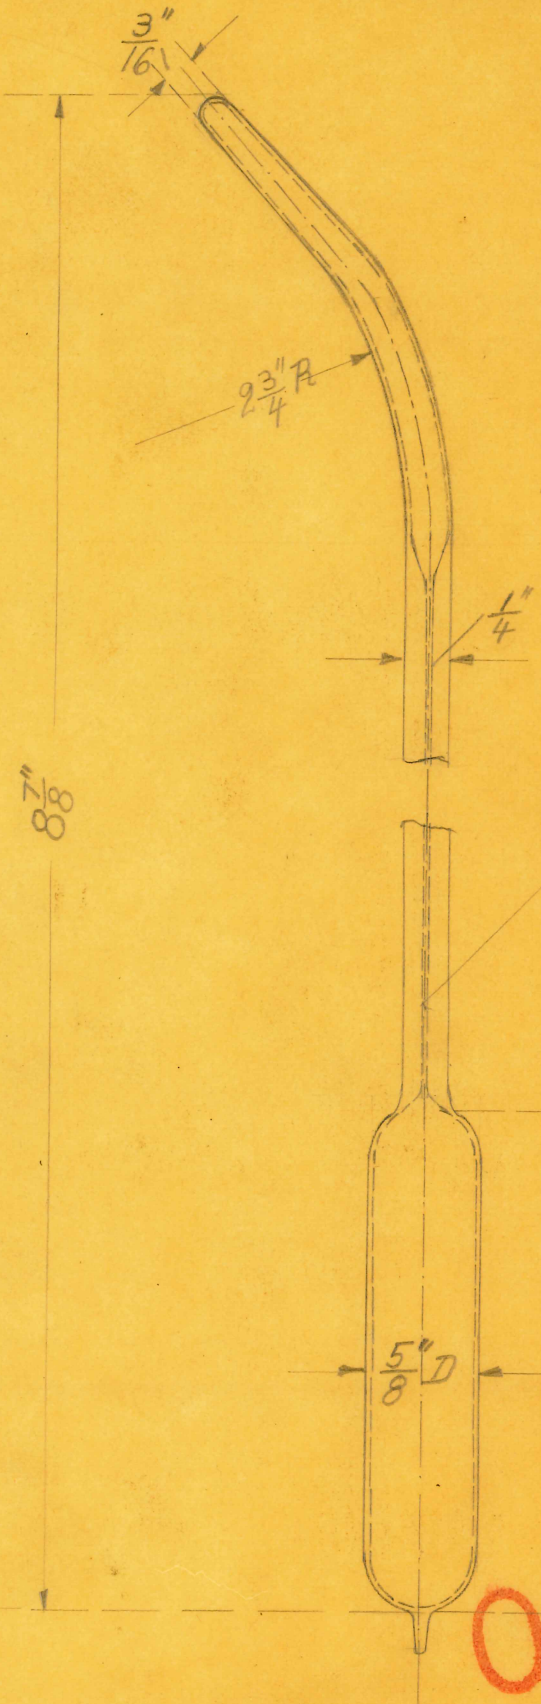

OBSOLETE

SIZE		ISSUE		TITLE: URETHRAL ELECTRODE DR. J.H. HAMMAN, VINCENNES, IND.
KIND		CHANGED		
SHAPE		" "		
FINISH		" "		
TEMP.		" "		H. G. FISCHER & CO. 2335 WABANSIA AVE. CHICAGO, ILL. / CAT. NO. / ~~PART~~ NO. S118
PATT.		" "		

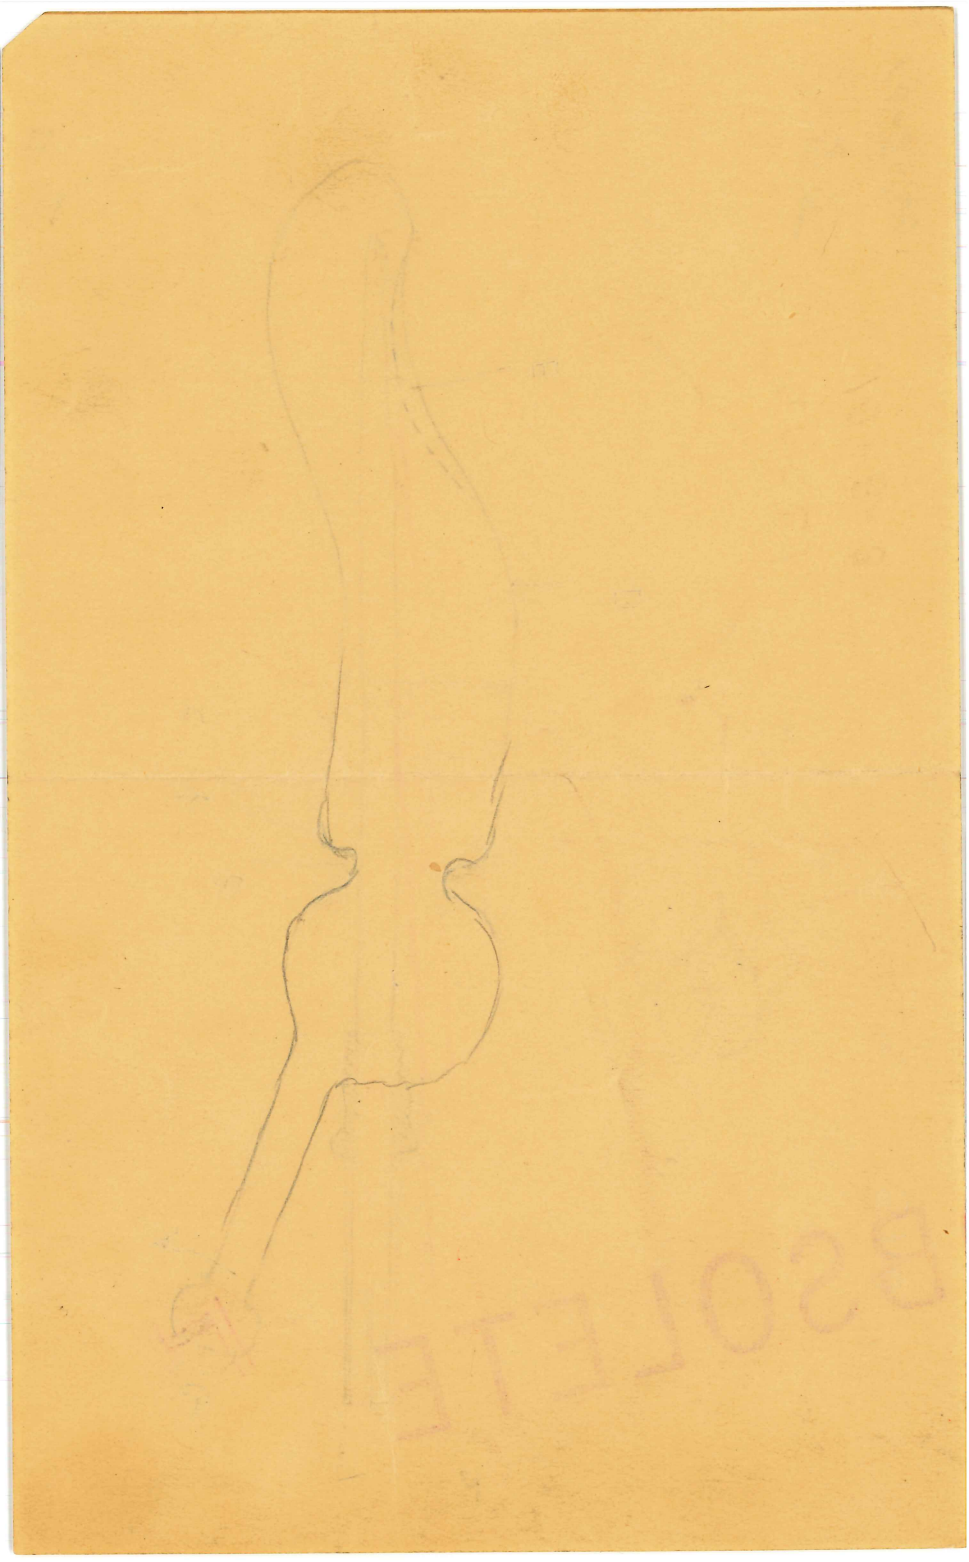

 

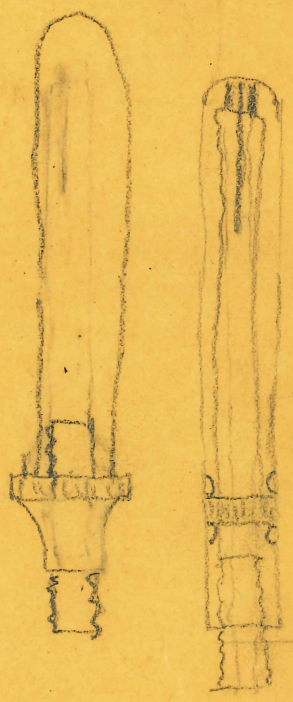

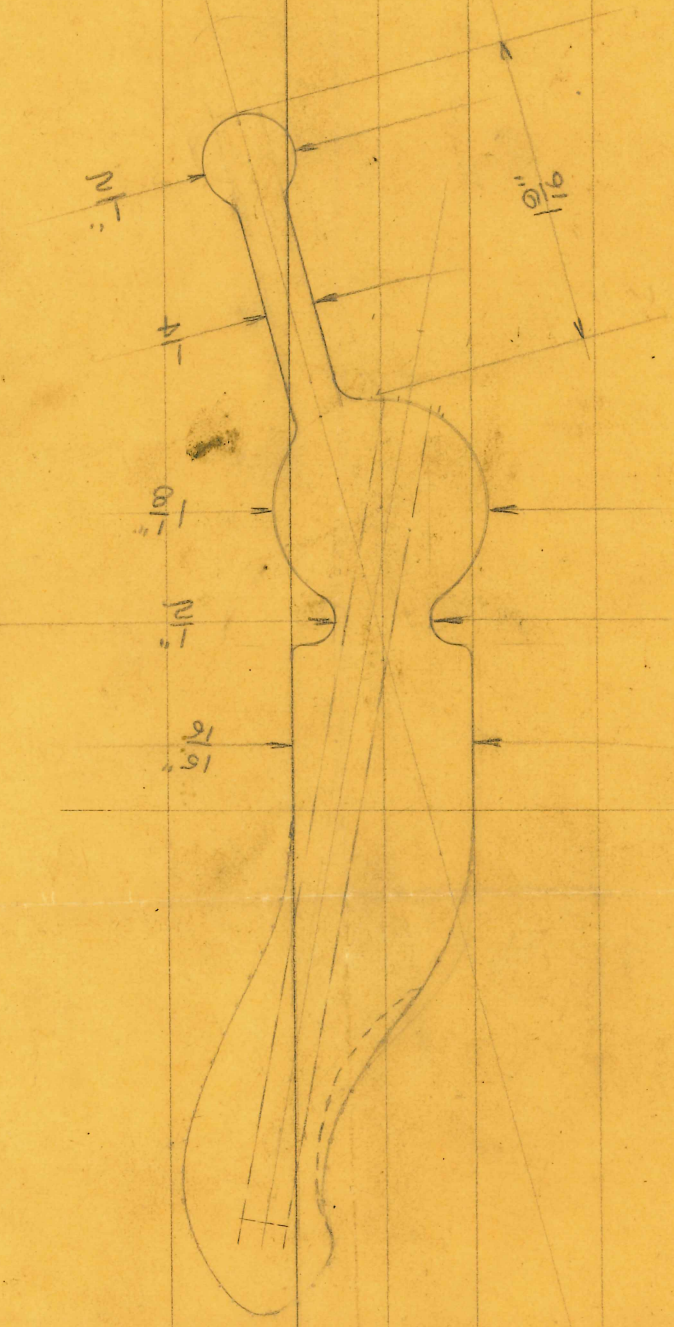

OBSOLETE

150

SIZE		ISSUE		TITLE:		
KIND		CHANGED				
SHAPE		" "				
FINISH		" "				
TEMP.		" "		H. G. FISCHER & CO. 2335 WABANSIA AVE. CHICAGO, ILL.	CAT. NO.	PART NO. S110
PATT.		" "				

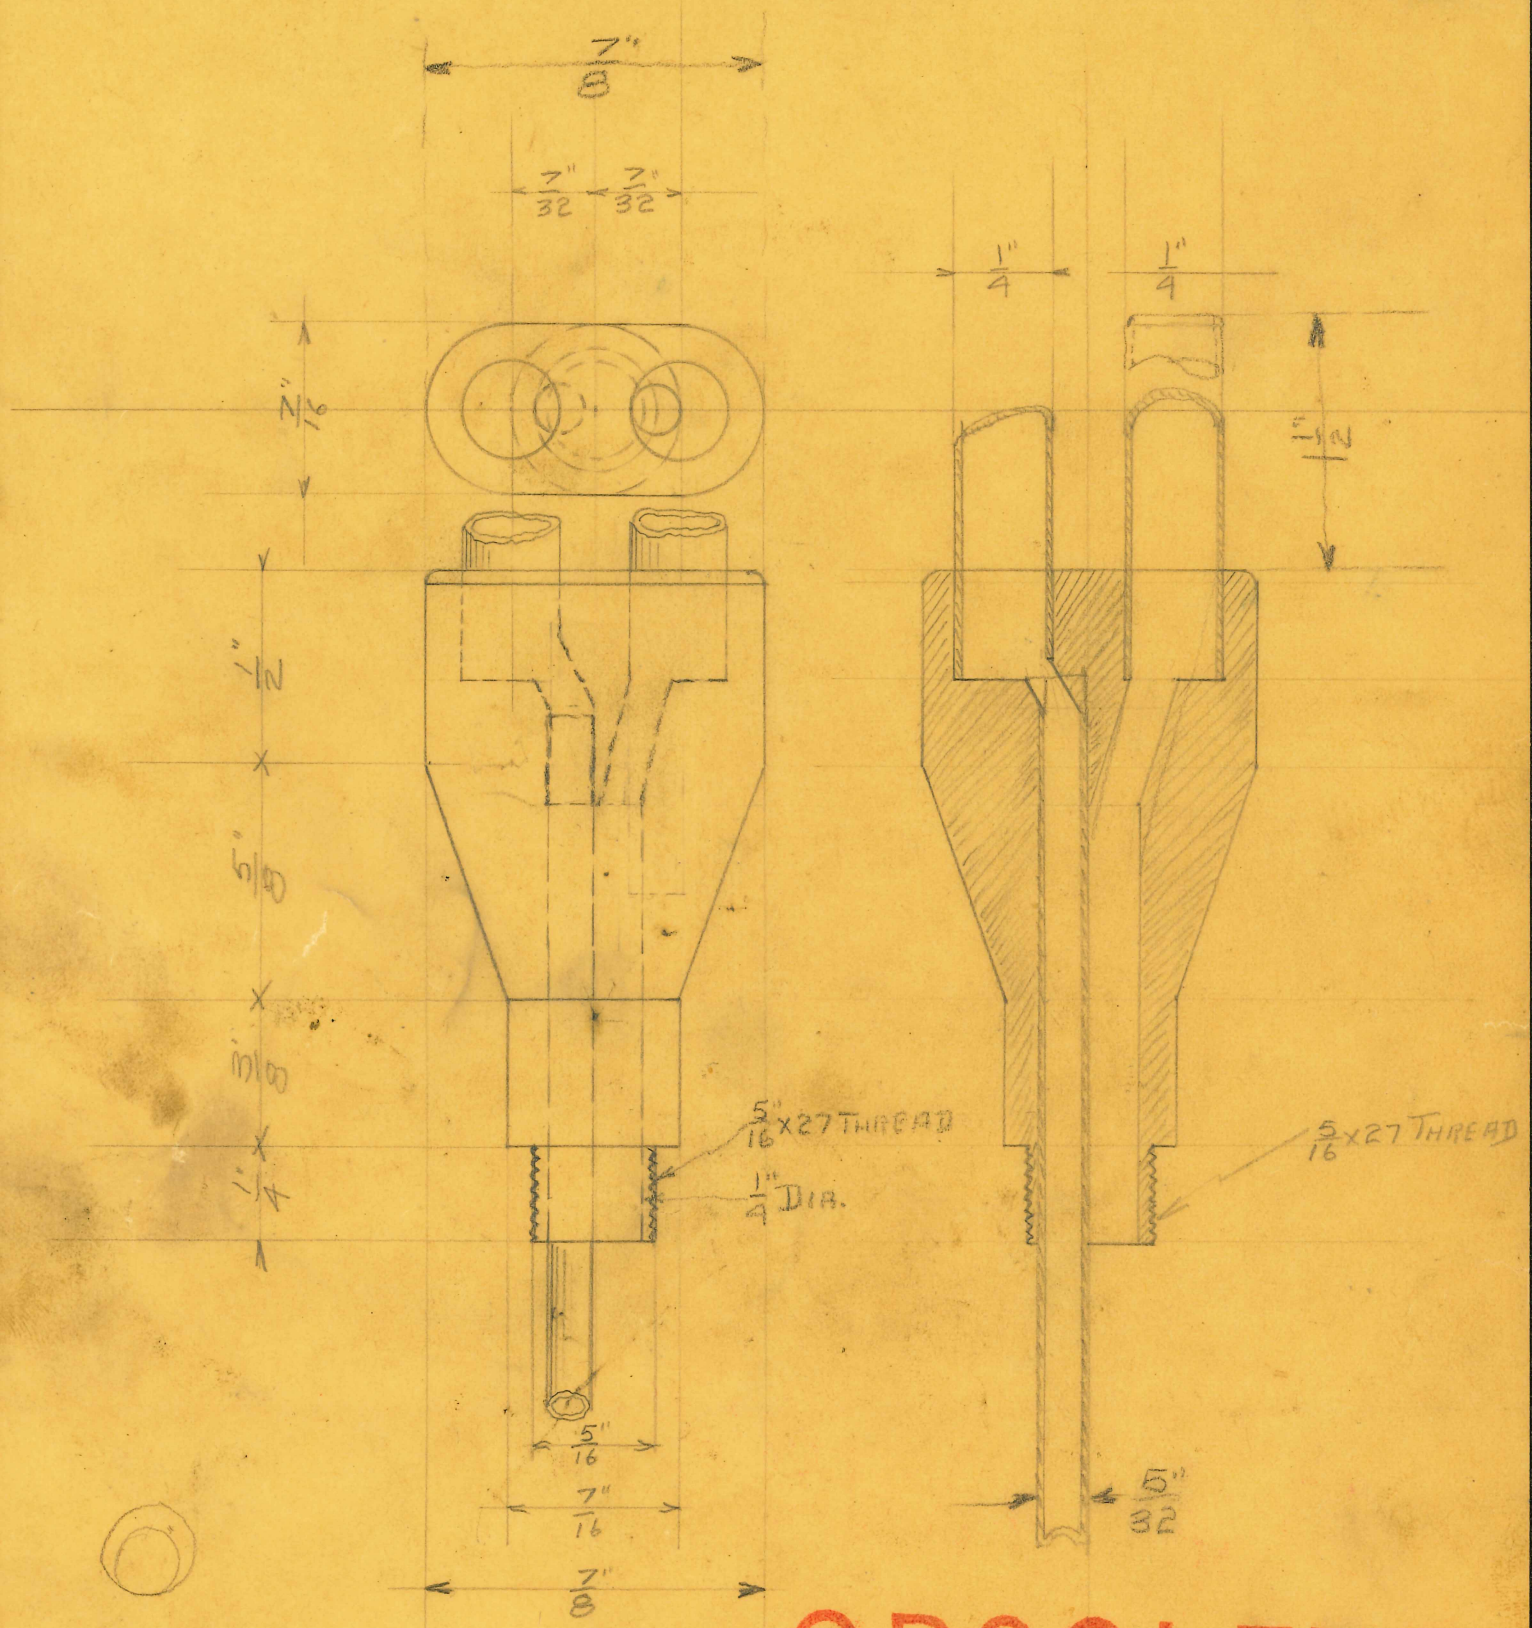

OBSOLETE

SIZE		ISSUE		TITLE:			
KIND		CHANGED					
SHAPE		" "					
FINISH		" "					
TEMP.		" "		H. G. FISCHER & CO. 2335 WABANSIA AVE. CHICAGO, ILL.	CAT. NO.	PART NO. 5110	
PATT.		" "					

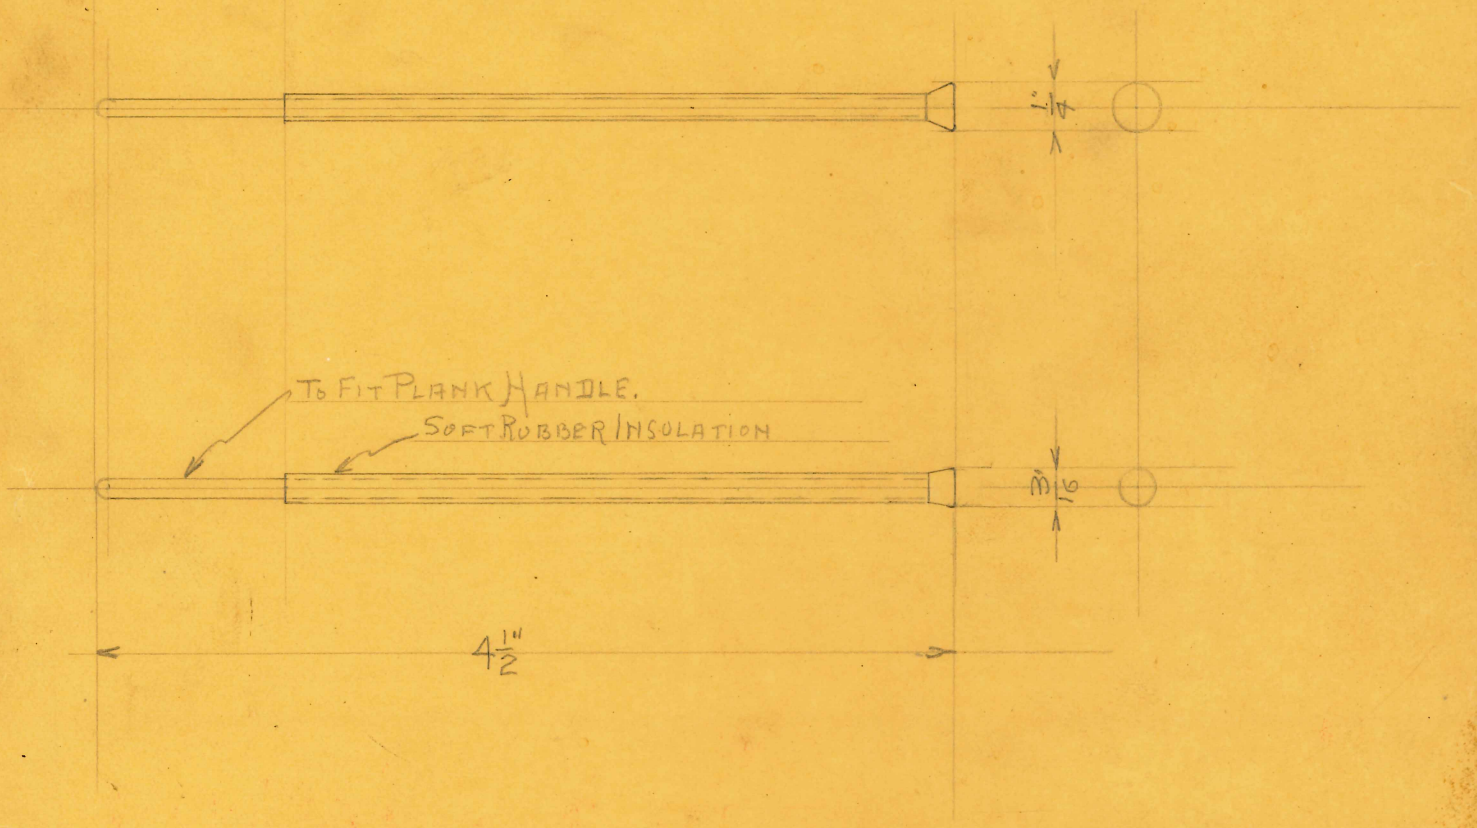

A. B. Butine
Order No. C47800 - 7-30-30

OBSOLETE

SIZE		ISSUE		TITLE: Special Button Electrodes To Fit Plank Handle		
KIND		CHANGED				
SHAPE		" "				
FINISH		" "				
TEMP.		" "		H. G. FISCHER & CO. 2335 WABANSIA AVE. CHICAGO, ILL.	CAT. NO.	PART NO. S-105
PATT.		" "				

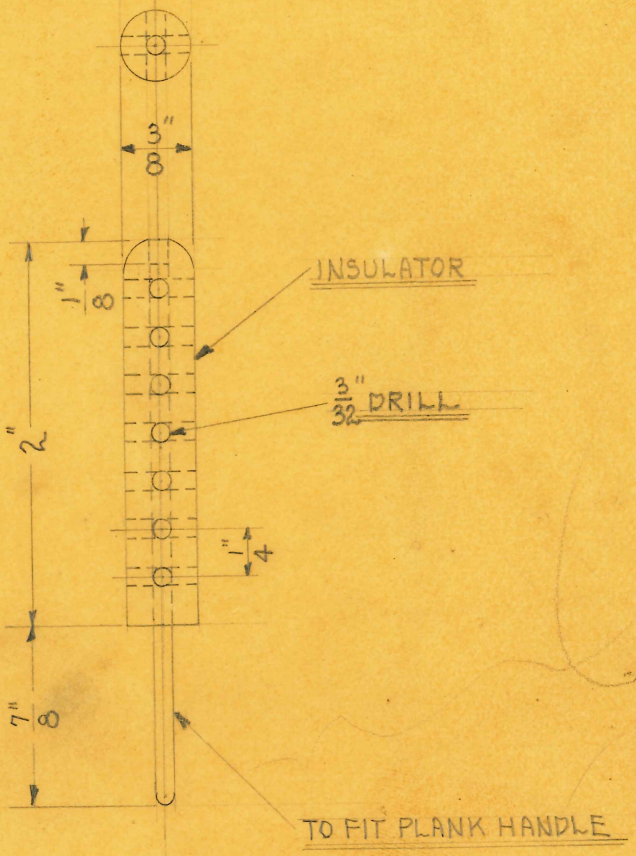

OBSOLETE

SIZE		ISSUE 8-20-30	3/8.	TITLE: SPEC. ELEC. FOR DR. KOEBEL ; DETROIT, MICH		
KIND		CHANGED				
SHAPE		" "				
FINISH		" "				
TEMP.		" "		H. G. FISCHER & CO. 2335 WABANSIA AVE. CHICAGO, ILL.	CAT. NO.	PART NO. S-106
PATT.		" "				

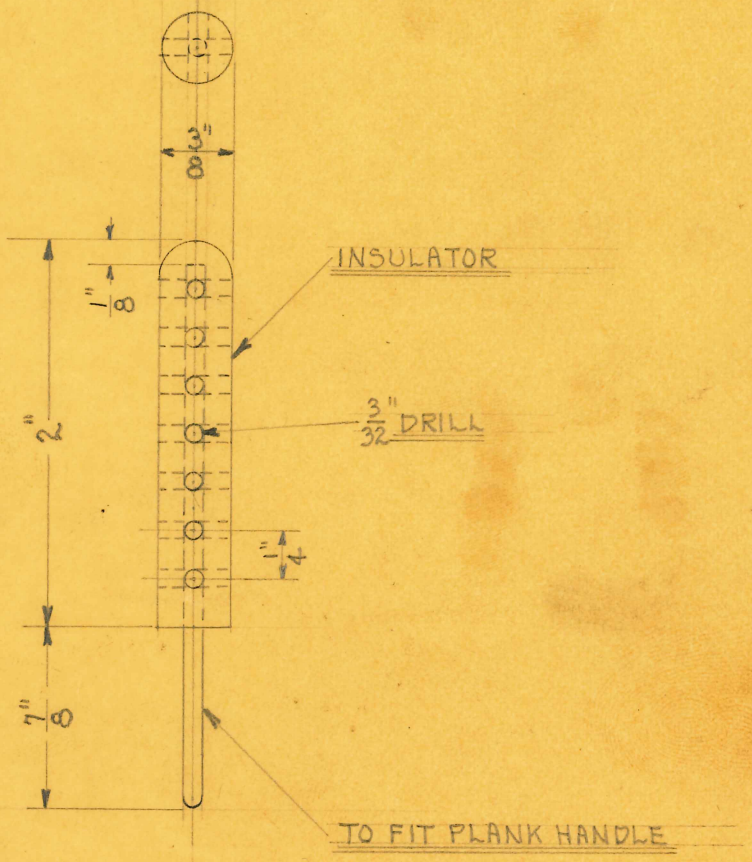

OBSOLETE

SIZE		ISSUE 8-20-30	J.E.	**TITLE:** SPEC. ELEC. FOR DR. KOEBEL - DETROIT, MICH
KIND		CHANGED		
SHAPE		" "		
FINISH		" "		
TEMP.		" "		H. G. FISCHER & CO. 2335 WABANSIA AVE. CHICAGO, ILL. — CAT. NO. — PART NO. S-107
PATT.		" "		

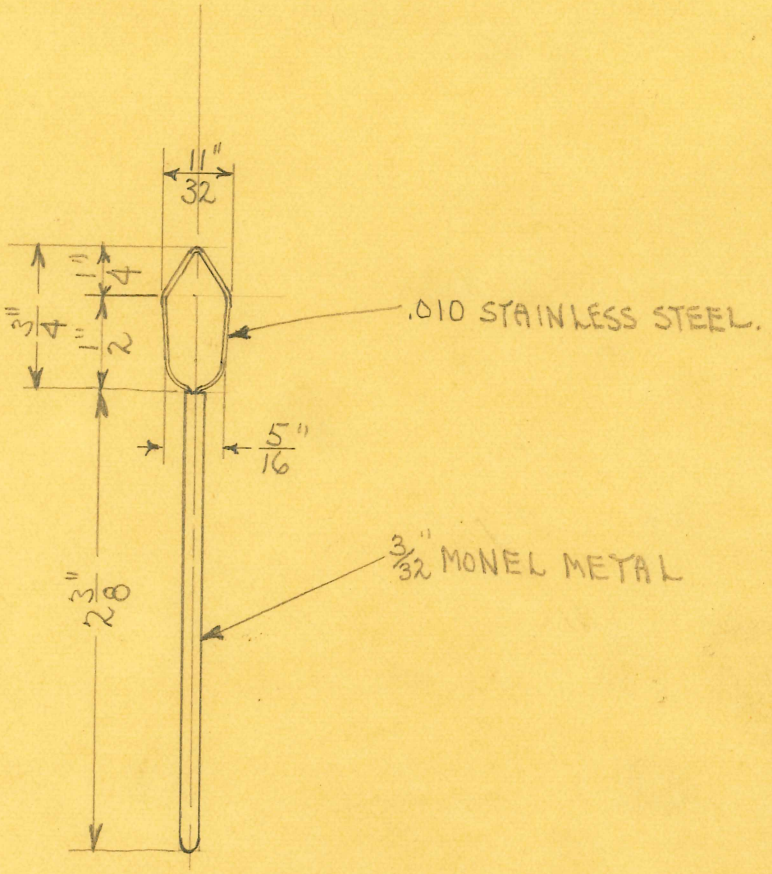

OBSOLETE

SIZE		ISSUE 10-5-32	A.E.	TITLE: SPECIAL CUTTING KNIFE FOR MICHAEL REESE HOSPITAL		
KIND		CHANGED				
SHAPE		" "				
FINISH		" "				
TEMP.		" "		H. G. FISCHER & CO. 2335 WABANSIA AVE. CHICAGO, ILL.	CAT. NO.	PART NO. 5123
PATT.		" "				

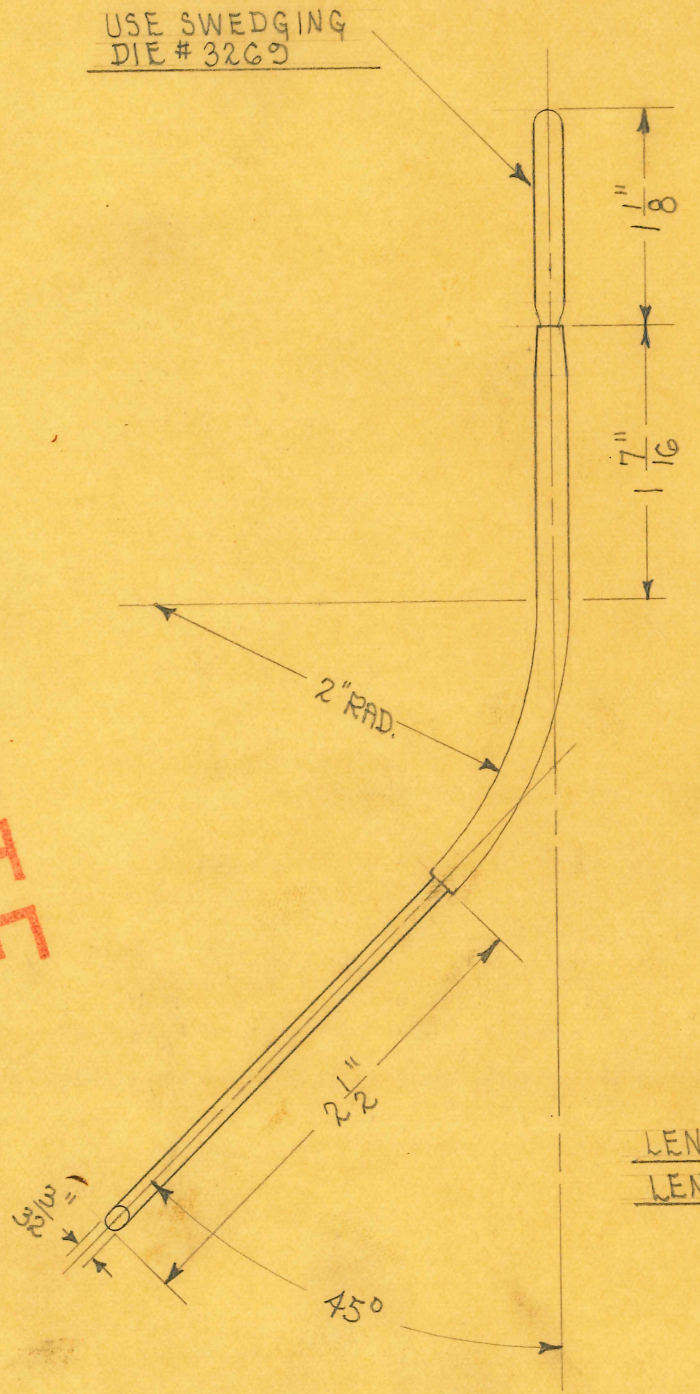

OBSOLETE

LENGTH OF ELECT. - 6 11/16"
LENGTH OF INSULATOR - 3 1/16"

SIZE		ISSUE 3-17-33	A.E.
KIND		CHANGED	
SHAPE		" "	
FINISH		" "	
TEMP.		" "	
PATT.		" "	

TITLE: SPECIAL SINSKEY ELECT. FOR DR. WM. H. SMITH
CINCINNATI, OHIO O.O. # 74673

H. G. FISCHER & CO.
2335 WABANSIA AVE.
CHICAGO, ILL.

CAT. NO.

PART NO. S124

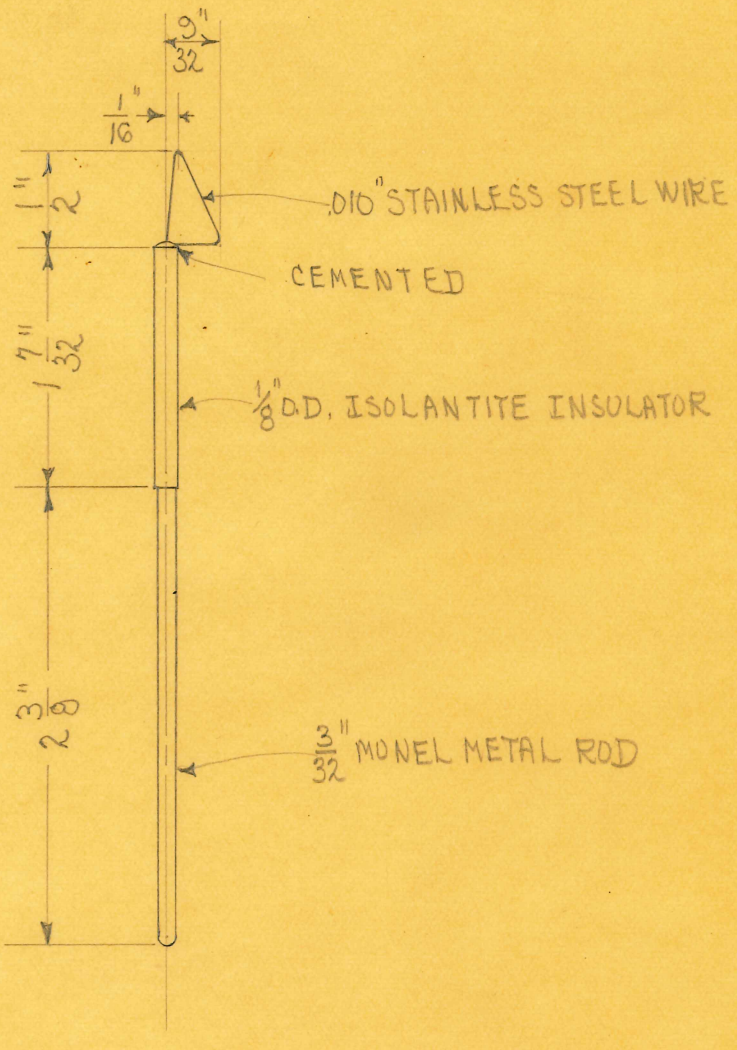

OBSOLETE

SIZE		ISSUE 9-14-33		TITLE: CERVICAL REAMER- MED. FOR DR. SUTTON- ROYAL OAK, MICH. O.O.# 24583
KIND		CHANGED		
SHAPE		" "		
FINISH		" "		
TEMP.		" "		H. G. FISCHER & CO. 2335 WABANSIA AVE. CHICAGO, ILL. — CAT. NO. — PART NO. S125
PATT.		" "		

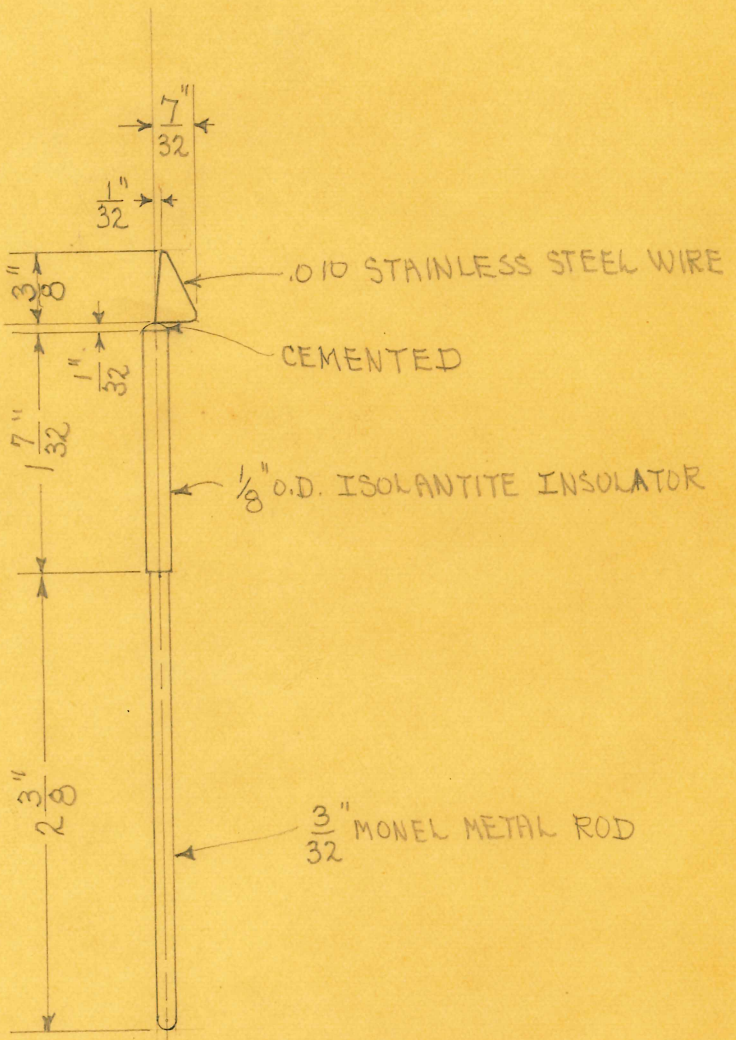

OBSOLETE

SIZE		ISSUE 9-14-33	2/8	TITLE: CERVICAL REAMER - SMALL FOR DR. SUTTON - ROYAL OAK, MICH. O.D. #24583
KIND		CHANGED		
SHAPE		" "		
FINISH		" "		
TEMP.		" "		H. G. FISCHER & CO. 2335 WABANSIA AVE. CHICAGO, ILL.
PATT.		" "		CAT. NO.
				PART NO. S125

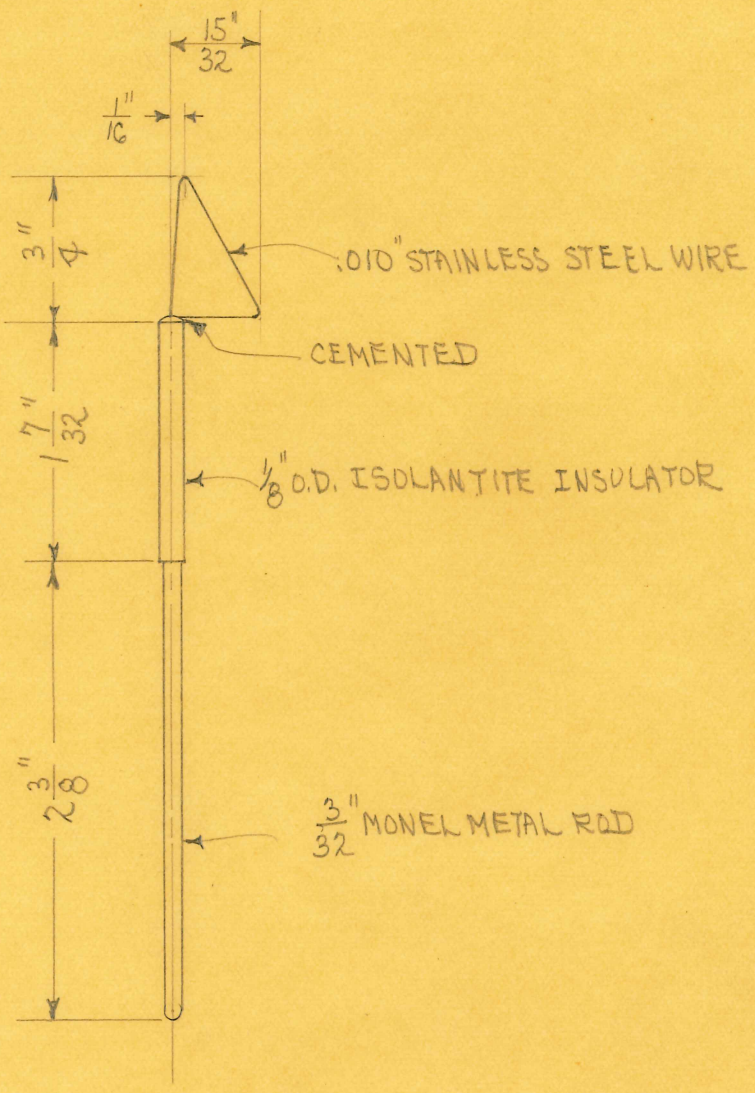

OBSOLETE

SIZE		ISSUE 9-14-33	2/6	TITLE: CERVICAL REAMER-LARGE FOR DR. SUTTON- ROYAL OAK, MICH. O.D. # 24583		
KIND		CHANGED				
SHAPE		" "				
FINISH		" "				
TEMP.		" "		H. G. FISCHER & CO. 2335 WABANSIA AVE. CHICAGO, ILL.	CAT. NO.	PART NO. S125
PATT.		" "				

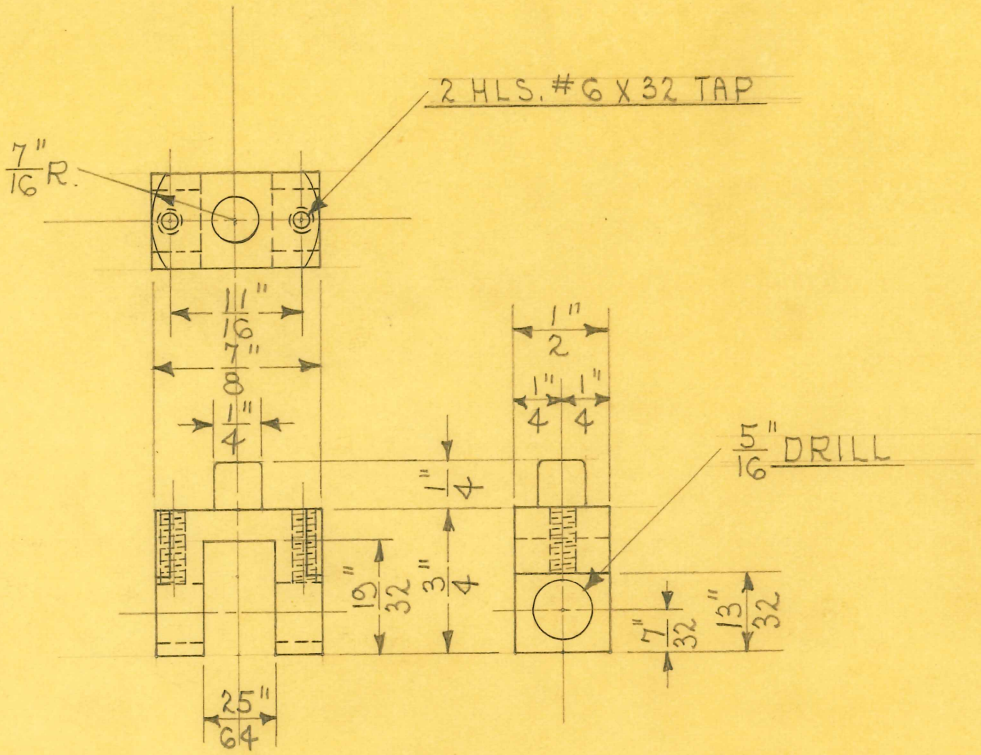

2 REQUIRED

OBSOLETE

SIZE	1/2" X 7/8"	ISSUE 1-23-37	A.E.G.
KIND	C.R. STEEL	CHANGED	
SHAPE	BAR	"	
FINISH		"	
TEMP.		"	
PATT.		"	

TITLE: WRIST PIN BLOCK

H. G. FISCHER & CO.
2338 WABANSIA AVE.
CHICAGO, ILL.

CAT. NO.

PART NO. P139

NOTE:
DRAWN HALF SCALE

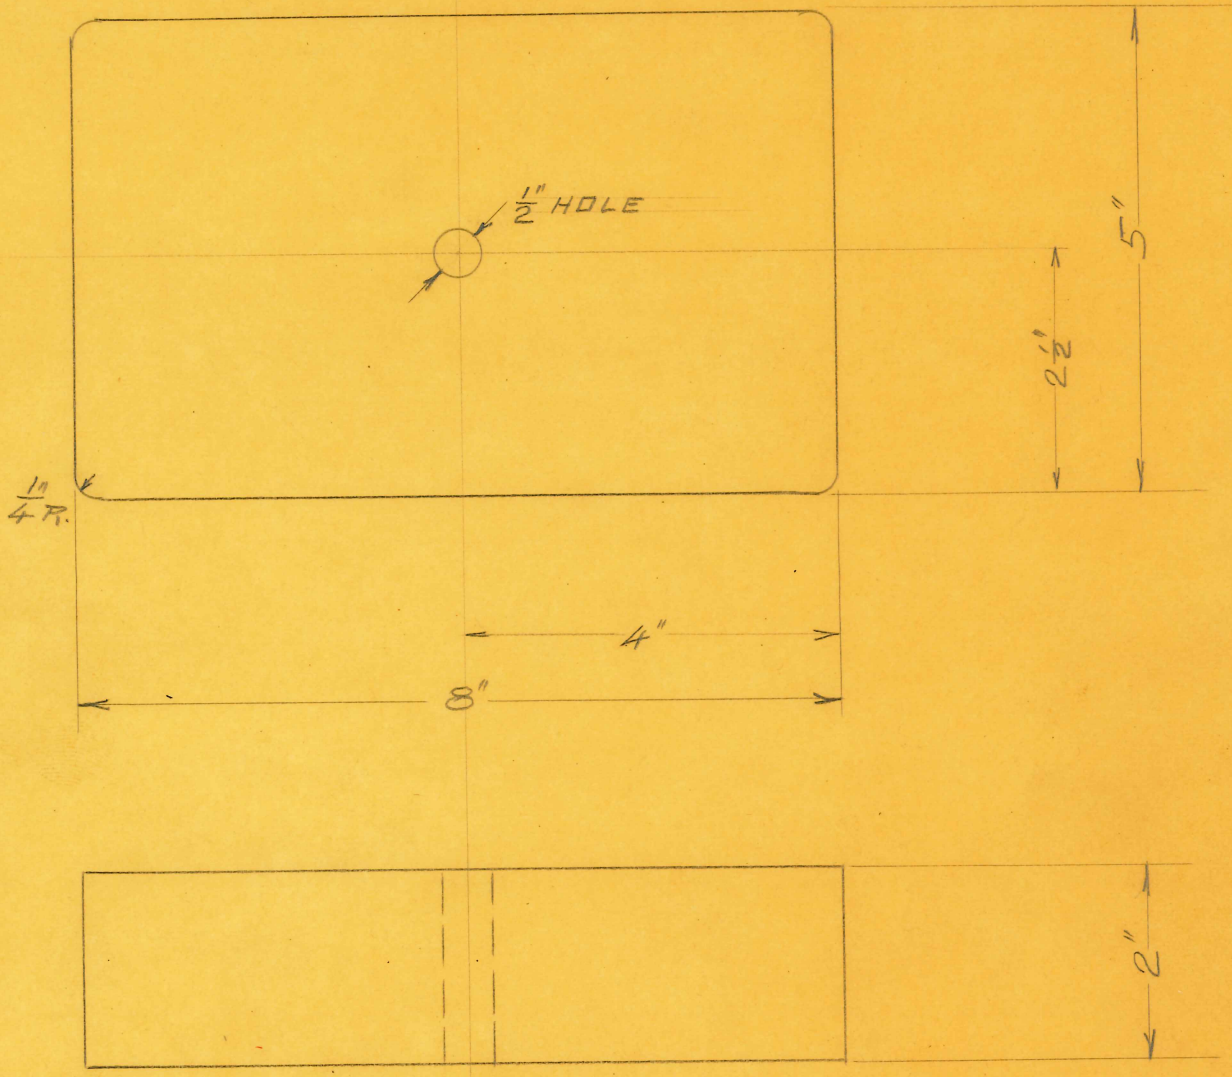

5" X 8"
6½" X 9½"
8" X 12"
} 2" THICK.

OBSOLETE

SIZE		ISSUE 9-16-26	G.P.	TITLE: SPECIAL PAD			
KIND		CHANGED					
SHAPE		" "					
FINISH		" "					
TEMP.		" "		H. G. FISCHER & CO. 2335 WABANSIA AVE. CHICAGO, ILL.	CAT. NO.	~~PART~~ NO. 782	
PATT.		" "					

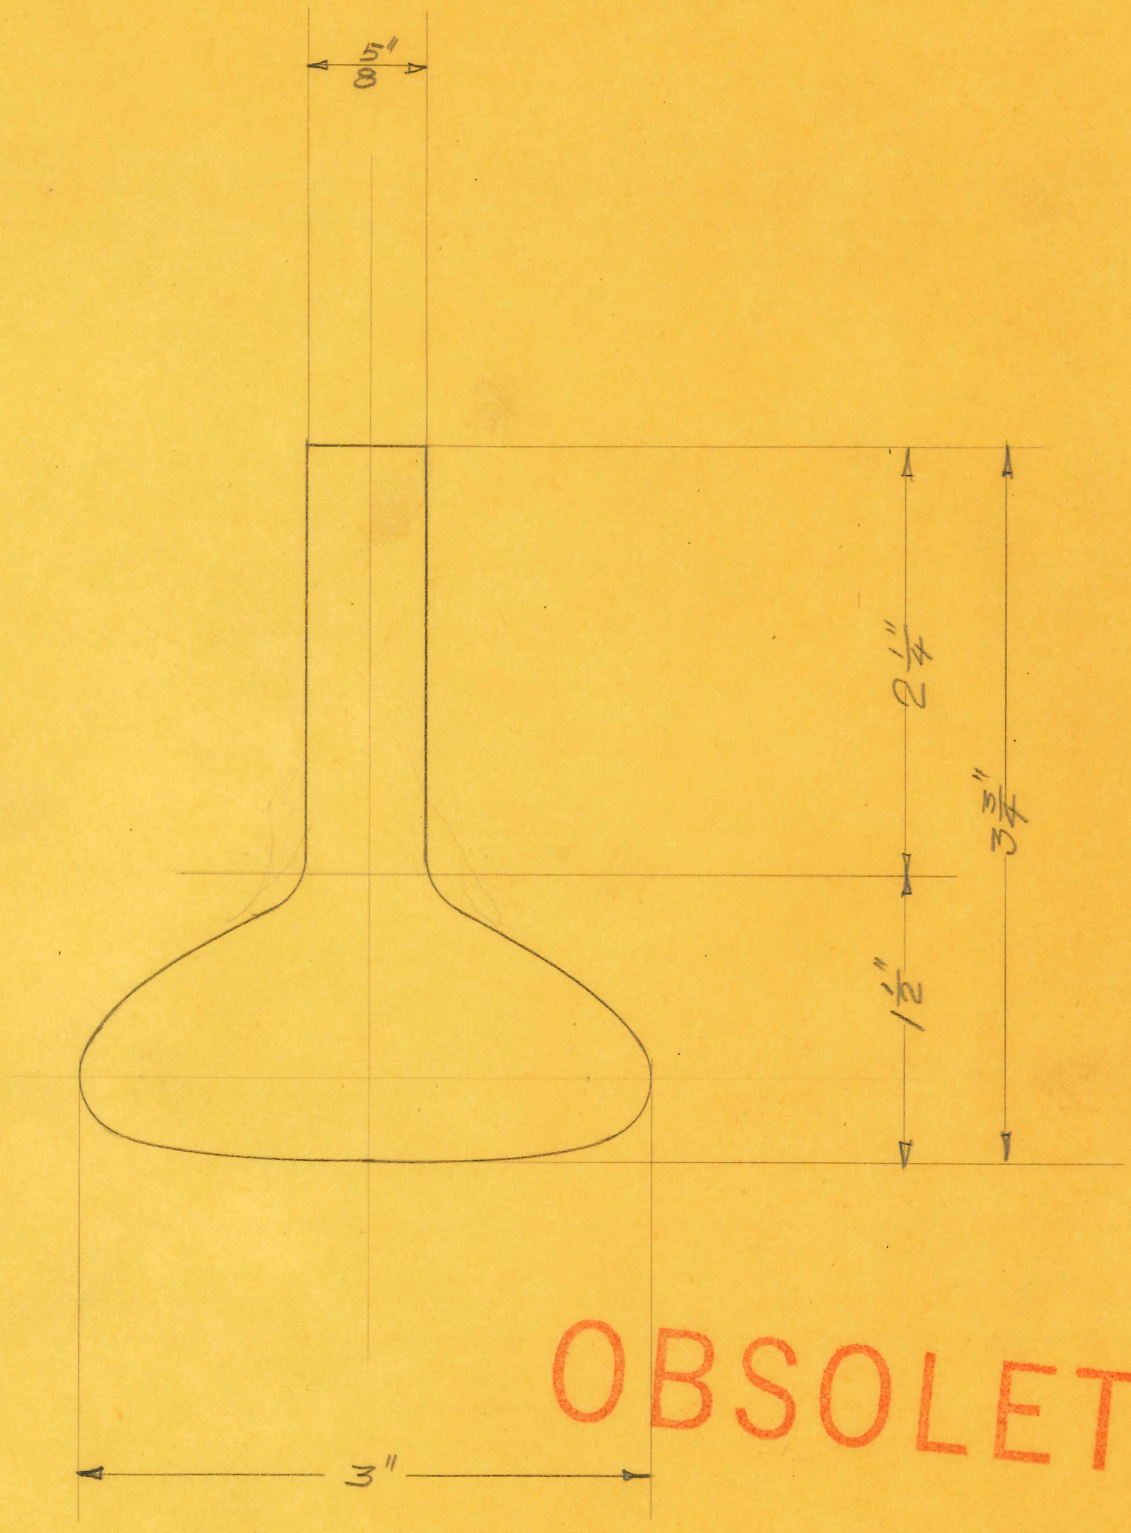

OBSOLETE

SIZE		ISSUE 9-9-26	DP.	TITLE:		
KIND		CHANGED				
SHAPE		" "				
FINISH		" "				
TEMP.		" "		H. G. FISCHER & CO. 2335 WABANSIA AVE. CHICAGO, ILL.	CAT. NO.	PART NO. 782
PATT.		" "				

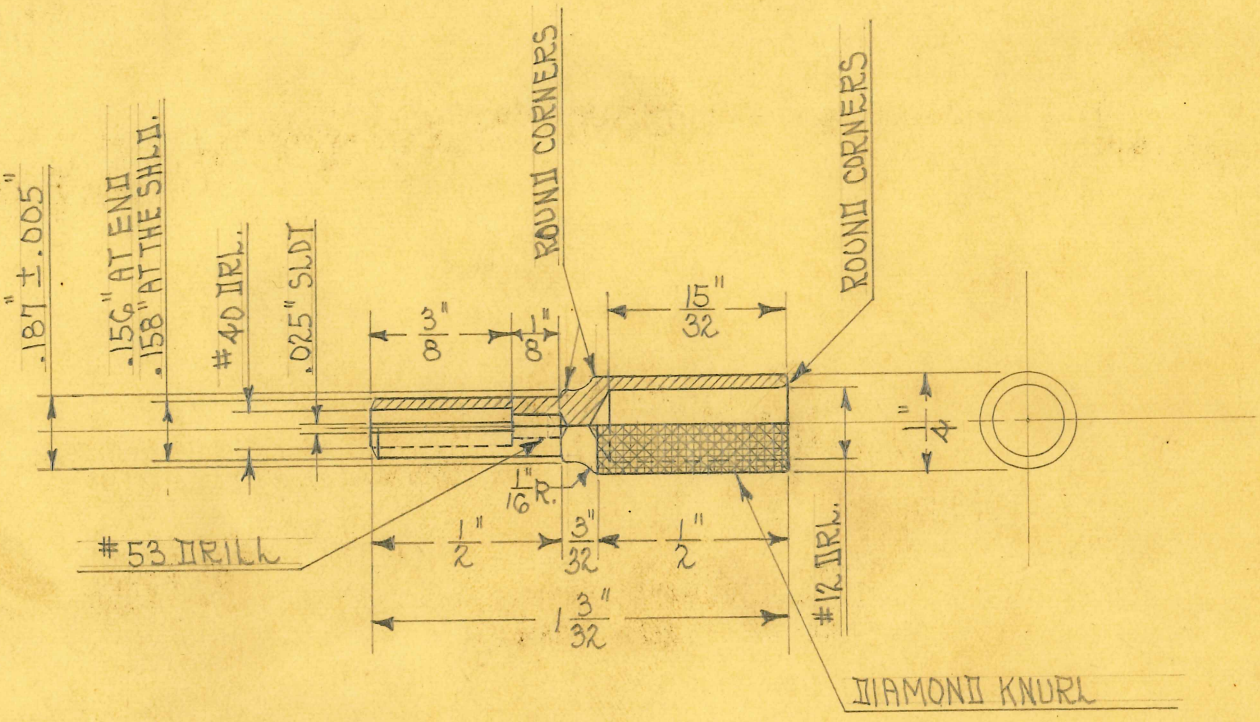

SCALE ~ 1" = 1/2"

OBSOLETE

SIZE	1/4"	ISSUE 8-12-32	W.E.	TITLE: PLANK TONSIL ELECT. CORD TIP (5/32") FRICTION TYPE
KIND	BRASS ROD	CHANGED		
SHAPE		" "		
FINISH	W.P.	" "		
TEMP.		" "		H. G. FISCHER & CO. 2335 WABANSIA AVE. CHICAGO, ILL. — CAT. NO. — PART NO. 1269 3/4 A
PATT.		" "		

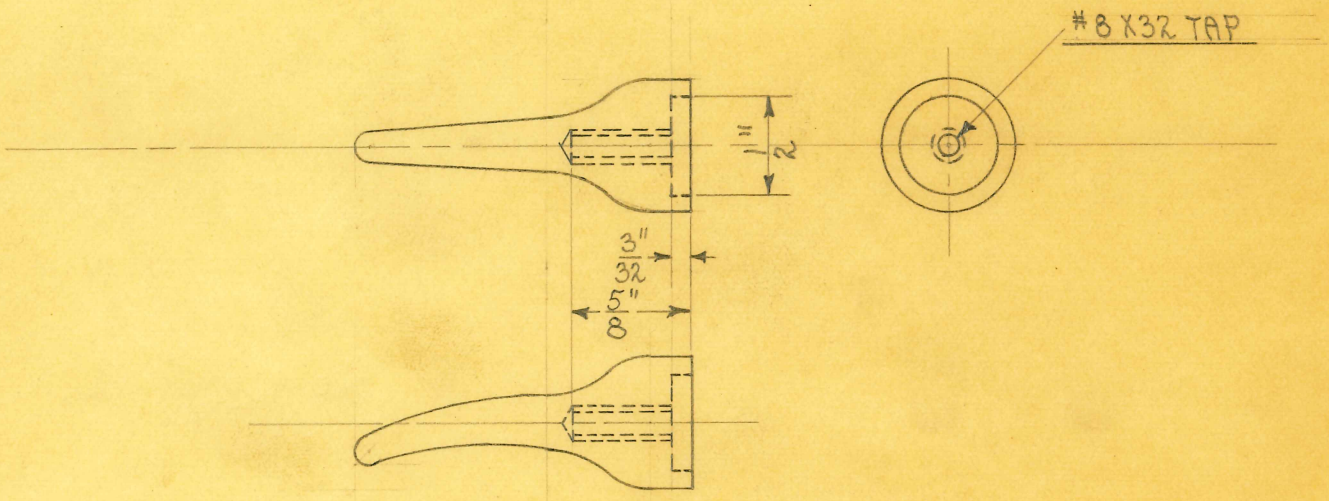

SCALE = FULL SIZE

OBSOLETE

SIZE		ISSUE 2-3-32	H.E.	**TITLE:** WASHINGTON INTRA-CERVICAL IONIZING ELECT. HEAD
KIND	ZINC CASTING	CHANGED		
SHAPE		" "		
FINISH	BUFF & POL.	" "		
TEMP.		" "		H. G. FISCHER & CO. 2335 WABANSIA AVE. CHICAGO, ILL. — CAT. NO. — PART NO. 4310F
PATT.		" "		

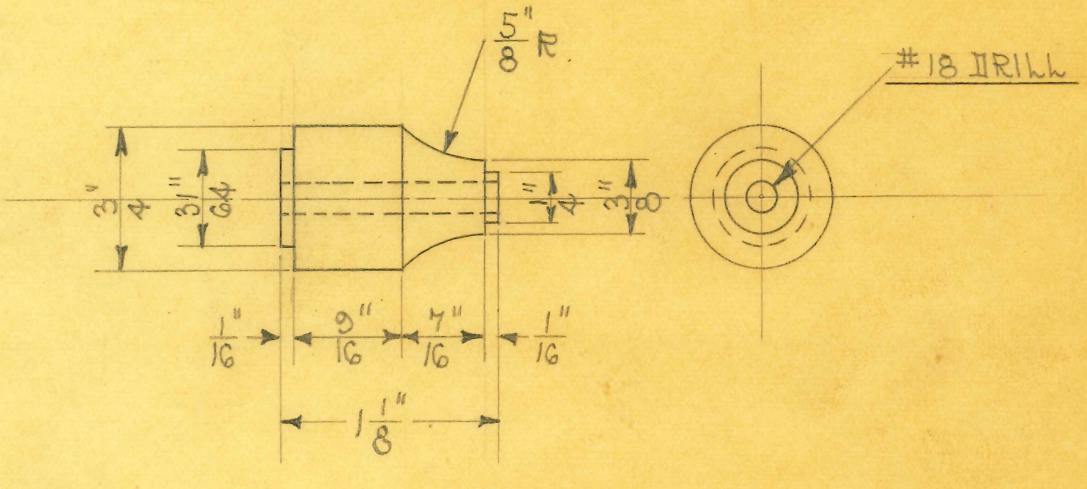

SCALE ~ FULL SIZE

OBSOLETE

SIZE	3/4"	ISSUE 2-2-32	A.E.	**TITLE:** WASHINGTON INTRA-CERVICAL IONIZING ELECT. HEAD INSULATOR
KIND	POL. RUB. ROD	CHANGED		
SHAPE		" "		
FINISH		" "		
TEMP.		" "		
PATT.		" "		

H. G. FISCHER & CO.
2335 WABANSIA AVE.
CHICAGO, ILL.

CAT. NO.

PART NO. 4311

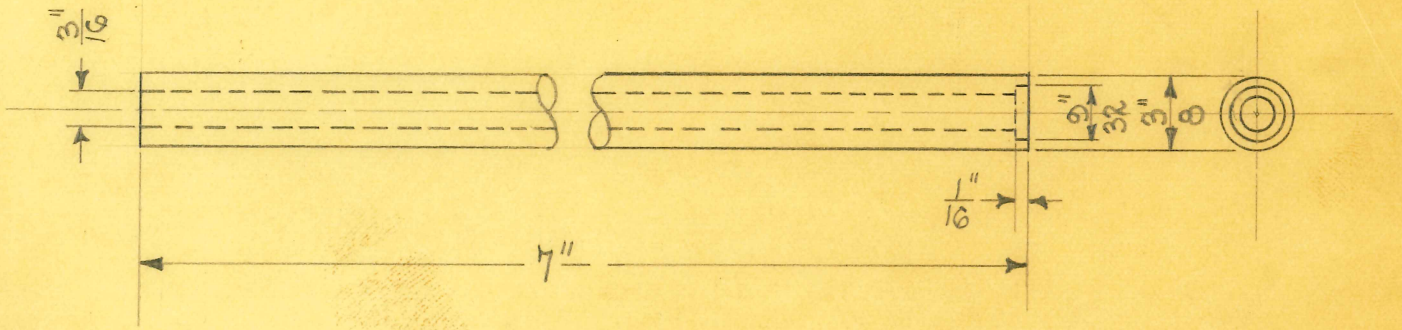

SCALE ~ FULL SIZE

OBSOLETE

SIZE	3/16" X 3/8"	ISSUE 2-3-32	A.E.
KIND	POL. RUB. TUBING	CHANGED	
SHAPE		" "	
FINISH		" "	
TEMP.		" "	
PATT.		" "	

TITLE: WASHINGTON INTRA-CERVICAL IONIZING ELECT.

H. G. FISCHER & CO.
2335 WABANSIA AVE.
CHICAGO, ILL.

CAT. NO.

PART NO. 4312

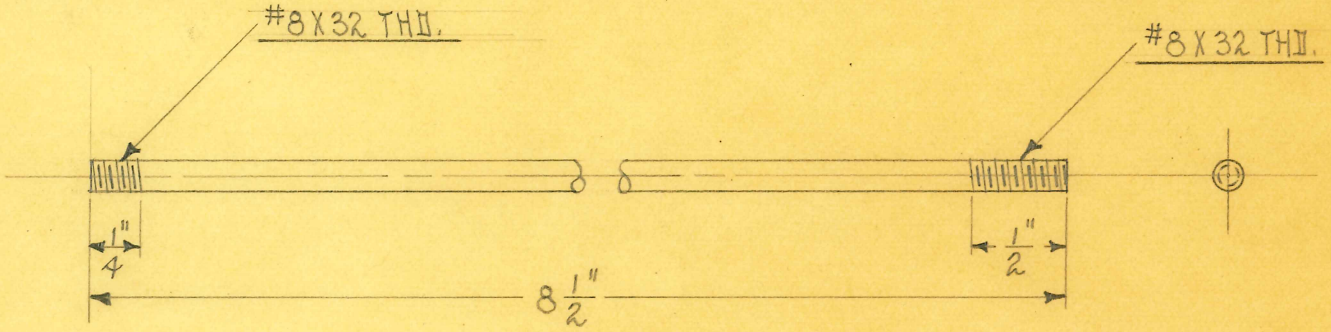

SCALE ~ FULL SIZE

OBSOLETE

SIZE	5/32"	ISSUE 2-2-32	A.E.	TITLE: WAIIIINGTON INTRA-CERVICAL IONIZING ELECT. ROII		
KIND	BRASS ROII	CHANGED				
SHAPE		" "				
FINISH		" "				
TEMP.		" "		H. G. FISCHER & CO. 2335 WABANSIA AVE. CHICAGO, ILL.	CAT. NO.	PART NO. 4313
PATT.		" "				

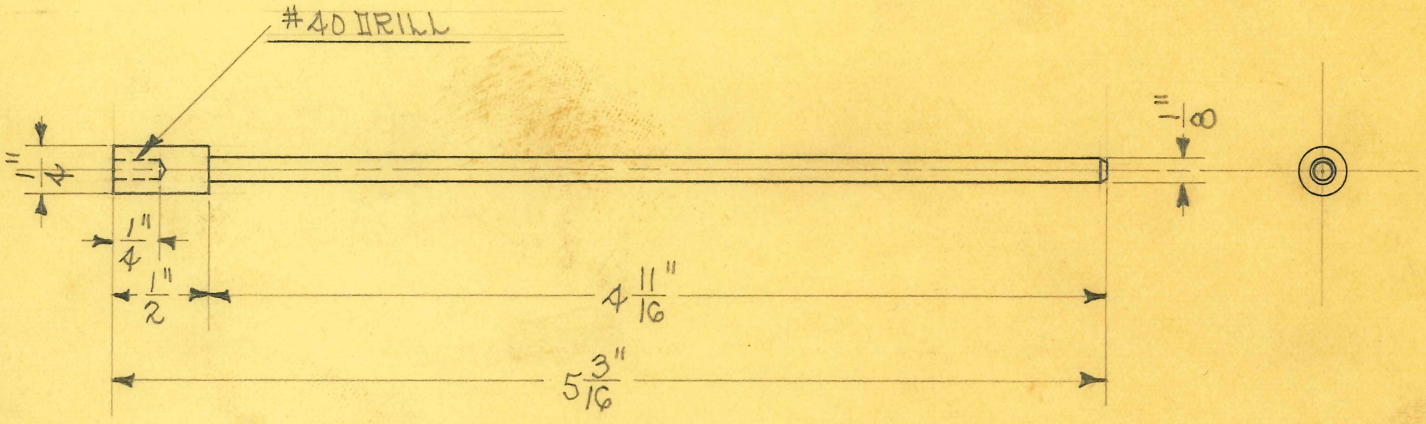

SCALE ~ FULL SIZE

OBSOLETE

SIZE		ISSUE 1-19-32	A.E.	TITLE: DR. KNOTTS TONSIL ELEC. NEEDLE HOLDER ROD
KIND	BRASS ROD	CHANGED		
SHAPE		" "		
FINISH		" "		
TEMP.		" "		H. G. FISCHER & CO. 2335 WABANSIA AVE. CHICAGO, ILL. — CAT. NO. — PART NO. 4502
PATT.		" "		

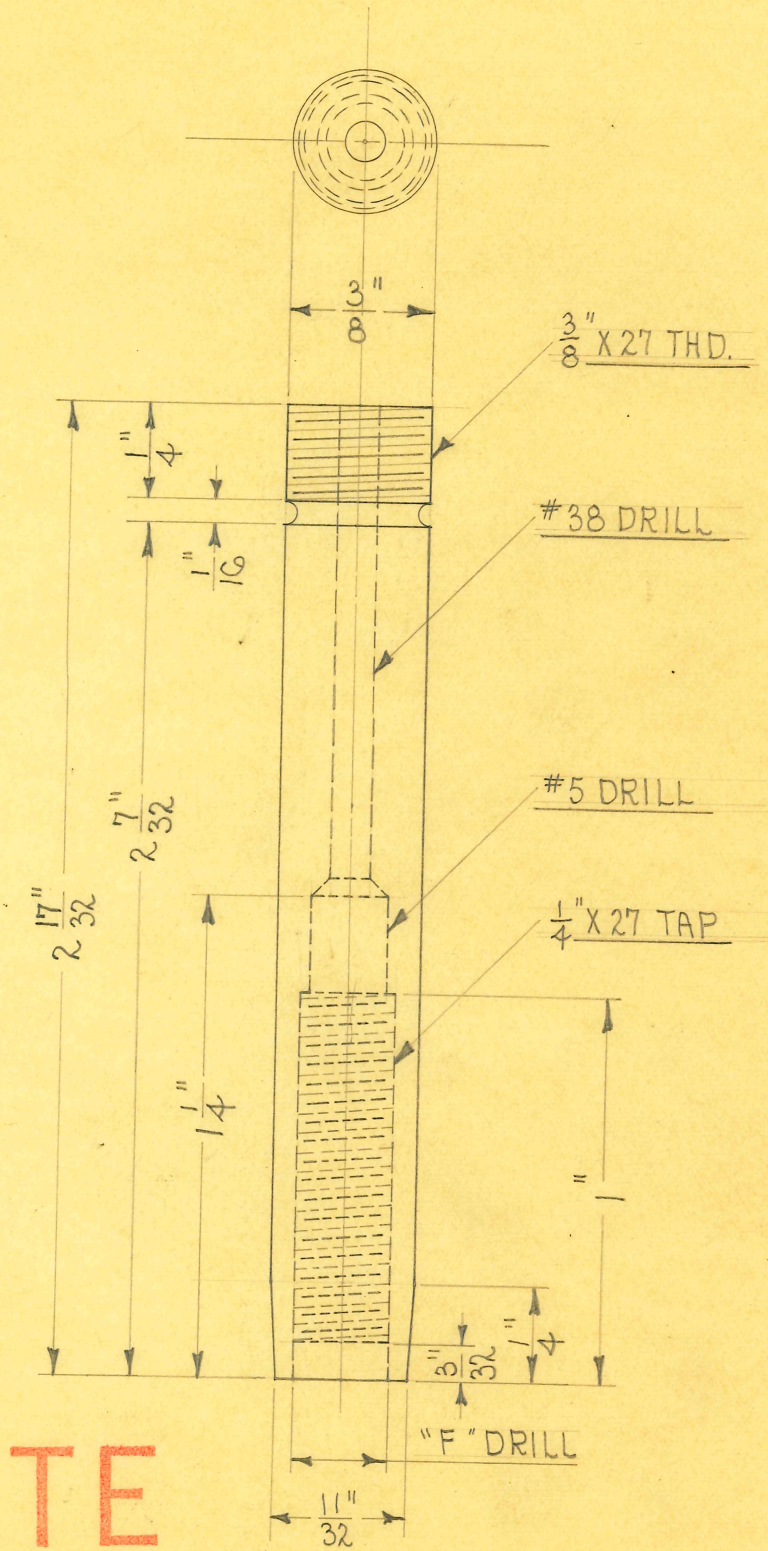

OBSOLETE

SIZE	3/8" XXX	ISSUE 2-4-35	~~A.E.~~
KIND	BAKELITE ROD	CHANGED	
SHAPE		"	
FINISH	BUFF	"	
TEMP.		"	
PATT.		"	

TITLE: TISSUE CUTTING KNIFE ELECTRODE HANDLE BODY

H. G. FISCHER & CO.
2335 WABANSIA AVE.
CHICAGO, ILL

CAT. NO.

PART NO. 4511

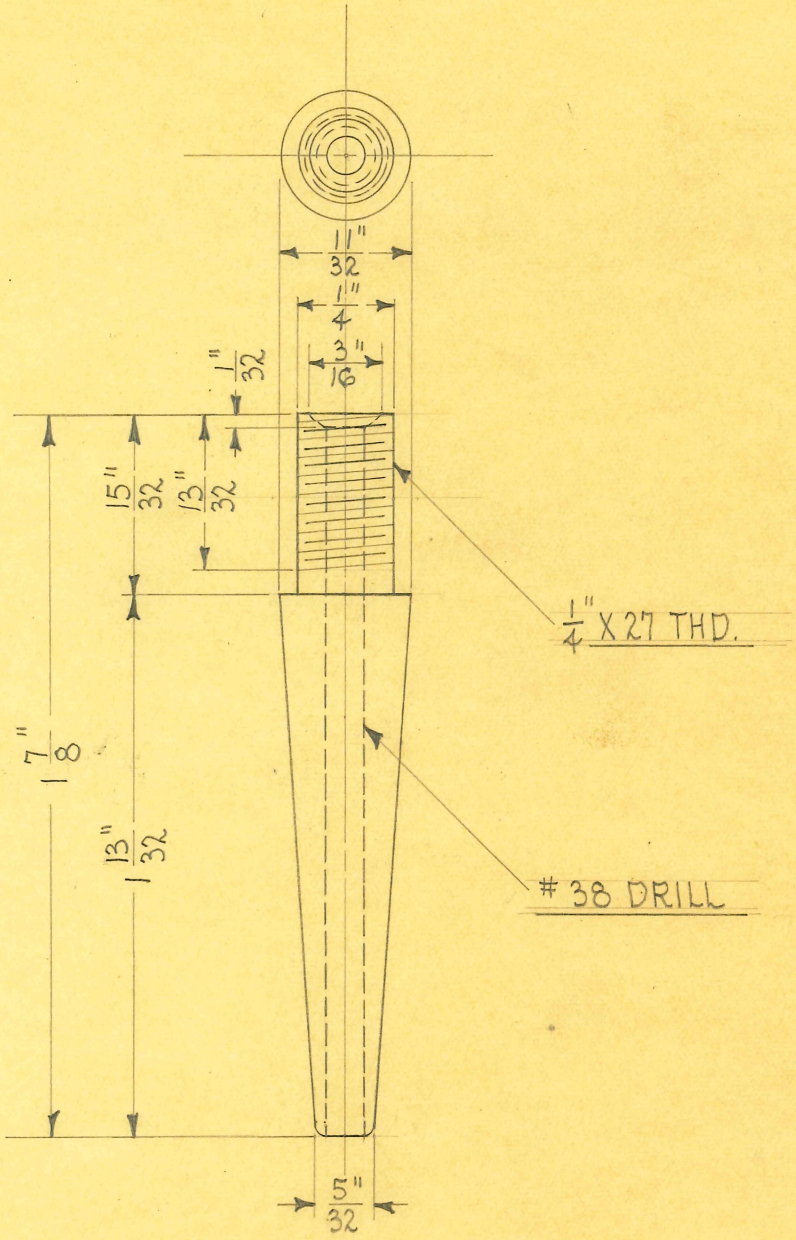

SCALE ≈ 2 DIAMETERS

OBSOLETE

SIZE	3/8" XXX	ISSUE 2-4-35	A.E.	**TITLE:** TISSUE CUTTING KNIFE ELECTRODE HANDLE TIP
KIND	BAKELITE ROD	CHANGED		
SHAPE		"		
FINISH	BUFF	"		
TEMP.		"		
PATT.		"		

H. G. FISCHER & CO.
2335 WABANSIA AVE.
CHICAGO, ILL

CAT. NO.

PART NO. 4511 1/4

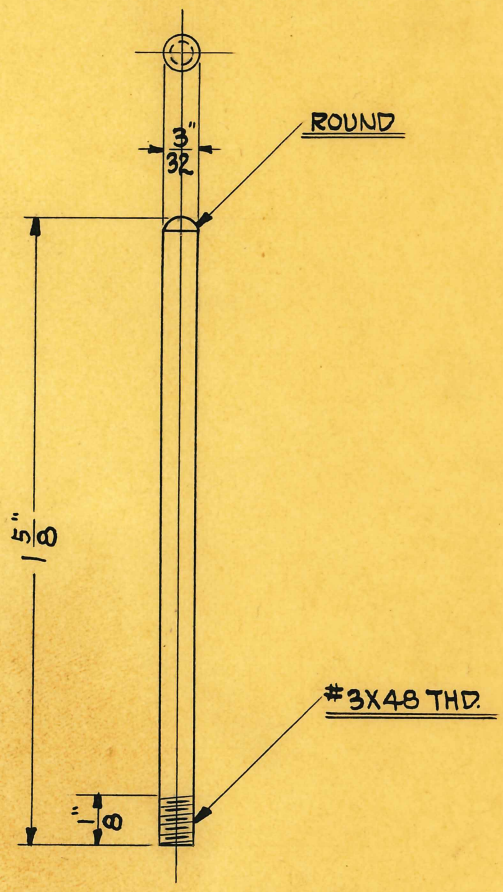

SCALE ~ 2 DIAMETERS

OBSOLETE

SIZE	3/32"	ISSUE H.E.	2-21-30	TITLE: TISSUE CUTTING KNIFE ELEC. CHUCK ROD
KIND	BRASS ROD	CHANGED		
SHAPE	ROUND	" "		
FINISH		" "		
TEMP.		" "		H. G. FISCHER & CO. 2335 WABANSIA AVE. CHICAGO, ILL. — CAT. NO. — PART NO. 4511 1/2
PATT.		" "		

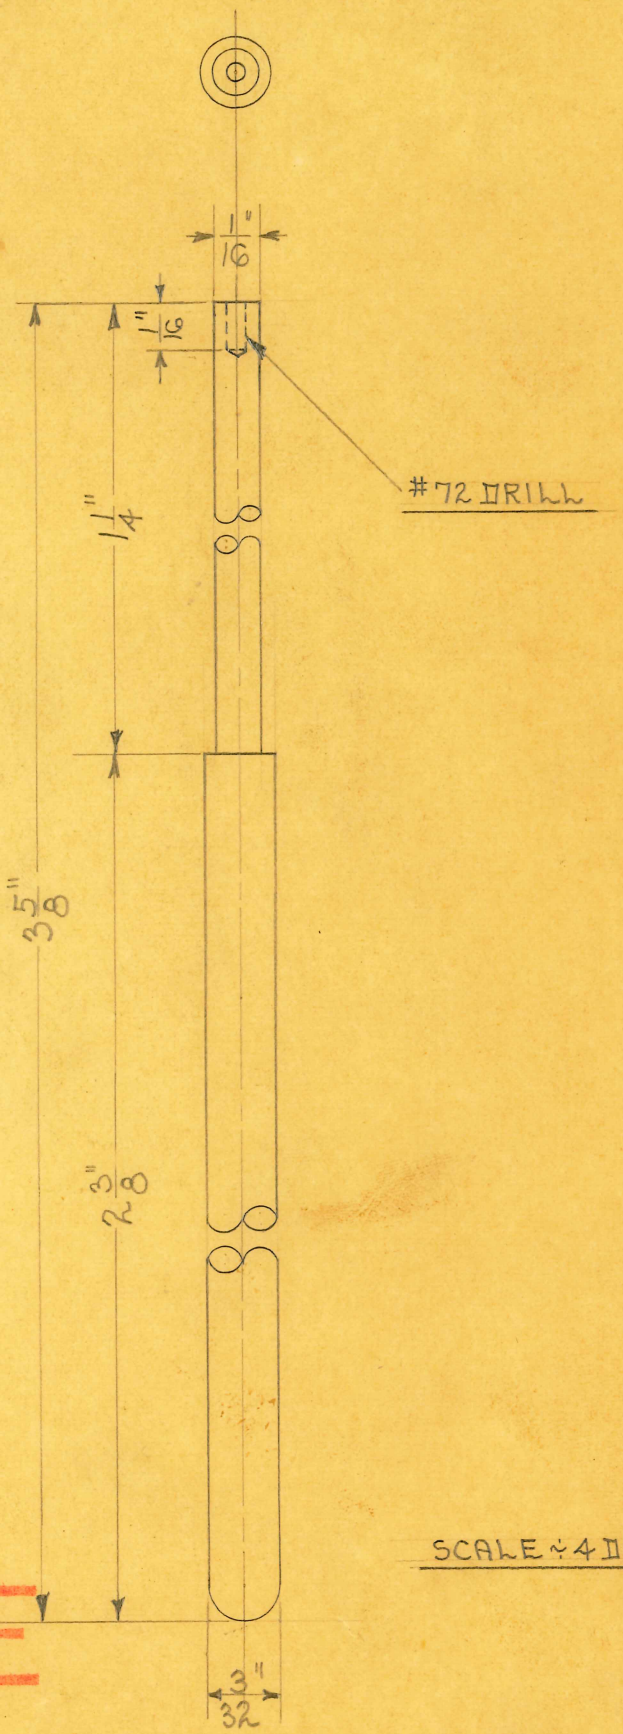

SCALE ÷ 4 DIAMETERS

OBSOLETE

SIZE	3/32"	ISSUE 6-25-31	A.E.	TITLE: LOOP SHAPE CERVICAL REAMER ROD
KIND	MONEL METAL	CHANGED		
SHAPE		" "		
FINISH		" "		
TEMP.		" "		H. G. FISCHER & CO. 2335 WABANSIA AVE. CHICAGO, ILL. — CAT. NO. — PART NO. 4523 1/4
PATT.		" "		

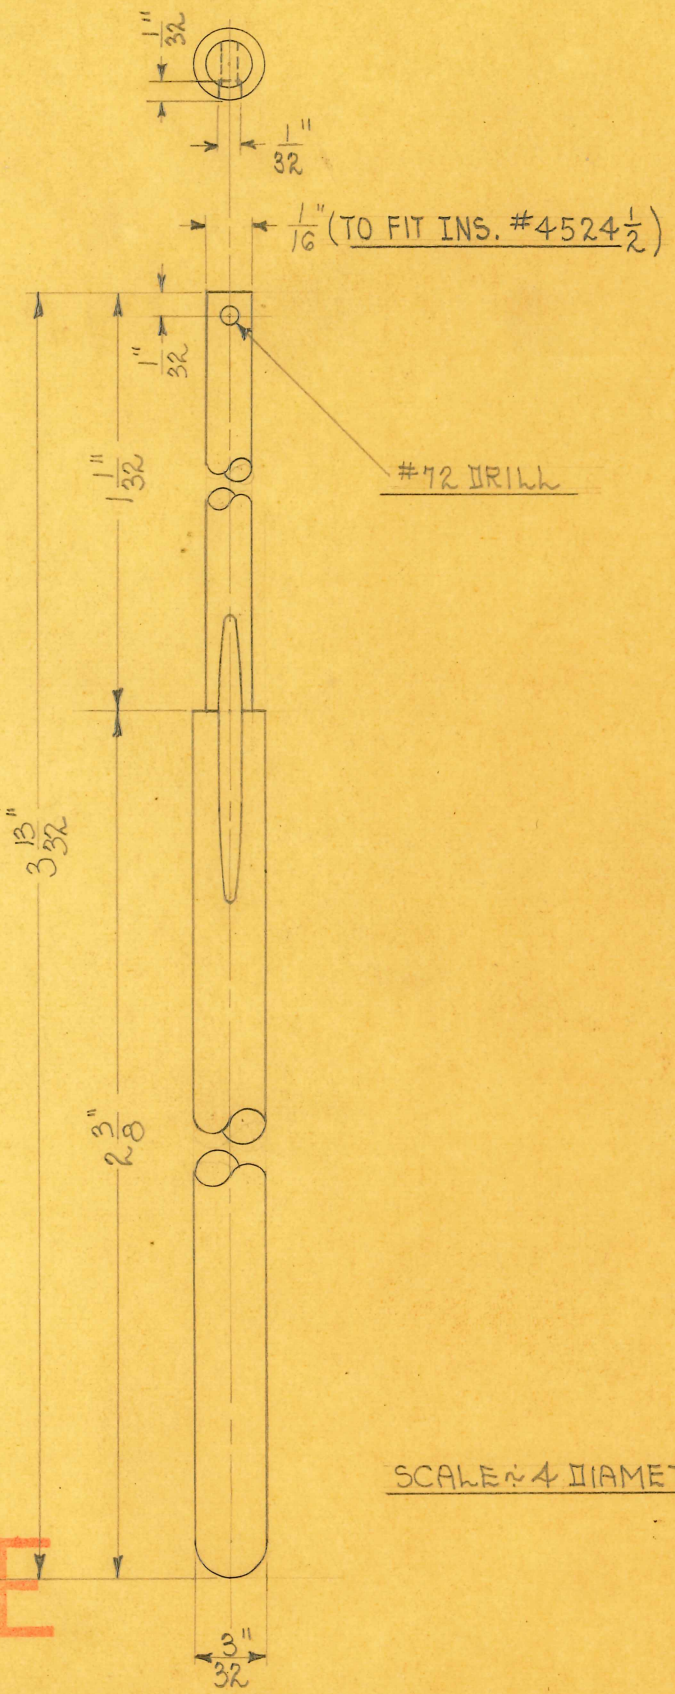

SCALE ~ 4 DIAMETERS

OBSOLETE

SIZE	3/32"	ISSUE 6-23-31	H.E.	**TITLE:** SHORT SIDE CUTTING CERVICAL REAMER ROD
KIND	MONEL METAL	CHANGED		
SHAPE	ROD	" "		
FINISH	BUFFED	" "		
TEMP.		" "		
PATT.		" "		

H. G. FISCHER & CO.
2335 WABANSIA AVE.
CHICAGO, ILL.

CAT. NO.

PART NO. 4524 1/4

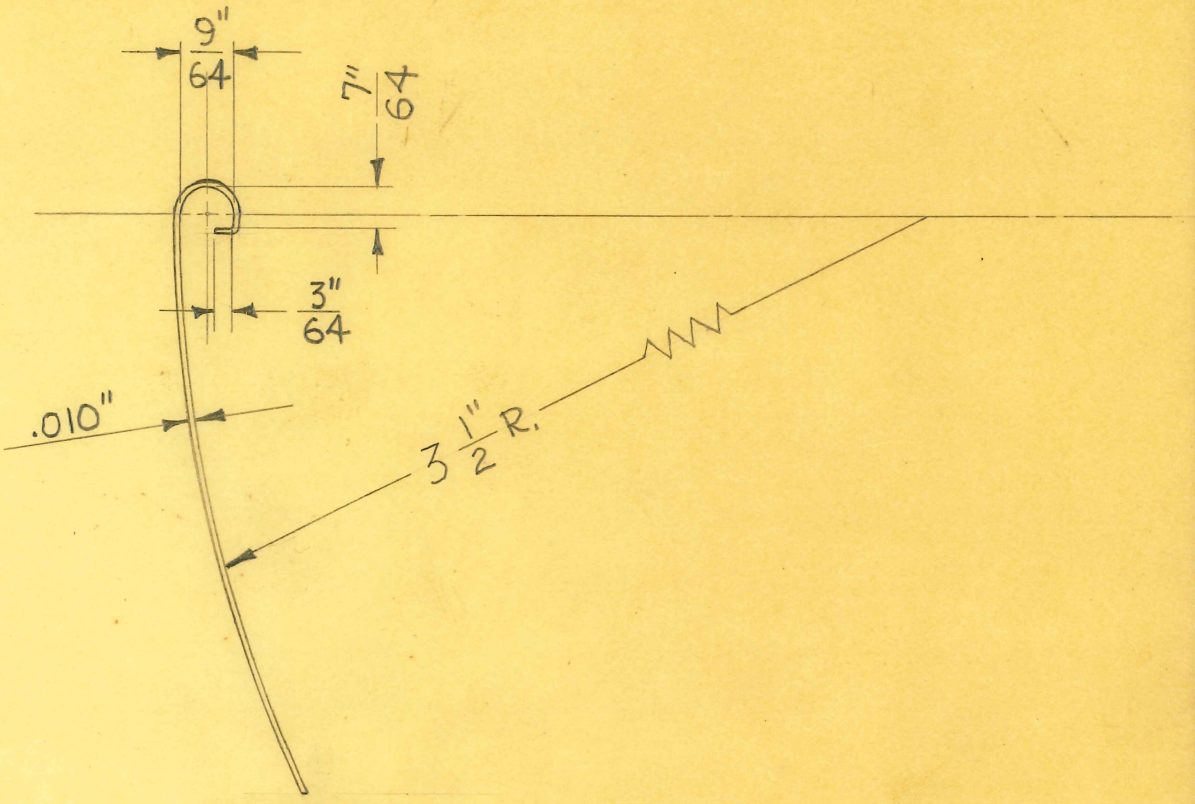

SCALE ~ DOUBLE SIZE

DEVELOPED LENGTH = 2"

1 REQUIRED

OBSOLETE

SIZE	.010" DIA.	ISSUE 6-13-41	J.V.W.
KIND	STAINLESS STEEL	CHANGED	
SHAPE	WIRE	"	
FINISH		"	
TEMP.		"	
PATT.		"	

TITLE: SHORT- SIDE CUTTING CERVICAL REAMER KNIFE.

H. G. FISCHER & CO.
2335 WABANSIA AVE.
CHICAGO, ILL.

CAT. NO.

PART NO. 4524 3/4

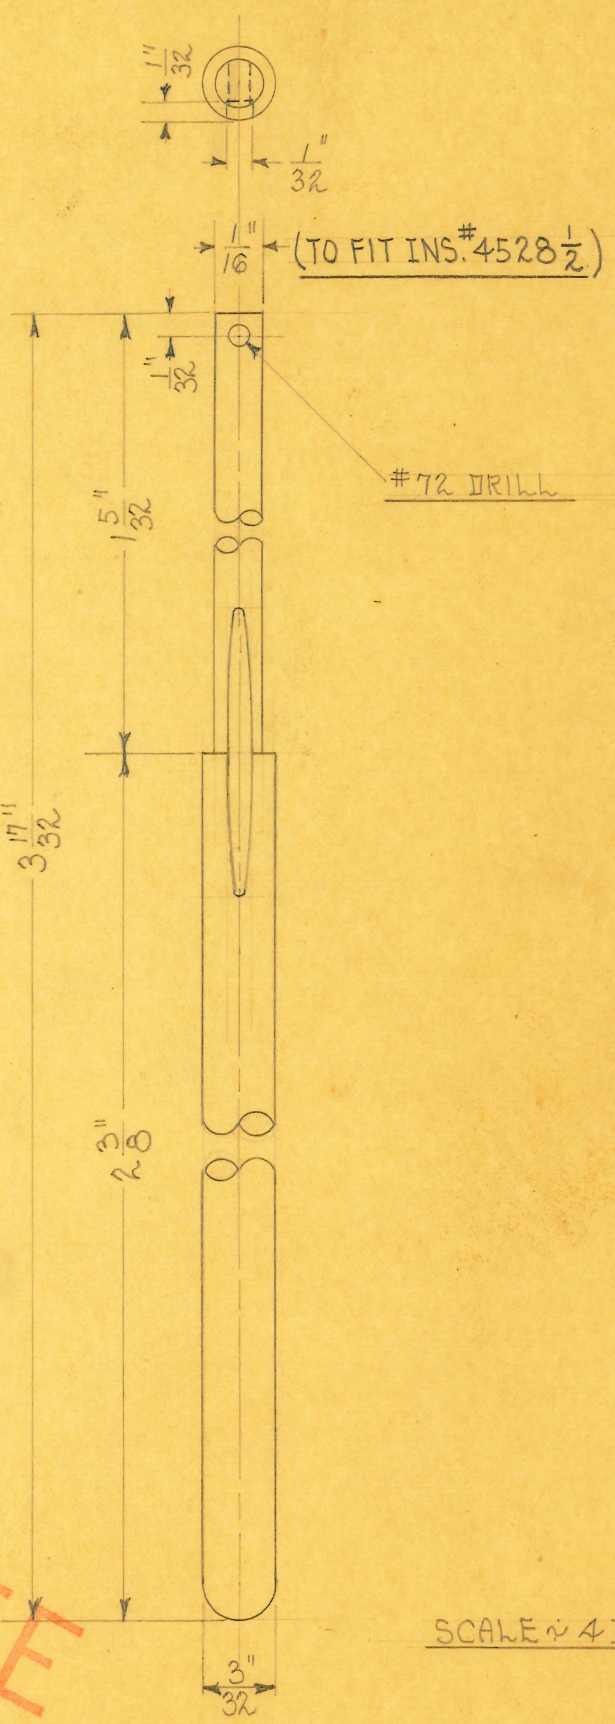

SCALE ~ 4 DIAMETERS

OBSOLETE

SIZE	3/32"	ISSUE 6-24-31	A.E.	**TITLE:** LONG SIDE CUTTING CERVICAL REAMER ROD
KIND	MONEL METAL	CHANGED		
SHAPE	ROD	" "		
FINISH		" "		
TEMP.		" "		H. G. FISCHER & CO. 2335 WABANSIA AVE. CHICAGO, ILL. — CAT. NO. — PART NO. 4528 1/4
PATT.		" "		

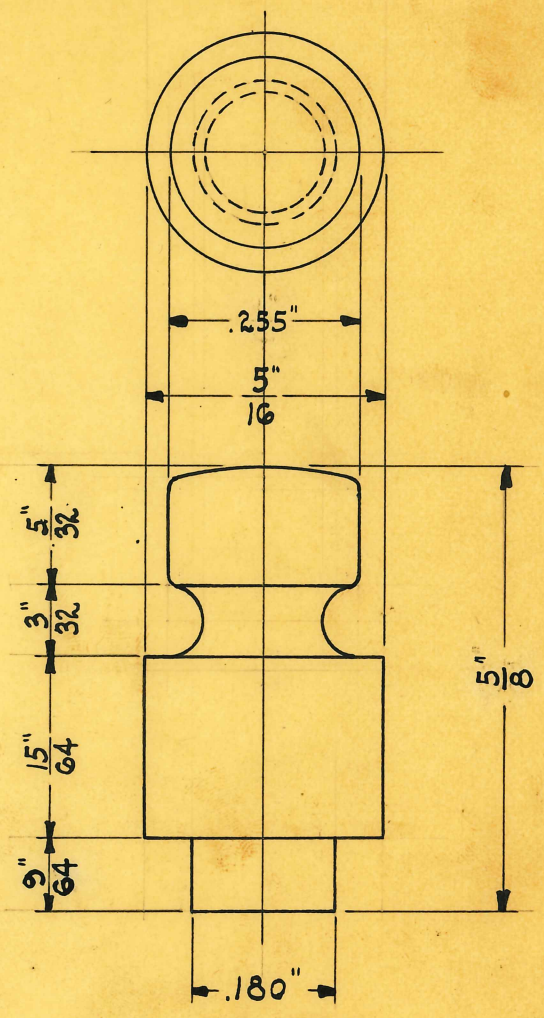

SCALE ÷ 4 DIAMETERS

OBSOLETE

SIZE	5/16"	ISSUE 8-19-30	A.E.	TITLE: DIA. SECTIONAL BELT ELECT. LINK STUD
KIND	BRASS ROD	CHANGED		
SHAPE	ROUND	" "		
FINISH	N.P.	" "		
TEMP.		" "		H. G. FISCHER & CO. 2335 WABANSIA AVE. CHICAGO, ILL. — CAT. NO. — PART NO. 4531
PATT.		" "		

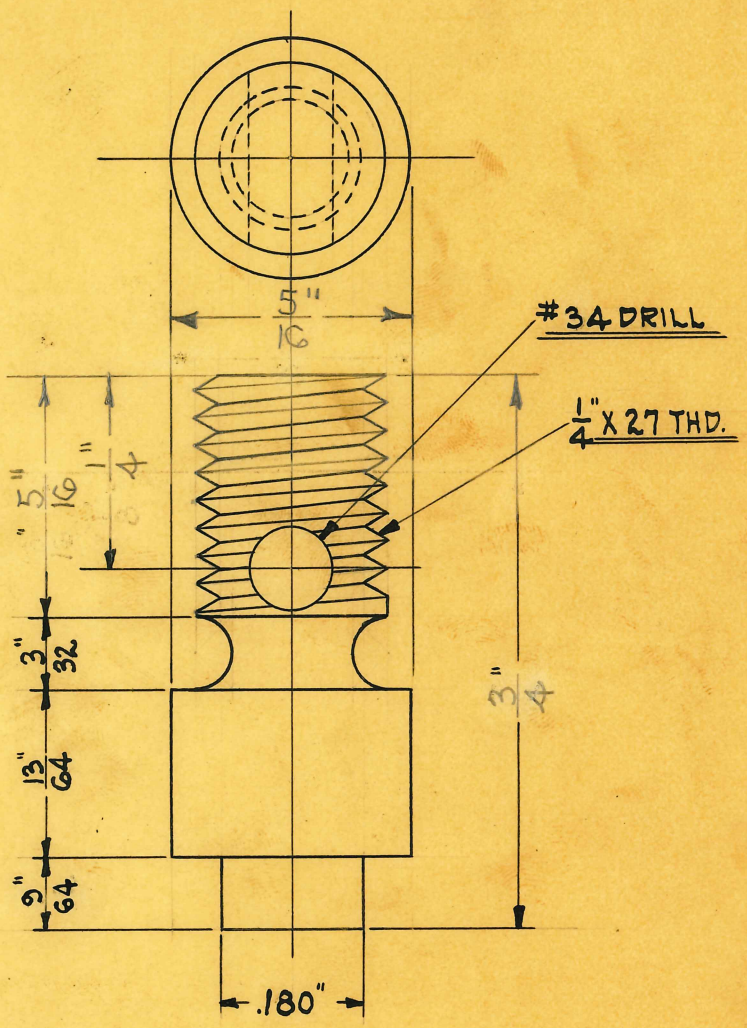

SCALE ÷ 4 DIAMETERS

DRILL JIG # 3794

OBSOLETE

SIZE	5/16"	ISSUE 8-19-30	H.E.
KIND	BRASS ROD	CHANGED	
SHAPE	ROUND	" "	
FINISH	N.P.	" "	
TEMP.		" "	
PATT.		" "	

TITLE: DIA. SECTIONAL BELT ELEC. LINK BIND. POST

H. G. FISCHER & CO.
2335 WABANSIA AVE.
CHICAGO, ILL.

CAT. NO.

PART NO. 4532

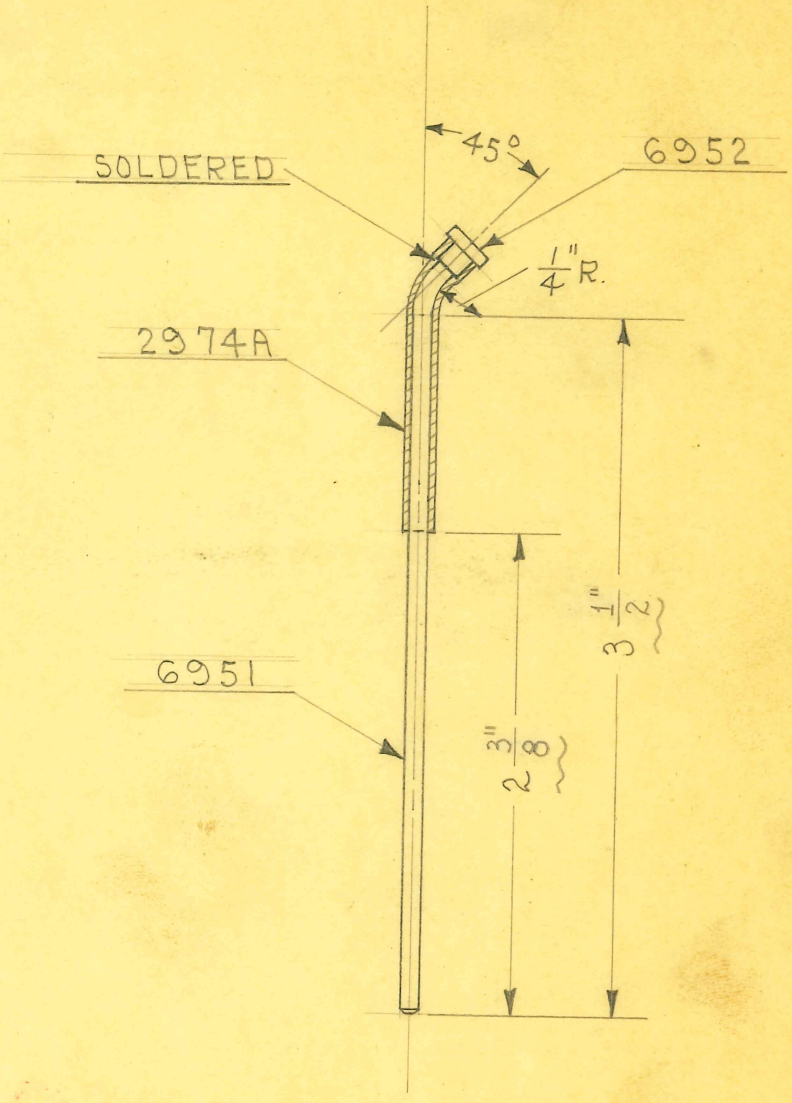

OBSOLETE

SIZE		ISSUE 5-27-36	A.E.	TITLE: THOREK COAGULATING ELECTRODE - 1/4"
KIND		CHANGED		
SHAPE		"		
FINISH	NICKEL #12	"		
TEMP.	SQ. END ONLY	"		
PATT.		"		

H. G. FISCHER & CO.
2335 WABANSIA AVE.
CHICAGO, ILL.

CAT. NO. 2086

PART NO. 6952G

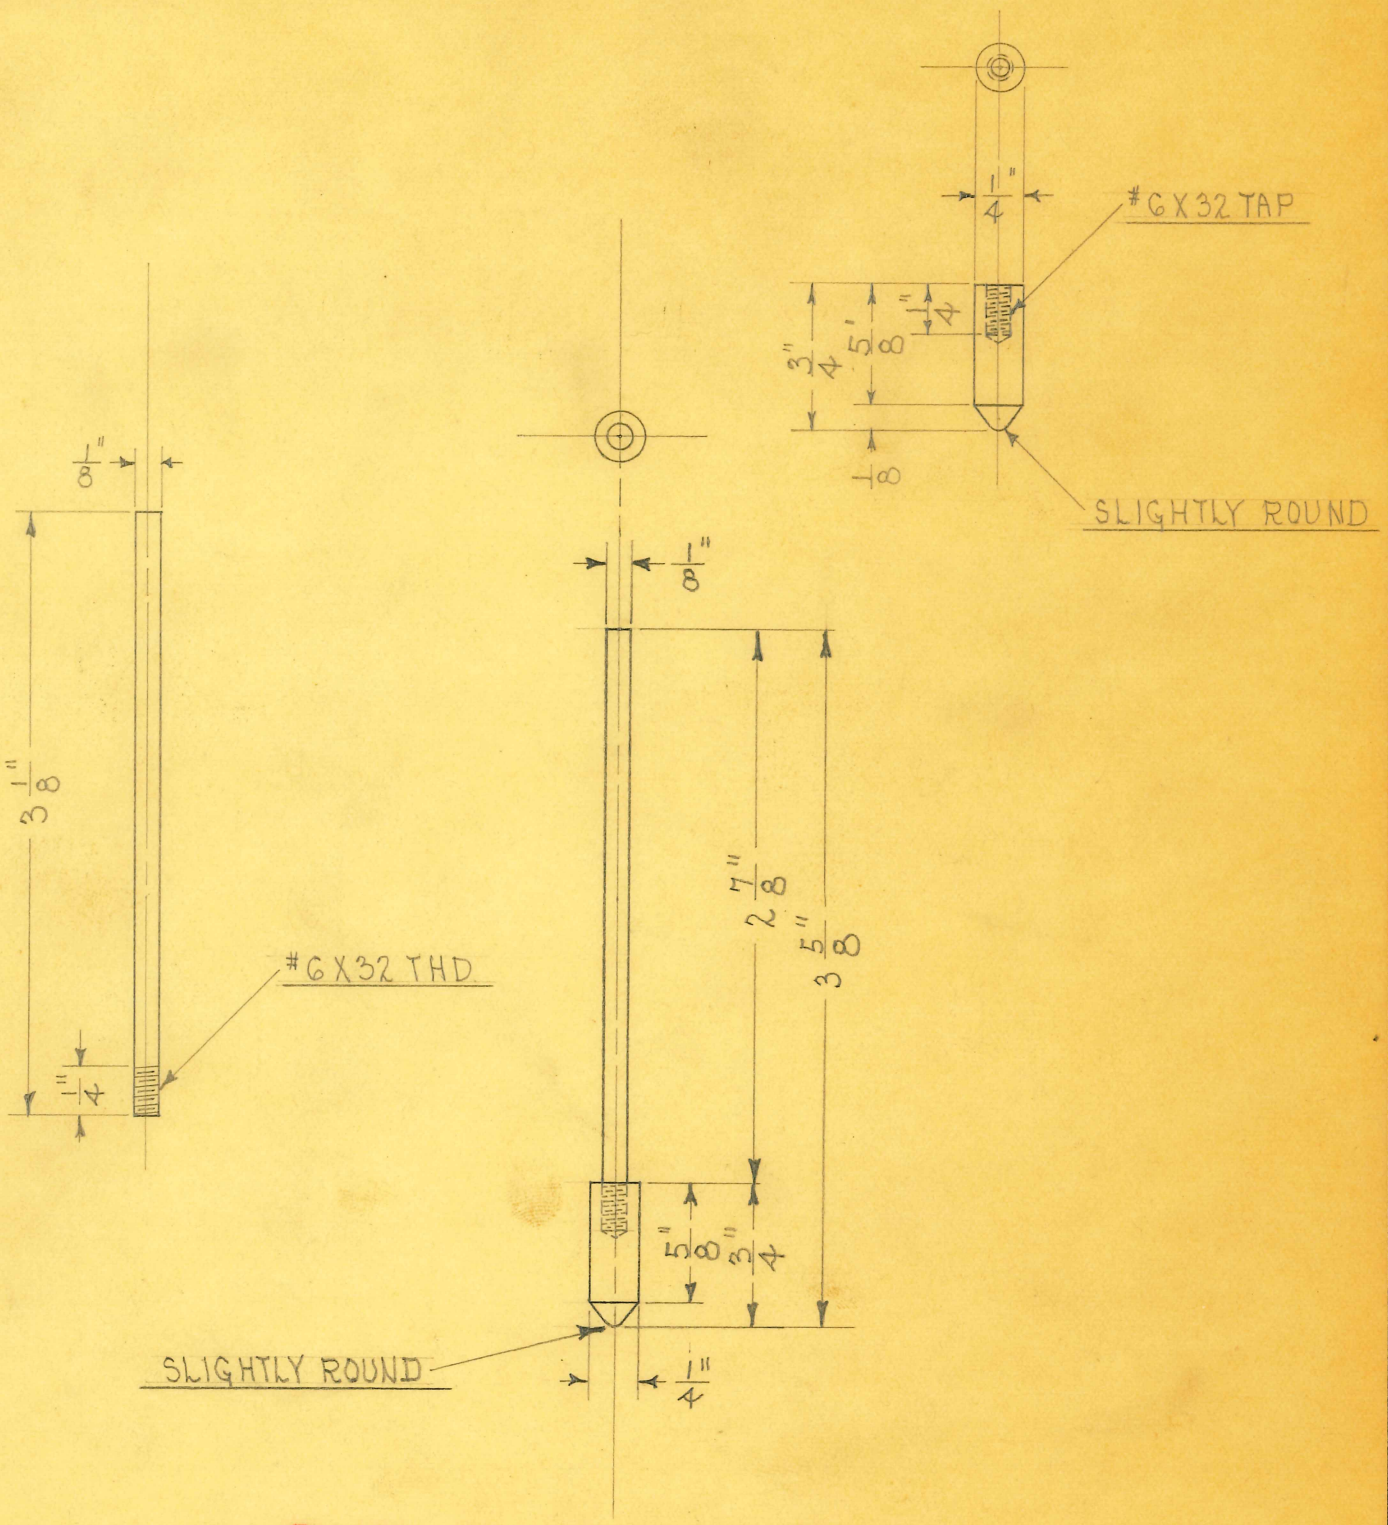

OBSOLETE

SIZE		ISSUE 2-2-33	A.E.	**TITLE:** SINSKEY ELECT. HANDLE BODY PLUNGER
KIND	BRASS ROD	CHANGED		
SHAPE		" "		
FINISH		" "		
TEMP.		" "		H. G. FISCHER & CO. 2335 WABANSIA AVE. CHICAGO, ILL. / CAT. NO. / PART NO. 6972
PATT.		" "		

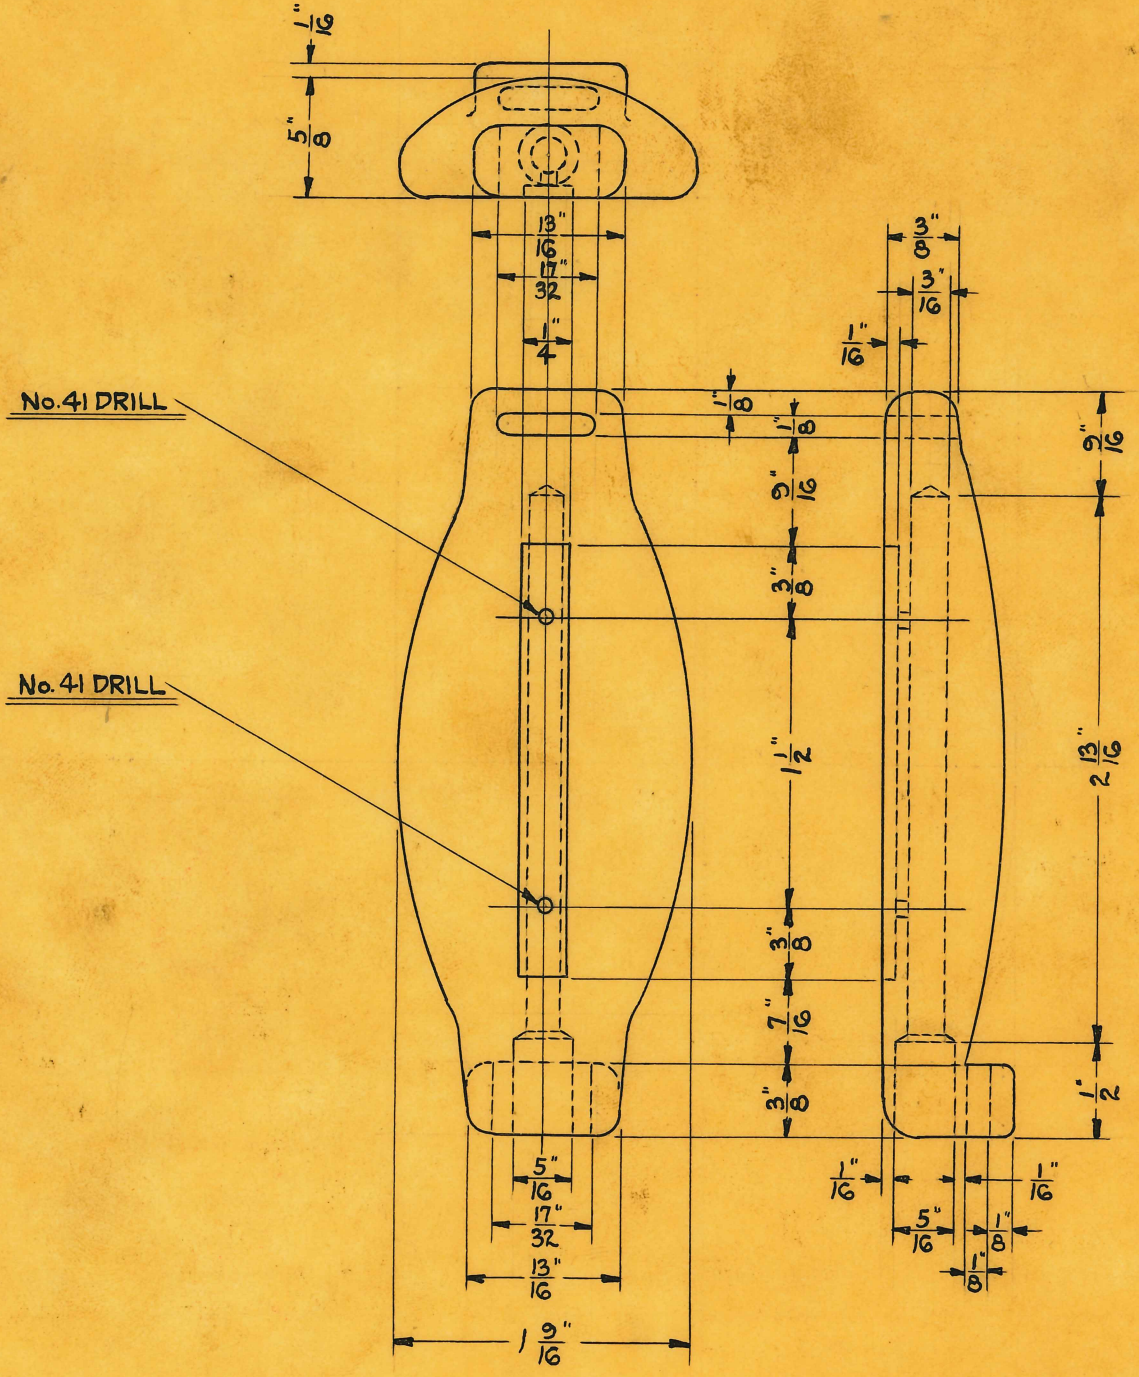

OBSOLETE

SIZE		ISSUE	11-19-29
KIND	SOFT RUBBER	CHANGED	
SHAPE		" "	
FINISH		" "	
TEMP.		" "	
PATT.		" "	

TITLE: FISCHER INDIRECT FULGURATION ELECTRODE RUBBER HANDLE

H. G. FISCHER & CO.
2335 WABANSIA AVE.
CHICAGO, ILL.

CAT. NO.

PART NO. 690

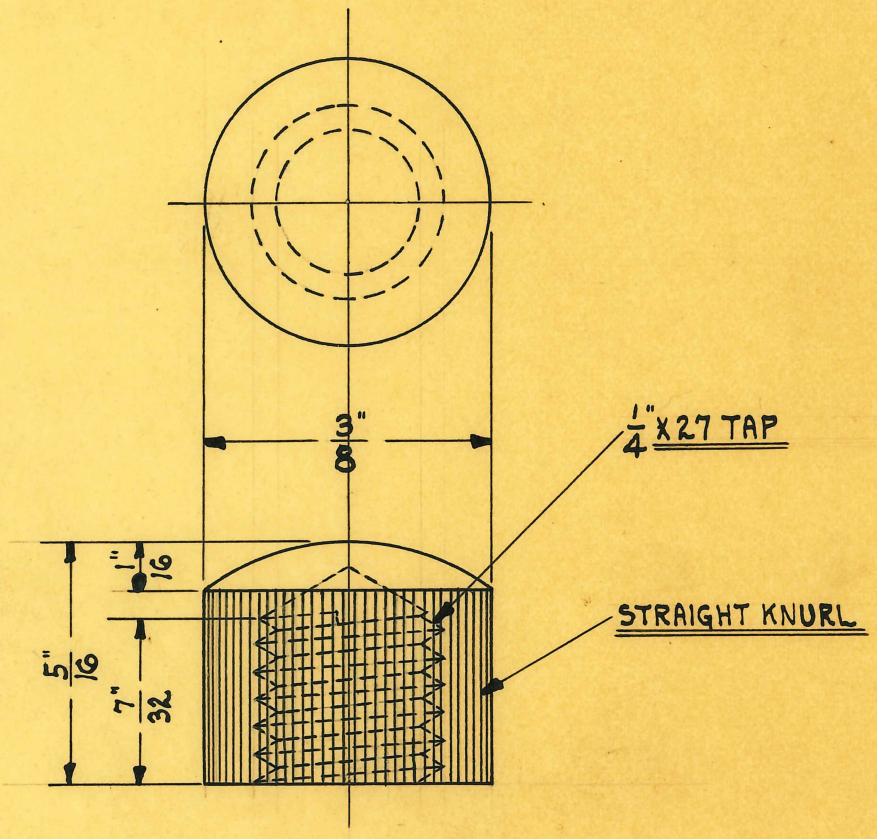

SCALE ÷ 4 DIAMETERS

OBSOLETE

SIZE	3/8"	ISSUE 8-10-30	H.E.
KIND	BRASS ROD	CHANGED	
SHAPE	ROUND	" "	
FINISH	N.P.	" "	
TEMP.		" "	
PATT.		" "	

TITLE: DIA. SECTIONAL BELT ELEC. LINK BIND. POST CAP

H. G. FISCHER & CO.
2335 WABANSIA AVE.
CHICAGO, ILL.

CAT. NO.

PART NO. 4533

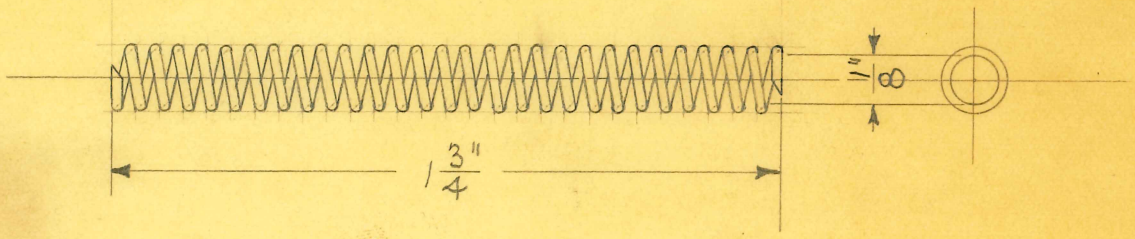

SCALE ≈ 1" = ½"

OBSOLETE

SIZE	.022"	ISSUE 2-7-33	H.E.	**TITLE:** SINSKEY ELECT. HANDLE BODY PLUNGER SPRING
KIND	BRASS WIRE	CHANGED		
SHAPE		" "		
FINISH		" "		
TEMP.		" "		H. G. FISCHER & CO. 2335 WABANSIA AVE. CHICAGO, ILL. / CAT. NO. / PART NO. 6973
PATT.		" "		

SCALE 1"= 1/2"

OBSOLETE

SIZE	5/8"	ISSUE 2-3-33		TITLE: SINSKEY ELECT. HANDLE 30° END
KIND	POL. RUB. ROD	CHANGED		
SHAPE		" "		
FINISH		" "		
TEMP.		" "		H. G. FISCHER & CO. 2333 WABANSIA AVE. CHICAGO, ILL.
PATT.		" "		CAT. NO. / PART NO. C374

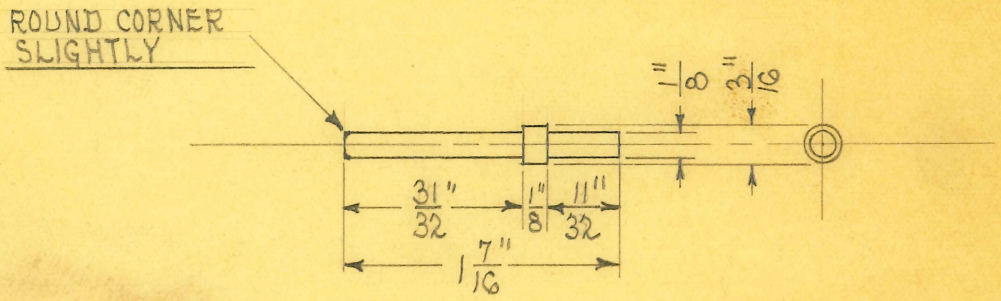

2 REQUIRED

OBSOLETE

SIZE		ISSUE 2-2-33	A.E.	**TITLE:** SINSKEY ELECT. HANDLE 90° & 45° END PLUNGER
KIND	BRASS ROD	CHANGED		
SHAPE		" "		
FINISH		" "		
TEMP.		" "		H. G. FISCHER & CO. 2335 WABANSIA AVE. CHICAGO, ILL. — CAT. NO. — PART NO. 6975
PATT.		" "		

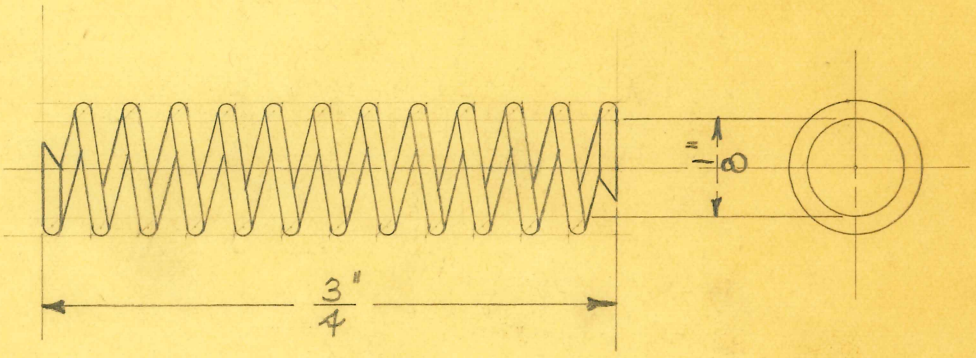

SCALE ~ 4 X SIZE

OBSOLETE

SIZE	.022"	ISSUE 2-6-33	H.E.	TITLE: SINSKEY ELECT. HANDLE 90° END PLUNGER SPG.
KIND	BRASS WIRE	CHANGED		
SHAPE		" "		
FINISH		" "		
TEMP.		" "		H. G. FISCHER & CO. 2335 WABANSIA AVE. CHICAGO, ILL. — CAT. NO. — PART NO. C976
PATT.		" "		

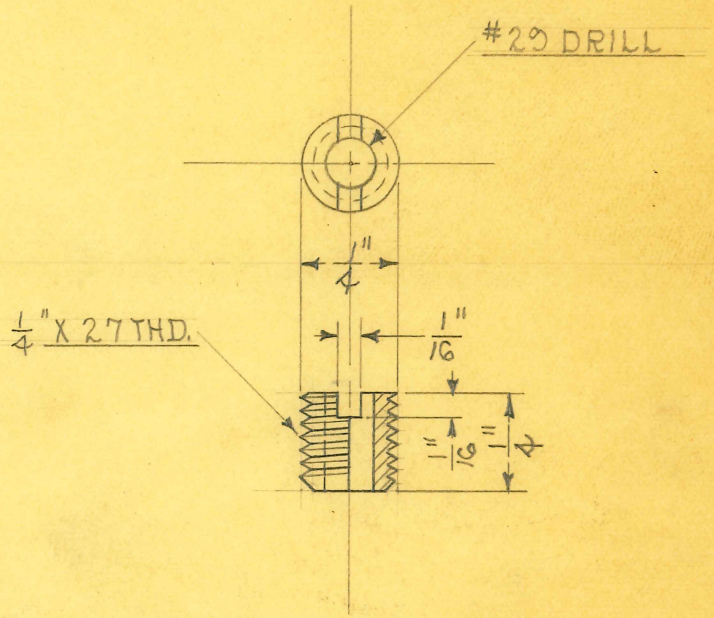

SCALE ~ DOUBLE SIZE

2 REQUIRED

OBSOLETE

SIZE	1/4"	ISSUE 2-3-33	A.E.	**TITLE:** SINSKEY ELECT. HANDLE 90° END PLUNGER SET SCR.
KIND	BRASS ROD	CHANGED		
SHAPE		" "		
FINISH		" "		
TEMP.		" "		
PATT.		" "		

H. G. FISCHER & CO.
2335 WABANSIA AVE.
CHICAGO, ILL.

CAT. NO.

PART NO. 6977

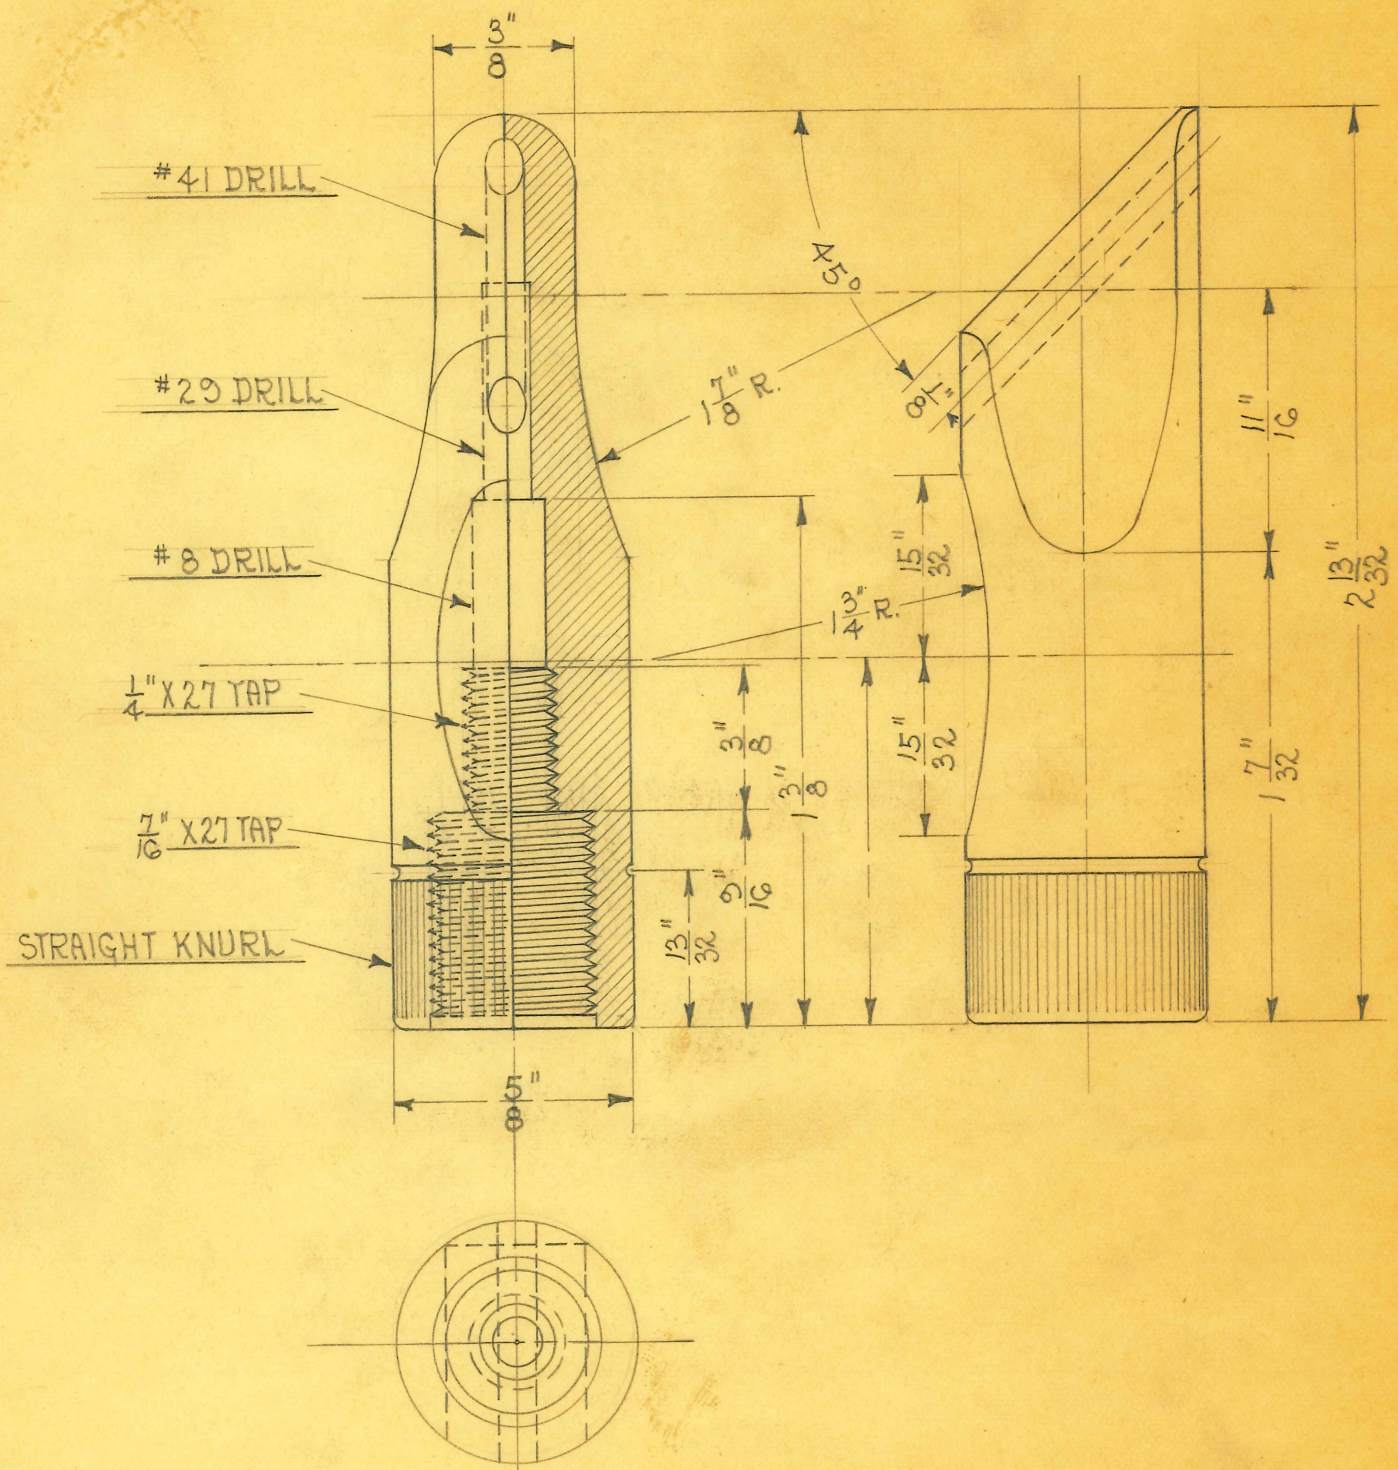

SCALE: 1" = 1/2"

OBSOLETE

SIZE	5/8"	ISSUE 2-7-33	A.E.
KIND	POL. RUB. ROD	CHANGED	
SHAPE		" "	
FINISH		" "	
TEMP.		" "	
PATT.		" "	

TITLE: SINSKEY ELECT. HANDLE 45° END

H. G. FISCHER & CO.
2335 WABANSIA AVE.
CHICAGO, ILL.

CAT. NO.

PART NO. C978

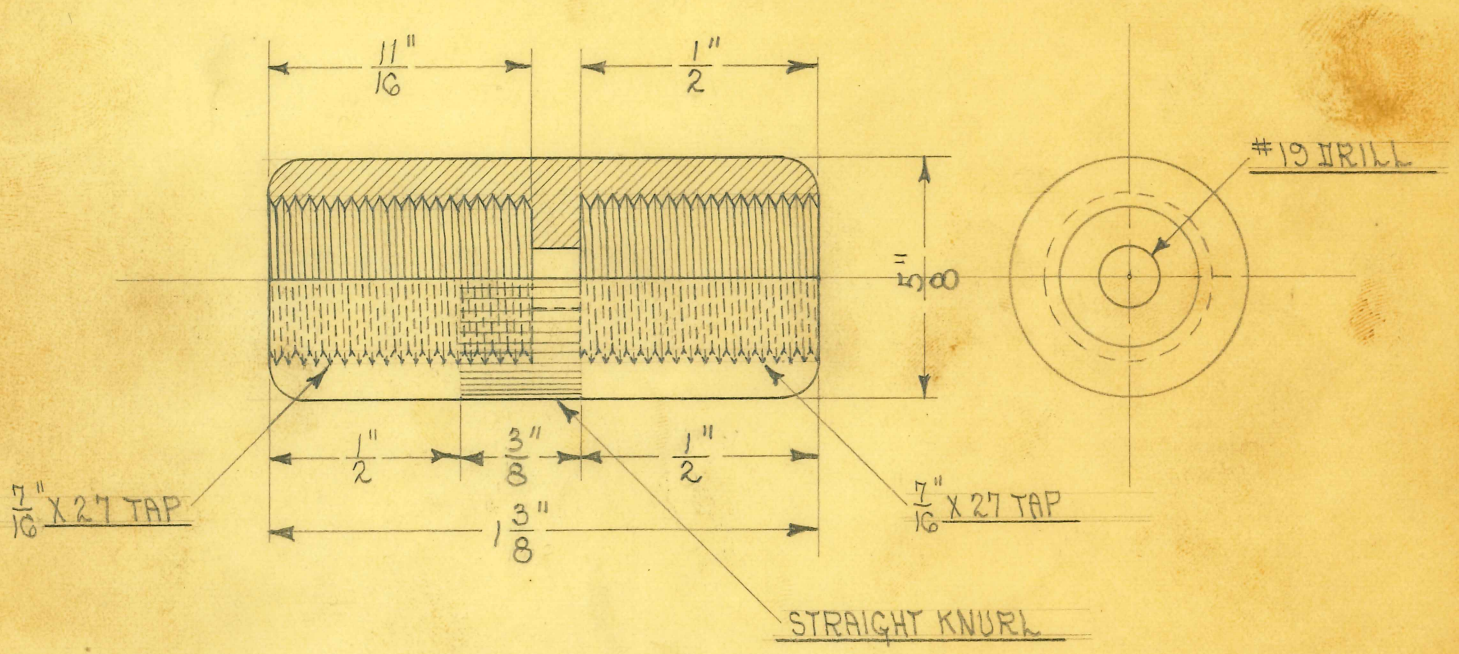

SCALE ≈ 1" = 1/2"

OBSOLETE

SIZE	5/8"	ISSUE 10-26-32	W.E.	**TITLE:** SINSKEY ELECT. HANDLE CORD CONN. SLEEVE
KIND	POL. RUB. ROD	CHANGED		
SHAPE		" "		
FINISH		" "		
TEMP.		" "		H. G. FISCHER & CO. 2335 WABANSIA AVE. CHICAGO, ILL. — CAT. NO. — PART NO. 6979
PATT.		" "		

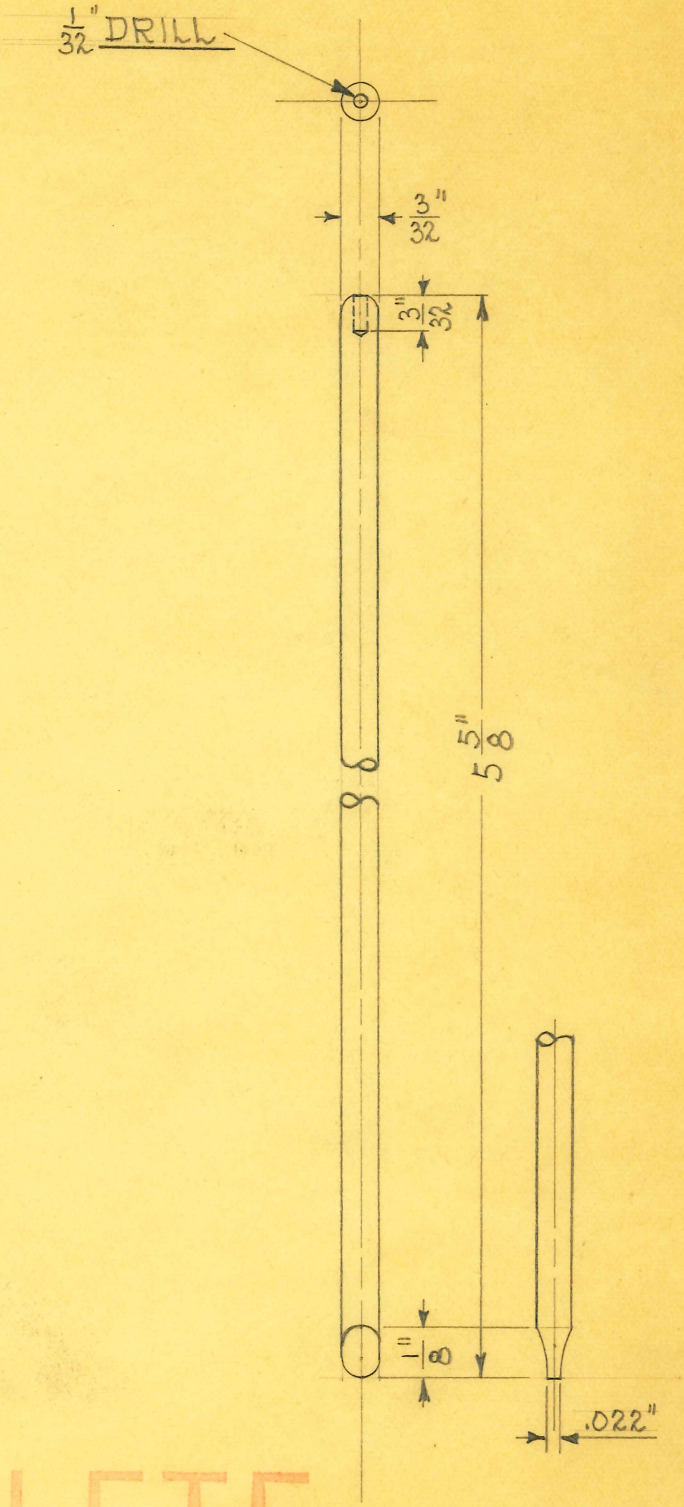

OBSOLETE

SCALE ~ 1" = 1/2"

SIZE	3/32"	ISSUE 2-8-33	H.E.	**TITLE:** SINSKEY NEEDLE POINT ELECTRODE ROD
KIND	STAINLESS STEEL	CHANGED		
SHAPE		" "		
FINISH		" "		
TEMP.		" "		H. G. FISCHER & CO. 2335 WABANSIA AVE. CHICAGO, ILL. — CAT. NO. — PART NO. C981
PATT.		" "		

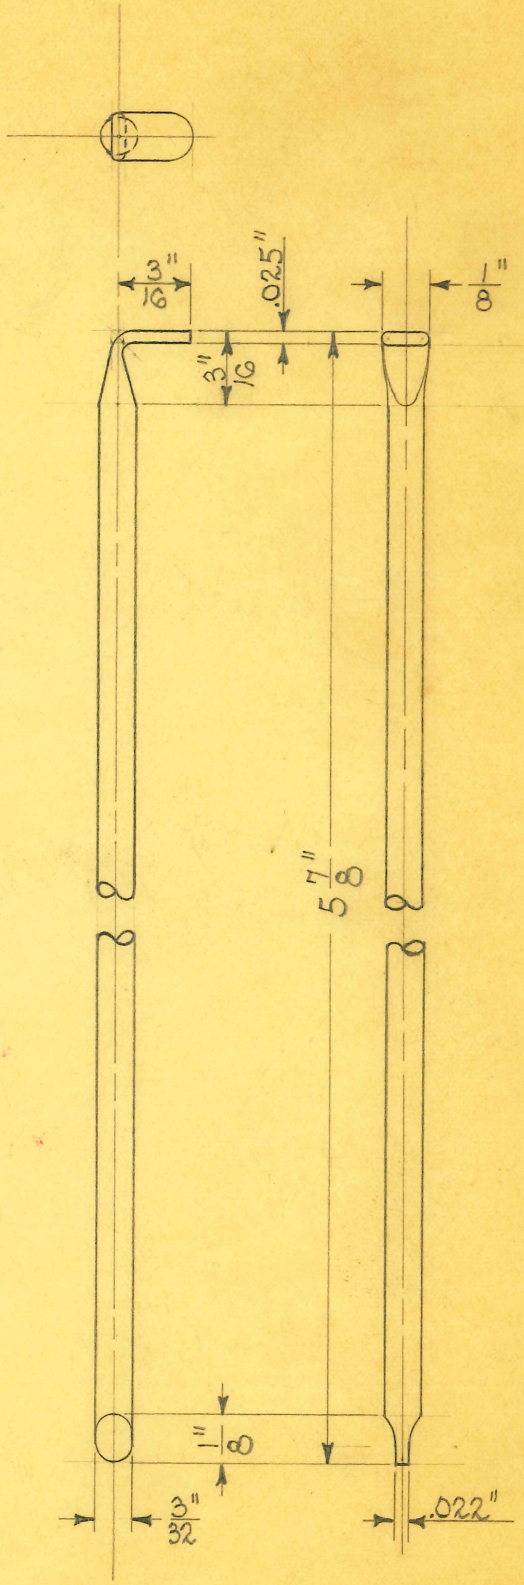

SCALE ≈ 1" = 1/2"

DEVELOPED LENGTH - 6 1/16"

OBSOLETE

SIZE	3/32"	ISSUE 2-10-33	A.E.	**TITLE:** SINSKEY RIGHT ANGLE FLAT TIP ELECTRODE
KIND	MONEL METAL	CHANGED		
SHAPE		" "		
FINISH		" "		
TEMP.		" "		H. G. FISCHER & CO. 2335 WABANSIA AVE. CHICAGO, ILL. — CAT. NO. — PART NO. 6983
PATT.		" "		

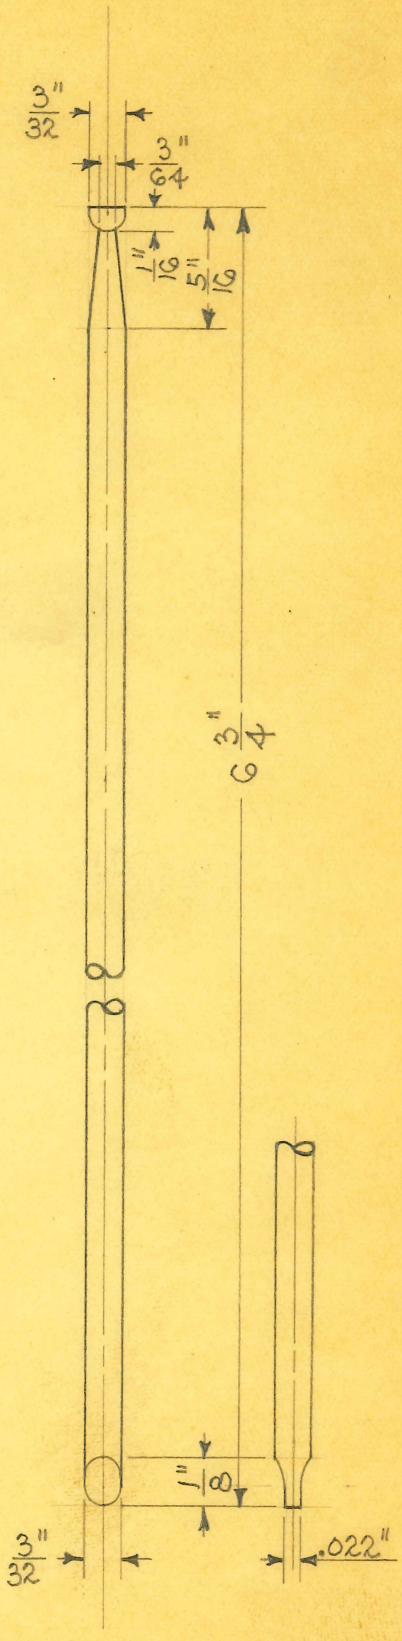

OBSOLETE

SCALE ~ 1" = 1/2"

SIZE	3/32"	ISSUE 2-9-33	A.E.	**TITLE:** SINSKEY BALL SHAPE ELECT. WITH FLAT TOP
KIND	MONEL METAL	CHANGED		
SHAPE		" "		
FINISH		" "		
TEMP.		" "		
PATT.		" "		

H. G. FISCHER & CO.
2335 WABANSIA AVE.
CHICAGO, ILL.

CAT. NO.

PART NO. 6984

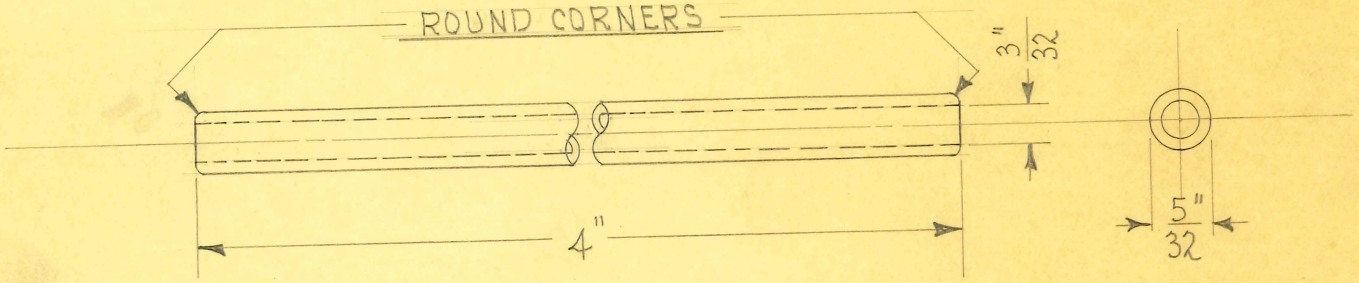

SCALE ~ 2 DIAMETERS

OBSOLETE

SIZE	3/32" I.D. X 5/32" O.D.	ISSUE 11-6-35	A.E.
KIND	BAKELITE	CHANGED	
SHAPE	TUBING	"	
FINISH		"	
TEMP.		"	
PATT.		"	

TITLE: SINSKEY ELECTRODE INSULATOR (MEDIUM)

H. G. FISCHER & CO.
2335 WABANSIA AVE.
CHICAGO, ILL.

CAT. NO.

PART NO. 6985

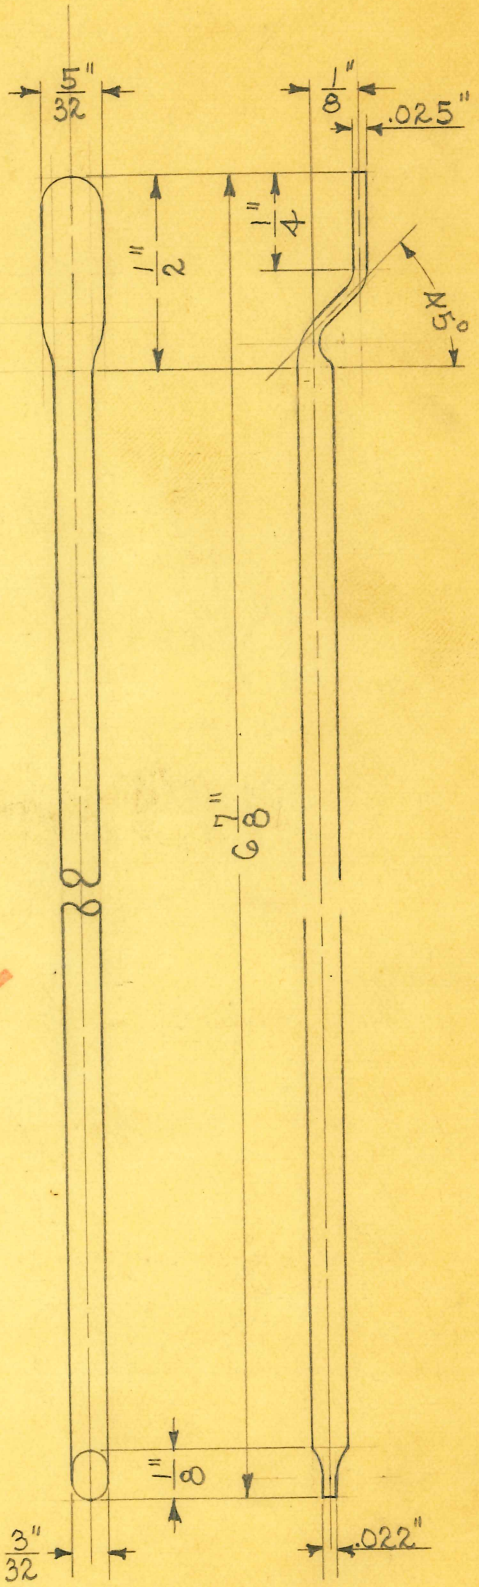

OBSOLETE

SCALE ≈ 1" = 1/2"

DEVELOPED LENGTH - 7"

SIZE	3/32"	ISSUE 2-9-33	A.E.
KIND	MONEL METAL	CHANGED	
SHAPE		" "	
FINISH		" "	
TEMP.		" "	
PATT.		" "	

TITLE: SINSKEY OFFSET FLAT TIP ELECTRODE

H. G. FISCHER & CO.
2335 WABANSIA AVE.
CHICAGO, ILL.

CAT. NO.

PART NO. 6986

USE SWEDGING DIE #3269

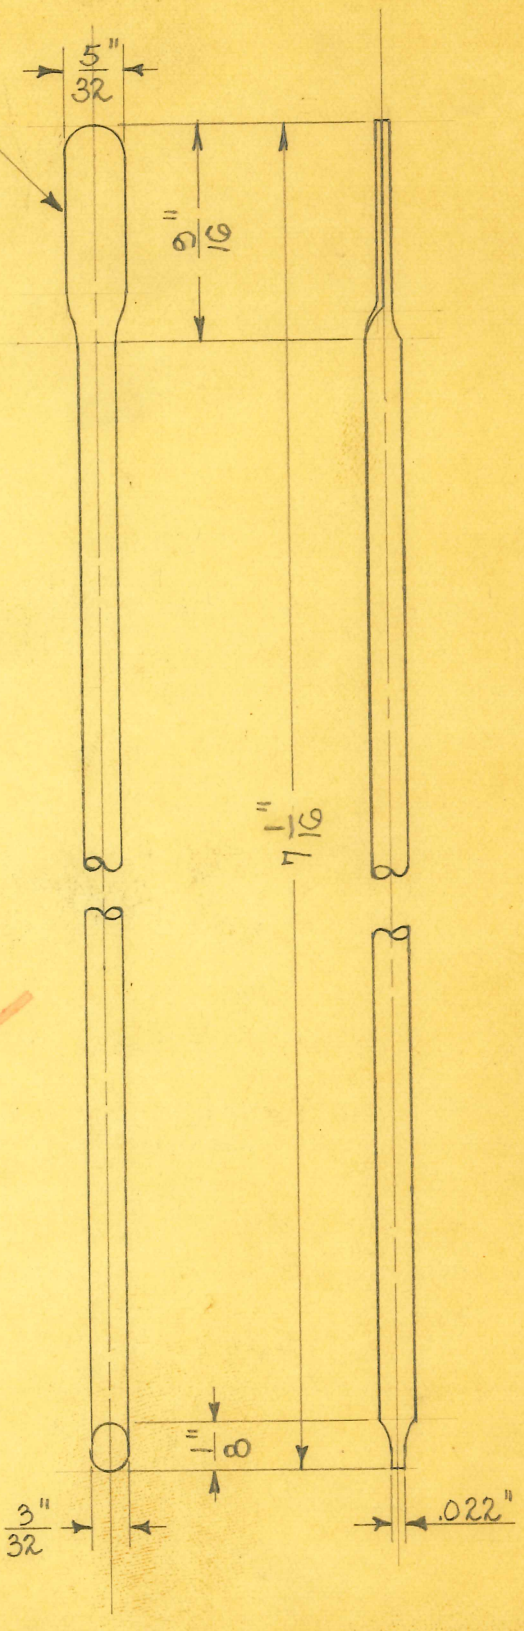

OBSOLETE

SCALE ~ 1" = 1/2"

DEVELOPED LENGTH - 7 3/4"

CUT ELECTRODE END OFF TO 9/16" AFTER FORMING.

SIZE	3/32"	ISSUE 2-13-33	A.B.
KIND	MONEL METAL	CHANGED	
SHAPE		" "	
FINISH		" "	
TEMP.		" "	
PATT.		" "	

TITLE: SINSKEY TURB. EL. WITH LONG SHANK & SHORT END

H. G. FISCHER & CO.
2335 WABANSIA AVE.
CHICAGO, ILL.

CAT. NO.

PART NO. 6987

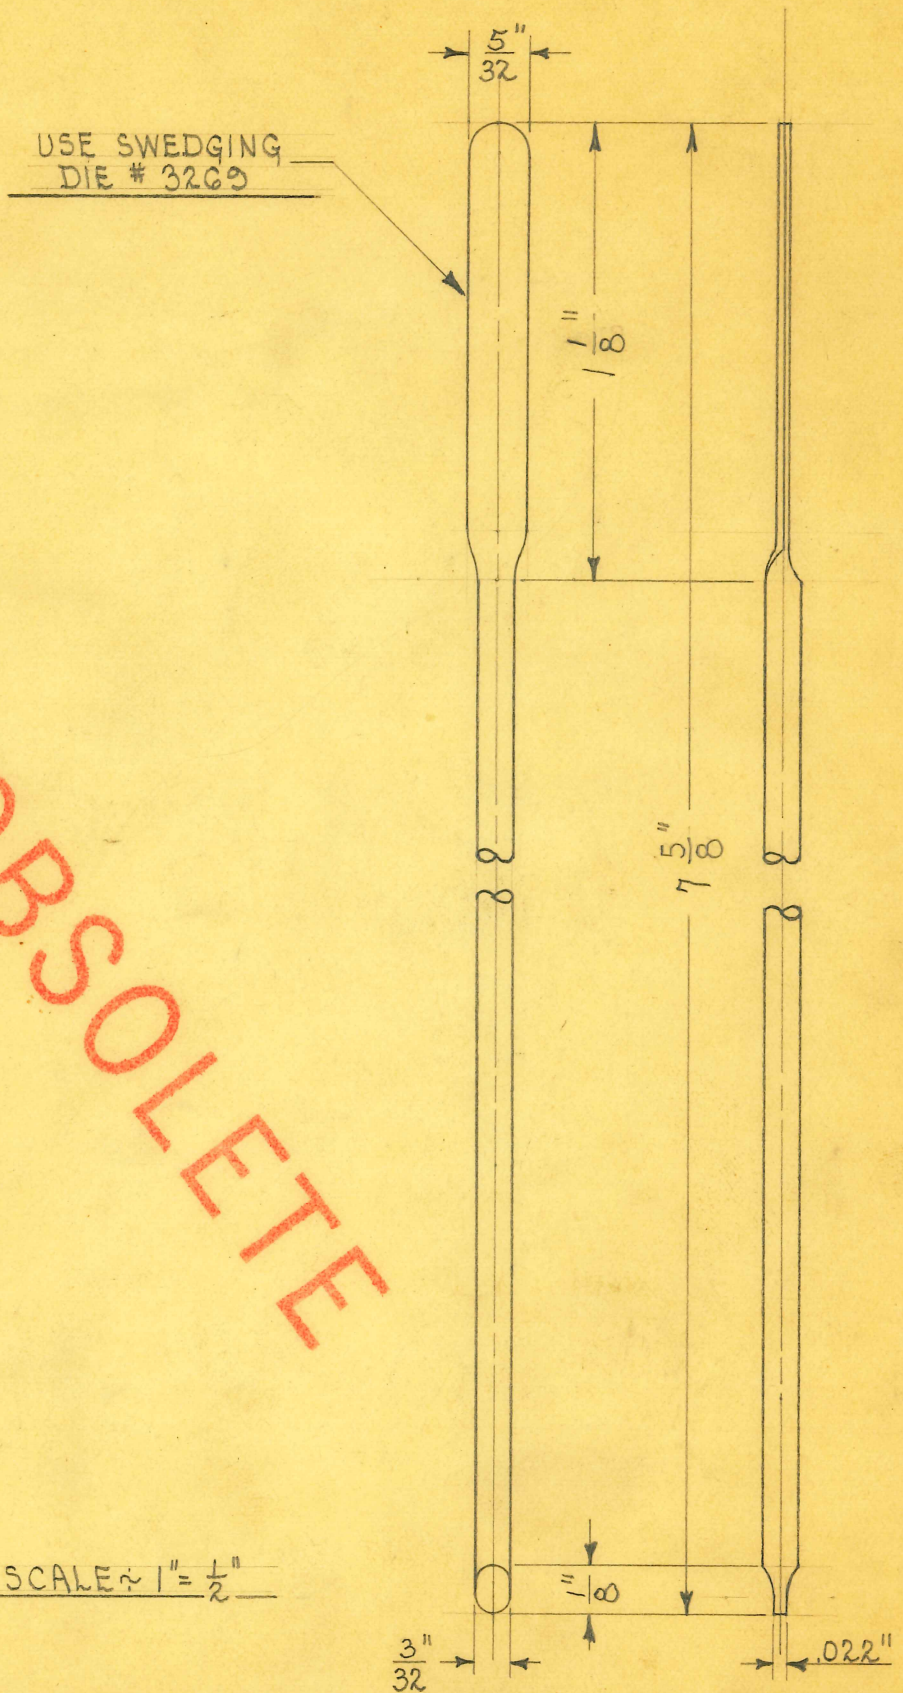

OBSOLETE

SCALE ~ 1" = 1/2"

SIZE	3/32"	ISSUE 2-13-33	H.E.
KIND	MONEL METAL	CHANGED	
SHAPE		" "	
FINISH		" "	
TEMP.		" "	
PATT.		" "	

TITLE: SINSKEY TURB. EL. WITH LONG SHANK & LONG END

H. G. FISCHER & CO.
2335 WABANSIA AVE.
CHICAGO, ILL.

CAT. NO.

PART NO. 6988

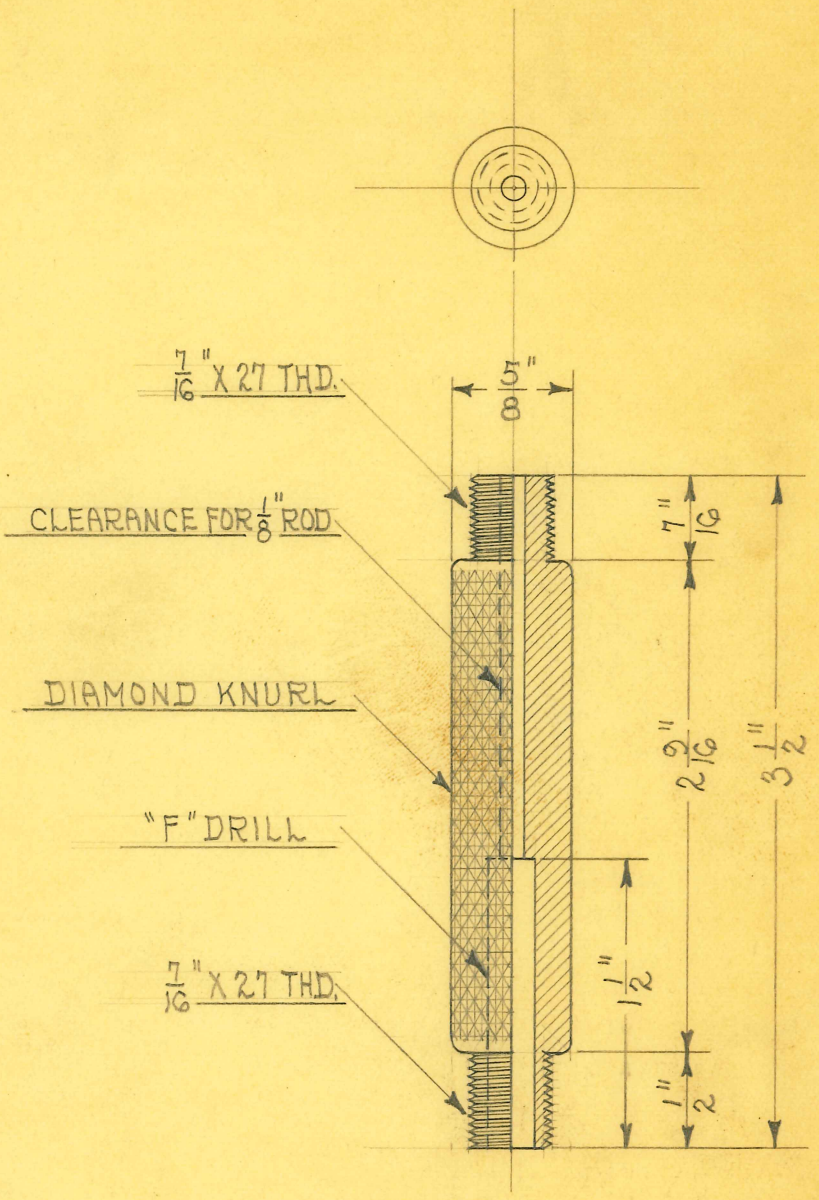

OBSOLETE

SIZE	5/8"	ISSUE 2-2-33	A.E.	**TITLE:** SINSKEY ELECT. HANDLE BODY
KIND	H. RUB. ROD	CHANGED		
SHAPE		" "		
FINISH		" "		
TEMP.		" "		H. G. FISCHER & CO. 2335 WABANSIA AVE. CHICAGO, ILL.
PATT.		" "		CAT. NO. / PART NO. 6971

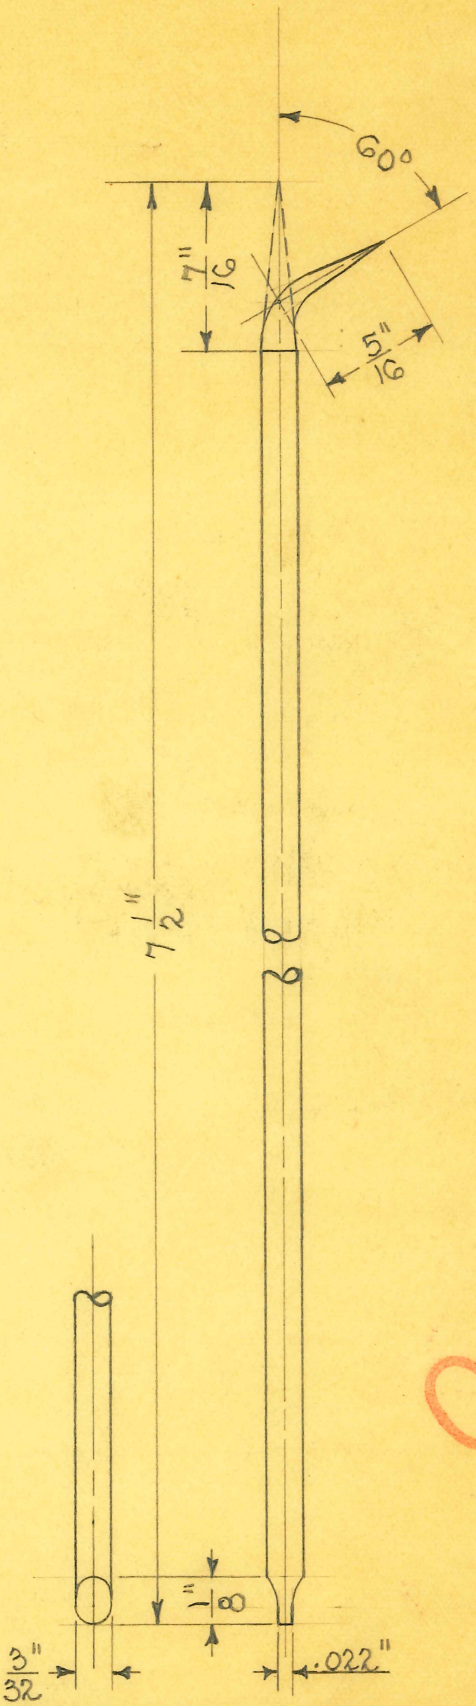

OBSOLETE

SCALE ≈ 1" = 1/2"

SIZE	3/32"	ISSUE 2-9-33	A.E.
KIND	STAINLESS STEEL	CHANGED	
SHAPE		" "	
FINISH		" "	
TEMP.		" "	
PATT.		" "	

TITLE: SINSKEY SHARP POINT ELECT. 60° ANGLE

H. G. FISCHER & CO.
2335 WABANSIA AVE.
CHICAGO, ILL.

CAT. NO.

PART NO. 6989

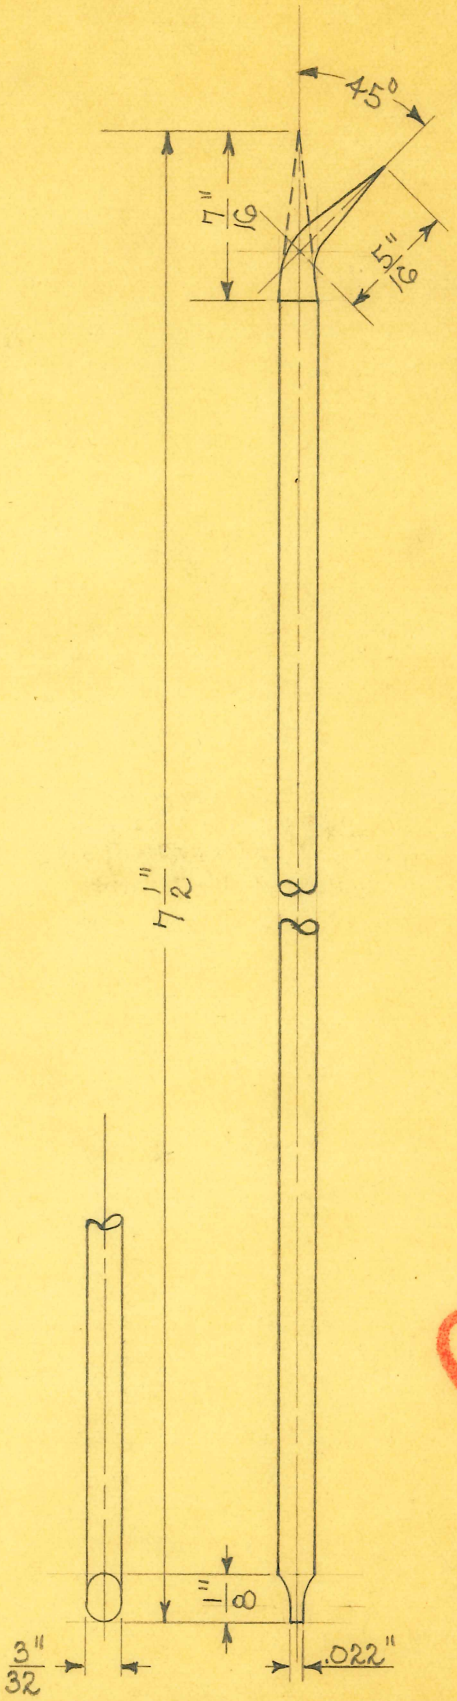

SCALE ÷ 1" = 1/2"

OBSOLETE

SIZE	3/32"	ISSUE 2-9-33	A.E.	**TITLE:** SINSKEY SHARP POINT ELECT. 45° ANGLE
KIND	STAINLESS STEEL	CHANGED		
SHAPE		" "		
FINISH		" "		
TEMP.		" "		H. G. FISCHER & CO. 2335 WABANSIA AVE. CHICAGO, ILL. — CAT. NO. — PART NO. 6991
PATT.		" "		

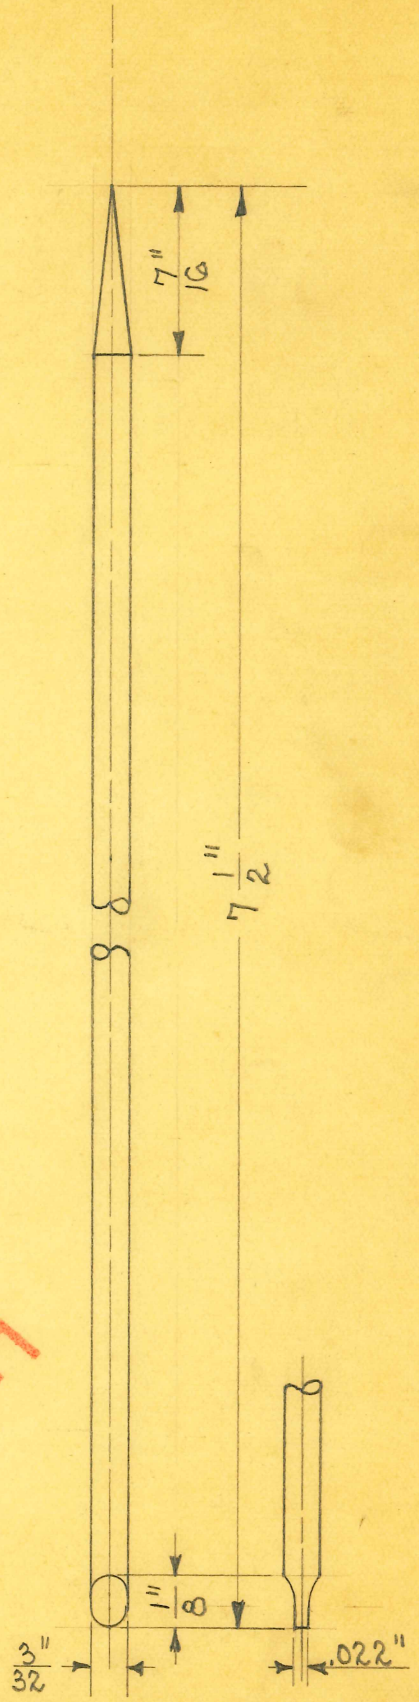

OBSOLETE

SCALE ≈ 1" = 1/2"

SIZE	3/32"	ISSUE 2-9-33	A.E.	**TITLE:** SINSKEY STRAIGHT POINT EL. WITH LONG SHANK
KIND	STAINLESS STEEL	CHANGED		
SHAPE		" "		
FINISH		" "		
TEMP.		" "		H. G. FISCHER & CO. 2335 WABANSIA AVE. CHICAGO, ILL. — CAT. NO. — PART NO. 6992
PATT.		" "		

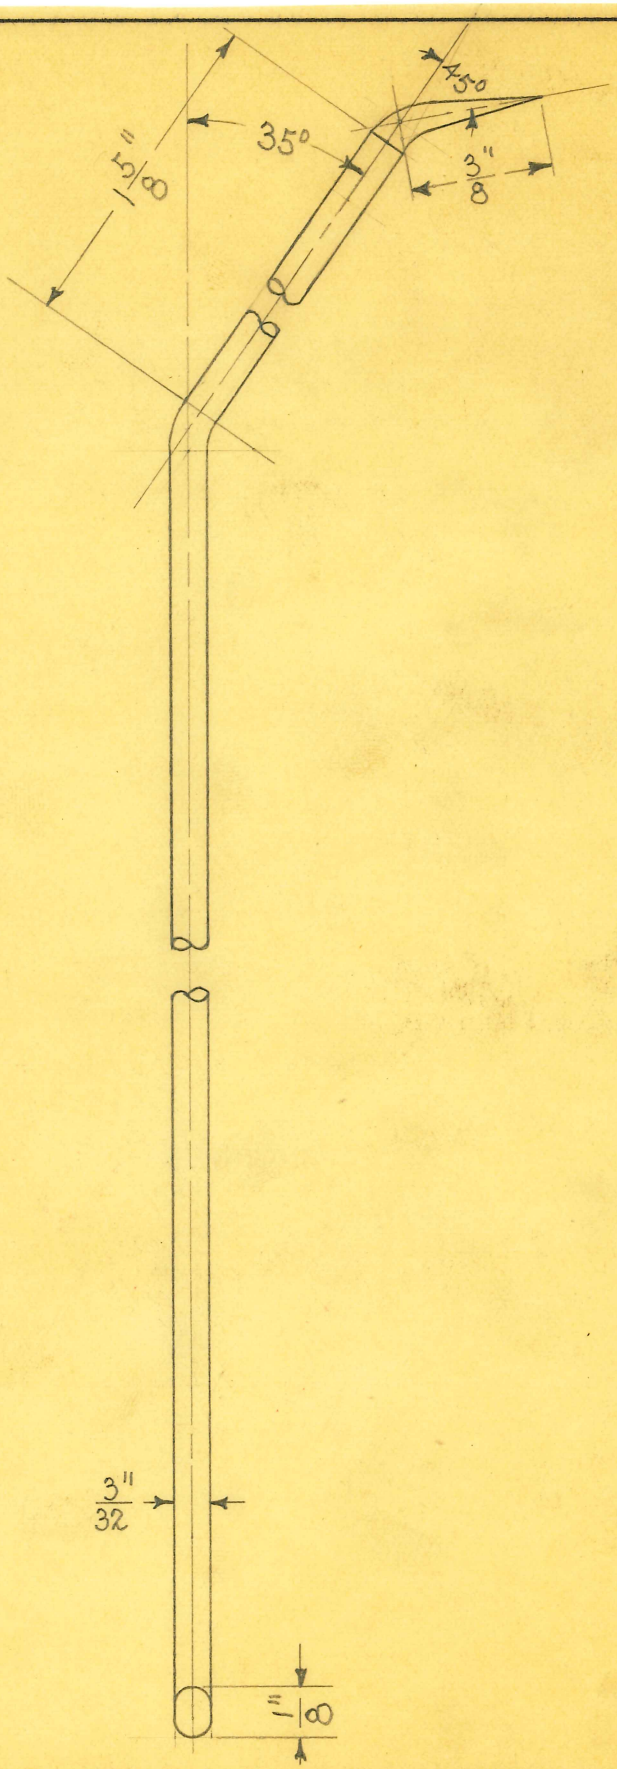

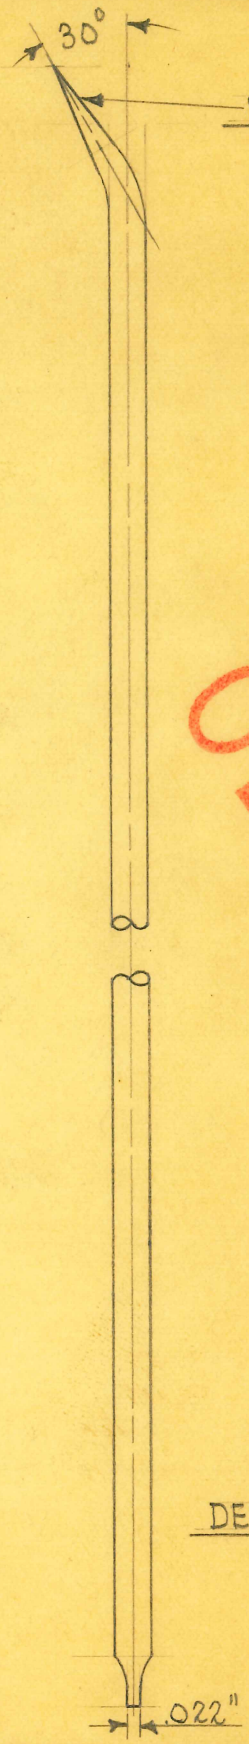

POINT SAME AS 6992

OBSOLETE

SCALE ~ 1" = 1/2"

DEVELOPED LENGTH - 9 1/8"

SIZE	3/32"	ISSUE 2-13-33	J.E.	**TITLE:** SINSKEY EXTRA LONG POINT EL. WITH DOUBLE BEND
KIND	MONEL METAL	CHANGED		
SHAPE		" "		
FINISH		" "		
TEMP.		" "		H. G. FISCHER & CO. 2335 WABANSIA AVE. CHICAGO, ILL. — CAT. NO. — PART NO. 6993
PATT.		" "		

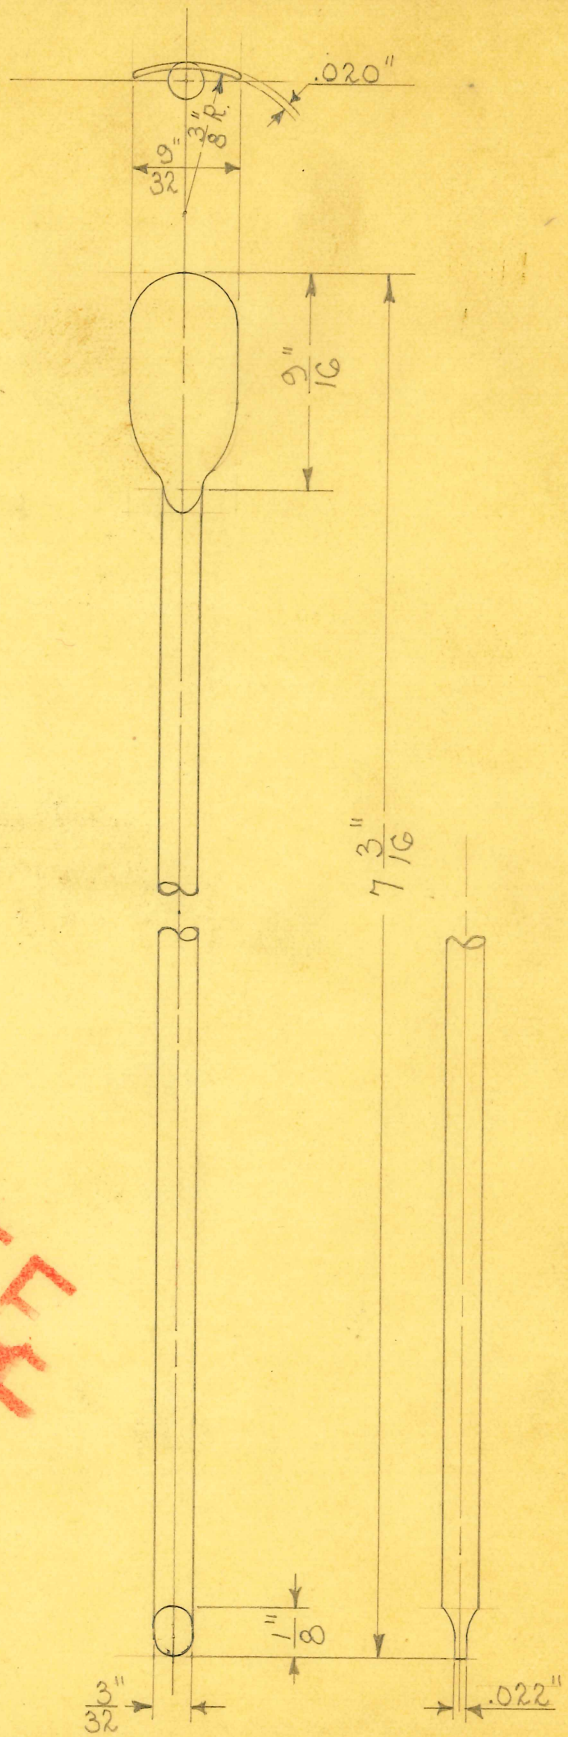

OBSOLETE

SCALE 1" = 1/2"

SIZE	3/32"	ISSUE 6-22-33	A.E.
KIND	MONEL METAL	CHANGED	
SHAPE		" "	
FINISH		" "	
TEMP.		" "	
PATT.		" "	

TITLE: SINSKEY TURBINATE ELECT. (SHORT, BROAD SURFACE)

H. G. FISCHER & CO.
2335 WABANSIA AVE.
CHICAGO, ILL.

CAT. NO.

PART NO. 6997

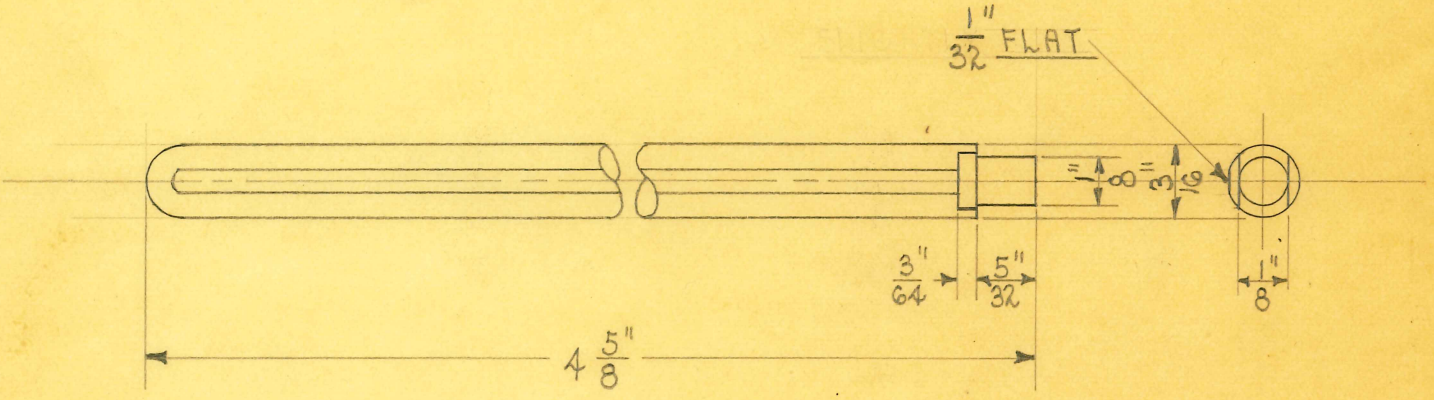

SCALE ~ 2 DIAMETERS

OBSOLETE

SIZE	3/16"	ISSUE 2-4-32	H.G.	**TITLE:** DR. LINN ADJ. EAR ELECTRODE ADJUSTING ROD
KIND	BRASS ROD	CHANGED		
SHAPE		" "		
FINISH	N.P.	" "		
TEMP.		" "		H. G. FISCHER & CO. 2335 WABANSIA AVE. CHICAGO, ILL. — CAT. NO. — PART NO. 2702 1/2
PATT.		" "		

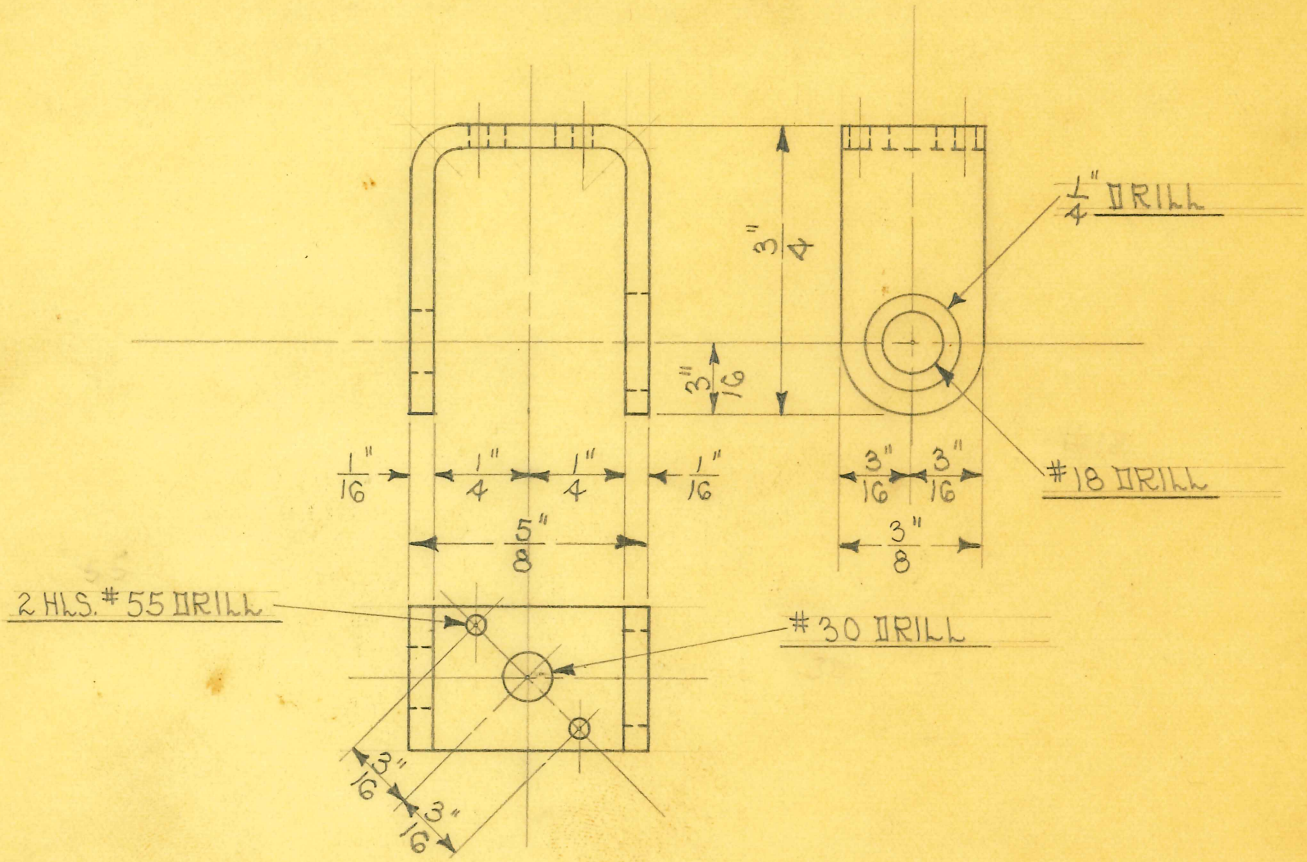

SCALE ~ DOUBLE SIZE

DEVELOPED LENGTH - 1 11/16"

OBSOLETE

SIZE	#14 GA.	ISSUE 2-5-32	H.E.	**TITLE:** DR. LINN ADJ. EAR ELECTRODE ADJ. ROD FORK
KIND	STRIP BRASS	CHANGED		
SHAPE		" "		
FINISH		" "		
TEMP.		" "		
PATT.		" "		

H. G. FISCHER & CO.
2335 WABANSIA AVE.
CHICAGO, ILL.

CAT. NO.

PART NO. 2703 1/2

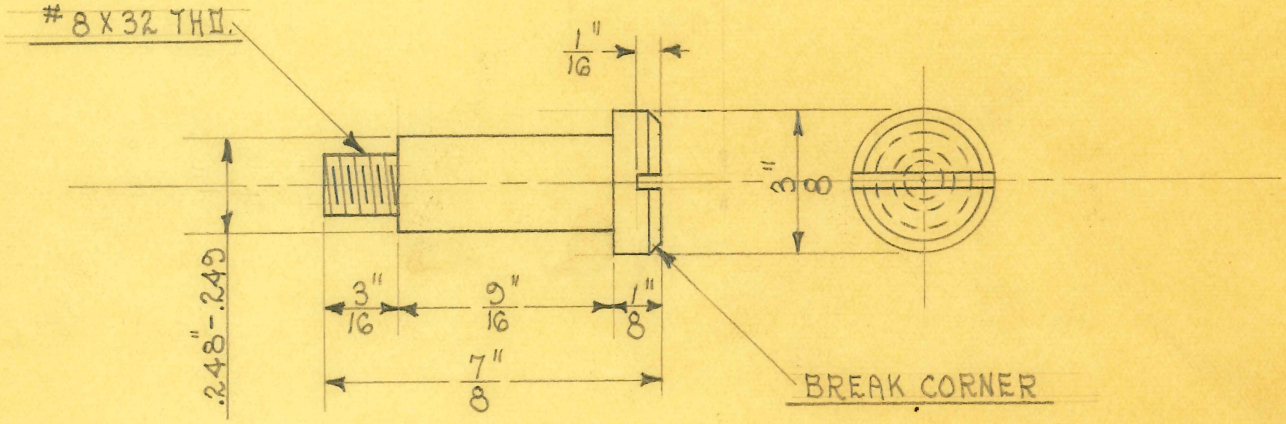

SCALE ~ 2 DIAMETERS

OBSOLETE

SIZE	3/8"	ISSUE 2-4-32	A.E.	TITLE: DR. LINN ADJ. EAR ELECTRODE ADJ. ROD FORK SCR.
KIND	BRASS ROD	CHANGED		
SHAPE		" "		
FINISH		" "		
TEMP.		" "		H. G. FISCHER & CO. 2335 WABANSIA AVE. CHICAGO, ILL. / CAT. NO. / PART NO. 2704 1/2
PATT.		" "		

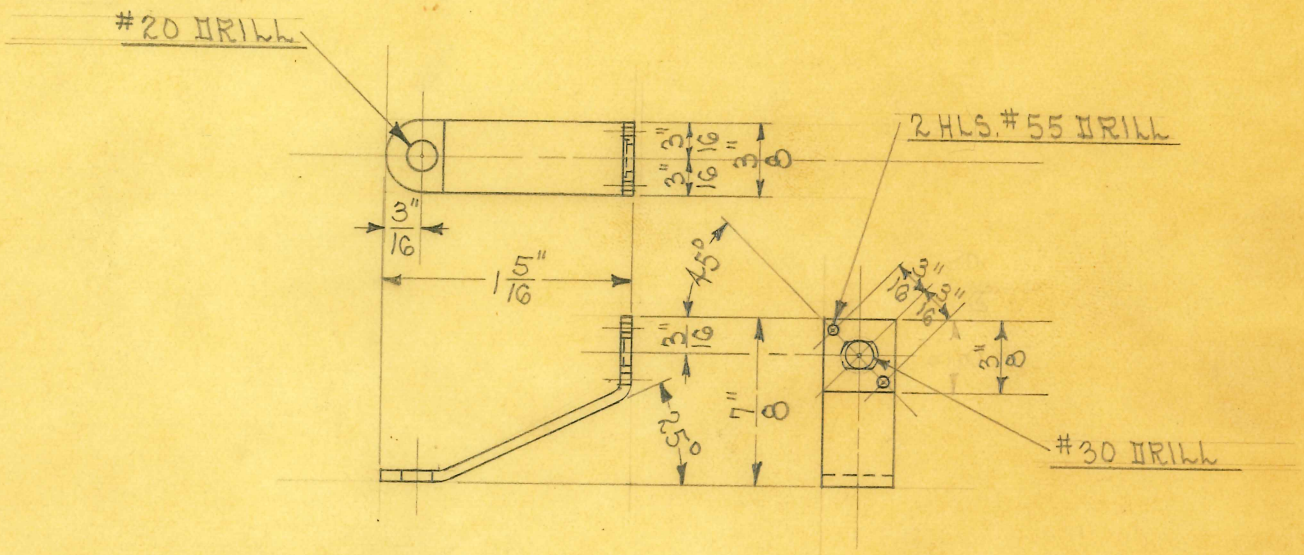

SCALE ~ FULL SIZE

OBSOLETE

SIZE	1/16" X 5/8"	ISSUE 2-6-32	A.E.
KIND	COIL ROLLED	CHANGED	
SHAPE		" "	
FINISH		" "	
TEMP.		" "	
PATT.		" "	

TITLE: DR. LINN ADJ. EAR ELECTRODE HEAD REST SPG.

H. G. FISCHER & CO.
2335 WABANSIA AVE.
CHICAGO, ILL.

CAT. NO.

PART NO. 2705 1/2

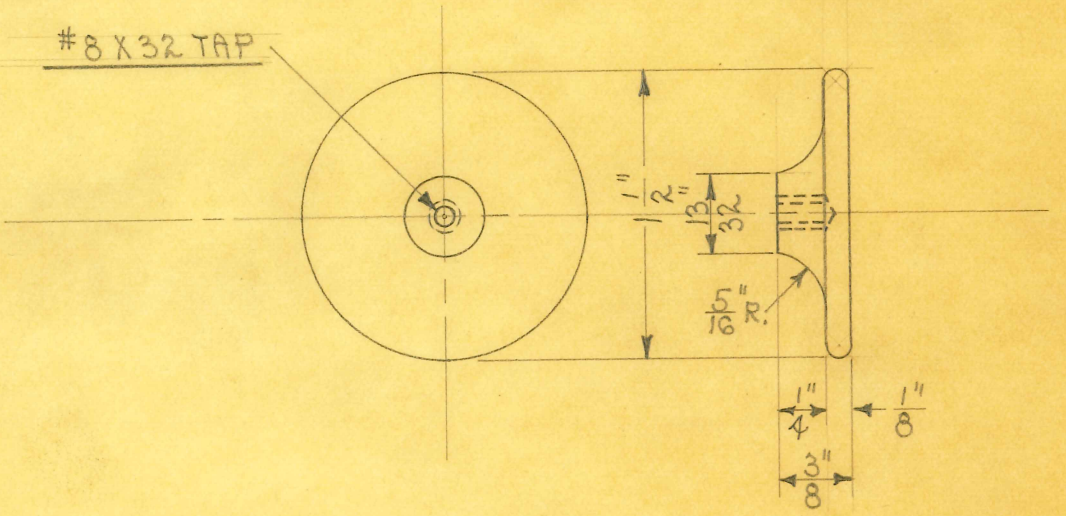

SCALE ~ FULL SIZE

OBSOLETE

SIZE	1½"	ISSUE 2-4-32	H.E.	TITLE: IR. LINN ADJ. EAR ELECT. HEAD REST BUTTON	
KIND	ROUGH RUB. ROD	CHANGED			
SHAPE		" "			
FINISH		" "			
TEMP.		" "		H. G. FISCHER & CO. 2335 WABANSIA AVE. CHICAGO, ILL.	CAT. NO.
PATT.		" "			PART NO. 2706 1/2

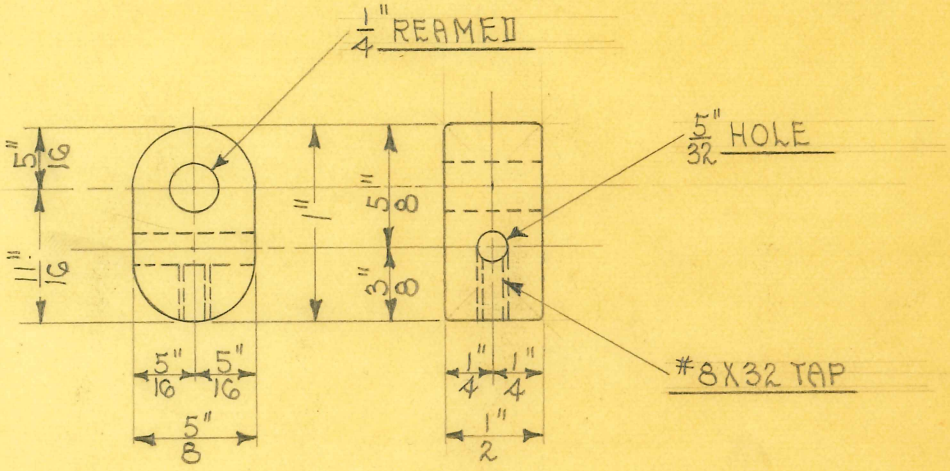

SCALE ~ FULL SIZE

OBSOLETE

SIZE	1/2"	ISSUE 2-4-32	A.E.	TITLE: DR. LINN ADJ. EAR ELECTRODE INSULATING BLOCK
KIND	SHEET BAKELITE	CHANGED		
SHAPE		" "		
FINISH	POL. & BUFF	" "		
TEMP.		" "		
PATT.		" "		

H. G. FISCHER & CO.
2335 WABANSIA AVE.
CHICAGO, ILL.

CAT. NO.

PART NO. 2707 1/2

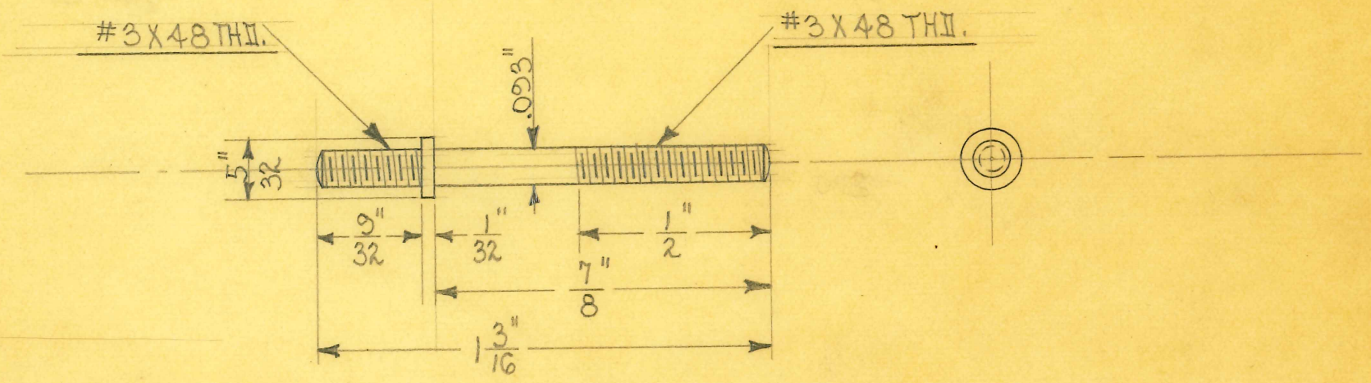

SCALE ~ 2 DIAMETERS

OBSOLETE

SIZE	5/32"	ISSUE 2-10-32	A.E.	TITLE: DR. LINN ADJ. EAR ELECT. COTTON HOLDER ROD TIP
KIND	BRASS ROD	CHANGED		
SHAPE		" "		
FINISH	N.P.	" "		
TEMP.		" "		
PATT.		" "		

H. G. FISCHER & CO.
2335 WABANSIA AVE.
CHICAGO, ILL.

CAT. NO.

PART NO. 2708 1/4

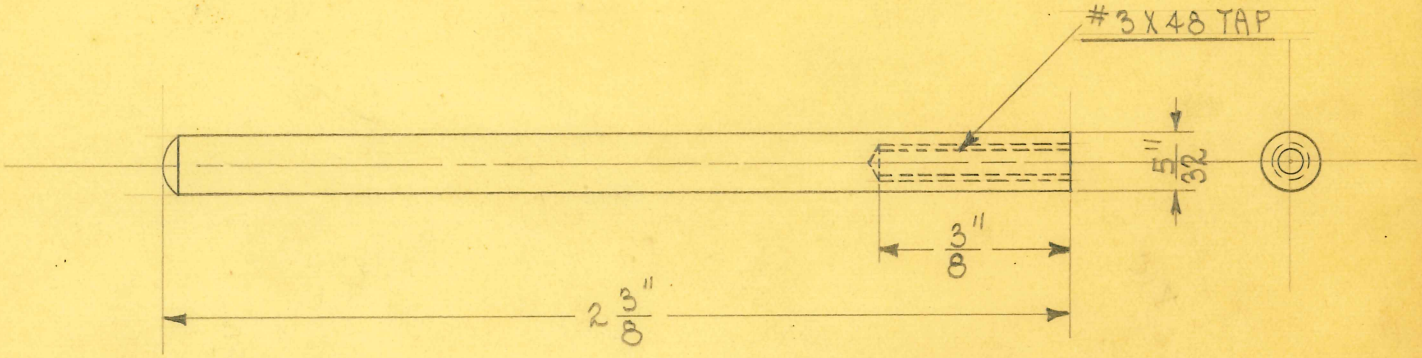

SCALE~ 2 DIAMETERS

OBSOLETE

SIZE	5/32"	ISSUE 2-11-32	J.E.	**TITLE:** DR. LINN ADJ. EAR ELECT. COTTON HOLDER ROD
KIND	BRASS ROD	CHANGED		
SHAPE		" "		
FINISH	N.P.	" "		
TEMP.		" "		H. G. FISCHER & CO. 2335 WABANSIA AVE. CHICAGO, ILL. — CAT. NO. — PART NO. 2708 1/2 A
PATT.		" "		

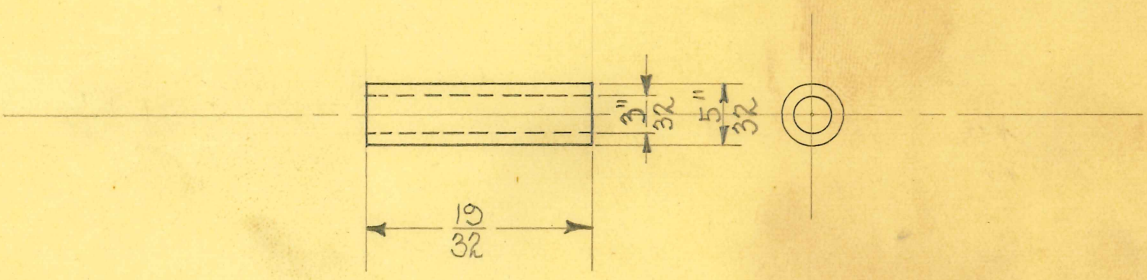

SCALE ~ 2 DIAMETERS

OBSOLETE

SIZE	3/32" I.D. X 5/32" O.D.	ISSUE 2-11-32	H.E.
KIND	POL. RUB. TUBING	CHANGED	
SHAPE		" "	
FINISH		" "	
TEMP.		" "	
PATT.		" "	

TITLE: DR. LINN. ADJ. EAR ELECT. COTTON HOLDER ROD TIP INSULATOR

H. G. FISCHER & CO.
2335 WABANSIA AVE.
CHICAGO, ILL.

CAT. NO.

PART NO. 2708 3/4

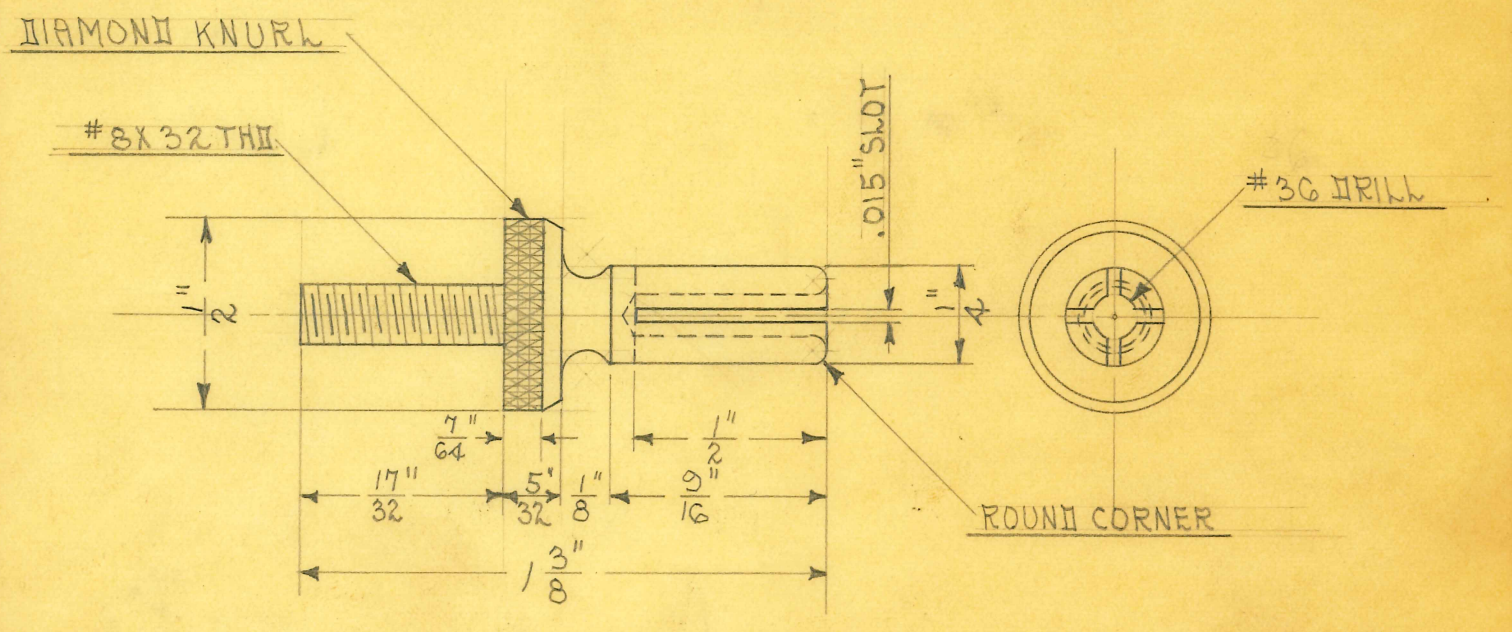

SCALE ~ 2 DIAMETERS

OBSOLETE

SIZE	1/2"	ISSUE 2-5-32	A.E.	TITLE: DR. LINN ADJ. EAR ELECTRODE CONNECTION SCR.
KIND	BRASS ROD	CHANGED		
SHAPE		" "		
FINISH	N.P.	" "		
TEMP.		" "		H. G. FISCHER & CO. 2335 WABANSIA AVE. CHICAGO, ILL.
PATT.		" "		CAT. NO.
				PART NO. 2710 1/2

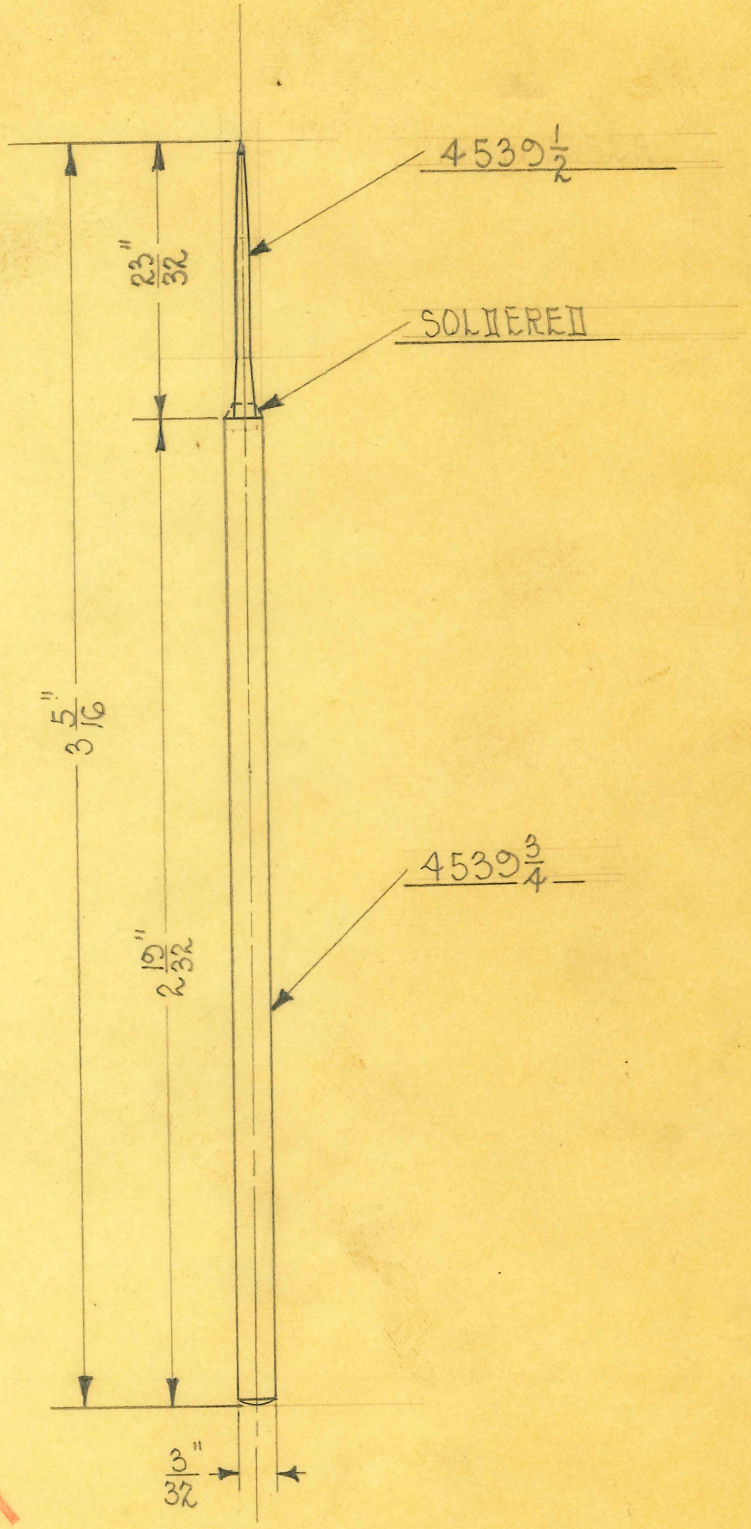

SCALE ~ 2 DIAMETERS

OBSOLETE

SIZE		ISSUE 3-28-32	A.E.
KIND		CHANGED	
SHAPE		" "	
FINISH		" "	
TEMP.		" "	
PATT.		" "	

TITLE: NEEDLE POINT ELECTRODE TO FIT DILLINGER & PLANK HANDLES

H. G. FISCHER & CO.
2335 WABANSIA AVE.
CHICAGO, ILL.

CAT. NO.

PART NO. 4539 1/2 G

OBSOLETE

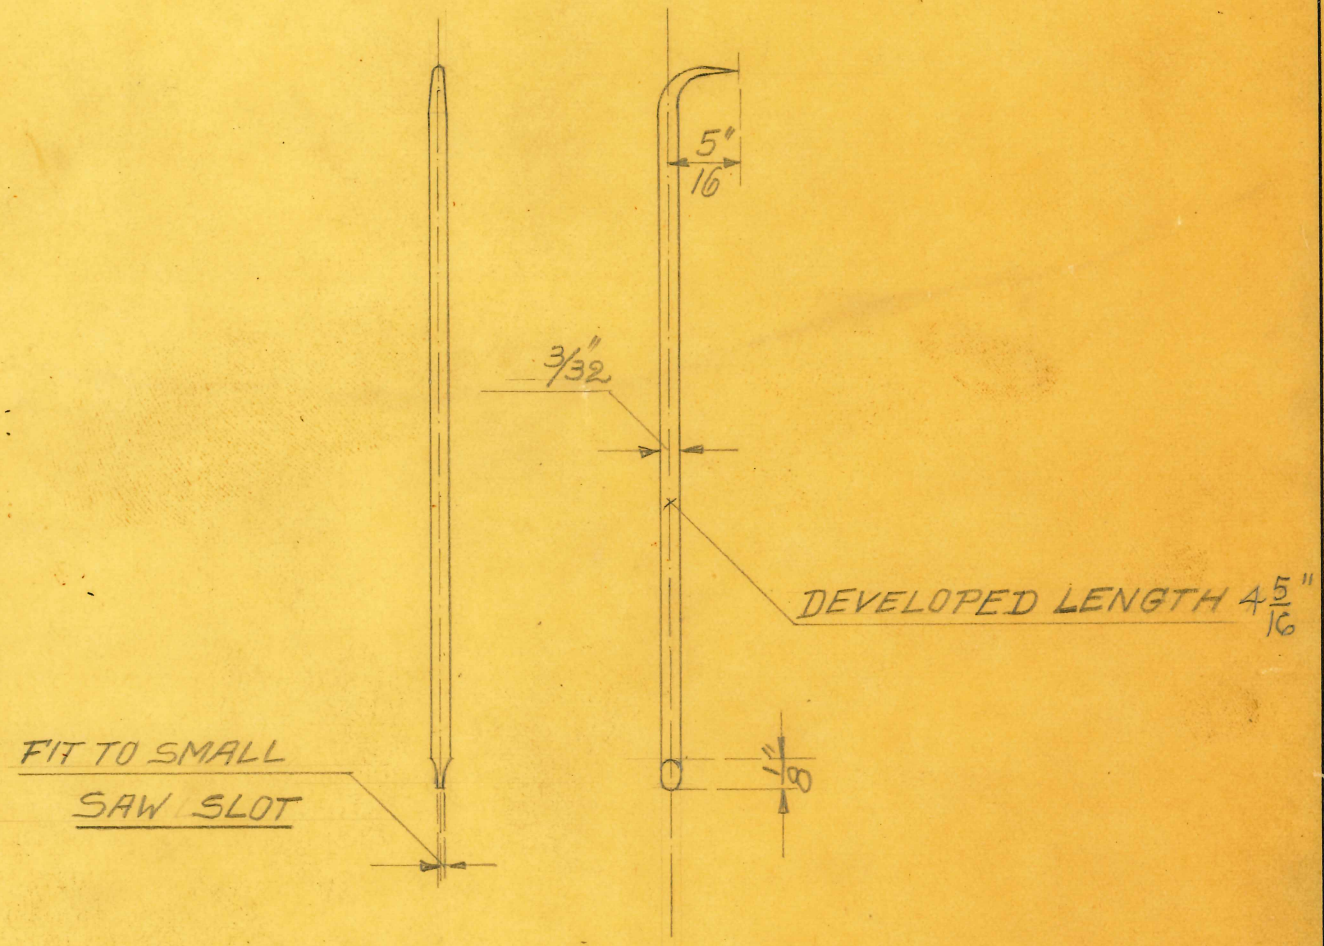

738

SIZE		ISSUE		TITLE: DILLINGER-ELECT. COAG. HDLE. MED. CURVED-NEEDLE		
KIND		CHANGED				
SHAPE		" "				
FINISH		" "				
TEMP.		" "		H. G. FISCHER & CO. 2335 WABANSIA AVE. CHICAGO, ILL.	CAT. NO.	PART NO. 4540
PATT.		" "				

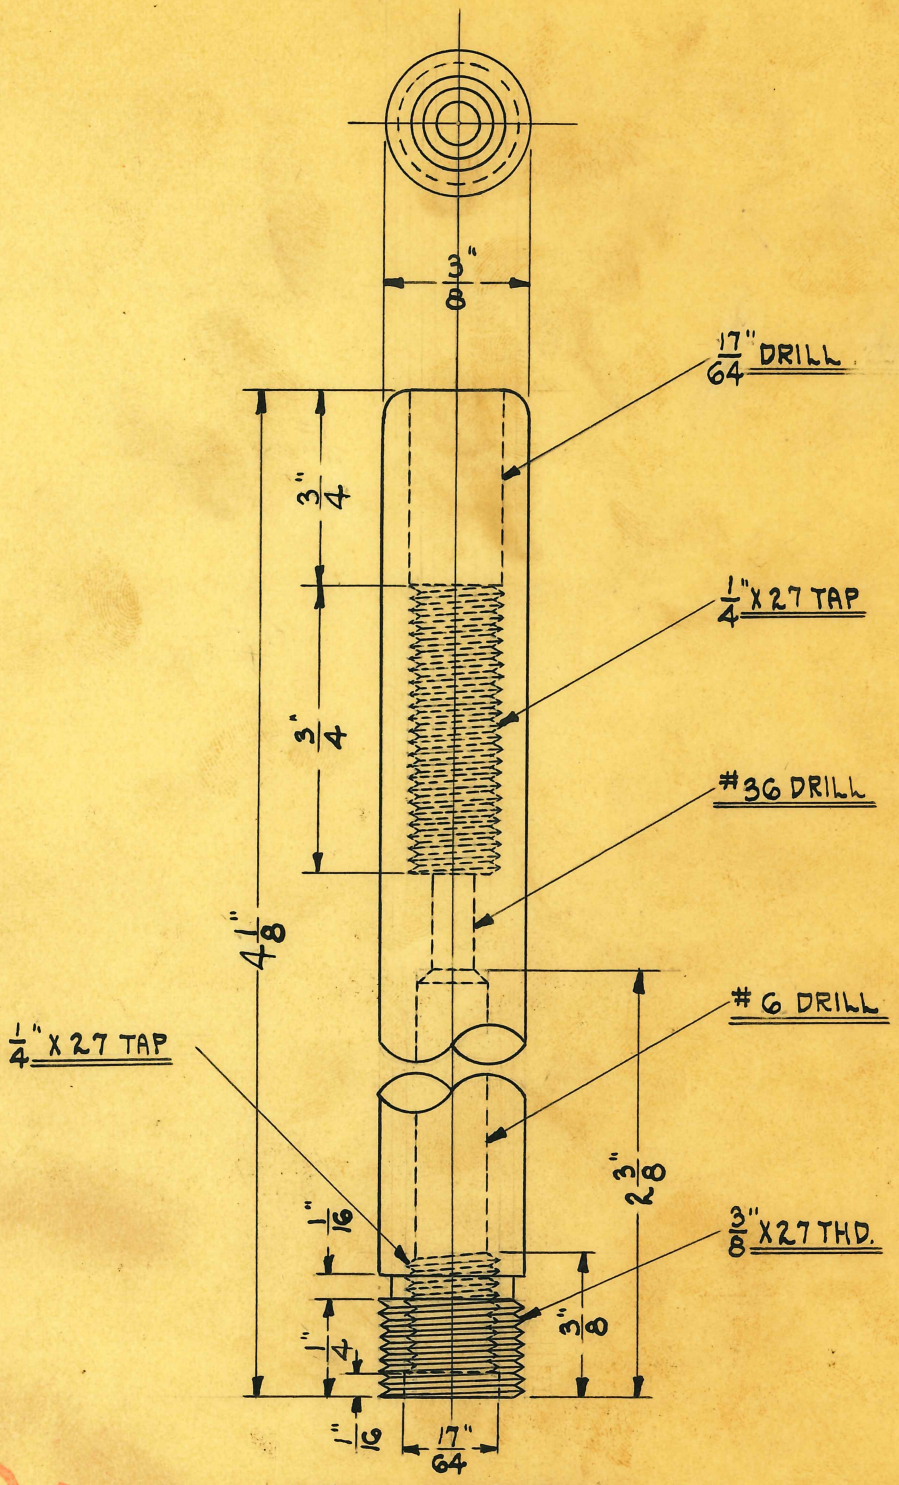

SCALE ÷ 2 DIAMETERS

OBSOLETE

SIZE	3/8"	ISSUE 9-9-30	H.E.	TITLE: MILLSTONE ADJUST. TONSIL ELEC. HOLDER STEM
KIND	HARD RUB. ROD	CHANGED 11-25-30	H.E.	
SHAPE	ROUND	" "		
FINISH		" "		
TEMP.		" "		H. G. FISCHER & CO. 2335 WABANSIA AVE. CHICAGO, ILL. — CAT. NO. — PART NO. 4566
PATT.		" "		

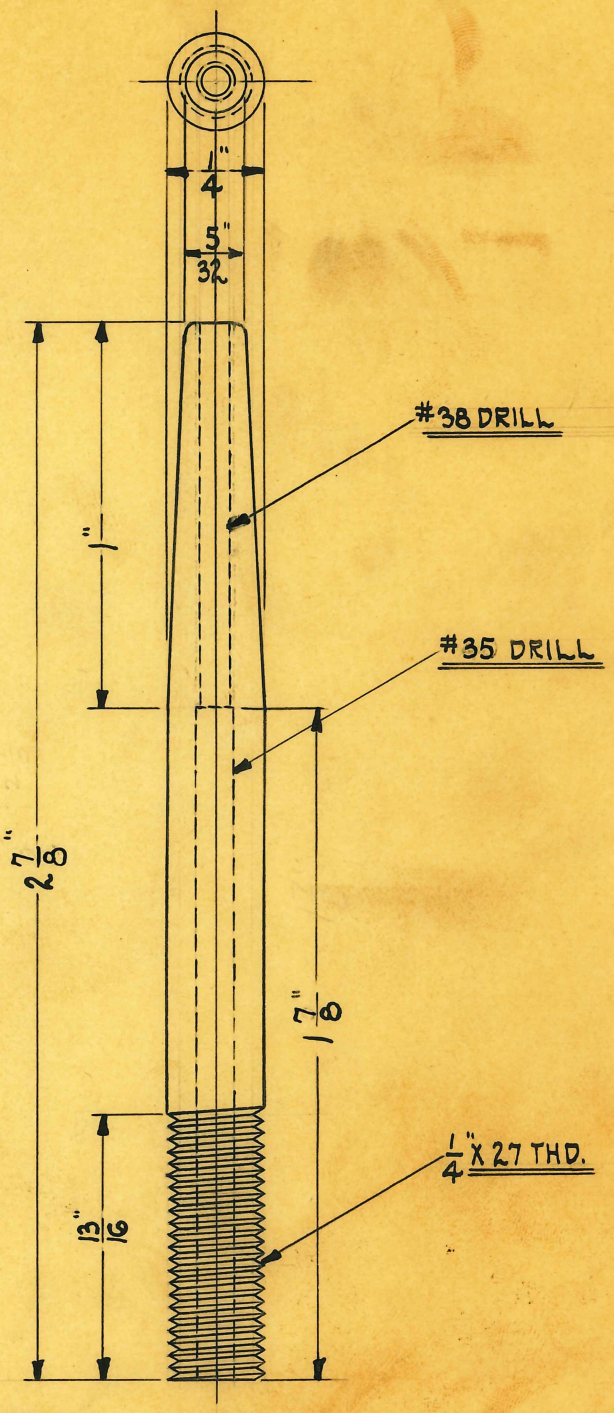

SCALE ~ 2 DIAMETERS

OBSOLETE

SIZE	1/4"	ISSUE 9-9-30	A.E.	TITLE: MILLSTONE ADJ. TONSIL ELEC. ADJUSTING SLEEVE
KIND	HARD RUB. ROD	CHANGED 11-25-30	A.E.	
SHAPE	ROUND	" "		
FINISH		" "		
TEMP.		" "		H. G. FISCHER & CO. 2335 WABANSIA AVE. CHICAGO, ILL. — CAT. NO. — PART NO. 4567
PATT.		" "		

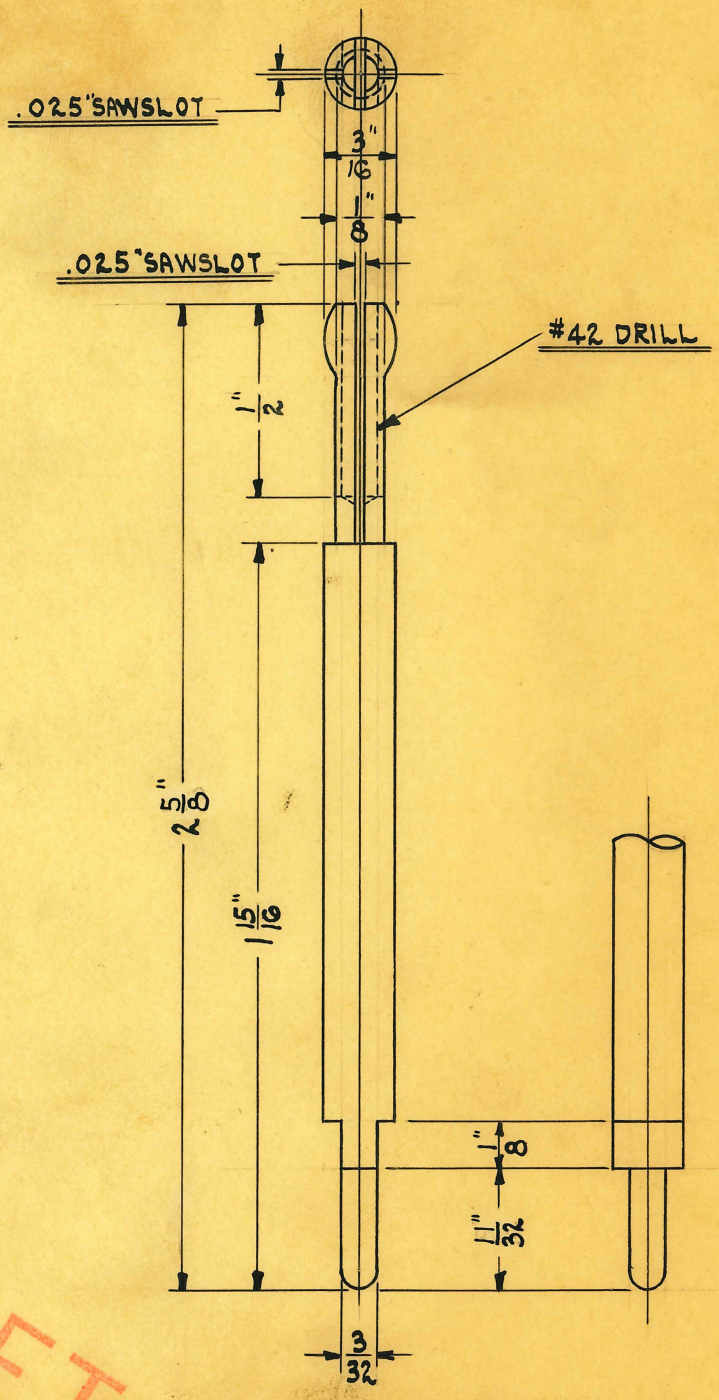

SCALE ~ 2 DIAMETERS

DEVELOPED LENGTH 2 11/16"

OBSOLETE

SIZE	3/16"	ISSUE 9-6-30	A.E.	TITLE: MILLSTONE ADJUSTABLE TONSIL ELEC. CHUCK
KIND	BRASS ROD	CHANGED		
SHAPE	ROUND	" "		
FINISH	W.P.	" "		
TEMP.		" "		H. G. FISCHER & CO. 2335 WABANSIA AVE. CHICAGO, ILL. — CAT. NO. — PART NO. 4568
PATT.		" "		

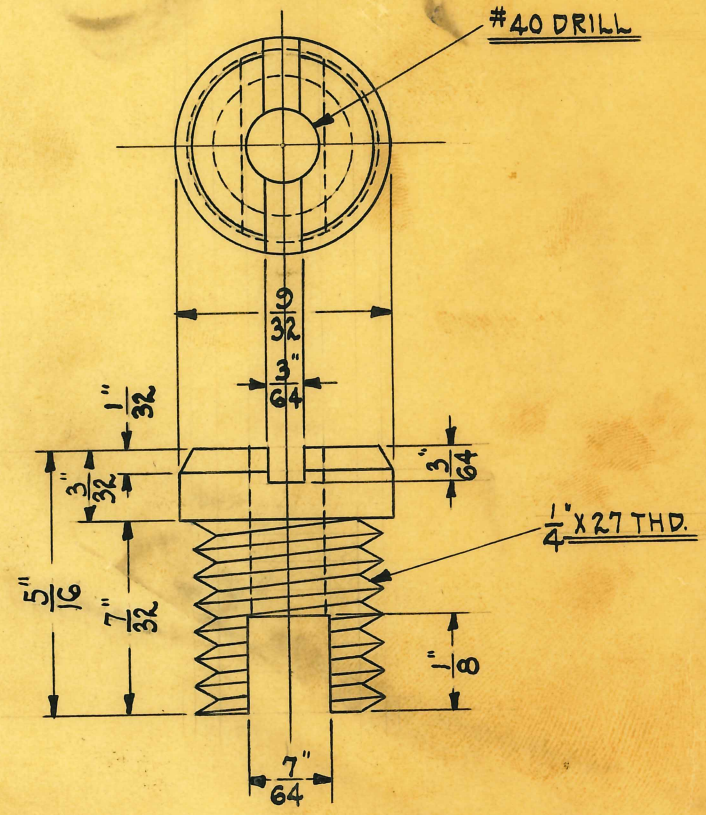

SCALE ÷ 4 DIAMETERS

OBSOLETE

SIZE	9/32"	ISSUE 9-5-30	A.E.
KIND	BRASS ROD	CHANGED	
SHAPE	ROUND	" "	
FINISH	W.P.	" "	
TEMP.		" "	
PATT.		" "	

TITLE: MILLSTONE ADJUSTABLE TONSIL ELEC. CHUCK LOCK SCREW

H. G. FISCHER & CO.
2335 WABANSIA AVE.
CHICAGO, ILL.

CAT. NO.

PART NO. 4569

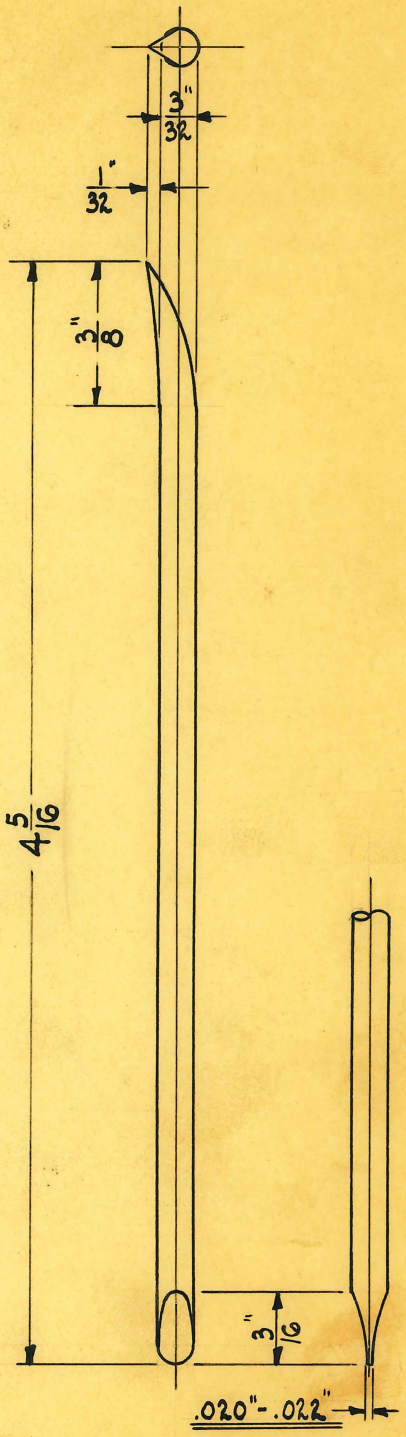

SCALE ÷ 2 DIAMETERS

OBSOLETE

SIZE	3/32"	ISSUE 9-9-30	A.E.
KIND	STAINLESS STEEL	CHANGED	
SHAPE	ROUND	" "	
FINISH	BUFFED	" "	
TEMP.		" "	
PATT.		" "	

TITLE: MILLSTONE ADJ. TONSIL ELECTRODE NEEDLE

H. G. FISCHER & CO.
2335 WABANSIA AVE.
CHICAGO, ILL.

CAT. NO.

PART NO. 4570

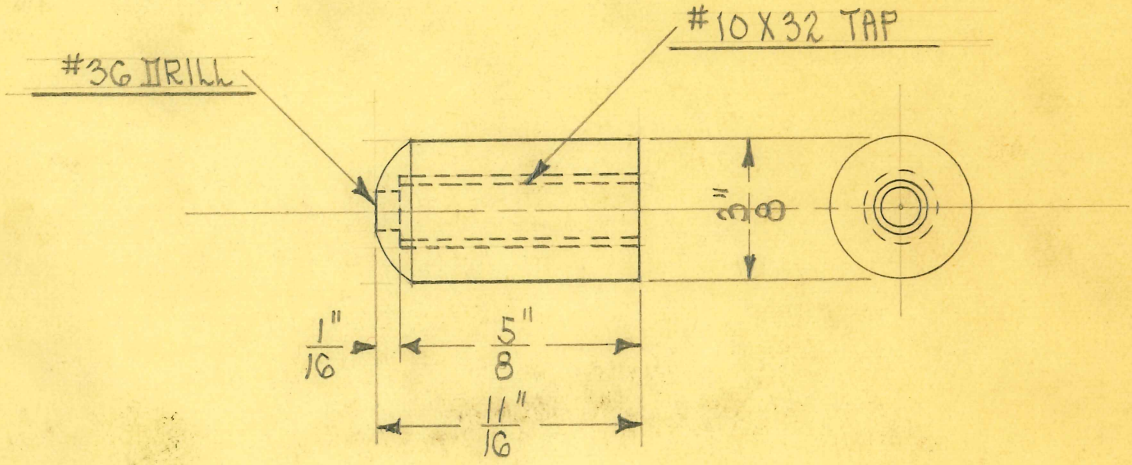

SCALE ~ 2 DIAMETERS

OBSOLETE

SIZE	3/8"	ISSUE 7-18-32	2.5.	TITLE: McCARTHY ELECTROTONE CORE SLEEVE
KIND	POL. RUB. ROD	CHANGED		
SHAPE		" "		
FINISH		" "		
TEMP.		" "		H. G. FISCHER & CO. 2335 WABANSIA AVE. CHICAGO, ILL. / CAT. NO. / PART NO. 6936
PATT.		" "		

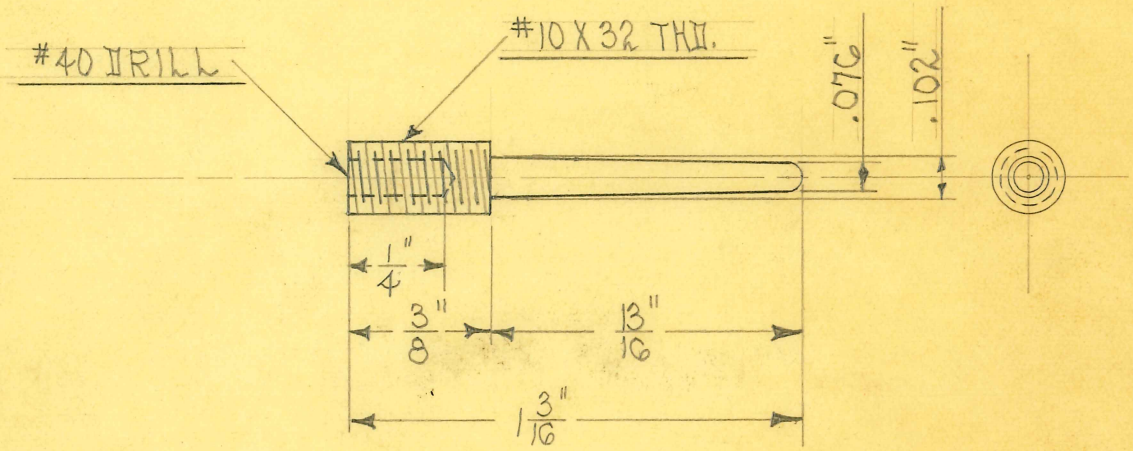

SCALE ~ 2 DIAMETERS

OBSOLETE

SIZE	3/16"	ISSUED 7-15-32	A.E.
KIND	BRASS ROD	CHANGED	
SHAPE		" "	
FINISH		" "	
TEMP.		" "	
PATT.		" "	

TITLE: Mc CARTHY ELECTROTONE CORD TIP

H. G. FISCHER & CO.
2335 WABANSIA AVE.
CHICAGO, ILL.

CAT. NO.

PART NO. 6937

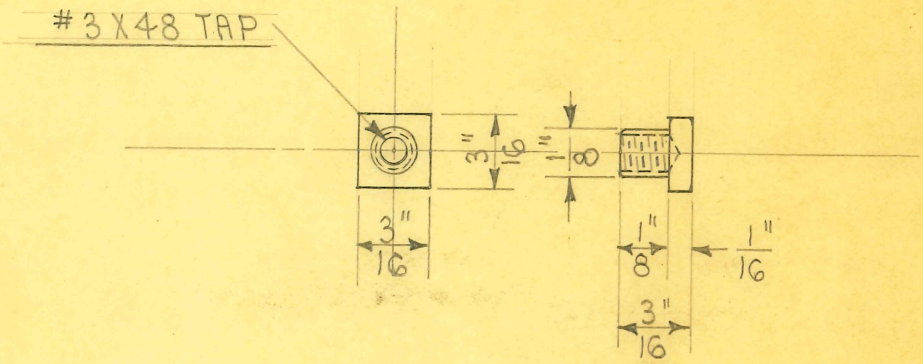

SCALE ≈ 1" = 1/2"

OBSOLETE

SIZE	3/16" SQ.	ISSUE 5-26-36	A.B.
KIND	BRASS ROD	CHANGED	
SHAPE		"	
FINISH		"	
TEMP.		"	
PATT.		"	

TITLE: THOREK COAGULATING ELECTRODE- 3/16" SQUARE END

H. G. FISCHER & CO.
2335 WABANSIA AVE.
CHICAGO, ILL.

CAT. NO.

PART NO. 6950

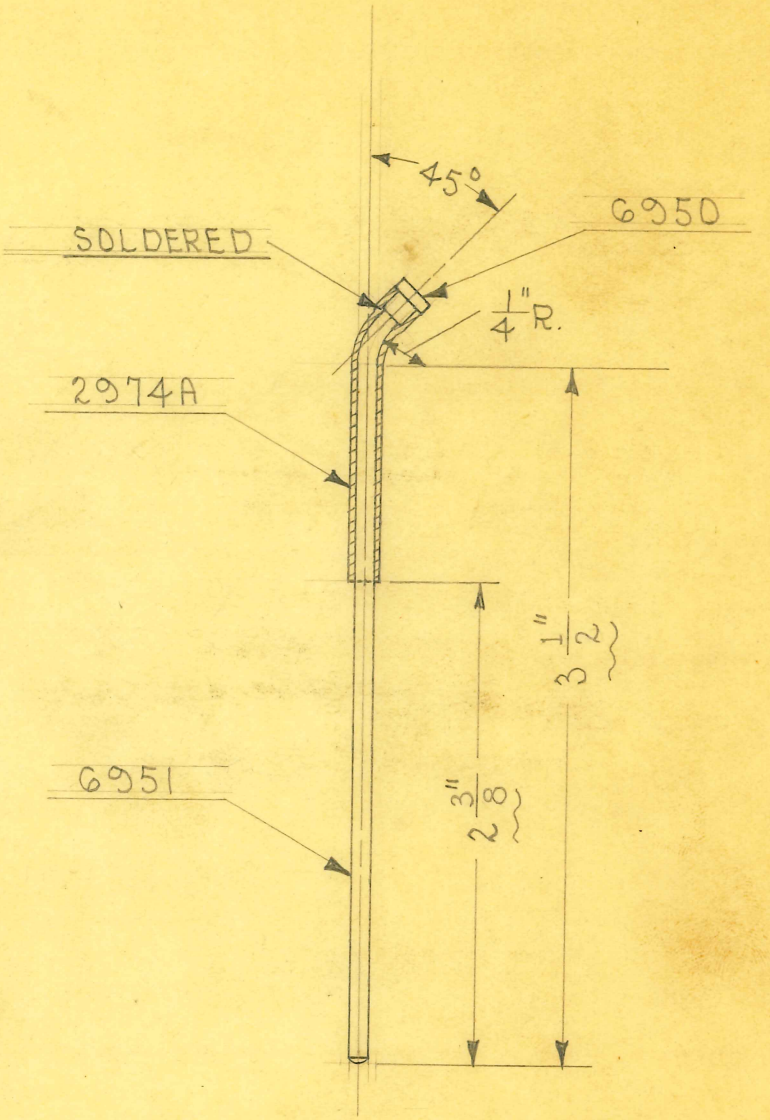

OBSOLETE

SIZE		ISSUE 5-27-36	A.E.
KIND		CHANGED	
SHAPE		"	
FINISH	NICKEL #12	"	
TEMP.	SQ. END ONLY	"	
PATT.		"	

TITLE: THOREK COAGULATING ELECTRODE - 3/16"

H. G. FISCHER & CO.
2335 WABANSIA AVE.
CHICAGO, ILL.

CAT. NO. 2085

PART NO. 6950G

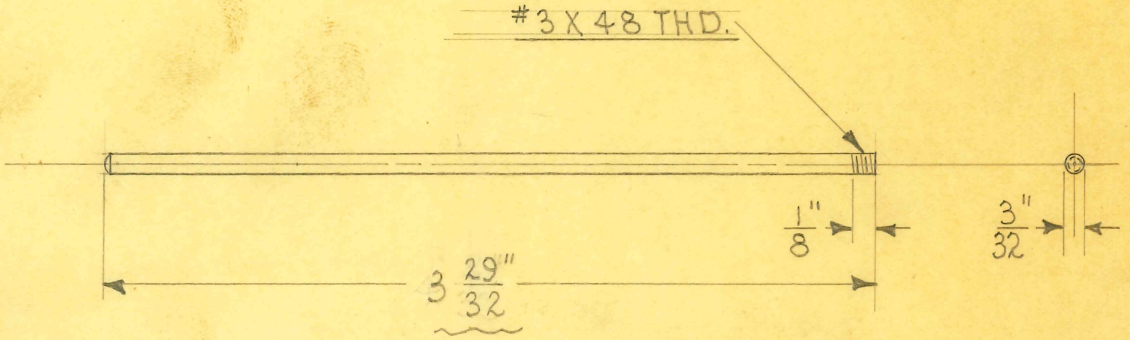

OBSOLETE

SIZE	3/32" DIAM	ISSUE 5-27-36	A.E.
KIND	STAINLESS STEEL	CHANGED	
SHAPE		"	
FINISH		"	
TEMP.		"	
PATT.		"	

TITLE: THOREK COAGULATING ELECTRODE ROD

H. G. FISCHER & CO. 2335 WABANSIA AVE. CHICAGO, ILL.	CAT. NO.	PART NO. 6951

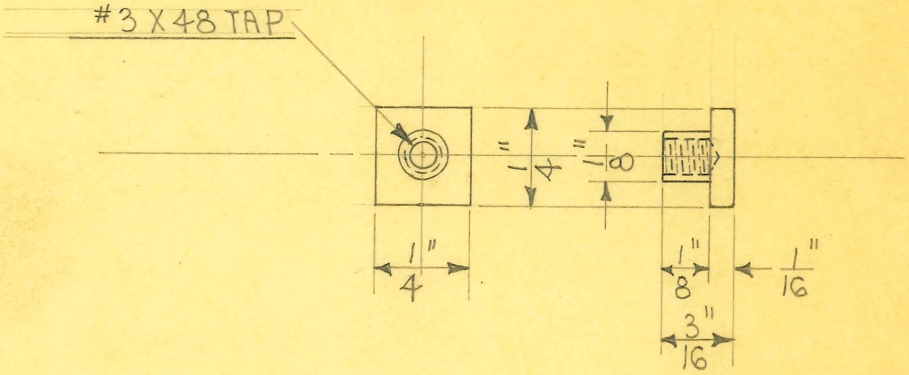

SCALE ~ 1" = 1/2"

OBSOLETE

SIZE	1/4" SQ.	ISSUE 5-27-36	A.E.
KIND	BRASS ROD	CHANGED	
SHAPE		"	
FINISH		"	
TEMP.		"	
PATT.		"	

TITLE: THOREK COAGULATING ELECTRODE - 1/4" SQUARE END

H. G. FISCHER & CO.
2335 WABANSIA AVE.
CHICAGO, ILL.

CAT. NO.

PART NO. 6952

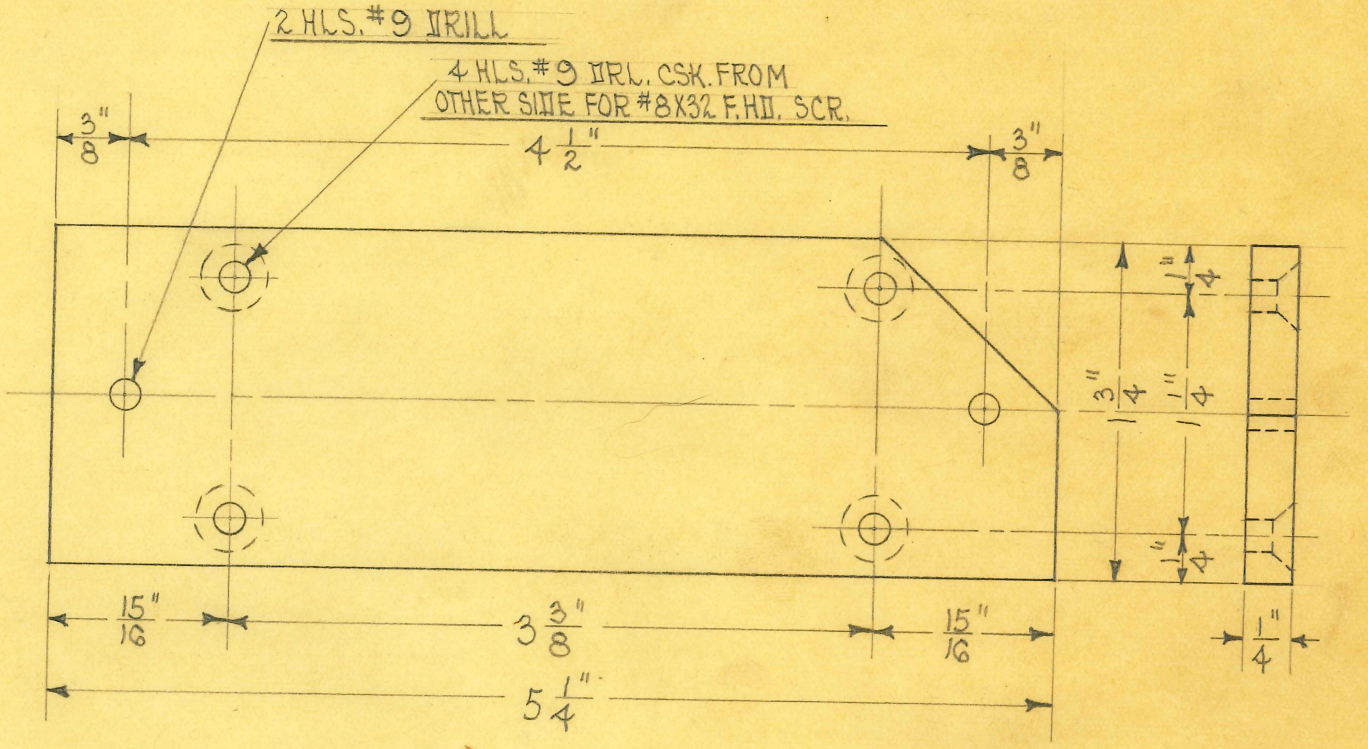

OBSOLETE

SIZE		ISSUE 11-28-32	A.E.	**TITLE:** CUTTING CUR. GEN. FOR MODEL "H" CONV. CLAMP PLATE (UPPER)
KIND	C.R. STEEL	CHANGED		
SHAPE		" "		
FINISH	BLACK DIP	" "		
TEMP.		" "		
PATT.		" "		

H. G. FISCHER & CO.
2335 WABANSIA AVE.
CHICAGO, ILL.

CAT. NO.

PART NO. 7498

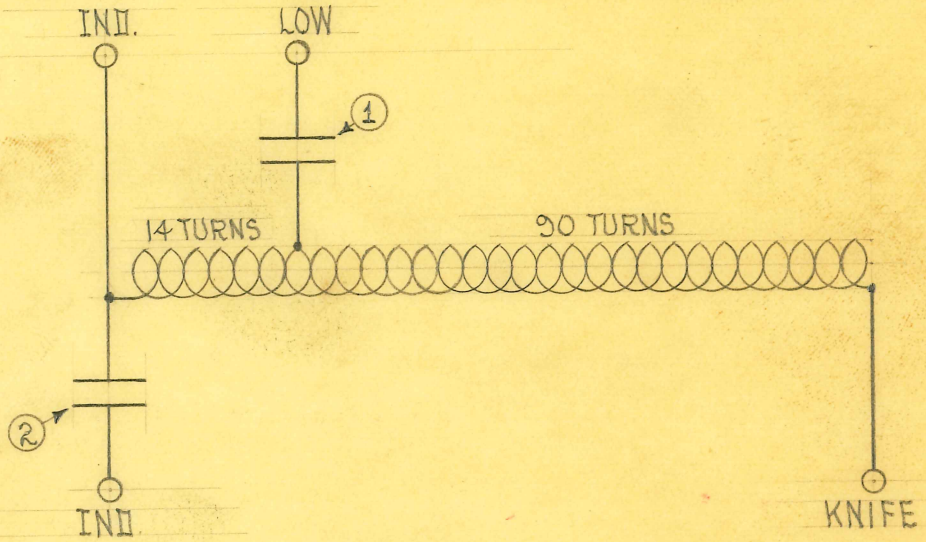

CONDENSER ① - 10-10

CONDENSER ② - 5-5

OBSOLETE

SIZE		ISSUE 11-25-32	A.E.	TITLE: CUTTING CUR. GEN. FOR MODEL "H" WIRING DIAGRAM	
KIND		CHANGED			
SHAPE		" "			
FINISH		" "			
TEMP.		" "		H. G. FISCHER & CO. 2335 WABANSIA AVE. CHICAGO, ILL.	CAT. NO.
PATT.		" "			PART NO. 7494G

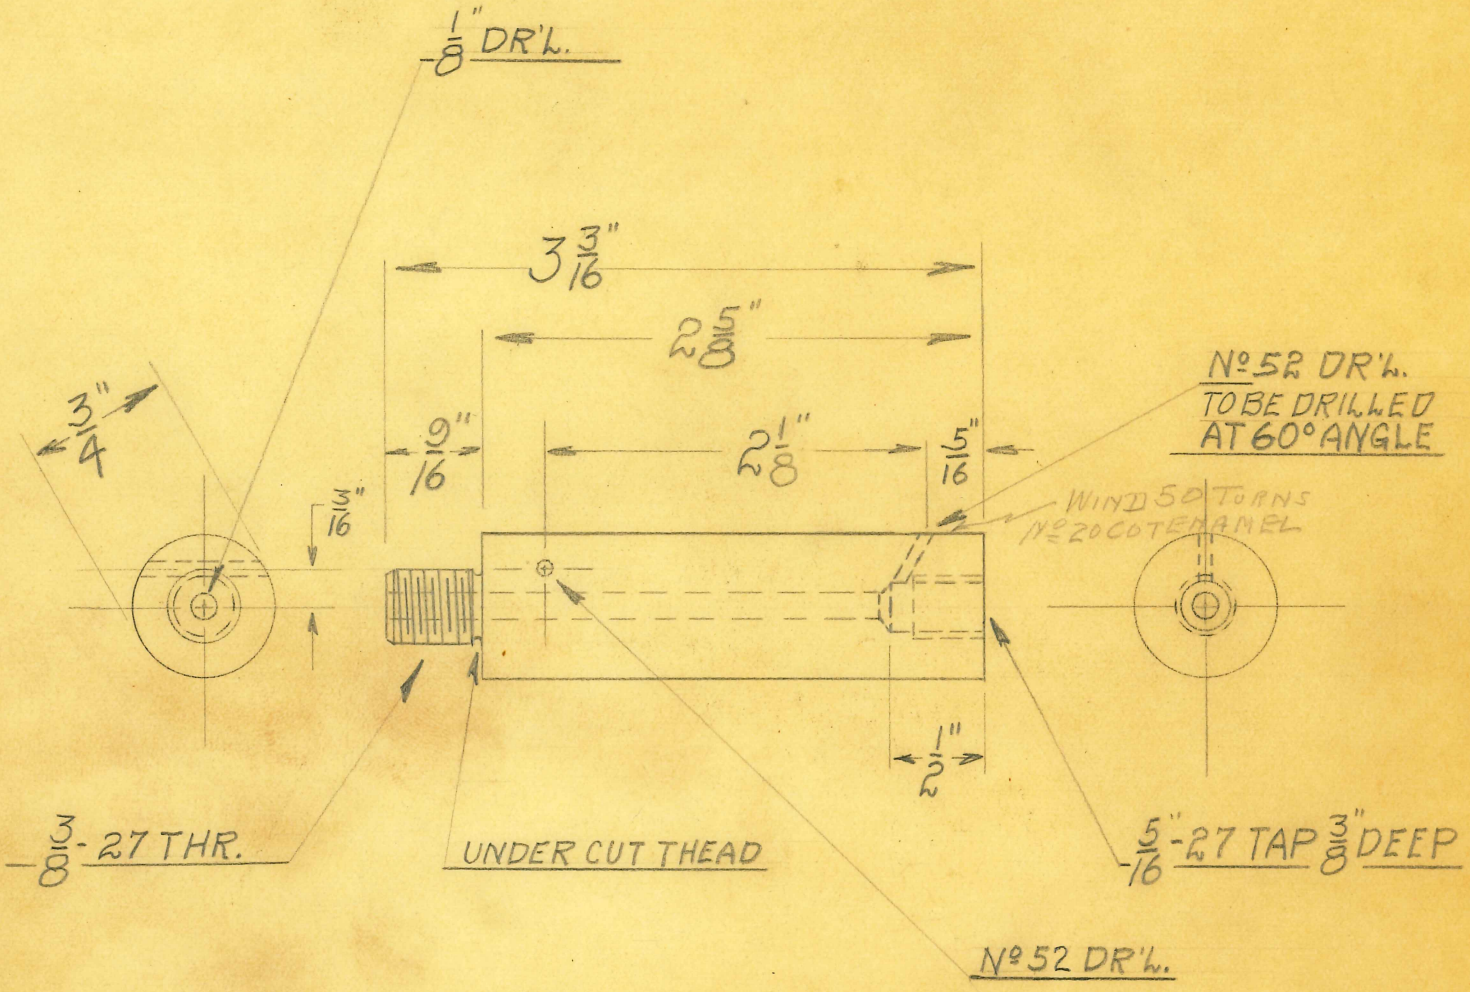

1~ REQ'D.

OBSOLETE

SIZE	3/4"	ISSUE	7-27-32	TITLE: HIGH VOLTAGE COIL PRIMARY CORE		
KIND	BAKELITE ROD	CHANGED				
SHAPE	ROUND	" "				
~~FINISH~~	BLACK "X"	" "				
TEMP.		" "		H. G. FISCHER & CO. 2335 WABANSIA AVE. CHICAGO, ILL.	CAT. NO.	PART NO. 7577
PATT.		" "				

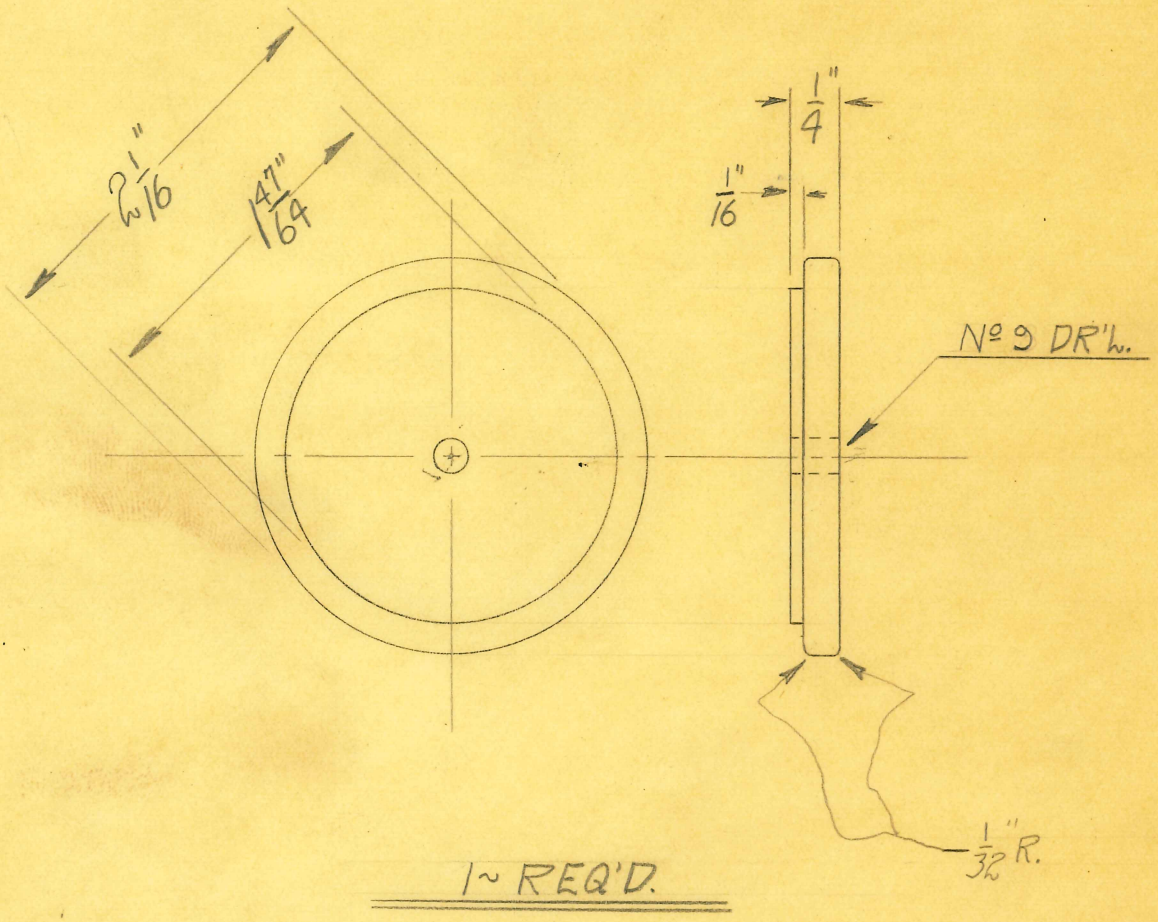

1~ REQ'D.

OBSOLETE

SIZE		ISSUE	7-27-32	TITLE: HIGH VOLTAGE COIL UPPER COLLAR		
KIND	BLACK BAKELITE	CHANGED				
SHAPE		" "				
FINISH		" "				
TEMP.		" "		H. G. FISCHER & CO. 2335 WABANSIA AVE. CHICAGO, ILL.	CAT. NO.	PART NO. 7579
PATT.		" "	Aug.			

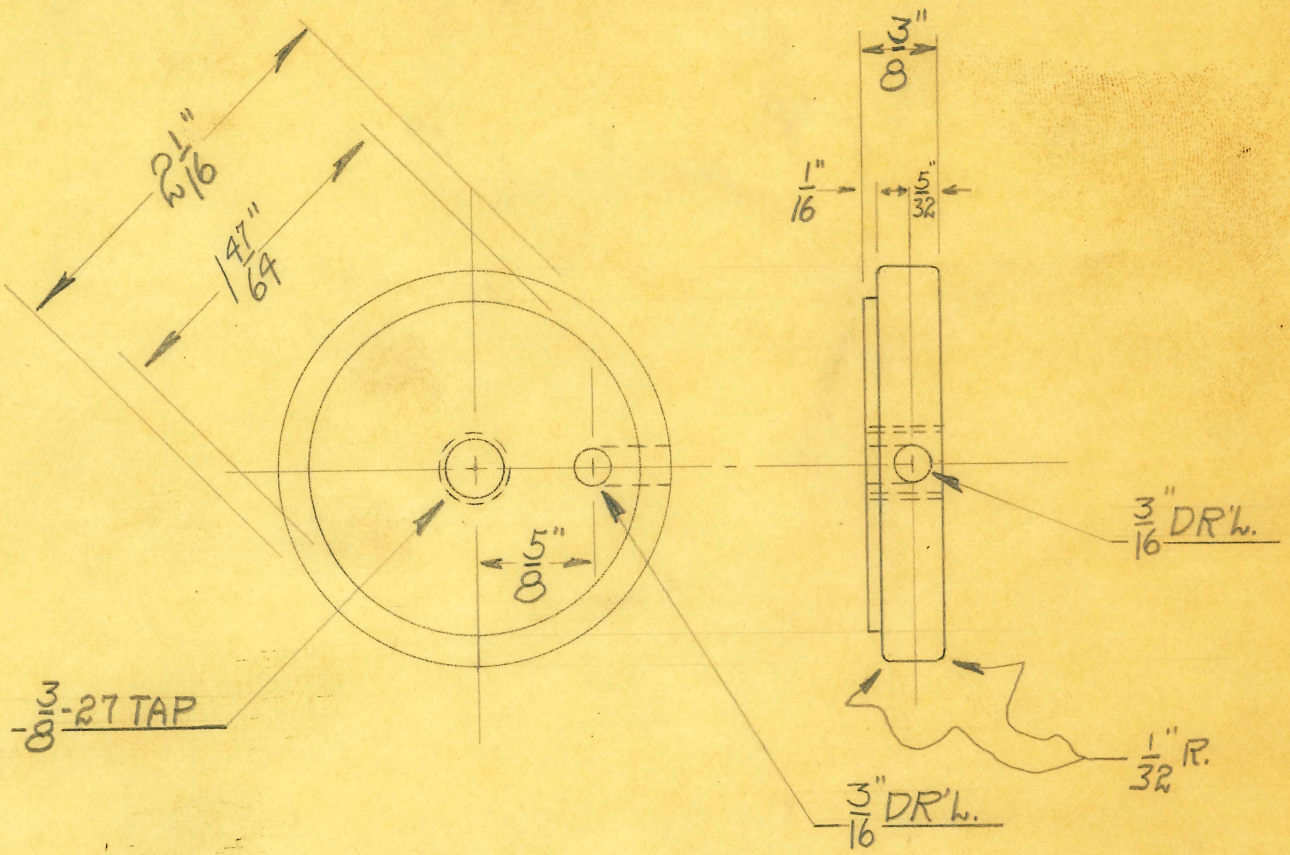

OBSOLETE

SIZE		ISSUE	7-27-32
KIND	BLACK BAKELITE	CHANGED	
SHAPE		" "	
FINISH		" "	
TEMP.		" "	
PATT.		" "	AR.

TITLE: HIGH VOLTAGE COIL LOWER COLLAR

H. G. FISCHER & CO.
2335 WABANSIA AVE.
CHICAGO, ILL.

CAT. NO.

PART NO. 7579½

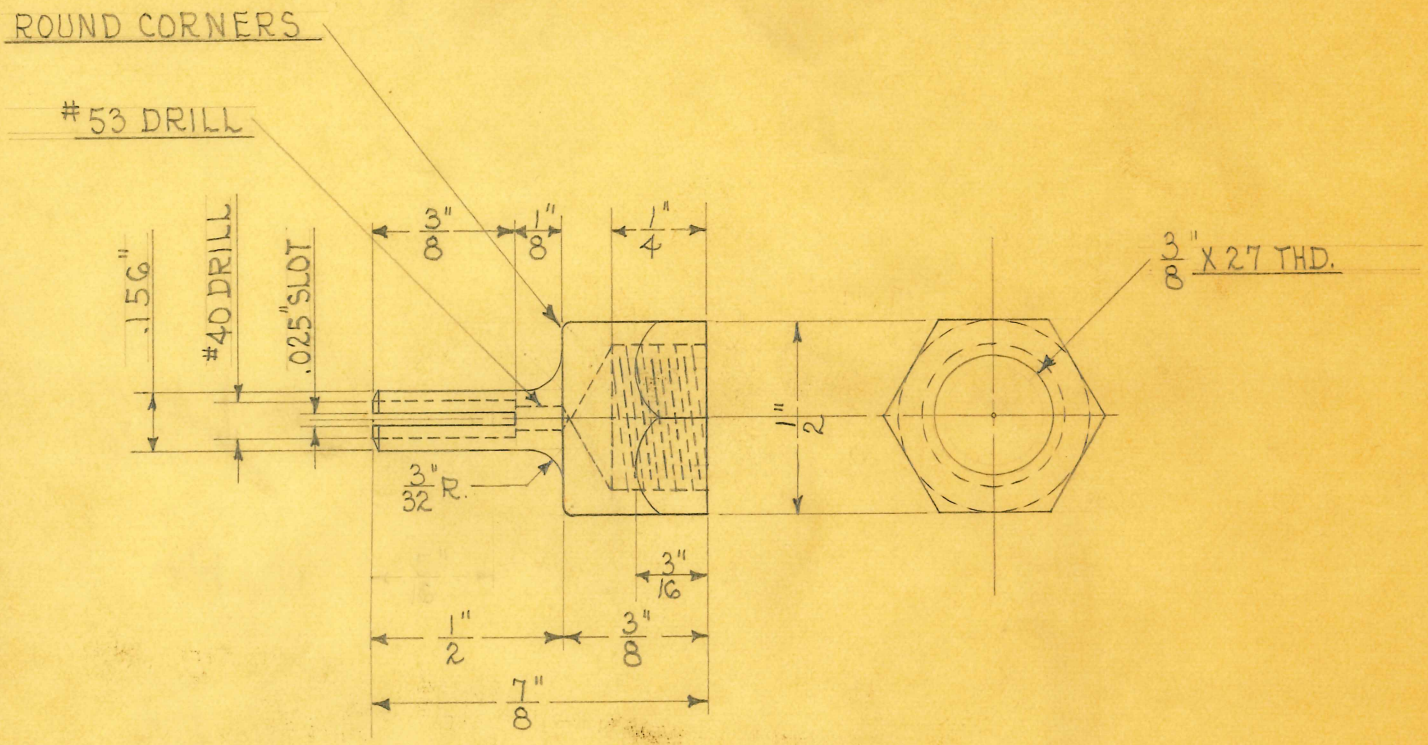

1 REQUIRED

SCALE ÷ 2 DIAMETERS

OBSOLETE

SIZE	1/2" HEX.	ISSUE 10-6-33	A.E.
KIND	BRASS ROD	CHANGED	
SHAPE		" "	
FINISH	N.P.	" "	
TEMP.		" "	
PATT.		" "	

TITLE: HIGH VOLTAGE COIL TIP

H. G. FISCHER & CO.
2335 WABANSIA AVE.
CHICAGO, ILL.

CAT. NO.

PART NO. 7581

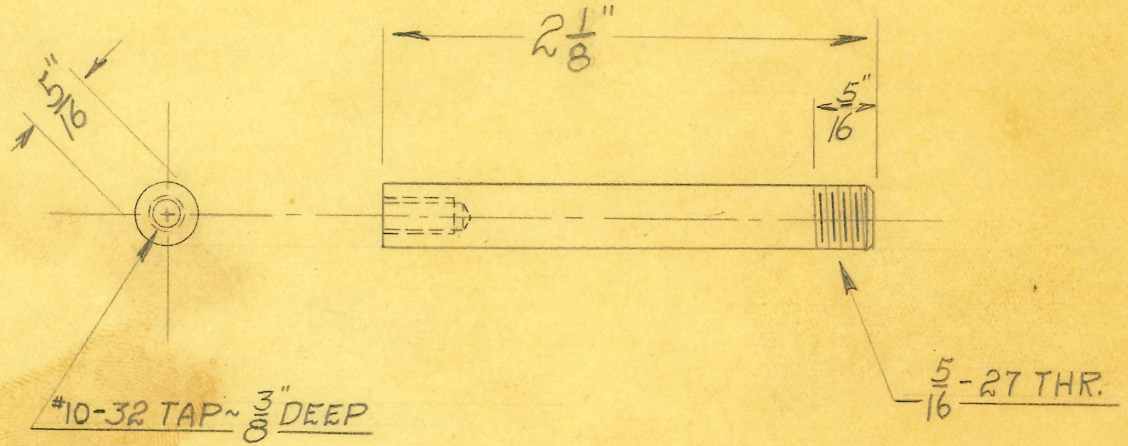

1~ REQ'D.

OBSOLETE

SIZE	5/16" DIA.	ISSUE	7-27-32	TITLE: HIGH VOLTAGE COIL EXTENSION ROD		
KIND	HD. RUBBER	CHANGED				
SHAPE	ROUND	" "				
~~FINISH~~	BLACK	" "				
TEMP.		" "		H. G. FISCHER & CO. 2335 WABANSIA AVE. CHICAGO, ILL.	CAT. NO.	PART NO. 7580
PATT.		" "				

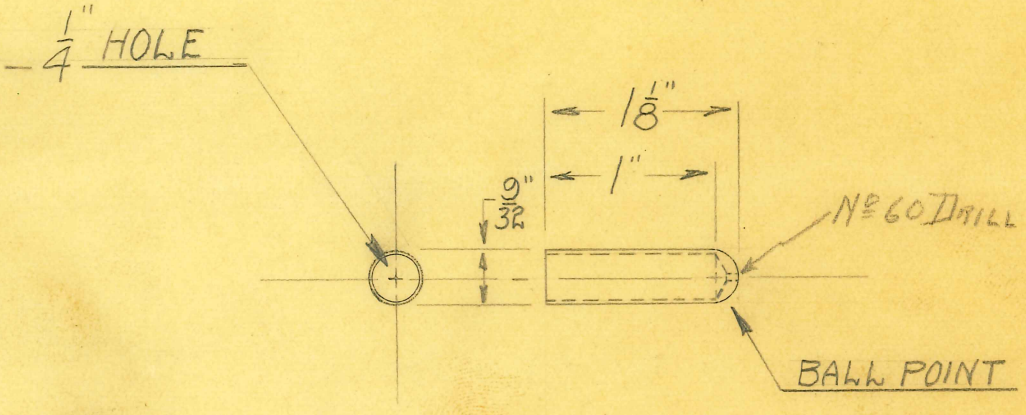

1~REQ'D.

OBSOLETE

SIZE	9/32"	ISSUE	7-27-32	TITLE: HIGH VOLTAGE FULG. ELECT. GLASS ELECTRODE CAP
KIND	BRASS	CHANGED		
SHAPE	ROD	" "		
FINISH	CAD. #23	" "		
TEMP.		" "		H. G. FISCHER & CO. 2335 WABANSIA AVE. CHICAGO, ILL. — CAT. NO. — PART NO. 7591
PATT.		" "	Ord.	

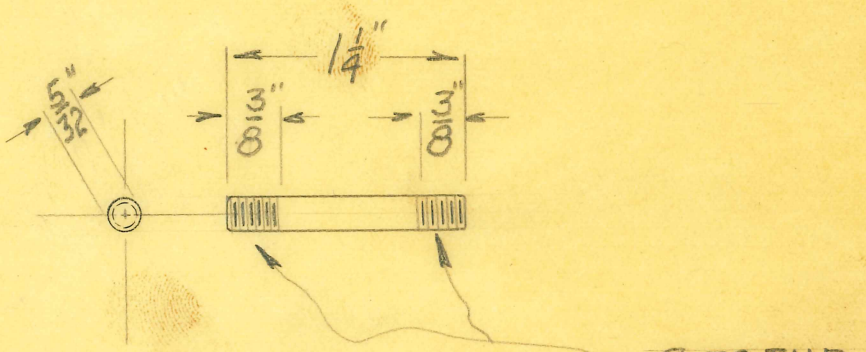

1~ REQ'D.

OBSOLETE

SIZE	5/32" X 1 1/4"	ISSUE	7-28-32
KIND	BRASS	CHANGED	
SHAPE	ROUND	" "	
FINISH		" "	
TEMP.		" "	
PATT.		" "	Ref.

TITLE: HIGH VOLTAGE FULGURATION ELECT. HANDLE CONN. ROD

H. G. FISCHER & CO.
2335 WABANSIA AVE.
CHICAGO, ILL.

CAT. NO.

PART NO. 7589

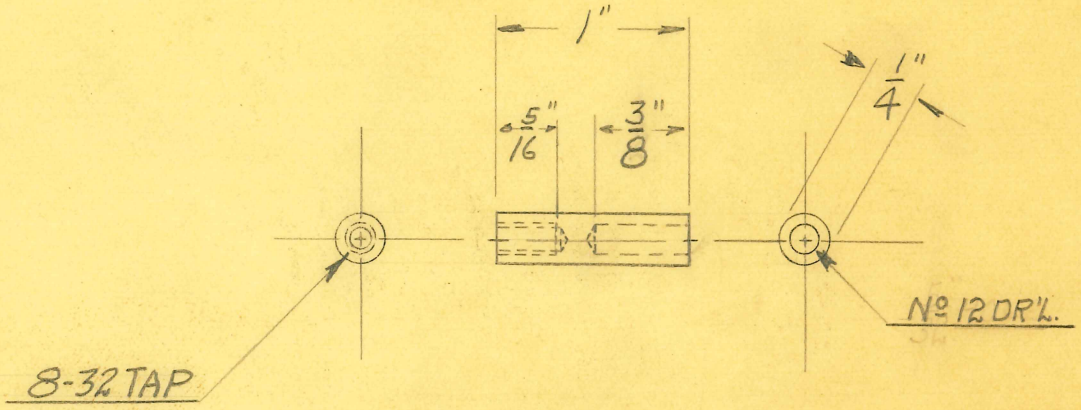

1~REQ'D.

OBSOLETE

SIZE	1/4" X 1"	ISSUE	7-28-32	TITLE: HIGH VOLTAGE FULGURATION ELECT. HANDLE CORD CONN.		
KIND	BRASS	CHANGED				
SHAPE	ROUND	" "				
FINISH		" "				
TEMP.		" "		H. G. FISCHER & CO. 2335 WABANSIA AVE. CHICAGO, ILL.	CAT. NO.	PART NO. 7588
PATT.		" "	A.P.			

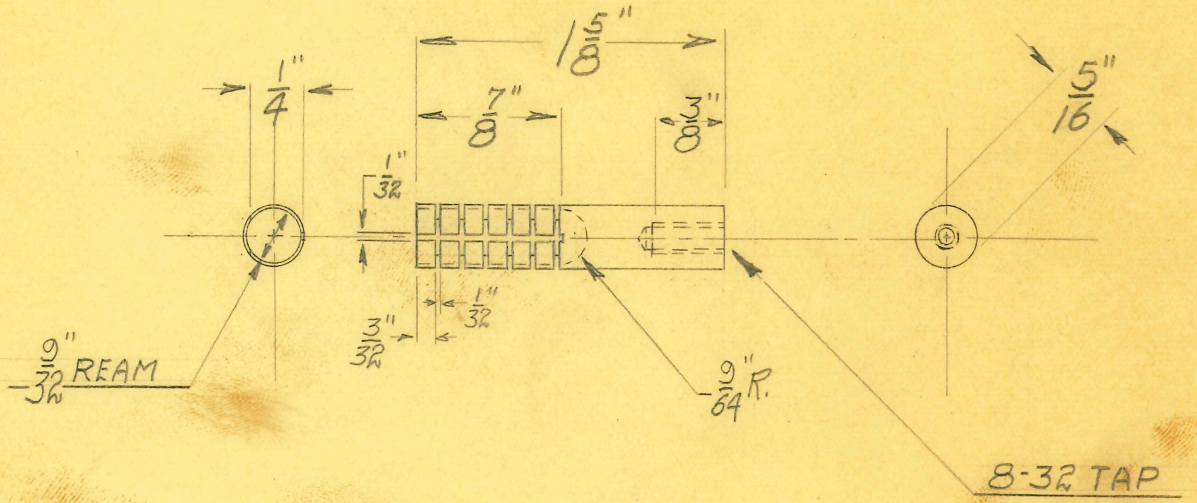

1-REQ'D.

OBSOLETE

SIZE	5/16" X 1 5/8"	ISSUE	7-28-32	TITLE: HIGH VOLTAGE FULGURATION ELECT. HANDLE CHUCK
KIND	BRASS	CHANGED		
SHAPE	ROUND	" "		
FINISH		" "		
TEMP.		" "		
PATT.		" "	Ayp.	

H. G. FISCHER & CO.
2335 WABANSIA AVE.
CHICAGO, ILL.

CAT. NO.

PART NO. 7587

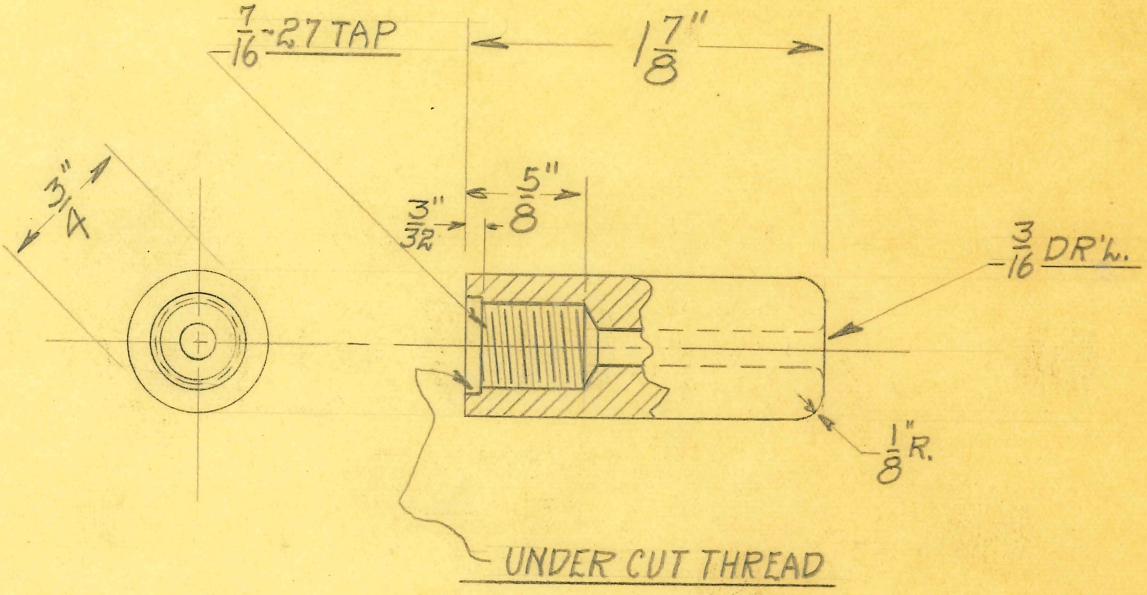

1~REQ'D.

OBSOLETE

SIZE	3/4"	ISSUE	7-28-32
KIND	H. RUBBER	CHANGED	
SHAPE	ROUND	" "	
~~FINISH~~	BLACK	" "	
TEMP.		" "	
PATT.		" "	AP

TITLE: HIGH VOLTAGE FULGURATION ELECT. HANDLE CAP

H. G. FISCHER & CO.
2335 WABANSIA AVE.
CHICAGO, ILL.

CAT. NO.

PART NO. 7586

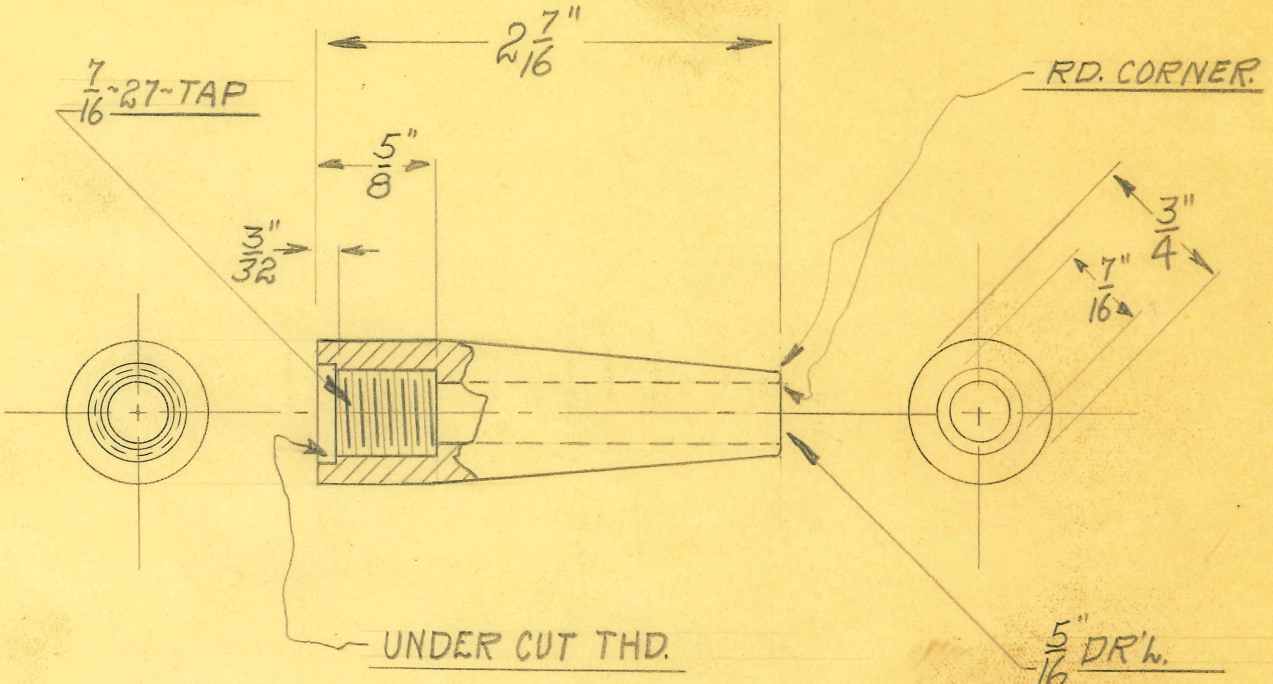

1-REQ'D.

OBSOLETE

SIZE	3/4"	ISSUE	7-28-32	TITLE: HIGH VOLTAGE FULGURATION ELECT. HANDLE TIP
KIND	H. RUBBER	CHANGED		
SHAPE	ROUND	" "		
~~FINISH~~	BLACK	" "		
TEMP.		" "		H. G. FISCHER & CO. 2335 WABANSIA AVE. CHICAGO, ILL. — CAT. NO. — PART NO. 7585
PATT.		" "	Orig.	

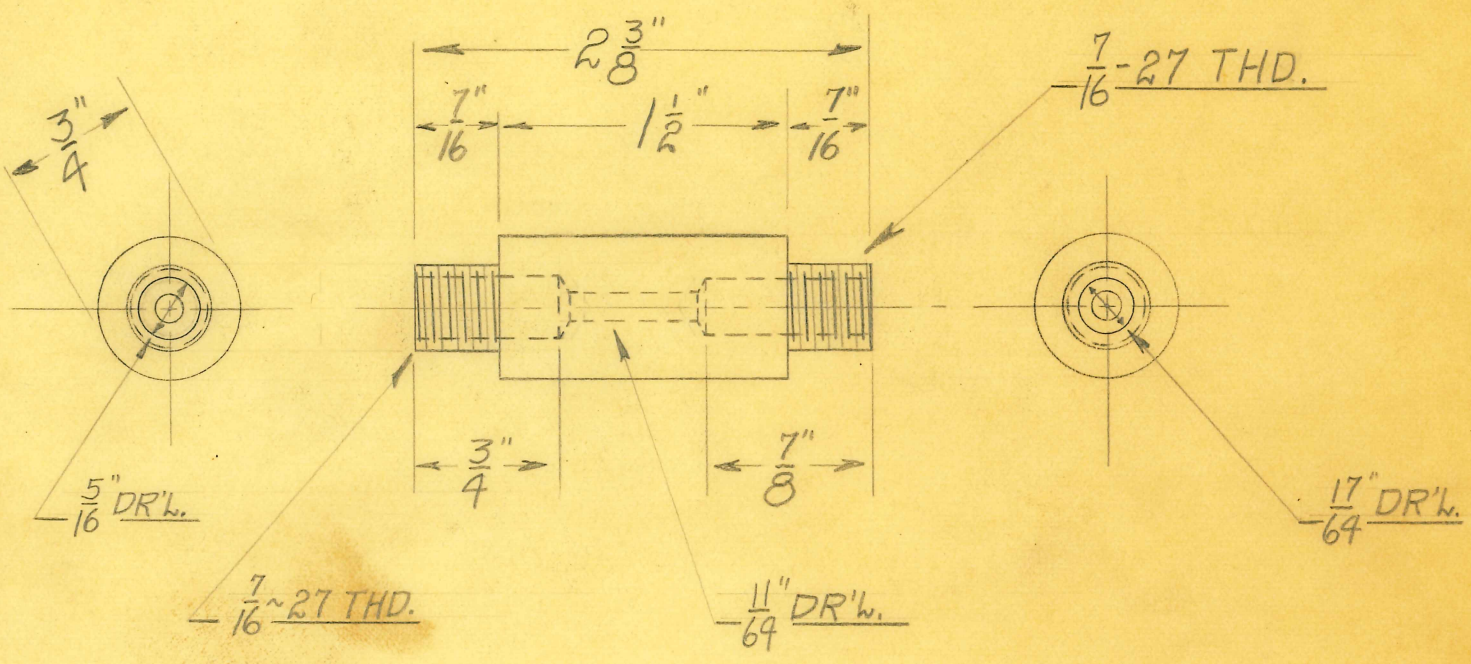

1 - REQ'D.

OBSOLETE

SIZE	3/4"	ISSUE	7-28-32	TITLE: HIGH VOLTAGE FULGURATION ELECT. HANDLE BODY	
KIND	H. RUBBER	CHANGED			
SHAPE	ROUND	" "			
~~FINISH~~	BLACK	" "			
TEMP.		" "		H. G. FISCHER & CO. 2335 WABANSIA AVE. CHICAGO, ILL.	CAT. NO.
PATT.		" "			PART NO. 7584

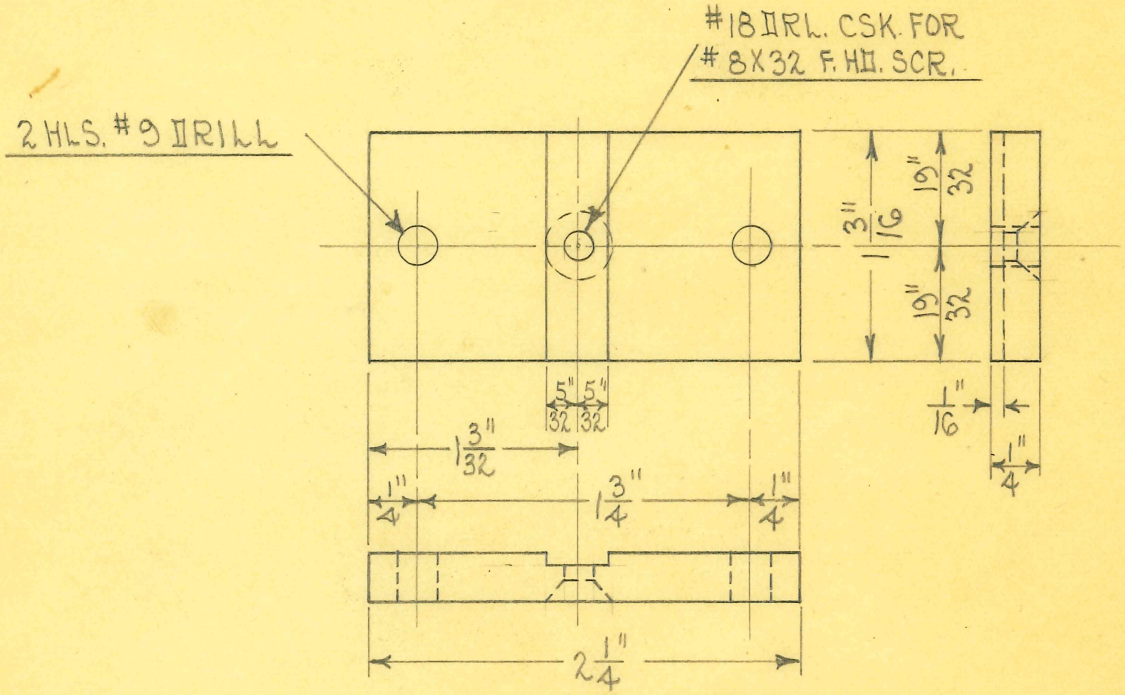

1 REQUIRED

OBSOLETE

SIZE		ISSUE 5-5-32	H.E.
KIND	BRASS	CHANGED	
SHAPE		" "	
FINISH	COPPER PLATED	" "	
TEMP.		" "	
PATT.		" "	

TITLE: LARGE SIZE FIXED GAP BASE

H. G. FISCHER & CO.
2335 WABANSIA AVE.
CHICAGO, ILL.

CAT. NO.

PART NO. 7306

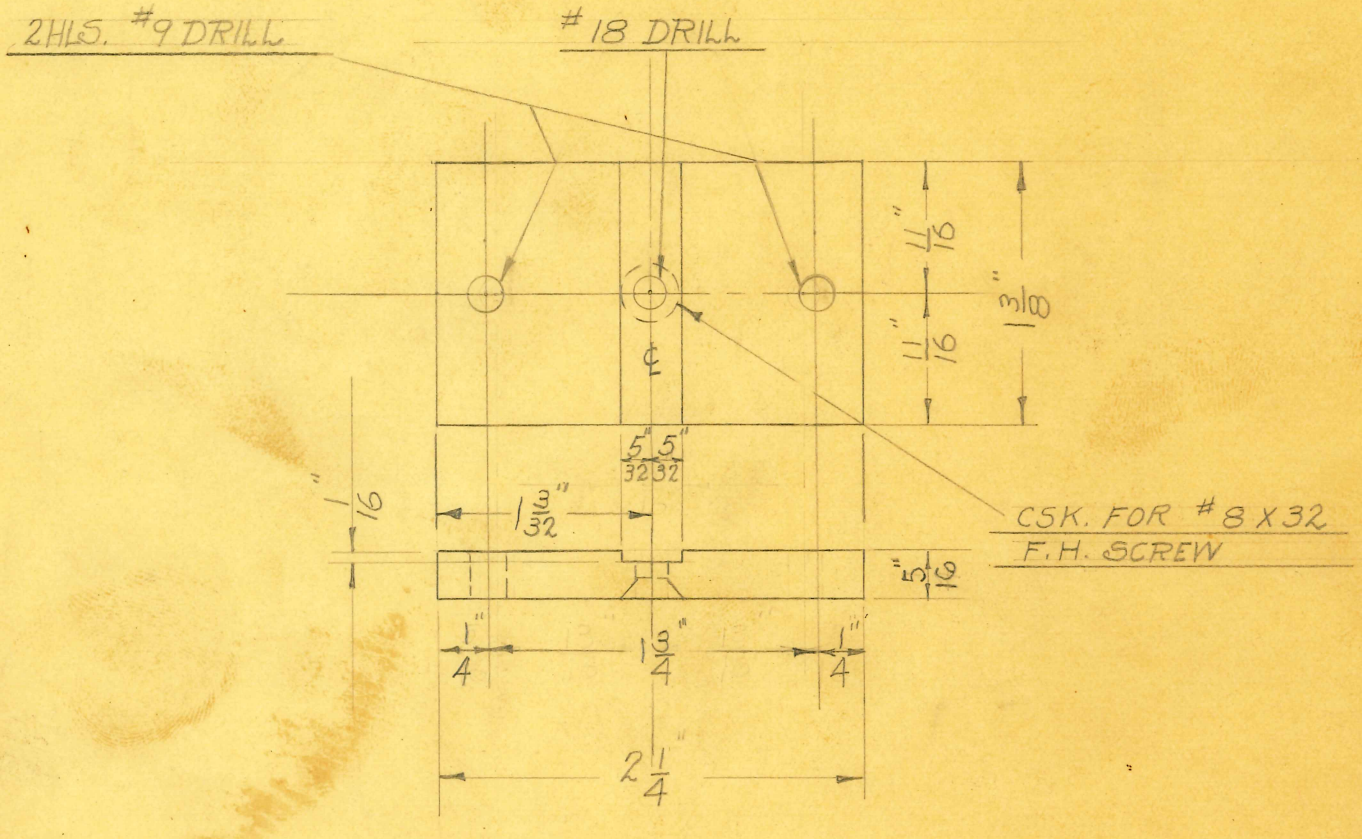

OBSOLETE

SIZE		ISSUE 9-6-33	N.P.
KIND	BRASS	CHANGED	
SHAPE		" "	
FINISH		" "	
TEMP.		" "	
PATT.		" "	

TITLE: LARGE SIZE FIXED GAP BASE FOR EXTRA SIZE TIP

H. G. FISCHER & CO.
2335 WABANSIA AVE.
CHICAGO, ILL.

CAT. NO.

PART NO. 7306A

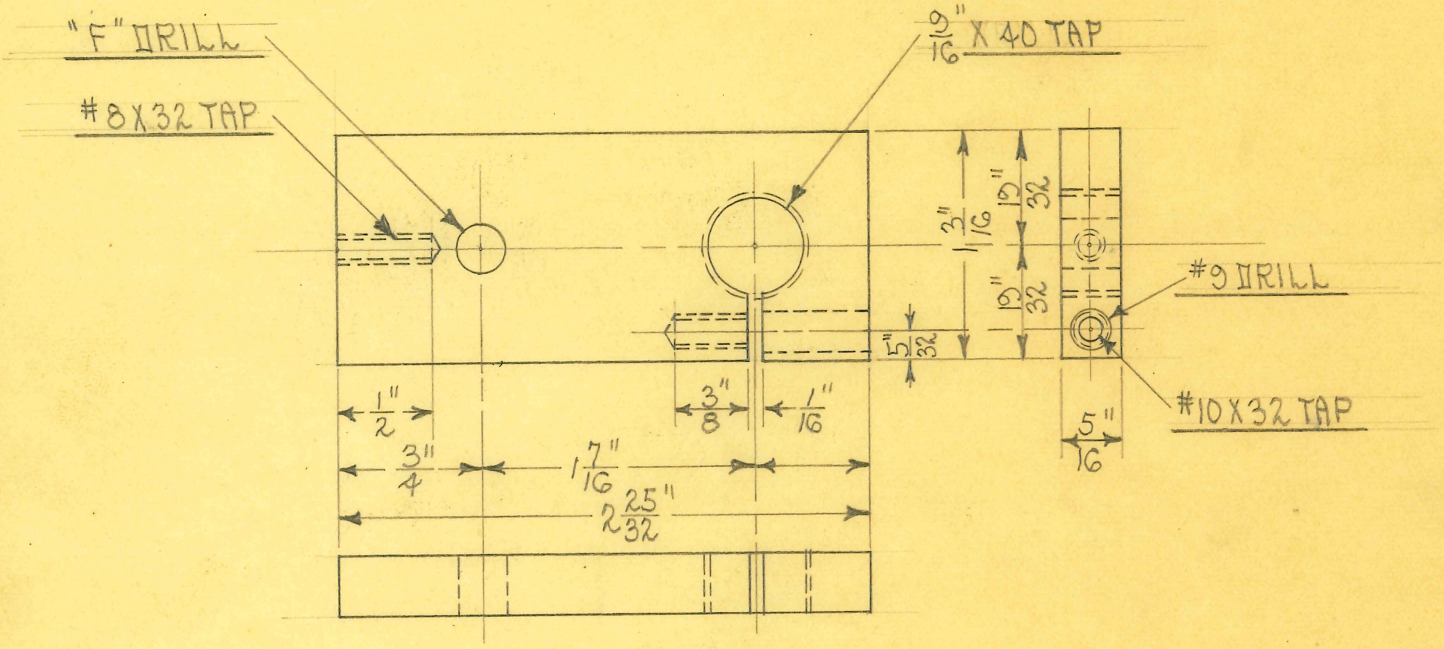

1 REQUIRED

OBSOLETE

SIZE		ISSUE 5-5-32	A.E.	TITLE: LARGE SIZE FIXED GAP SUPPORT (LONG)
KIND	BRASS	CHANGED		
SHAPE		" "		
FINISH	COPPER PLATED	" "		
TEMP.		" "		H. G. FISCHER & CO. 2335 WABANSIA AVE. CHICAGO, ILL. / CAT. NO. / PART NO. 7307
PATT.		" "		

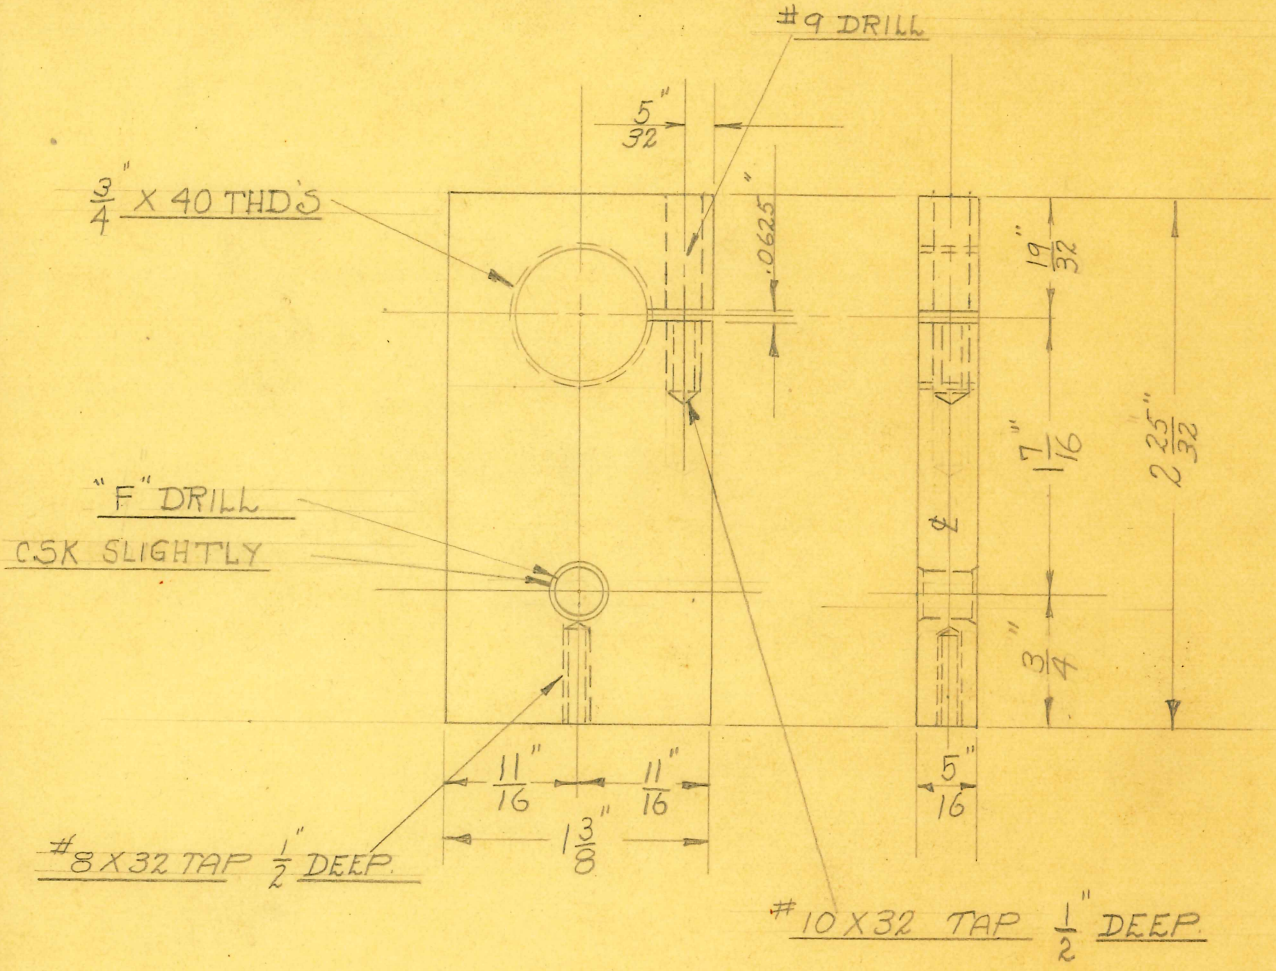

OBSOLETE

SIZE		ISSUE 9-6-33	N.P.
KIND	BRASS	CHANGED	
SHAPE		" "	
FINISH		" "	
TEMP.		" "	
PATT.		" "	

TITLE: LARGE SIZE FIXED GAP SUPPORT (LONG) FOR EXTRA SIZE TIP.

H. G. FISCHER & CO.
2335 WABANSIA AVE.
CHICAGO, ILL.

CAT. NO.

PART NO. 7307A

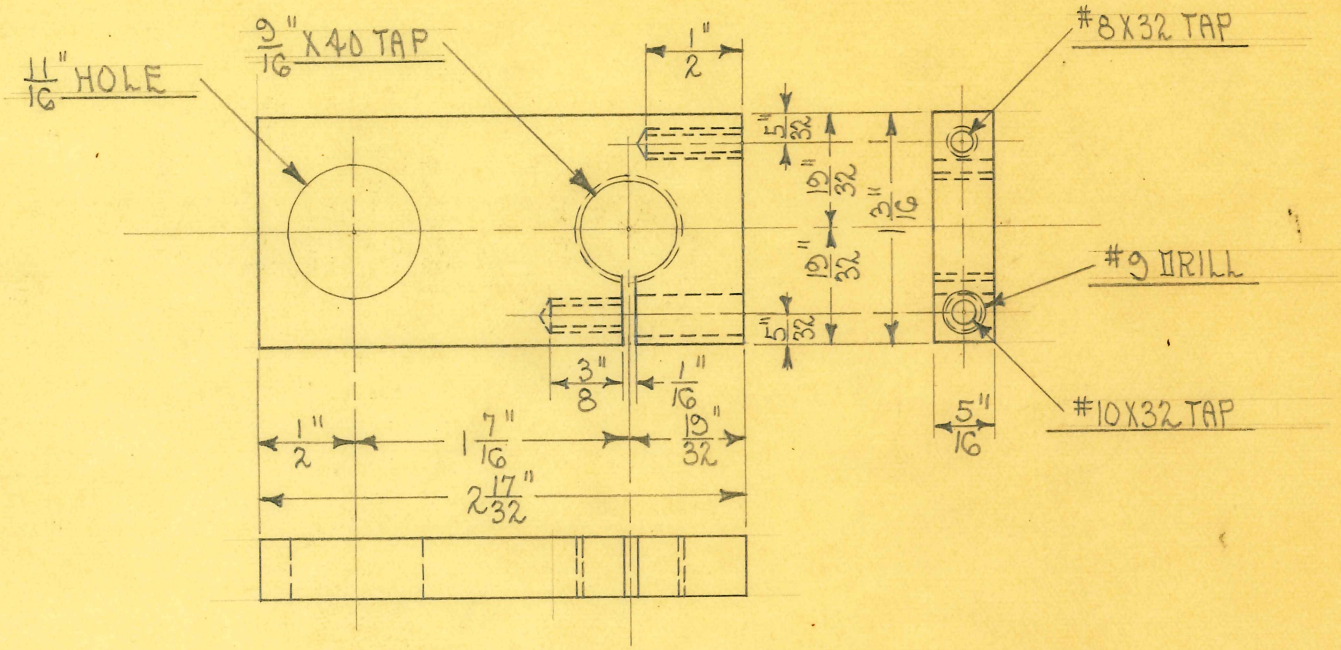

1 REQUIRED

OBSOLETE

SIZE		ISSUE 5-5-32	A.E.
KIND	BRASS	CHANGED	
SHAPE		" "	
FINISH	COPPER PLATED	" "	
TEMP.		" "	
PATT.		" "	

TITLE: LARGE SIZE FIXED GAP SUPPORT (SHORT)

H. G. FISCHER & CO.
2335 WABANSIA AVE.
CHICAGO, ILL.

CAT. NO.

PART NO. 7307 1/2

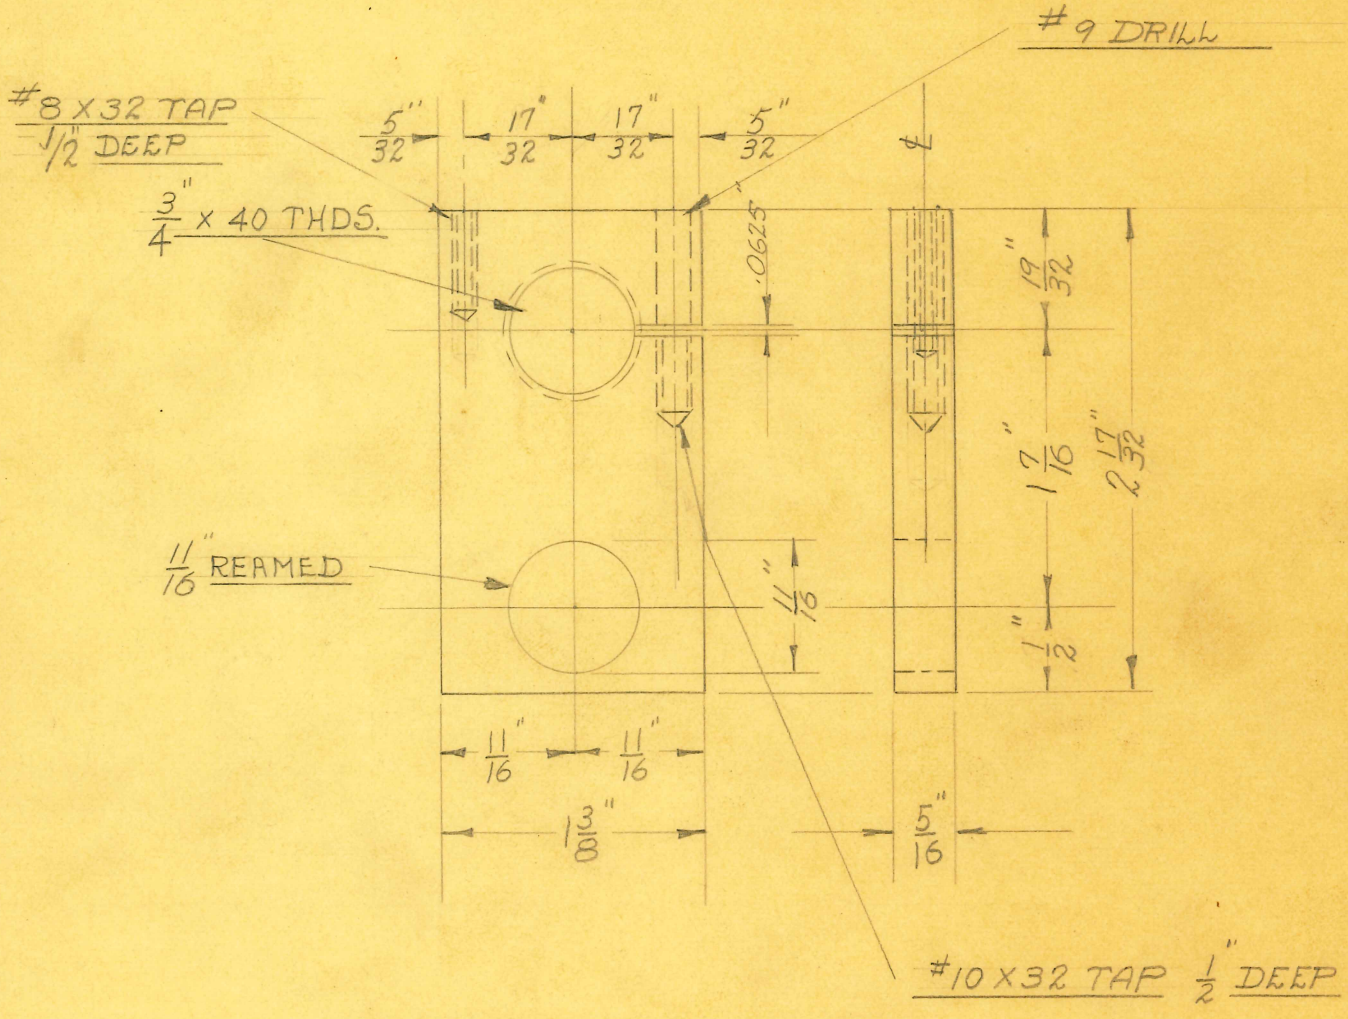

OBSOLETE

SIZE		ISSUE 9-6-33	N. P.	TITLE: LARGE SIZE FIXED GAP SUPPORT (SHORT) FOR EXTRA SIZE TIP.		
KIND	BRASS	CHANGED				
SHAPE		" "				
FINISH		" "				
TEMP.		" "		H. G. FISCHER & CO. 2335 WABANSIA AVE. CHICAGO, ILL.	CAT. NO.	PART NO. 7307½A
PATT.		" "				

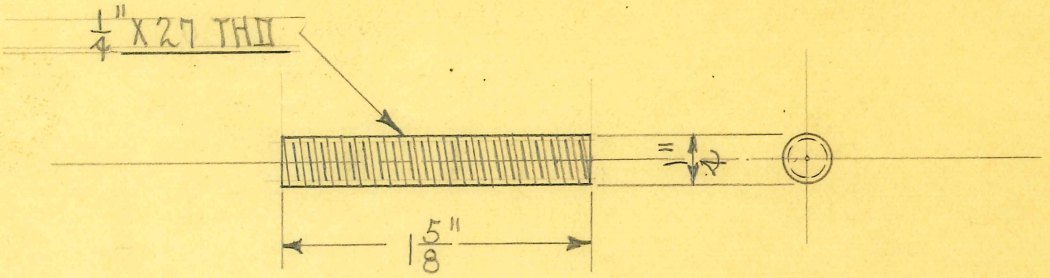

1 REQUIRED

OBSOLETE

SIZE	1/4"	ISSUE 5-6-32	A.E.	TITLE: LARGE SIZE FIXED GAP STUD		
KIND	BRASS ROD	CHANGED				
SHAPE		" "				
FINISH		" "				
TEMP.		" "		H. G. FISCHER & CO. 2335 WABANSIA AVE. CHICAGO, ILL.	CAT. NO.	PART NO. 7308
PATT.		" "				

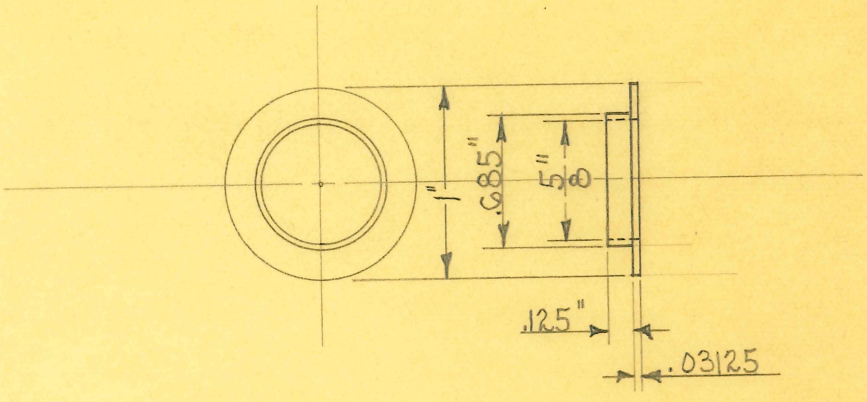

1 REQUIRED

OBSOLETE

SIZE	1"	ISSUE 5-5-32	A.E.
KIND	BRASS ROD	CHANGED	
SHAPE		" "	
FINISH		" "	
TEMP.		" "	
PATT.		" "	

TITLE: LARGE SIZE FIXED GAP FLANGED WASHER-LIGHT

H. G. FISCHER & CO.
2335 WABANSIA AVE.
CHICAGO, ILL.

CAT. NO.

PART NO. 7309

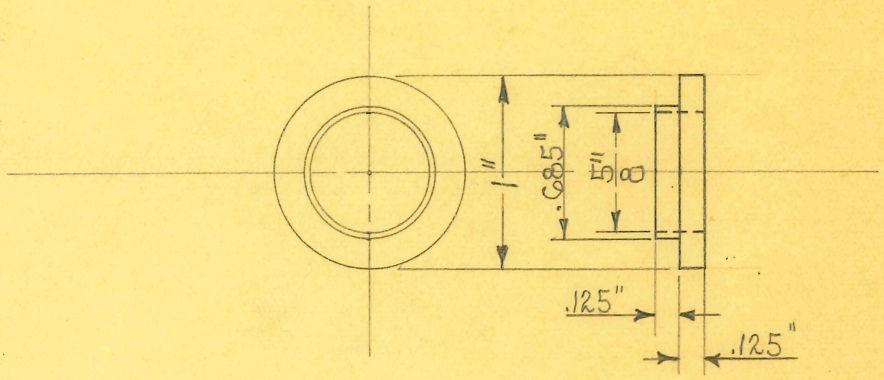

1 REQUIRED

OBSOLETE

SIZE	1"	ISSUE 5-5-32	A.E.	**TITLE:** LARGE SIZE FIXED GAP FLANGED WASHER-HEAVY
KIND	BRASS ROD	CHANGED		
SHAPE		" "		
FINISH	COPY LATER	" "		
TEMP.		" "		H. G. FISCHER & CO. 2335 WABANSIA AVE. CHICAGO, ILL.
PATT.		" "		CAT. NO.
				PART NO. 7309 1/2

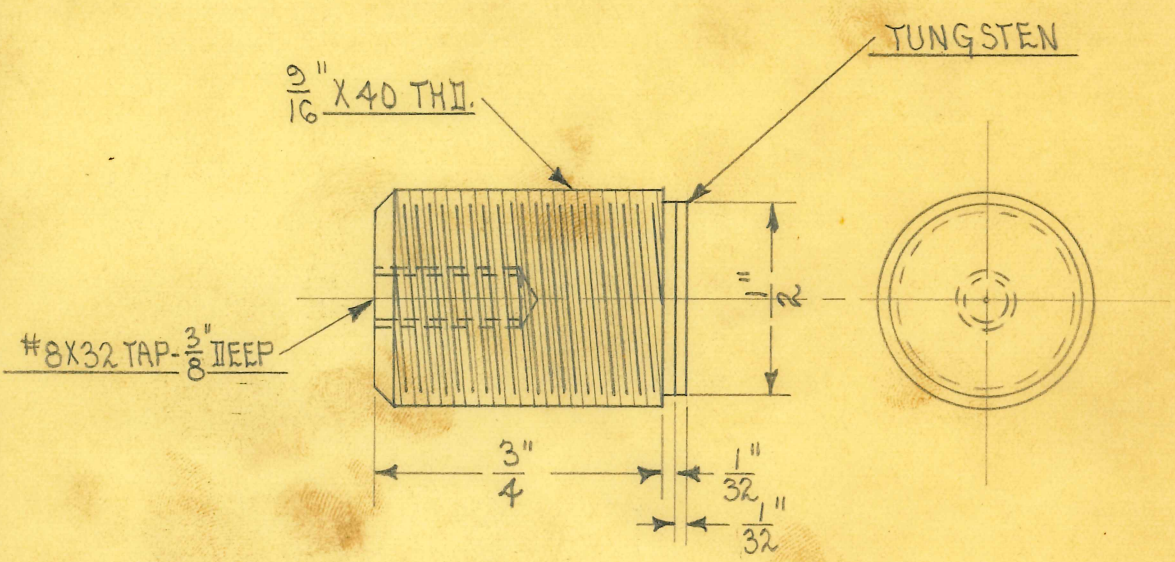

SCALE ½ DOUBLE SIZE

OBSOLETE

SIZE		ISSUE 4-25-32	A.E.	TITLE: LARGE SIZE FIXED GAP TUNGSTEN TIP		
KIND		CHANGED				
SHAPE		" "				
FINISH		" "				
TEMP.		" "		H. G. FISCHER & CO. 2335 WABANSIA AVE. CHICAGO, ILL.	CAT. NO.	PART NO. 7310GF
PATT.		" "				

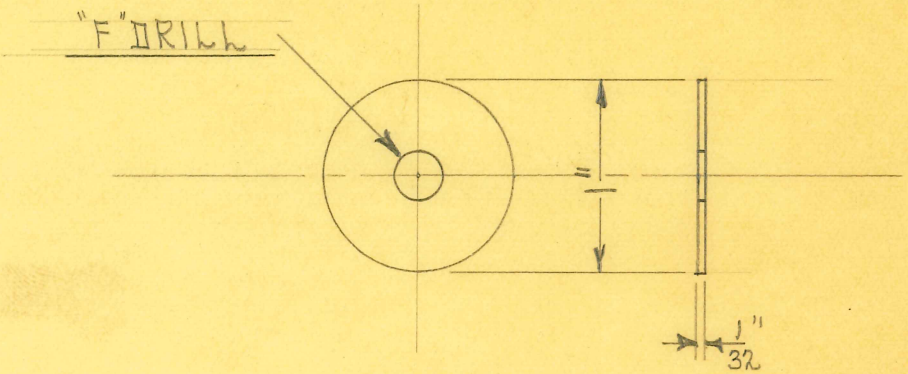

1 REQUIRED

OBSOLETE

SIZE	1/32"	ISSUE 5-5-32	H.E.	**TITLE:** LARGE SIZE FIXED GAP WASHER - 1/32"
KIND	SHEET BRASS	CHANGED		
SHAPE		" "		
FINISH		" "		
TEMP.		" "		H. G. FISCHER & CO. 2335 WABANSIA AVE. CHICAGO, ILL. — CAT. NO. — PART NO. 7311
PATT.		" "		

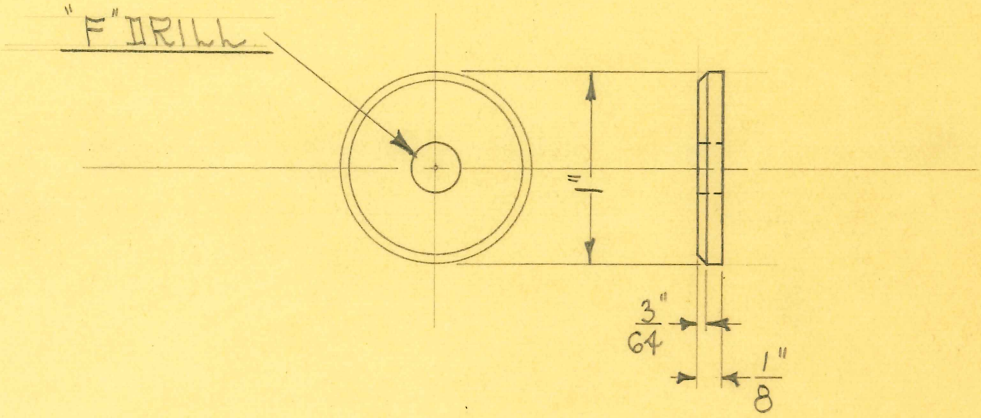

1 REQUIRED

OBSOLETE

SIZE	1"	ISSUE 5-5-32	A.E.	TITLE: LARGE SIZE FIXED GAP CLAMP WASHER-LARGE		
KIND	BRASS ROD	CHANGED				
SHAPE		" "				
FINISH		" "				
TEMP.		" "		H. G. FISCHER & CO. 2335 WABANSIA AVE. CHICAGO, ILL.	CAT. NO.	PART NO. 7312
PATT.		" "				

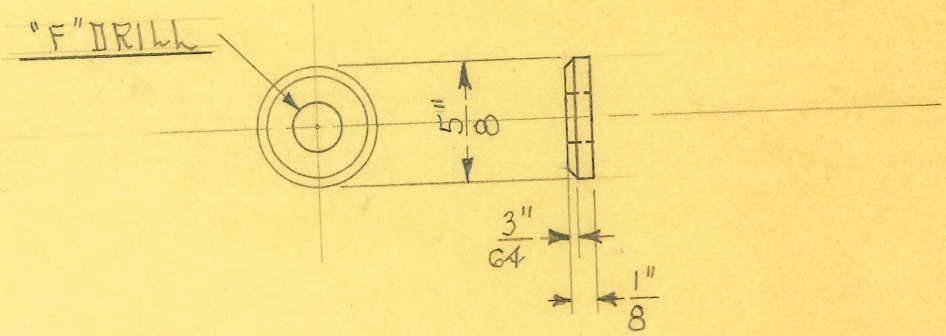

1 REQUIRED

OBSOLETE

SIZE	5/8"	ISSUE 5-6-32	J.E.	**TITLE:** LARGE SIZE FIXED GAP CLAMP WASHER-SMALL
KIND	BRASS ROD	CHANGED		
SHAPE		" "		
FINISH		" "		
TEMP.		" "		H. G. FISCHER & CO. 2335 WABANSIA AVE. CHICAGO, ILL. — CAT. NO. — PART NO. 7313
PATT.		" "		

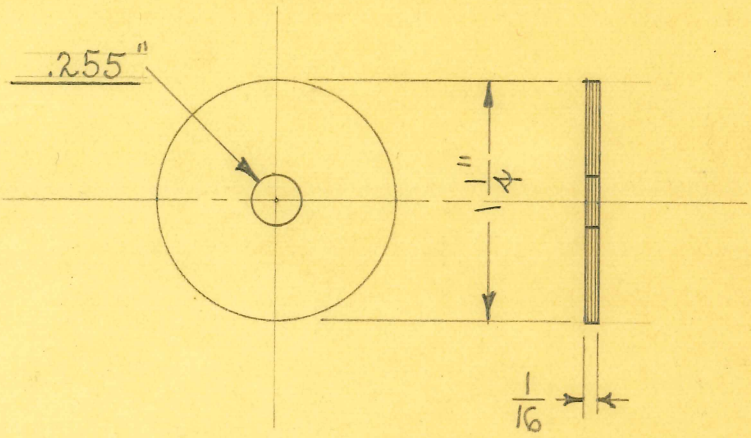

2 REQUIRED

OBSOLETE

SIZE		ISSUE 5-6-32	J.E.	TITLE: LARGE SIZE FIXED GAP MICA WASHER		
KIND	MICA	CHANGED				
SHAPE		" "				
FINISH		" "				
TEMP.		" "		H. G. FISCHER & CO. 2335 WABANSIA AVE. CHICAGO, ILL.	CAT. NO.	PART NO. 7314F
PATT.		" "				

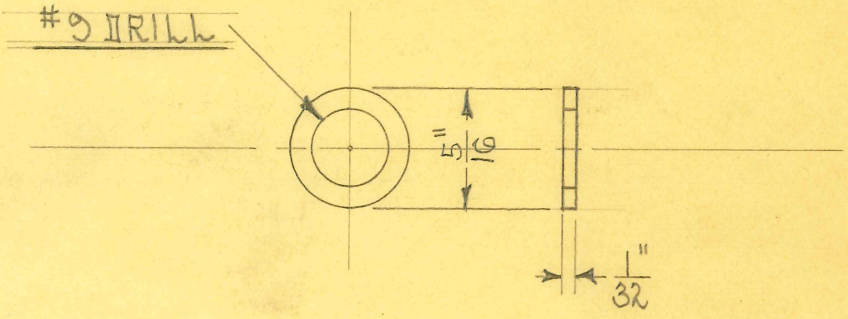

3-REQUIRED

OBSOLETE

SIZE	5/16"	ISSUE 5-6-32	A.E.	TITLE: LARGE SIZE FIXED GAP SCREW WASHER		
KIND	BRASS ROD	CHANGED				
SHAPE		" "				
FINISH		" "				
TEMP.		" "		H. G. FISCHER & CO. 2335 WABANSIA AVE. CHICAGO, ILL.	CAT. NO.	PART NO. 7315
PATT.		" "				

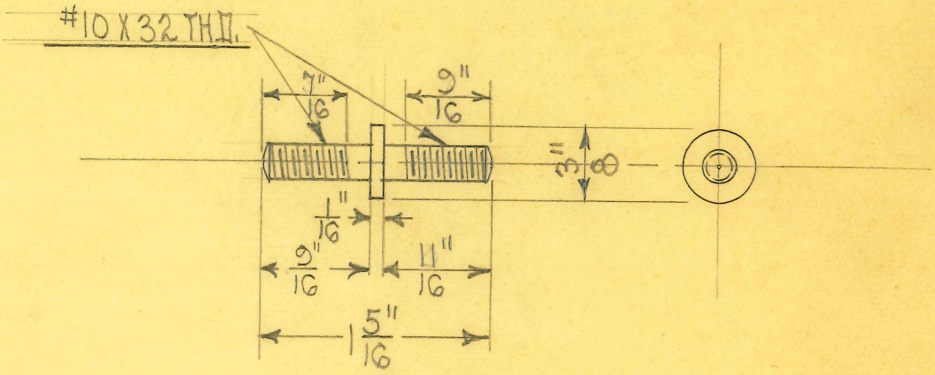

1 REQUIRED

OBSOLETE

SIZE	3/8"	ISSUE 5-C-32	H.E.	TITLE: LARGE SIZE FIXED GAP MOUNTING STUD - LONG	
KIND	BRASS ROD	CHANGED			
SHAPE		" "			
FINISH	COP. PLATED	" "			
TEMP.		" "		H. G. FISCHER & CO. 2335 WABANSIA AVE. CHICAGO, ILL.	CAT. NO.
PATT.		" "			PART NO. 7316

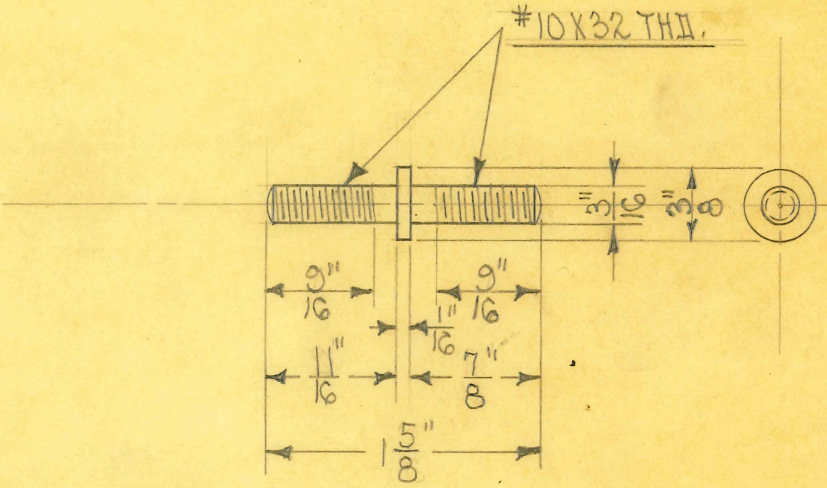

1 REQUIRED

OBSOLETE

SIZE	3/8"	ISSUE 9-1-32	A.E.	**TITLE:** LARGE SIZE FIXED GAP MOUNTING STUD (LONG)
KIND	BRASS ROD	CHANGED		
SHAPE		" "		
FINISH		" "		
TEMP.		" "		
PATT.		" "		

H. G. FISCHER & CO.
2335 WABANSIA AVE.
CHICAGO, ILL.

CAT. NO.

PART NO. 731CA

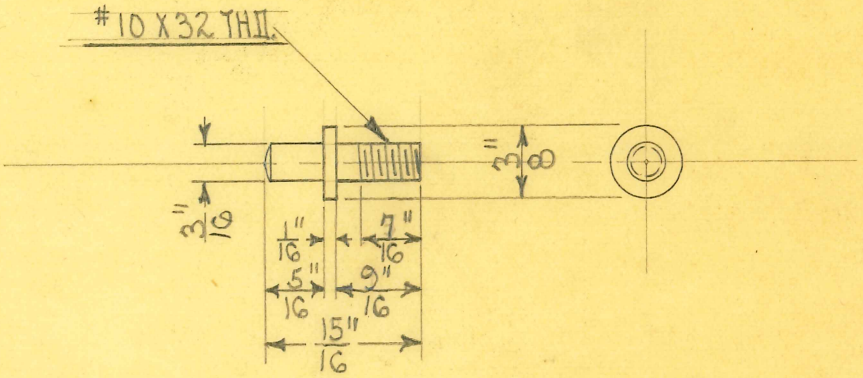

1 REQUIRED

OBSOLETE

SIZE	3/8"	ISSUE 5-6-32	A.E.	TITLE: LARGE SIZE FIXED GAP MOUNTING STUD - SHORT		
KIND	BRASS ROD	CHANGED				
SHAPE		" "				
FINISH	COP. PLATED	" "				
TEMP.		" "		H. G. FISCHER & CO. 2335 WABANSIA AVE. CHICAGO, ILL.	CAT. NO.	PART NO. 7316 1/2
PATT.		" "				

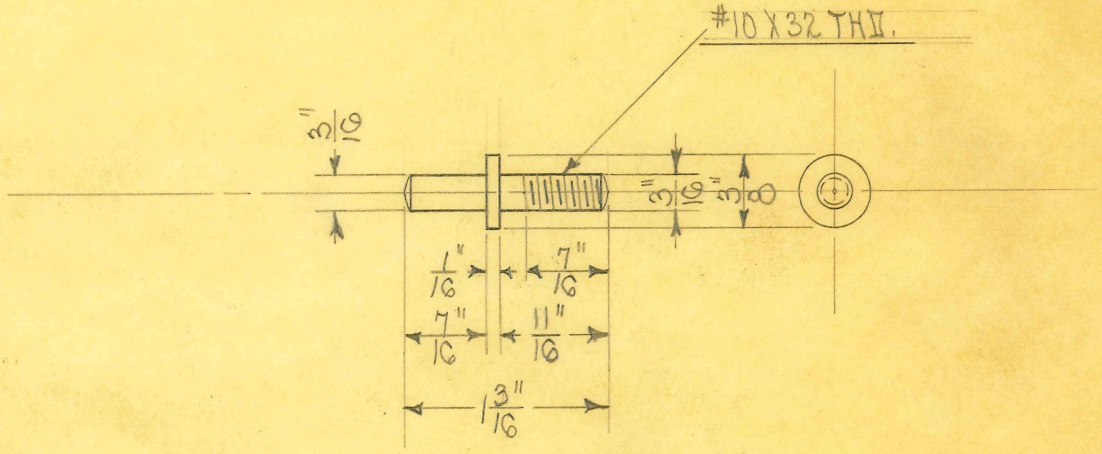

1 REQUIRED

OBSOLETE

SIZE	3/8"	ISSUE 8-31-32	A.E.	TITLE: LARGE SIZE FIXED GAP MOUNTING STUD (SHORT)		
KIND	BRASS ROD	CHANGED				
SHAPE		" "				
FINISH		" "				
TEMP.		" "		H. G. FISCHER & CO. 2335 WABANSIA AVE. CHICAGO, ILL.	CAT. NO.	PART NO. 7316 1/2 A
PATT.		" "				

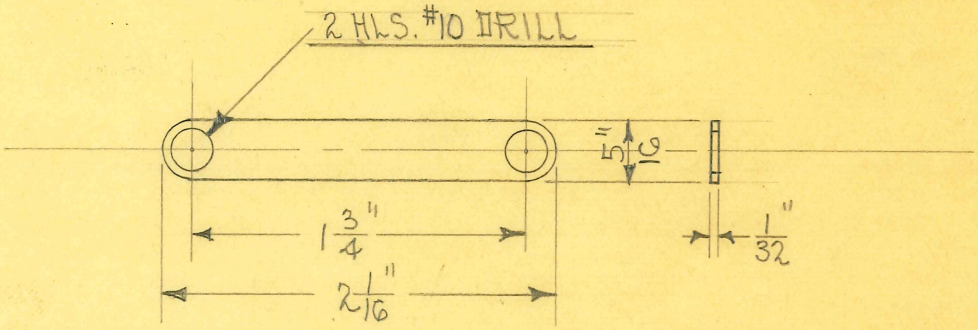

2 REQUIRED

2

OBSOLETE

SIZE		ISSUE 5-6-32	A.E.	**TITLE:** LARGE SIZE FIXED GAP CONNECTING STRIP-SMALL
KIND	STRIP BRASS	CHANGED		
SHAPE		" "		
FINISH		" "		
TEMP.		" "		H. G. FISCHER & CO. 2335 WABANSIA AVE. CHICAGO, ILL. — CAT. NO. — PART NO. 7317
PATT.		" "		

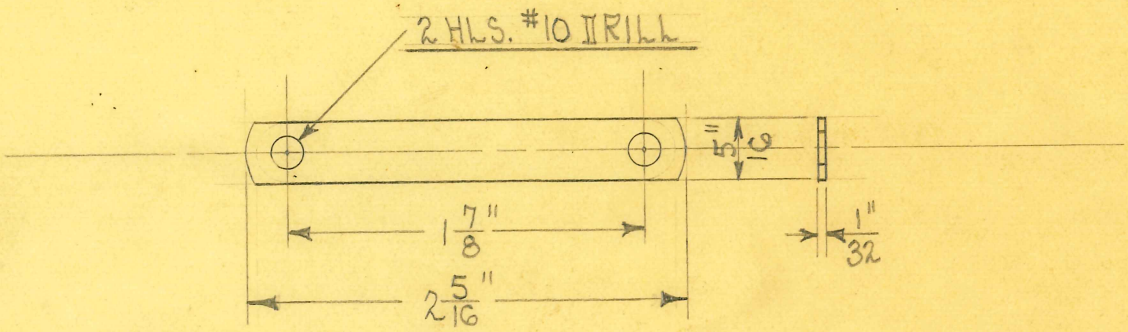

2 REQUIRED

OBSOLETE

SIZE		ISSUE 5-6-32	A.E.	**TITLE:** LARGE SIZE FIXED GAP CONNECTING STRIP-MEDIUM
KIND	STRIP BRASS	CHANGED		
SHAPE		" "		
FINISH		" "		
TEMP.		" "		H. G. FISCHER & CO. 2335 WABANSIA AVE. CHICAGO, ILL. — CAT. NO. — PART NO. 7317 1/2
PATT.		" "		

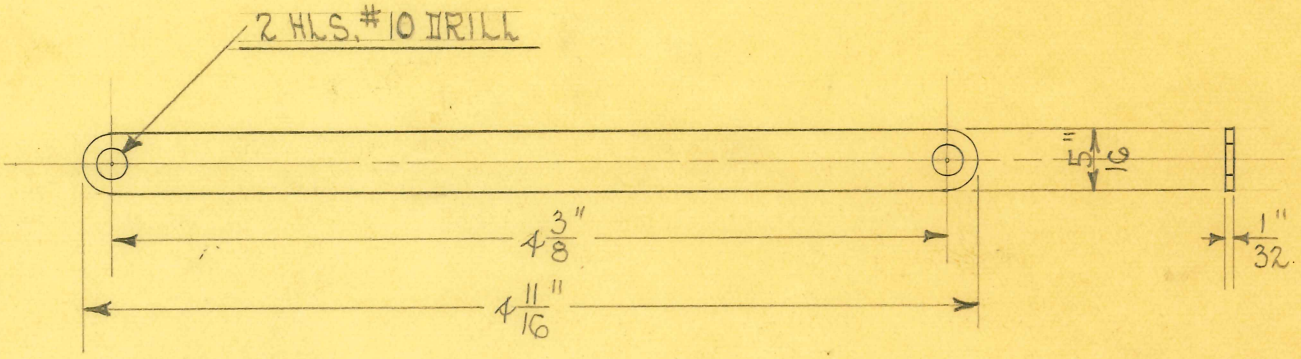

1 REQUIRED

OBSOLETE

SIZE		ISSUE 5-6-32	A.E.	TITLE: LARGE SIZE FIXED GAP CONNECTING STRIP-LARGE
KIND	STRIP BRASS	CHANGED		
SHAPE		" "		
FINISH		" "		
TEMP.		" "		H. G. FISCHER & CO. 2335 WABANSIA AVE. CHICAGO, ILL. / CAT. NO. / PART NO. 7318
PATT.		" "		

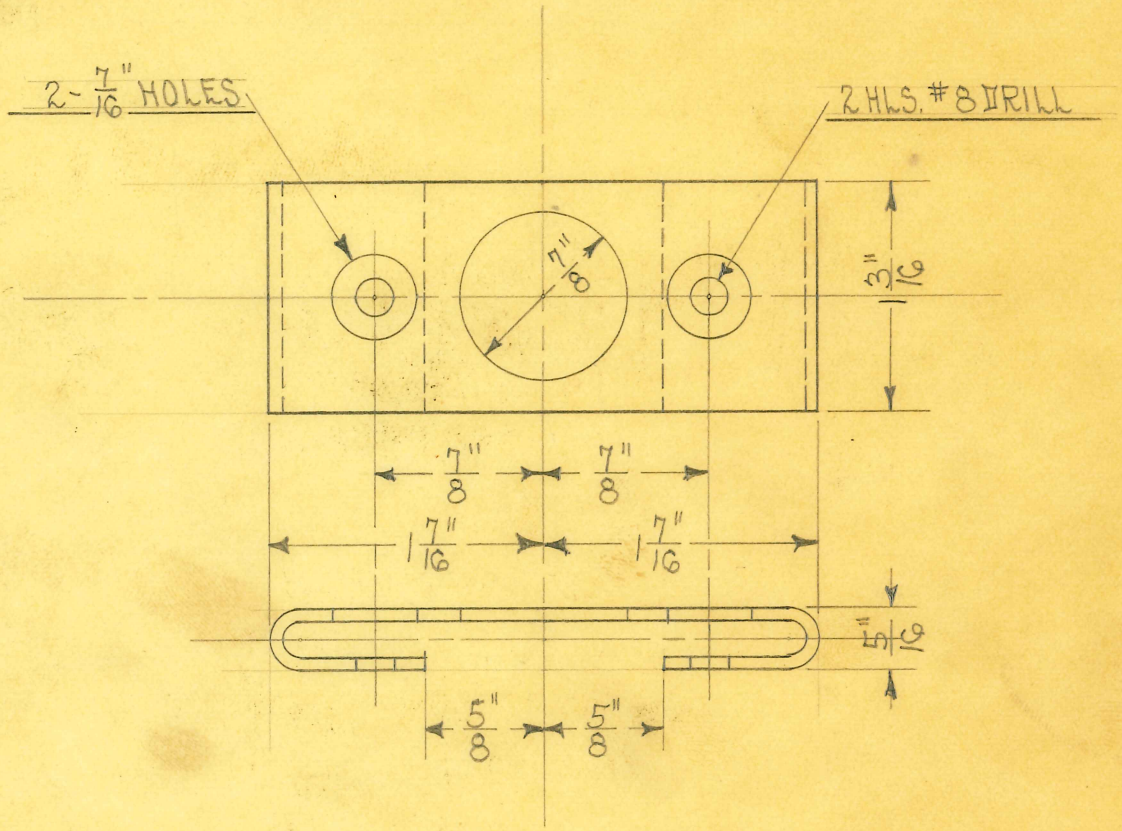

DEVELOPED LENGTH-4 5/8"

OBSOLETE

SIZE	#14 B.&S. GA.	ISSUE 9-1-32	A.E.	**TITLE:** LARGE SIZE FIXED GAP SUB-BASE
KIND	H.H. BRASS	CHANGED		
SHAPE		" "		
FINISH		" "		
TEMP.		" "		
PATT.		" "		

H. G. FISCHER & CO.
2335 WABANSIA AVE.
CHICAGO, ILL.

CAT. NO.

PART NO. 7320

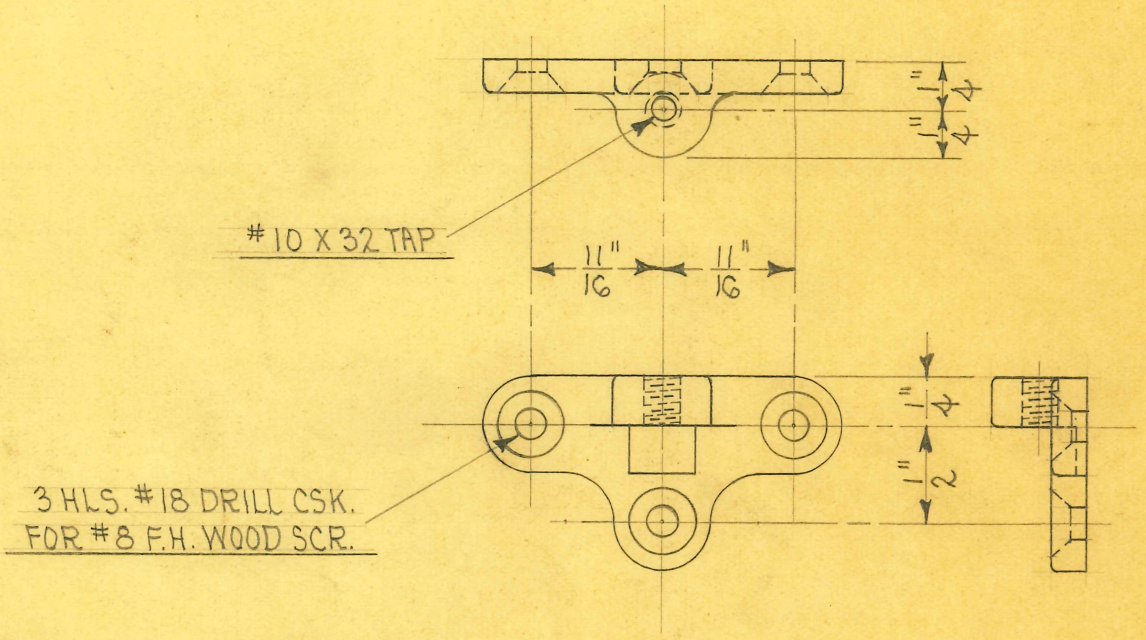

4 REQUIRED

OBSOLETE

SIZE		ISSUE 6-6-34	A.E.	**TITLE:** CHASSIS STYLE MODEL "H" OUTFIT CABINET CLAMP
KIND	BRASS CASTING	CHANGED		
SHAPE		"		
FINISH		"		
TEMP.		"		H. G. FISCHER & CO. 2335 WABANSIA AVE. CHICAGO, ILL. — CAT. NO. — PART NO. 7452 1/4 F
PATT.	555-740	"		

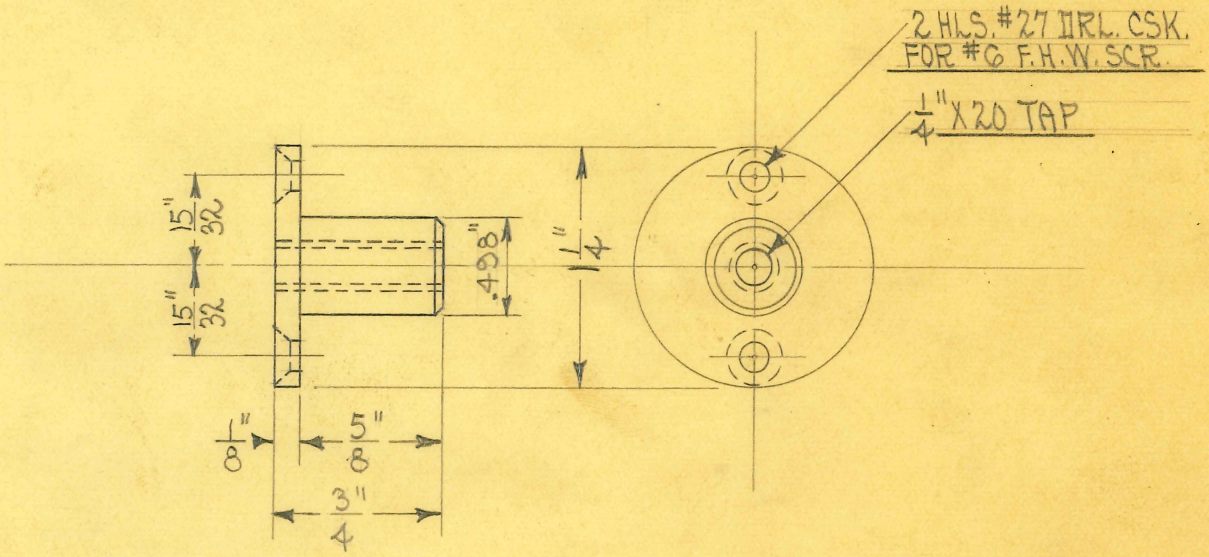

4 REQUIRED

OBSOLETE

SIZE	1¼"	ISSUE 10-21-32	A.E.	TITLE: FISCHER MOD. "H" DIA. OUTFIT CABINET INSERT	
KIND	COLD ROLLED	CHANGED		OBSOLETE	
SHAPE		" "			
FINISH	RUSTPROOF	" "			
TEMP.		" "		H. G. FISCHER & CO. 2335 WABANSIA AVE. CHICAGO, ILL.	CAT. NO.
PATT.		" "			PART NO. 7452½

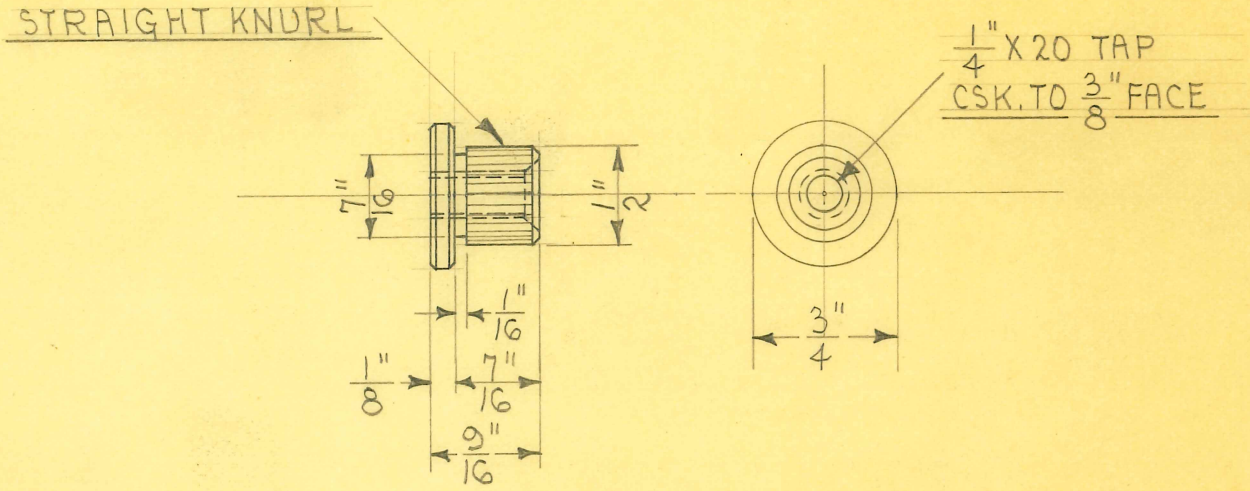

OBSOLETE

SIZE	3/4" DIAM.	ISSUE 12-10-36	A.E.
KIND	C.R. STEEL	CHANGED	
SHAPE		"	
FINISH		"	
TEMP.		"	
PATT.		"	

TITLE: FISCHER MOD. "H" DIA. OUTFIT CABINET INSERT

H. G. FISCHER & CO.
2335 WABANSIA AVE.
CHICAGO, ILL.

CAT. NO.

PART NO. 7452 1/2 A

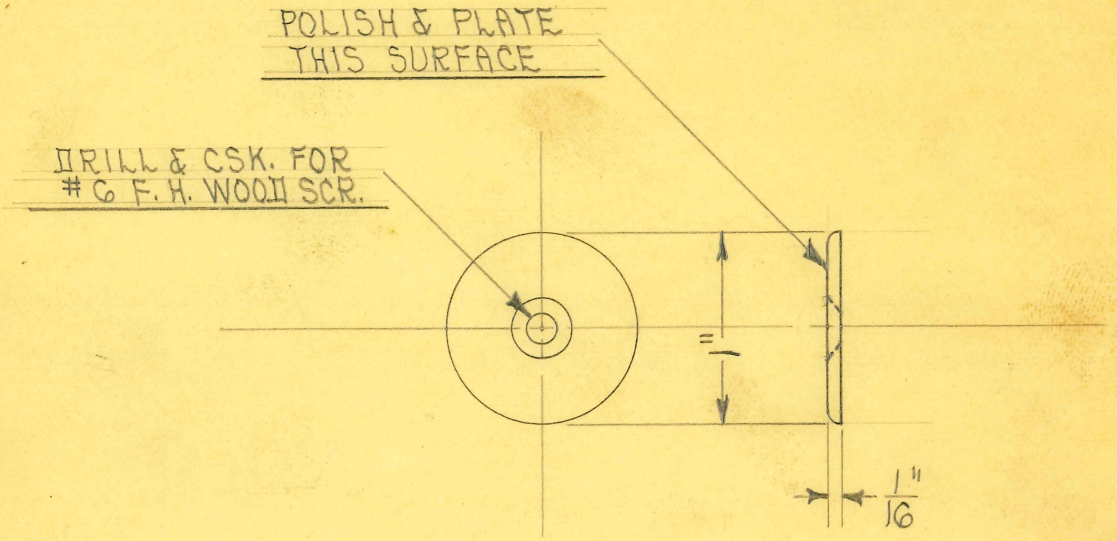

4 REQUIRED

OBSOLETE

SIZE	1"	ISSUE 6-13-32	A.E.	TITLE: CABINET WASHER FOR MODEL "H", MODEL "T", & LOW VOLT GENERATOR	
KIND	BRASS ROD	CHANGED			
SHAPE		" "			
FINISH		" "			
TEMP.		" "			
PATT.		" "			

H. G. FISCHER & CO.
2335 WABANSIA AVE.
CHICAGO, ILL.

CAT. NO.

PART NO. 5643

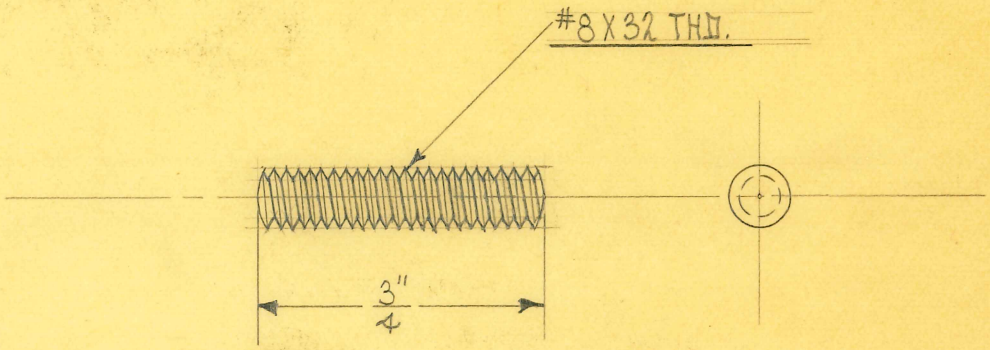

SCALE ~ 1" = 1/2"

OBSOLETE

SIZE		ISSUE 10-22-32	J.E.	TITLE: FISCHER MODEL "H" DIA. OUTFIT CONN. STUD
KIND	BRASS ROD	CHANGED		
SHAPE		" "		
FINISH		" "		
TEMP.		" "		H. G. FISCHER & CO. 2335 WABANSIA AVE. CHICAGO, ILL. / CAT. NO. / PART NO. 7461
PATT.		" "		

EH

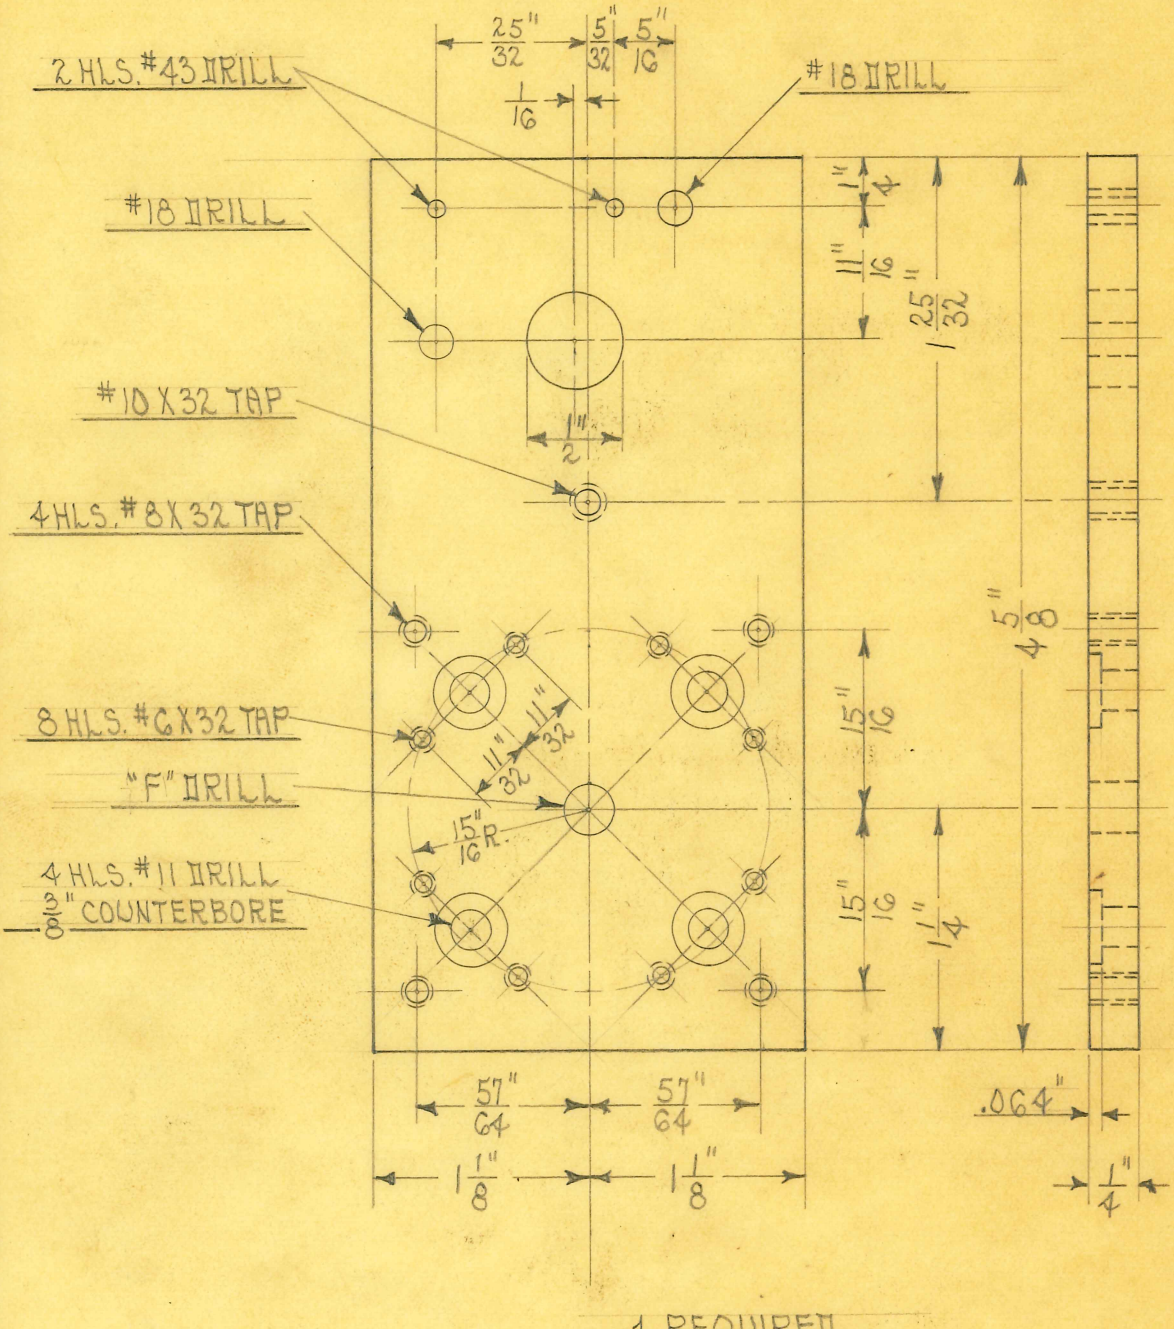

1 REQUIRED

OBSOLETE

SIZE	RICHELAIN	ISSUE 9-9-32	H.E.	**TITLE:** FISCHER MODEL "H" DIA. OUTFIT VARIOMETER END SUPPORT PLATE
KIND	BAKELITE	CHANGED		
SHAPE		" "		
FINISH		" "		
TEMP.		" "		
PATT.		" "		

H. G. FISCHER & CO.
2335 WABANSIA AVE.
CHICAGO, ILL.

CAT. NO.

PART NO. 7463F

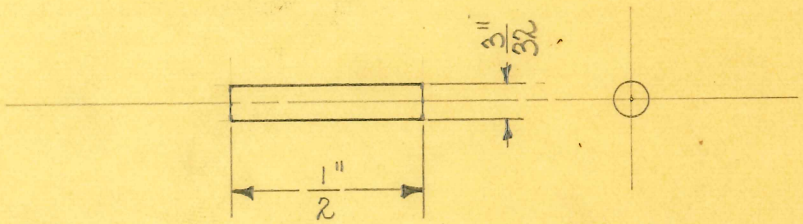

2 REQUIRED

SCALE ~ 1" = 1/2"

OBSOLETE

SIZE	3/32"	ISSUE 9-21-32	H.E.	**TITLE:** FISCHER MODEL "H" IIA. OUTFIT VARIOMETER END SUPP. PLATE DOWEL PIN	
KIND	SCR. STOCK.	CHANGED			
SHAPE		" "			
FINISH		" "			
TEMP.		" "		H. G. FISCHER & CO. 2335 WABANSIA AVE. CHICAGO, ILL.	CAT. NO.
PATT.		" "			PART NO. 7463 1/4

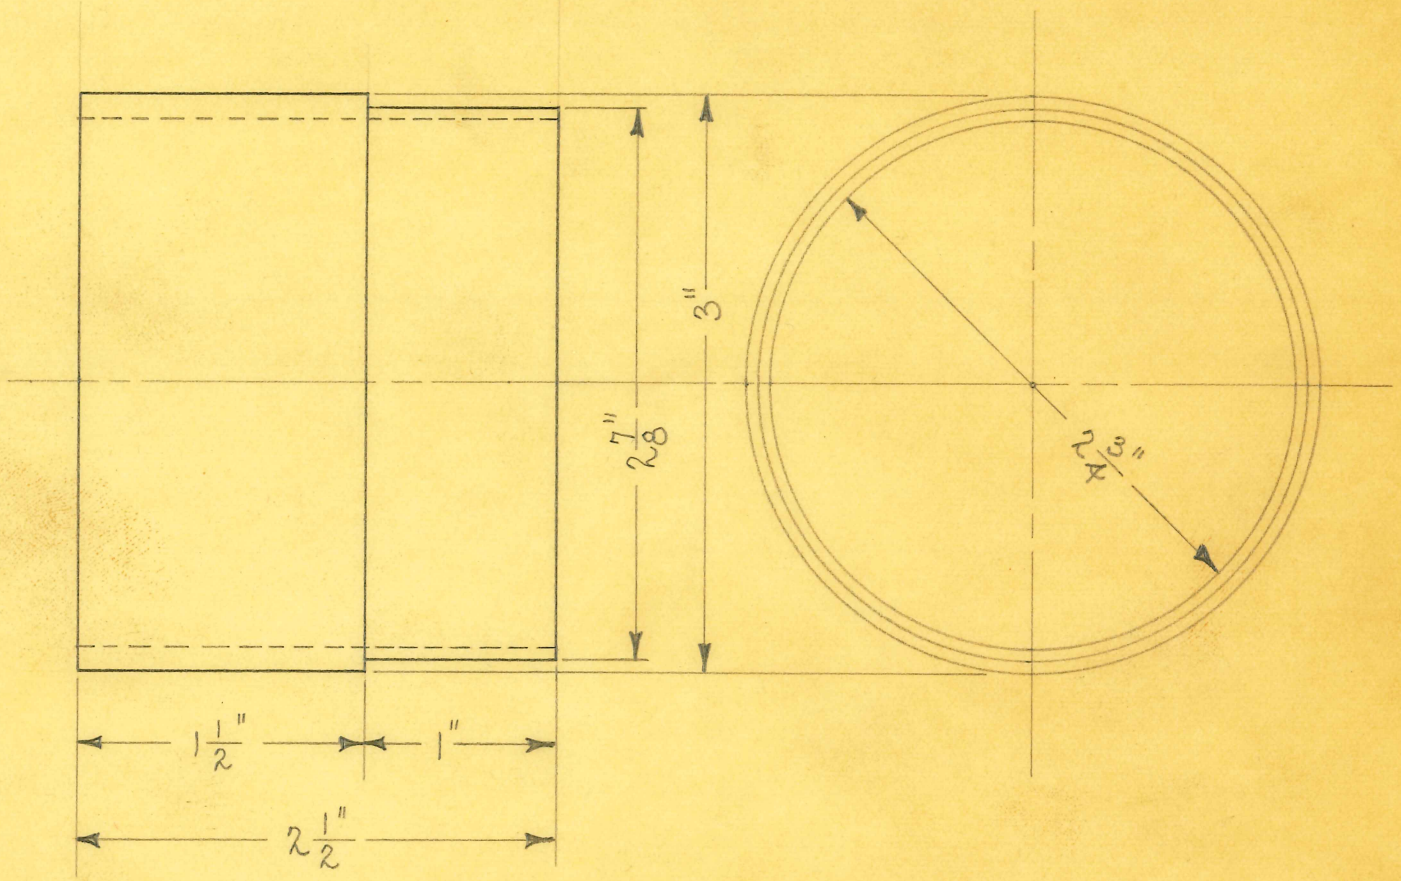

1 REQUIRED

OBSOLETE

SIZE	2¾" I.D. X 3" O.D.	ISSUE 9-6-32	H.E.
KIND	CELLULAC TUBE	CHANGED	
SHAPE		" "	
FINISH		" "	
TEMP.		" "	
PATT.		" "	

TITLE: FISCHER MODEL "H" DIA. OUTFIT VARIOMETER MOVABLE COIL TUBE

H. G. FISCHER & CO.
2335 WABANSIA AVE.
CHICAGO, ILL.

CAT. NO.

PART NO. 7464F

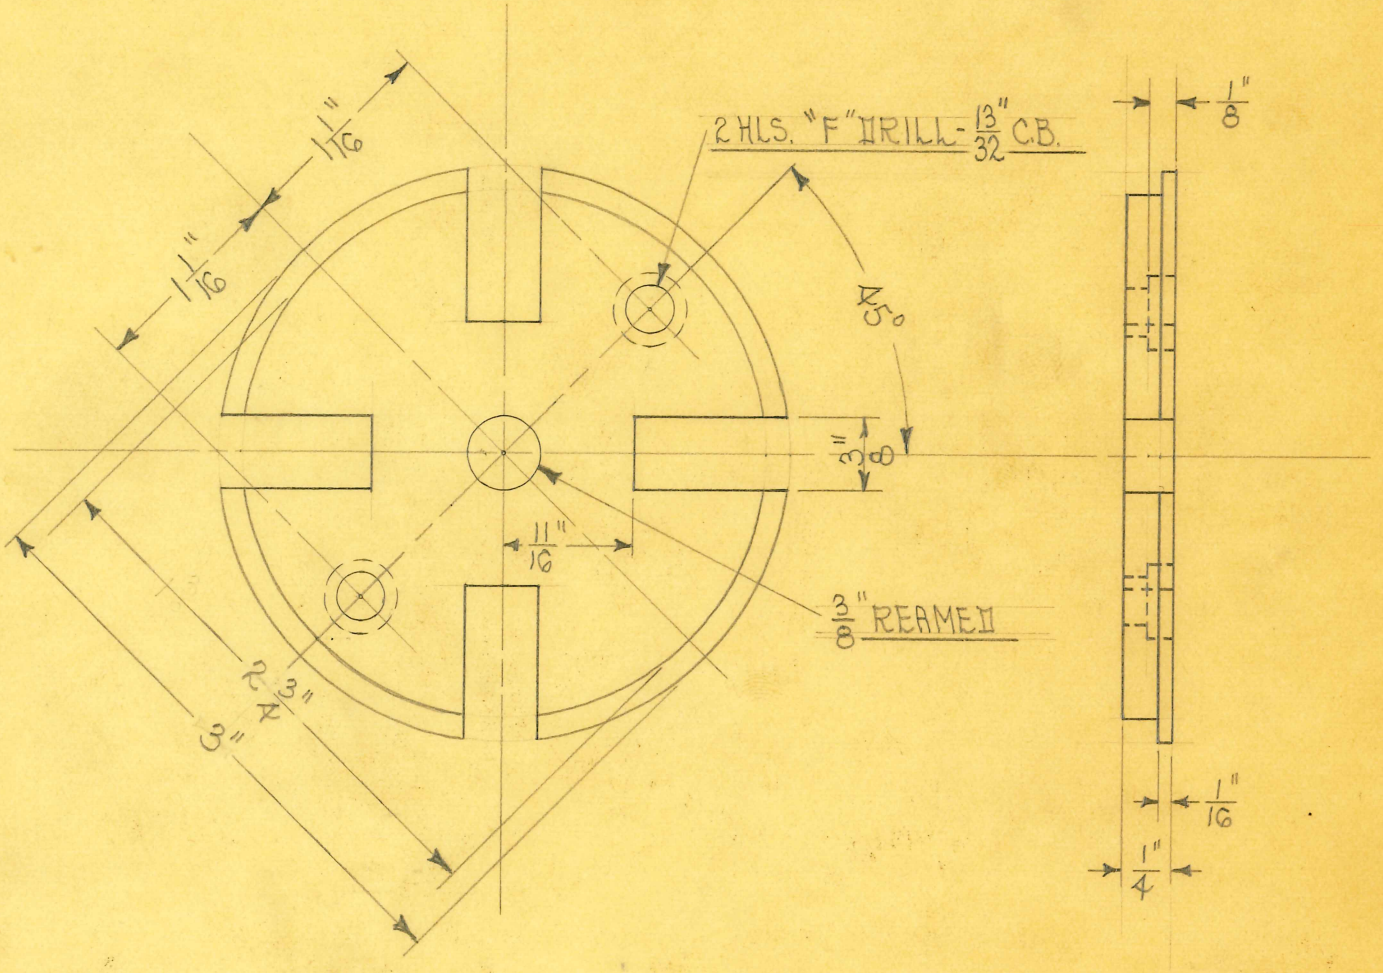

1 REQUIRED

OBSOLETE

SIZE	1/4" SHEET	ISSUE 9-2-32	H.E.	**TITLE:** FISCHER MODEL "H" DIA. OUTFIT VARIOMETER MOVABLE COIL HEAD (LARGE)
KIND	BAKELITE	CHANGED		
SHAPE		" "		
FINISH		" "		
TEMP.		" "		H. G. FISCHER & CO. 2335 WABANSIA AVE. CHICAGO, ILL. — CAT. NO. — PART NO. 7465F
PATT.		" "		

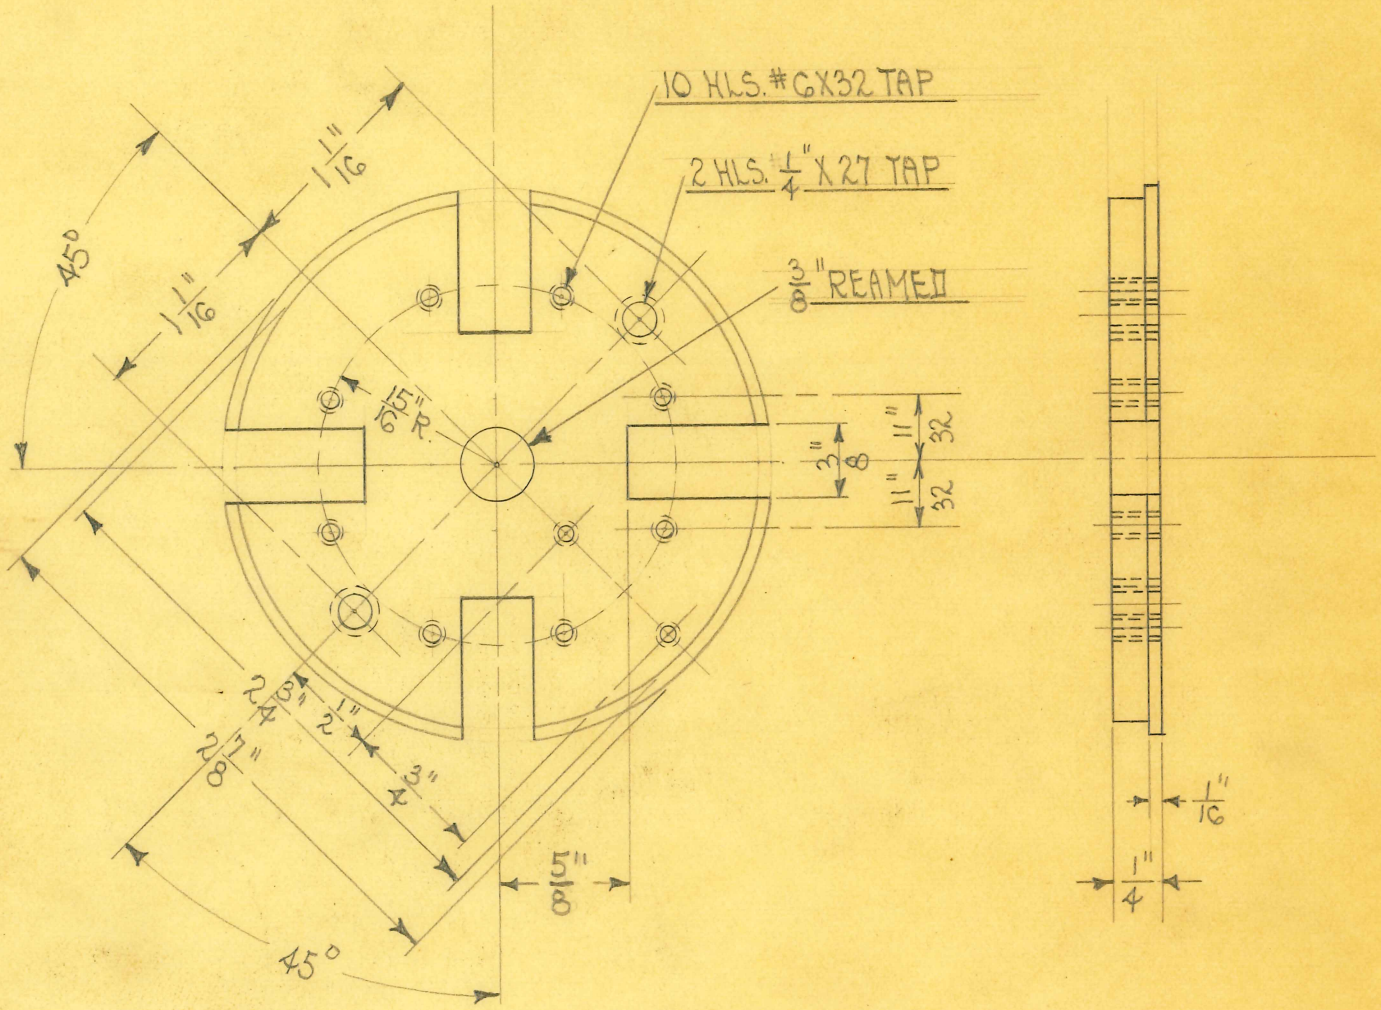

1 REQUIRED.

OBSOLETE

SIZE	1/4" SHEET	ISSUE 9-6-32	A.E.
KIND	BAKELITE	CHANGED	
SHAPE		" "	
FINISH		" "	
TEMP.		" "	
PATT.		" "	

TITLE: FISCHER MODEL "H" IIA. OUTFIT VARIOMETER
MOVABLE COIL HEAD (SMALL)

H. G. FISCHER & CO.
2335 WABANSIA AVE.
CHICAGO, ILL.

CAT. NO.

PART NO. 7465 1/2 F

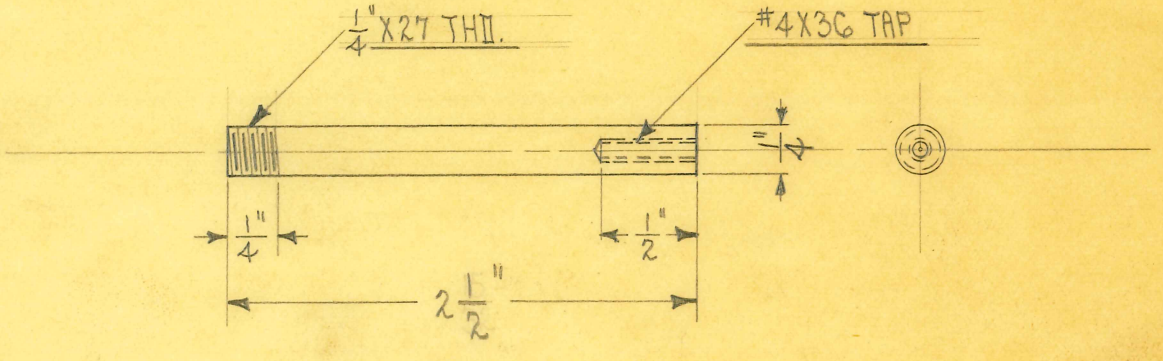

2 REQUIRED

OBSOLETE

SIZE	1/4"	ISSUE 9-6-32	A.E.	TITLE: FISCHER MODEL "H" DIA. OUTFIT VARIOMETER MOVABLE COIL HEAD CLAMP ROD	
KIND	BAKELITE ROD	CHANGED			
SHAPE		" "			
FINISH		" "			
TEMP.		" "		H. G. FISCHER & CO. 2335 WABANSIA AVE. CHICAGO, ILL.	CAT. NO.
PATT.		" "			PART NO. 7466

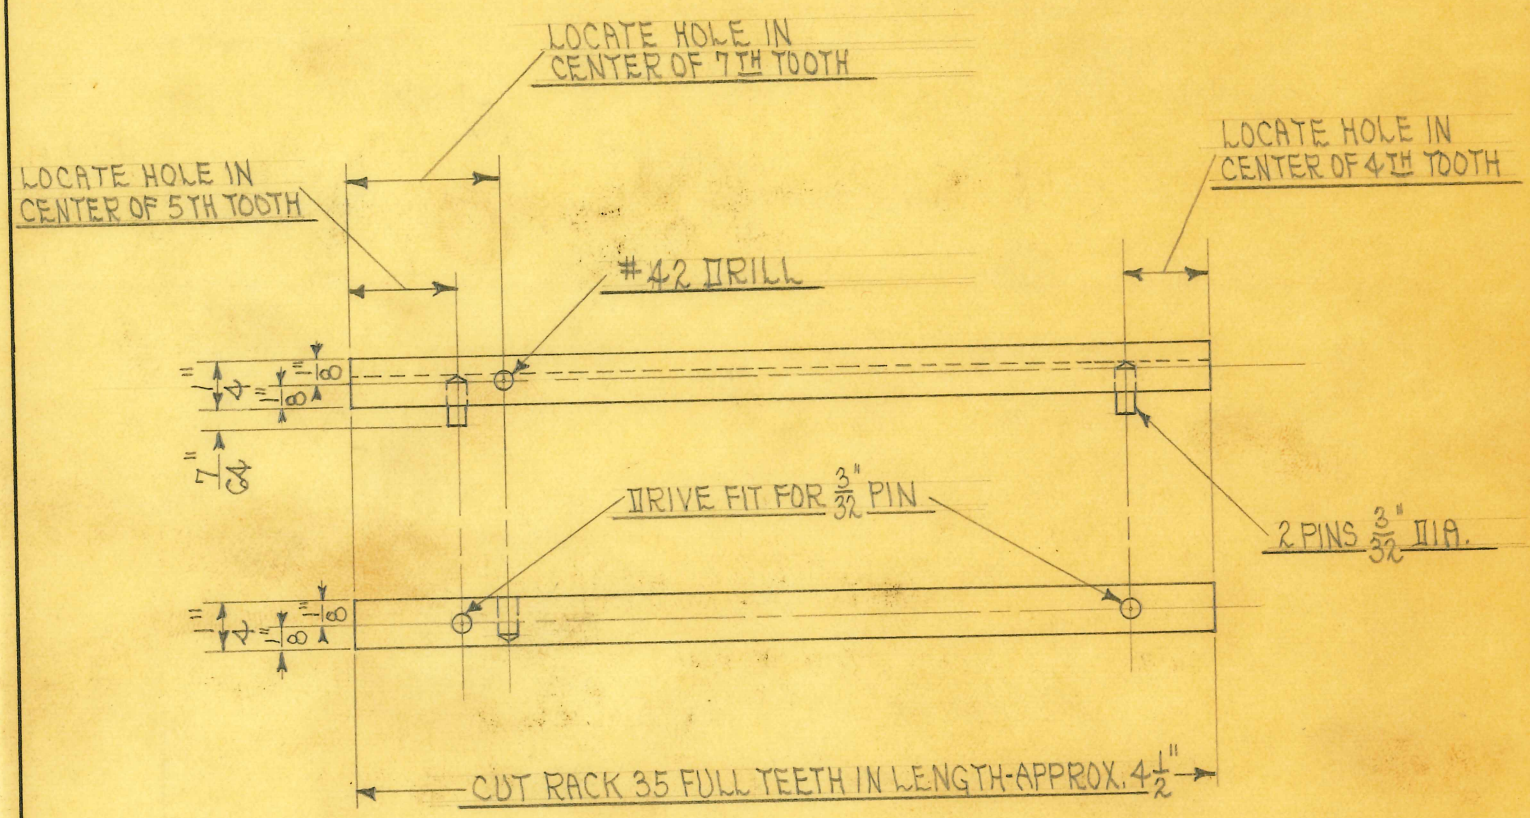

1 REQUIRED

OBSOLETE

SIZE	L505	ISSUE 9-15-32	A.E.	TITLE: FISCHER MODEL "H" DIA. OUTFIT VARIOMETER RACK		
KIND	STEEL RACK	CHANGED				
SHAPE		" "				
FINISH		" "				
TEMP.		" "		H. G. FISCHER & CO. 2335 WABANSIA AVE. CHICAGO, ILL.	CAT. NO.	PART NO. 7469G
PATT.		" "				

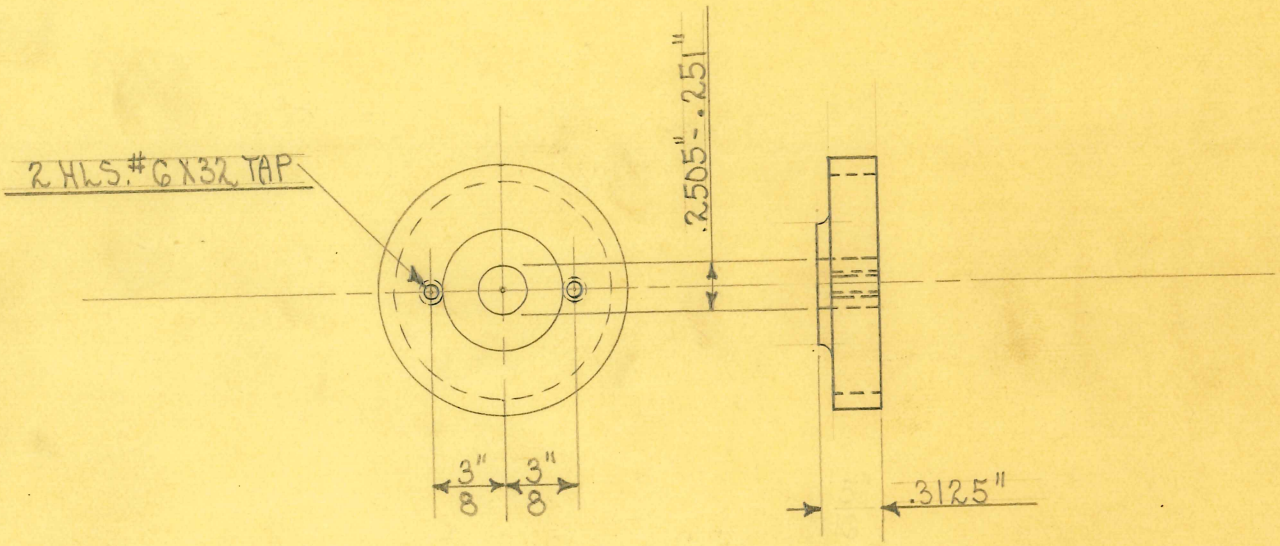

1 REQUIRED
FROM 7050

OBSOLETE

SIZE		ISSUE 9-20-32	A.E.	TITLE: FISCHER MODEL "H" IIA. OUTFIT VARIOMETER GEAR		
KIND		CHANGED				
SHAPE		" "				
FINISH		" "				
TEMP.		" "		H. G. FISCHER & CO. 2335 WABANSIA AVE. CHICAGO, ILL.	CAT. NO.	PART NO. 7470
PATT.		" "				

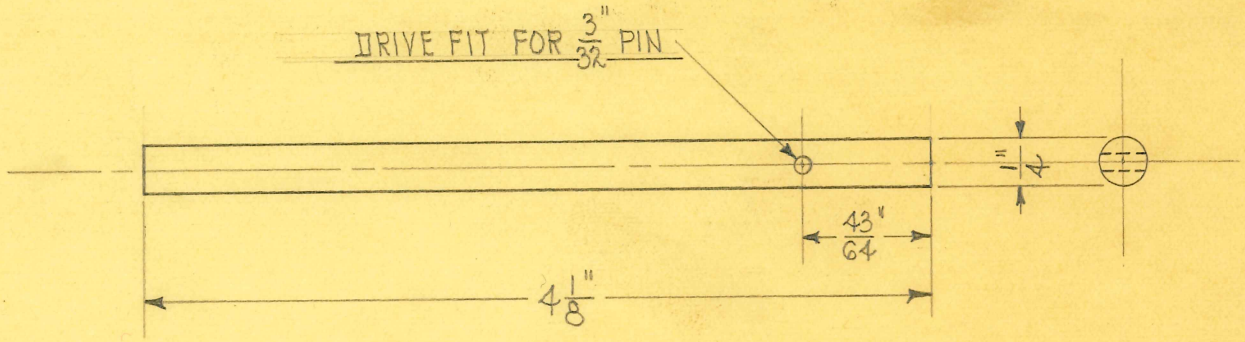

1 REQUIRED

OBSOLETE

SIZE	1/4 GROUND	ISSUE 9-21-32	A.E.	TITLE: FISCHER MODEL "H" DIA. OUTFIT VARIOMETER SHAFT
KIND	SCR. STOCK	CHANGED		
SHAPE		" "		
FINISH		" "		
TEMP.		" "		H. G. FISCHER & CO. 2335 WABANSIA AVE. CHICAGO, ILL. — CAT. NO. — PART NO. 7471
PATT.		" "		

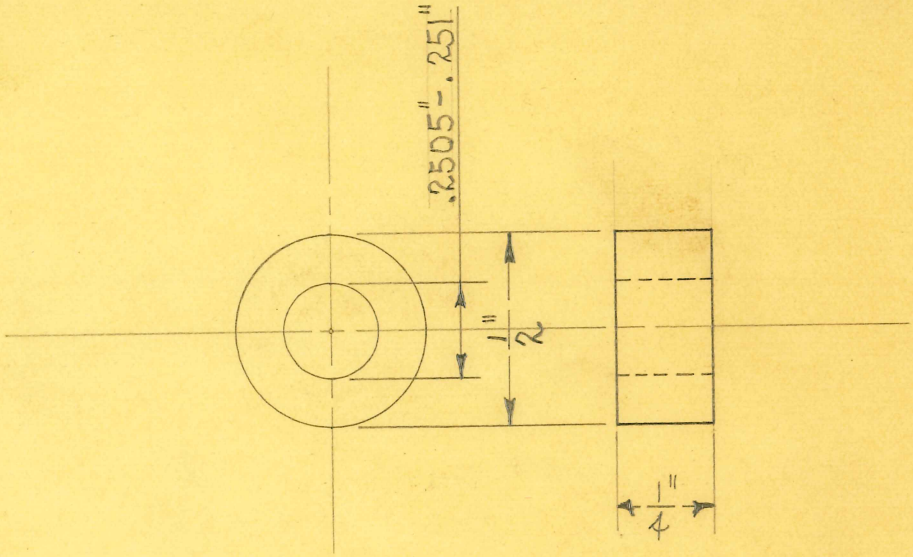

SCALE ~ 1" = 1/2"

1 REQUIRED

OBSOLETE

SIZE	1/2"	ISSUE 9-10-32	H.E.	TITLE: FISCHER MODEL "H" IIA. OUTFIT VARIOMETER SHAFT COLLAR	
KIND	BRASS ROD	CHANGED			
SHAPE		" "			
FINISH		" "			
TEMP.		" "			
PATT.		" "			

H. G. FISCHER & CO.
2335 WABANSIA AVE.
CHICAGO, ILL.

CAT. NO.

PART NO. 7471 1/2

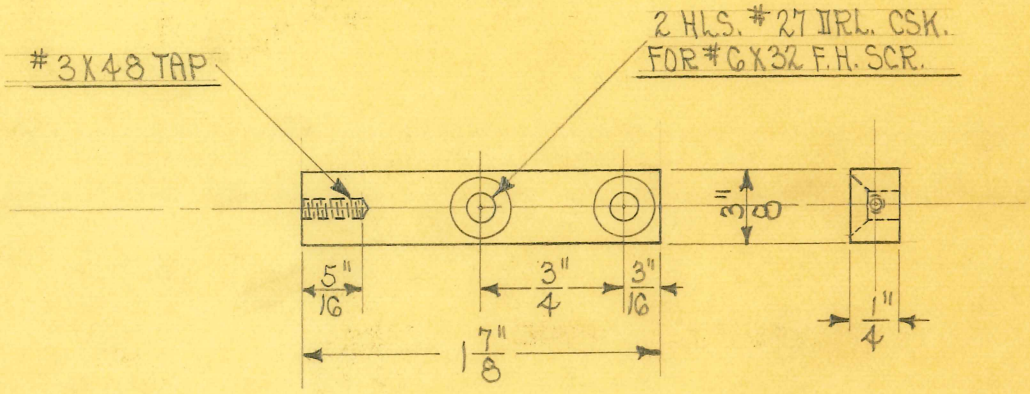

OBSOLETE

SIZE	1/4" (RICHELAIN)	ISSUE 10-22-32	H.E.	**TITLE:** FISCHER MOII. "H" IIIA. OUTFIT VARIOMETER MOVABLE COIL GUIDE BAR
KIND	BAKELITE	CHANGED		
SHAPE		" "		
FINISH		" "		
TEMP.		" "		
PATT.		" "		

H. G. FISCHER & CO.
2335 WABANSIA AVE.
CHICAGO, ILL.

CAT. NO.

PART NO. 7473

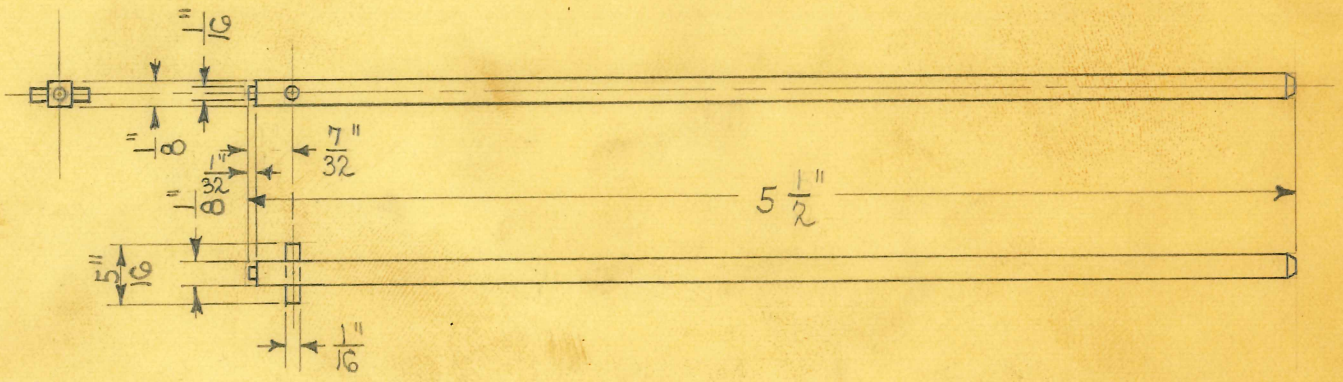

4 REQUIRED

MATERIAL: 1/8" SQUARE BRASS ROD
1/16" BRASS ROD

OBSOLETE

SIZE		ISSUE 9-16-32	A.E.	TITLE: FISCHER MODEL "H" DIA. OUTFIT VARIOMETER CONTACT ROD		
KIND		CHANGED				
SHAPE		" "				
FINISH		" "				
TEMP.		" "		H. G. FISCHER & CO. 2335 WABANSIA AVE. CHICAGO, ILL.	CAT. NO.	PART NO. 7474 3/4 G
PATT.		" "				

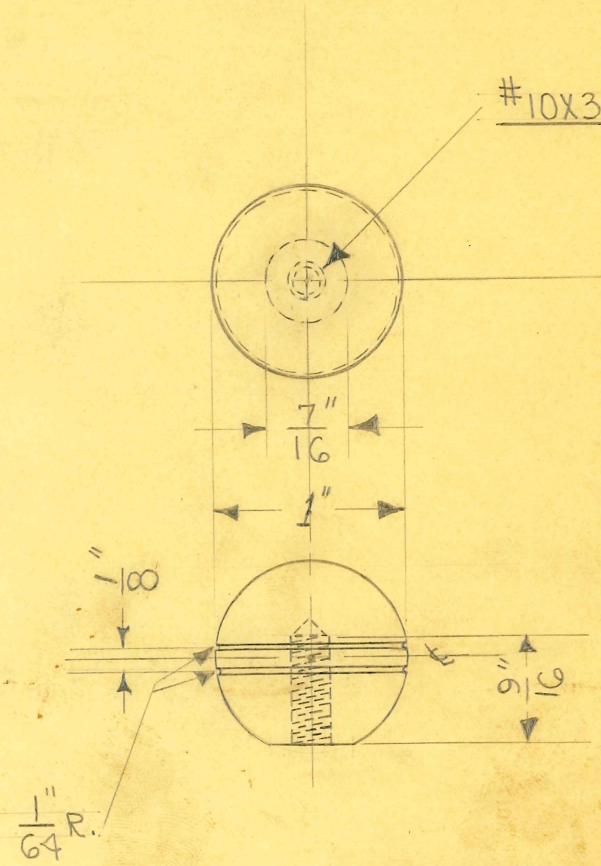

1 REQUIRED

OBSOLETE

SIZE	1" HARD	ISSUE 8-16-35	J.W
KIND	RUB. ROD	CHANGED	
SHAPE		"	
FINISH		"	
TEMP.		"	
PATT.		"	

TITLE: CHASSIS STYLE MODEL "H" OUTFIT
LINE SWITCH HANDLE

H. G. FISCHER & CO.
2335 WABANSIA AVE.
CHICAGO, ILL.

CAT. NO.

PART NO. 7476 1/4

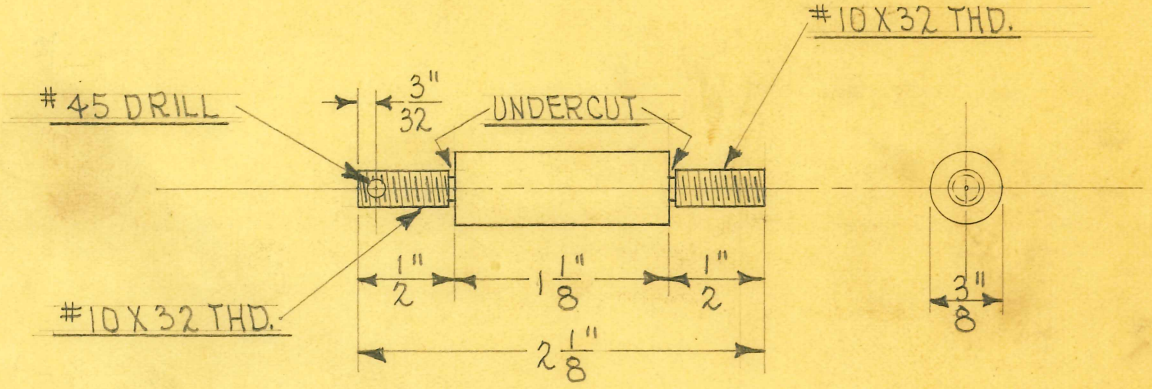

1 REQUIRED

OBSOLETE

SIZE	3/8"	ISSUE 5-22-34	A.E.	TITLE: CHASSIS STYLE MODEL "H" OUTFIT LINE SWITCH HANDLE STUD
KIND	BRASS ROD	CHANGED		
SHAPE		"		
FINISH	CAD. #23	"		
TEMP.		"		
PATT.		"		

H. G. FISCHER & CO.
2335 WABANSIA AVE.
CHICAGO, ILL.

CAT. NO.

PART NO. 7476 3/4

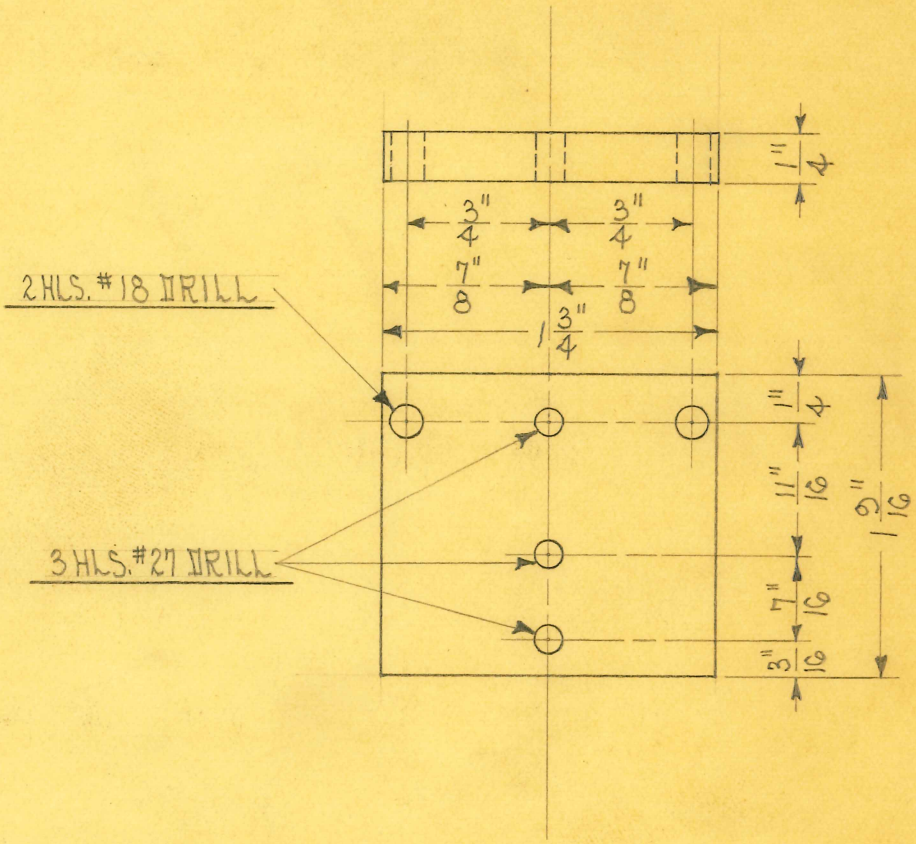

OBSOLETE

SIZE	1¾"X1 9/16"X¼"	ISSUE 12-21-32	A.E.
KIND	BAKELITE	CHANGED	
SHAPE		" "	
FINISH		" "	
TEMP.		" "	
PATT.		" "	

TITLE: FISCHER MOD. "H" DIA. OUTFIT PRE-ADJ. CONTACTOR BASE

H. G. FISCHER & CO.
2335 WABANSIA AVE.
CHICAGO, ILL.

CAT. NO.

PART NO. 7478F

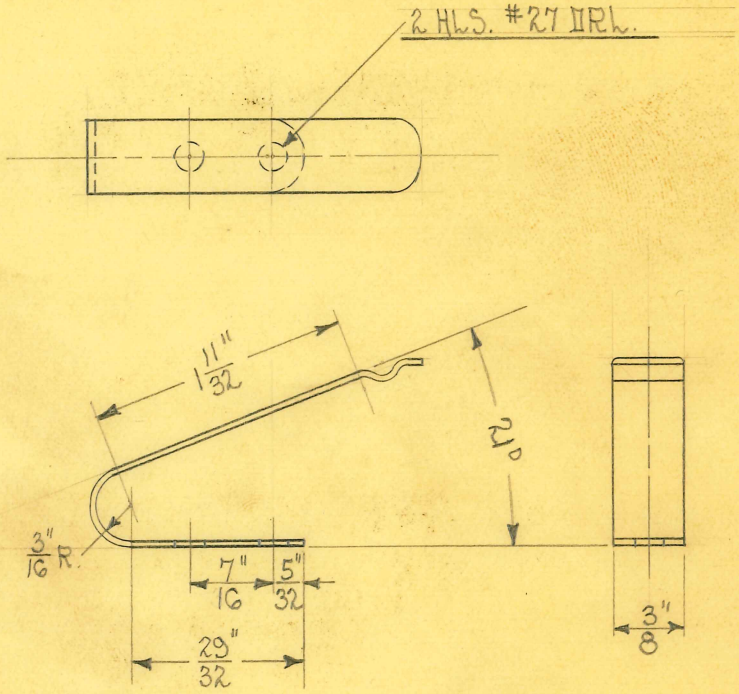

DEVELOPED LENGTH - 3 1/4"

1 REQUIRED

OBSOLETE

SIZE	.025"	ISSUE 9-23-32	A.E.	**TITLE:** FISCHER MODEL "H" DIA. OUTFIT PRE-ADJ. CONTACTER SPRING CONTACT	
KIND	PHOS. BRONZE	CHANGED			
SHAPE		" "			
FINISH		" "			
TEMP.		" "		H. G. FISCHER & CO. 2335 WABANSIA AVE. CHICAGO, ILL.	CAT. NO.
PATT.		" "			PART NO. 7479

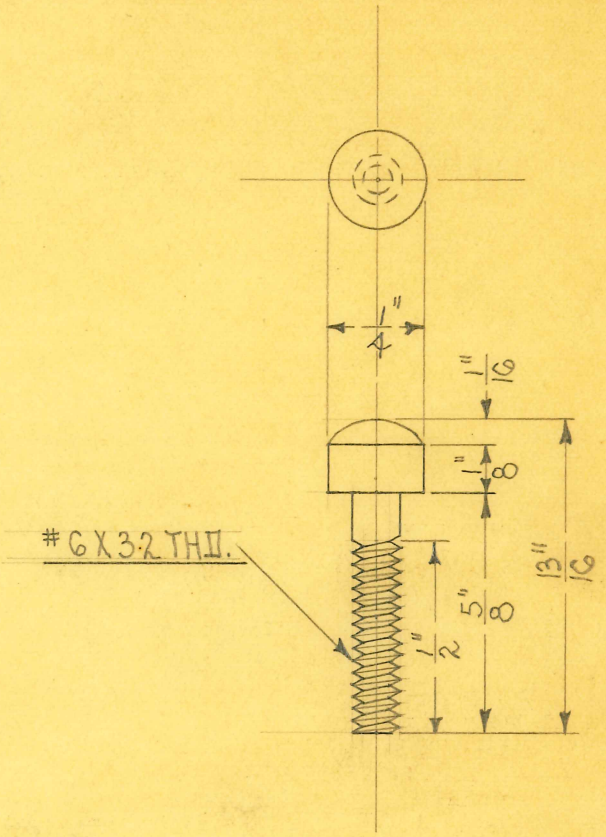

SCALE ~ 2 DIAMETERS

OBSOLETE

SIZE	1/4"	ISSUE 12-20-32	A.E.	**TITLE:** FISCHER MODEL "H" DIA. OUTFIT PRE-ADJ. CONT. CONTACT BUTTON.
KIND	BRASS ROD	CHANGED		
SHAPE		" "		
FINISH		" "		
TEMP.		" "		H. G. FISCHER & CO. 2335 WABANSIA AVE. CHICAGO, ILL. — CAT. NO. — PART NO. 7480
PATT.		" "		

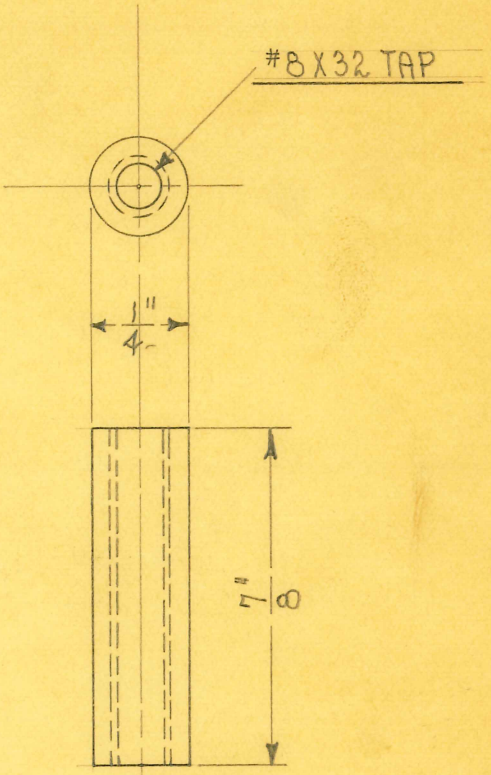

SCALE ~ 2 DIAMETERS

2 REQUIRED

OBSOLETE

SIZE	1/4"	ISSUE 12-20-32	A.E.	**TITLE:** FISCHER MODEL "H" DIA. OUTFIT PRE-ADJ. CONT. SPACER
KIND	BRASS ROD	CHANGED		
SHAPE		" "		
FINISH		" "		
TEMP.		" "		
PATT.		" "		

H. G. FISCHER & CO.
2335 WABANSIA AVE.
CHICAGO, ILL.

CAT. NO.

PART NO. 7481

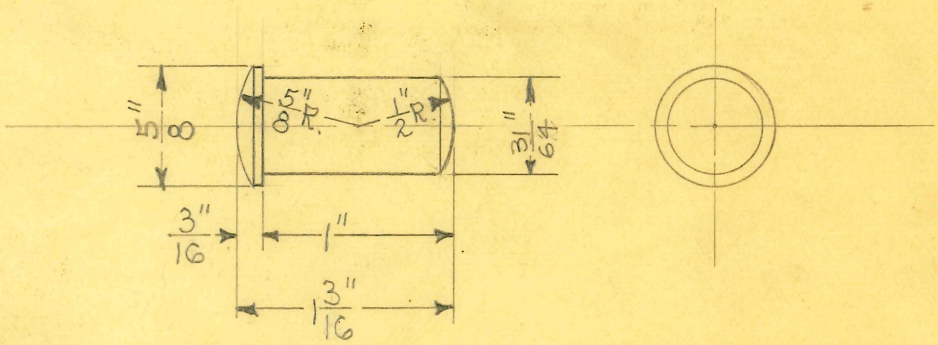

1 REQUIRED

OBSOLETE

SIZE	5/8"	ISSUE 9-21-32	A.E.	TITLE: FISCHER MODEL "H" IIA. OUTFIT PRE-ADJ. CONTACTER PUSH BUTTON
KIND	BAKELITE ROD	CHANGED		
SHAPE		" "		
FINISH		" "		
TEMP.		" "		
PATT.		" "		

H. G. FISCHER & CO.
2335 WABANSIA AVE.
CHICAGO, ILL.

CAT. NO.

PART NO. 7482

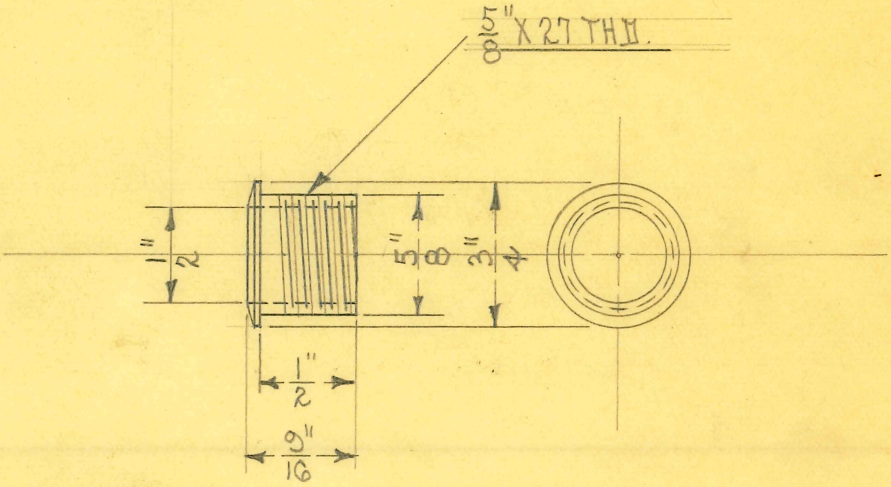

1 REQUIRED

OBSOLETE

SIZE	3/4"	ISSUE 9-20-32	A.E.	TITLE: FISCHER MODEL "H" DIA. OUTFIT PRE-ADJ. CONTACTER BUSHING		
KIND	BRASS ROD	CHANGED				
SHAPE		" "				
FINISH		" "				
TEMP.		" "		H. G. FISCHER & CO. 2335 WABANSIA AVE. CHICAGO, ILL.	CAT. NO.	PART NO. 7483
PATT.		" "				

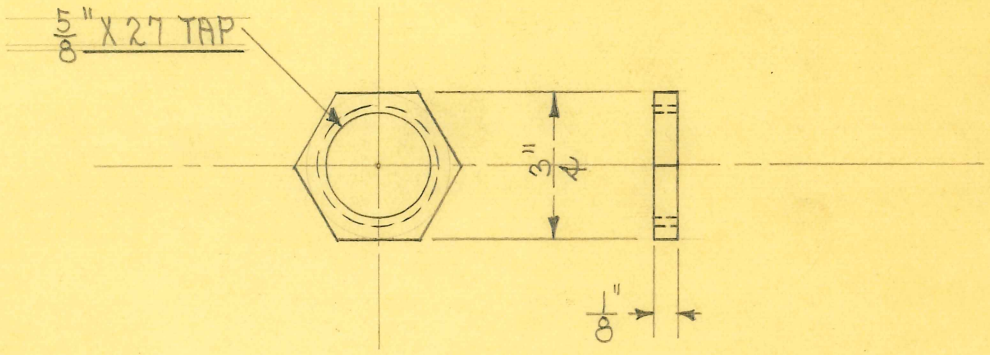

1 REQUIRED

OBSOLETE

SIZE	3/4"	ISSUE 9-20-32	J.E.	**TITLE:** FISCHER MODEL "H" IIA. OUTFIT PRE-ADJ. CONTACTER NUT	
KIND	HEX. BRASS ROD	CHANGED			
SHAPE		" "			
FINISH		" "			
TEMP.		" "		H. G. FISCHER & CO. 2335 WABANSIA AVE. CHICAGO, ILL.	CAT. NO.
PATT.		" "			PART NO. 7484

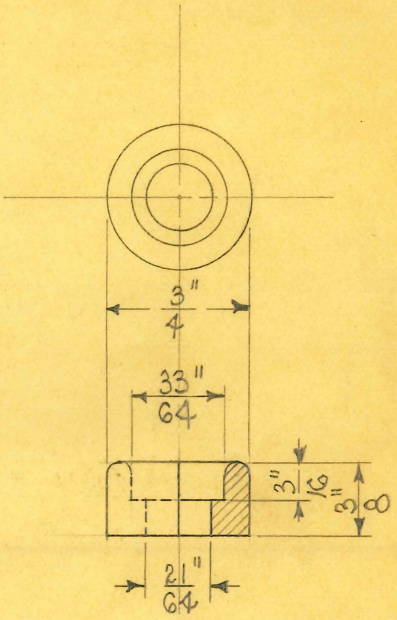

4 REQUIRED

OBSOLETE

SIZE	3/4"	ISSUE 12-20-32	A.E.	**TITLE:** FISCHER MOD. "H" DIA. OUTFIT TERM. BUSHING		
KIND	POL. RUB. ROD	CHANGED				
SHAPE		" "				
FINISH		" "				
TEMP.		" "		H. G. FISCHER & CO. 2335 WABANSIA AVE. CHICAGO, ILL.	CAT. NO.	PART NO. 7486
PATT.		" "				

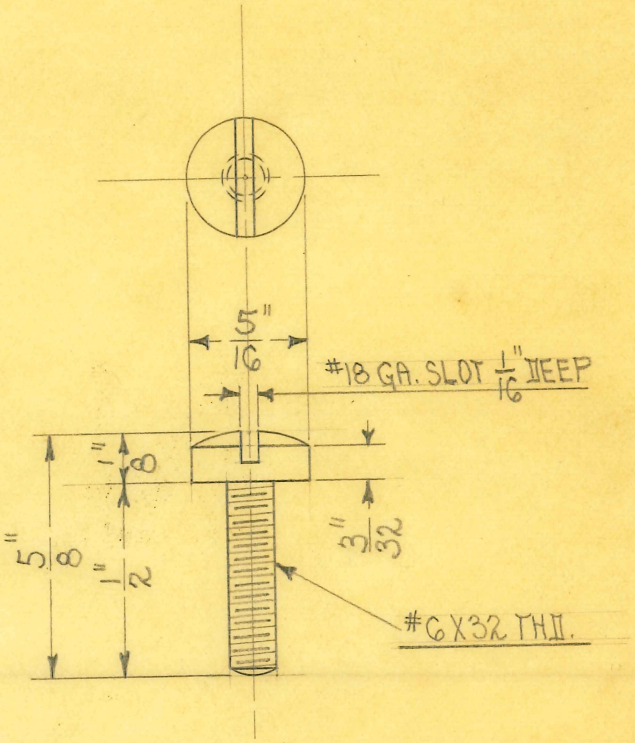

SCALE ~ 1" = 1/2"

2 REQUIRED

OBSOLETE

SIZE	5/16"	ISSUE 9-1-32	A.E.	TITLE: MODEL "H" DIATH. OUTFIT GAP COVER SCREW
KIND	BRASS ROD	CHANGED		
SHAPE		" "		
FINISH	BLK. NICKEL POL.	" "		
TEMP.		" "		H. G. FISCHER & CO. 2335 WABANSIA AVE. CHICAGO, ILL. — CAT. NO. — PART NO. 7491A
PATT.		" "		

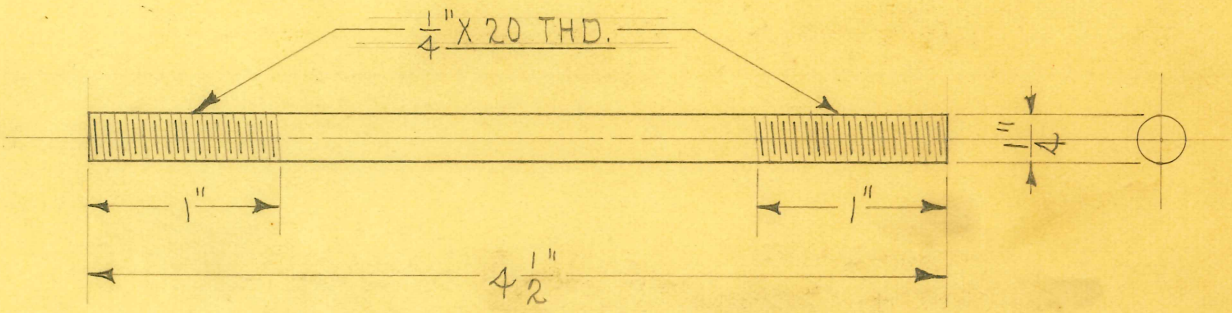

4 REQUIRED

OBSOLETE

SIZE	1/4"	ISSUE 7-12-34	A.E.	**TITLE:** FISCHER MODEL "H" DIA. OUTFIT LINE CHOKE MOUNTING STUD
KIND	SCREW STOCK	CHANGED		
SHAPE		"		
FINISH		"		
TEMP.		"		
PATT.		"		

H. G. FISCHER & CO.
2335 WABANSIA AVE.
CHICAGO, ILL.

CAT. NO.

PART NO. 7492

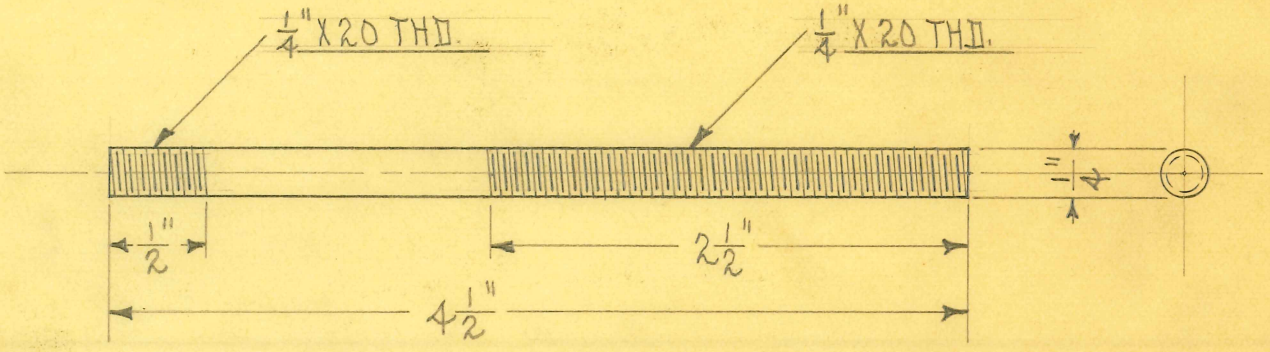

2 REQUIRED

OBSOLETE

SIZE	1/4"	ISSUE 9-21-32	A.E.	TITLE: FISCHER MODEL "H" DIA. OUTFIT LINE CHOKE MTG. STUD
KIND	BRASS ROD	CHANGED 6-14-34	A.E.	
SHAPE		" "		
FINISH		" "		
TEMP.		" "		
PATT.		" "		

H. G. FISCHER & CO.
2335 WABANSIA AVE.
CHICAGO, ILL.

CAT. NO.

PART NO. 7492A

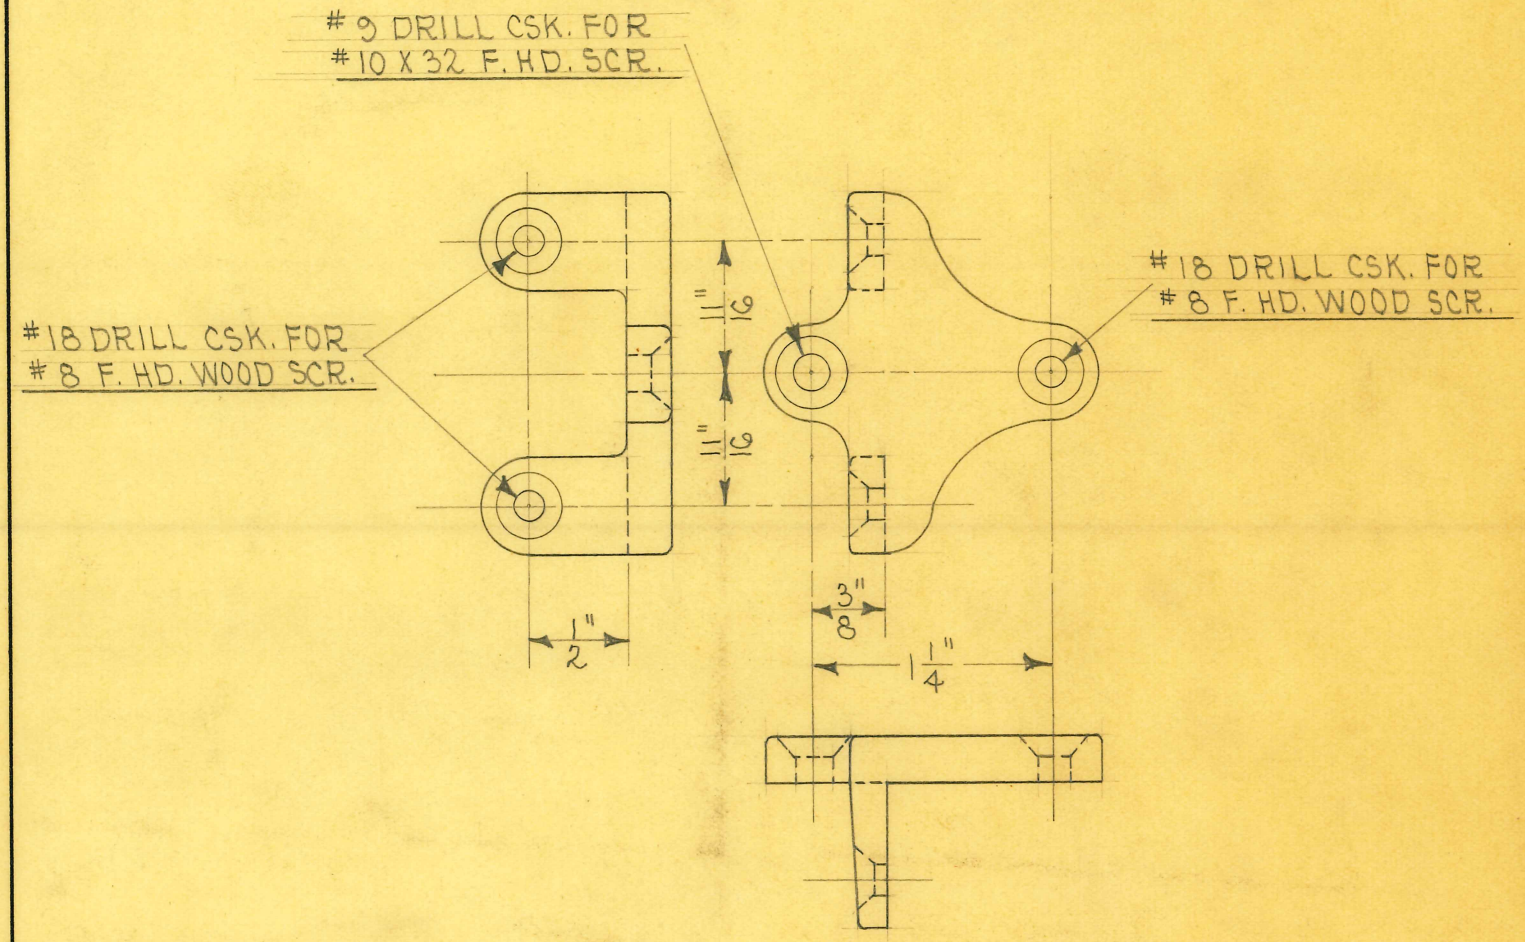

4 REQUIRED

OBSOLETE

SIZE		ISSUE 6-6-34	A.E.	**TITLE:** CHASSIS STYLE MODEL "H" OUTFIT ELECTRICAL UNIT CLAMP
KIND	BRASS CASTING	CHANGED		
SHAPE		"		
FINISH		"		
TEMP.		"		
PATT.	550-741	"		

H. G. FISCHER & CO.
2335 WABANSIA AVE.
CHICAGO, ILL.

CAT. NO.

PART NO. 7453 3/4 F

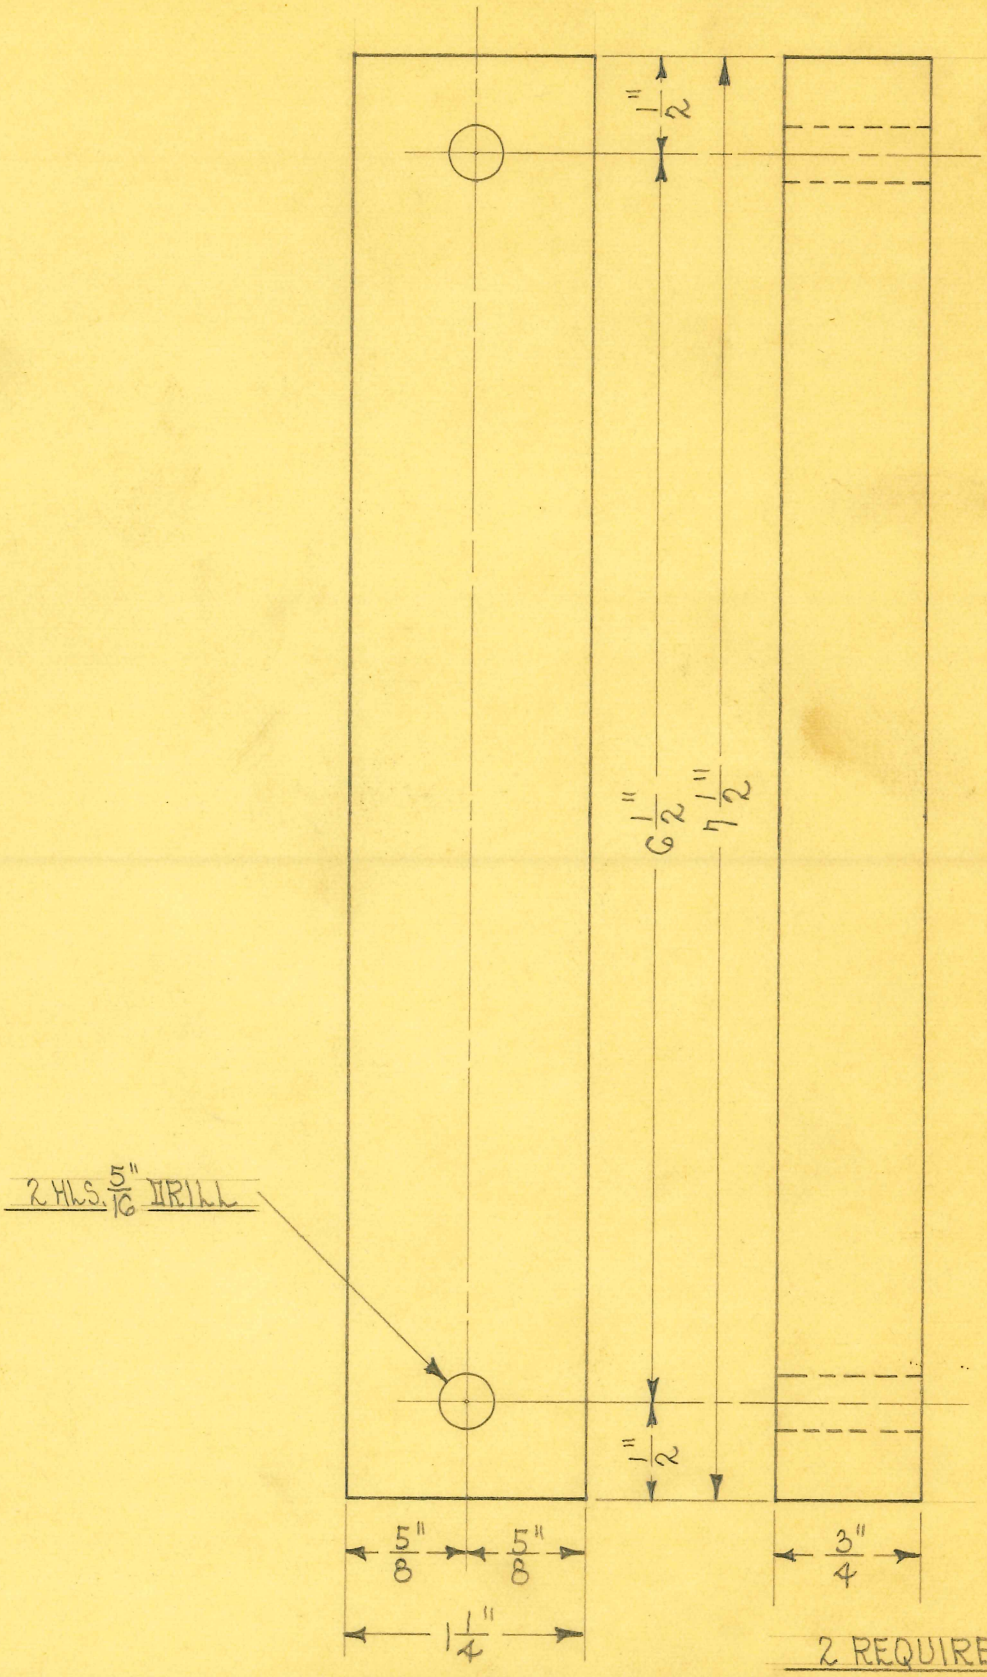

OBSOLETE

SIZE	7½"X1¼"X¾"	ISSUE 10-22-32	A.E.
KIND	H. WOOD	CHANGED	
SHAPE		" "	
FINISH		" "	
TEMP.		" "	
PATT.		" "	

TITLE: FISCHER MOD. "H" DIA. OUTFIT TRANS. BLOCK-UPPER

H. G. FISCHER & CO.
2335 WABANSIA AVE.
CHICAGO, ILL.

CAT. NO.

PART NO. 7458½F

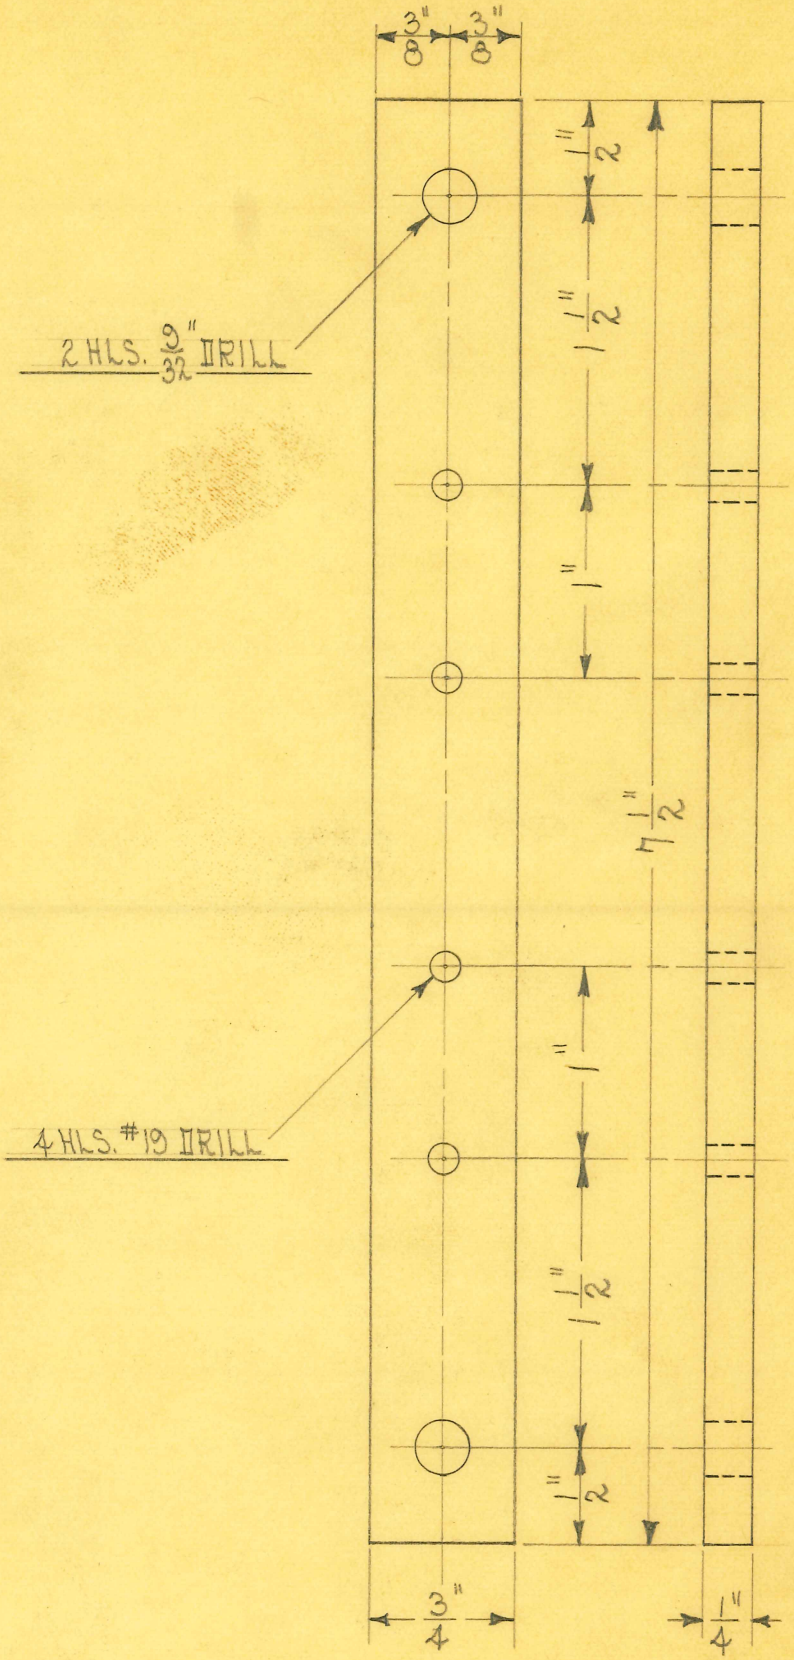

OBSOLETE

SIZE	7½" X ¾" X ¼"	ISSUE 10-21-32	A.E.	TITLE: FISCHER MOD. "H" DIA. OUTFIT TRANS. & CHOKE TERM. STRIP
KIND	N. BAKELITE	CHANGED		
SHAPE	(RICHELAIN)	" "		
FINISH		" "		
TEMP.		" "		
PATT.		" "		

H. G. FISCHER & CO.
2335 WABANSIA AVE.
CHICAGO, ILL.

CAT. NO.

PART NO. 7459

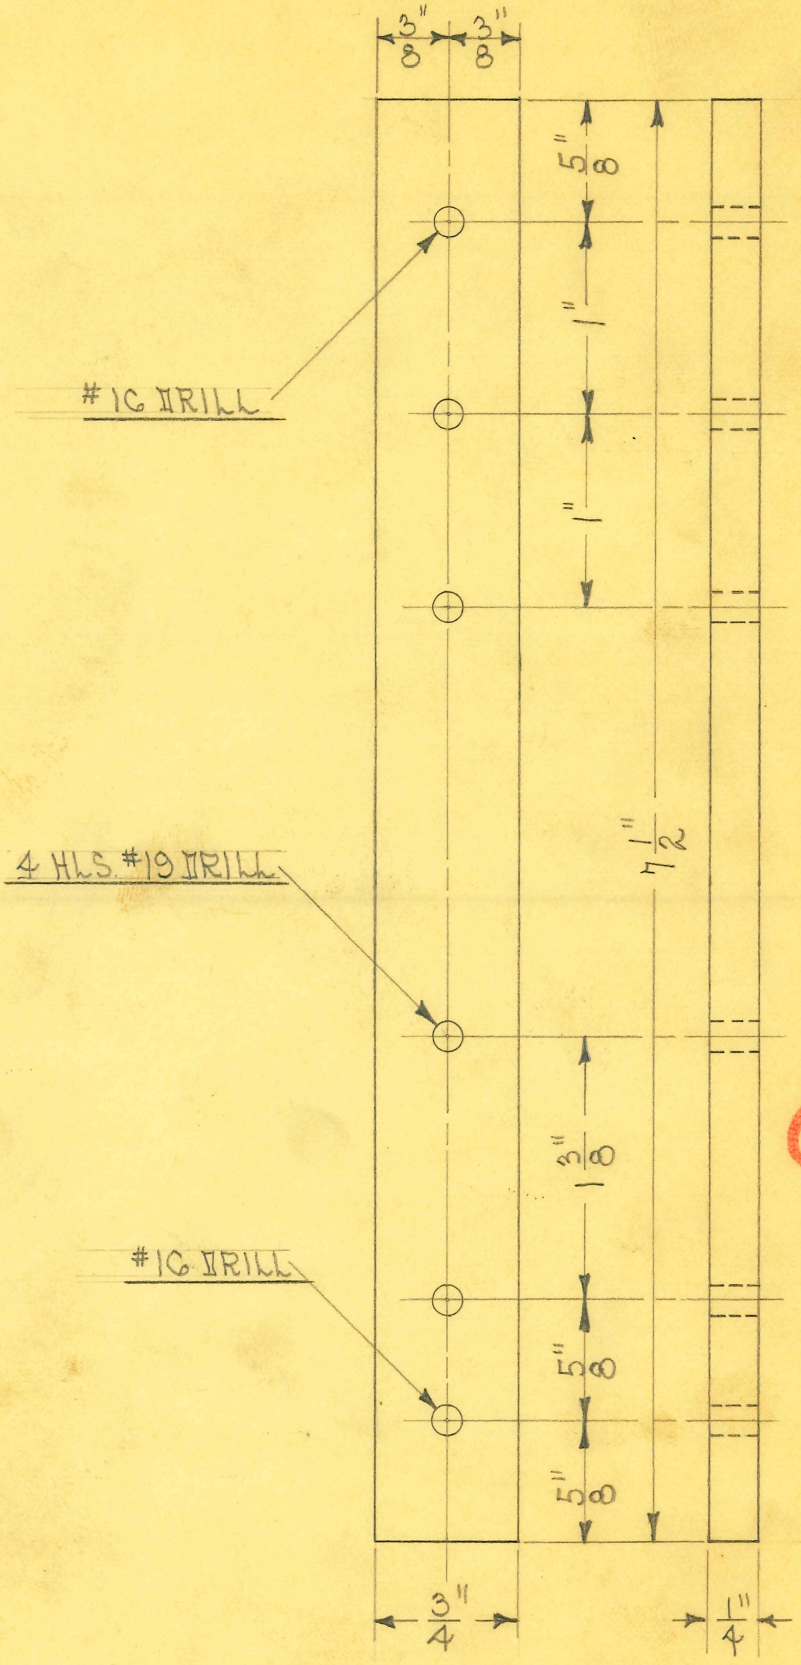

OBSOLETE

SIZE	7½" X 3/4" X 1/4"	ISSUE 10-21-32	2/6.	TITLE: FISCHER MOD. "H" DIA. OUTFIT TRANS. TERM. STRIP
KIND	N. BAKELITE	CHANGED		
SHAPE	(RICHELAIN)	" "		
FINISH		" "		
TEMP.		" "		
PATT.		" "		

H. G. FISCHER & CO.
2335 WABANSIA AVE.
CHICAGO, ILL.

CAT. NO.

PART NO. 7459½

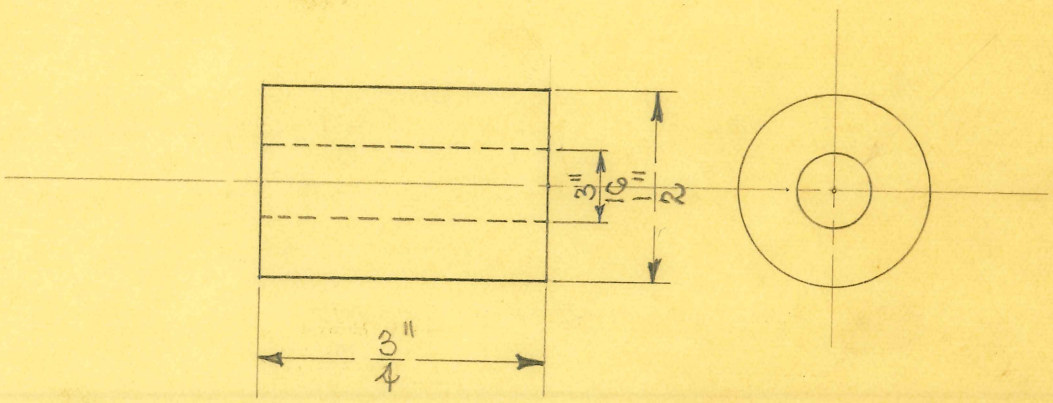

SCALE ~ 1" = 1/2"

OBSOLETE

SIZE	3/16" I.D. X 1/2" O.D.	ISSUE 10-22-32	A.E.	TITLE: FISCHER MODEL "H" IIA. OUTFIT TRANS. TERM. STRIP SPACER
KIND	POL. H. RUB. TUBING	CHANGED		
SHAPE		" "		
FINISH		" "		
TEMP.		" "		
PATT.		" "		

H. G. FISCHER & CO.
2335 WABANSIA AVE.
CHICAGO, ILL.

CAT. NO.

PART NO. 7459 3/4

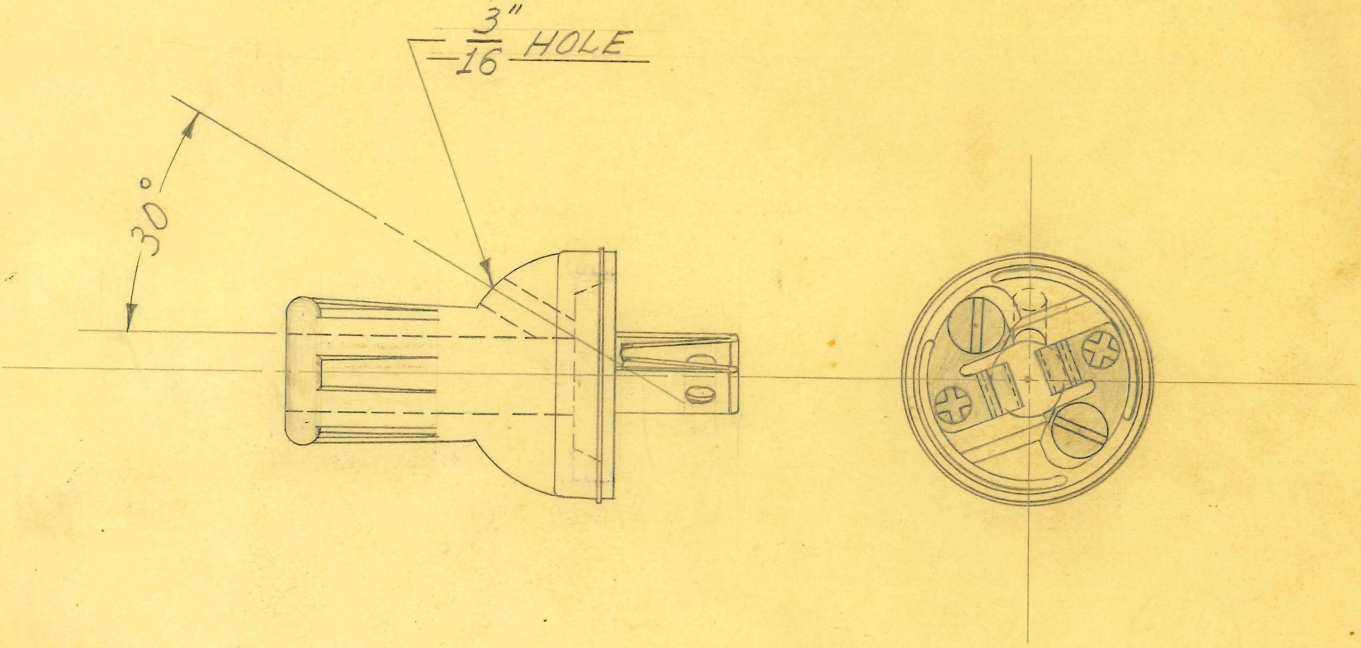

FROM #3498G

1 REQUIRED

OBSOLETE

SIZE		ISSUE 6-24-38	J.W.	TITLE: FISCHER MOD. "H" PORT. -X-RAY UNIT BLACK RUBBER ATTACH. PLUG. -WITH GROUND PLUG HOLE
KIND		CHANGED		
SHAPE		"		
FINISH		"		
TEMP.		"		
PATT.		"		

H. G. FISCHER & CO.
2335 WABANSIA AVE.
CHICAGO, ILL.

CAT. NO.

PART NO. 3498 3/4 G

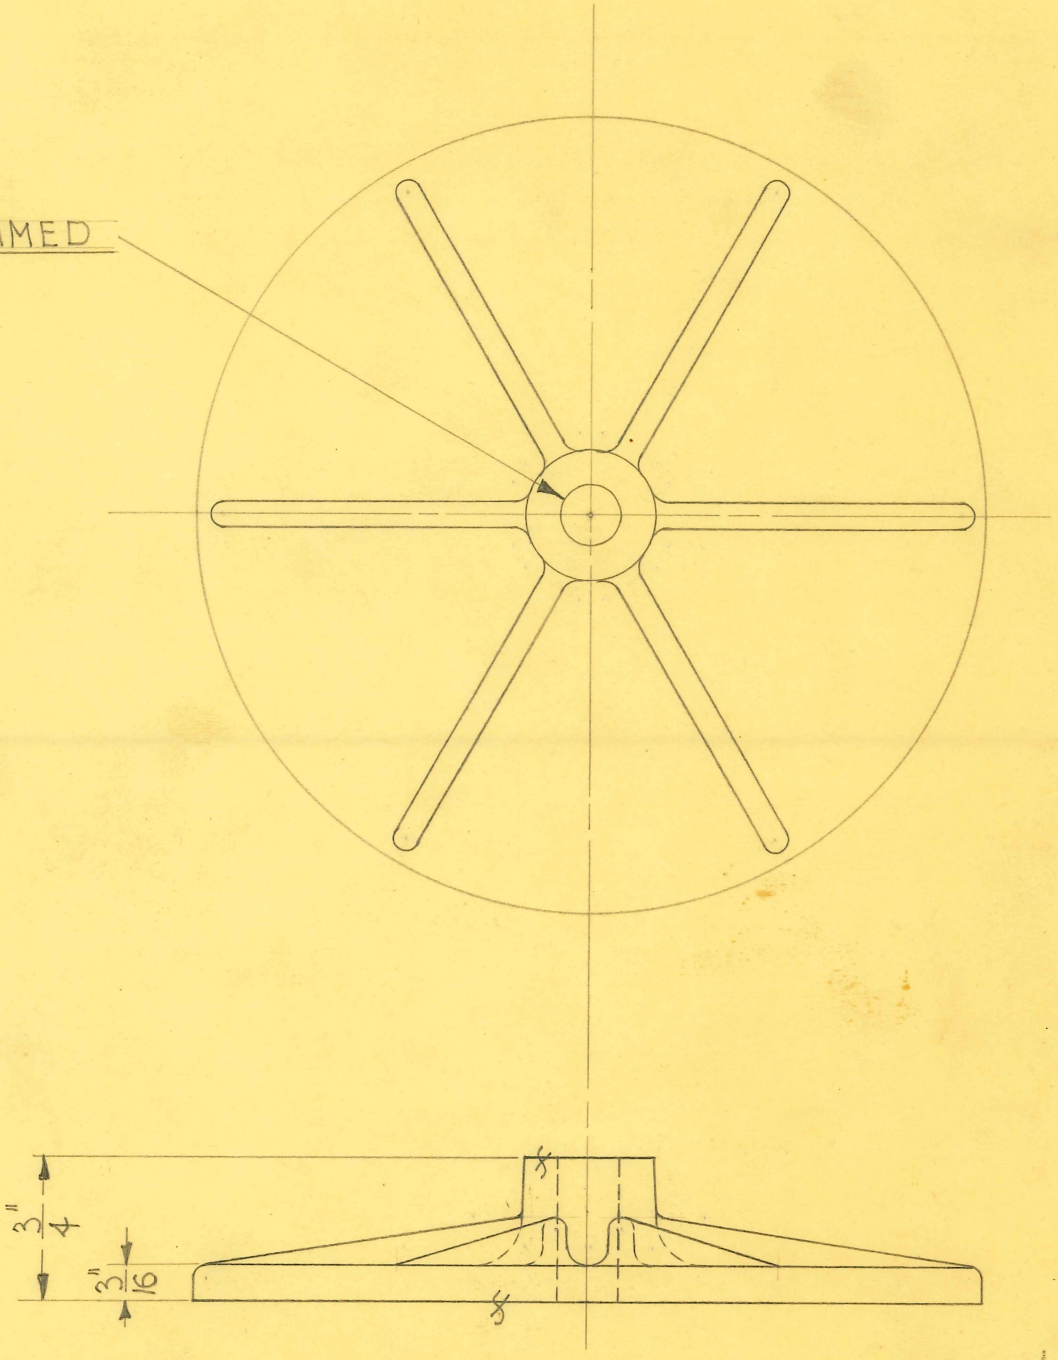

OBSOLETE
4-22-80

1 REQUIRED

SIZE		ISSUE 5-11-38	A.E.
KIND	IRON CASTING	CHANGED	
SHAPE		"	
FINISH	BLACK #80	"	
TEMP.	BACK SIDE	"	
PATT.	1120	"	

TITLE:
FISCHER MOD. "J" GALV. & CONT. CURR. GEN.-
SURGE UNIT-FRICTION DISC

H. G. FISCHER & CO.
2335 WABANSIA AVE.
CHICAGO, ILL.

CAT. NO.

PART NO. 11180F

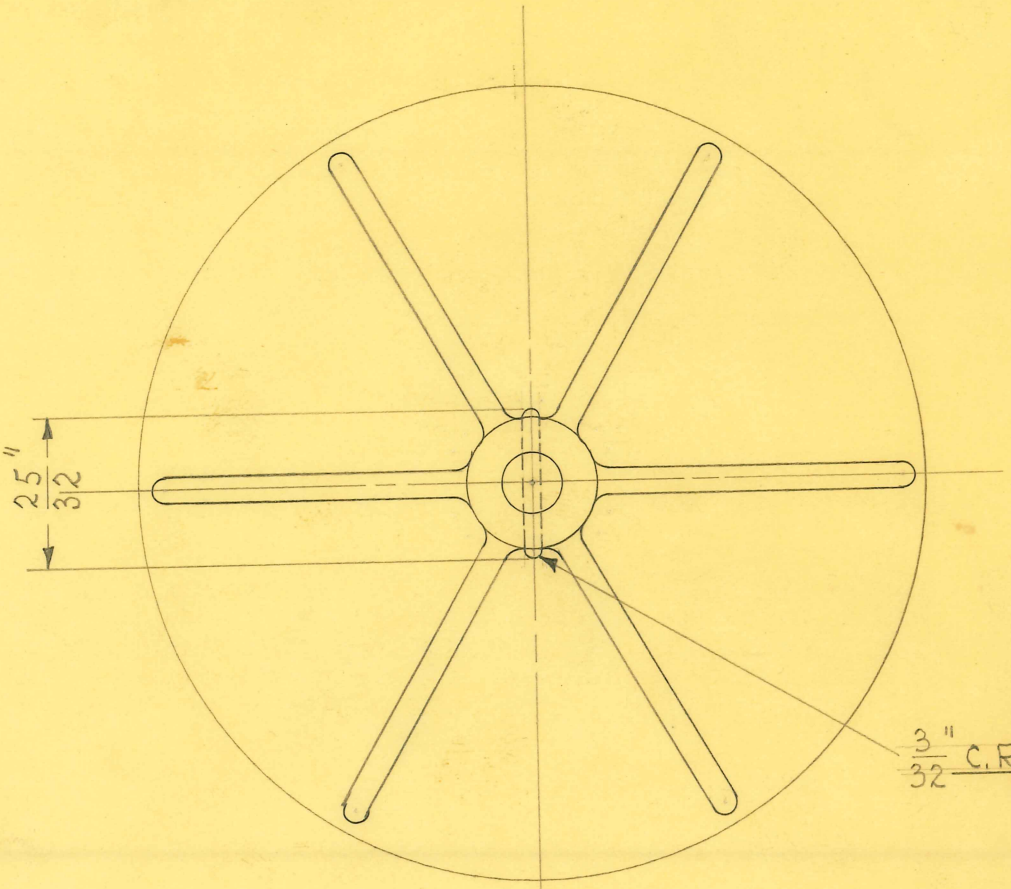

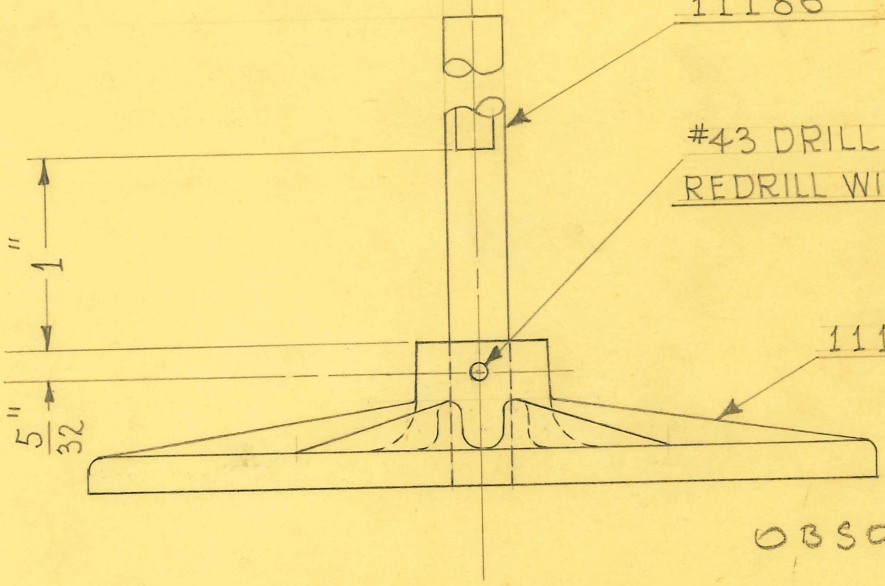

OBSOLETE
4-22-80

1 REQUIRED

SIZE		ISSUE 5-12-38	A.E.
KIND		CHANGED	
SHAPE		"	
FINISH		"	
TEMP.		"	
DATE		"	

TITLE: FISCHER MOD. "J" GALV. & CONT. CURR. GEN. - SURGE UNIT - FRICTION DISC & SHAFT ASSEM.

H. G. FISCHER & CO.
2335 WABANSIA AVE.
CHICAGO, ILL.

CAT. NO.

PART NO. 11190G

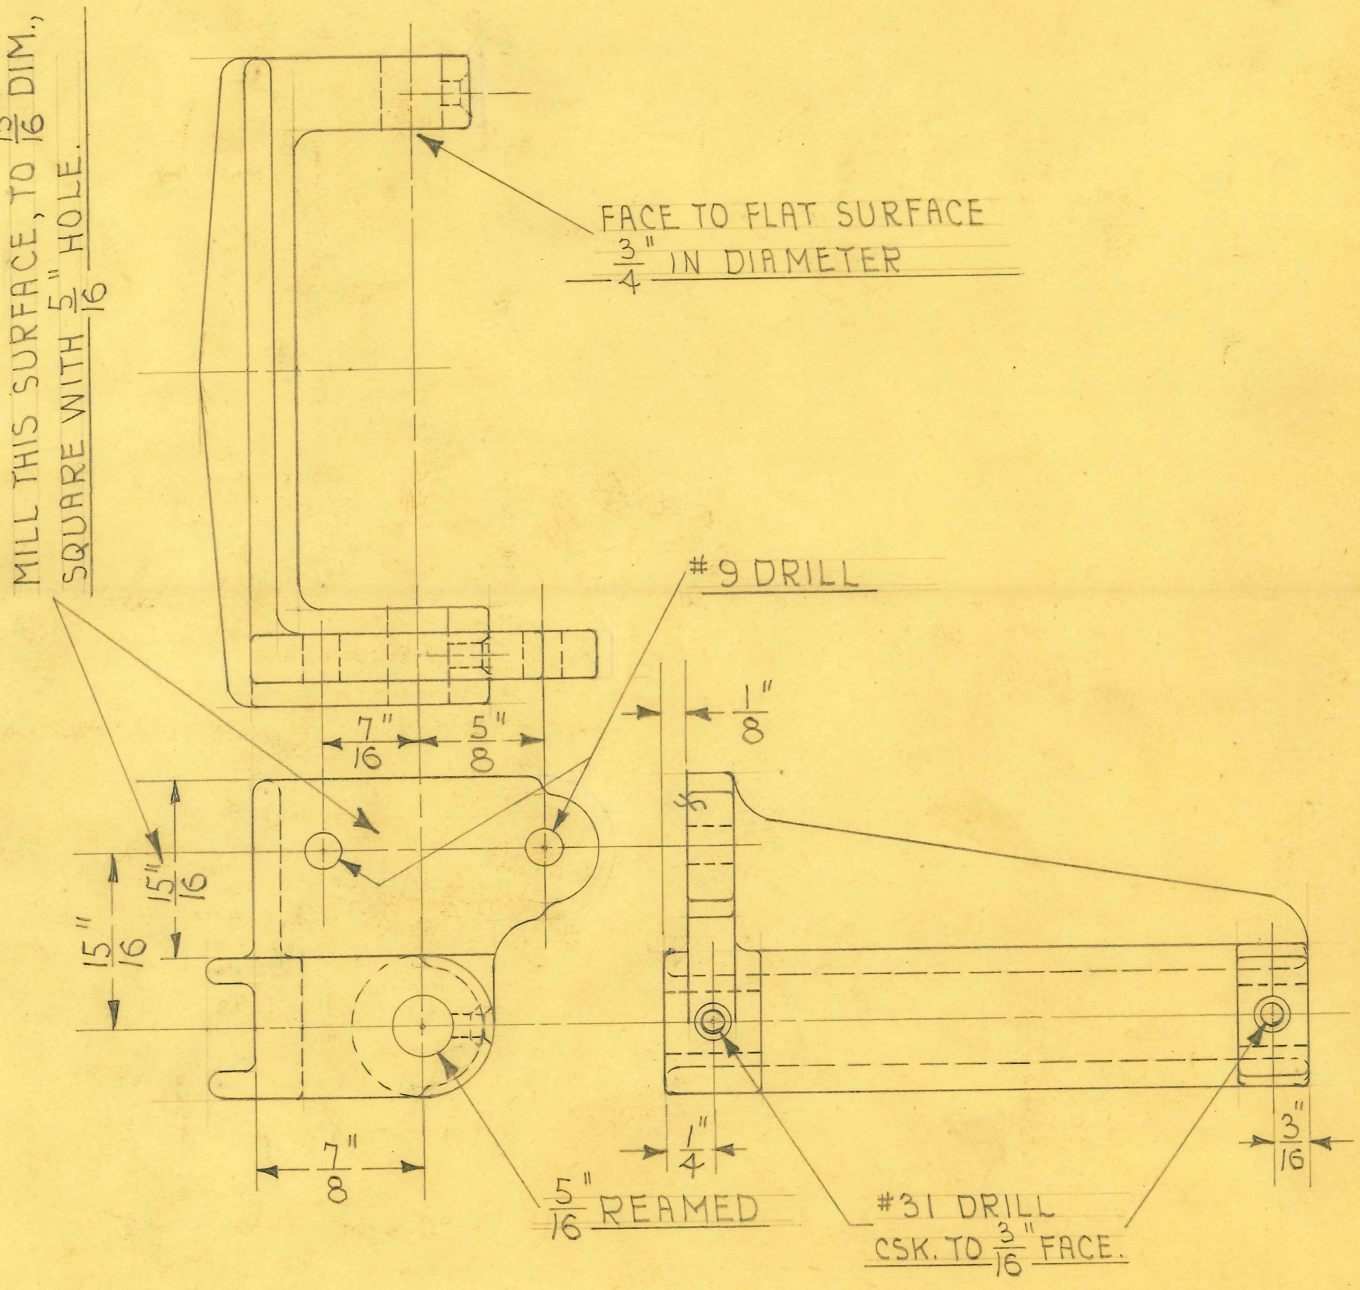

1 REQUIRED

OBSOLETE
4-22-80

SIZE		ISSUE 5-9-38	J.E.
KIND	IRON CASTING	CHANGED 7-1-38	J.W.
SHAPE		"	
FINISH	BLACK #80	"	
TEMP.		"	
PATT.	4426-1139	"	

TITLE: FISCHER MOD. "J" GALV. & CONT. CURR. GEN.-SURGE UNIT- FRICTION PLATE BEARING.

H. G. FISCHER & CO.
2335 WABANSIA AVE.
CHICAGO, ILL.

CAT. NO.

PART NO. 11192AF

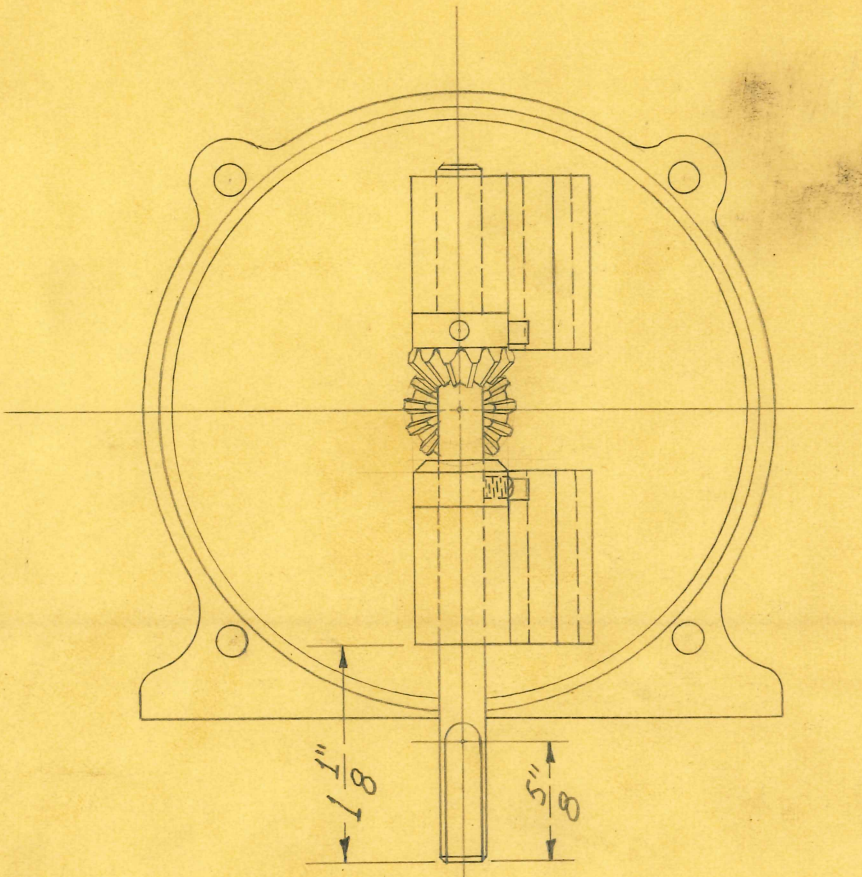

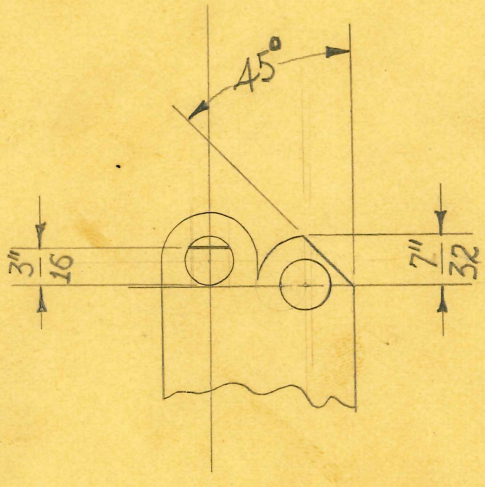

OBSOLETE
8-27-68

SIZE		ISSUE 11-15-38	J.W.
KIND		CHANGED	
SHAPE		"	
FINISH		"	
TEMP.		"	
PATT.		"	

TITLE: FISCHER MOD. "J" GALV. & CONT. CURR. GEN. SURGE UNIT - MOTOR (FINISHED)

H. G. FISCHER & CO.
2335 WABANSIA AVE.
CHICAGO, ILL.

CAT. NO.

PART NO. 11193GF

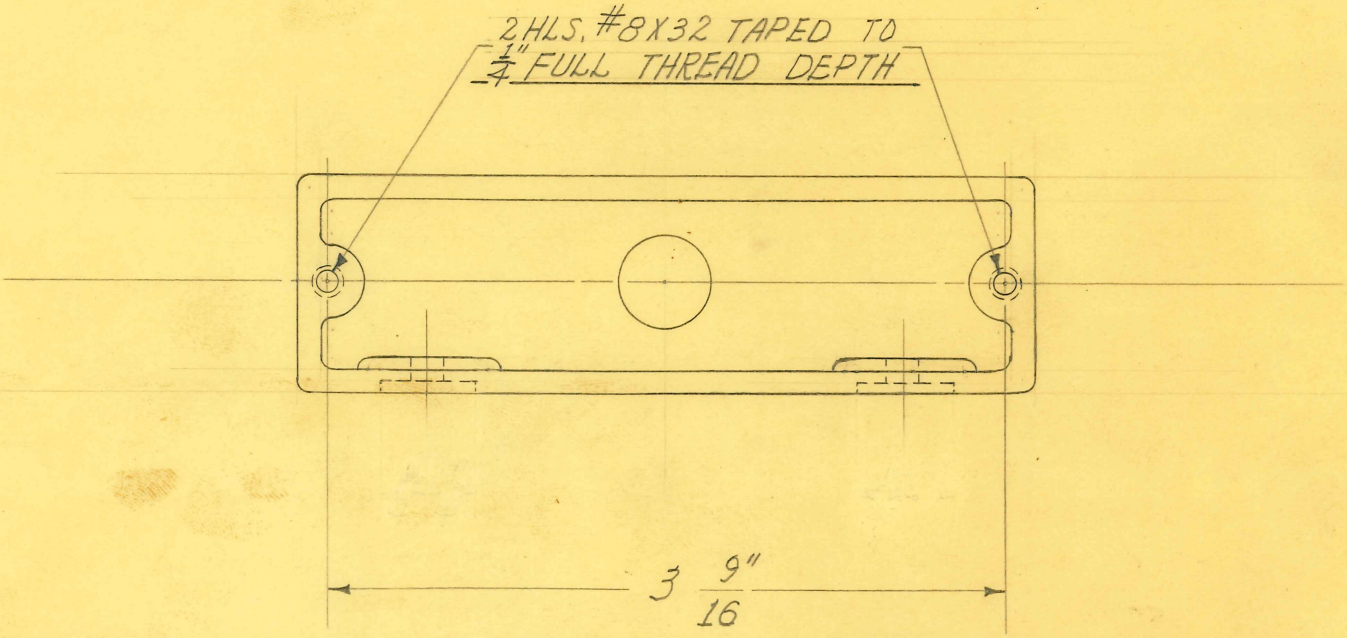

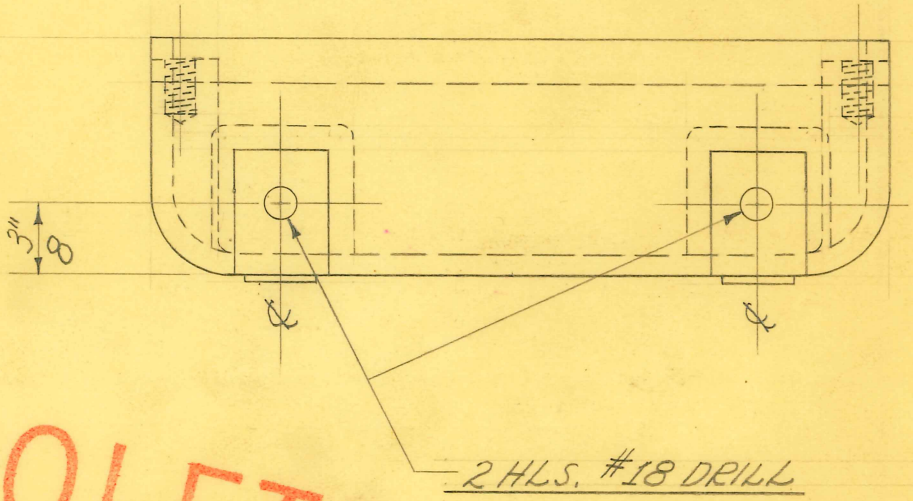

OBSOLETE

1 REQUIRED

SIZE		ISSUE 2-19-38	J.W.
KIND	FROM 11126	CHANGED	
SHAPE		"	
FINISH		"	
TEMP.		"	
PATT.		"	

TITLE: FISCHER MOD. "J" GALV. & CONT. CURR. GEN. POLARITY SWITCH BOX - FINISHED

H. G. FISCHER & CO.
2335 WABANSIA AVE.
CHICAGO, ILL.

CAT. NO.

PART NO. 11126F

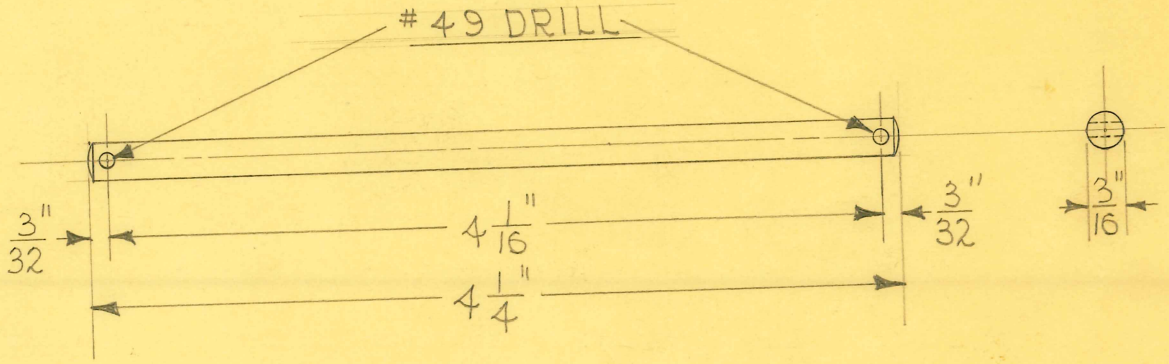

1 REQUIRED

OBSOLETE
4-22-80

SIZE	3/16" DIA.	ISSUE 5-13-38	A.E.
KIND	C.R. STEEL	CHANGED	
SHAPE		"	
FINISH		"	
TEMP.		"	
		"	

TITLE: FISCHER MOD. "J" GALV. & CONT. CURR. GEN. - SURGE UNIT - FRICTION RING REG. ARM SHAFT

H. G. FISCHER & CO.
2335 WABANSIA AVE.
CHICAGO, ILL.

CAT. NO.

PART NO. 11191

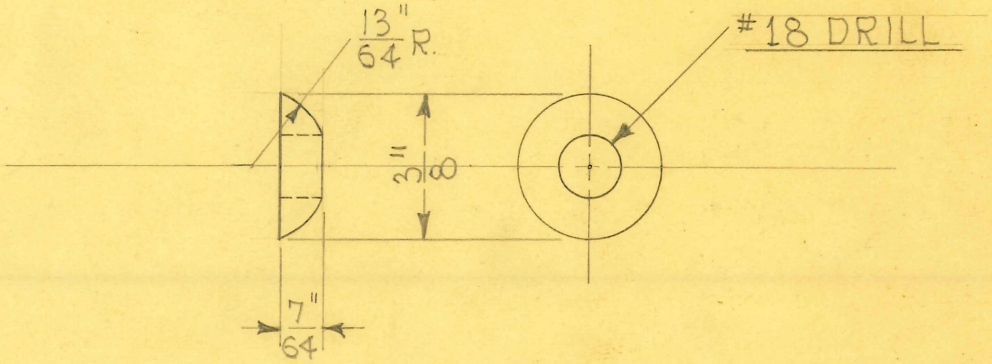

SCALE ~ 1" = 1/2"

1 REQUIRED

OBSOLETE
4-22-80

SIZE	3/8" DIAM.	ISSUE 5-23-38	A.E.
KIND	C.R. STEEL	CHANGED	
SHAPE		"	
FINISH		"	
TEMP.		"	
PATT.		"	

TITLE: FISCHER MOD. "J" GALV. & CONT. CURR. GEN.-POLARITY SWITCH BOX MOUNTING WASHER

H. G. FISCHER & CO.
2335 WABANSIA AVE.
CHICAGO, ILL.

CAT. NO.

PART NO. 11203

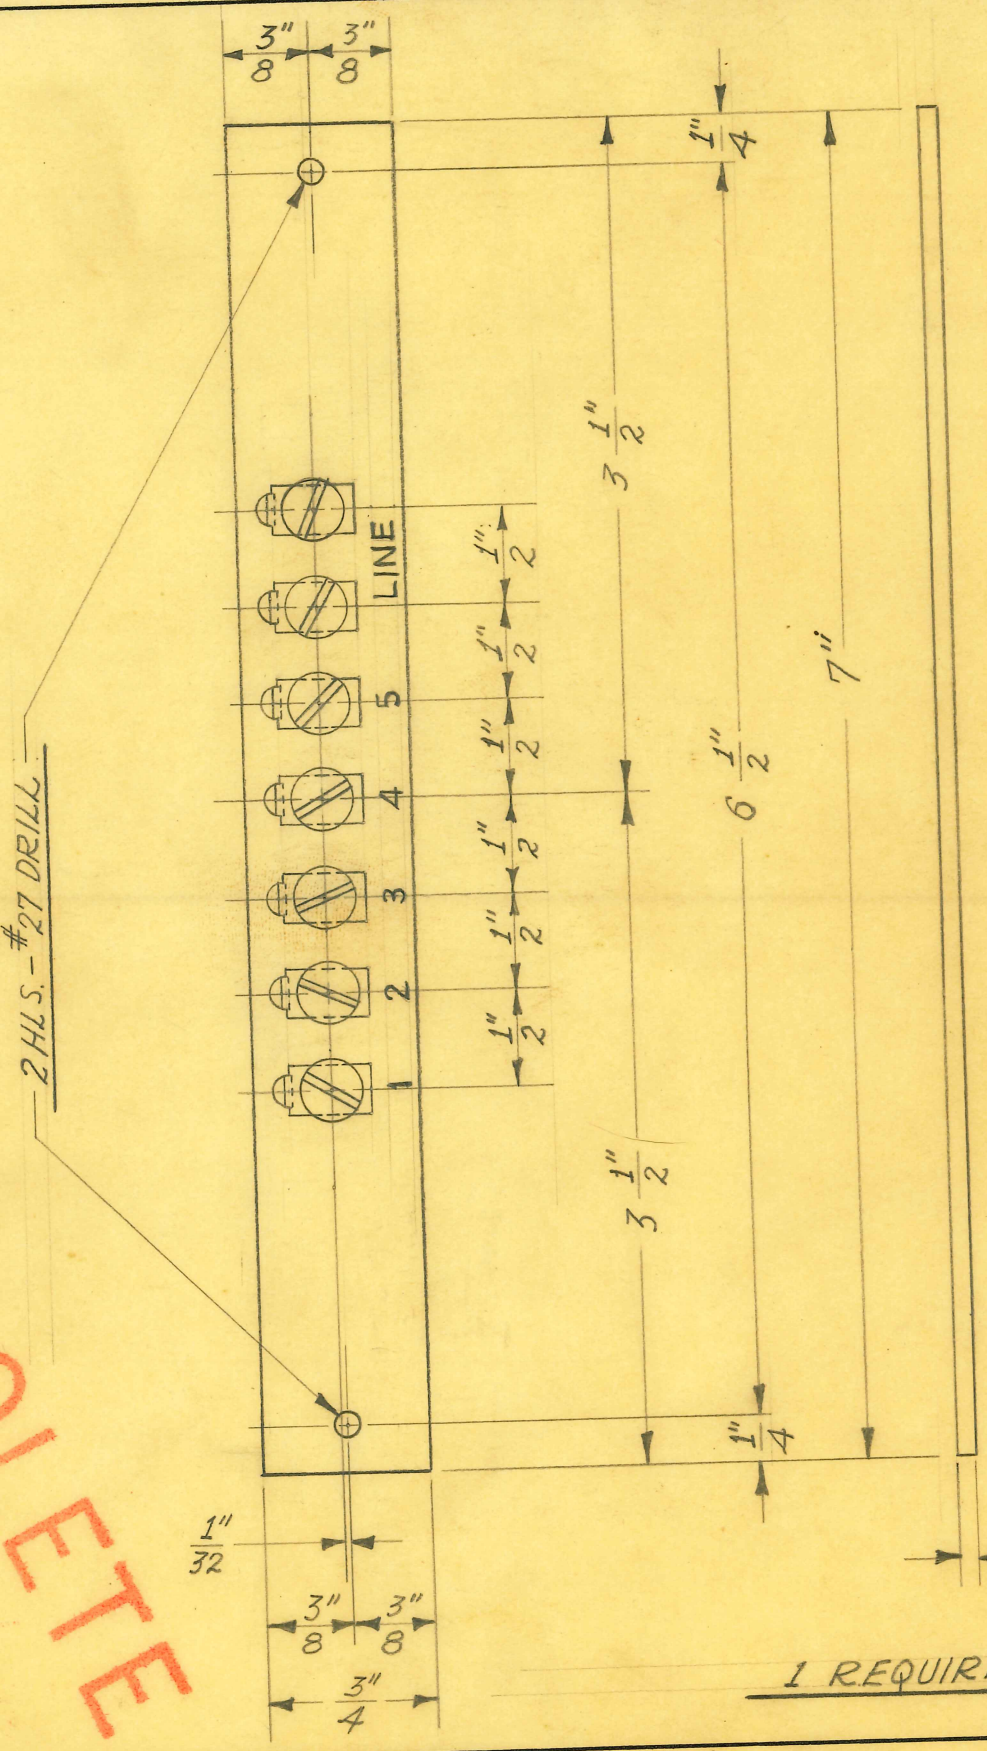

OBSOLETE

1 REQUIRED

SIZE		ISSUE 1-5-39	J.W.
KIND		CHANGED	
SHAPE		"	
FINISH		"	
TEMP.		"	
PATT.		"	

TITLE: FISCHER MOD. "J" GALV. & CONT. CURR. GEN. OSCIL. COIL TERMINAL BOARD

H. G. FISCHER & CO.
2335 WABANSIA AVE.
CHICAGO, ILL.

CAT. NO.

PART NO. 11119G

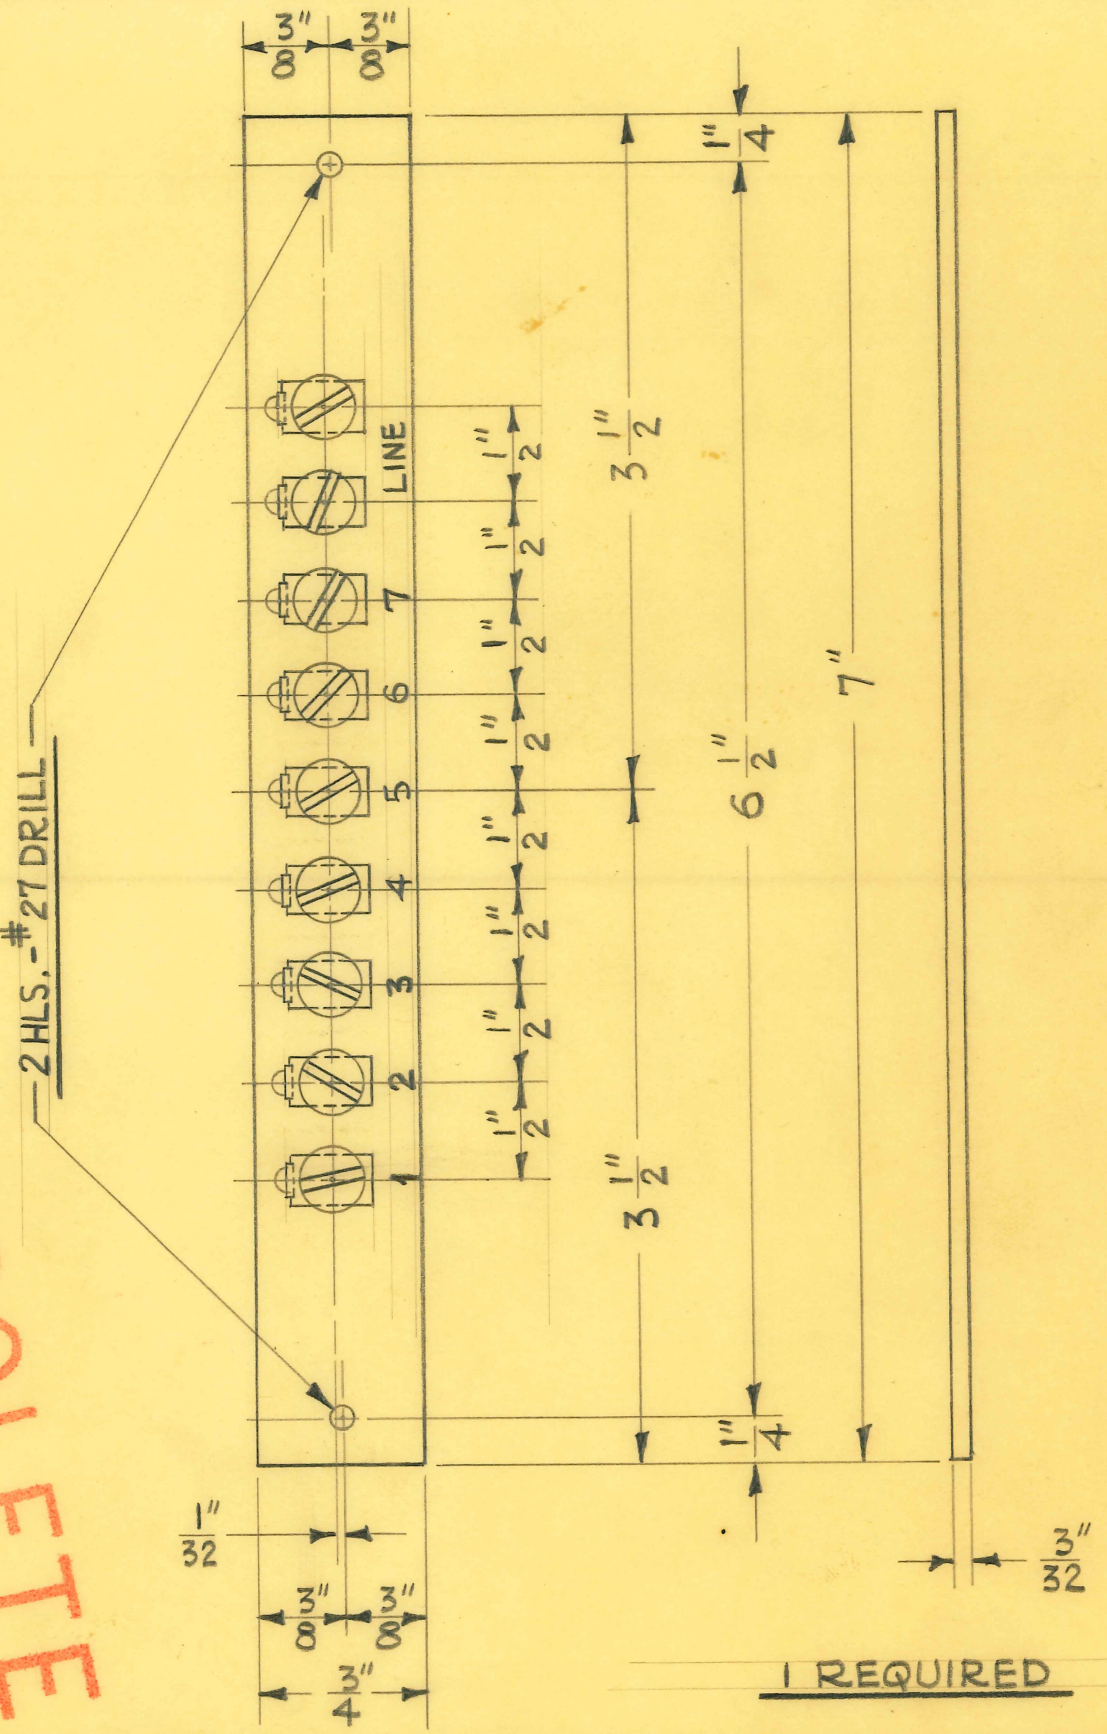

OBSOLETE

1 REQUIRED

SIZE		ISSUE 12-11-41	J.V.W.
KIND		CHANGED	
SHAPE		"	
FINISH		"	
TEMP.		"	
PATT.		"	

TITLE:
FISCHER MOD. "J" GALV. & CONT. CURR. GEN. OSCIL. COIL TERMINAL BOARD

H. G. FISCHER & CO.
2335 WABANSIA AVE.
CHICAGO, ILL.

CAT. NO.

PART NO. 11119GA

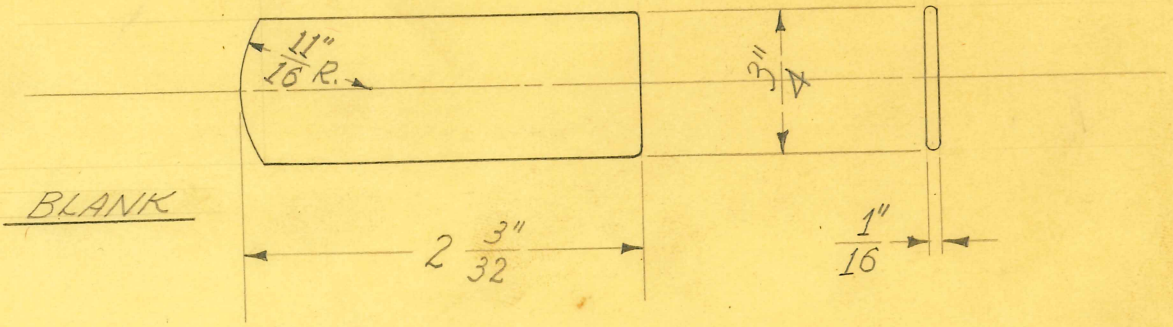

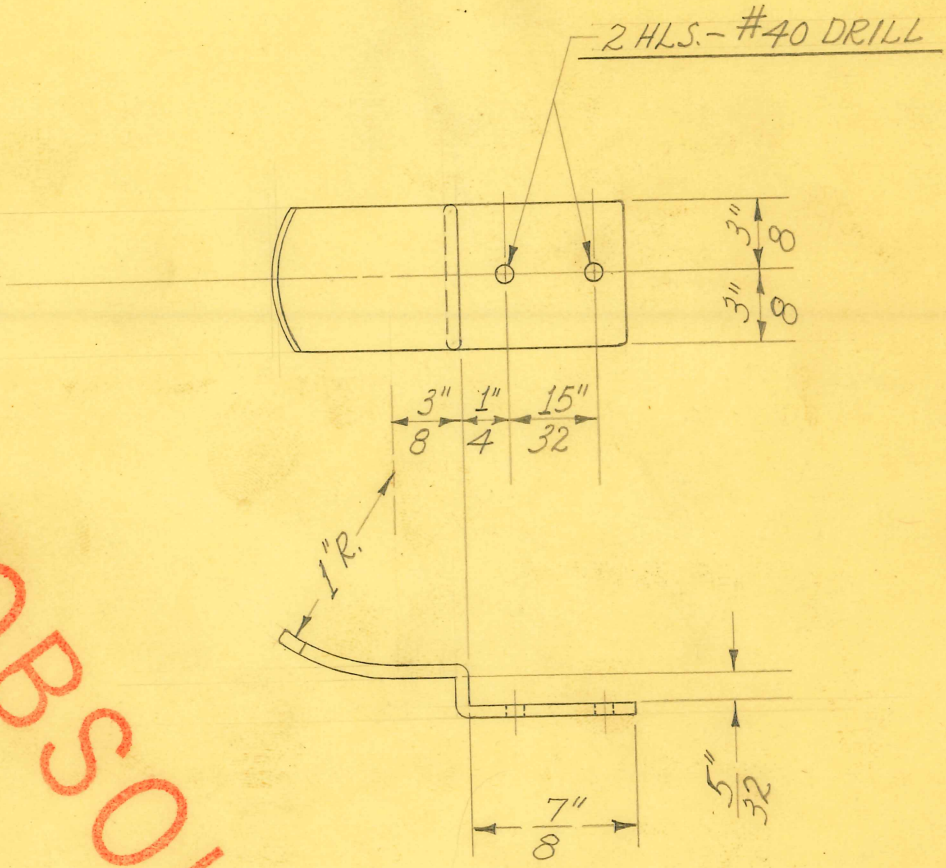

OBSOLETE

2 REQUIRED

SIZE	3/4" X 1/16"	ISSUE 5-17-38	J.W.
KIND	FLAT WIRE	CHANGED	
SHAPE		"	
FINISH		"	
TEMP.		"	
PATT.		"	

TITLE: FISCHER MOD. "J" GALV. & CONT. CURR. GEN. CABINET DOOR CLIP

H. G. FISCHER & CO.
2335 WABANSIA AVE.
CHICAGO, ILL.

CAT. NO.

PART NO. 11123

ROUND EDGES & CORNERS

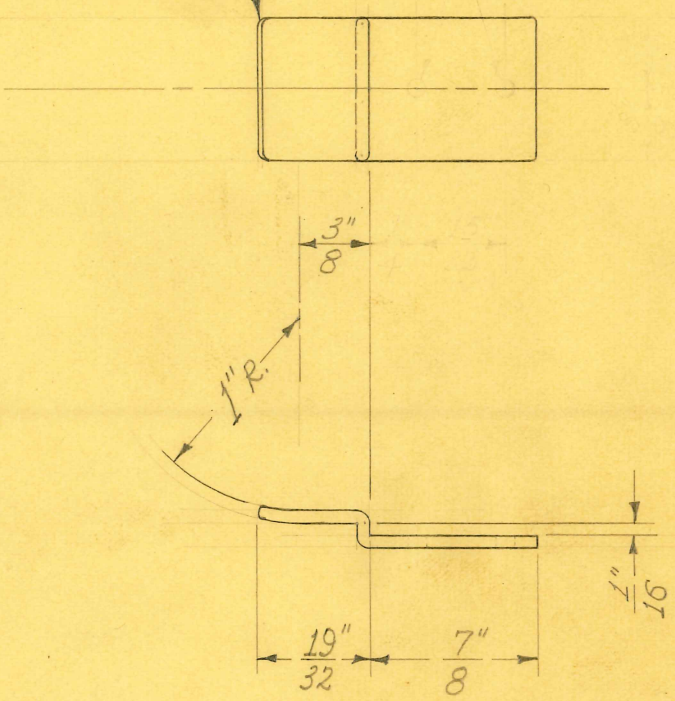

FROM PCE. # 11123A

2 REQUIRED

OBSOLETE

SIZE		ISSUE 8-23-38	J.W.
KIND		CHANGED 1-11-39	J.W.
SHAPE		"	
FINISH		"	
TEMP.		"	
PATT.		"	

TITLE: FISCHER MOD. "J" GALV. & CONT. CURR. GEN. CABINET DOOR CLIP-FRONT

H. G. FISCHER & CO.
2335 WABANSIA AVE.
CHICAGO, ILL.

CAT. NO.

PART NO. 11123 1/2

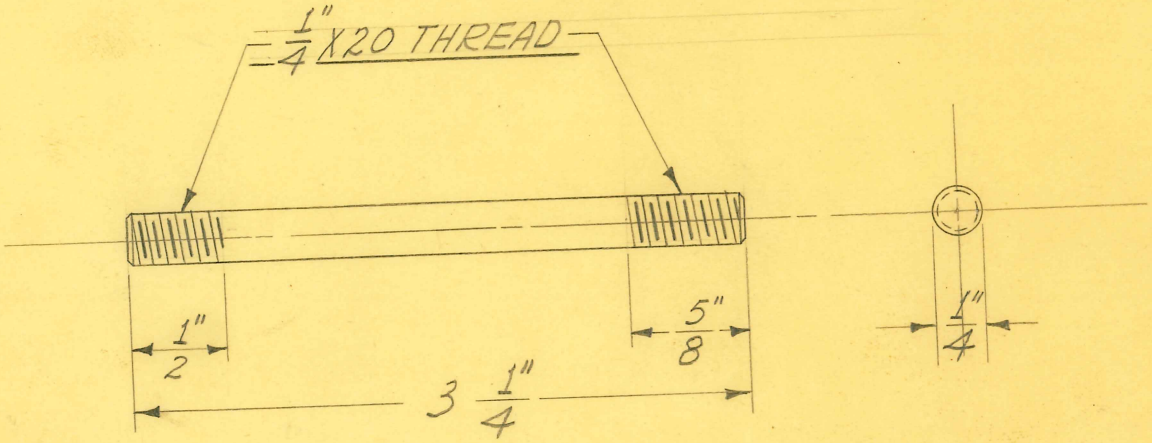

4 REQUIRED

OBSOLETE

SIZE	1/4" DIAM.	ISSUE 2-18-38	J.W.	
KIND	C.R. STEEL	CHANGED		
SHAPE		"		
FINISH		"		
TEMP.		"		
DATE		"		

TITLE: FISCHER MOD. "J" GALV. & CONT. CURR. GEN. POWER TRANSFORMER CLAMP STUD

H. G. FISCHER & CO.
2335 WABANSIA AVE.
CHICAGO, ILL.

CAT. NO.

PART NO. 11124

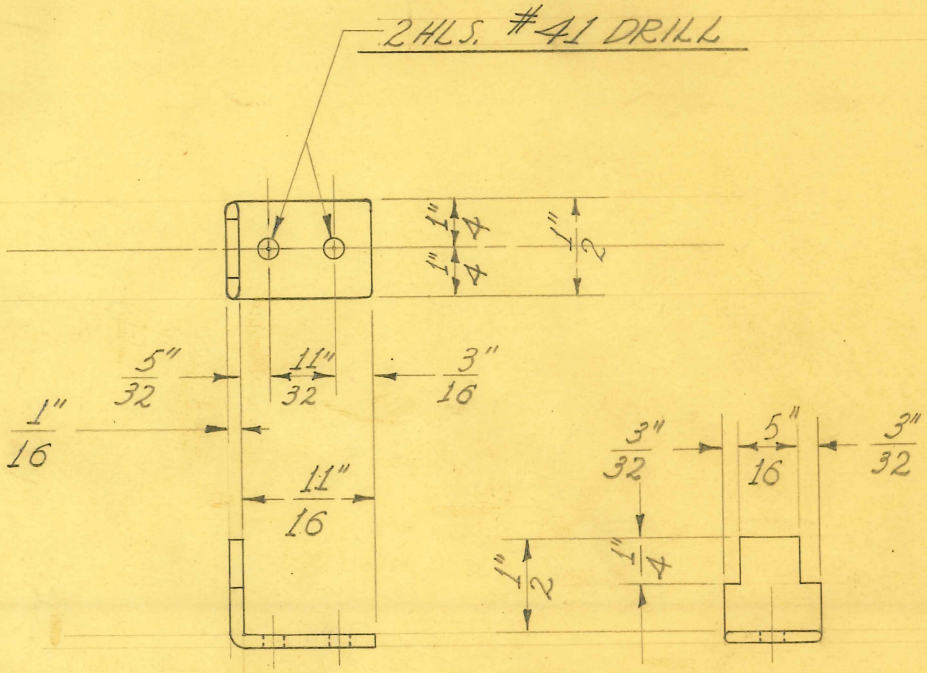

1 REQUIRED

OBSOLETE

Obsolete

SIZE	1/2" X 1/16"	ISSUE 2-15-38	J.W.
KIND	FLAT WIRE	CHANGED	
SHAPE		"	
FINISH		"	
TEMP.		"	
PATT.		"	

TITLE: FISCHER MOD. "J" GALV. & CONT. CURR. GEN. POTENTIOMETER ALIGNING BRACKET

H. G. FISCHER & CO.
2335 WABANSIA AVE.
CHICAGO, ILL.

CAT. NO.

PART NO. 11130

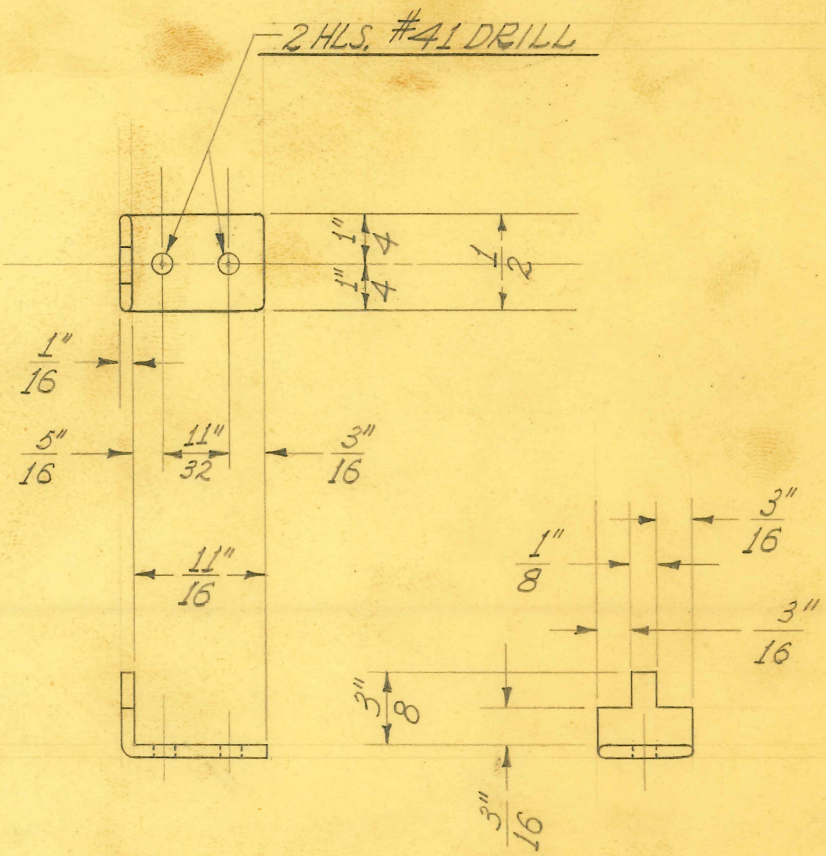

1 REQUIRED

OBSOLETE

Obsolete

SIZE	1/2" X 1/16"	ISSUE 2-15-38	J.W.
KIND	FLAT WIRE	CHANGED	
SHAPE		"	
FINISH		"	
TEMP.		"	
PATT.		"	

TITLE: FISCHER MOD. "J" GALV. & CONT. CURR. GEN. VERNIER CONTROL ALIGNING BRACKET

H. G. FISCHER & CO.
2335 WABANSIA AVE.
CHICAGO, ILL.

CAT. NO.

PART NO. 11132

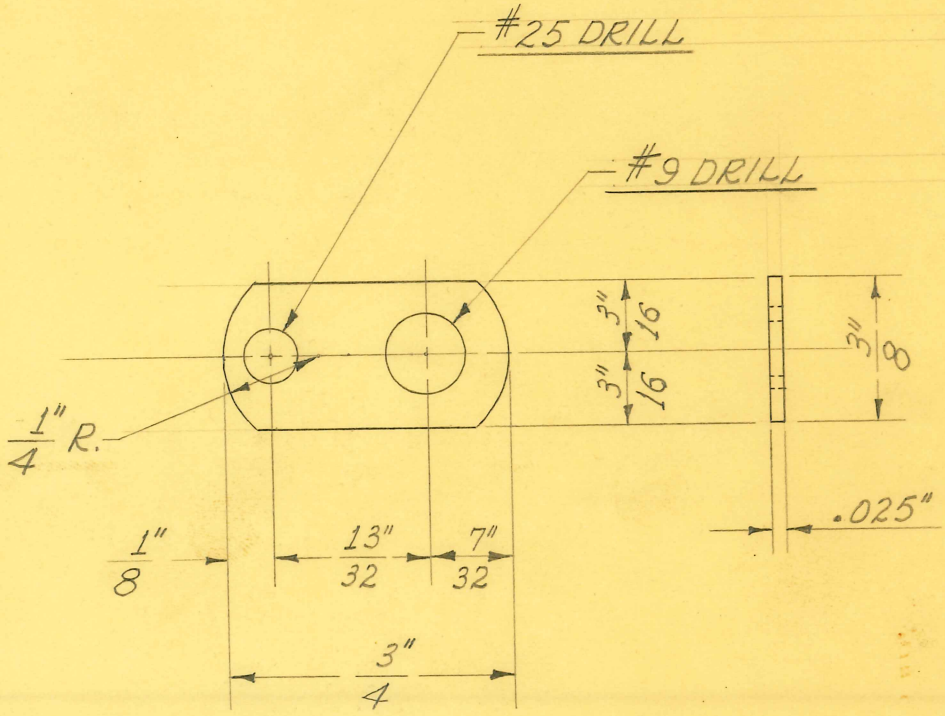

SCALE ÷ DOUBLE SIZE

6 REQUIRED

OBSOLETE

SIZE	.025"	ISSUE 2-16-38	J.W.
KIND	SHEET BRASS	CHANGED	
SHAPE		"	
FINISH		"	
TEMP.		"	
PATT.		"	

TITLE: FISCHER MOD. "J" GALV. & CONT. CURR. GEN. SELECTOR SWITCH CONN. LINK.

H. G. FISCHER & CO.
2335 WABANSIA AVE.
CHICAGO, ILL.

CAT. NO.

PART NO. 11134

1 REQUIRED

OBSOLETE

Obsolete

SIZE		ISSUE 3-14-38	J.W.
KIND	FROM 11135G	CHANGED	
SHAPE		"	
FINISH		"	
TEMP.		"	
PATT.		"	

TITLE:
FISCHER MOD. "J" GALV. & CONT. CURR. GEN.
OSCILLATING COIL - DRILLED

H. G. FISCHER & CO.
2335 WABANSIA AVE.
CHICAGO, ILL.

CAT. NO.

PART NO. 11135GF

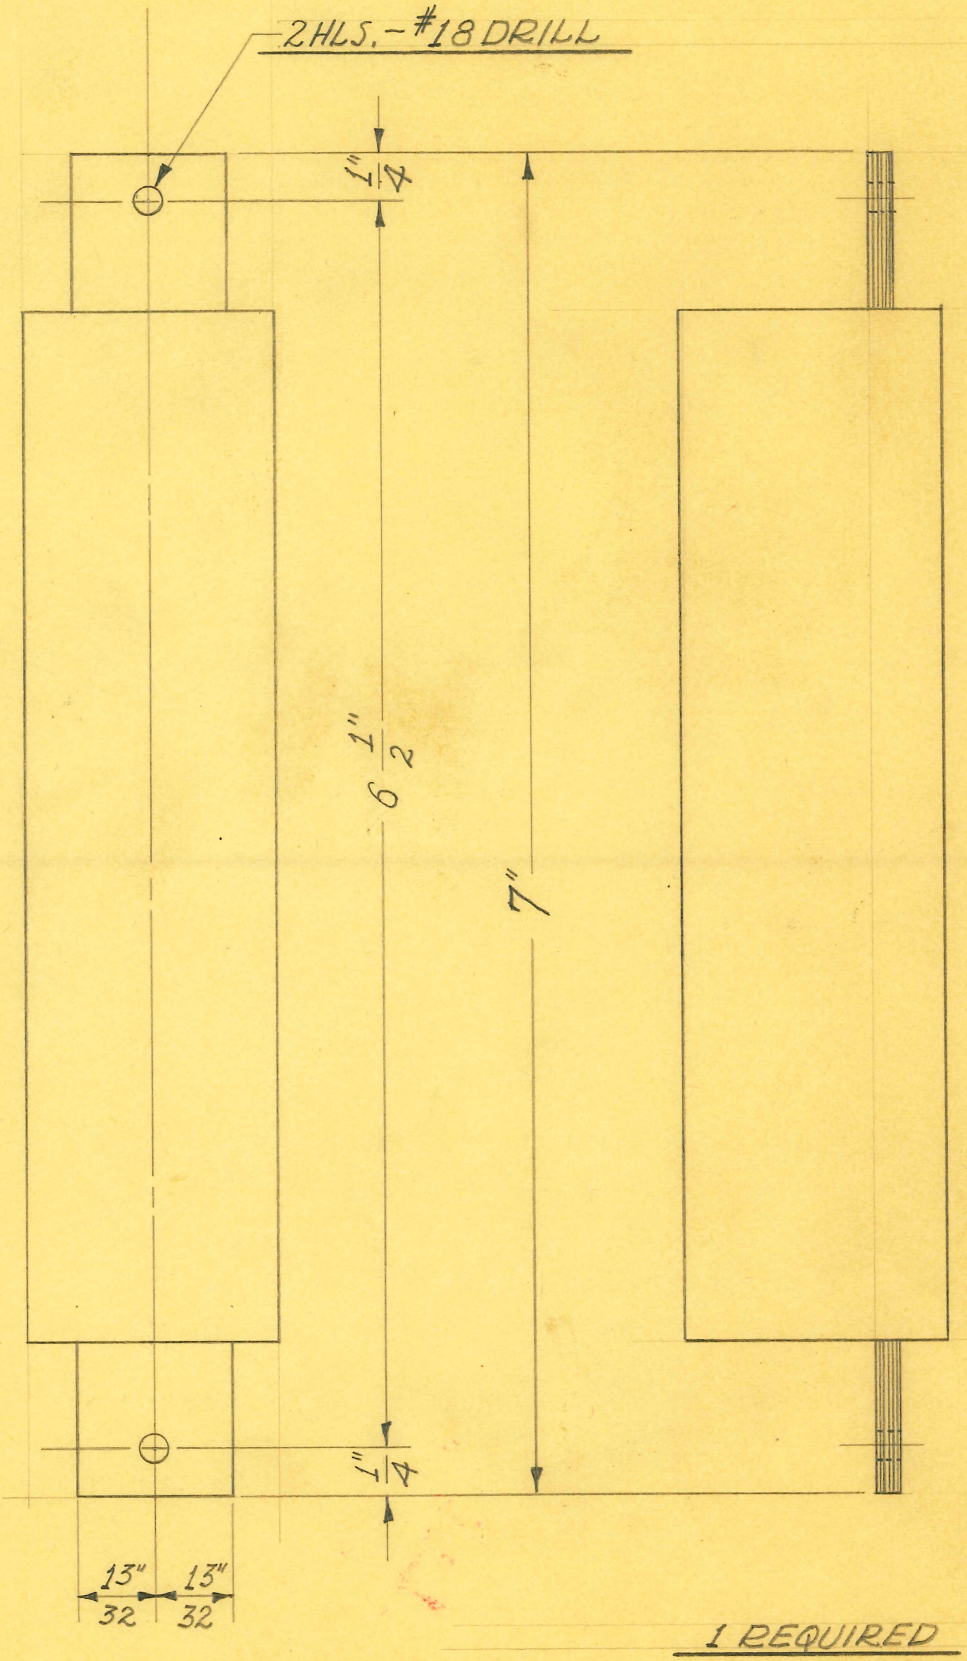

OBSOLETE

1 REQUIRED

SIZE		ISSUE 11-1-38	J.W.
KIND	FROM. 11135GA	CHANGED	
SHAPE		"	
FINISH		"	
TEMP.		"	
PATT.		"	

TITLE: FISCHER MOD. "J" GALV. & CONT. CURR. GEN. OSCILLATING COIL - DRILLED

H. G. FISCHER & CO.
2335 WABANSIA AVE.
CHICAGO, ILL.

CAT. NO.

PART NO. 11135GAF

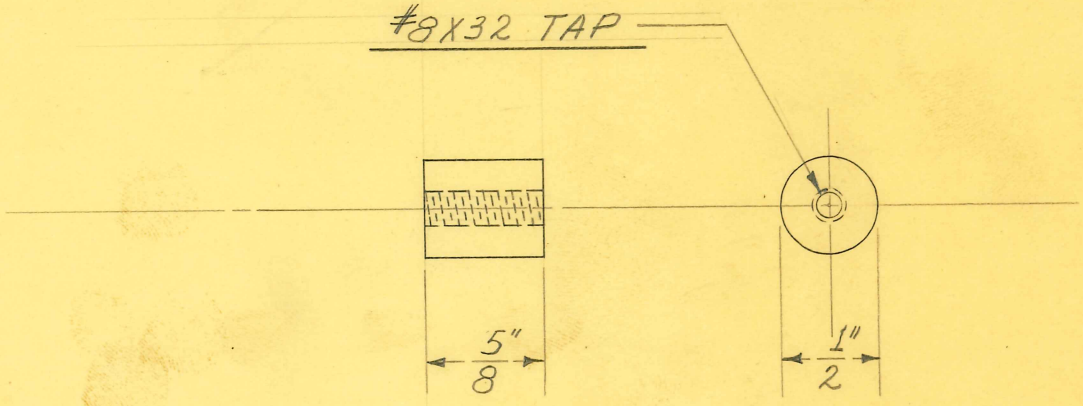

2 REQUIRED

OBSOLETE

Obsolete

SIZE	1/2" DIAM.	ISSUE 2-15-38	J.W.
KIND	BRASS ROD	CHANGED	
SHAPE		"	
FINISH	BLACK #80,	"	
TEMP.		"	
PATT.		"	

TITLE: FISCHER MOD. "J" GALV. & CONT. CURR. GEN. OSCILLATING COIL SPACER

H. G. FISCHER & CO.
2335 WABANSIA AVE.
CHICAGO, ILL.

CAT. NO.

PART NO. 11136

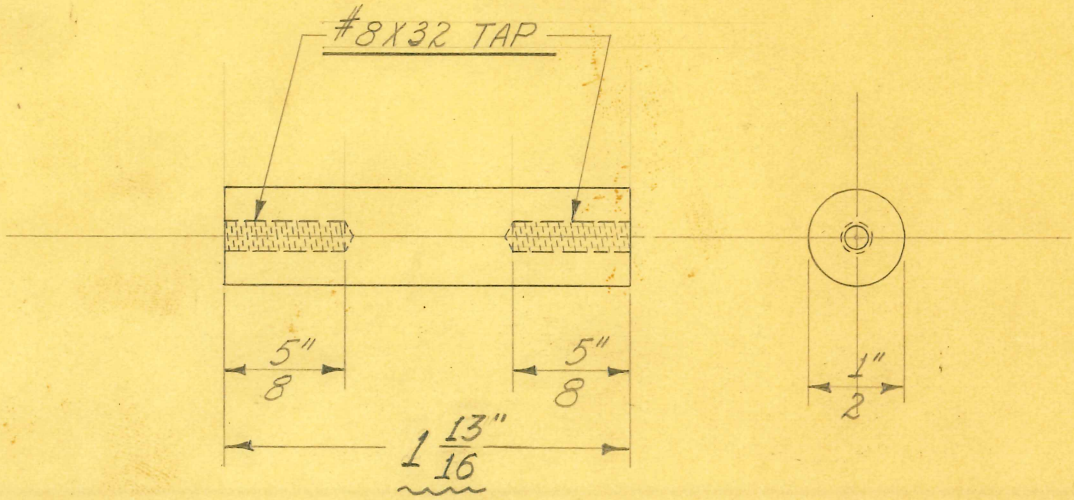

2 REQUIRED

OBSOLETE

SIZE	1/2" DIAM.	ISSUE 7-12-38	J.W.
KIND	BRASS. ROD	CHANGED	
SHAPE		"	
FINISH	DIP #7	"	
TEMP.		"	
PATT.		"	

TITLE: FISCHER MOD. "J" GALV. & CONT. CURR. GEN. OSCILLATING COIL SPACER

H. G. FISCHER & CO.
2335 WABANSIA AVE.
CHICAGO, ILL.

CAT. NO.

PART NO. 11136B

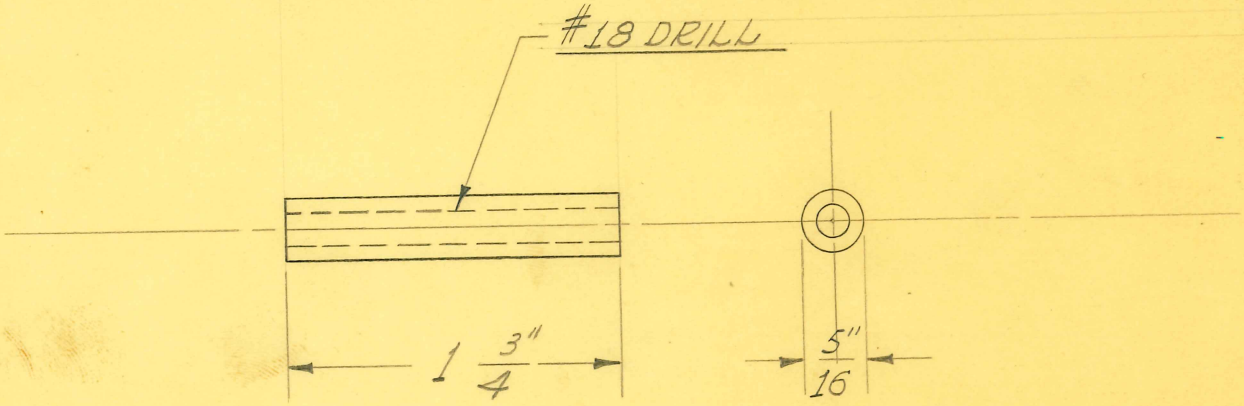

2 REQUIRED

OBSOLETE

SIZE	5/16" DIAM.	ISSUE 2-15-38	J.W.
KIND	BRASS ROD	CHANGED	
SHAPE		"	
FINISH	BLACK #80.	"	
TEMP.		"	
PATT.		"	

TITLE: FISCHER MOD. "J" GALV. & CONT. CURR. GEN. OSCILLATING COIL TERMINAL BOARD SPACER

H. G. FISCHER & CO.
2335 WABANSIA AVE.
CHICAGO, ILL.

CAT. NO.

PART NO. 11137

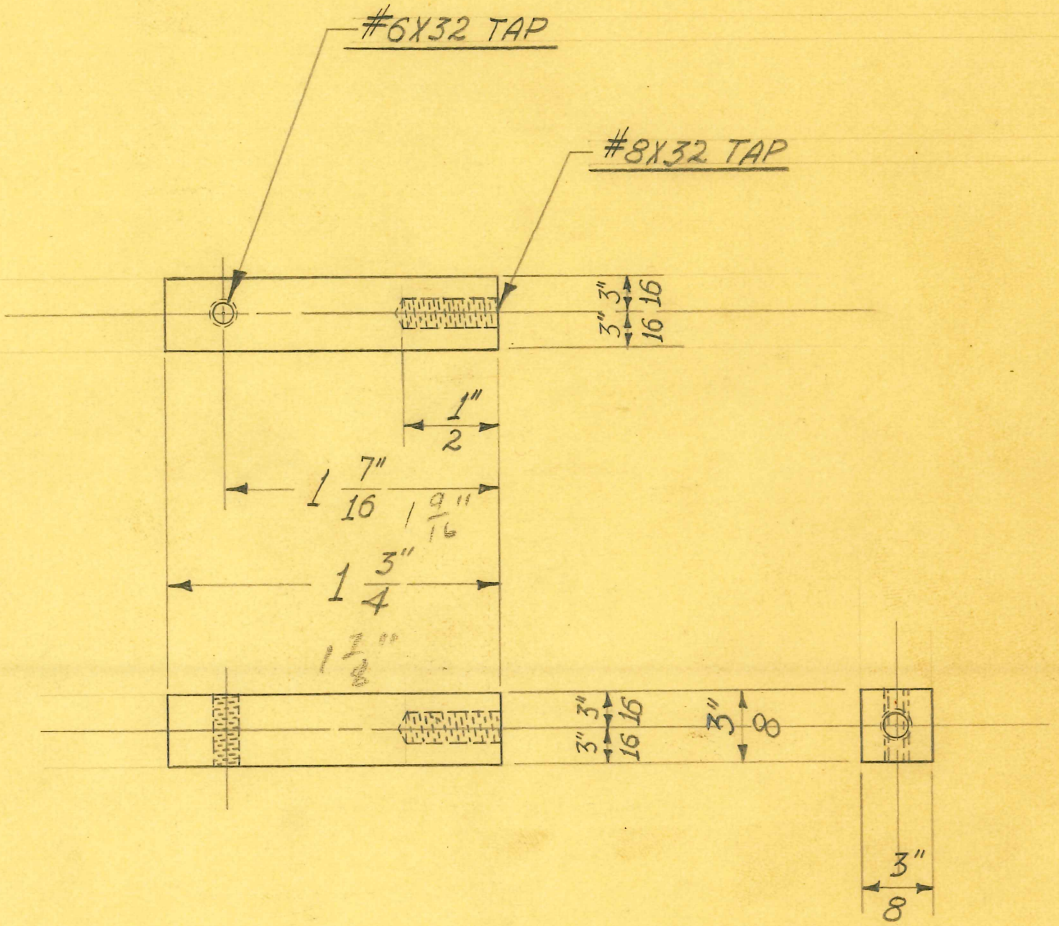

2 REQUIRED

OBSOLETE

SIZE	3/8" SQUARE	ISSUE 11-1-38	J.W.
KIND	BRASS ROD	CHANGED	
SHAPE		"	
FINISH	DIP #7	"	
TEMP.		"	
PATT.		"	

TITLE: FISCHER MOD. "J" GALV. & CONT. CURR. GEN. OSCILLATING COIL TERMINAL BOARD SPACER

H. G. FISCHER & CO.
2335 WABANSIA AVE.
CHICAGO, ILL.

CAT. NO.

PART NO. 11137A

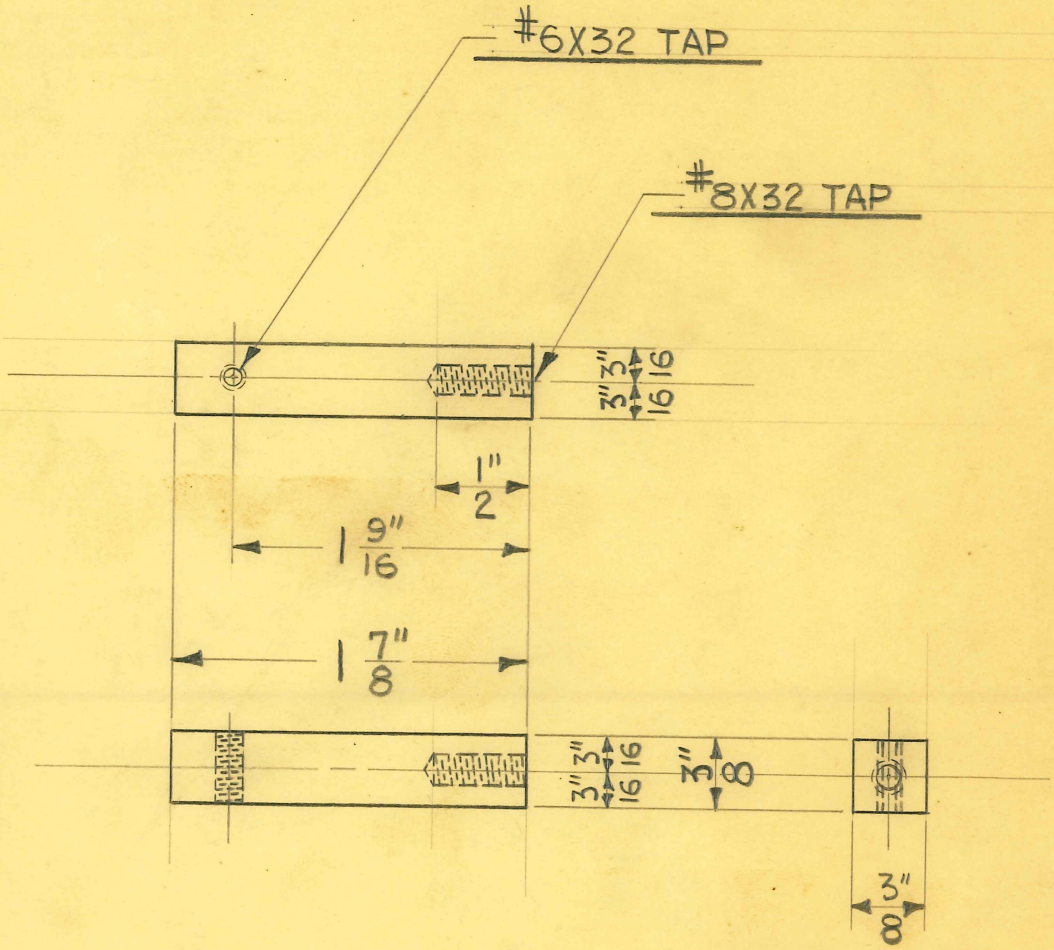

OBSOLETE

2 REQUIRED

SIZE	3/8" SQUARE	ISSUE 12-11-41	J.V.W.
KIND	BRASS ROD	CHANGED	
SHAPE		"	
FINISH	BLACK #80	"	
TEMP.		"	
PATT.		"	

TITLE: FISCHER MOD. "J" GALV. & CONT. CURR. GEN, OSCILLATING COIL TERMINAL BOARD SPACER

H. G. FISCHER & CO.
2335 WABANSIA AVE.
CHICAGO, ILL.

CAT. NO.

PART NO. 11137B

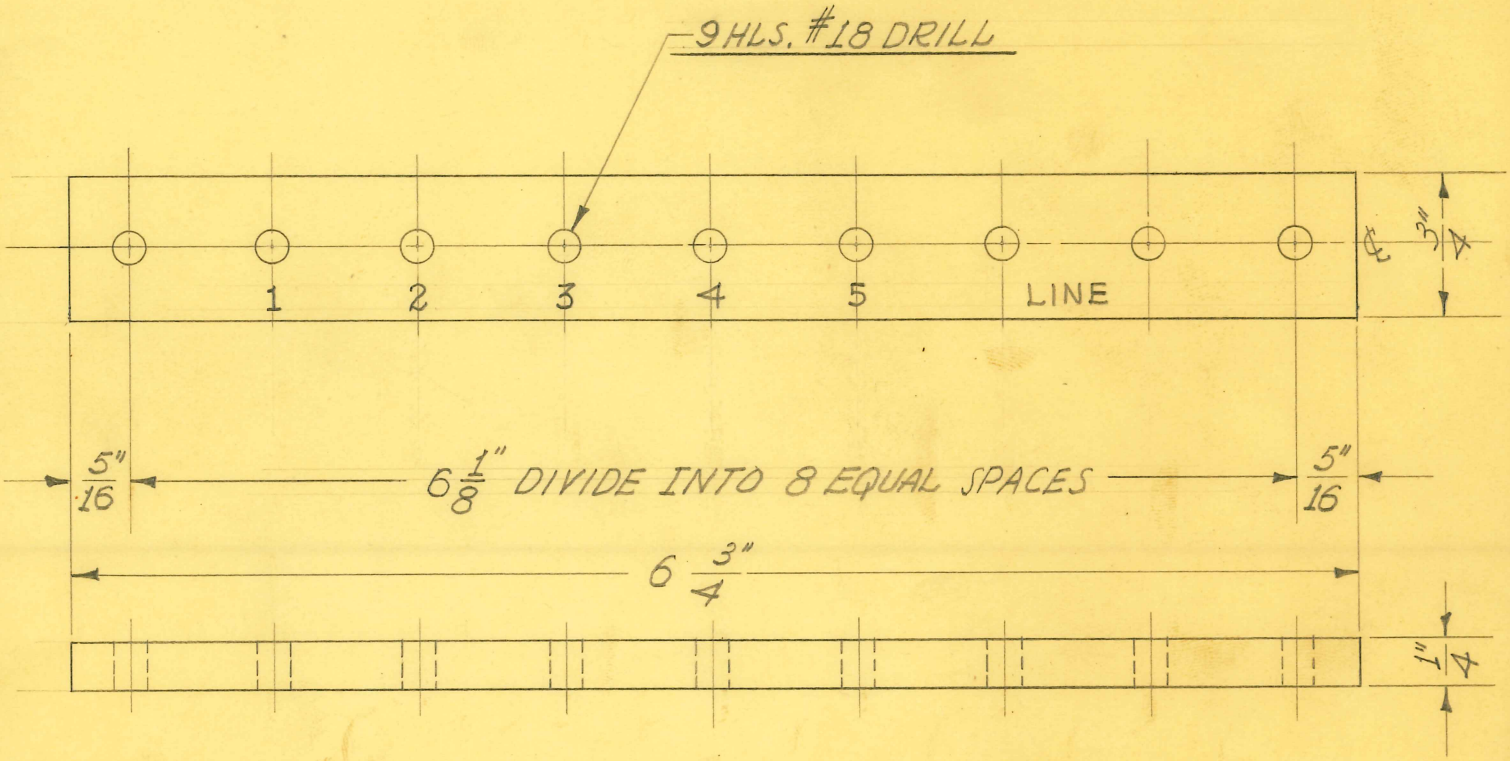

1 REQUIRED

OBSOLETE

obsolete

SIZE	1/4" SHEET	ISSUE	
KIND	BAKELITE	CHANGED	
SHAPE		"	
FINISH		"	
TEMP.		"	
PATT.		"	

TITLE: FISCHER MOD. "J" GALV. & CONT. CURR. GEN. OSCILLATING COIL TERMINAL BOARD

H. G. FISCHER & CO.
2335 WABANSIA AVE.
CHICAGO, ILL.

CAT. NO.

PART NO. 11138

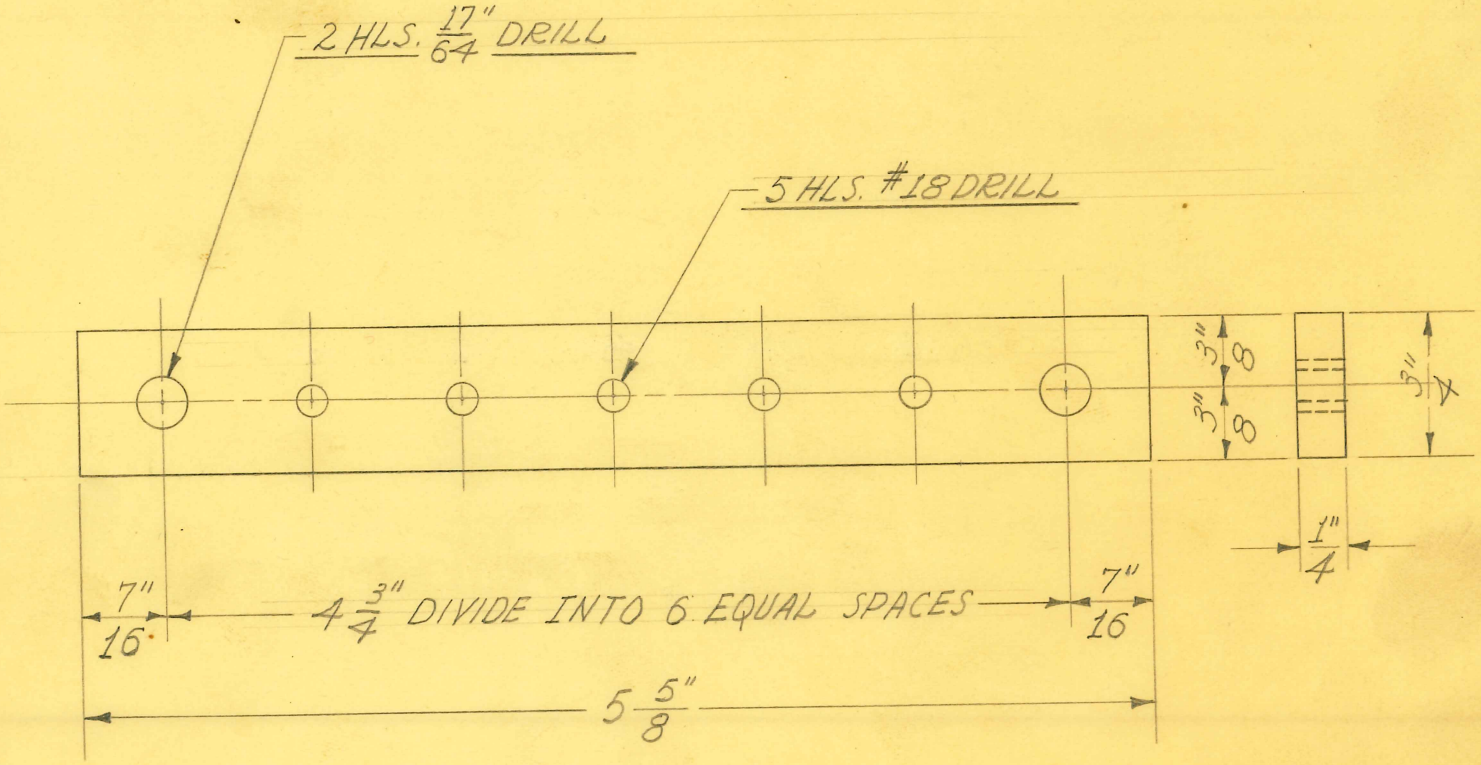

1 REQUIRED

OBSOLETE

SIZE	1/4" SHEET	ISSUE 2-15-38	J.W.
KIND	BAKELITE	CHANGED	
SHAPE		"	
FINISH		"	
TEMP.		"	
PATT.		"	

TITLE: FISCHER MOD. "J" GALV. & CONT. CURR. GEN POWER TRANSFORMER TERM. BD.

H. G. FISCHER & CO.
2335 WABANSIA AVE.
CHICAGO, ILL.

CAT. NO.

PART NO. 11139

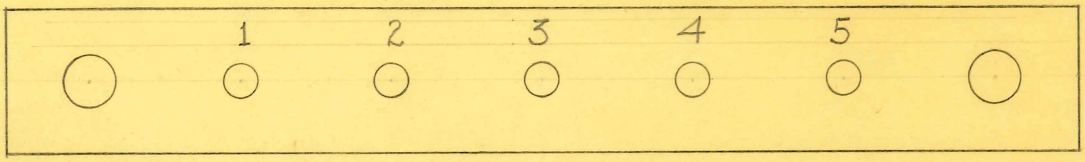

FROM # 11139

1 REQUIRED

OBSOLETE

SIZE		ISSUE 5-16-38	J.W.
KIND		CHANGED	
SHAPE		"	
FINISH		"	
TEMP.		"	
PATT.		"	

TITLE: FISCHER MOD. "J" GALV. & CONT. CURR. GEN. POWER TRANSFORMER TERM. BD. - LEFT

H. G. FISCHER & CO.
2335 WABANSIA AVE.
CHICAGO, ILL.

CAT. NO.

PART NO. 11139F

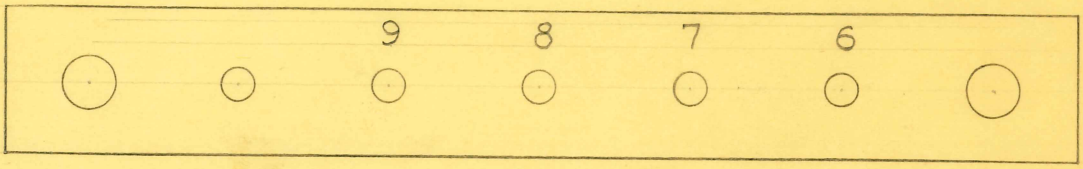

FROM PCE. # 11139

1 REQUIRED

OBSOLETE

SIZE		ISSUE 2-15-38	J.W.
KIND		CHANGED	
SHAPE		"	
FINISH		"	
TEMP.		"	
PATT.		"	

TITLE: FISCHER MOD. "J" GALV. & CONT. CURR. GEN. POWER TRANSFORMER TERM. BD. - RIGHT

H. G. FISCHER & CO.
2335 WABANSIA AVE.
CHICAGO, ILL.

CAT. NO.

PART NO. 11141

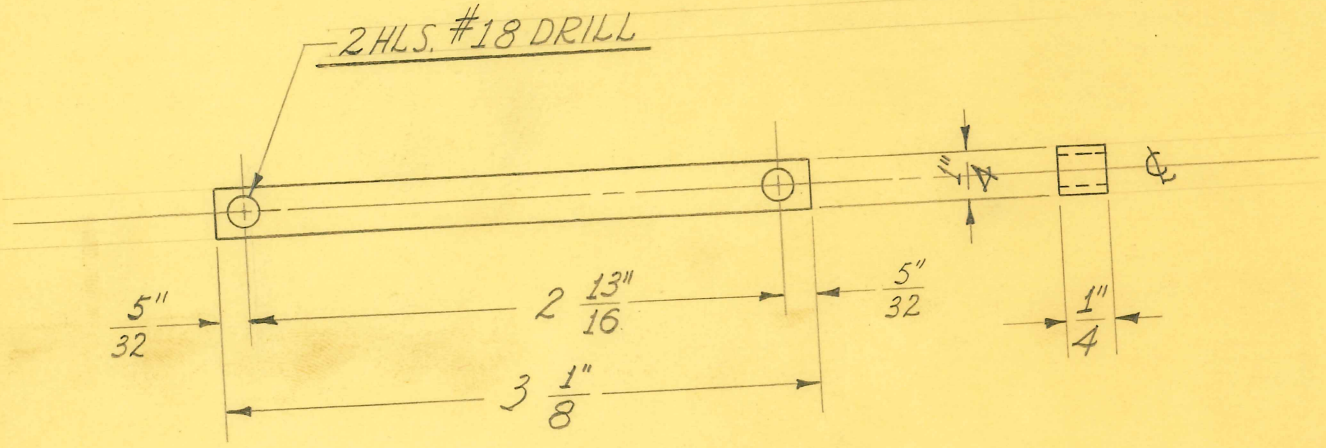

2 REQUIRED

OBSOLETE

SIZE	1/4" X 1/4"	ISSUE 2-15-38	J.W.	TITLE: FISCHER MOD. "J" GALV. & CONT. CURR. GEN. OUTPUT TRANSFORMER CLAMP-REAR
KIND	C.R. STEEL	CHANGED		
SHAPE	BAR	"		
FINISH	DU-LITE #8	"		
TEMP.		"		
PATT.		"		

H. G. FISCHER & CO.
2335 WABANSIA AVE.
CHICAGO, ILL.

CAT. NO.

PART NO. 11142

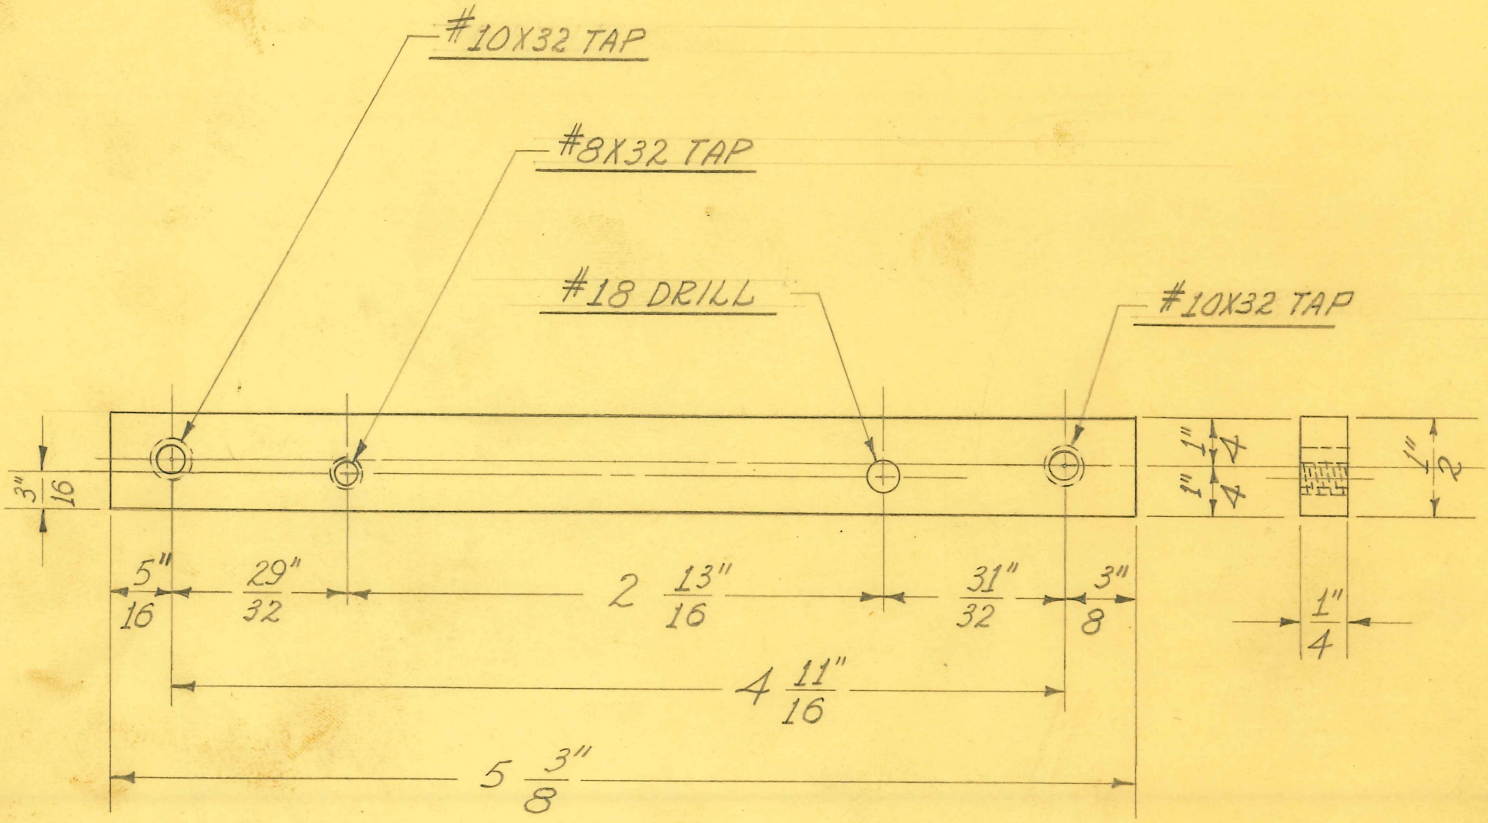

2 REQUIRED

OBSOLETE

SIZE	1/2" X 1/4"	ISSUE 2-15-38	J.W.
KIND	C.R. STEEL	CHANGED	
SHAPE		"	
FINISH	DU-LITE #8	"	
TEMP.		"	
PATT.		"	

TITLE: FISCHER MOD "J" GALV. & CONT. CURR. GEN. OUTPUT TRANSFORMER CLAMP - FRONT

H. G. FISCHER & CO.
2335 WABANSIA AVE.
CHICAGO, ILL.

CAT. NO.

PART NO. 11143

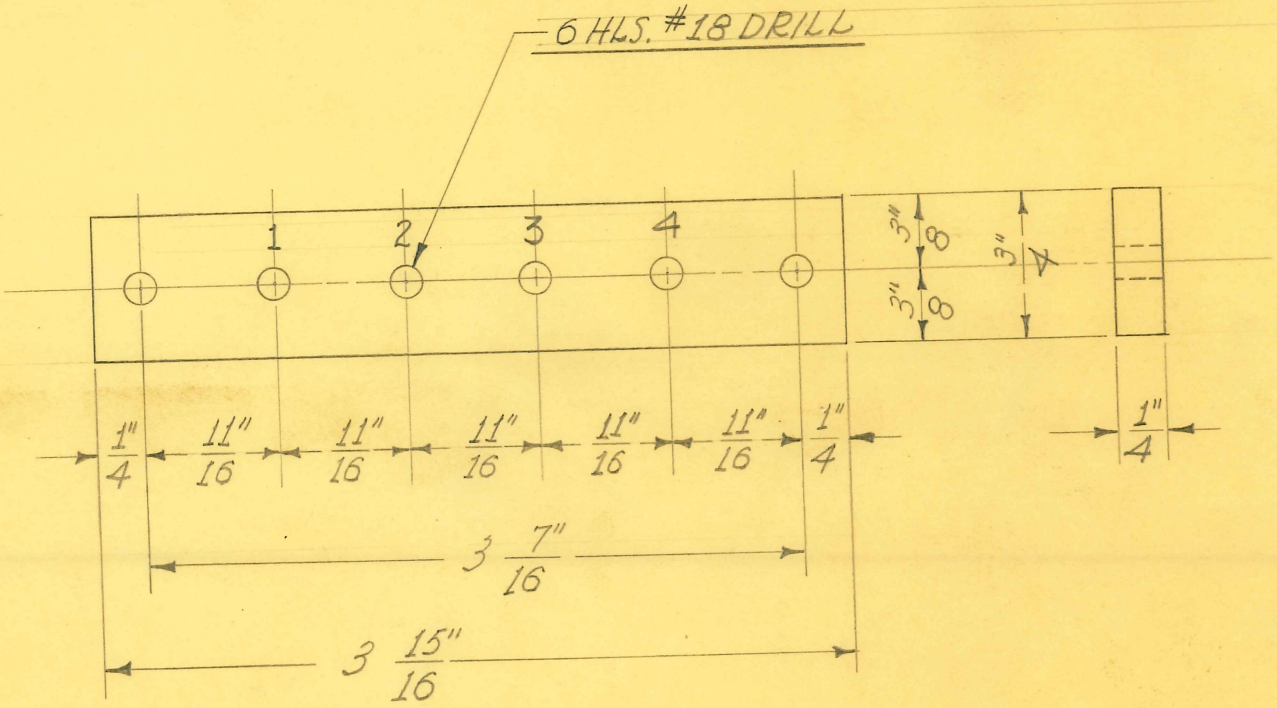

1 REQUIRED

OBSOLETE

SIZE	1/4" SHEET	ISSUE 2-15-38	J.W.
KIND	BAKELITE	CHANGED	
SHAPE		"	
FINISH		"	
TEMP.		"	
PATT.		"	

TITLE: FISCHER MOD. "J" GALV. & CONT. CURR. GEN. OUTPUT TRANSFORMER TERMINAL BOARD

H. G. FISCHER & CO.
2335 WABANSIA AVE.
CHICAGO, ILL.

CAT. NO.

PART NO. 11144

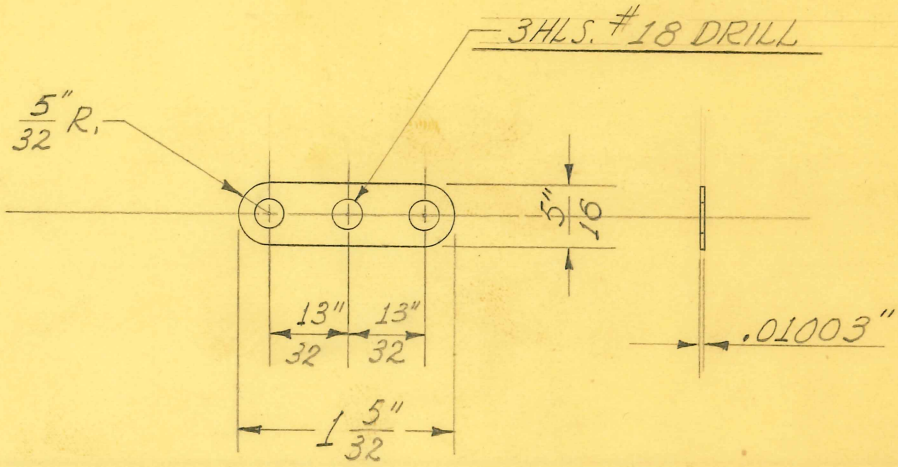

2 REQUIRED

OBSOLETE

SIZE	#30 GA. H.H.	ISSUE 2-16-38	J.W.
KIND	SHEET COPPER	CHANGED	
SHAPE		"	
FINISH		"	
TEMP.		"	
PATT.		"	

TITLE: FISCHER MOD. "J" GALV. & CONT. CURR. GEN. 15 POINT SWITCH CONN. PLATE - LARGE

H. G. FISCHER & CO.
2335 WABANSIA AVE.
CHICAGO, ILL.

CAT. NO.

PART NO. 11146A

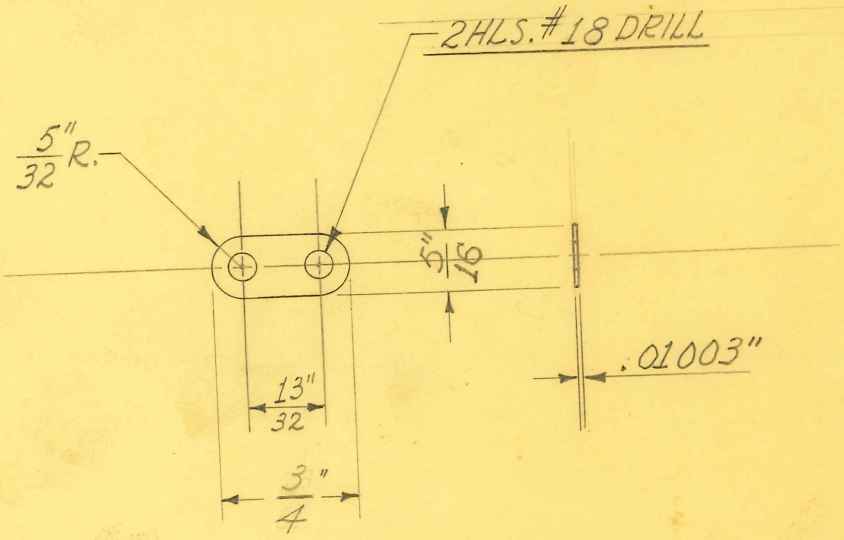

2 REQUIRED

OBSOLETE

SIZE	#30 GA. H.H.	ISSUE 2-16-38	J.W.
KIND	SHEET COPPER	CHANGED	
SHAPE		"	
FINISH		"	
TEMP.		"	
		"	

TITLE: FISCHER MOD. "J" GALV. & CONT. CURR. GEN. 15 POINT SWITCH CONN. PLATE - SMALL

H. G. FISCHER & CO.
2335 WABANSIA AVE.
CHICAGO, ILL.

CAT. NO.

PART NO. 11147A

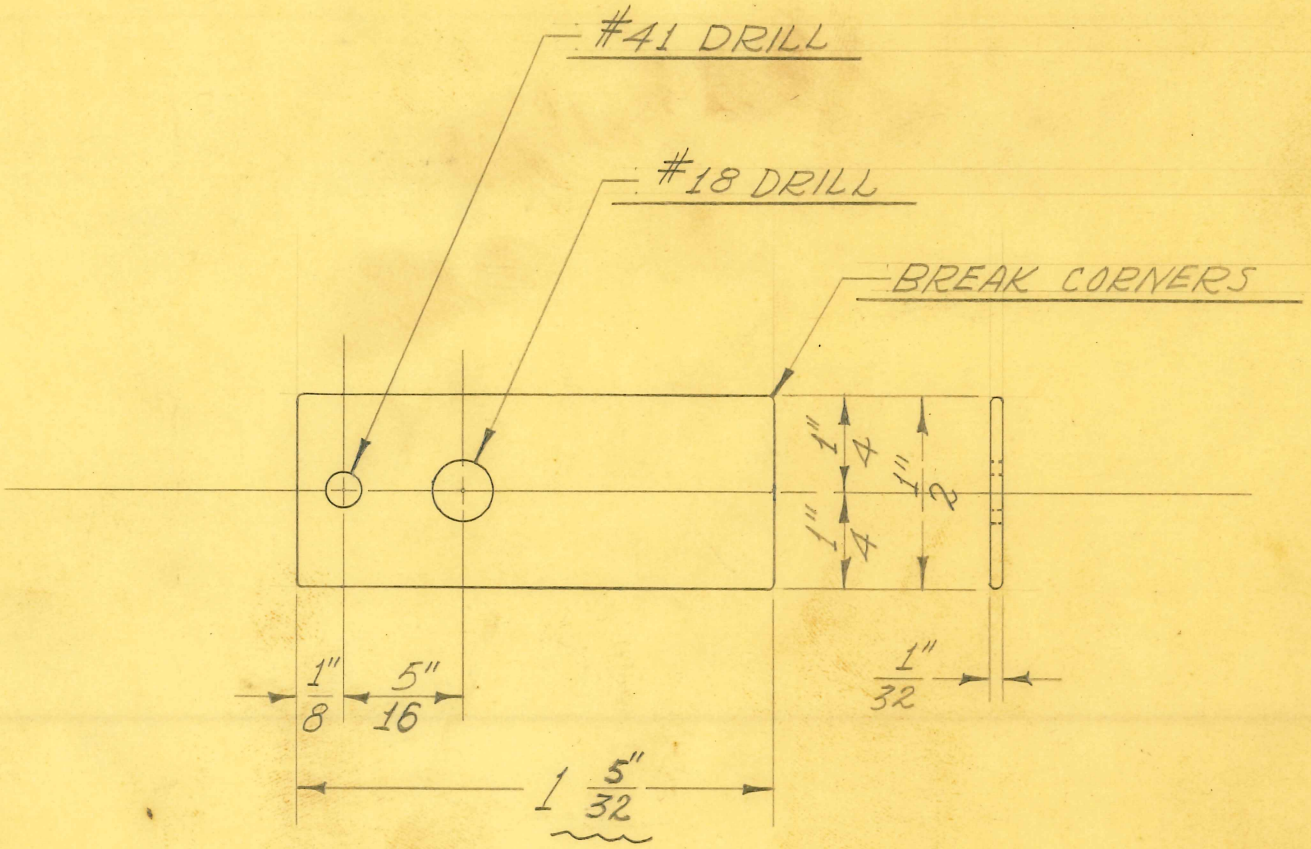

SCALE ÷ DOUBLE SIZE

1 REQUIRED

OBSOLETE

SIZE	1/2" X 1/32"	ISSUE 5-15-39	J.W.	TITLE: FISCHER MOD. "J" GALV. & CONT. CURR. GEN. VARIABLE SURGE REGULATING ROD RETAINING SPRING
KIND	FLAT SPRING	CHANGED		
~~SHAPE~~	STEEL	"		
FINISH		"		
TEMP.		"		
PATT.		"		

H. G. FISCHER & CO.
2335 WABANSIA AVE.
CHICAGO, ILL.

CAT. NO.

PART NO. 11165 1/2

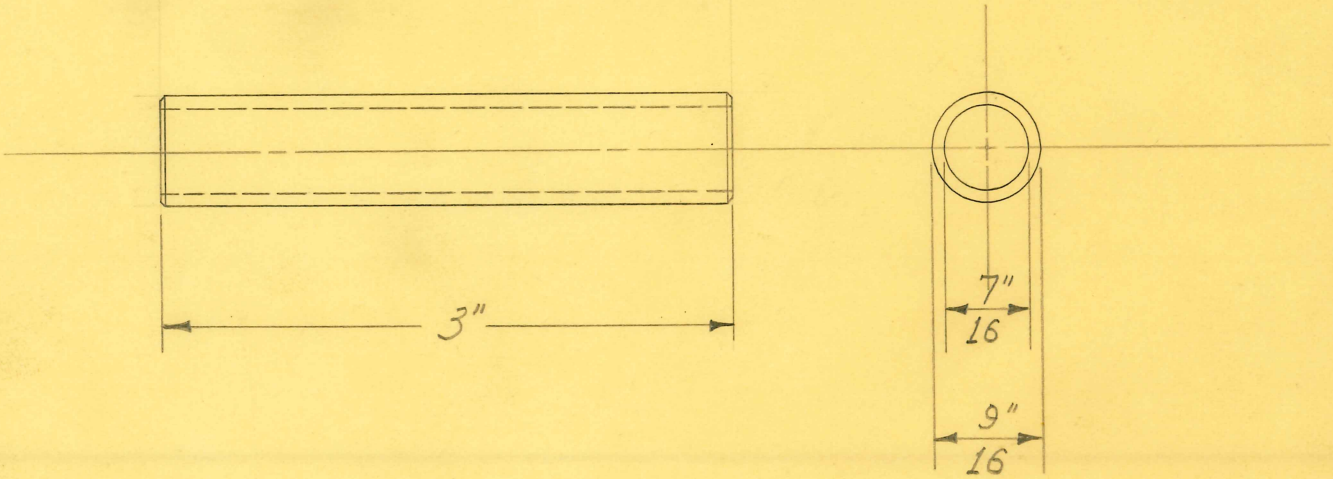

1 REQUIRED

OBSOLETE

delete

SIZE	9/16" O.D. X 7/16" I.D.	ISSUE 5-12-38	J.W.
KIND	C.R. STEEL	CHANGED	
SHAPE	TUBING	"	
FINISH		"	
TEMP.		"	
PATT.		"	

TITLE: FISCHER MOD. "J" GALV. & CONT. CURR. GEN. SURGE UNIT – COLLECTOR RING BUSHING

H. G. FISCHER & CO.
2335 WABANSIA AVE.
CHICAGO, ILL.

CAT. NO.

PART NO. 11169

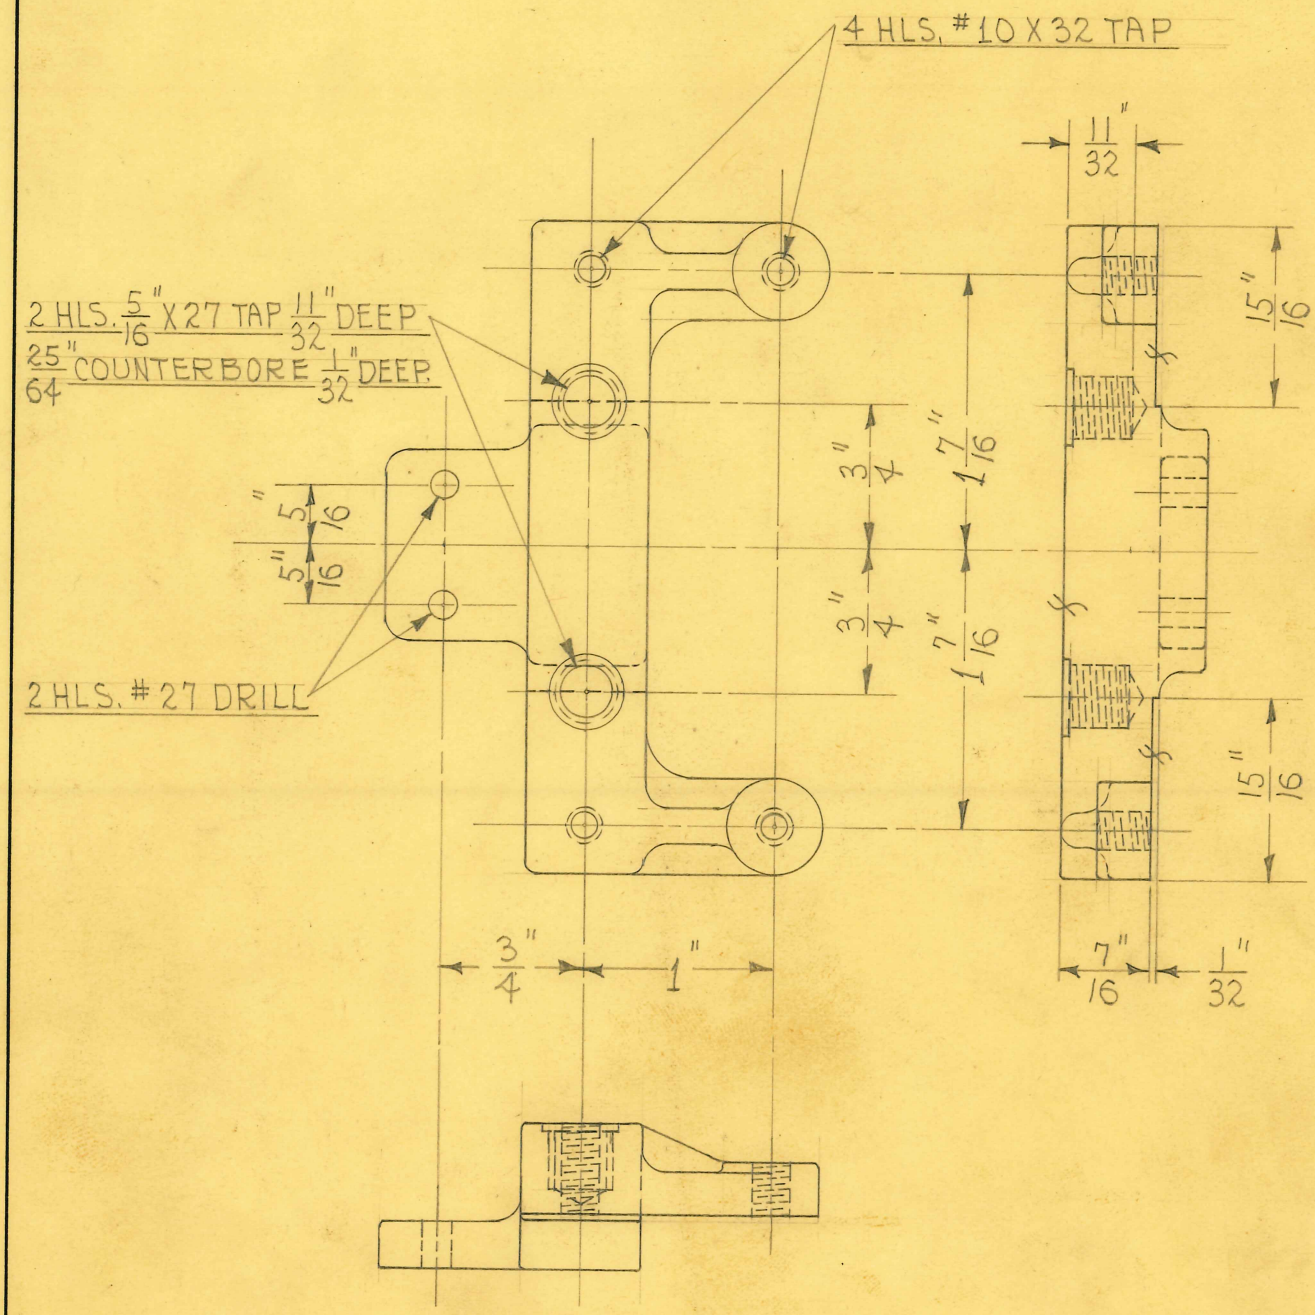

1 REQUIRED

OBSOLETE

SIZE		ISSUE 5-4-38	A.E.
KIND	IRON CASTING	CHANGED	
SHAPE		"	
FINISH	BLACK #80	"	
TEMP.		"	
PATT.	4604-1141	"	

TITLE: FISCHER MOD. "J" GALV. & CONT. CURR. GEN.- SURGE UNIT - COMMUTATOR BASE

H. G. FISCHER & CO.
2335 WABANSIA AVE.
CHICAGO, ILL.

CAT. NO.

PART NO. 11174F

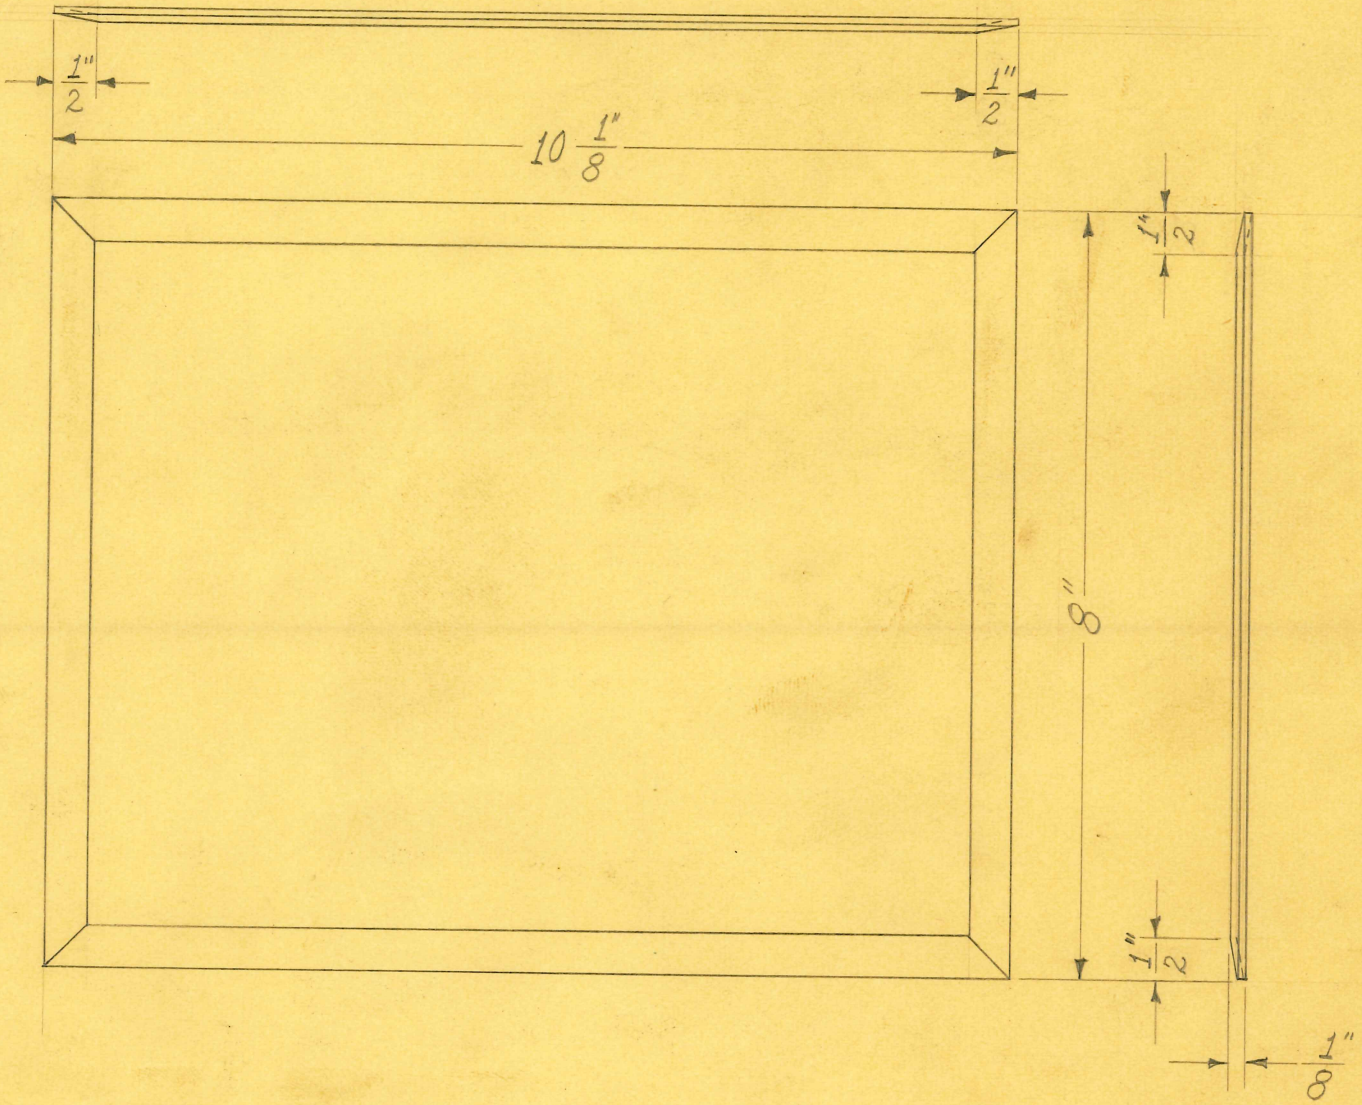

SCALE ~ 1/2" = 1"

1 REQUIRED

OBSOLETE

SIZE		ISSUE 8-22-38	J.W.
KIND	C.R. STEEL	CHANGED	
SHAPE		"	
FINISH		"	
TEMP.		"	
PATT.		"	

TITLE: FISCHER MOD. "J" GALV. & CONT. CURR. GEN. CABINET - REMOVABLE FRONT

H. G. FISCHER & CO.
2335 WABANSIA AVE.
CHICAGO, ILL.

CAT. NO.

PART NO. PART OF 11195G

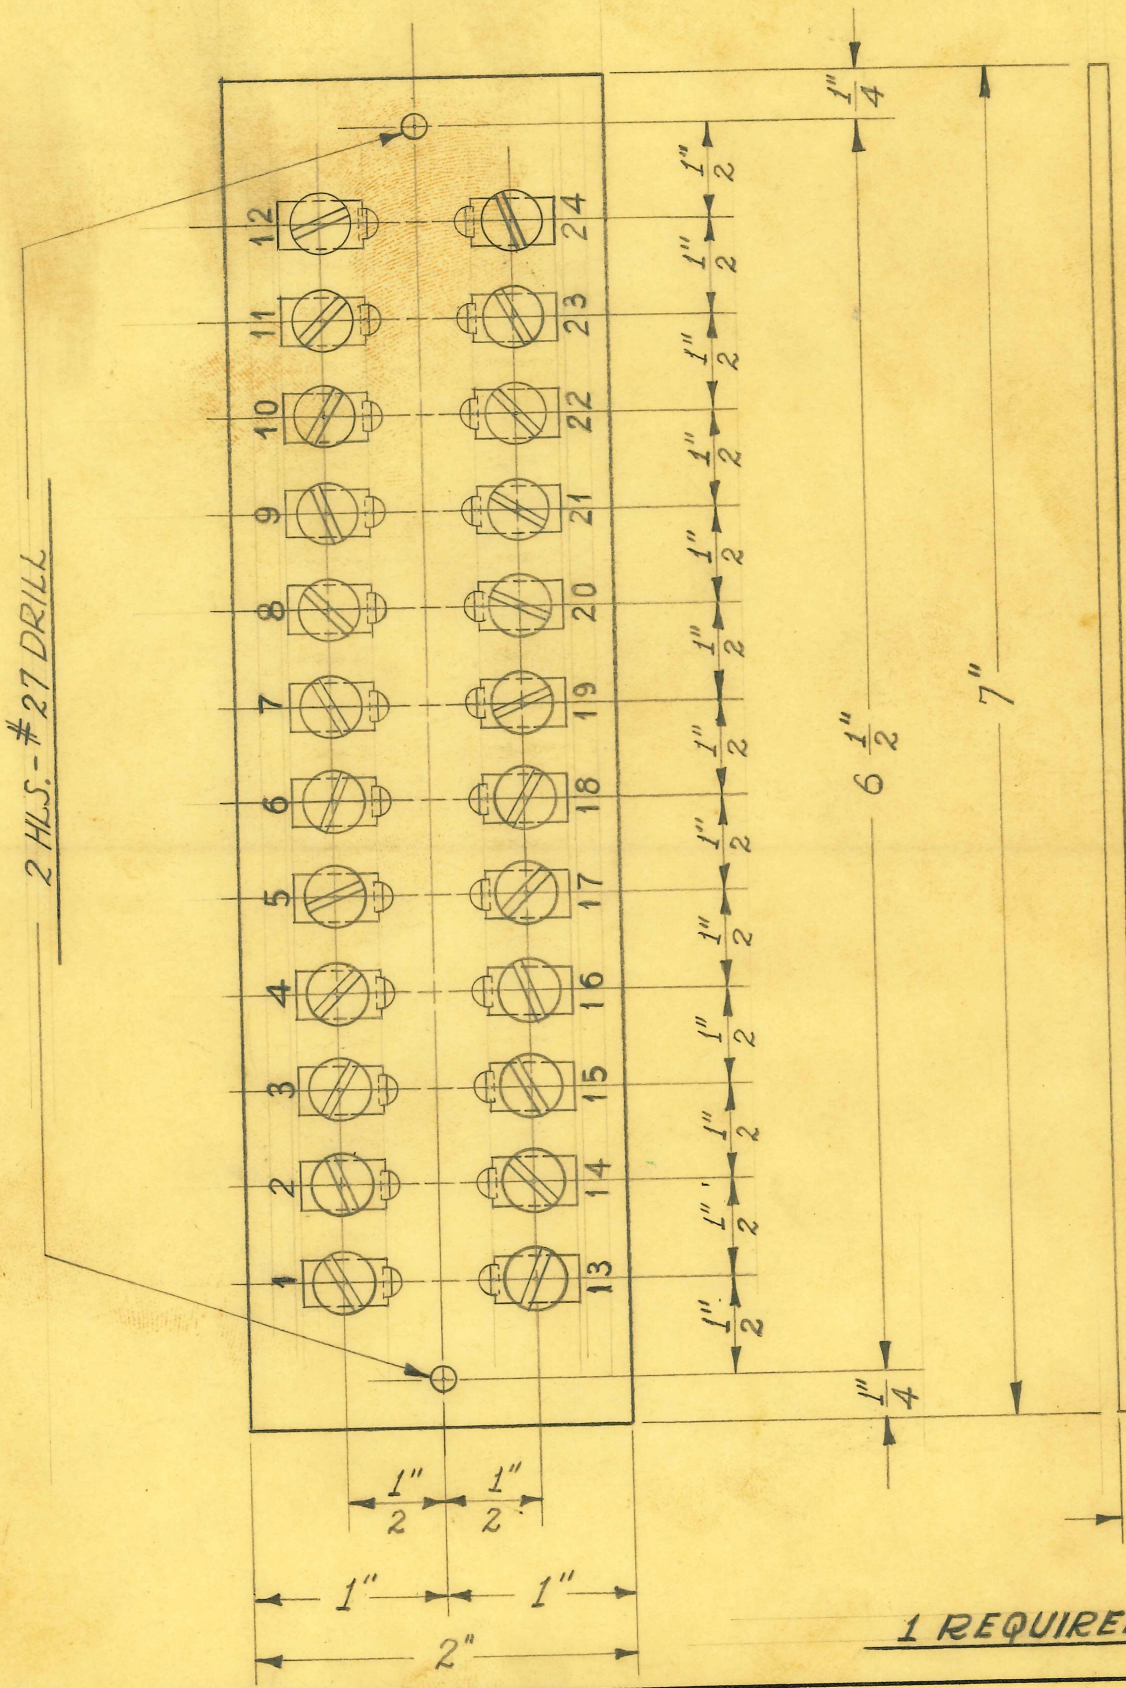

OBSOLETE

Obsolete

1 REQUIRED

SIZE		ISSUE 1-5-40	J.W.
KIND		CHANGED	
SHAPE		"	
FINISH		"	
TEMP.		"	
PATT.		"	

TITLE: FISCHER MOD. "J" GALV. & CONT. CURR. GEN. MAIN TERMINAL BOARD

H. G. FISCHER & CO.
2335 WABANSIA AVE.
CHICAGO, ILL.

CAT. NO.

PART NO. 11206G

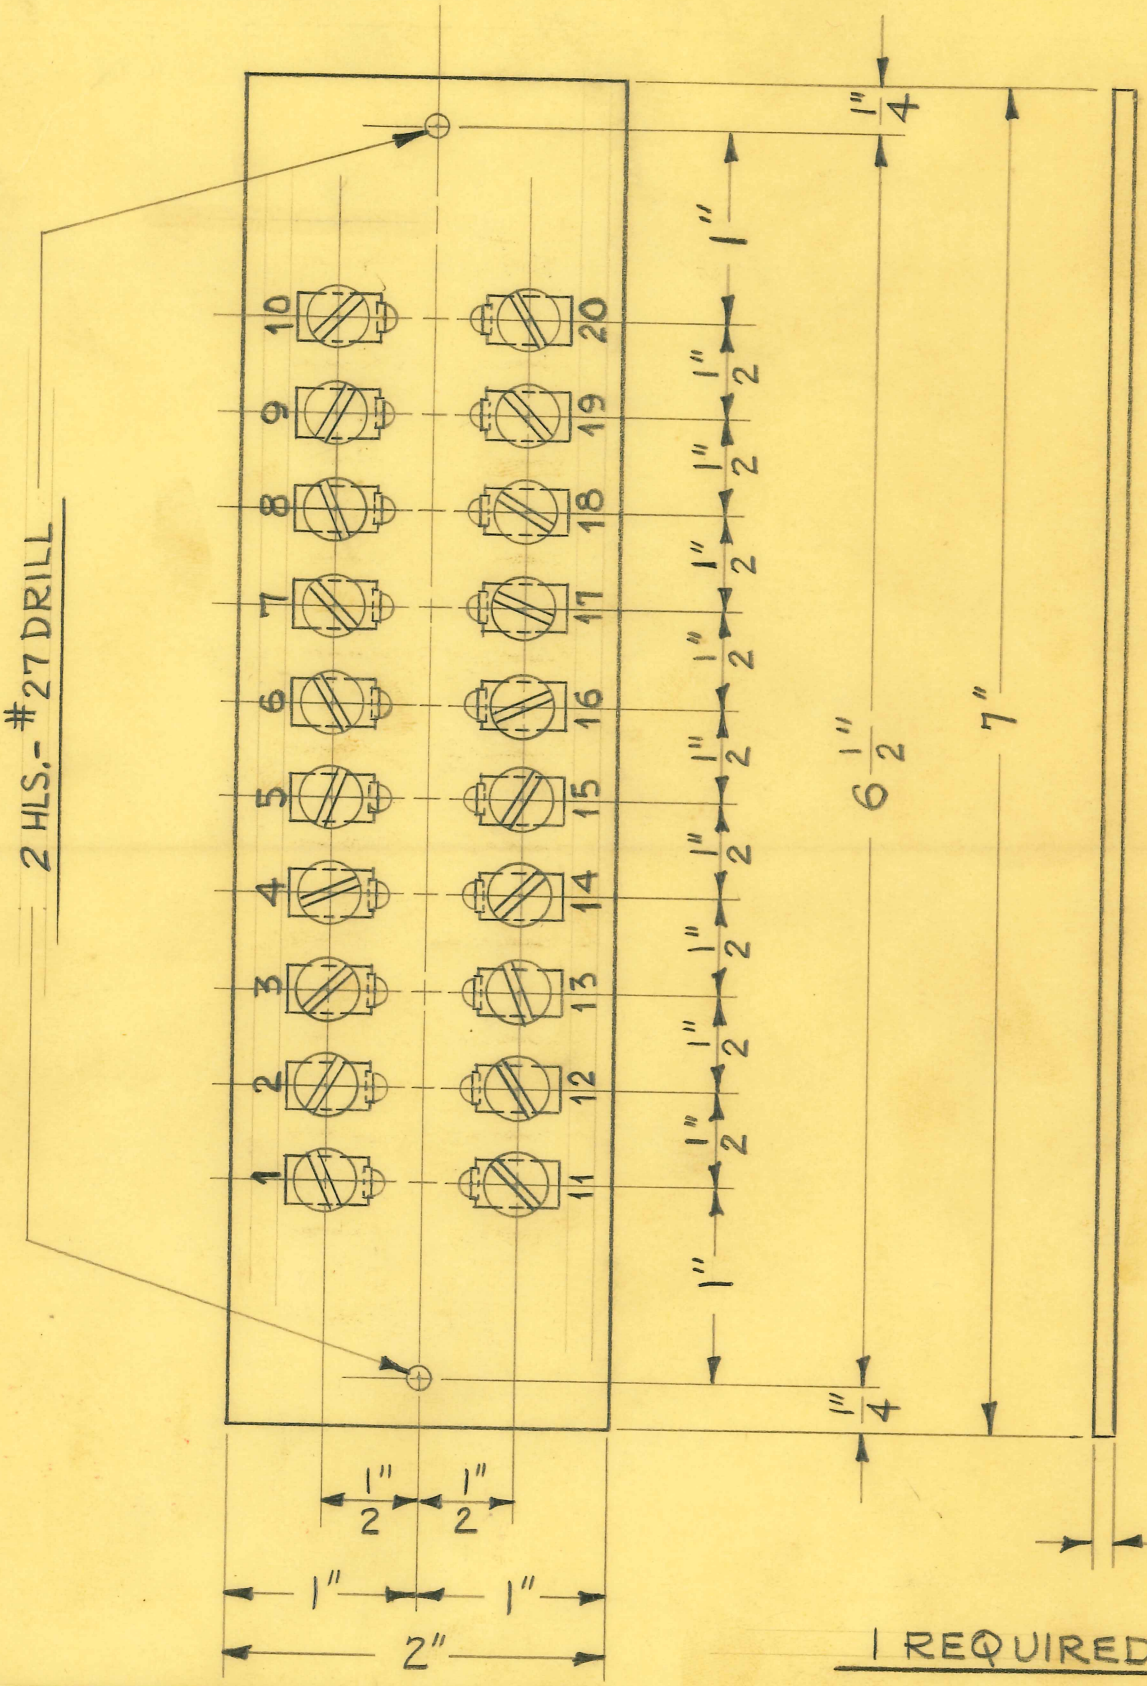

OBSOLETE

1 REQUIRED

SIZE		ISSUE 12-11-41	J.V.W.
KIND		CHANGED	
SHAPE		"	
FINISH		"	
TEMP.		"	
PATT.		"	

TITLE: FISCHER MOD. "J" GALV. & CONT. CURR. GEN. MAIN TERMINAL BOARD

H. G. FISCHER & CO.
2335 WABANSIA AVE.
CHICAGO, ILL.

CAT. NO.

PART NO. 11206GA

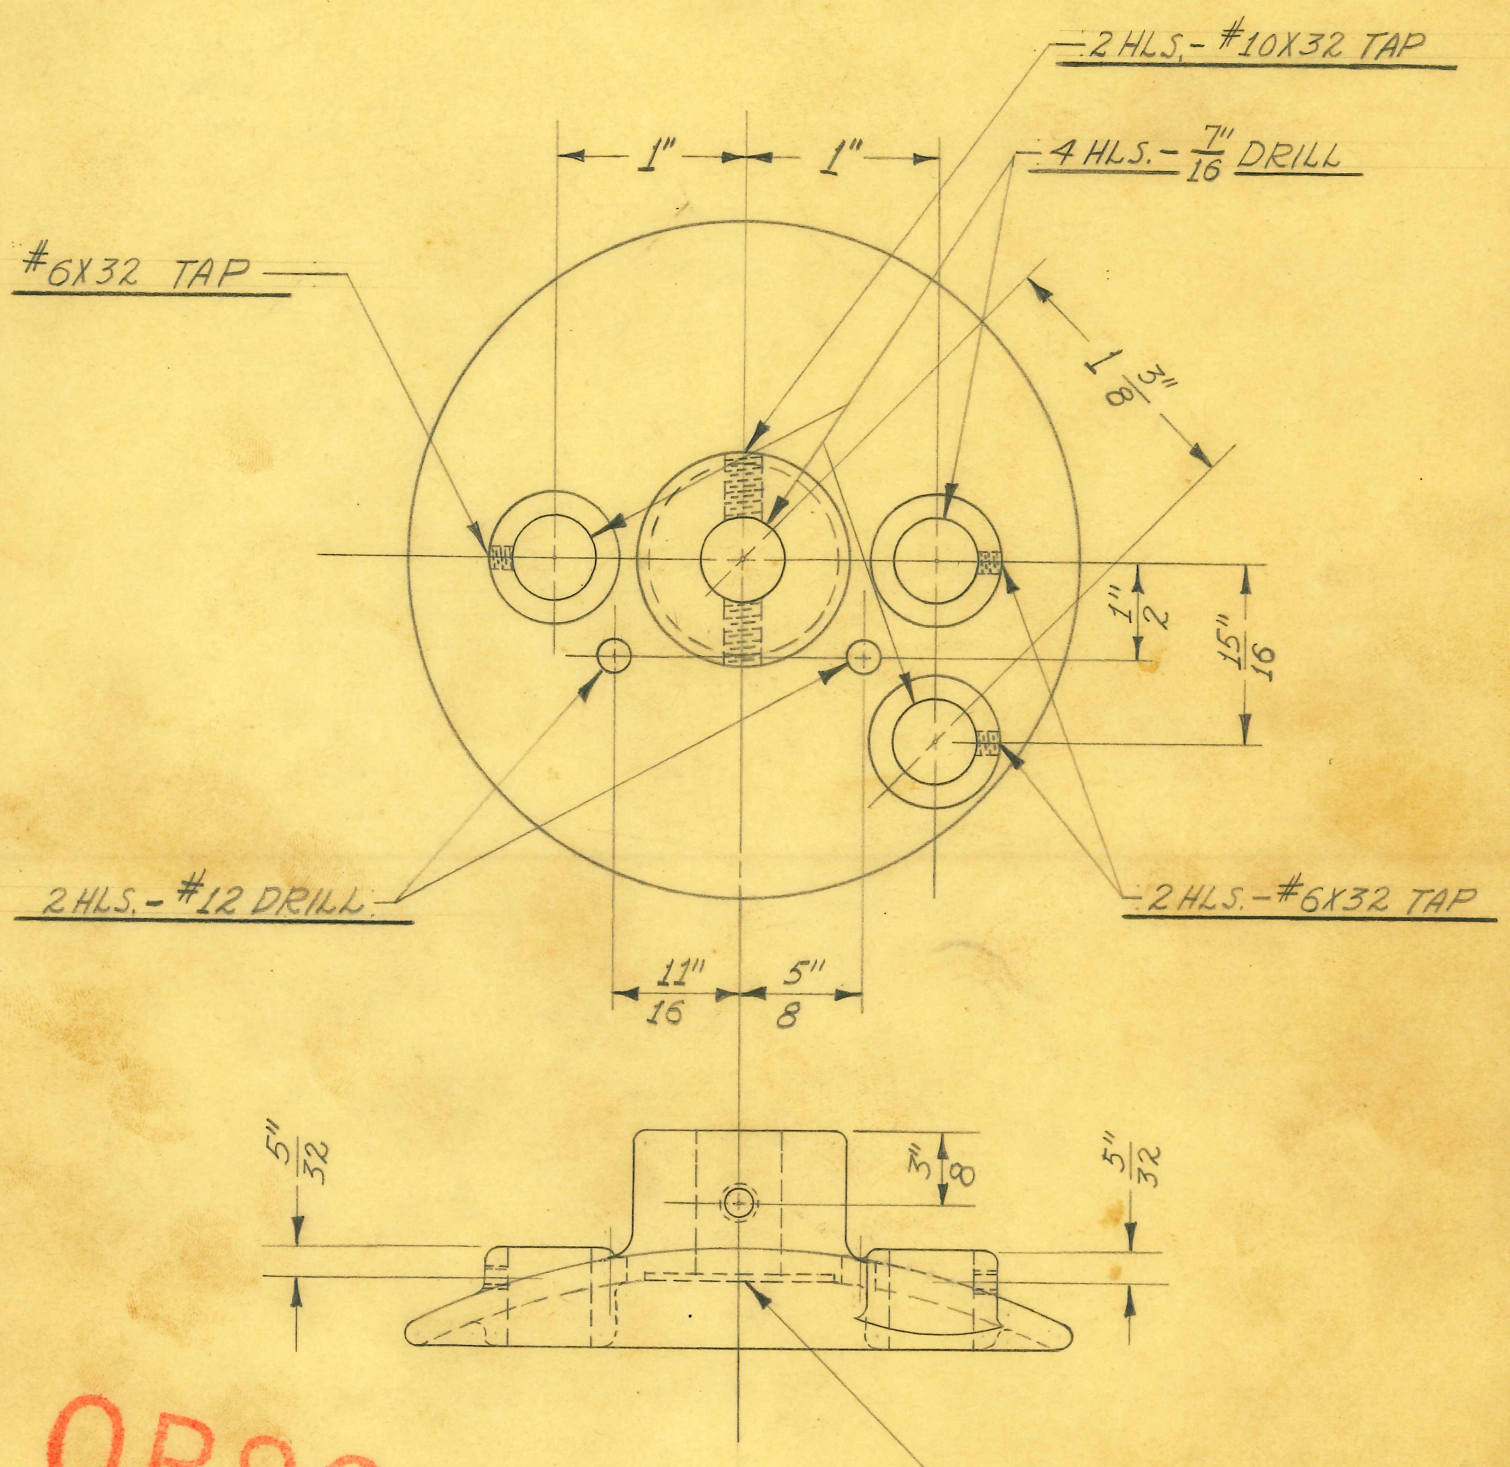

OBSOLETE

1 REQUIRED

obsolete

SIZE	#12	ISSUE 12-11-39	J.W.
KIND	ALUM. CAST.	CHANGED	
SHAPE		"	
FINISH	BLACK #80	"	
TEMP.		"	
PATT.	1431	"	

TITLE: FISCHER MOD. "J" GALV. & CONT. CURR. GEN. SURGE UNIT - REVOLVING BRUSH HOLDER

H. G. FISCHER & CO.
2335 WABANSIA AVE.
CHICAGO, ILL.

CAT. NO.

PART NO. 11209F

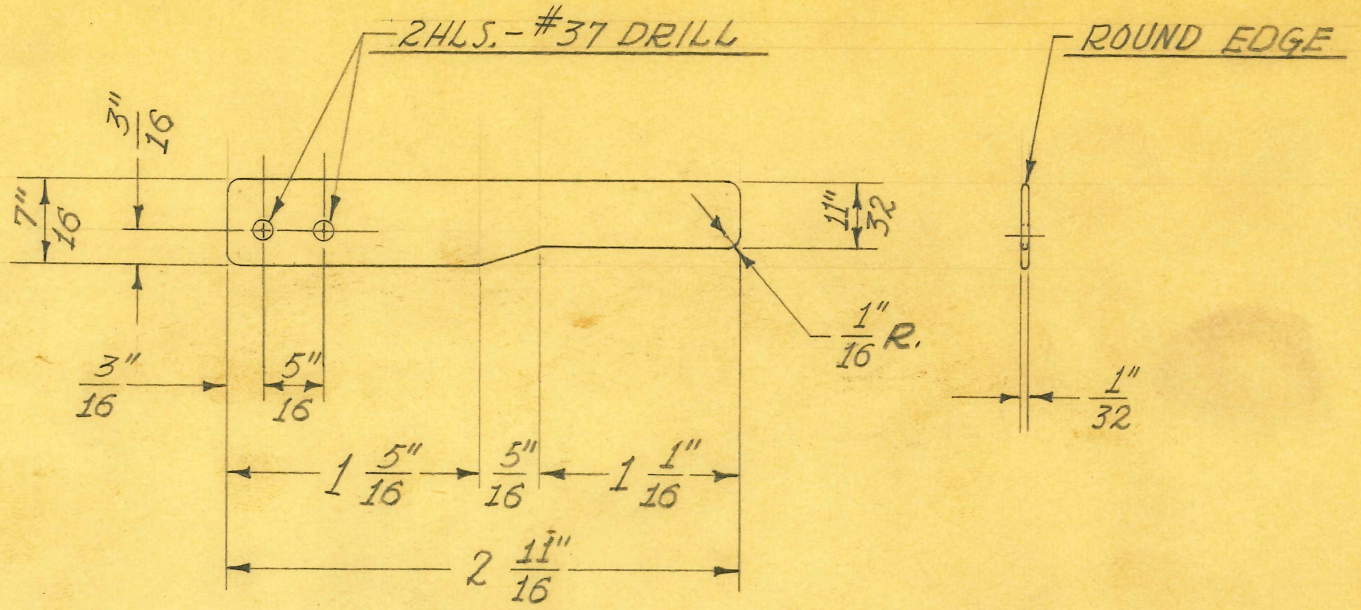

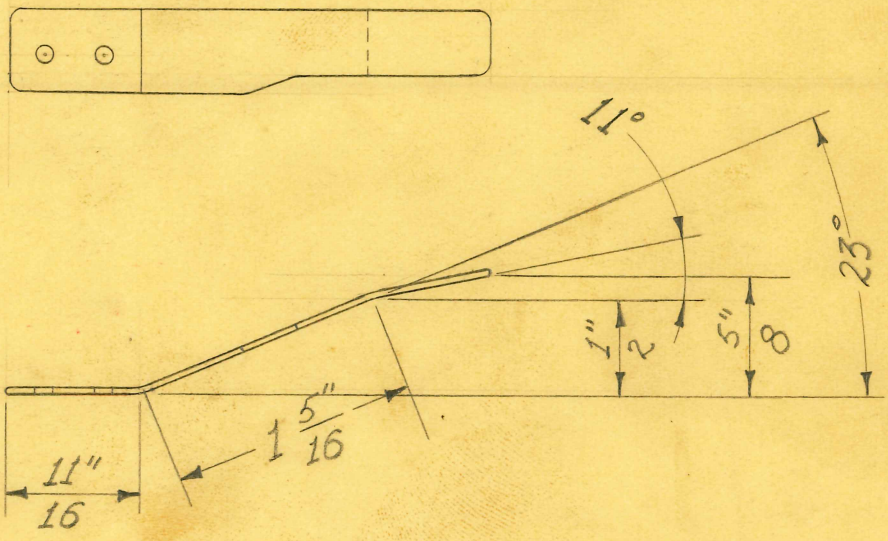

OBSOLETE

1 REQUIRED

SIZE	1/32" SHEET	ISSUE 3-9-39	J.W.
KIND	PHOS. BRONZE	CHANGED	
SHAPE		"	
FINISH		"	
TEMP.		"	
PATT.		"	

TITLE: FISCHER MODEL "J" GALV. & CONTRACTILE CURRENTS GEN.-CABT. LOUVRE SPRING

H. G. FISCHER & CO.
2335 WABANSIA AVE.
CHICAGO, ILL.

CAT. NO.

PART NO. 11211

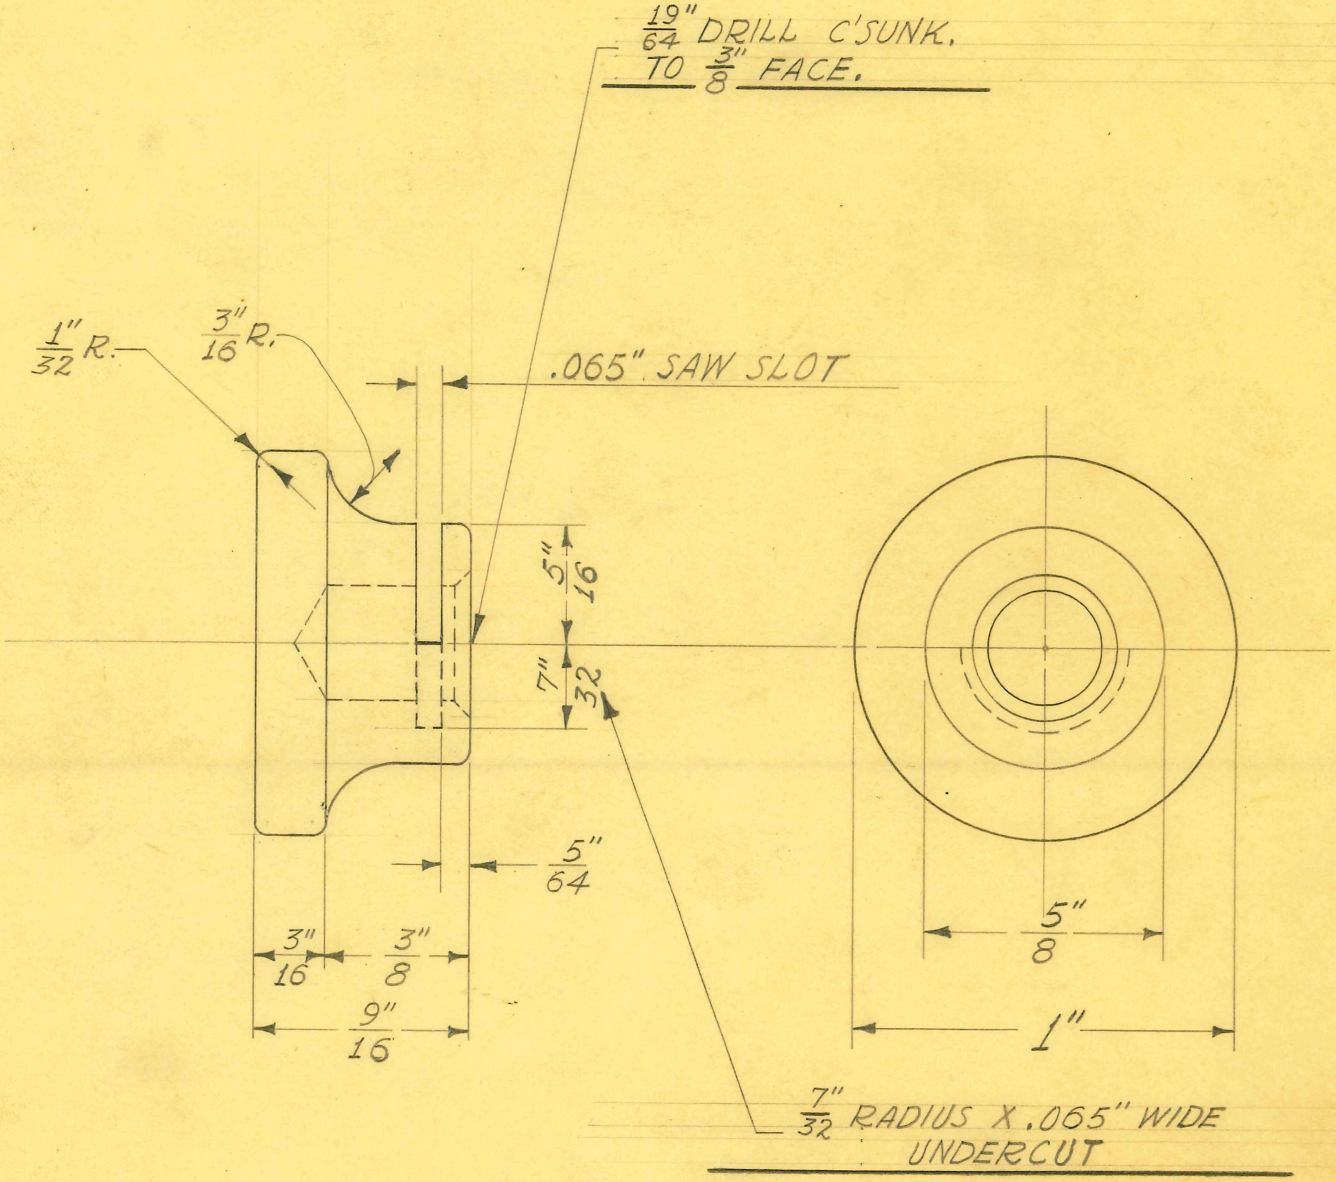

SCALE ÷ DOUBLE SIZE

OBSOLETE

2 REQUIRED

Obsolete

SIZE	1" DIAM.	ISSUE 4-3-40	J.W.
KIND	C.R. STEEL	CHANGED	
SHAPE		"	
FINISH	CAD. #23	"	
TEMP.		"	
PATT.		"	

TITLE:
FISCHER MOD. "GF" S.P. FLUOROSCOPE
CASTER BLOCK - STOP SCREW PAD

H. G. FISCHER & CO.
2335 WABANSIA AVE.
CHICAGO, ILL.

CAT. NO.

PART NO. 11216

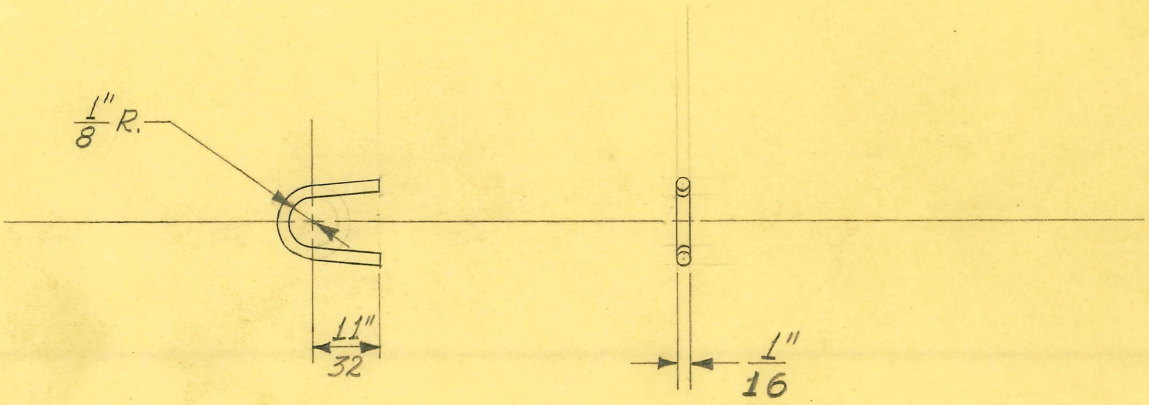

2 REQUIRED

DEVELOPED LENGTH 1 5/32"

OBSOLETE

obsolete

SIZE	1/16" DIAM.	ISSUE 4-2-40	J.W.
KIND	BESSEMER ROD	CHANGED	
SHAPE		"	
FINISH	CAD. #23	"	
TEMP.		"	
PATT.		"	

TITLE:
FISCHER MOD. "GF" S.P. FLUOROSCOPE
CASTER BLOCK STOP SCREW CLAMP WIRE

H. G. FISCHER & CO.
2335 WABANSIA AVE.
CHICAGO, ILL.

CAT. NO.

PART NO. 11217

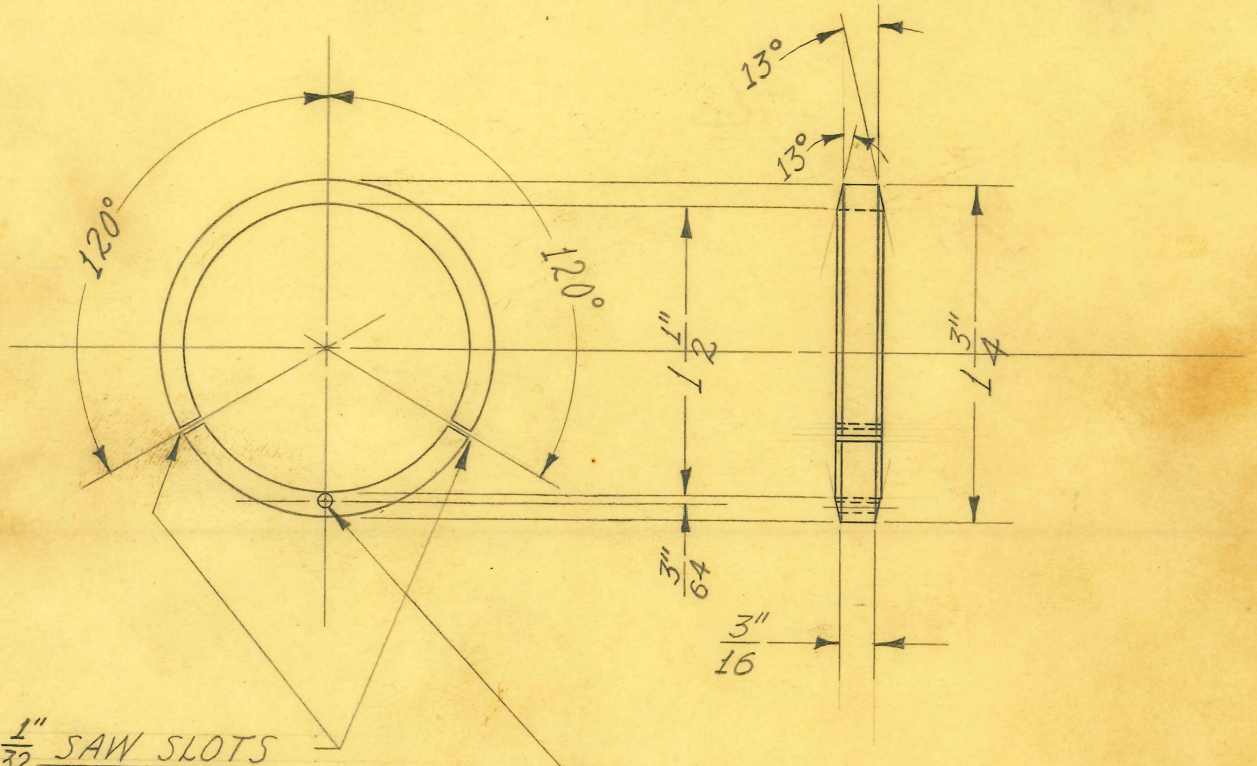

1 REQUIRED

OBSOLETE

Obsolete

SIZE	1¾"O.D.X1½"I.D.	ISSUE 12-7-39	J.W.
KIND	BRASS	CHANGED	
SHAPE	TUBING	"	
FINISH		"	
TEMP.		"	
PATT.		"	

TITLE: FISCHER MOD."J" GALV. & CONT. CURR. GEN. SURGE UNIT- COLLECTOR RING - SPLIT RING SET

H. G. FISCHER & CO.
2335 WABANSIA AVE.
CHICAGO, ILL.

CAT. NO.

PART NO. 11566G

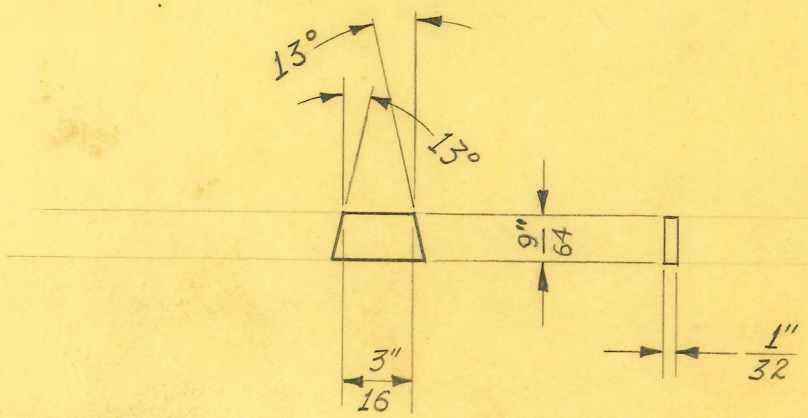

SCALE ÷ DOUBLE SIZE

2 REQUIRED

OBSOLETE

Obsolete

SIZE	1/32" SHEET	ISSUE 12-7-39	J.W.
KIND	BAKELITE	CHANGED	
SHAPE		"	
FINISH		"	
TEMP.		"	
PATT.		"	

TITLE: FISCHER MOD. "J" GALV. & CONT. CURR. GEN. SURGE UNIT – COLLECTOR RING - SPLIT RING INS. PIECE

H. G. FISCHER & CO.
2335 WABANSIA AVE.
CHICAGO, ILL.

CAT. NO.

PART NO. 11569

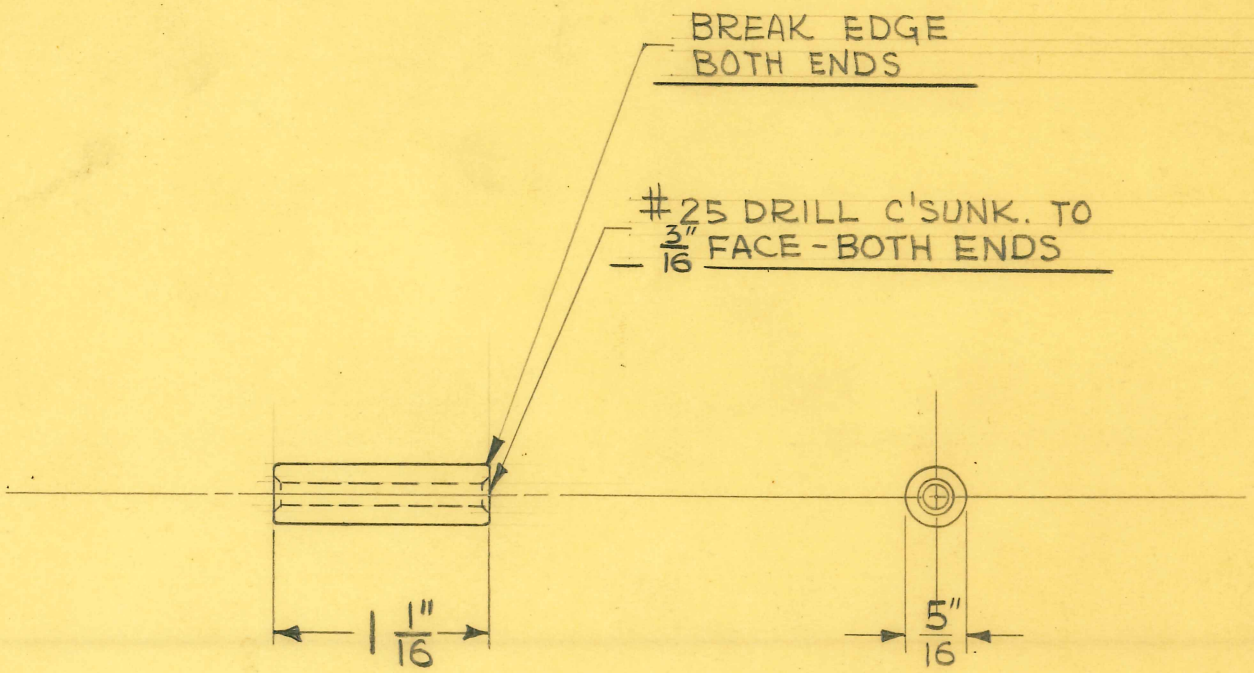

4 REQUIRED

OBSOLETE

SIZE	5/16" DIA.	ISSUE 2-5-42	J.V.W.
KIND	C.R. STEEL	CHANGED	
SHAPE		"	
FINISH		"	
TEMP.		"	
PATT.		"	

TITLE:
FISCHER MOD. "G" X-RAY UNIT
TANK - X-RAY SHIELD SPACER

H. G. FISCHER & CO.
2335 WABANSIA AVE.
CHICAGO, ILL.

CAT. NO.

PART NO. 11576

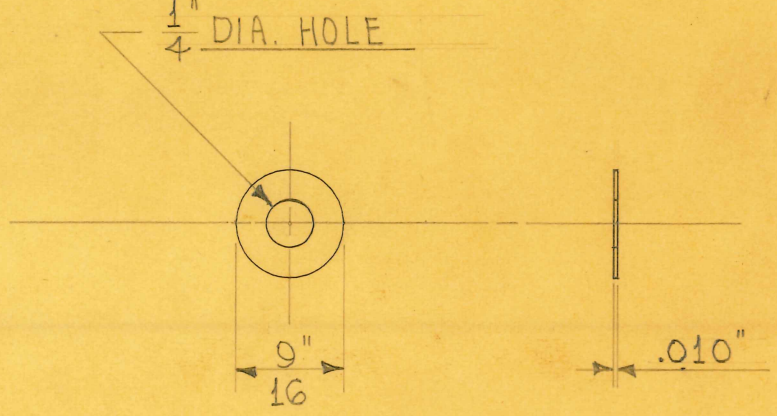

38 REQUIRED

OBSOLETE

SIZE	.010"	ISSUE 9-6-44	HE.
KIND	VARNISHED	CHANGED	
SHAPE	GLASS CLOTH	"	
FINISH		"	
TEMP.		"	
PATT.		"	

TITLE: MOD. "J" GALV. & CONT. CURR. GEN.~ SURGE UNIT~ COM. & RES. UNIT INS. WASHER

H. G. FISCHER & CO.
2335 WABANSIA AVE.
CHICAGO, ILL.

CAT. NO.

PART NO. 11578

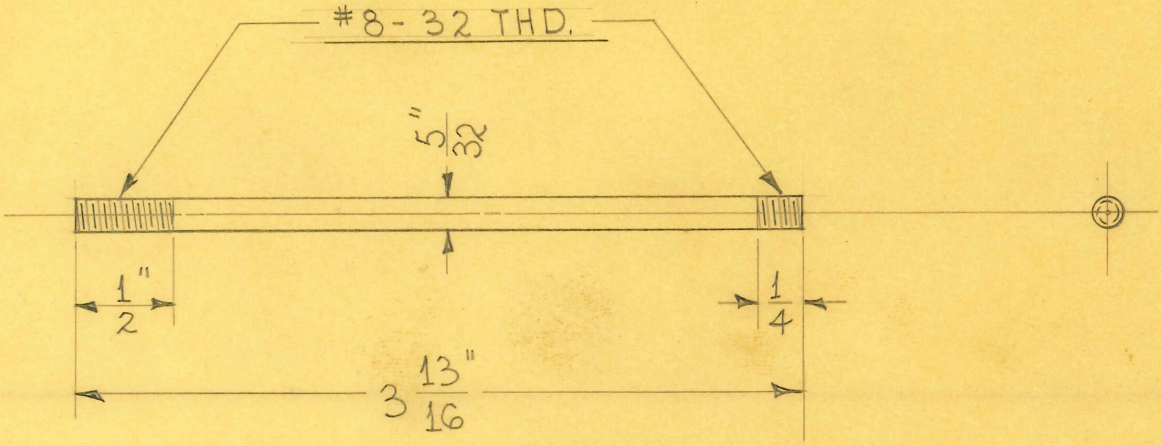

2 REQUIRED

OBSOLETE

SIZE	5/32" DIAM.	ISSUE 9-2-44	HE.	TITLE: MOD. "J" GALV. & CONT. CURR. GEN.- SURGE UNIT ~ COMMUTATOR RESISTOR UNIT - STUD
KIND	C.R. STEEL	CHANGED		
SHAPE	ROD	"		
FINISH	W.P. #13	"		
TEMP.		"		
PATT.		"		

H. G. FISCHER & CO.
2335 WABANSIA AVE.
CHICAGO. ILL.

CAT. NO.

PART NO. 11579

PROPER METHOD OF STAGGERING SEGMENTS & RESISTORS
& CORRECT CONNECTIONS SHOWN. SEGMENTS SHOWN TO FRONT.

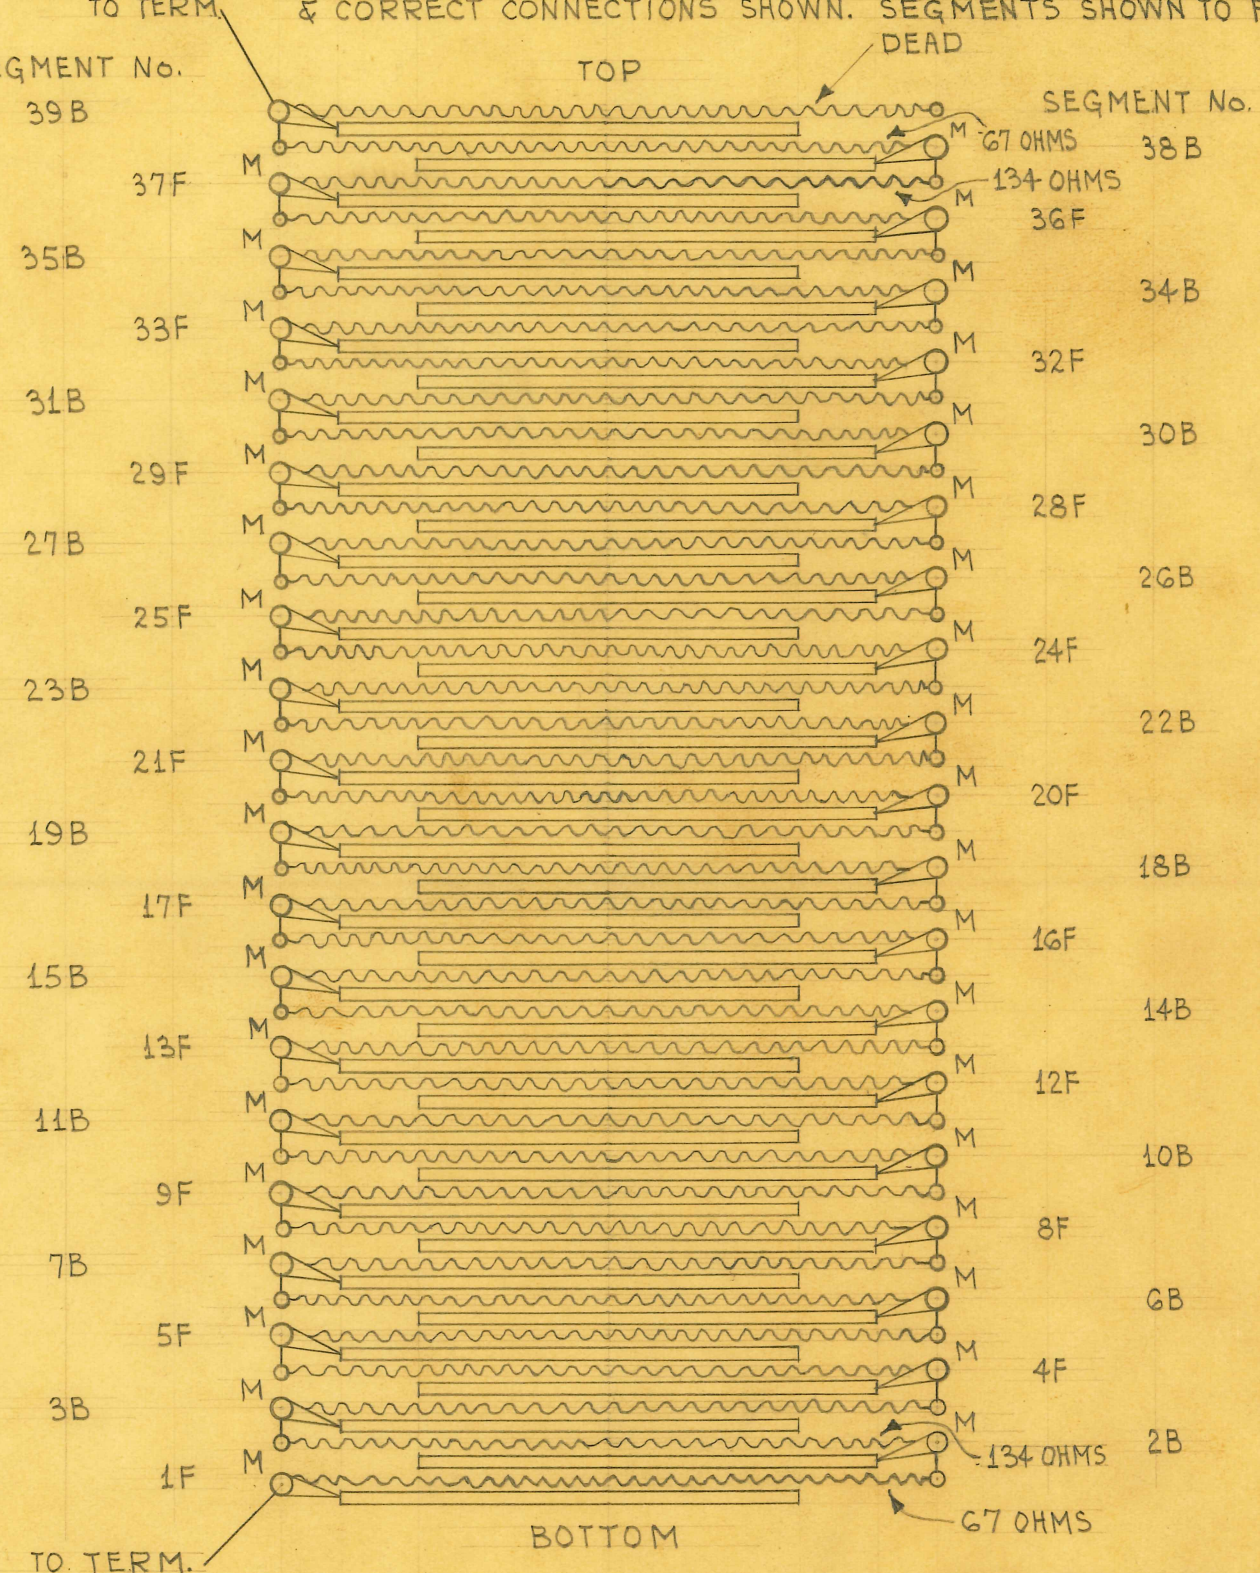

OBSOLETE

ALL RESISTORS 200 OHMS EACH, EXCEPT WHERE NOTED.

TAB END — RESISTOR — NO TAB END

F - MEANS SEGMENT TAB TO FRONT
B - MEANS SEGMENT TAB TO BACK
M - MEANS MICA WASHER

SIZE		ISSUE 9-26-44	HE.
KIND		CHANGED	
SHAPE		"	
FINISH		"	
TEMP.		"	
PATT.		"	

TITLE: MOD. "J" GALV. & CONT. CURRENT GEN.
SURGE UNIT - COMMUTATOR & RESISTANCE UNIT

H. G. FISCHER & CO.
2335 WABANSIA AVE.
CHICAGO. ILL.

CAT. NO.

PART NO. 11580G

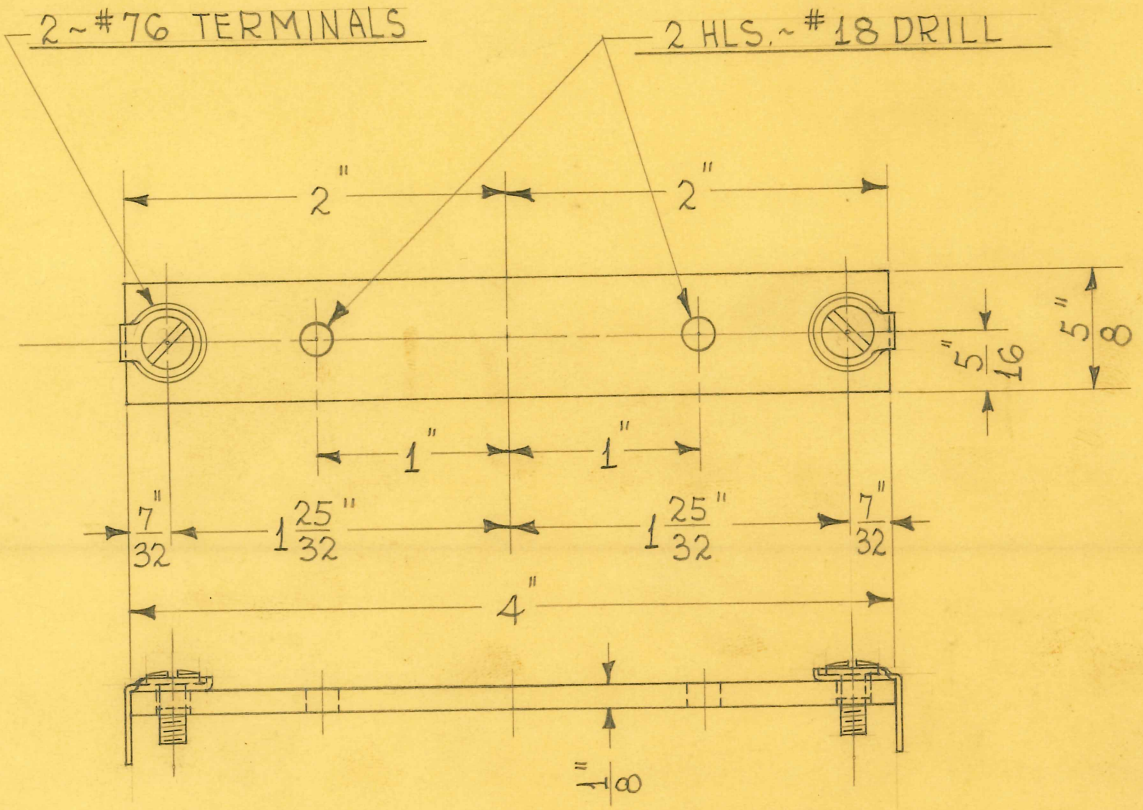

1 REQUIRED

OBSOLETE

SIZE	1/8"	ISSUE 10-3-44	HE.
KIND	XP BAKELITE	CHANGED	
SHAPE		"	
FINISH		"	
TEMP.		"	
BATT.		"	

TITLE: MOD. "J" GALV. & CONT. CURRENT GEN.~ SURGE UNIT ~ COM. & RES. UNIT TERM. STRIP

H. G. FISCHER & CO.
2338 WABANSIA AVE.
CHICAGO. ILL.

CAT. NO.

PART NO. 11581G

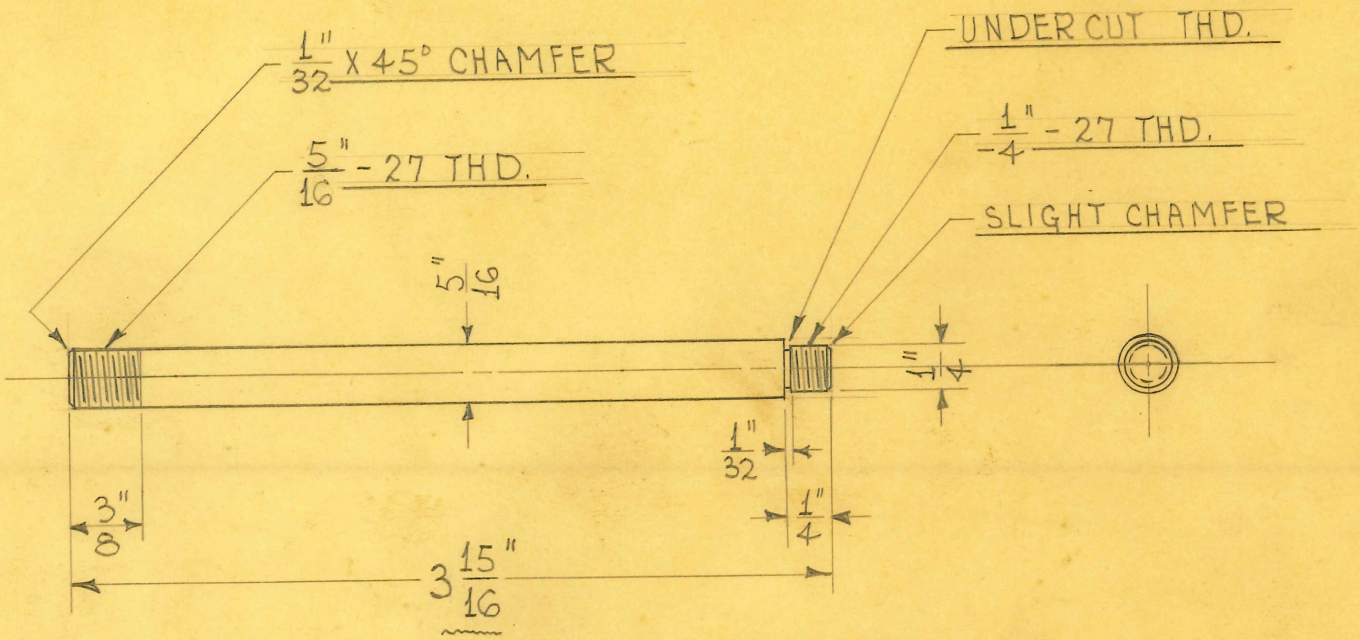

2 REQUIRED

OBSOLETE

SIZE	5/16" DIAM.	ISSUE 9-2-44	HE.
KIND	C.R. STEEL	CHANGED	
SHAPE	ROD	"	
FINISH		"	
TEMP.		"	
PATT.		"	

TITLE: MOD. "J" GALV. & CONT. CURR. GEN. SURGE UNIT- COMMUTATOR STUD

H. G. FISCHER & CO.
2335 WABANSIA AVE.
CHICAGO. ILL.

CAT. NO.

PART NO. 11583

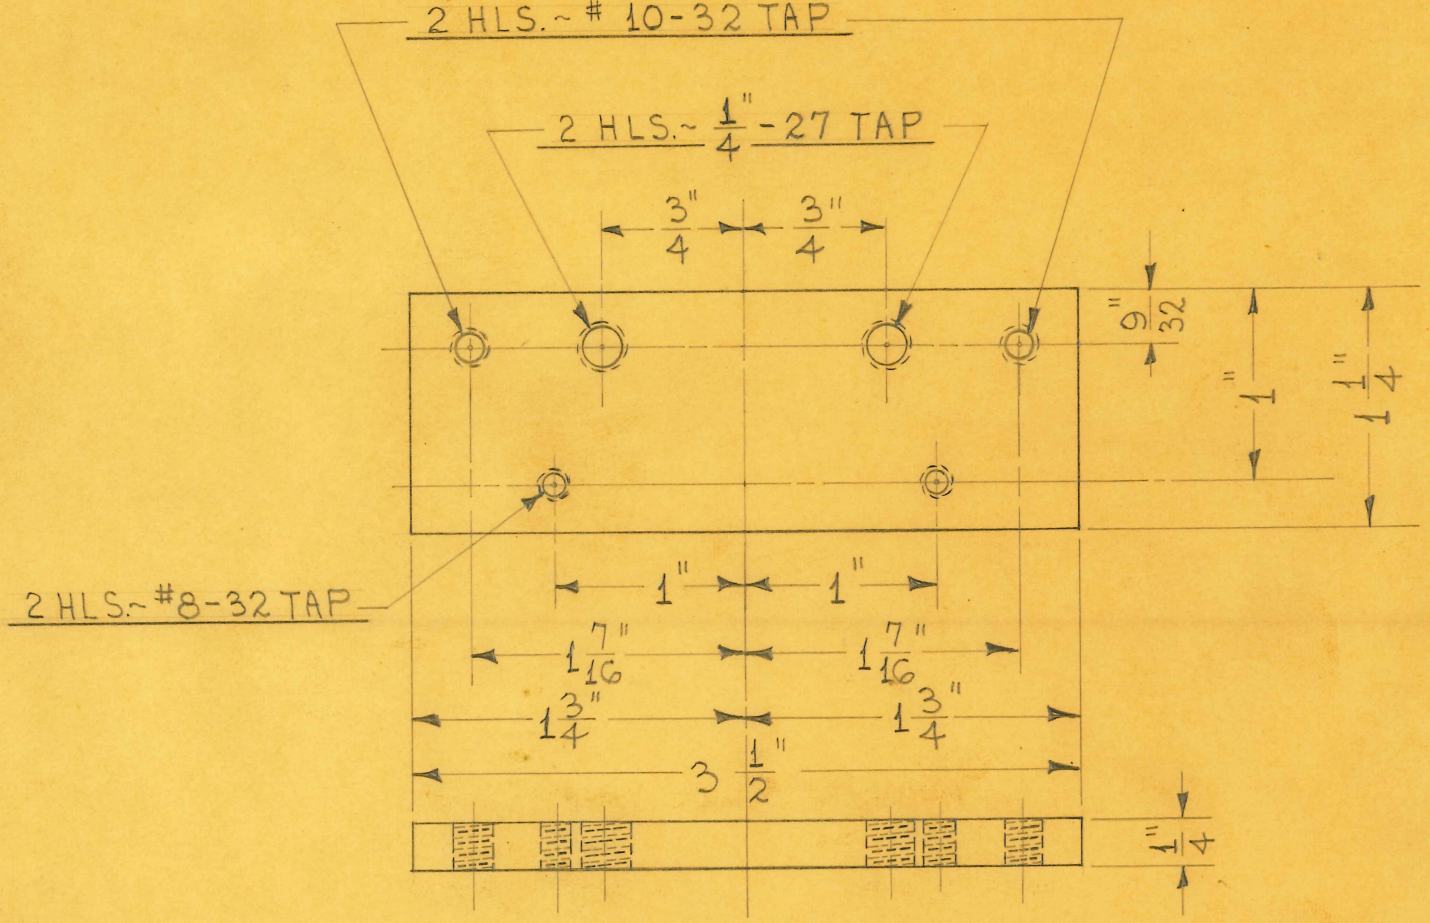

1 REQUIRED

OBSOLETE

SIZE	1 1/4" X 1/4"	ISSUE 9-6-44	H.E.
KIND	C.R. STEEL	CHANGED	
SHAPE	BAR	"	
FINISH	BLACK #81	"	
TEMP.		"	
PATT.		"	

TITLE: MOD. "J" GALV. & CONT. CURR. GEN. ~ SURGE UNIT ~ COMMUTATOR BASE (FOR OLD STYLE MOUNTING FRAMES)

H. G. FISCHER & CO.
2335 WABANSIA AVE.
CHICAGO, ILL.

CAT. NO.

PART NO. 11584

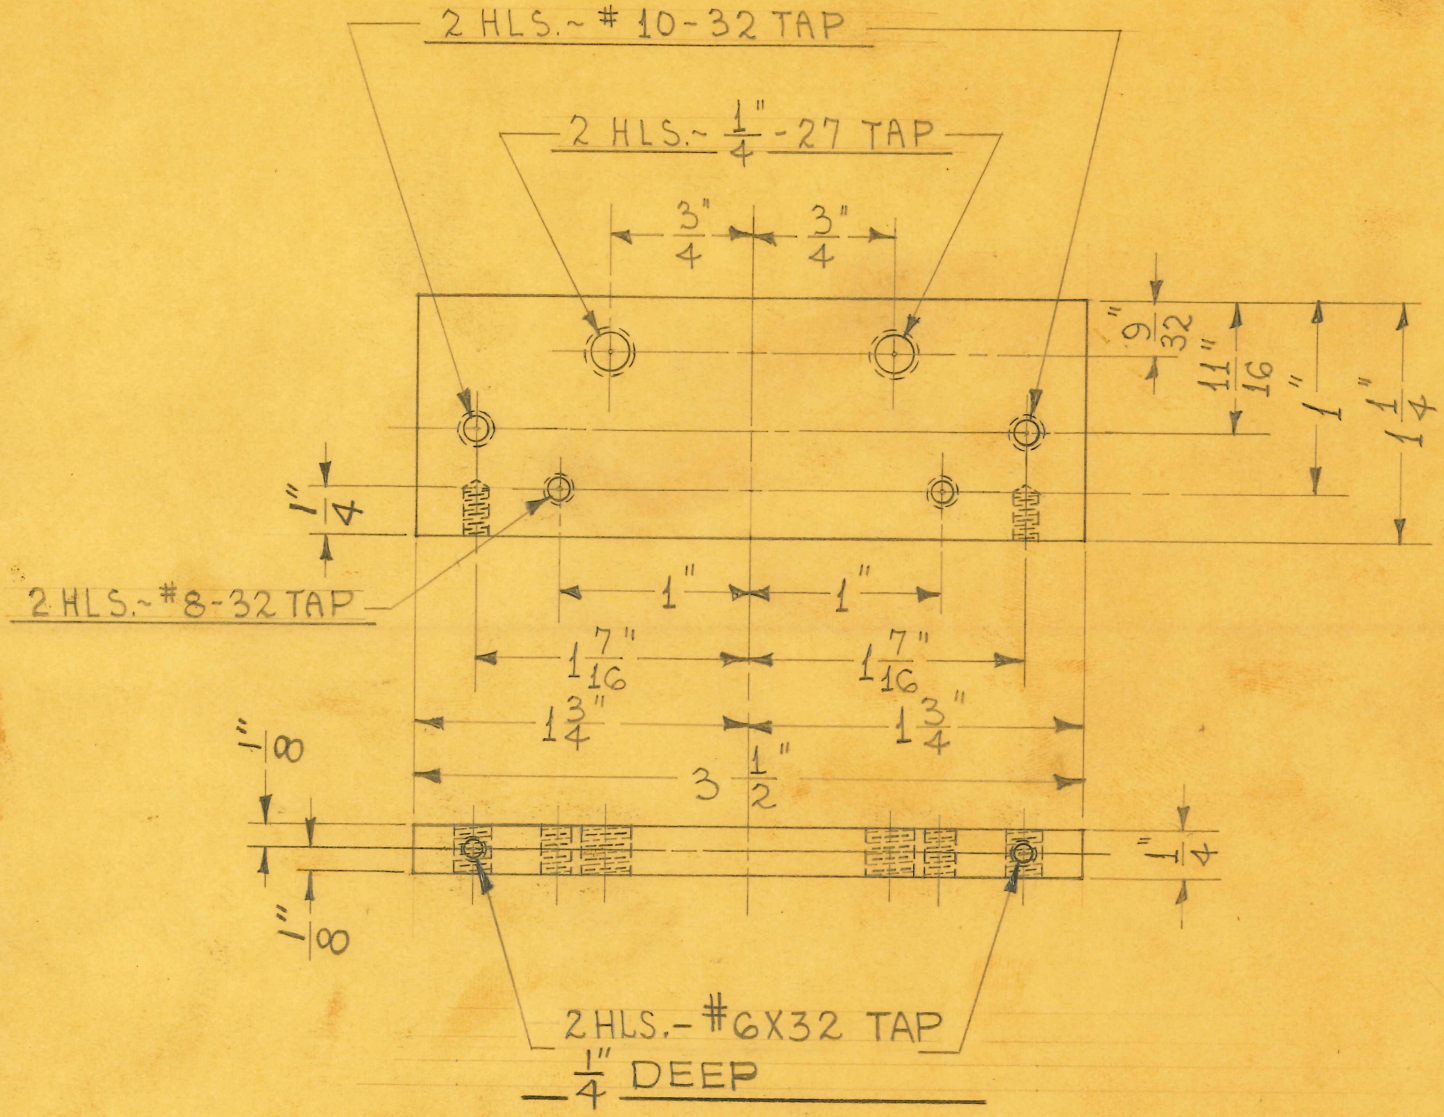

OBSOLETE

SIZE	1 1/4" X 1/4"	ISSUE 9-2-44	H.E.
KIND	C.R. STEEL	CHANGED	
SHAPE	BAR	"	
FINISH	BLACK #81	"	
TEMP.		"	
PATT.		"	

TITLE: MOD. "J" GALV. & CONT. CURR. GEN. ~ SURGE UNIT ~ COMMUTATOR BASE

H. G. FISCHER & CO.
2335 WABANSIA AVE.
CHICAGO, ILL.

CAT. NO.

PART NO. 11584B

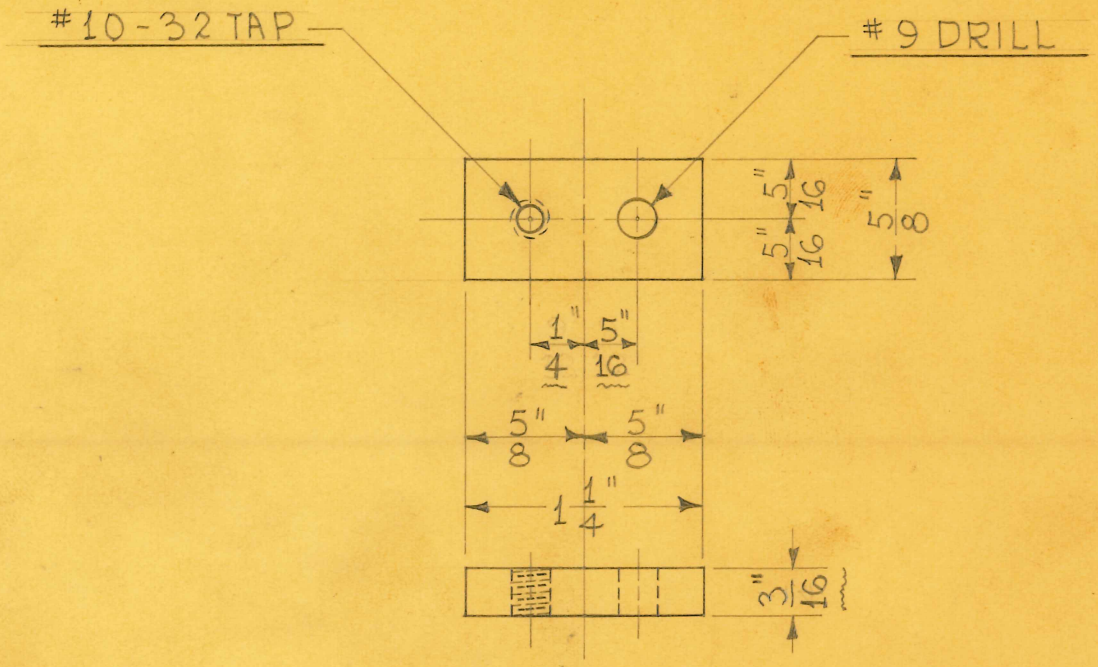

2 REQUIRED

OBSOLETE

SIZE	5/8" X 3/16"	ISSUE 9-6-44	HE.
KIND	C.R. STEEL	CHANGED	
SHAPE	BAR	" 3-30-45 PER C.M.	HE.
FINISH	BLACK #81	"	
TEMP.		"	
PATT.		"	

TITLE: MOD. "J" GALV. & CONT. CURR. GEN ~ SURGE UNIT ~ COM. & RES. UNIT MTG. SPACER BLOCK (FOR OLD STYLE MOUNTING FRAMES)

H. G. FISCHER & CO.
2335 WABANSIA AVE.
CHICAGO. ILL.

CAT. NO.

PART NO. 11584 1/2

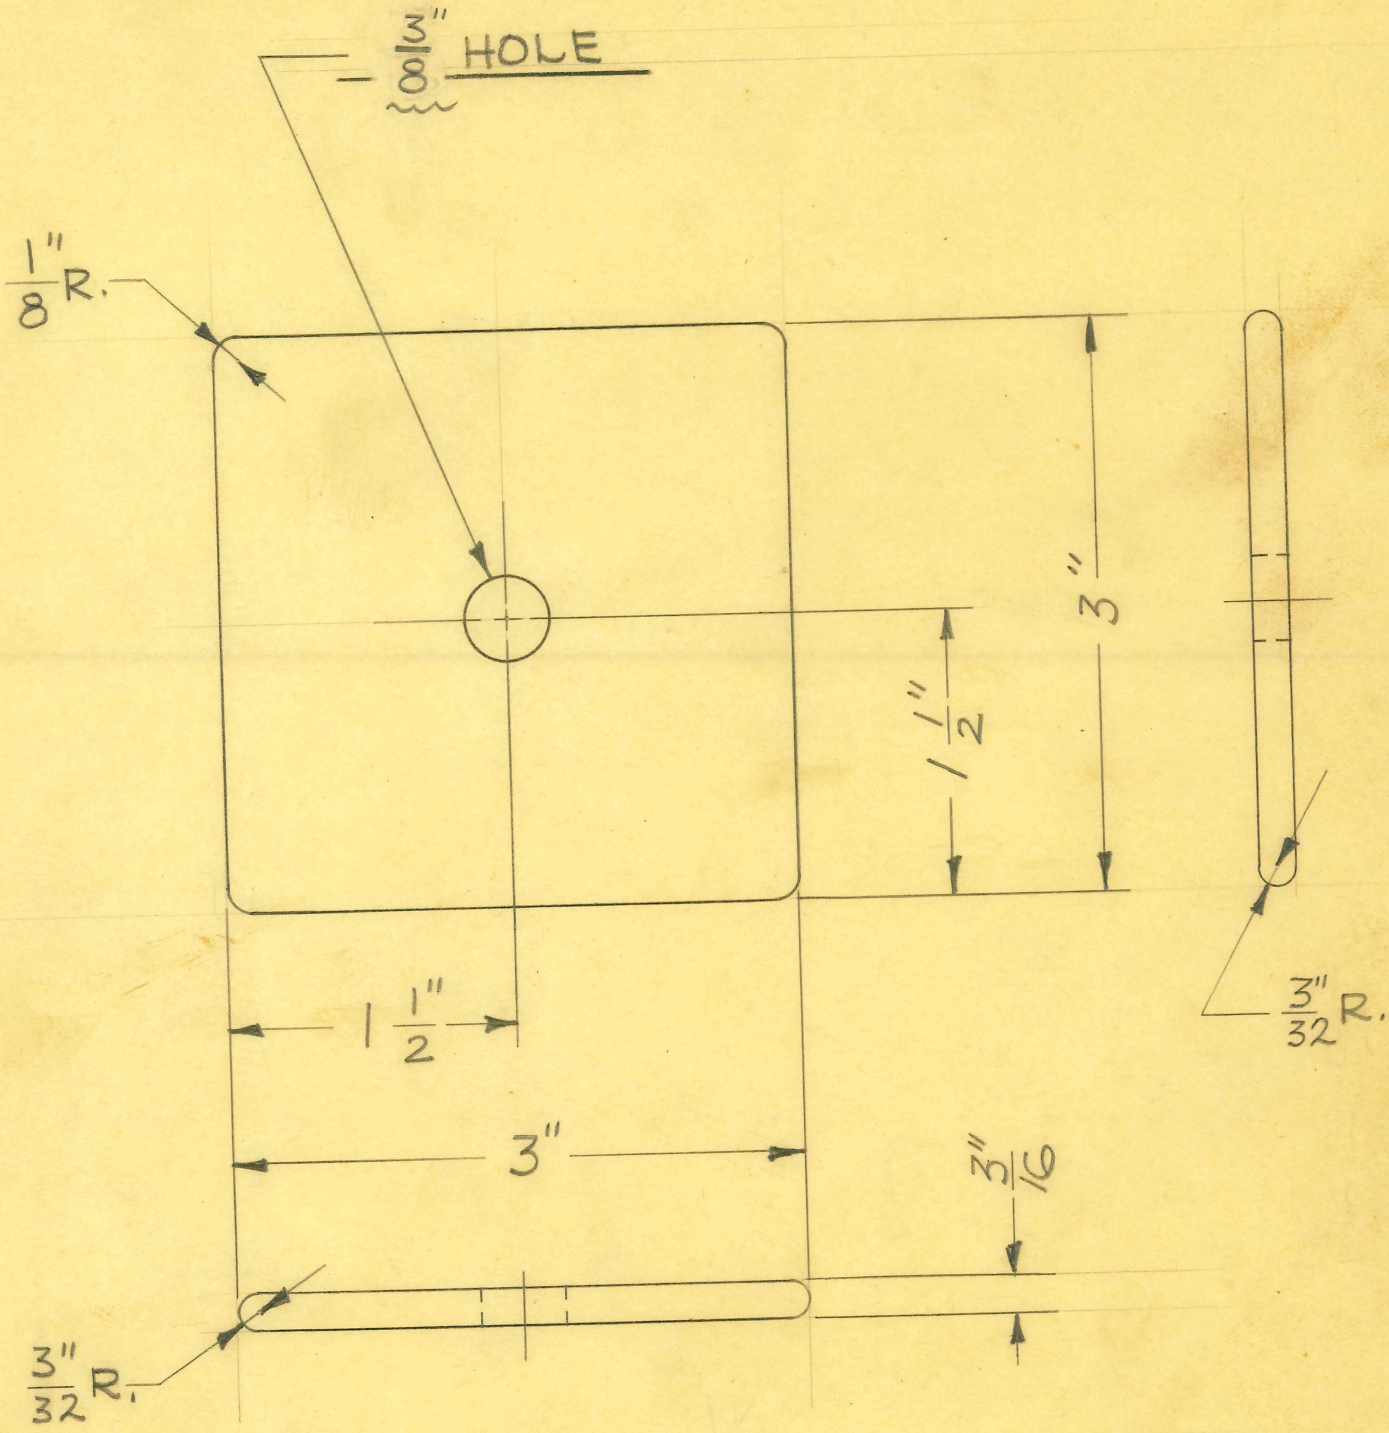

SIZE		ISSUE 6-19-47	J.V.W.	**TITLE:** FISCHER MOD. "J" GALV. & CONT. CURR. GEN. - ELECT. PAD - 3" X 3"
KIND		CHANGED		
SHAPE		"		
FINISH		"		
TEMP.		"		
PATT.		"		

H. G. FISCHER & CO.
2338 WABANSIA AVE.
CHICAGO, ILL.

CAT. NO.

PART NO. 16451

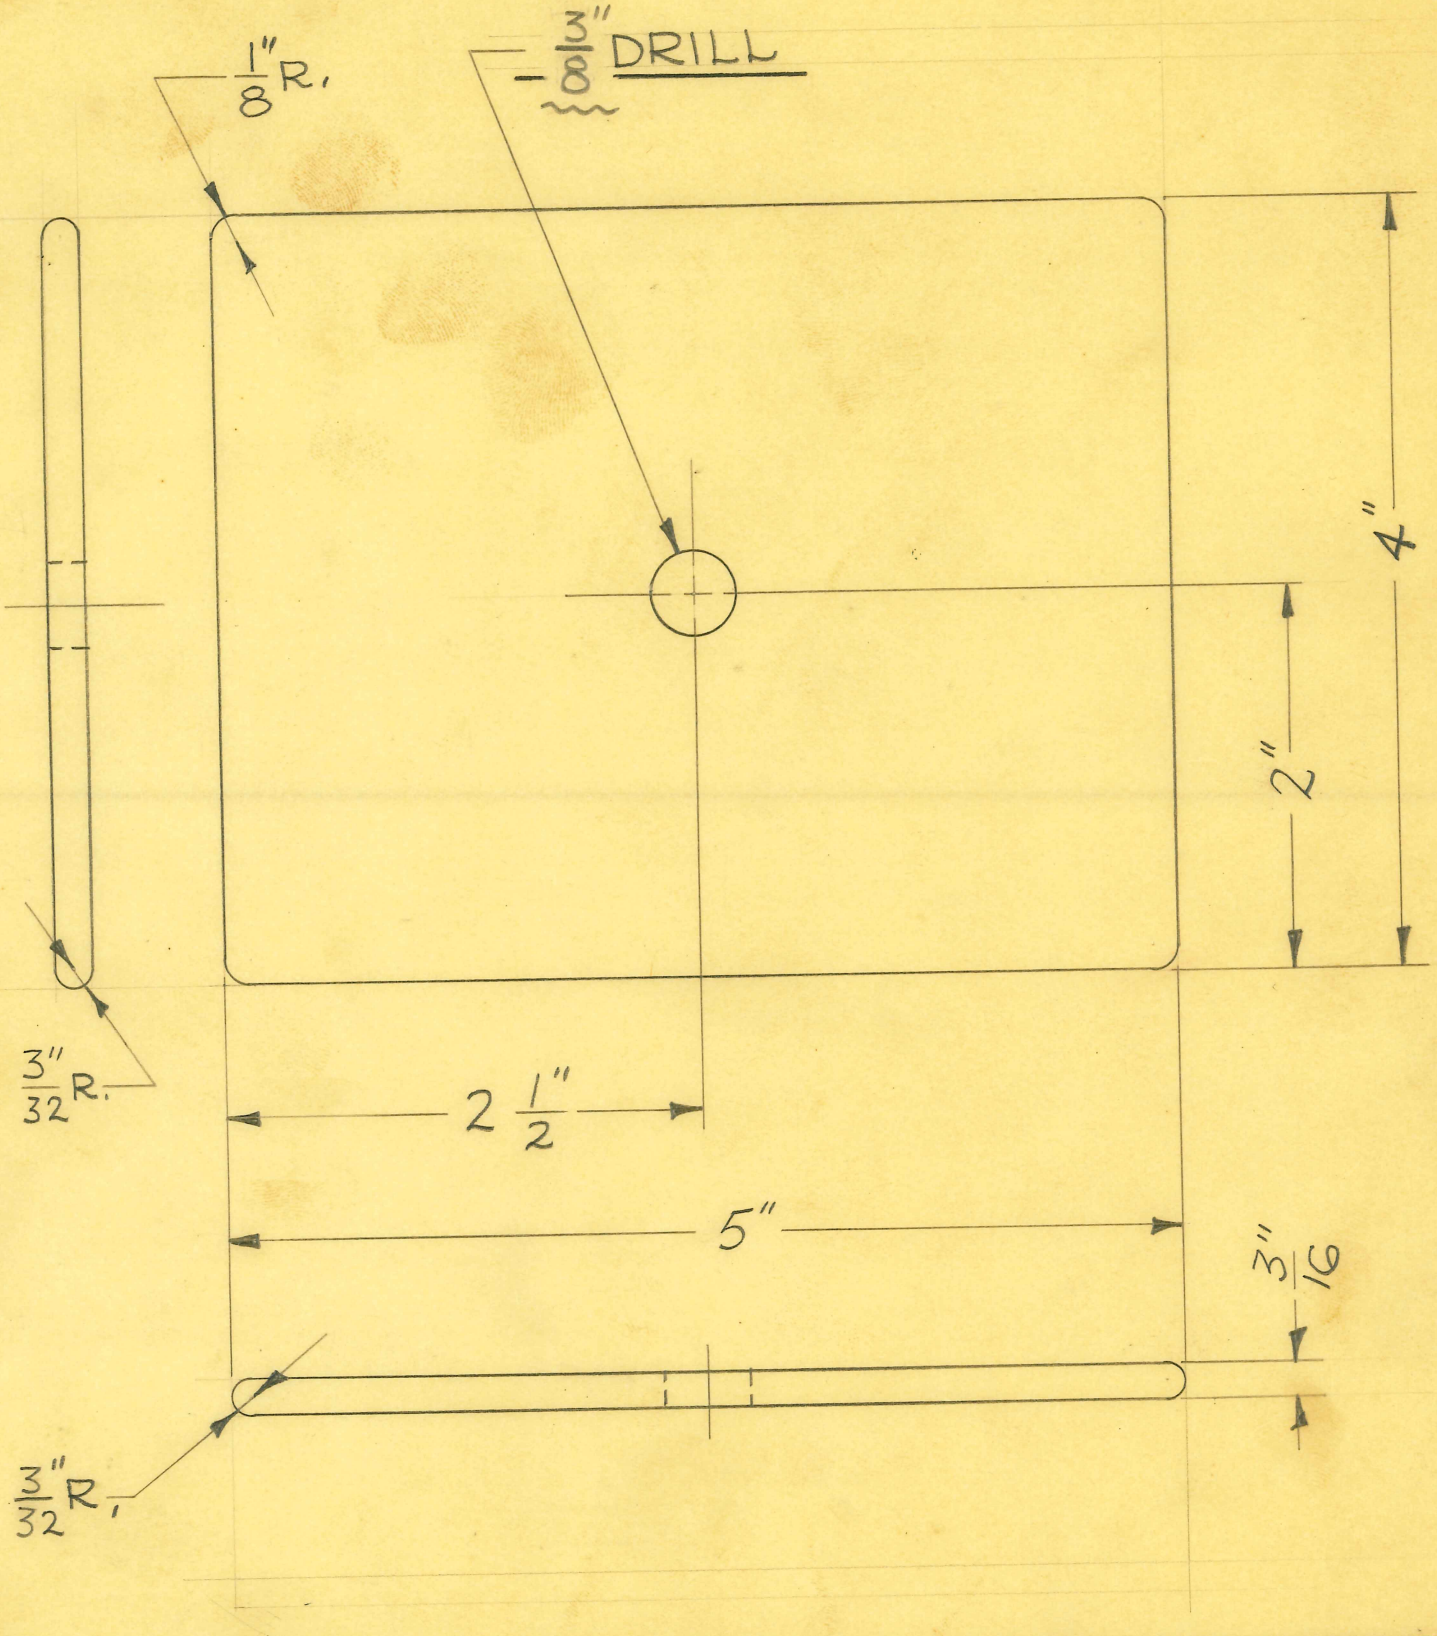

SIZE		ISSUE 6-19-47	J.V.W.
KIND		CHANGED	
SHAPE		"	
FINISH		"	
TEMP.		"	
PATT.		"	

TITLE: FISCHER MOD. "J" GALV. & CONT. CURR. GEN. ELECT. PAD 4"X5"

H. G. FISCHER & CO.
2335 WABANSIA AVE.
CHICAGO, ILL.

CAT. NO.

PART NO. 16452

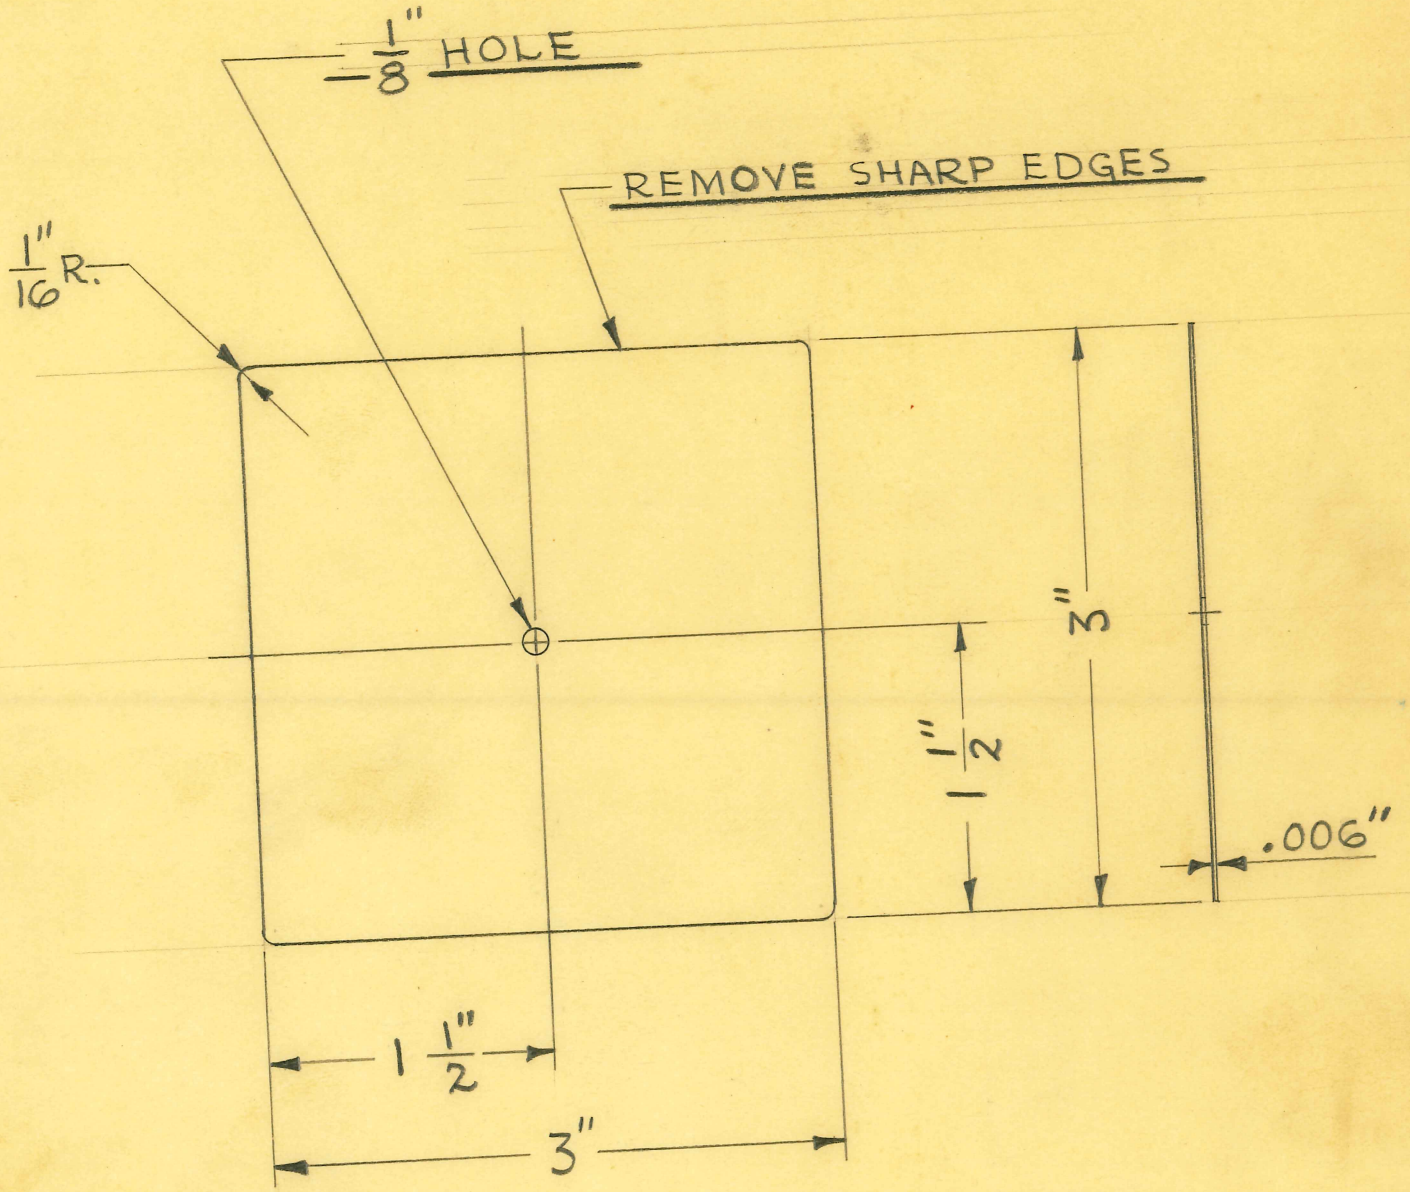

1 REQUIRED

PIERCING DIE TOOL # 9787 RADIUS DIE # 7642

.006" X 6" HALF HARD BRASS STRIP

DIMENSIONS	
FRACTIONAL	± .015
DECIMAL	± .005
ANGULAR	± 1/2°

UNLESS OTHERWISE SPECIFIED

		ISSUE	4-12-48	J.V.W.
SIZE		CHANGED		
KIND		"		
SHAPE		"		
FINISH		"		
TEMP.		"		
PATT.		"		

TITLE: FISCHER MOD. "J" GALV. & CONT. CURR. GEN. 3" X 3" PAD ELECT. CONTACT PLATE

H. G. FISCHER & CO.
2335 WABANSIA AVE.
CHICAGO, ILL.

CAT. NO.

PART NO. 16455

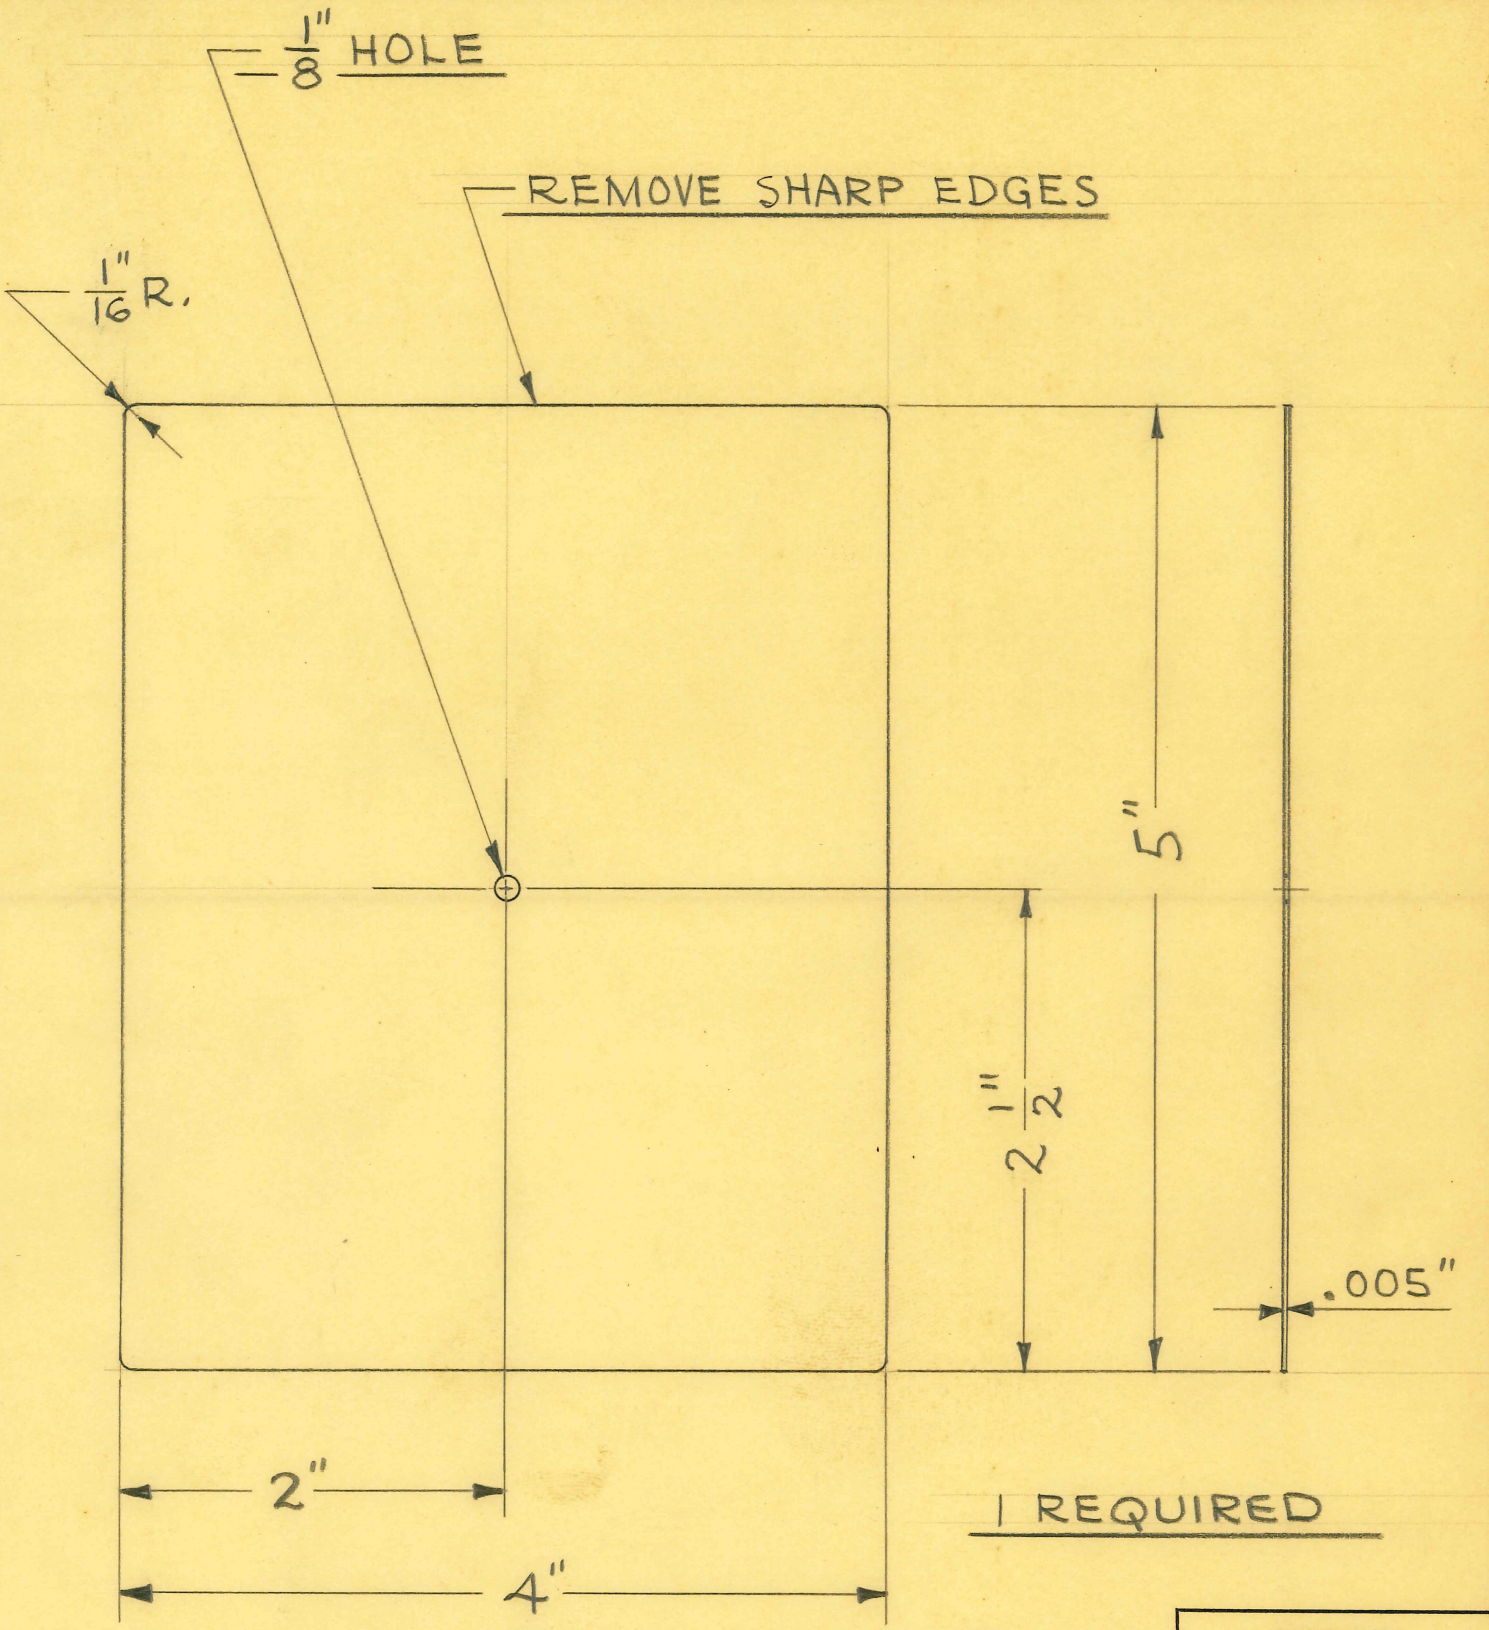

1 REQUIRED

PIERCING DIE TOOL # 9787 RADIUS DIE # 7642
.005" X 6" PHOS. BRONZE STRIP

DIMENSIONS	
FRACTIONAL	± .015
DECIMAL	± .005
ANGULAR	± 1/2°

UNLESS OTHERWISE SPECIFIED

SIZE		ISSUE 4-12-48	J.V.W.
KIND		CHANGED	
SHAPE		"	
FINISH		"	
TEMP.		"	
PATT.		"	

TITLE:
FISCHER MOD. "J" GALV. & CONT. CURR. GEN.
4"X5" PAD ELECT. CONTACT PLATE

H. G. FISCHER & CO.
2335 WABANSIA AVE.
CHICAGO, ILL.

CAT. NO.

PART NO. 16456

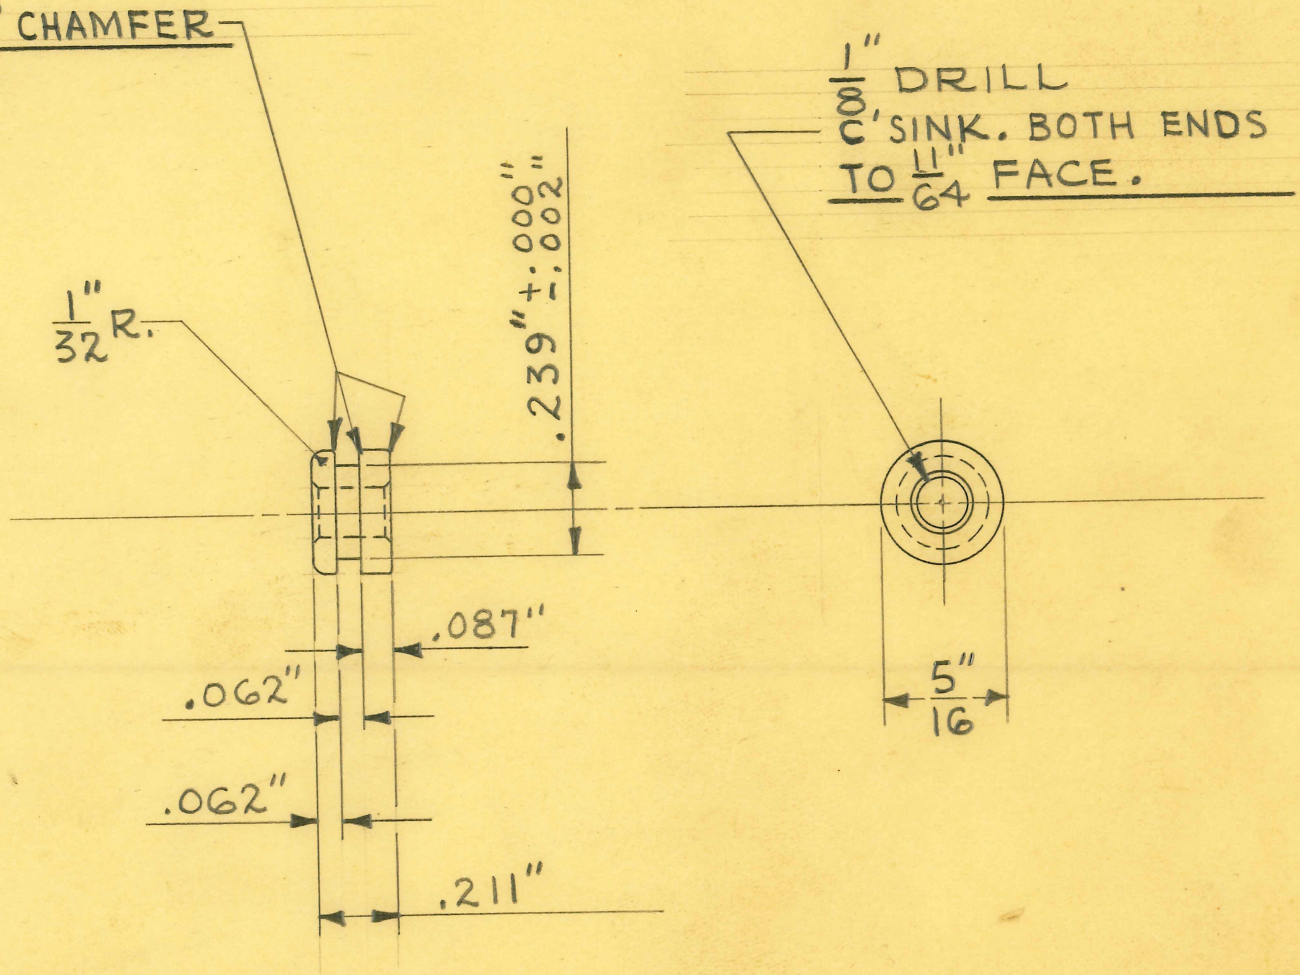

SCALE ~ DOUBLE SIZE

1 REQUIRED

FORMING TOOL # 9861

DIMENSIONS	
FRACTIONAL	± .015
DECIMAL	± .005
ANGULAR	± 1/2°

UNLESS OTHERWISE SPECIFIED

SIZE	5/16" DIA.	ISSUE 4-12-48	J.V.W.
KIND	BRASS ROD	CHANGED	
SHAPE		"	
FINISH		"	
TEMP.		"	
PATT.		"	

TITLE: FISCHER MOD. "J" GALV. & CONT. CURR. GEN. PAD ELECT. CONTACT BUTTON

H. G. FISCHER & CO.
2335 WABANSIA AVE.
CHICAGO, ILL.

CAT. NO.

PART NO. 16463

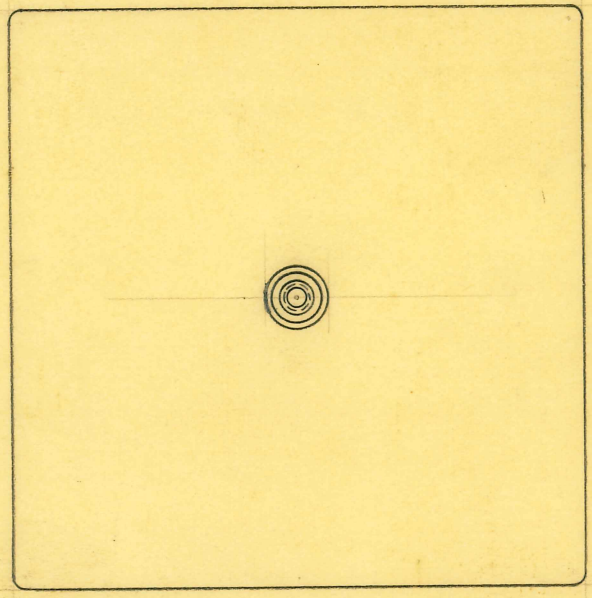

SPIN OVER ONTO
CONTACT BUTTON
MUST BE VERY TIGHT

BUTTON # 16463

PLATE # 16455

EYELET # 16464

1 REQUIRED

DIMENSIONS	
FRACTIONAL	± .015
DECIMAL	± .005
ANGULAR	± 1/2°

UNLESS OTHERWISE SPECIFIED

SIZE		ISSUE 4-12-48	J.V.W.
KIND		CHANGED	
SHAPE		"	
FINISH	WH. CHR. #3	"	
TEMP.		"	
PATT.		"	

TITLE:

FISCHER MOD. "J" GALV. & CONT. CURR. GEN.
3" X 3" PAD ELECT. CONTACT PLATE
ASSEM.

H. G. FISCHER & CO.
2335 WABANSIA AVE.
CHICAGO, ILL.

CAT. NO.

PART NO. 16465G

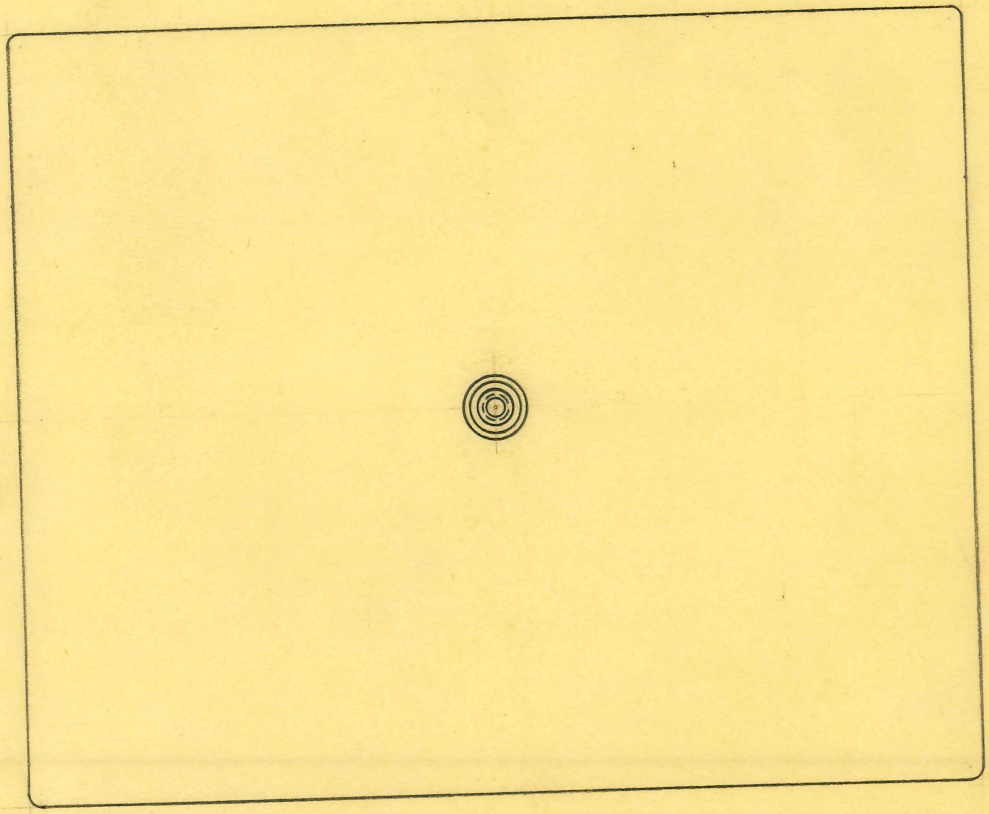

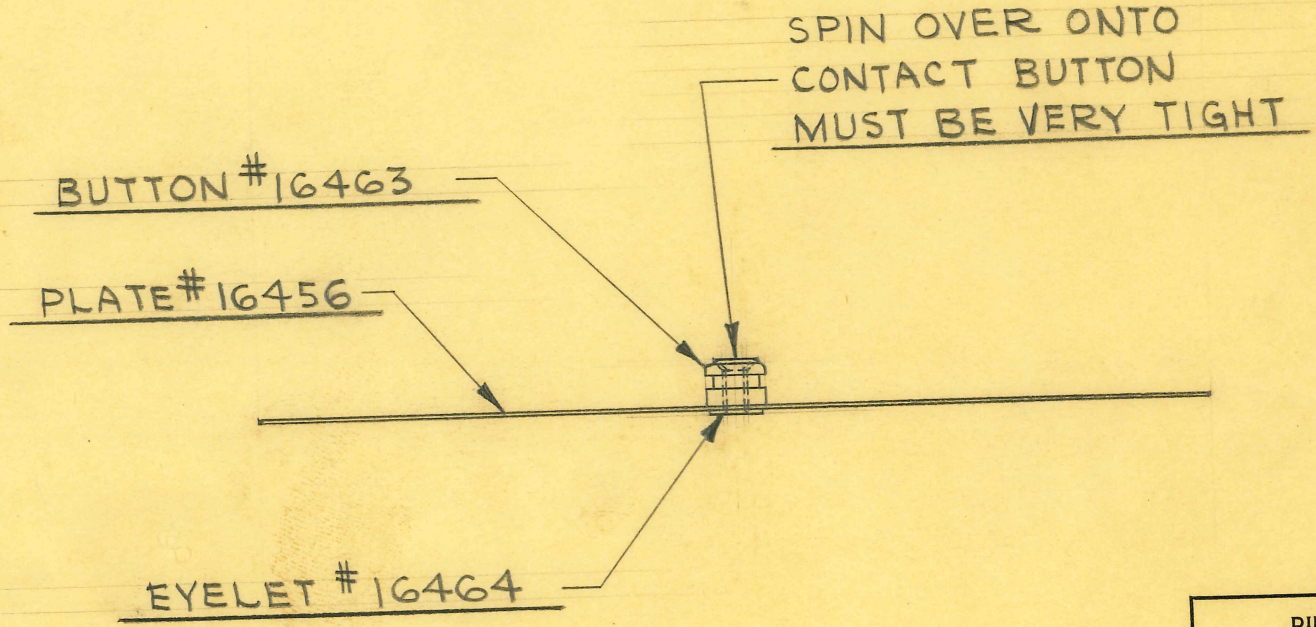

1 REQUIRED

DIMENSIONS	
FRACTIONAL	± .015
DECIMAL	± .005
ANGULAR	± 1/2°

UNLESS OTHERWISE SPECIFIED

SIZE		ISSUE 4-13-48	J.V.W.
KIND		CHANGED	
SHAPE		"	
FINISH	WH. CHR. #3	"	
TEMP.		"	
PATT.		"	

TITLE: FISCHER MOD. "J" GALV. & CONT. CURR. GEN. 4X5 PAD ELECT.- CONTACT PLATE ASSEM.

H. G. FISCHER & CO.
2335 WABANSIA AVE.
CHICAGO, ILL.

CAT. NO.

PART NO. 16466G

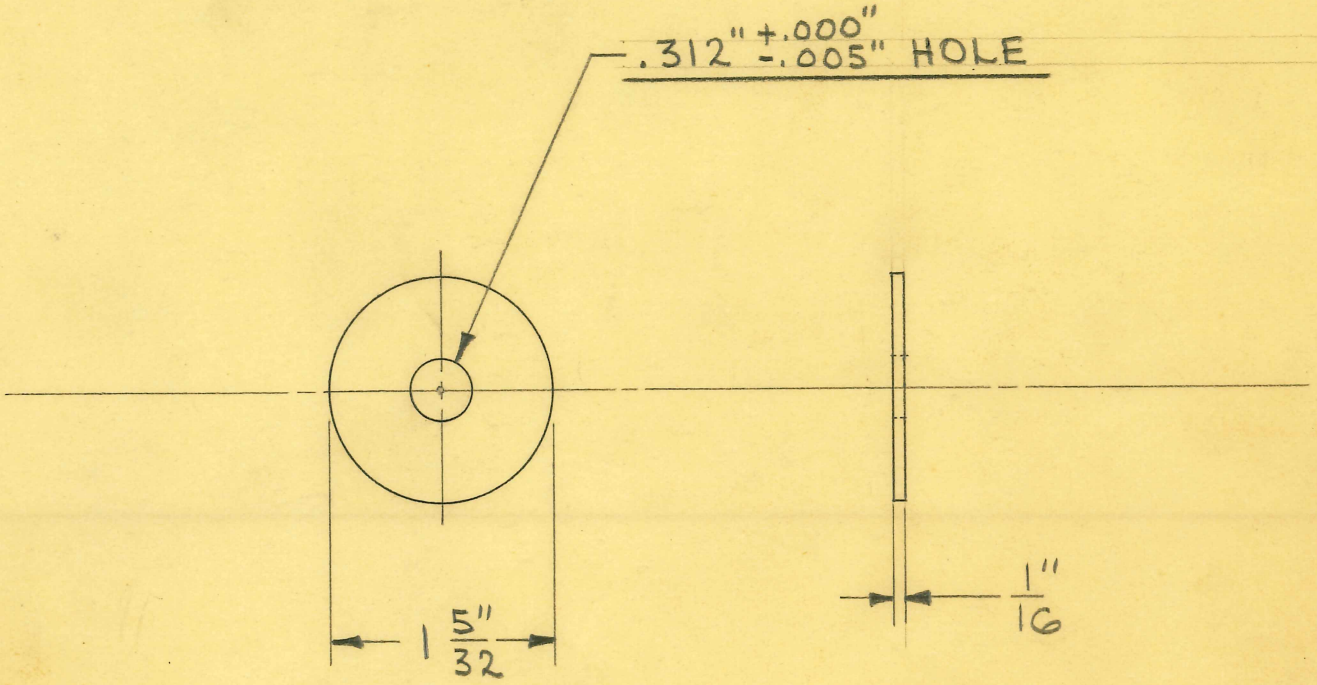

USE SCRAP 1 5/32" DIA. BLANK
PUNCHED FROM #13281A WASHER

1 REQUIRED

1 5/32" DIA. BLANK DIE TOOL # 7866
.312 PIERCING DIE TOOL # 9786

DIMENSIONS	
FRACTIONAL	± .015
DECIMAL	± .005
ANGULAR	± 1/2°

UNLESS OTHERWISE SPECIFIED

SIZE	1/16" SHEET	ISSUE 4-13-48	J.V.W.
KIND	NEOPRENE	CHANGED	
~~SHAPE~~	USE SCRAP	"	
~~FINISH~~	BLANK FROM	"	
~~TEMP.~~	PCE. #13281A	"	
~~PATT.~~		"	

TITLE:
FISCHER MOD. "J" GALV. & CONT. CURR. GEN.
PAD ELECT - RUBBER WASHER

H. G. FISCHER & CO.
2335 WABANSIA AVE.
CHICAGO, ILL.

CAT. NO.

PART NO. 16479

TITLE
FISCHER MOD. "J" GALV. & CONT. CURR. GEN. — MOTOR MOUNT CLAMP ANGLE

H. G. FISCHER & CO.
FRANKLIN PARK, ILLINOIS

PART NO. 15941

DATE 7-14-49 DR. BY J.V.W. CH'K'D.

REVISION	DATE	BY

PATTERN | FINISH BLACK #80 | SCALE FULL

TOOLS
DRILL JIG # 11309

MATERIAL
#18 GA. (.048") SHEET C.R. STEEL

DIMENSIONS
FRACTIONAL ± .015
DECIMAL ± .005
ANGULAR ± ½°
UNLESS OTHERWISE SPECIFIED

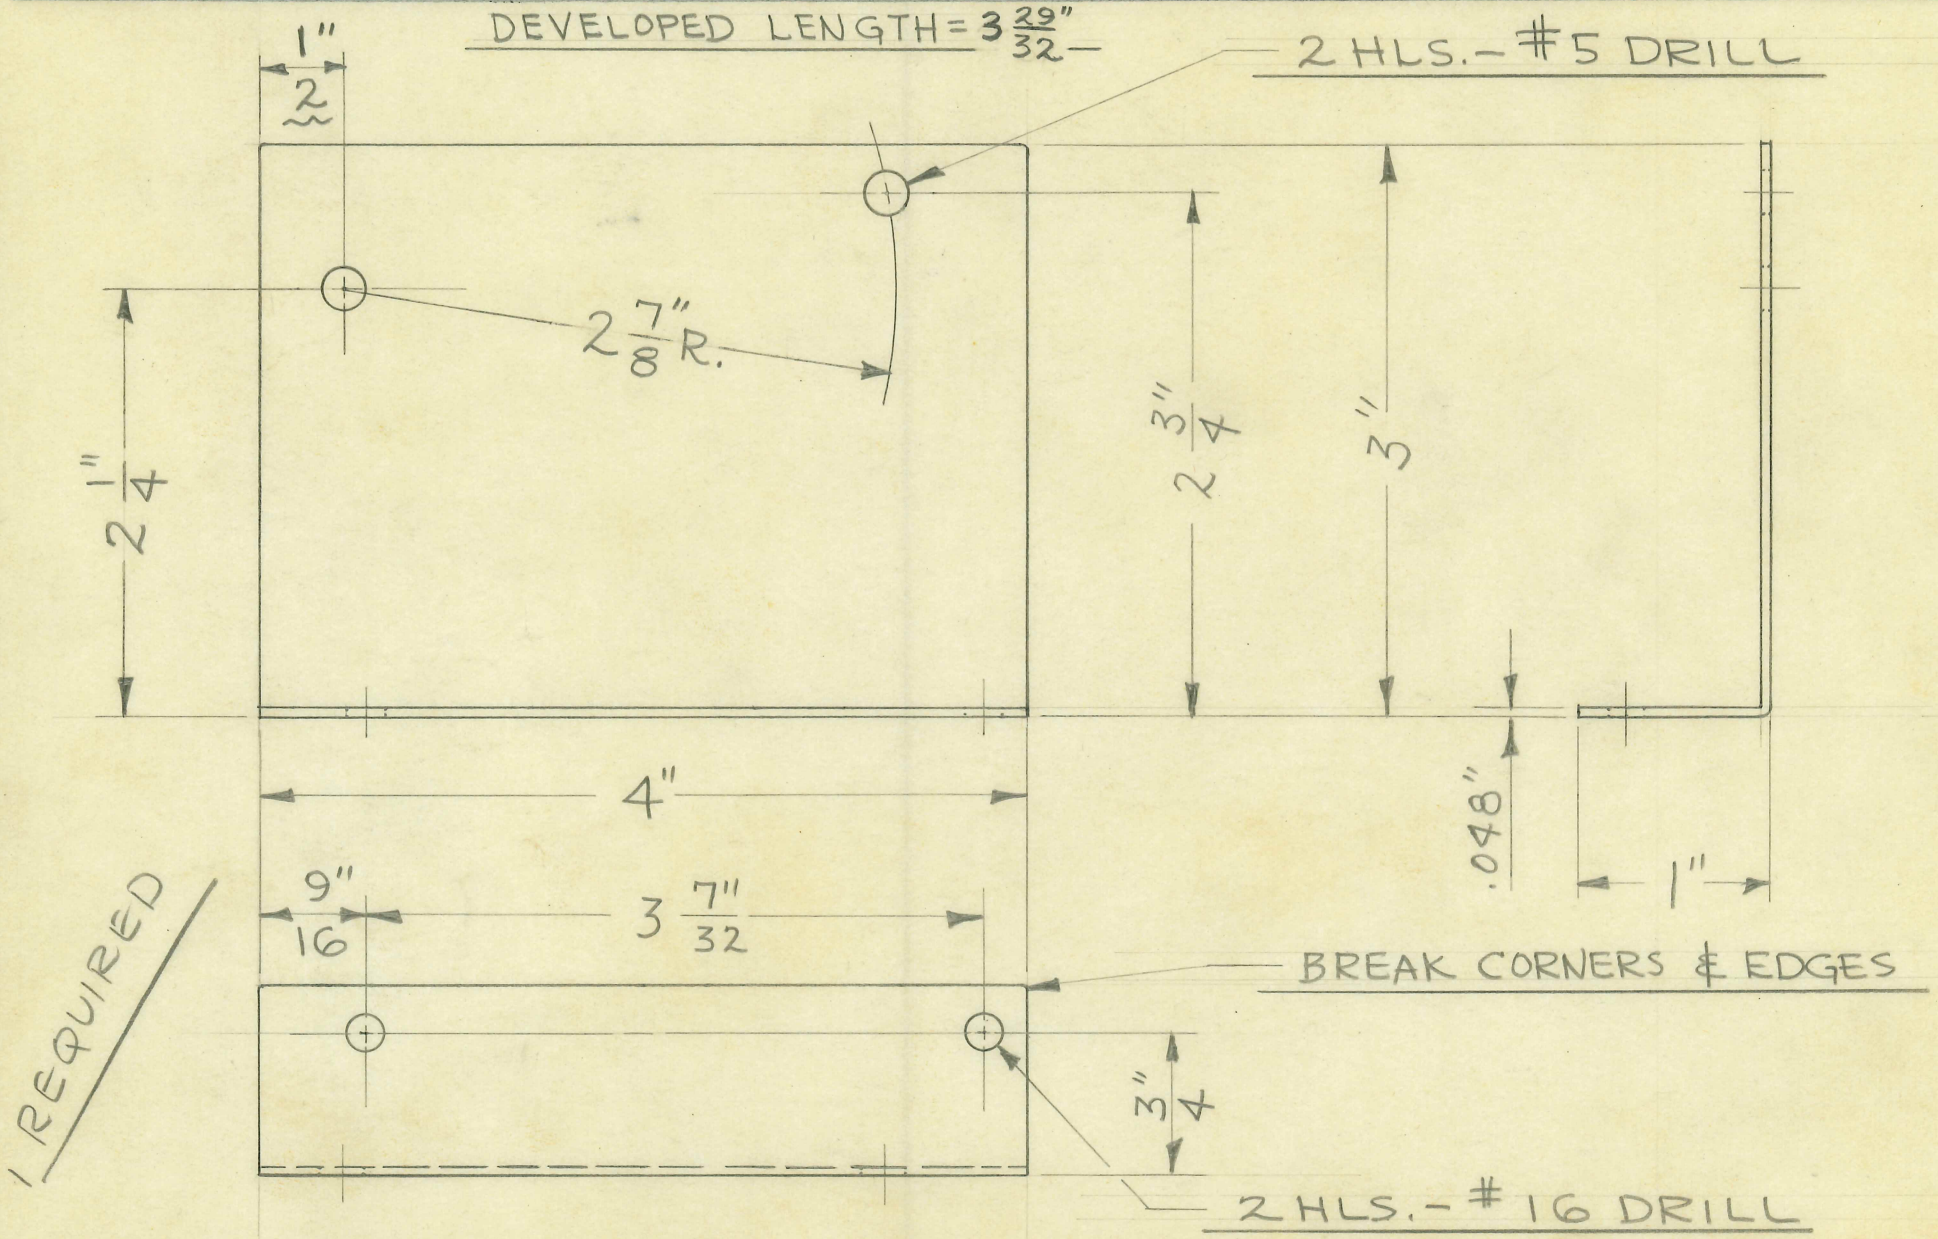

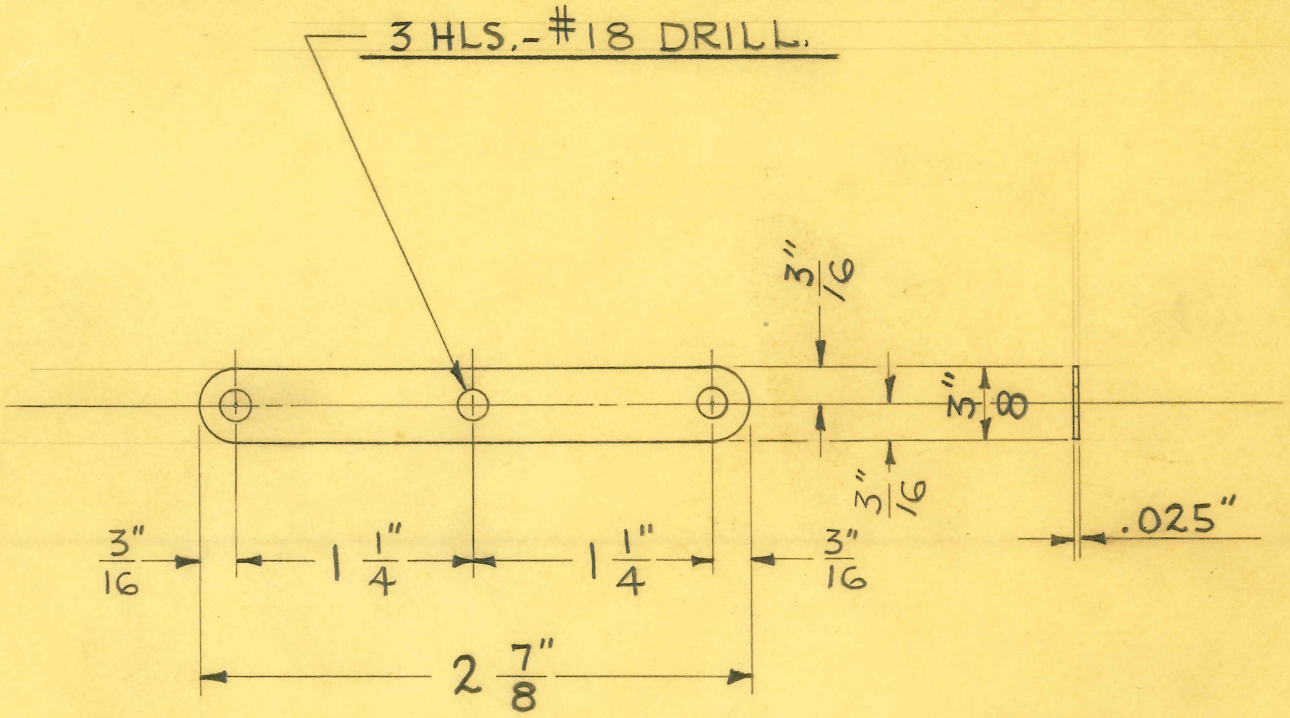

2 REQUIRED

SIZE	.025"	ISSUE 5-17-46	J.V.W.
KIND	SHEET BRASS	CHANGED	
SHAPE		"	
FINISH		"	
TEMP.		"	
PATT.		"	

TITLE:
FISCHER MOD. "J" GALV. & CONT. CURR. GEN. MULTIPLE CONNECTION CLIP LINK

H. G. FISCHER & CO.
2335 WABANSIA AVE.
CHICAGO, ILL.

CAT. NO.

PART NO. 15949

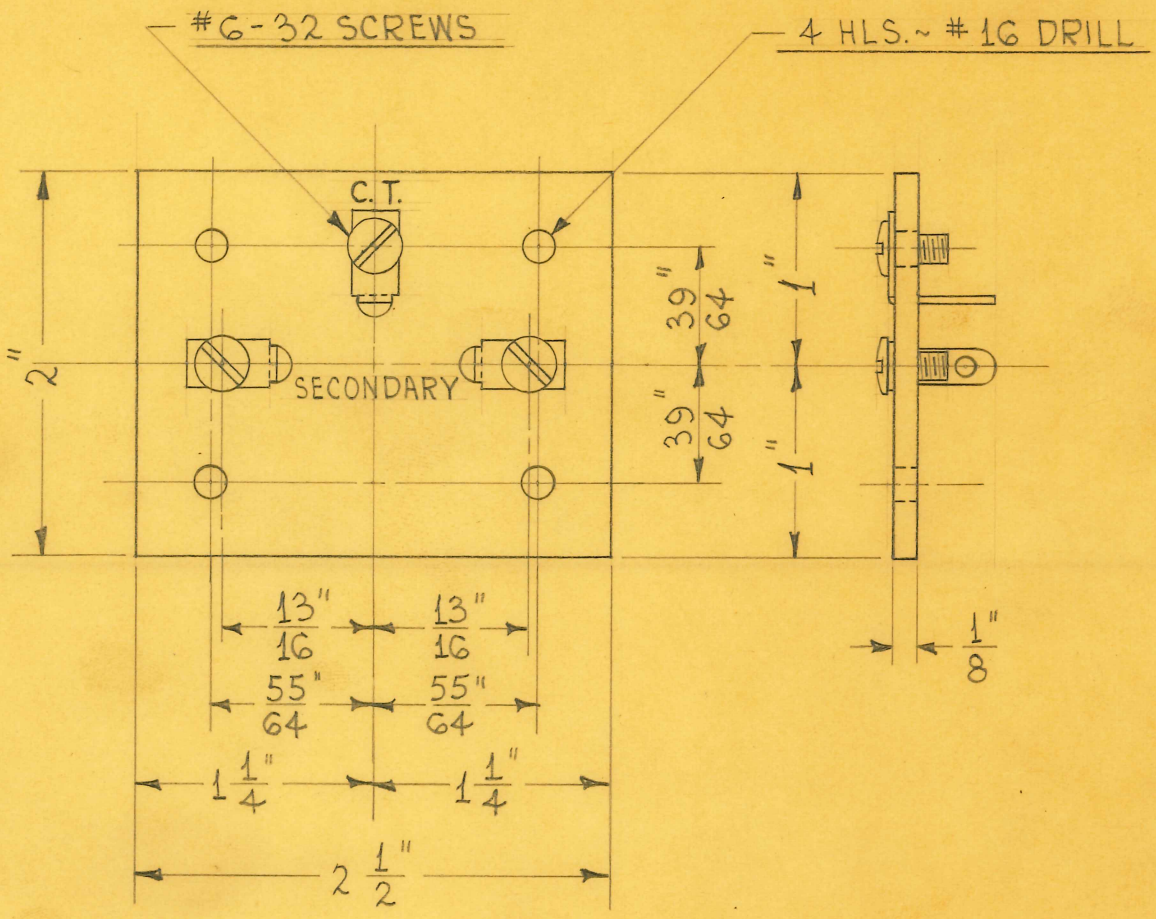

1 REQUIRED

SIZE	1/8" SHEET	ISSUE 2-19-45	HE.
KIND	XX BAKELITE	CHANGED	
SHAPE		"	
FINISH		"	
TEMP.		"	
PATT.		"	

TITLE: FISCHER MOD. "J" GALV. & CONT. CURR. GEN. POWER TRANS. ~ SECONDARY TERM. BOARD

H. G. FISCHER & CO.
2335 WABANSIA AVE.
CHICAGO. ILL.

CAT. NO.

PART NO. 15953G

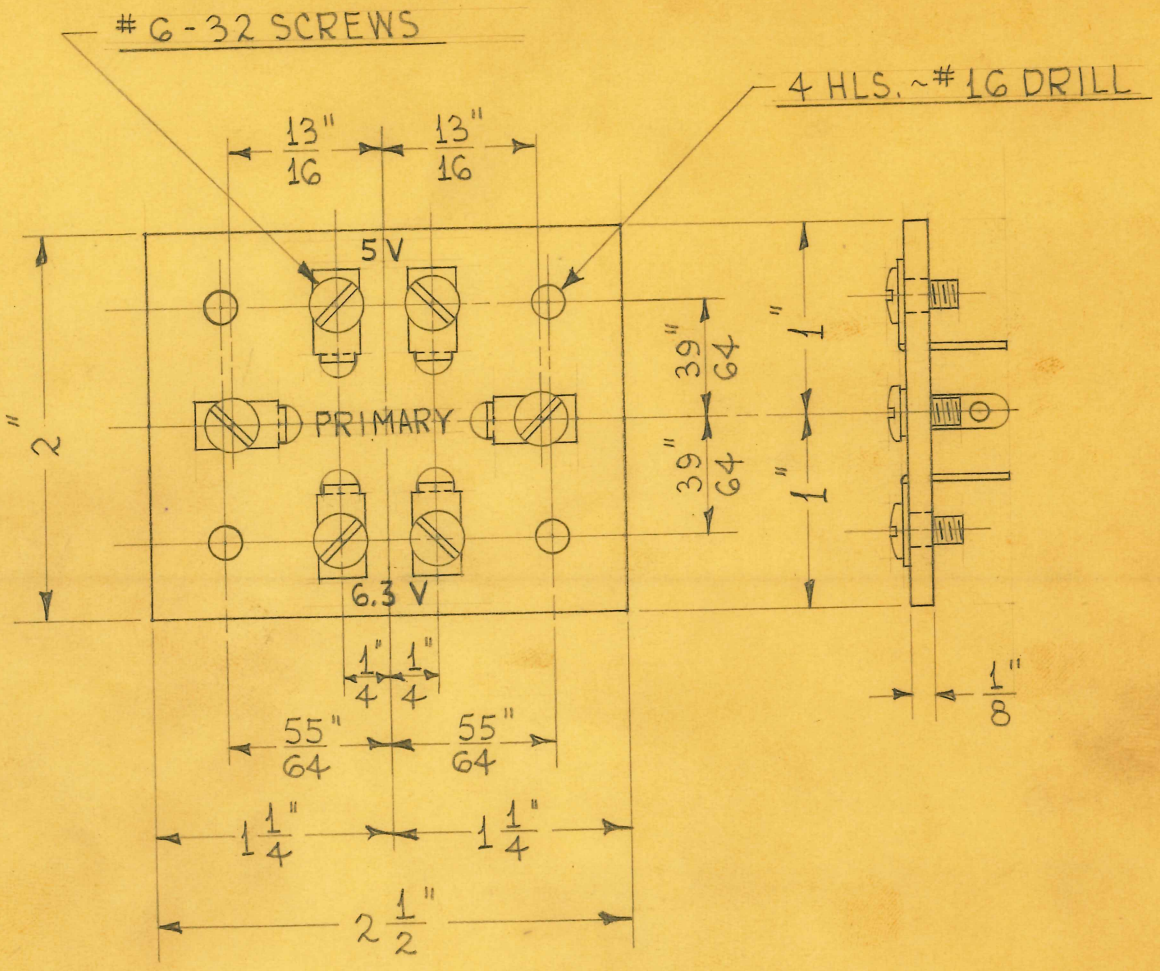

1 REQUIRED

SIZE	1/8" SHEET	ISSUE 2-19-45	H.E.
KIND	XX BAKELITE	CHANGED	
SHAPE		" 12-27-45	J.V.W.
FINISH		"	
TEMP.		"	
PATT.		"	

TITLE: FISCHER MOD. "J" GALV. & CONT. CURR. GEN. POWER TRANS. - PRIMARY TERM. BOARD

H. G. FISCHER & CO.
2338 WABANSIA AVE.
CHICAGO, ILL.

CAT. NO.

PART NO. 15954G

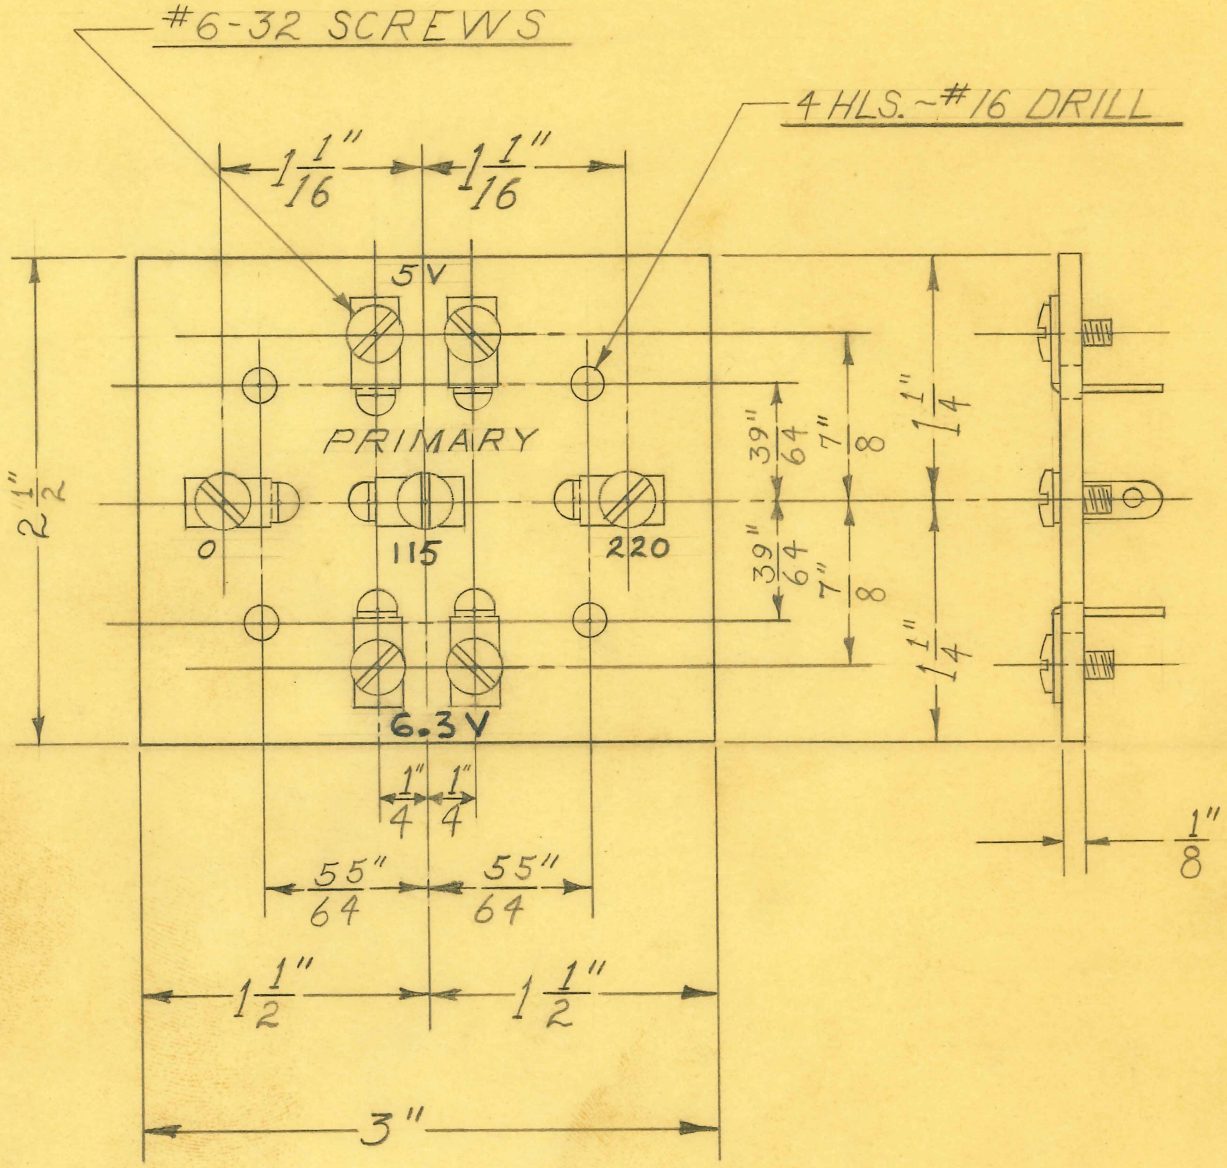

1 REQUIRED

SIZE	1/8 SHEET	ISSUE 5-9-47	W.V.
KIND	XX BAKELITE	CHANGED	
SHAPE		"	
FINISH		"	
TEMP.		"	
PATT.		"	

TITLE: FISCHER MOD. "J" GALV. & CONT. CURR. GEN. POWER TRANS. PRIMARY TERM. BOARD (220)

H. G. FISCHER & CO.
2335 WABANSIA AVE.
CHICAGO, ILL.

CAT. NO.

PART NO. 15954 1/2

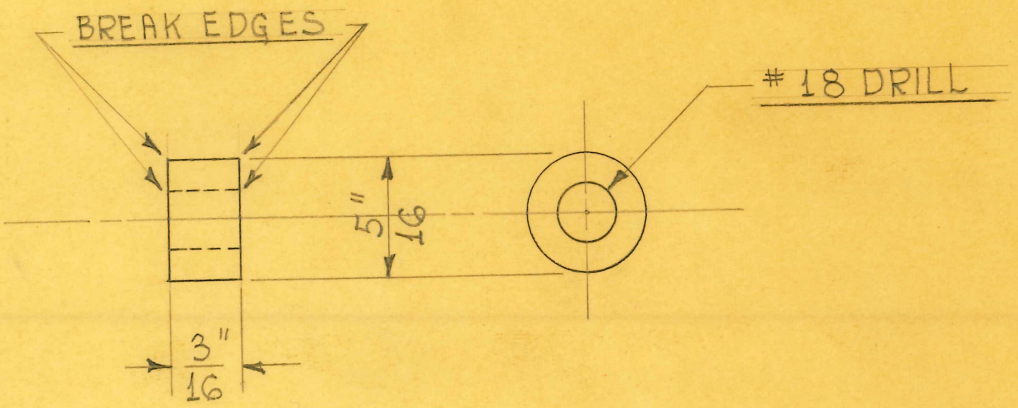

SCALE ≈ 1" = 1/2"

8 REQUIRED

SIZE	5/16" DIA.	ISSUE 3-5-45	HE.
KIND	BRASS ROD	CHANGED	
SHAPE		"	
FINISH		"	
TEMP.		"	
		"	

TITLE: FISCHER MOD. "J" GALV. & CONT. CURR. GEN. POWER TRANSF. TERM. BD. SPACER

H. G. FISCHER & CO.
2335 WABANSIA AVE.
CHICAGO, ILL.

CAT. NO.

PART NO. 15958

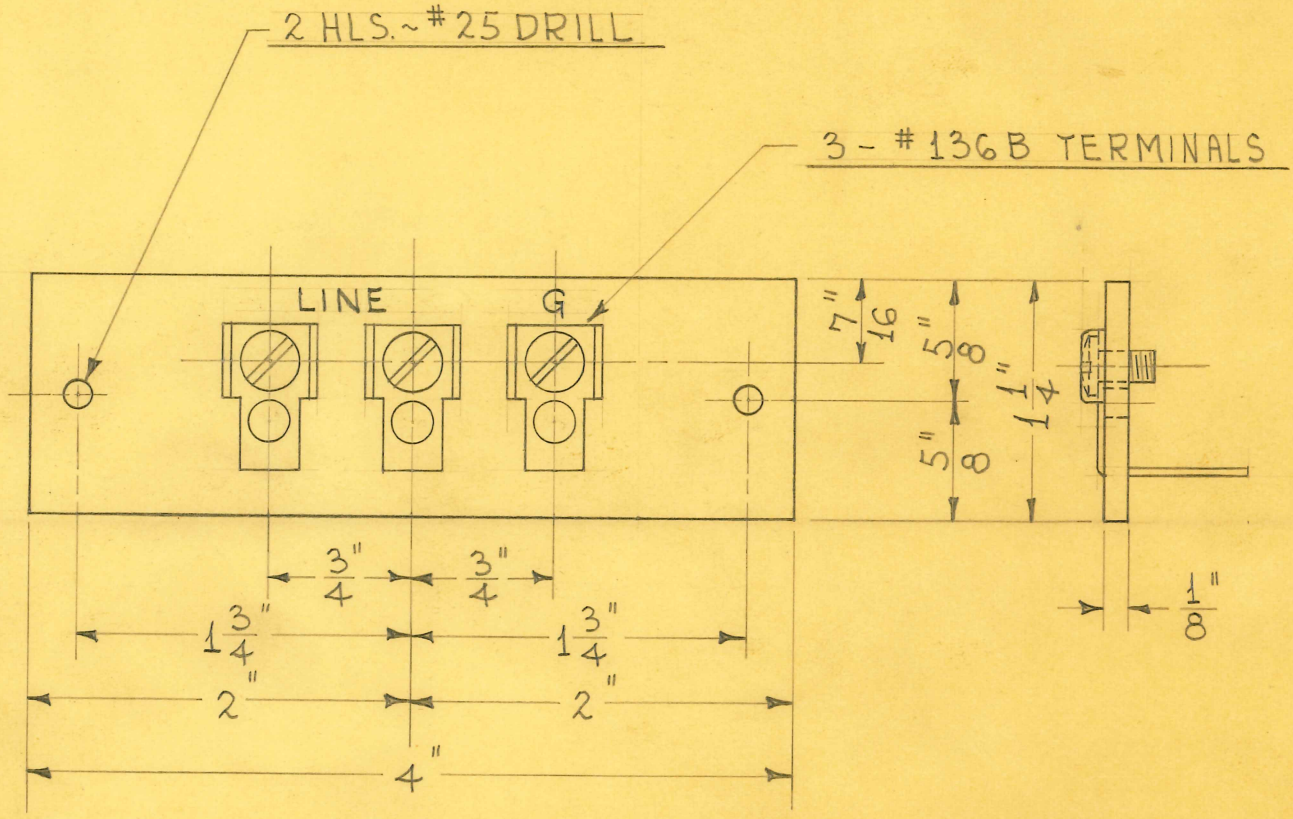

1 REQUIRED

SIZE	1/8"	ISSUE 4-23-45	HE.
KIND	XP BAKELITE	CHANGED	
SHAPE		"	
FINISH		"	
TEMP.		"	
PATT.		"	

TITLE: FISCHER "J" GALV. & CONT. CURR. GEN. LINE TERMINAL BOARD

H. G. FISCHER & CO.
2335 WABANSIA AVE.
CHICAGO, ILL.

CAT. NO.

PART NO. 15961G

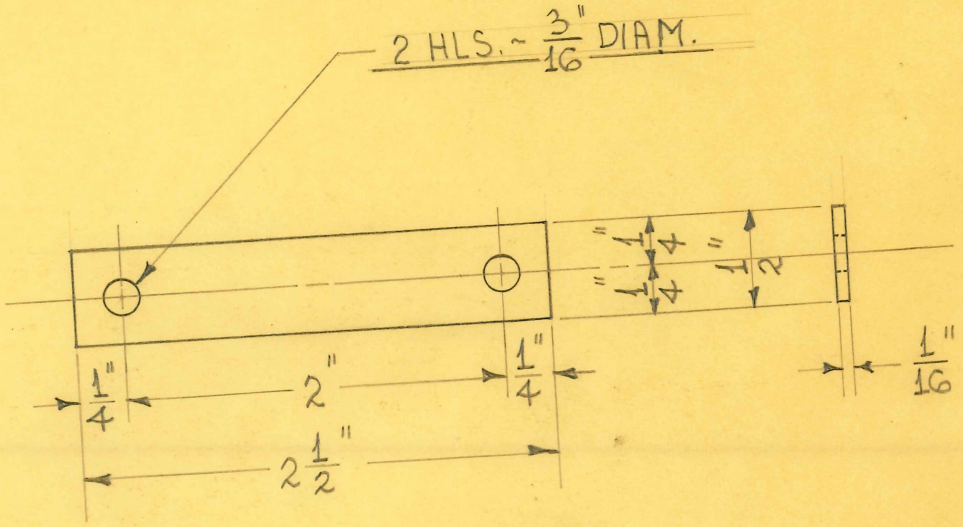

4 REQUIRED

SIZE	1/16"	ISSUE 4-23-45	HE.
KIND	BLACK FIBRE	CHANGED	
SHAPE		"	
FINISH		"	
TEMP.		"	
		"	

TITLE: FISCHER "J" GALV. & CONT. CURR. GEN. MAGNETIC INSULATOR

H. G. FISCHER & CO.
2335 WABANSIA AVE.
CHICAGO. ILL.

CAT. NO.

PART NO. 15967

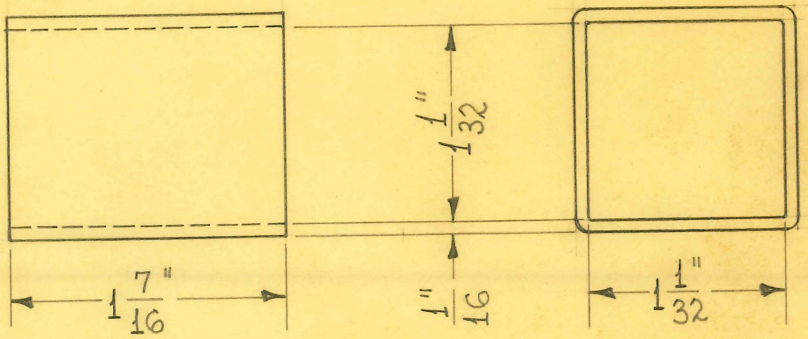

1 REQUIRED

SIZE	1/32" SQ. I.D. X	ISSUE 4-27-45	HE.
KIND	1/16" WALL	CHANGED	
KIND SHAPE	PAPER TUBING	"	
FINISH		"	
TEMP.		"	
PATT.		"	

TITLE: FISCHER "J" GALV. & CONT. CURR. GENERATOR
OSCILATING COIL WINDING TUBE

H. G. FISCHER & CO.
2335 WABANSIA AVE.
CHICAGO, ILL.

CAT. NO.

PART NO. 15969

LEADS TO BE PLACED AS SHOWN

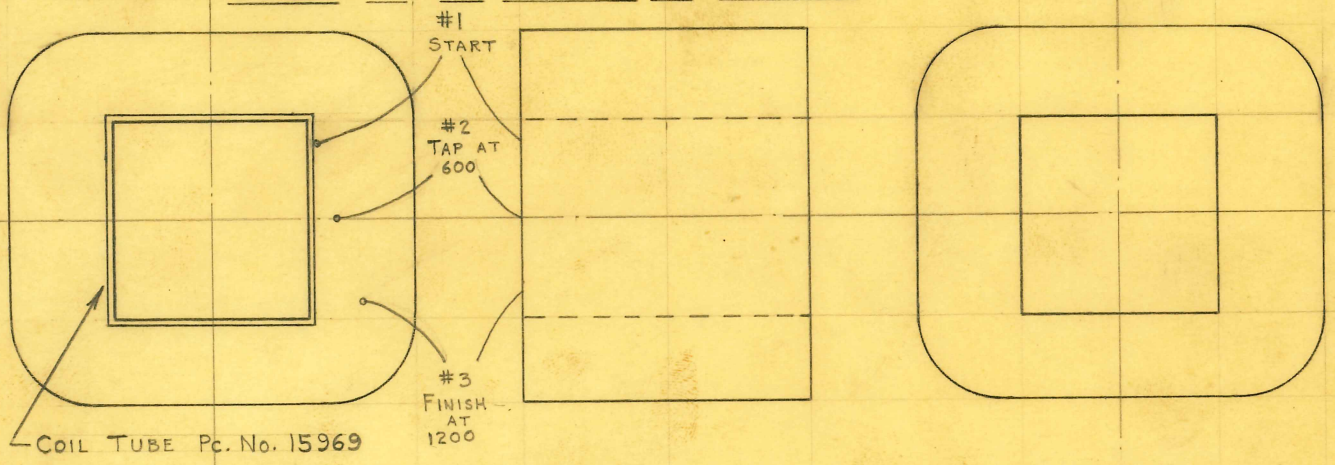

#30 ENAMELLED WIRE USED ON ALL WINDINGS MARGIN = $\frac{1}{8}$" APPROX.
LEADS : 3" LONG APPROX.

WINDING A :

START AT #1 ; WIND 12 LAYERS AT 100 TURNS PER LAYER
TAP AT 600 TURNS (#2); FINISH AT 1200 TURNS (#3)
WRAP 2 LAYERS OF .0015" GLASSINE PAPER 1$\frac{7}{16}$" WIDE BETWEEN LAYERS
THEN WRAP 2 LAYERS OF .005 FIBROID PAPER 1$\frac{7}{16}$" WIDE OVER WDG. A.
THEN TURN COIL ONE HALF TURN AND :

NOTE :
FINISHED COIL MUST NOT EXCEED 1$\frac{15}{16}$" IN THIS DIMENSION

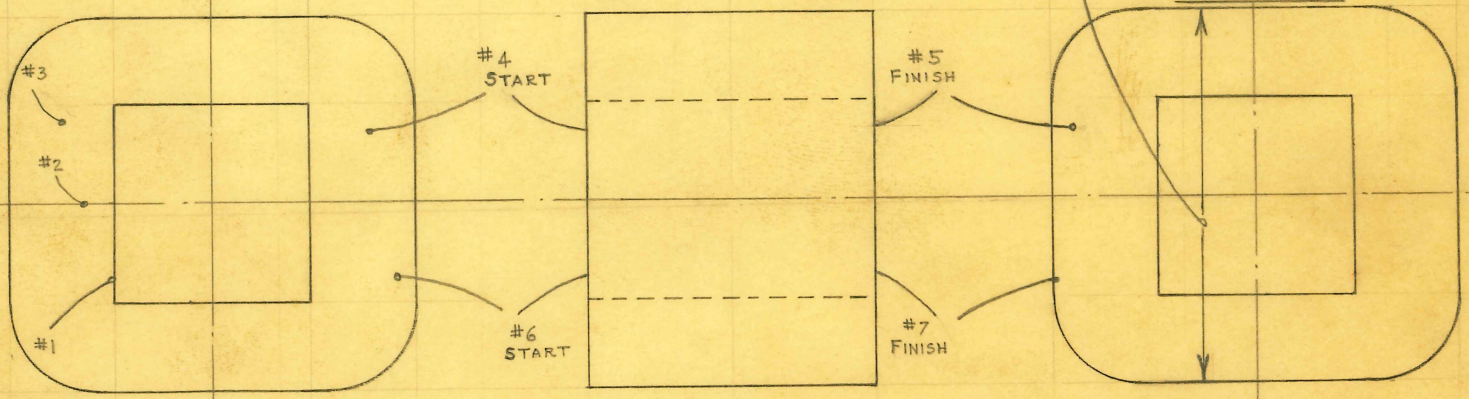

WINDING B:

START AT #4; WIND 5 LAYERS AT 100 TURNS PER LAYER; NO TAPS; FINISH AT 500 TURNS (#5)
WRAP 2 LAYERS OF .0015" GLASSINE PAPER 1$\frac{7}{16}$" WIDE BETWEEN LAYERS.
THEN WRAP 10 LAYERS OF .005" FIBROID PAPER 1$\frac{7}{16}$" WIDE OVER WINDING B

NEXT :

WINDING C :

START AT #6; WIND 3 LAYERS AT 100 TURNS PER LAYER; NO TAPS; FINISH AT 300 TURNS (#7)
WRAP 2 LAYERS OF .0015" GLASSINE PAPER 1$\frac{7}{16}$" WIDE BETWEEN LAYERS
THEN WRAP 2 LAYERS OF .005" FIBROID PAPER OVER FINISHED COIL

TERMINAL STRIP Pc. No. 15968G TO BE WRAPPED AROUND FINISHED COIL SO THAT EACH TERMINAL IS ADJACENT TO ITS LIKE NUMBERED LEAD.

SIZE		ISSUE 10-19-45	W.J.W.
KIND		CHANGED	
SHAPE		"	
FINISH		"	
TEMP.		"	
PATT.		"	

TITLE: OSCILLATING COIL WINDING

H. G. FISCHER & CO.
2335 WABANSIA AVE.
CHICAGO, ILL.

CAT. NO.

PART NO. 15970G

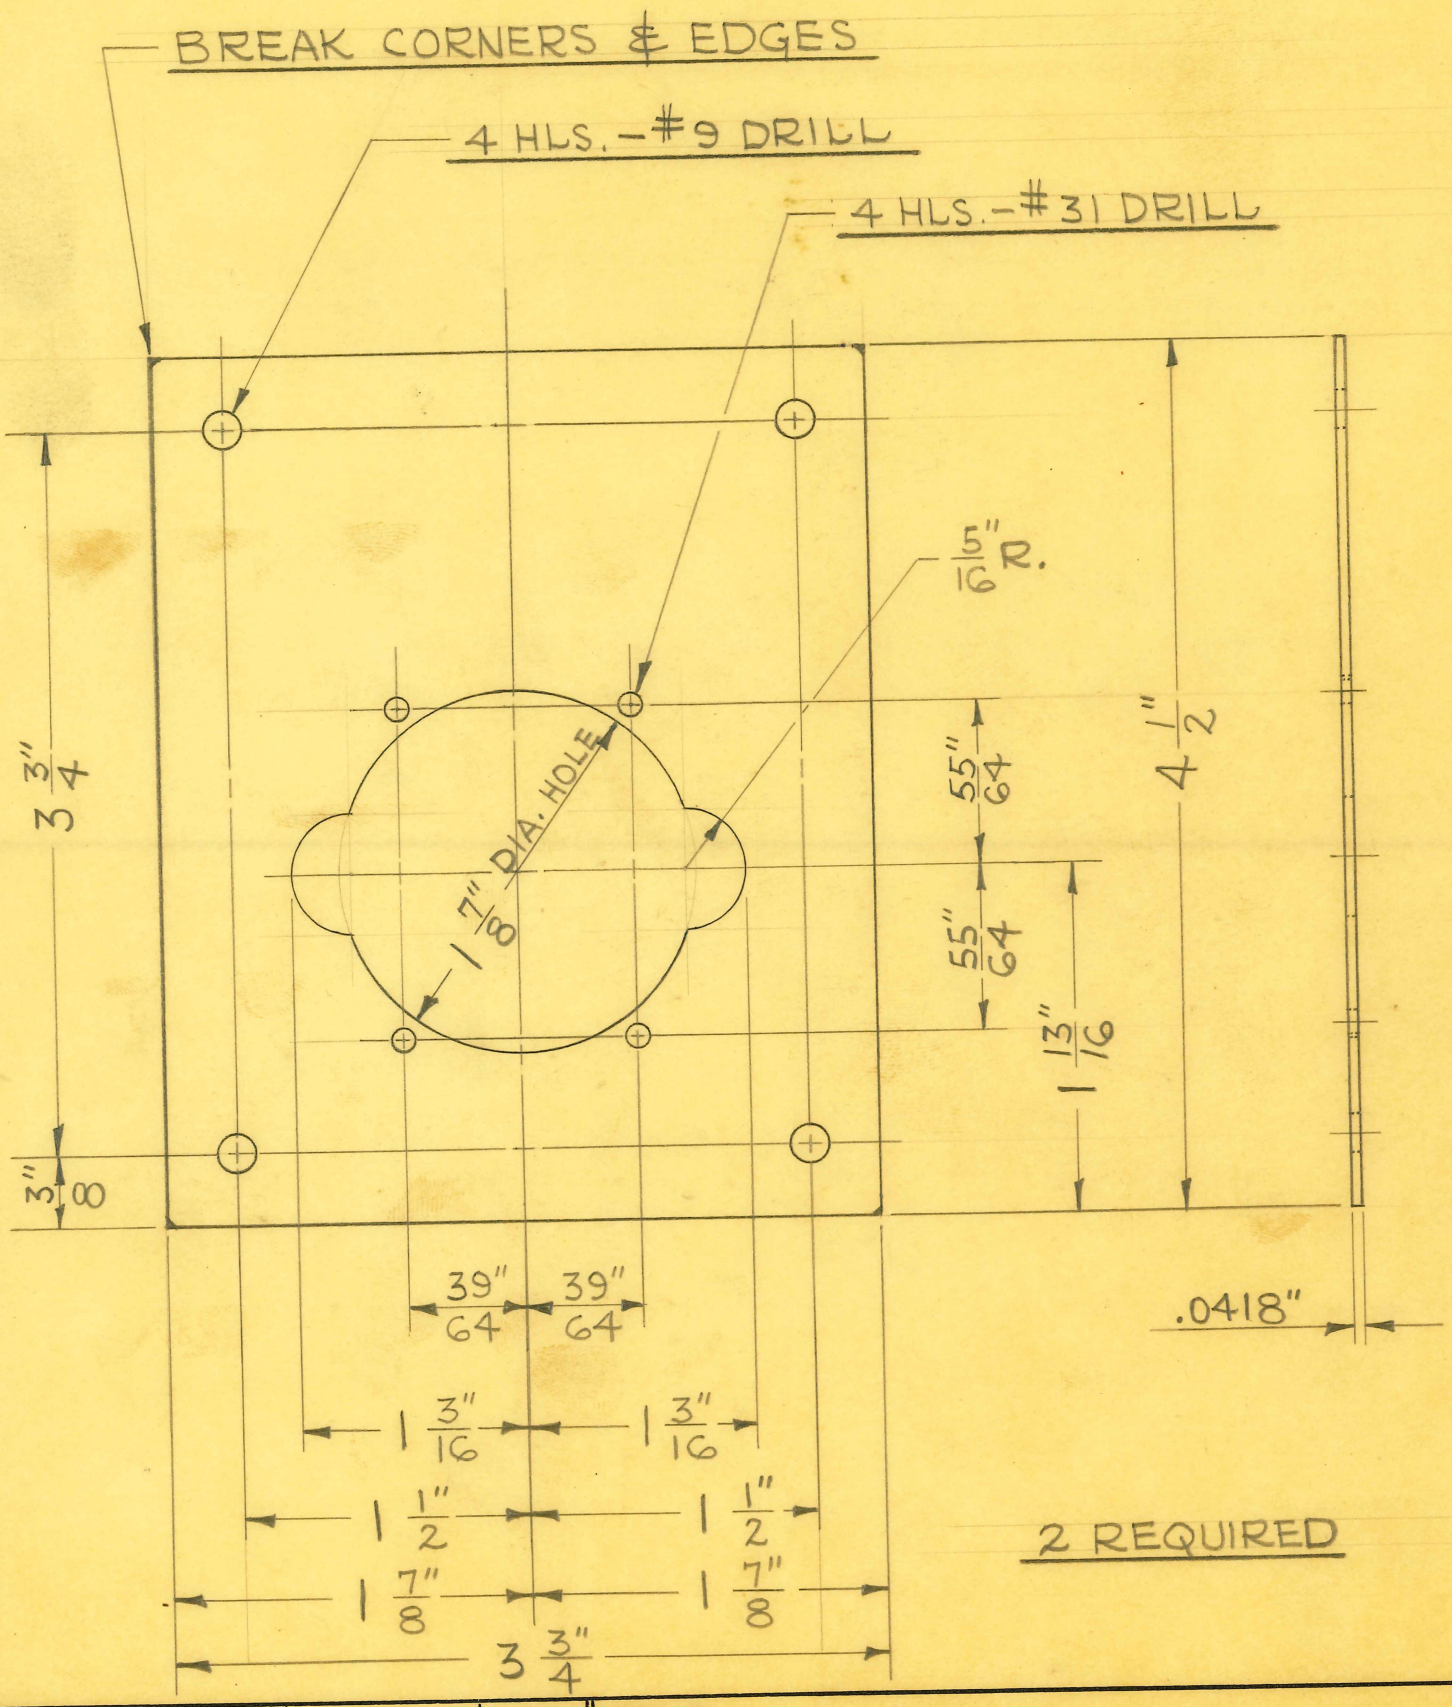

2 REQUIRED

SIZE	#19GA. (.0418")	ISSUE 1-16-46	J.V.W.
KIND	SHEET STEEL	CHANGED	
SHAPE		"	
FINISH	BLACK #81	"	
TEMP.		"	
PATT.		"	

TITLE: FISCHER MOD. "J" GALV. & CONT. CURR. GEN. POWER TRANSF. COVER PLATE

H. G. FISCHER & CO.
2335 WABANSIA AVE.
CHICAGO, ILL.

CAT. NO.

PART NO. 15971

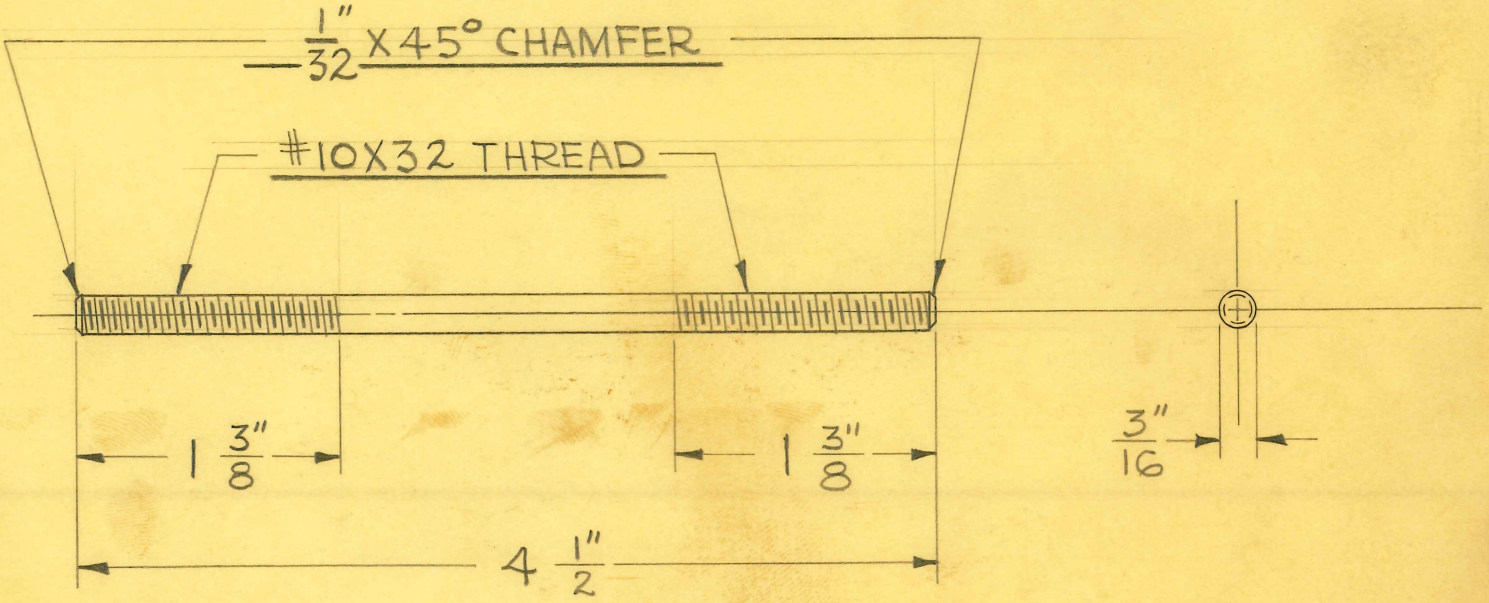

4 REQUIRED

SIZE	3/16" DIA.	ISSUE 1-16-46	J.V.W.
KIND	C.R. STEEL	CHANGED	
SHAPE		"	
FINISH	CAD. #23	"	
TEMP.		"	
PATT.		"	

TITLE: FISCHER MOD. "J" GALV. & CONT. CURR. GEN. POWER TRANSFORMER - CLAMP STUD

H. G. FISCHER & CO.
2335 WABANSIA AVE.
CHICAGO, ILL.

CAT. NO.

PART NO. 15972

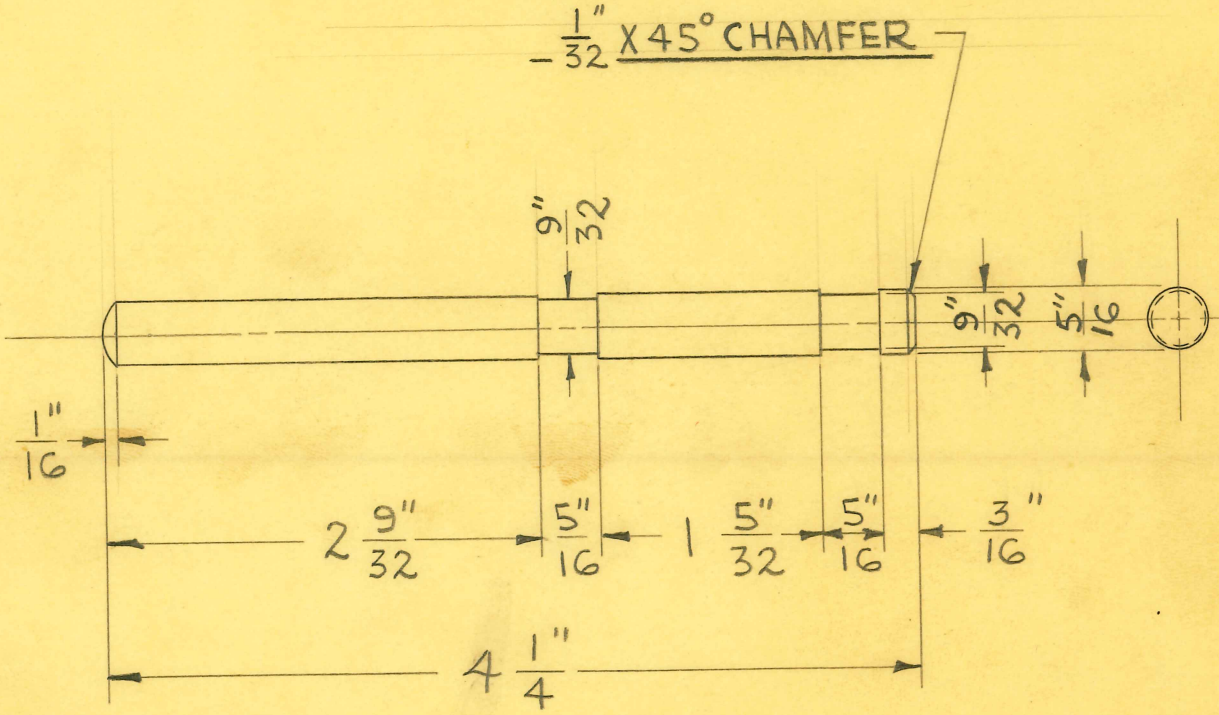

1 REQUIRED

SIZE	5/16" DIA.	ISSUE 1-31-46	J.V.W.
KIND	C.R. STEEL	CHANGED	
SHAPE		"	
FINISH		"	
TEMP.		"	
PATT.		"	

TITLE: FISCHER MOD. "J" GALV. & CONT. CURR. GEN. VARIABLE SURGE REGULATING ROD

H. G. FISCHER & CO.
2335 WABANSIA AVE.
CHICAGO, ILL.

CAT. NO.

PART NO. 15984

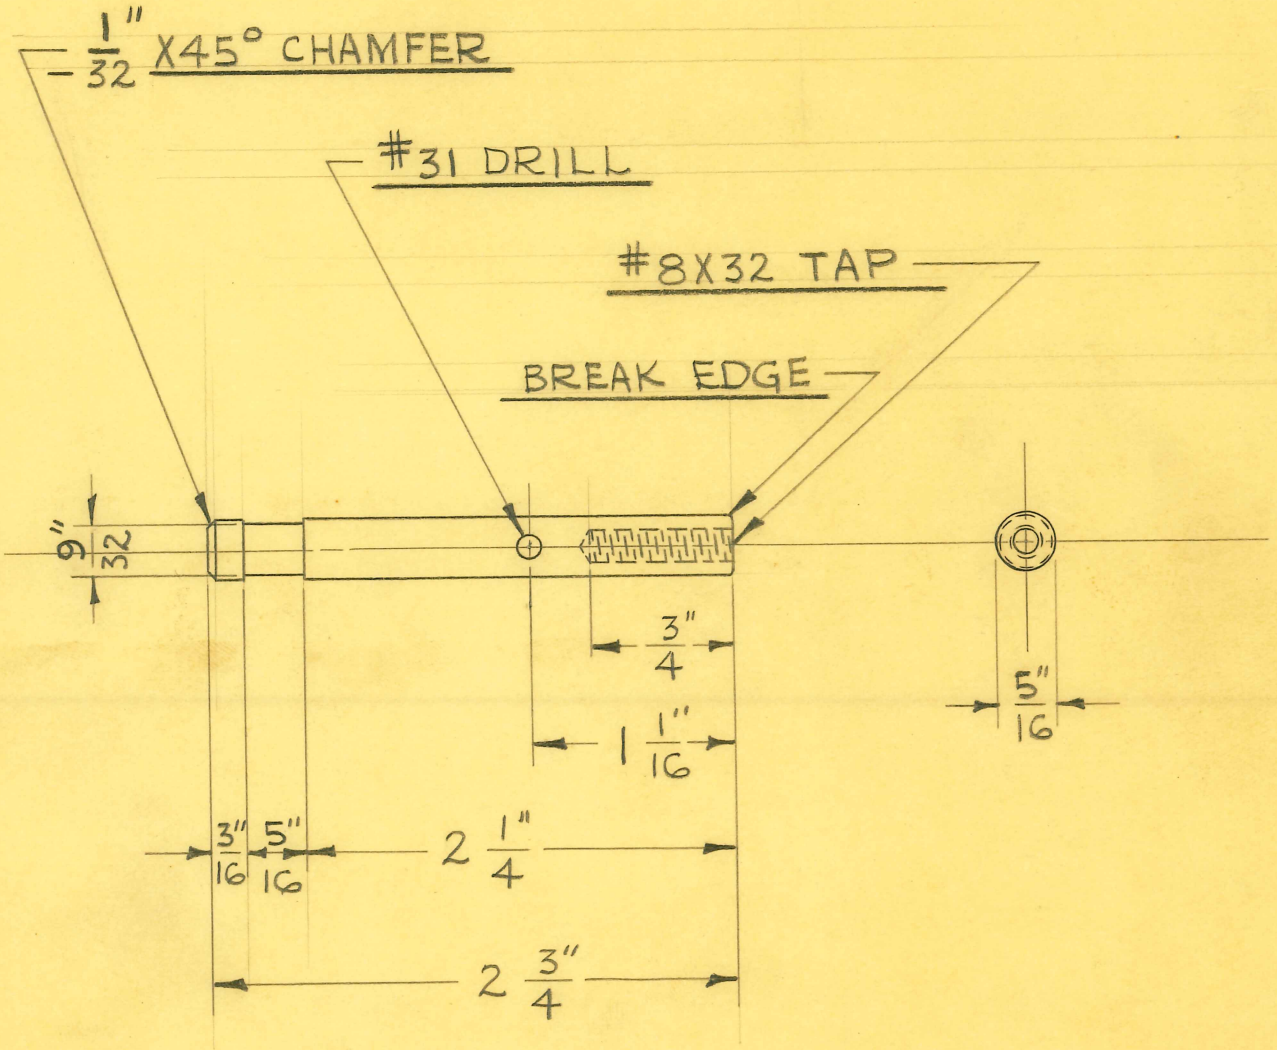

1 REQUIRED

SIZE	5/16" DIA.	ISSUE	1-31-46	J.V.W.
KIND	C.R. STEEL	CHANGED		
SHAPE		"		
FINISH		"		
TEMP.		"		
PATT.		"		

TITLE:
FISCHER MOD. "J" GALV. & CONT. CURR. GEN. VARIABLE SURGE REGULATING ROD EXTENSION

H. G. FISCHER & CO.
2335 WABANSIA AVE.
CHICAGO, ILL.

CAT. NO.

PART NO. 15985

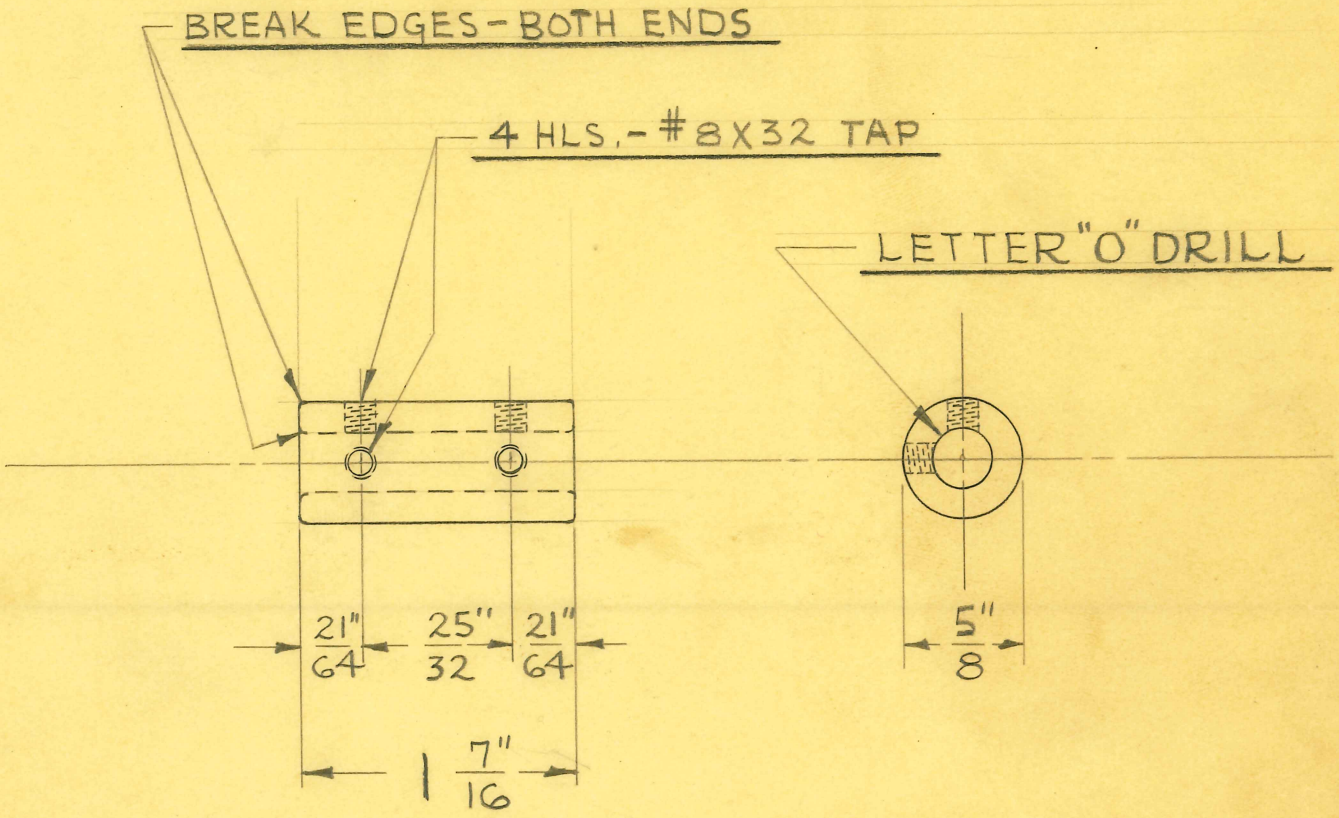

1 REQUIRED

SIZE	5/8" DIA.	ISSUE 1-31-46	J.V.W.
KIND	C.R. STEEL	CHANGED	
SHAPE		"	
FINISH		"	
TEMP.		"	
PATT.		"	

TITLE:
FISCHER MOD. "J" GALV. & CONT. CURR. GEN. VARIABLE SURGE REGULATING ROD COUPLING

H. G. FISCHER & CO.
2335 WABANSIA AVE.
CHICAGO, ILL.

CAT. NO.

PART NO. 15986

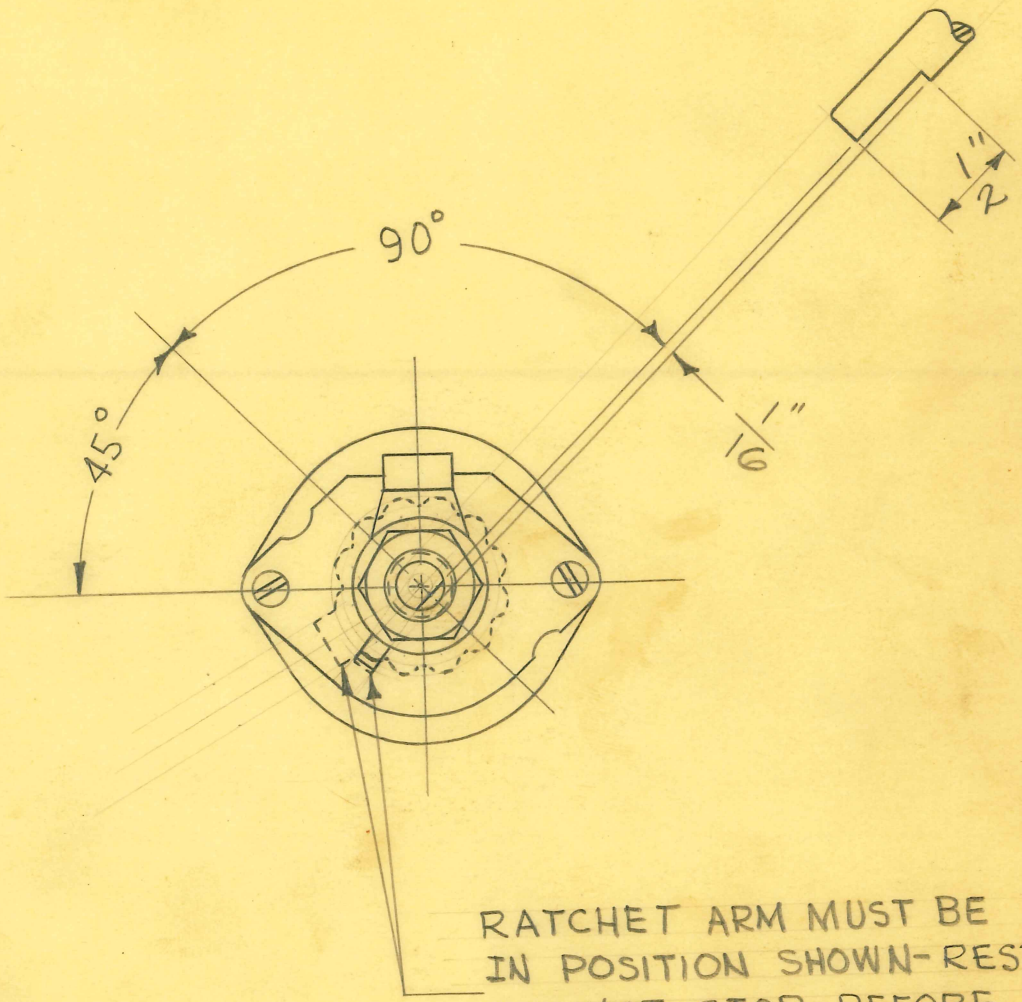

RATCHET ARM MUST BE IN POSITION SHOWN-RESTING AGAINST STOP-BEFORE MILLING FLAT ON SHAFT

FROM #16001G

SIZE		ISSUE 10-18-46	J.V.W.
KIND		CHANGED	
SHAPE		"	
FINISH		"	
TEMP.		"	
PATT.		"	

TITLE: FISCHER MOD. "J" GALV. & CONT. CURR. GEN. – 4 POINT SWITCH

H. G. FISCHER & CO.
2335 WABANSIA AVE.
CHICAGO, ILL.

CAT. NO.

PART NO. 16001GF

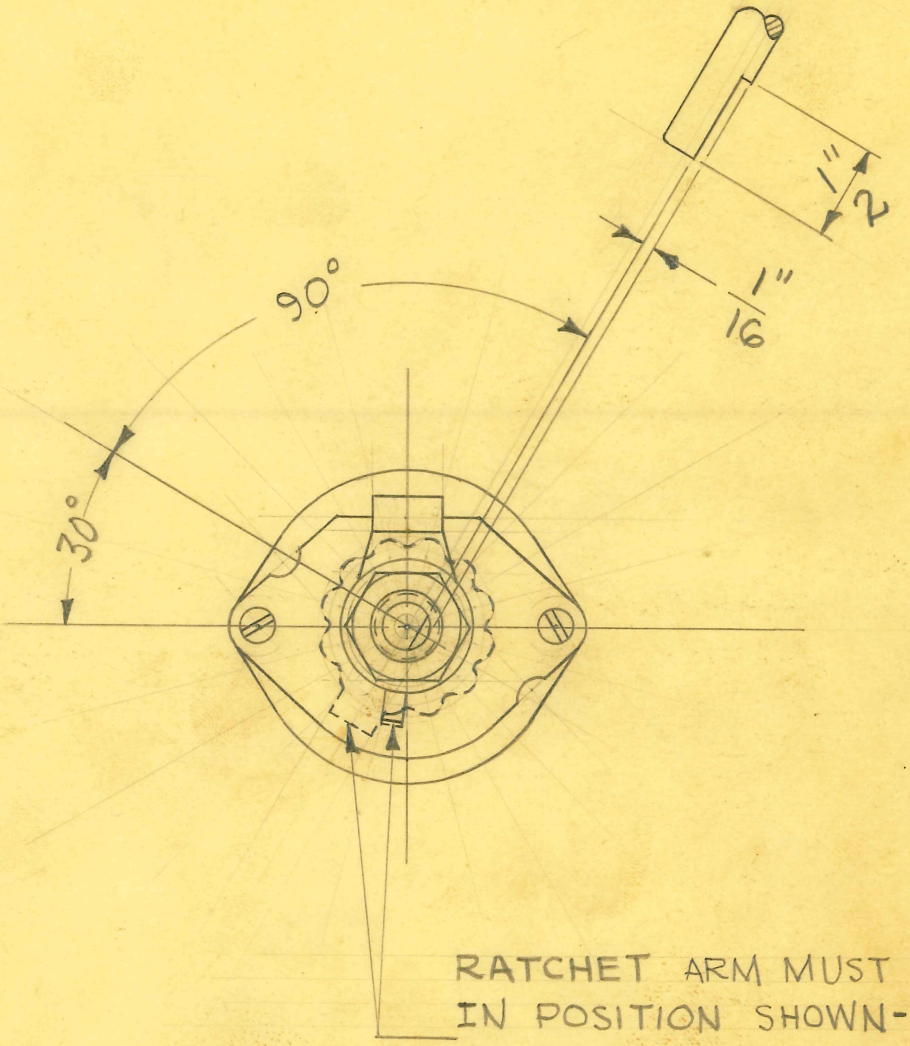

RATCHET ARM MUST BE IN POSITION SHOWN-RESTING AGAINST STOP-BEFORE MILLING FLAT ON SHAFT

FROM #16002G

SIZE		ISSUE 10-18-46	J.V.W.
KIND		CHANGED	
SHAPE		"	
FINISH		"	
TEMP.		"	
PATT.		"	

TITLE: FISCHER MOD. "J" GALV. & CONT. CURR. GEN. — 5 POINT SWITCH

H. G. FISCHER & CO.
2335 WABANSIA AVE.
CHICAGO, ILL.

CAT. NO.

PART NO. 16002GF

TITLE

MOD. "J" GALV. & CONT. CURR. GEN.
1/4 MFD OSC. CONDENSER

H. G. FISCHER & CO.
FRANKLIN PARK, ILLINOIS

DATE 3-17-50 | DR. BY W.J. | CH'K'D. J.V.W.

PART NO. 16003A

REVISION	DATE	BY

PATTERN | FINISH | SCALE FULL

TOOLS | MATERIAL OIL-MITE 1/4 MFD-1000V.D.C WITH BRACKETS

DIMENSIONS
FRACTIONAL ± .015
DECIMAL ± .005
ANGULAR ± ½°
UNLESS OTHERWISE SPECIFIED

1 REQUIRED

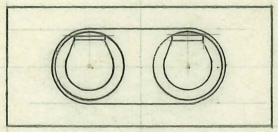

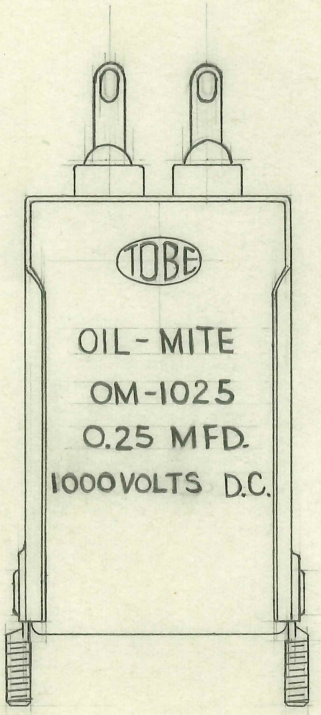

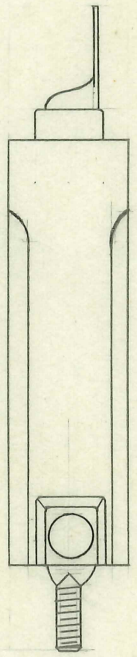

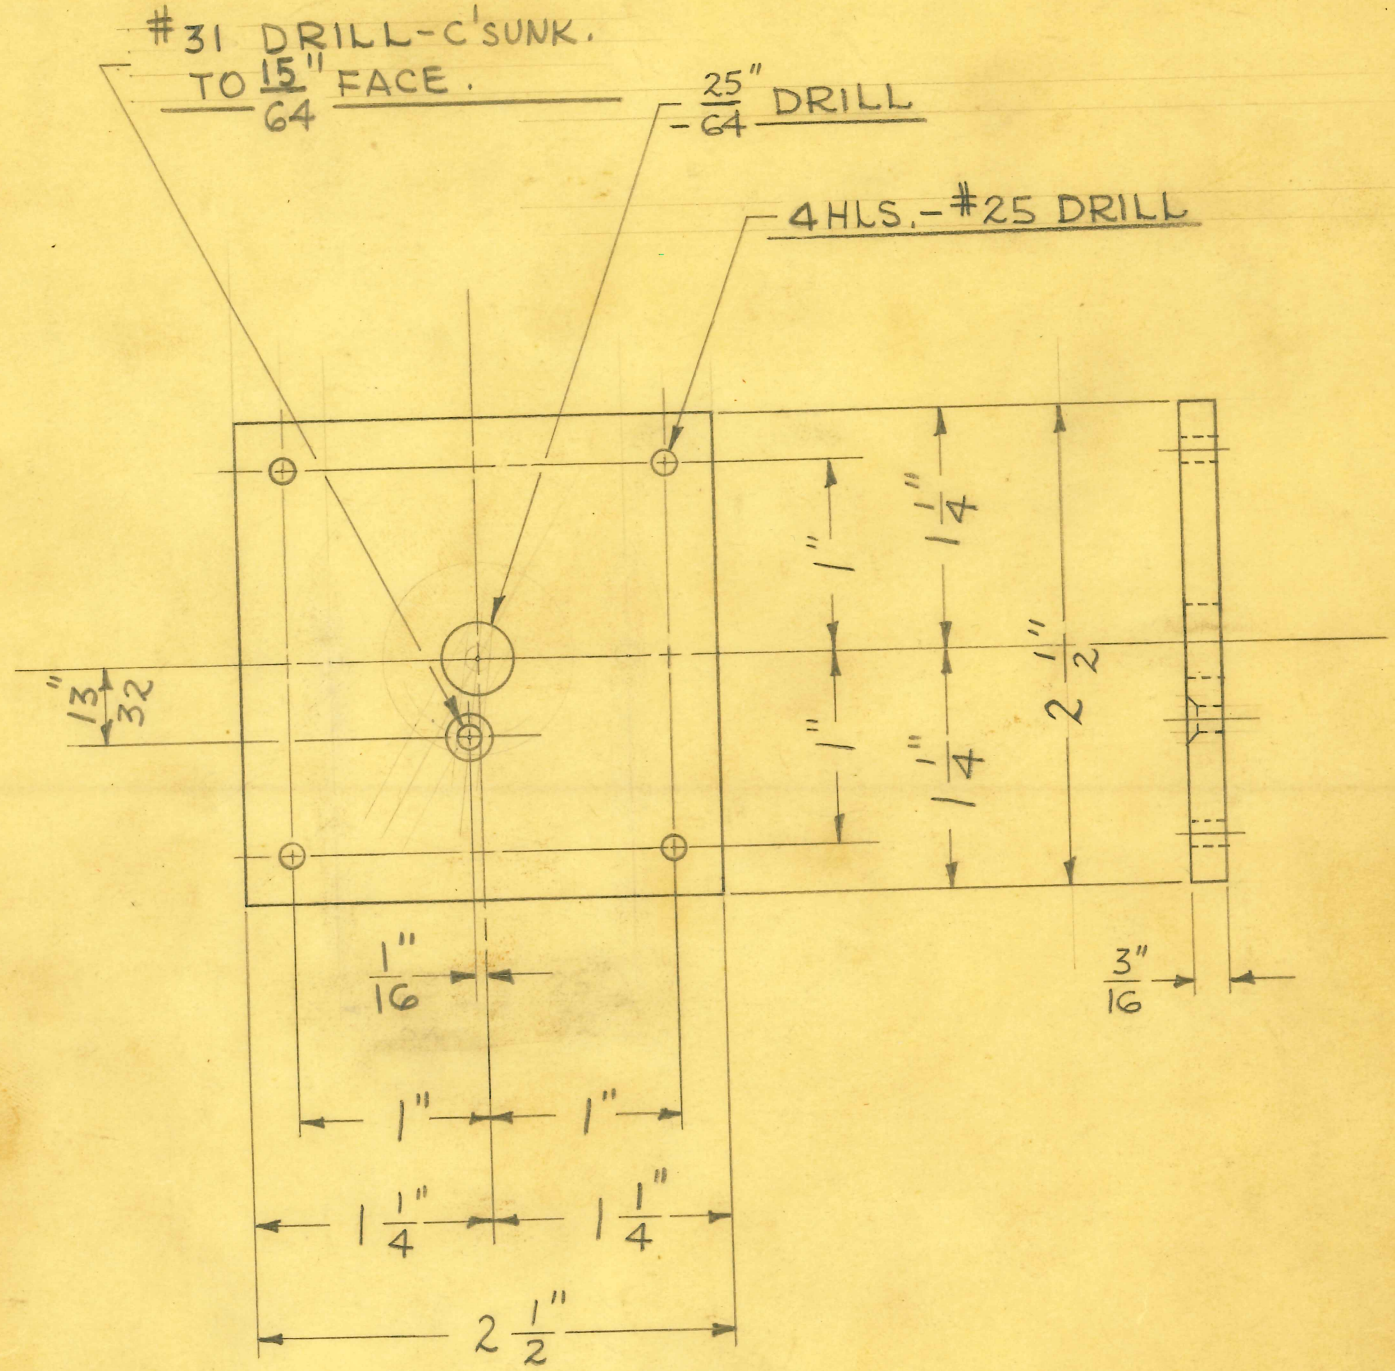

1 REQUIRED

SIZE	3/16" SHEET	ISSUE 4-16-46	J.V.W.
KIND	BLK. BAKELITE	CHANGED	
SHAPE		"	
FINISH		"	
TEMP.		"	
PATT.		"	

TITLE: FISCHER MOD. "J" GALV. & CONT. CURR. GEN. 5 POINT SWITCH BASE

H. G. FISCHER & CO.
2335 WABANSIA AVE.
CHICAGO, ILL.

CAT. NO.

PART NO. 16004

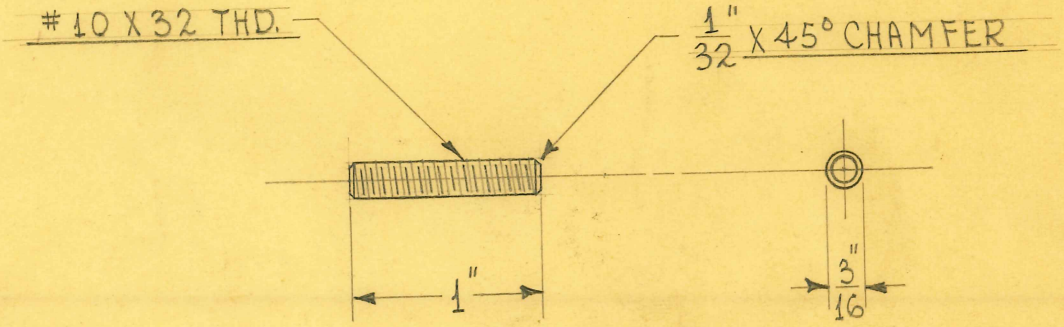

6 REQUIRED

SIZE	3/16" DIAM.	ISSUE 3-15-45	HE.
KIND	C.R. STEEL	CHANGED	
SHAPE	ROD	"	
FINISH		"	
TEMP.		"	

TITLE: #10 X 32 X 1" STEEL STUD

H. G. FISCHER & CO.
2335 WABANSIA AVE.
CHICAGO, ILL.

CAT. NO.

PART NO. 16006

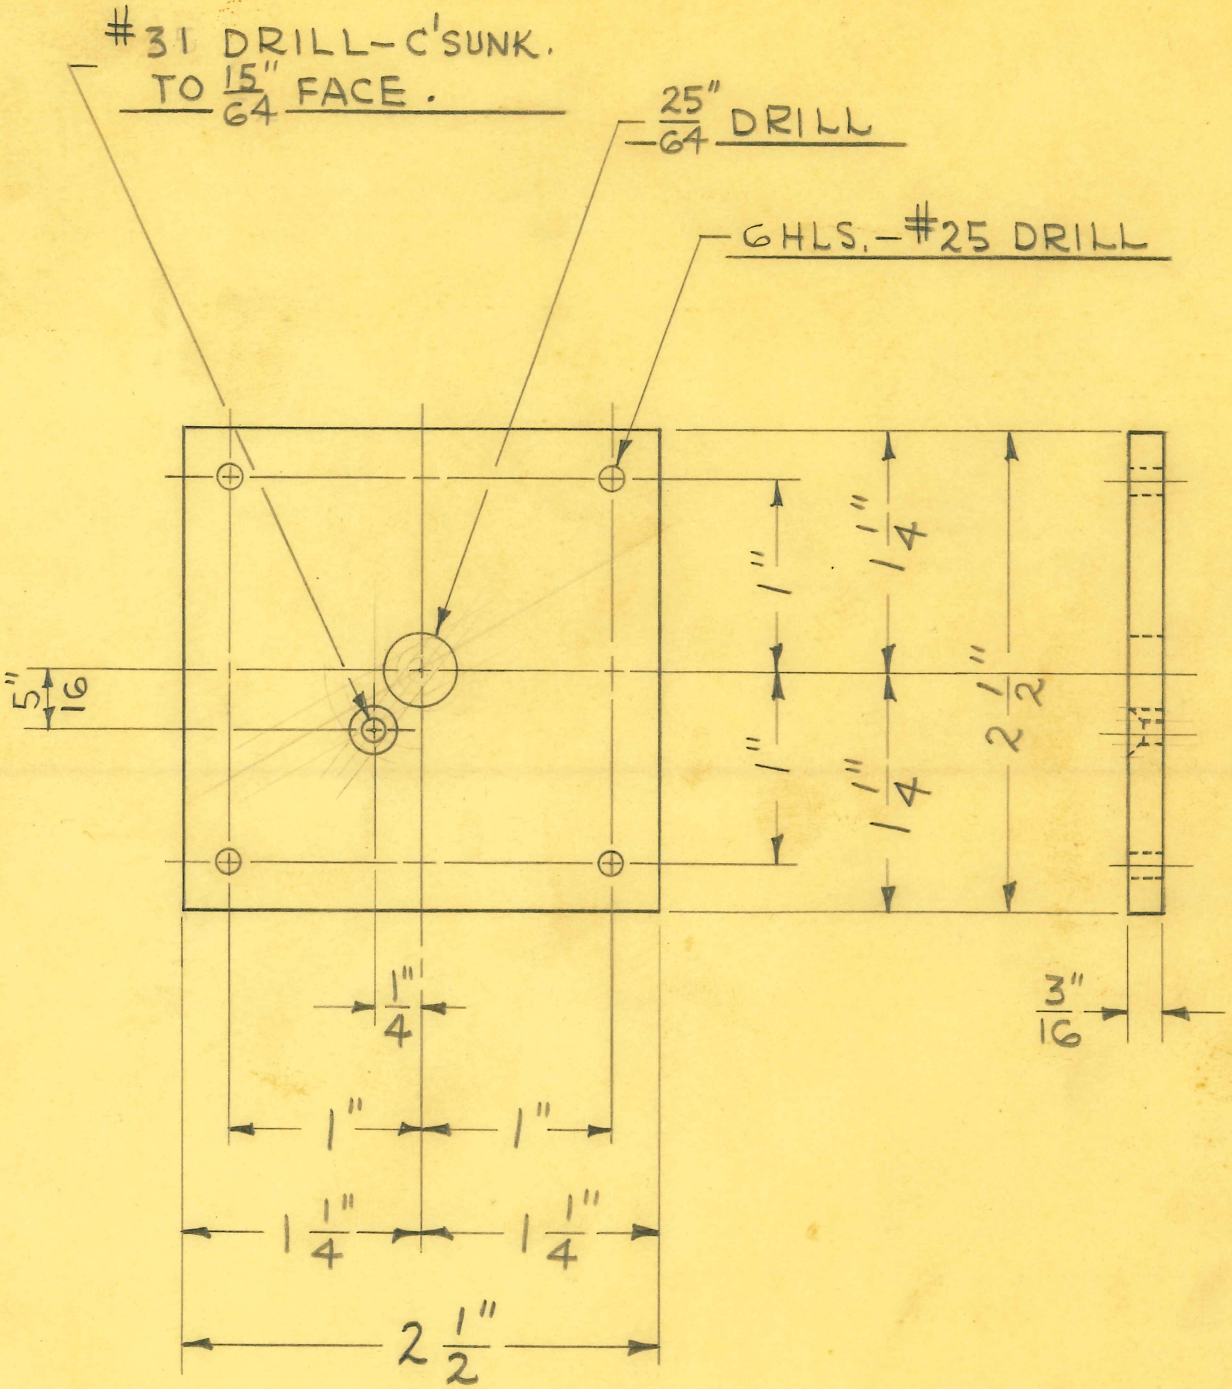

1 REQUIRED

SIZE	3/16" SHEET	ISSUE 10-17-46	J.V.W.
KIND	BLK. BAKELITE	CHANGED	
SHAPE		"	
FINISH		"	
TEMP.		"	
PATT.		"	

TITLE:
FISCHER MOD. "J" GALV. & CONT. CURR. GEN.
4 POINT SWITCH BASE

H. G. FISCHER & CO.
2335 WABANSIA AVE.
CHICAGO, ILL.

CAT. NO.

PART NO. 16009

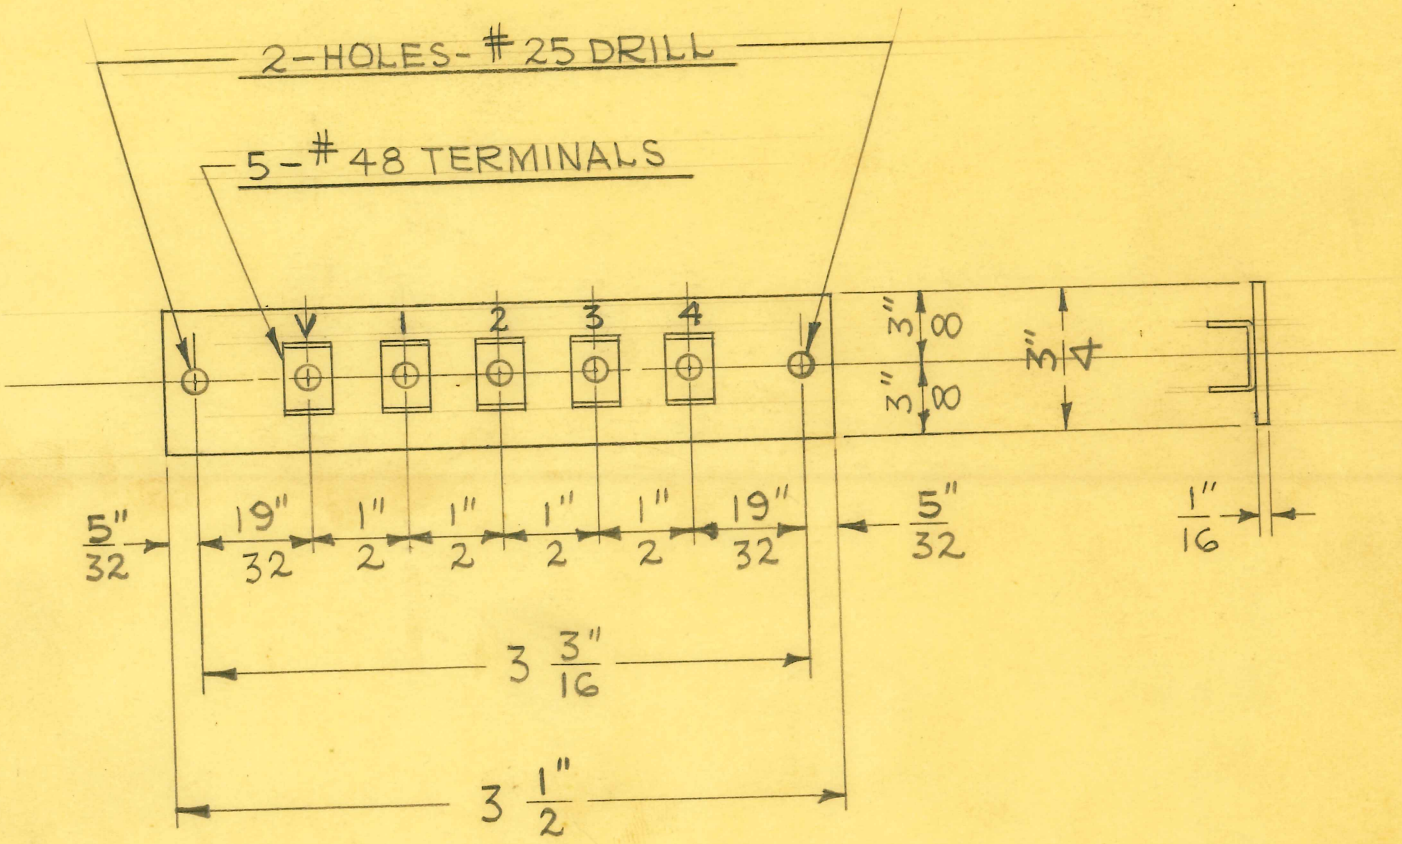

1 REQUIRED

SIZE	1/16"	ISSUE 4-18-46	J.V.W.	TITLE: FISCHER MOD. "J" GALV. & CONT. CURR. GEN. FARADIC COIL TERMINAL STRIP
KIND	BLACK FIBRE	CHANGED		
SHAPE		"		
FINISH		"		
TEMP.		"		
PATT.		"		

H. G. FISCHER & CO.
2335 WABANSIA AVE.
CHICAGO, ILL.

CAT. NO.

PART NO. 16011

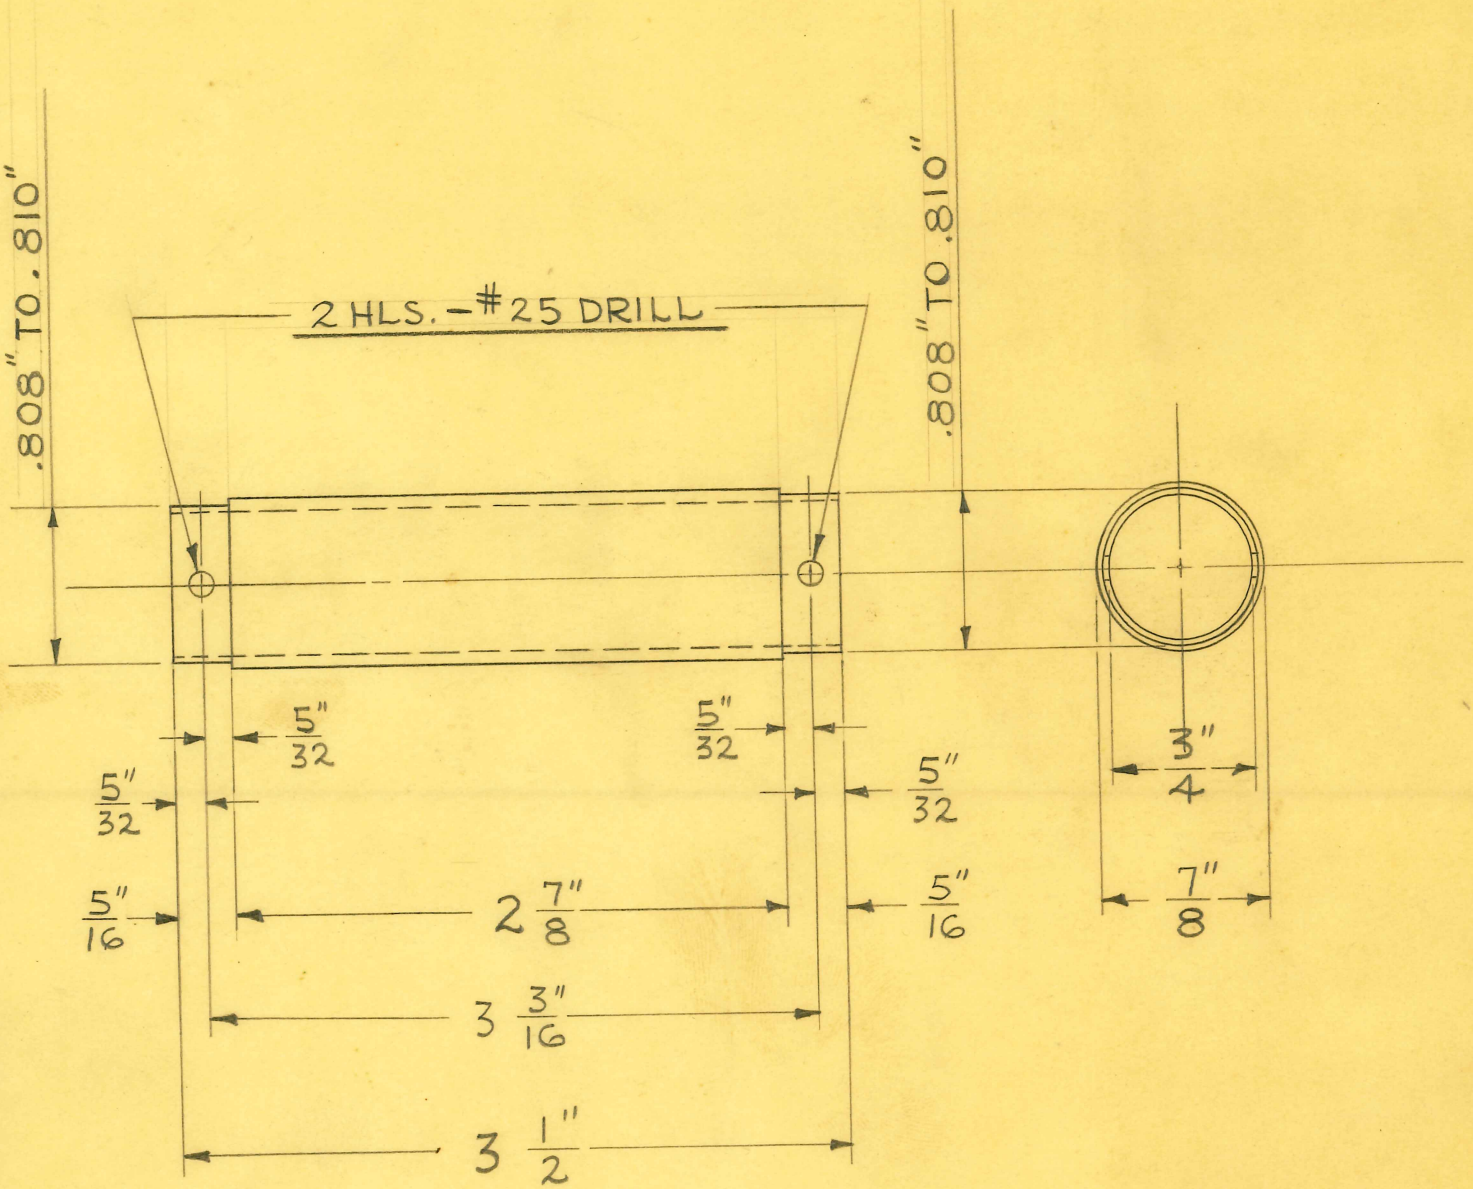

1 REQUIRED

SIZE	7/8" O.D. X 3/4" I.D.	ISSUE 5-13-46	J.V.W.
KIND	BLK. BAKELITE	CHANGED	
SHAPE	TUBING	"	
FINISH		"	
TEMP.		"	
PATT.		"	

TITLE: FISCHER MOD. "J" GALV. & CONT. CURR. GEN. FARADIC COIL TUBE

H. G. FISCHER & CO.
2338 WABANSIA AVE.
CHICAGO, ILL.

CAT. NO.

PART NO. 16012

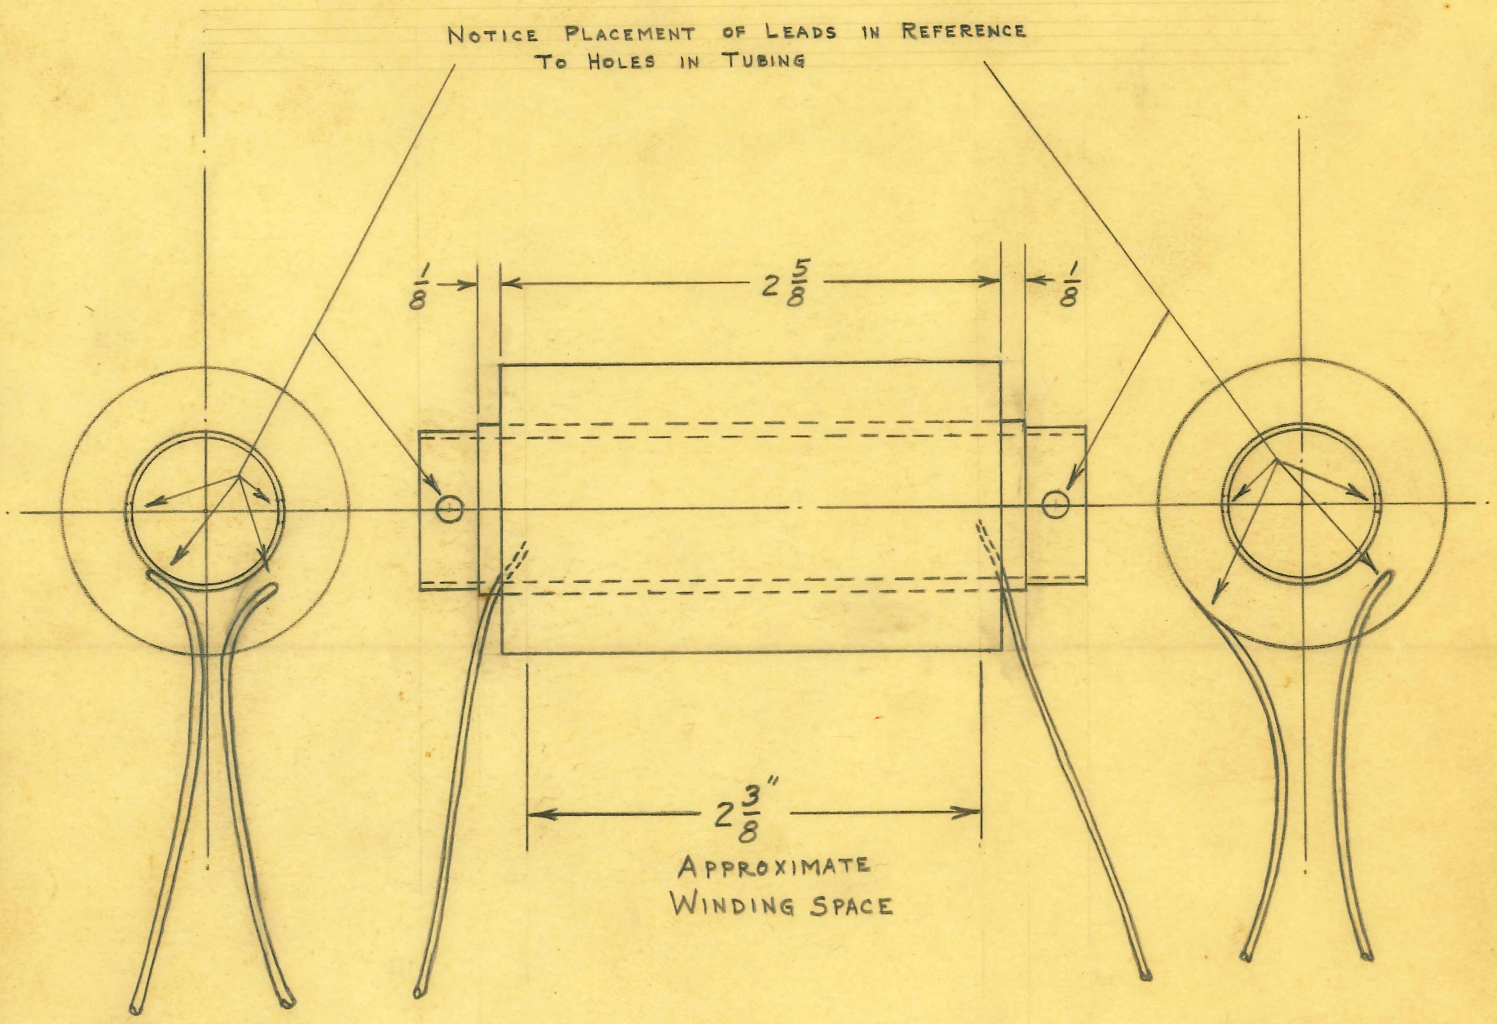

PRIMARY : 3,000 T. #32 E. WIRE ~ 12 LAYERS @ 250 TURNS PER LAYER
1 LAYER OF .0015" GLASSINE PAPER 2 5/8" WIDE BETWEEN LAYERS

WIND 4 LAYERS OF .005 FIBROID PAPER 2 5/8" WIDE OVER PRIMARY

SECONDARY : 3,000 T. #32 E. WIRE ~ 12 LAYERS @ 250 TURNS PER LAYER
1 LAYER OF .0015" GLASSINE PAPER 2 5/8" WIDE BETWEEN LAYERS

WIND WRAPPER OVER SECONDARY

LEADS : #20 'FREEZE' WIRE

SIZE		ISSUE 9-12-46	W.J.W.
KIND		CHANGED	
SHAPE		"	
FINISH		"	
TEMP.		"	
PATT.		"	

TITLE: MODEL J FARADIC COIL WINDING

H. G. FISCHER & CO.
2335 WABANSIA AVE.
CHICAGO, ILL.

CAT. NO.

PART NO. 16013 G

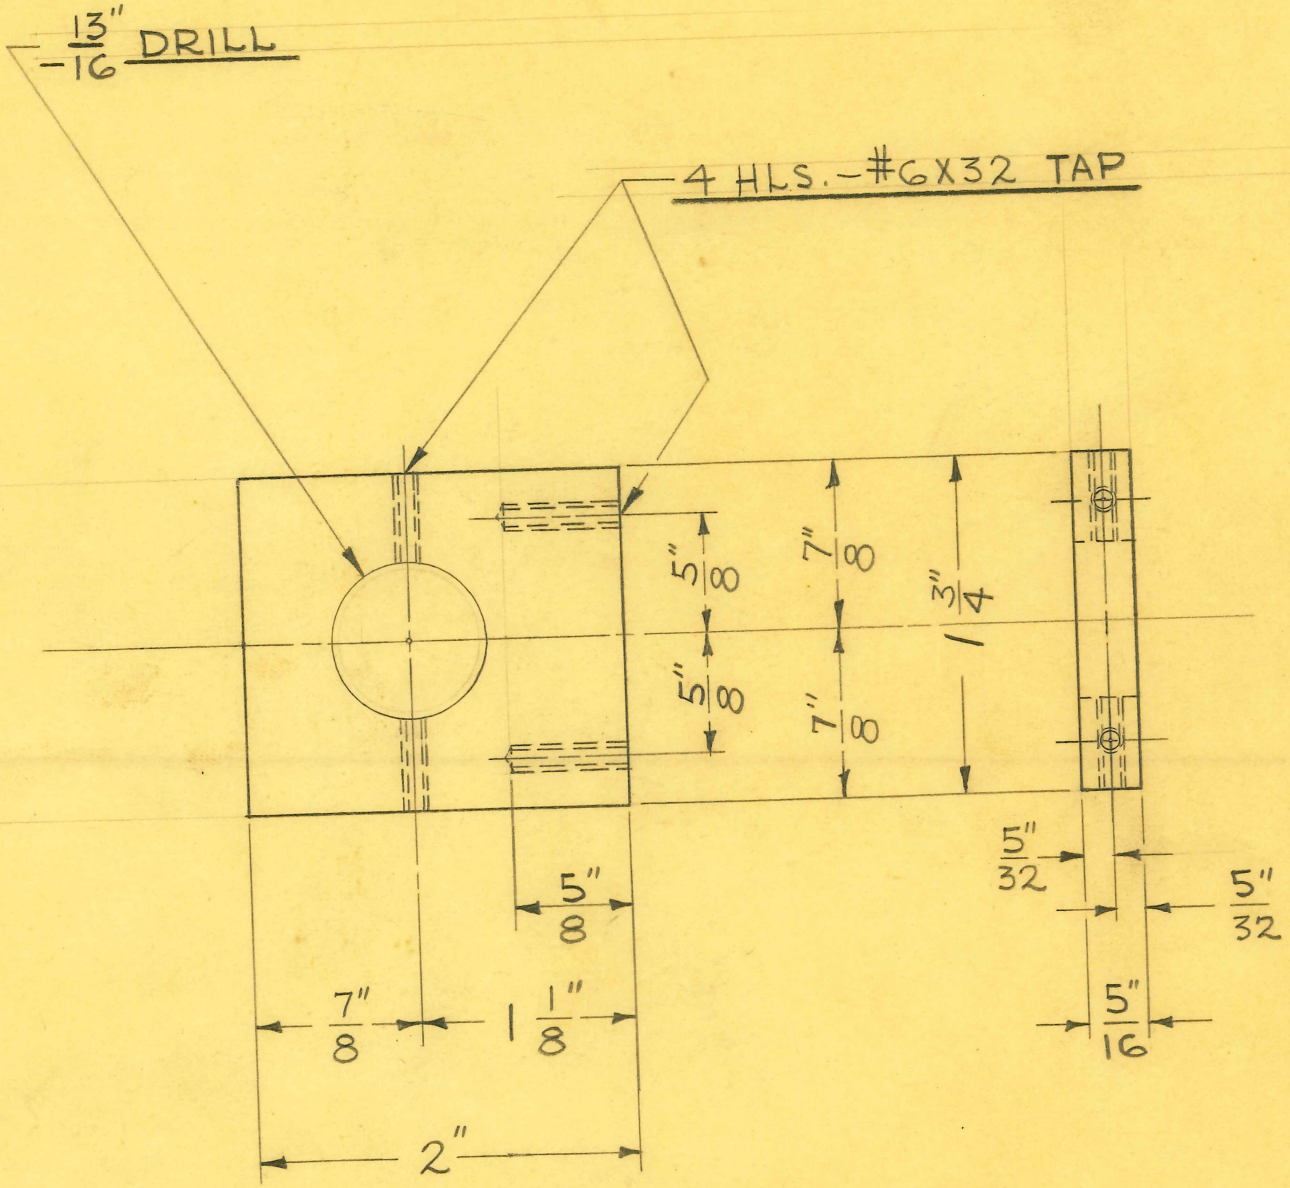

1 REQUIRED

SIZE	5/16" SHEET	ISSUE 5-13-46	J.V.W.	TITLE: FISCHER MOD. "J" GALV. & CONT. CURR. GEN. FARADIC COIL SUPPORT
KIND	BLK. BAKELITE	CHANGED		
SHAPE		"		
FINISH		"		
TEMP.		"		
PATT.		"		

H. G. FISCHER & CO.
2335 WABANSIA AVE.
CHICAGO, ILL.

CAT. NO.

PART NO. 16014

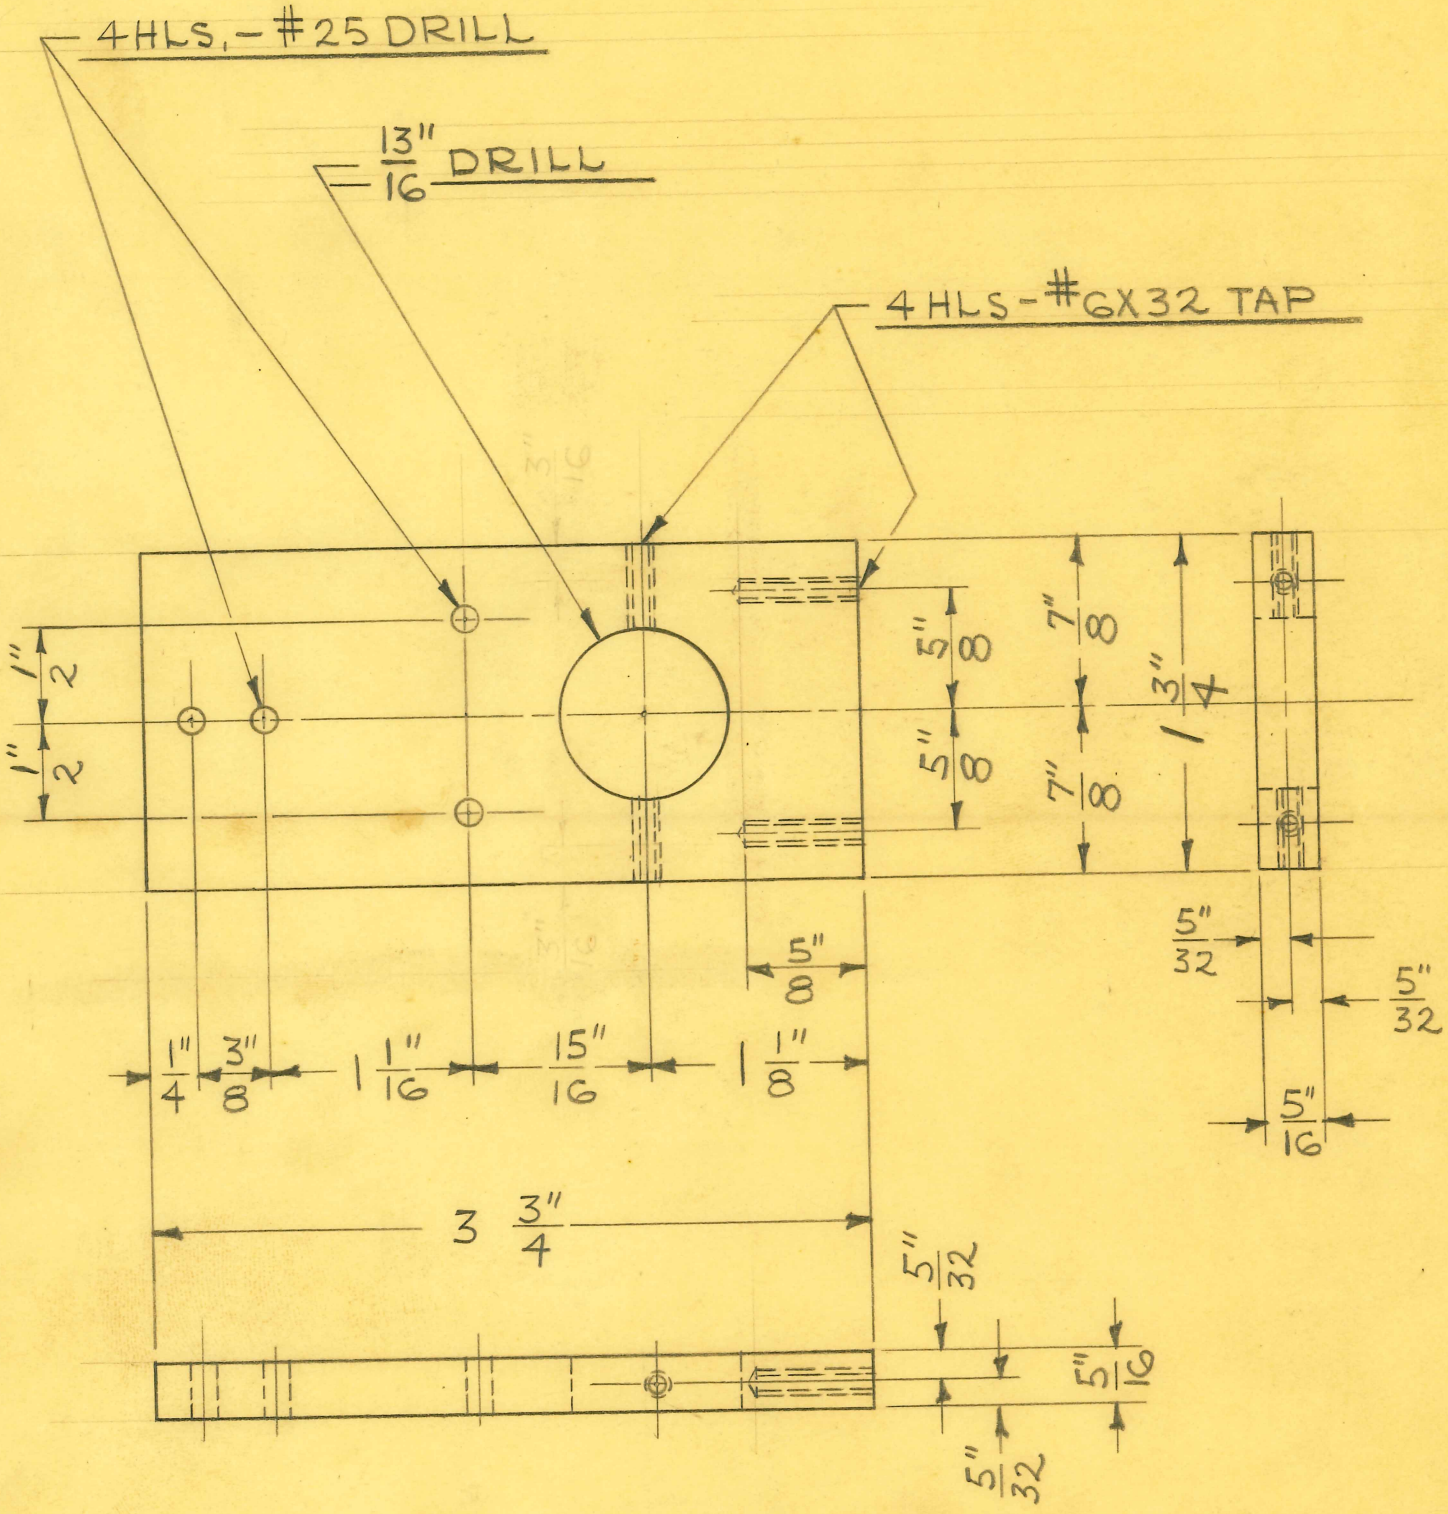

1 REQUIRED

SIZE	5/16" SHEET	ISSUE 4-19-46	J.V.W.
KIND	BLK. BAKELITE	CHANGED	
SHAPE		"	
FINISH		"	
TEMP.		"	
PATT.		"	

TITLE: FISCHER MOD. "J" GALV. & CONT. CURR. GEN. FARADIC COIL VIBRATOR SUPPORT

H. G. FISCHER & CO.
2335 WABANSIA AVE.
CHICAGO. ILL.

CAT. NO.

PART NO. 16015

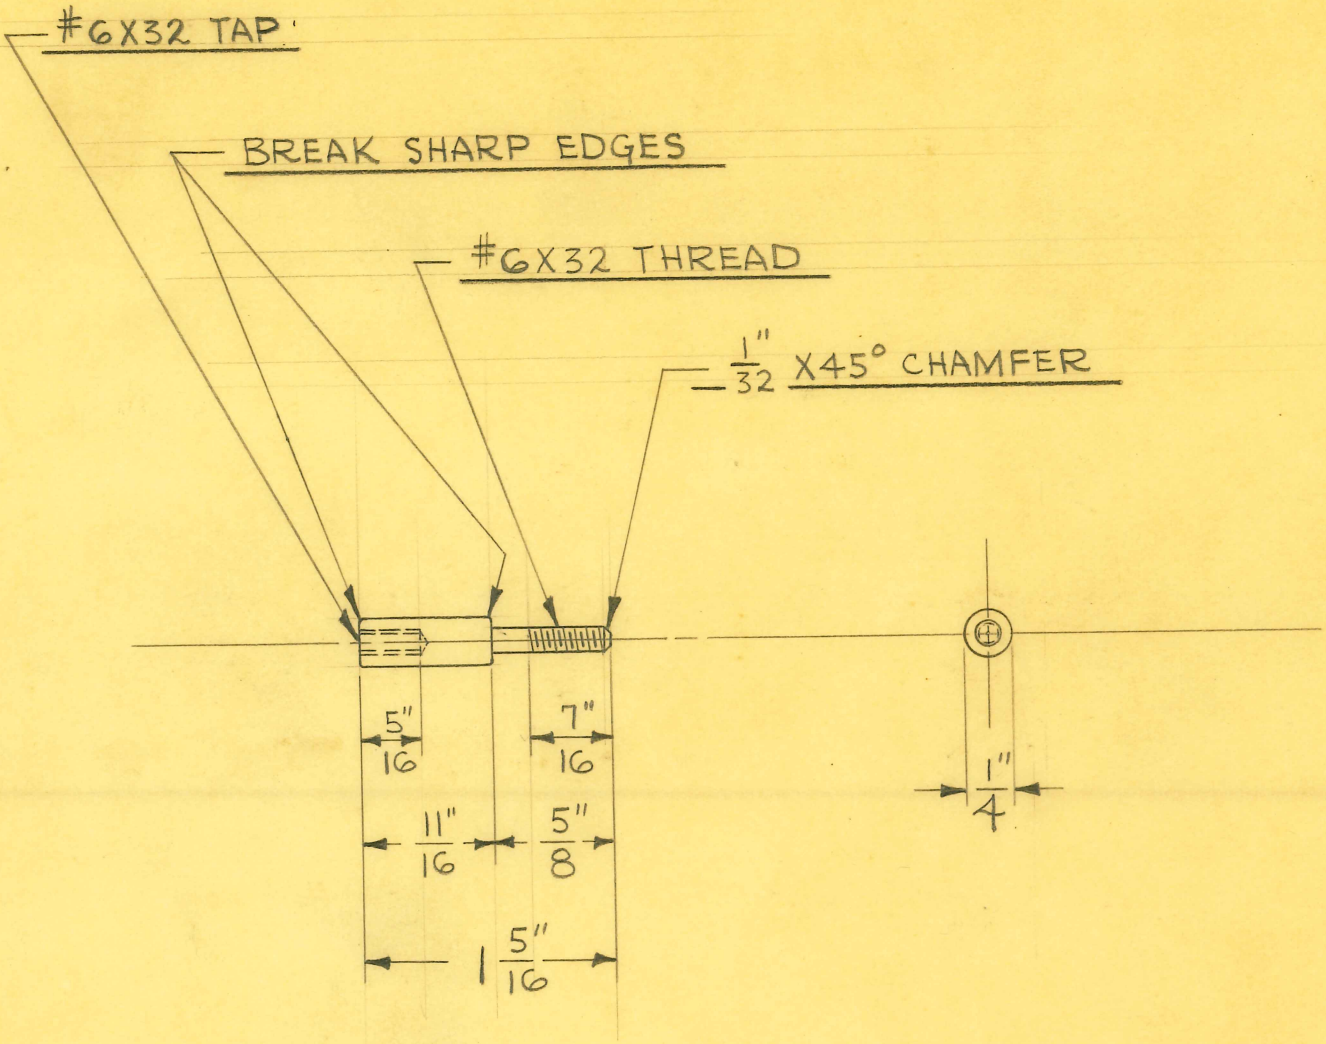

2 REQUIRED

SIZE	1/4" DIA.	ISSUE 5-14-46	J.V.W.
KIND	BRASS ROD	CHANGED	
SHAPE		"	
FINISH		"	
TEMP.		"	
PATT.		"	

TITLE: FISCHER MOD. "J" GALV. & CONT. CURR. GEN. FARADIC COIL ADJ. CONTACT SPACER

H. G. FISCHER & CO.
2335 WABANSIA AVE.
CHICAGO, ILL.

CAT. NO.

PART NO. 16016

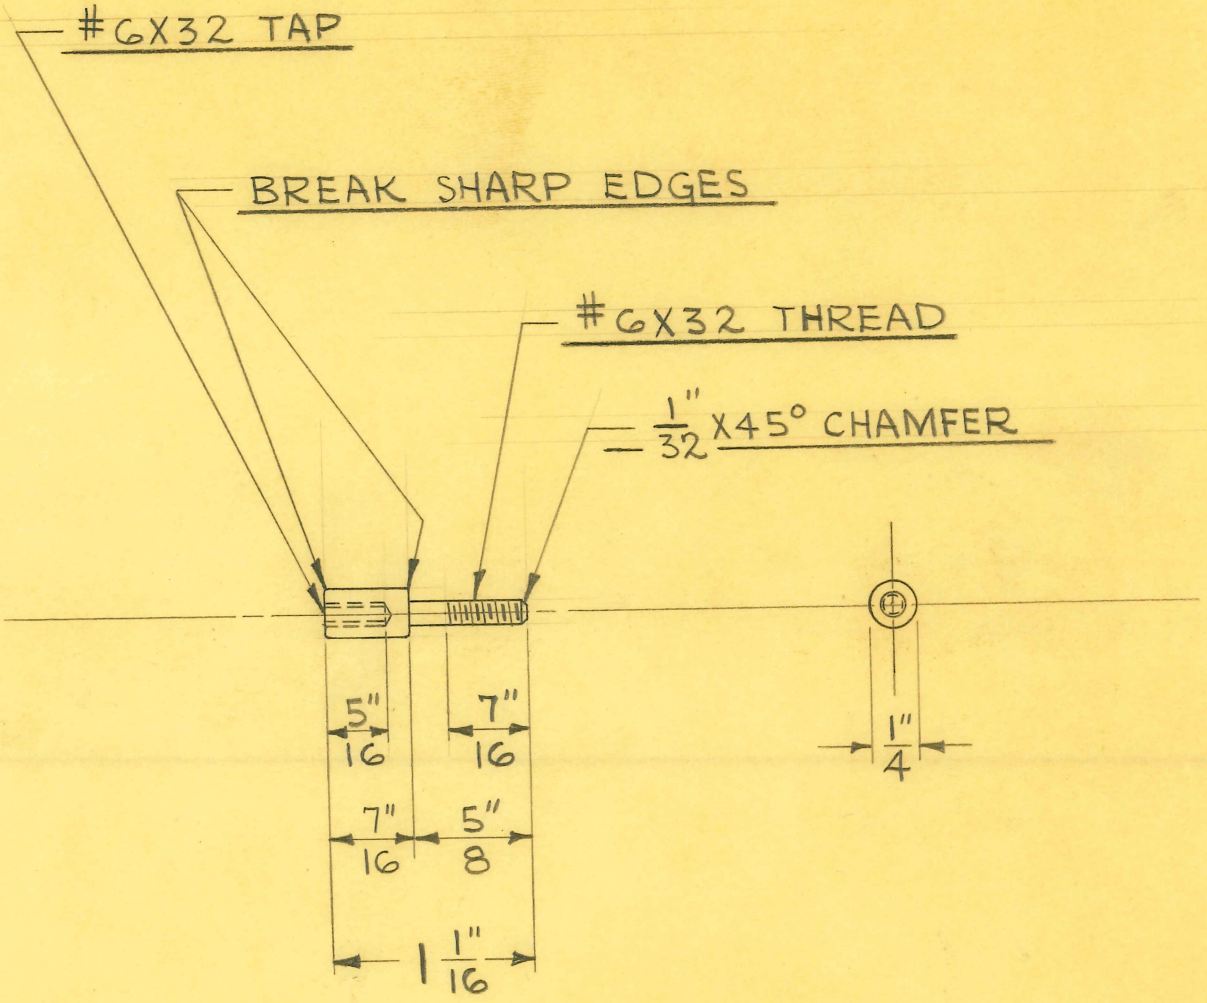

2 REQUIRED

SIZE	1/4" DIA.	ISSUE 5-13-46	J.V.W.
KIND	BRASS ROD	CHANGED	
SHAPE		"	
FINISH		"	
TEMP.		"	
PATT.		"	

TITLE: FISCHER MOD. "J" GALV. & CONT. CURR. GEN. FARADIC COIL VIBRATOR SPACER

H. G. FISCHER & CO.
2335 WABANSIA AVE.
CHICAGO, ILL.

CAT. NO.

PART NO. 16017

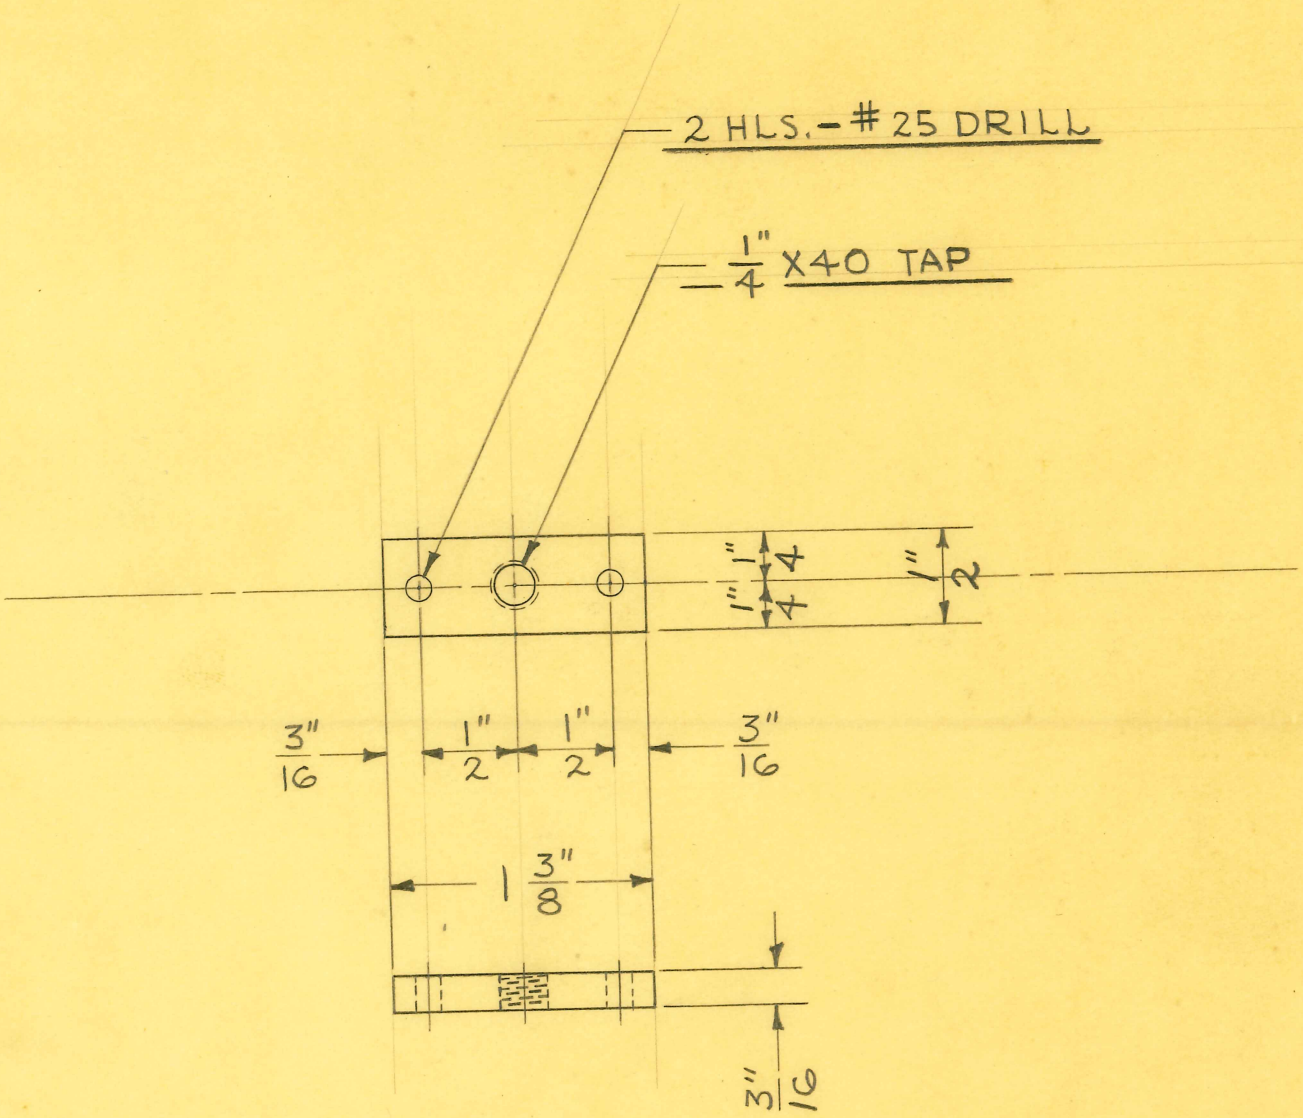

1 REQUIRED

SIZE	3/16" X 1/2"	ISSUE 5-14-46	J.N.W.
KIND	BRASS BAR	CHANGED	
SHAPE		"	
FINISH		"	
TEMP.		"	
PATT.		"	

TITLE: FISCHER MOD. "J" GALV. & CONT. CURR. GEN. FARADIC COIL ADJ. CONTACT SUPPORT

H. G. FISCHER & CO.
2335 WABANSIA AVE.
CHICAGO, ILL.

CAT. NO.

PART NO. 16018

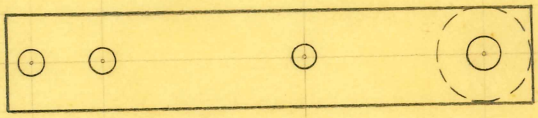

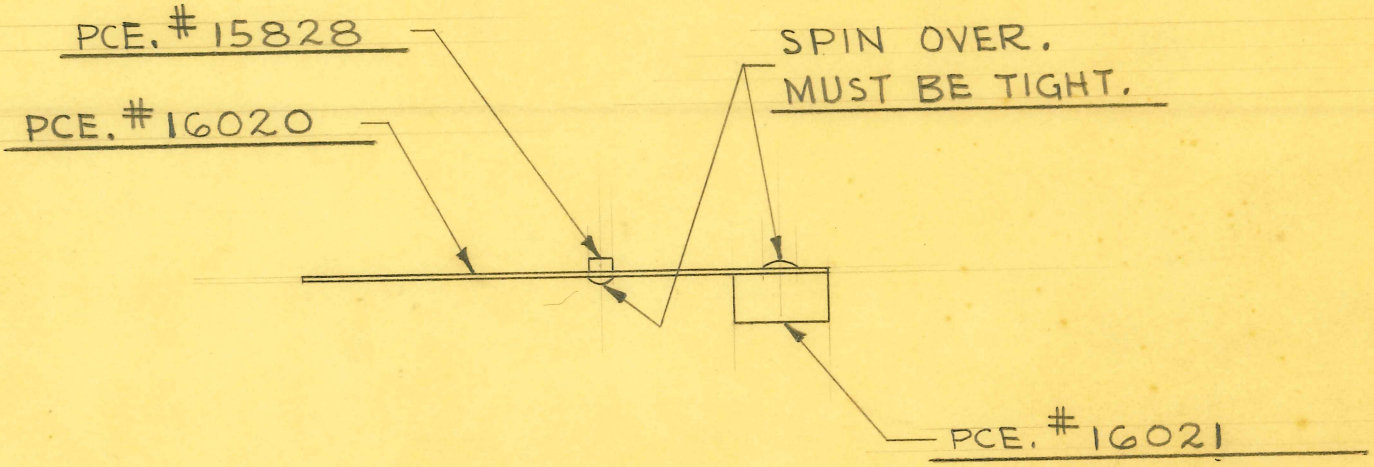

1 REQUIRED

SIZE		ISSUE 5-13-46	J.V.W.
KIND		CHANGED	
SHAPE		"	
FINISH		"	
TEMP.		"	
PATT.		"	

TITLE: FISCHER MOD. "J" GALV. & CONT. CURR. GEN. FARADIC COIL VIBRATOR ASSEMBLY

H. G. FISCHER & CO.
2335 WABANSIA AVE.
CHICAGO, ILL.

CAT. NO.

PART NO. 16019G

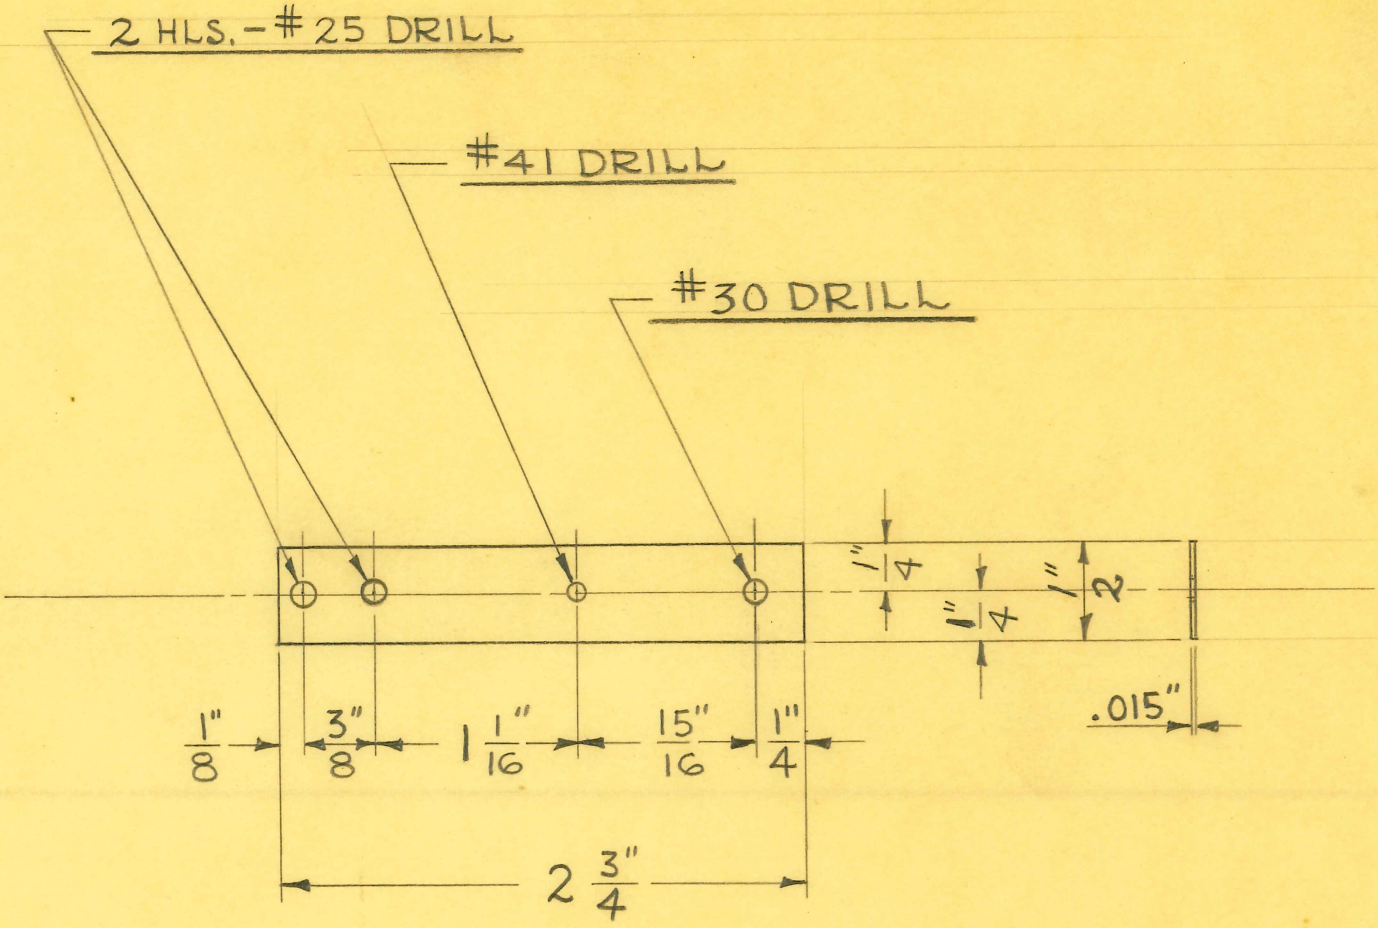

1 REQUIRED

SIZE	.015" SHEET	ISSUE 5-13-46	J.V.W.
KIND	PHOS. BRONZE	CHANGED	
SHAPE		"	
FINISH		"	
TEMP.		"	
PATT.		"	

TITLE:
FISCHER MOD. "J" GALV. & CONT. CURR. GEN. FARADIC COIL VIBRATOR

H. G. FISCHER & CO.
2335 WABANSIA AVE.
CHICAGO, ILL.

CAT. NO.

PART NO. 16020

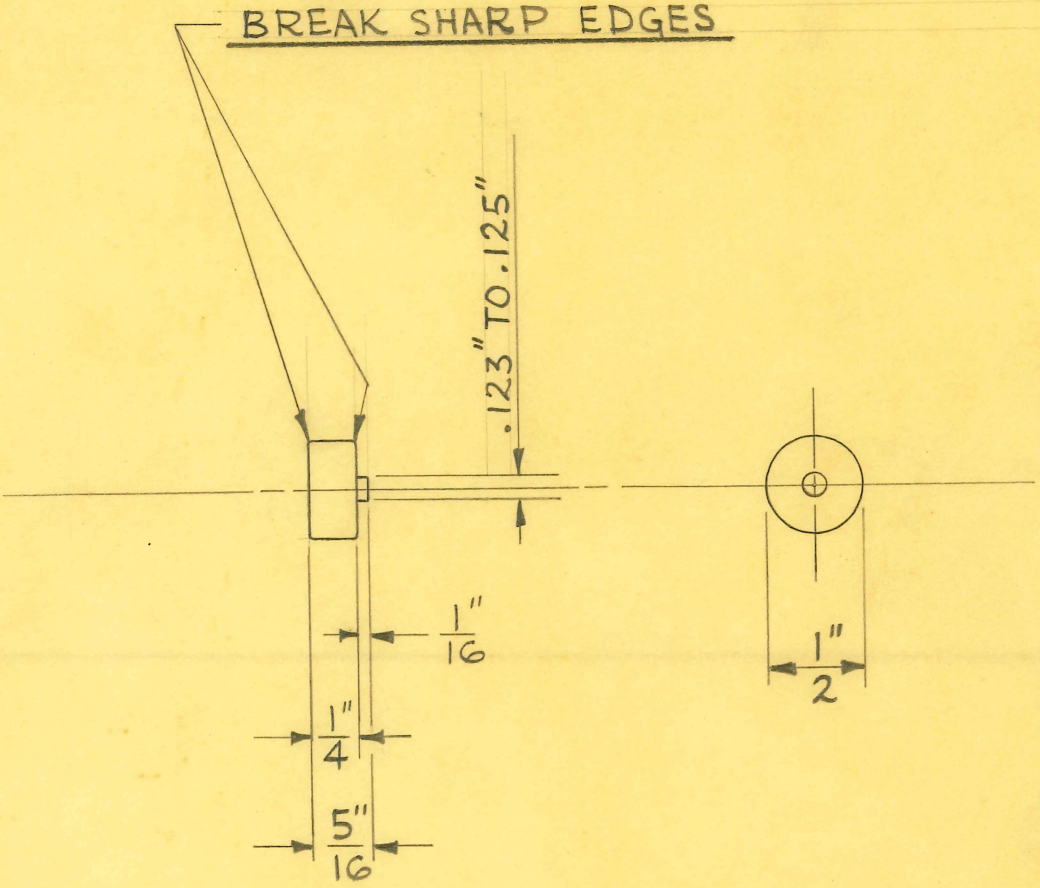

1 REQUIRED

SIZE	1/2" DIA.	ISSUE 5-13-46	J.V.W.
KIND	C.R. STEEL	CHANGED	
SHAPE		"	
FINISH		"	
TEMP.		"	
PATT.		"	

TITLE: FISCHER MOD. "J" GALV. & CONT. CURR. GEN. FARADIC COIL ARMATURE

H. G. FISCHER & CO.
2335 WABANSIA AVE.
CHICAGO, ILL.

CAT. NO.

PART NO. 16021

TITLE
TC-50 X-RAY HEAD
O-RING

H. G. FISCHER & CO.
FRANKLIN PARK, ILLINOIS

PART NO. 16035

PATTERN	FINISH	SCALE 4

MATERIAL PURCHASE

TOOLS

DATE 10-1-66 | DR. BY KTK | CH'K'D. RS

DIMENSIONS—UNLESS OTHERWISE SPECIFIED:

FRACTIONAL	± .015	THREAD CHAMFER
DECIMAL	± .005	UP TO 5/16 D.-1/32 X 45°
ANGULAR	± 1/2°	3/8 D. & OVER-1/16 X 45°

REMOVE ALL BURRS & SHARP CORNERS

USED ON	QTY.	USED ON	QTY.
16005G	6		

REVISION	DATE	BY

5/16" O.D. X 3/16" I.D. 1/16" C/S O-RING

BUNA "N" RUBBER

DO NOT SCALE DRAWING.

TITLE FISCHER ADJUSTABLE INDUCTION ELECT.- COIL CONN. LINK-BLANK

H. G. FISCHER & CO.
FRANKLIN PARK, ILLINOIS

PART NO. 16194B

DATE 8-22-52 | DR. BY J.V.W. | CH'K'D.

REVISION	DATE	BY

PATTERN | FINISH | SCALE FULL

DIMENSIONS
FRACTIONAL ± .015
DECIMAL ± .005
ANGULAR ± ½°
UNLESS OTHERWISE SPECIFIED

TOOLS $\frac{5}{16}$" x $\frac{1}{2}$" CUT-OFF DIE #687 (Q-4)
$\frac{5}{16}$" x $\frac{1}{2}$" SLOT DIE # 11806

MATERIAL #20GA.(.032") SHEET BRASS

FLATTENING DIE #6146 (Y-5)

GRAIN TO RUN IN THIS DIRECTION

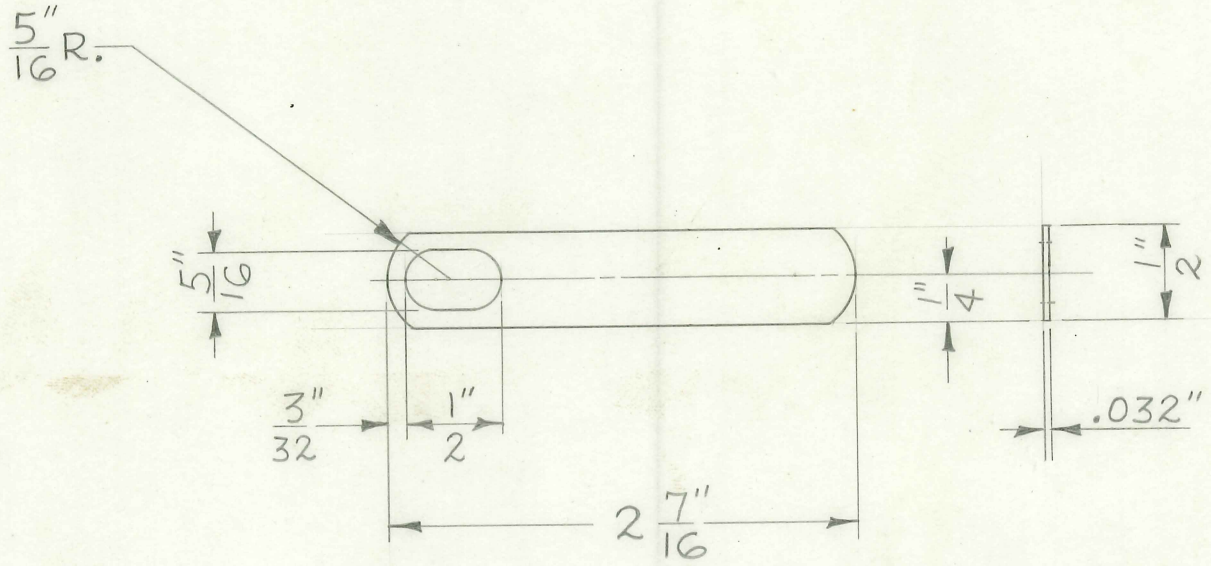

PUT THRU FLATTENING DIE AFTER BLANKING & PIERCING

4 REQUIRED

FOLDER #118

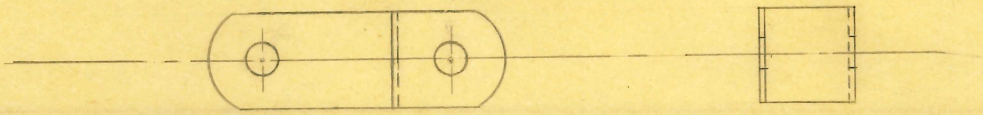

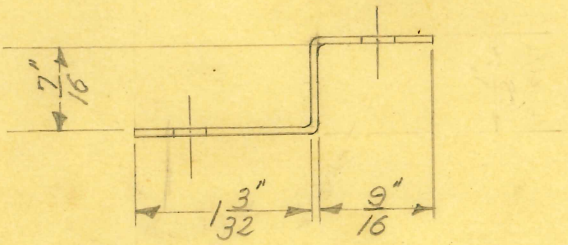

1 REQUIRED

RS

SIZE	MAKE	ISSUE	
KIND	FROM	CHANGED	
SHAPE	15865	"	
FINISH		"	
TEMP.		"	
PATT.		"	

TITLE: FISCHER ADJUSTABLE INDUCTION ELECT. COIL & CABLE CONNECTOR

H. G. FISCHER & CO.
2335 WABANSIA AVE.
CHICAGO, ILL.

CAT. NO.

PART NO. 16198

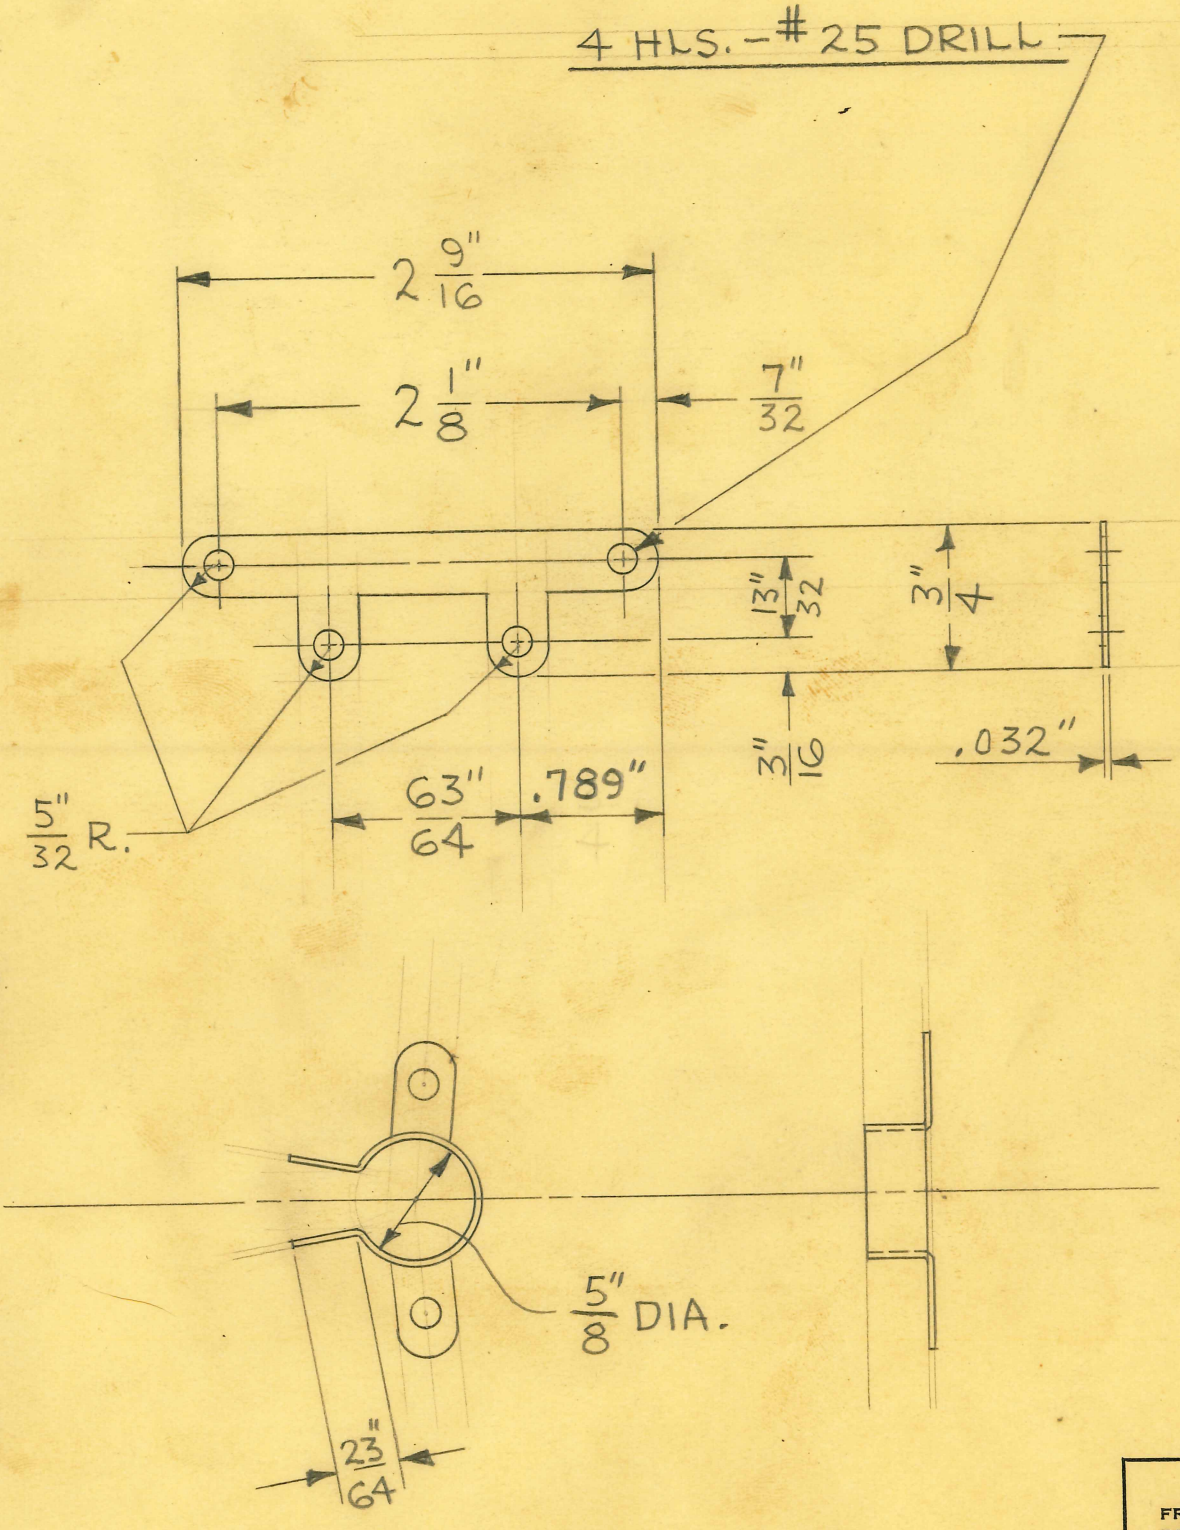

BLANKING DIE TOOL #9721
DRILLING PLATE TOOL #9722

.032" x 2 1/8" SHEARED SHEET BRASS - GRAIN TO RUN LENGTHWISE
1 1/2" FOR EACH PIECE
H.H.

2 REQUIRED

DIMENSIONS	
FRACTIONAL	± .015
DECIMAL	± .005
ANGULAR	± 1/2°
UNLESS OTHERWISE SPECIFIED	

SIZE	#20 GA. (.032")	ISSUE 2-27-48	J.V.W.
KIND	SHEET BRASS	CHANGED	
SHAPE		"	
FINISH		"	
TEMP.		"	
PATT.		"	

TITLE: FISCHER ADJUSTABLE INDUCTION ELECTRODE - CABLE CLAMP

H. G. FISCHER & CO.
2335 WABANSIA AVE.
CHICAGO, ILL.

CAT. NO.

PART NO. 16199

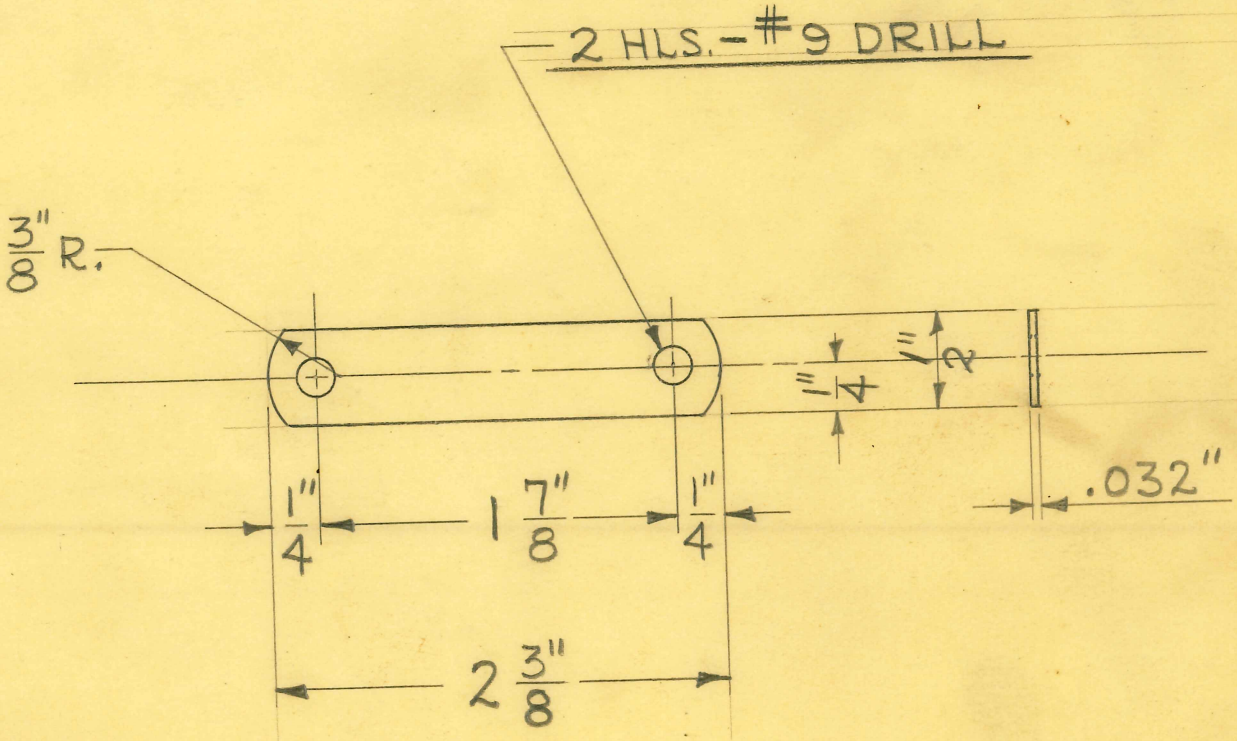

1 REQUIRED

DIMENSIONS	
FRACTIONAL	± .015
DECIMAL	± .005
ANGULAR	± 1/2°

UNLESS OTHERWISE SPECIFIED

SIZE	#20 GA. (.032")	ISSUE 2-27-48	J.V.W.
KIND	SHEET BRASS	CHANGED	
SHAPE		"	
FINISH		"	
TEMP.		"	
PATT.		"	

TITLE: FISCHER ADJUSTABLE INDUCTION ELECTRODE - COIL & CABLE CONNECTOR

H. G. FISCHER & CO.
2335 WABANSIA AVE.
CHICAGO, ILL.

CAT. NO.

PART NO. 16200

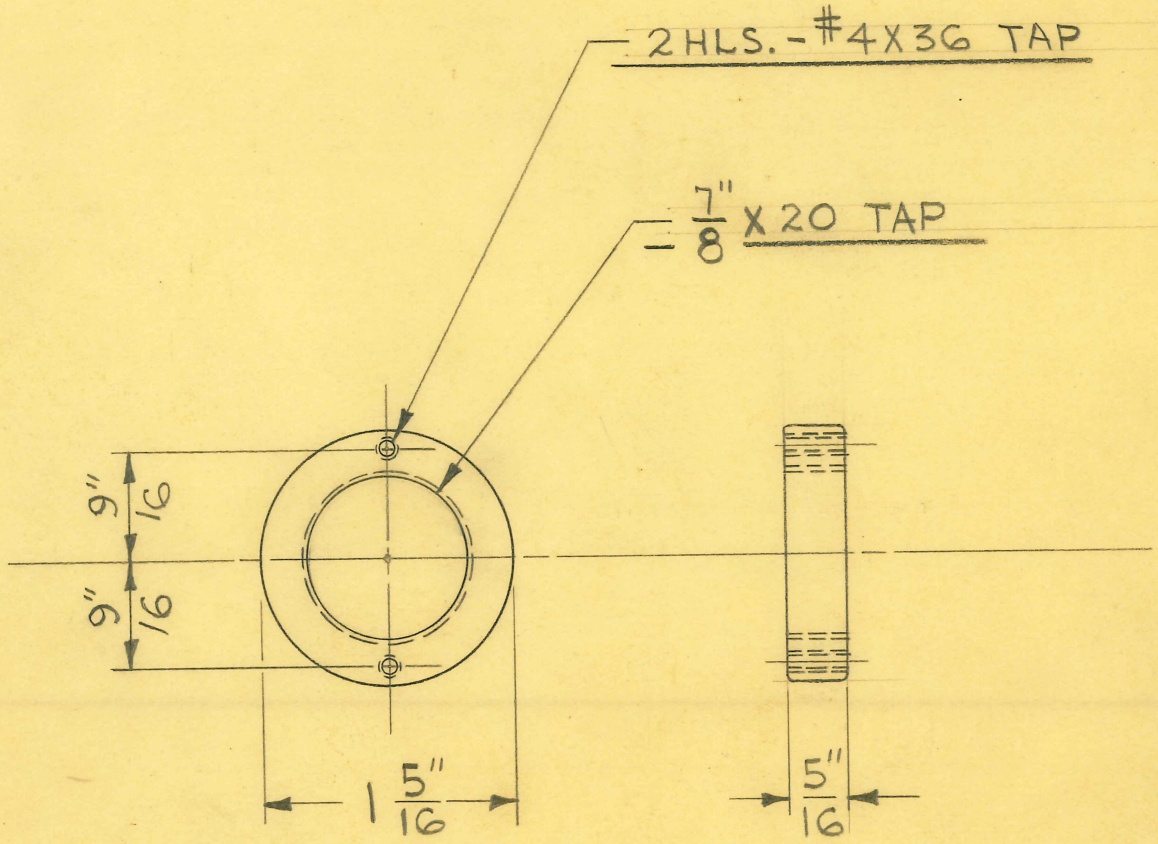

2 REQUIRED

7/8" X 20 TAP - TOOL #9744

DRILL JIG TOOL #9723

13/16" I.D. X 1/4" WALL NATURAL BAKELITE TUBING

DIMENSIONS	
FRACTIONAL	± .015
DECIMAL	± .005
ANGULAR	± 1/2°

UNLESS OTHERWISE SPECIFIED

SIZE		ISSUE 2-26-48	J.V.W.
KIND		CHANGED	
SHAPE		"	
FINISH		"	
TEMP.		"	
PATT.		"	

TITLE: FISCHER ADJUSTABLE INDUCTION ELECTRODE - CABLE BUSHING NUT

H. G. FISCHER & CO.
2335 WABANSIA AVE.
CHICAGO, ILL.

CAT. NO.

PART NO. 16201

3 HLS. - #25 DRILL

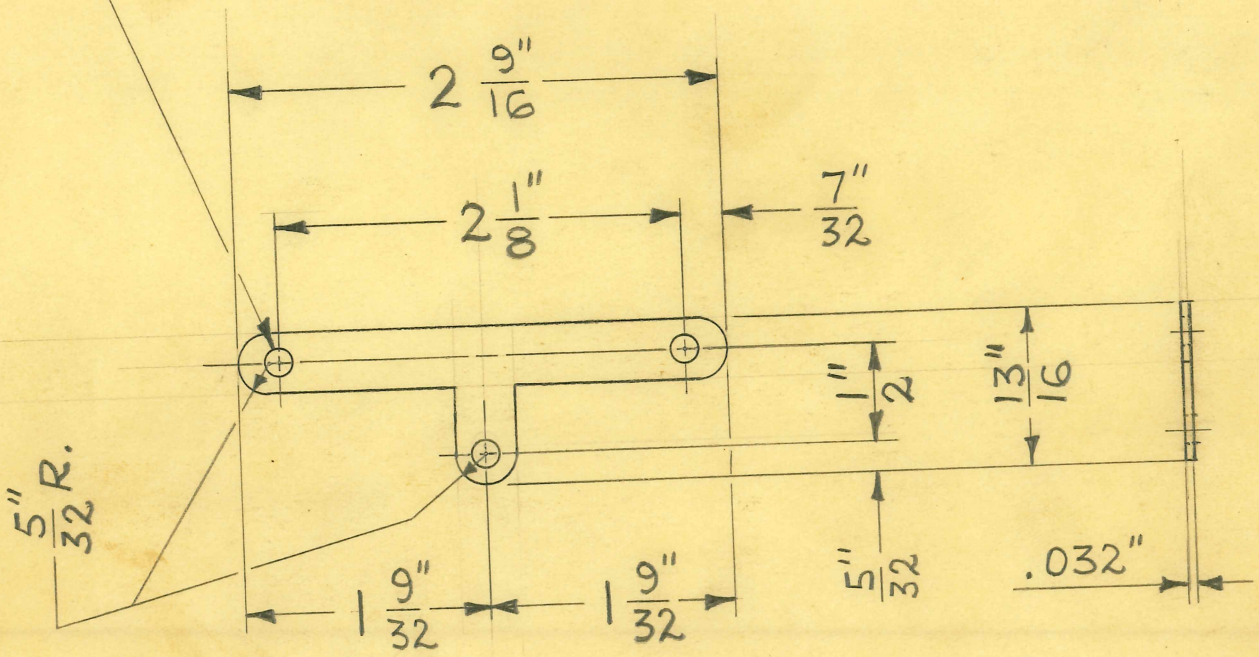

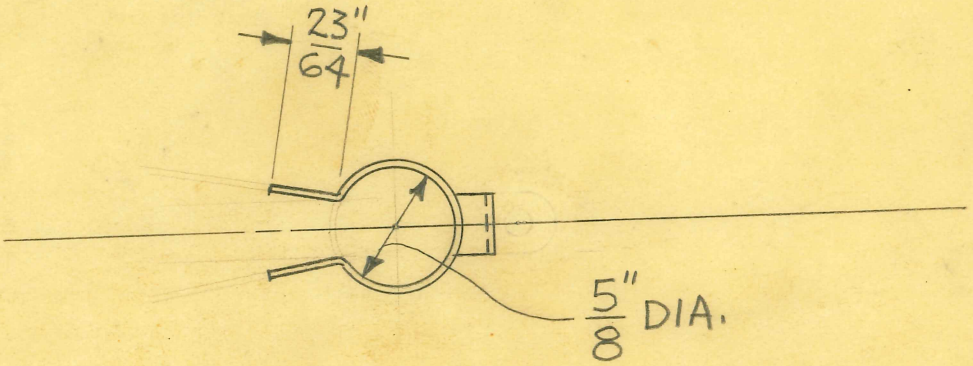

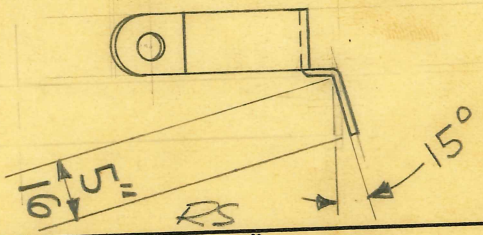

BLANK, & PIERCE DIE TOOL #9719
BENDING FIX. TOOL #14401
(WAS #9720)

H.H.
.032" X 2 1/8" SHEARED SHEET BRASS - GRAIN TO RUN LENGTHWISE
1 1/2" FOR EACH PIECE

2 REQUIRED

DIMENSIONS	
FRACTIONAL	± .015
DECIMAL	± .005
ANGULAR	± 1/2°
UNLESS OTHERWISE SPECIFIED	

SIZE	SEE NOTE →	ISSUE 2-27-48	J.V.W.
KIND		CHANGED	
SHAPE		"	
FINISH		"	
TEMP.		"	
PATT.		"	

TITLE: FISCHER ADJUSTABLE INDUCTION ELECTRODE - CABLE CLAMP

H. G. FISCHER & CO.
2335 WABANSIA AVE.
CHICAGO, ILL.

CAT. NO.

PART NO. 16202

TITLE

FISCHER ADJUSTABLE INDUCTION ELECT. COIL & CABLE CONNECTOR

H. G. FISCHER & CO.
FRANKLIN PARK, ILLINOIS

PART NO. 16204

DATE 11-26-48 | DR. BY J.B.G. | CH'K'D. J.V.W.

REVISION	DATE	BY

PATTERN | FINISH | SCALE FULL

DIMENSIONS
FRACTIONAL ± .015
DECIMAL ± .005
ANGULAR ± ½°
UNLESS OTHERWISE SPECIFIED

TOOLS FORMING FIXTURE TOOL #9672 FROM PC. #17060

MATERIAL #20 GA. (.032") STRIP BRASS

CUT-OFF & PIERCING DIE TOOL
#721 LOC. Y-5 FROM PC. #8776½

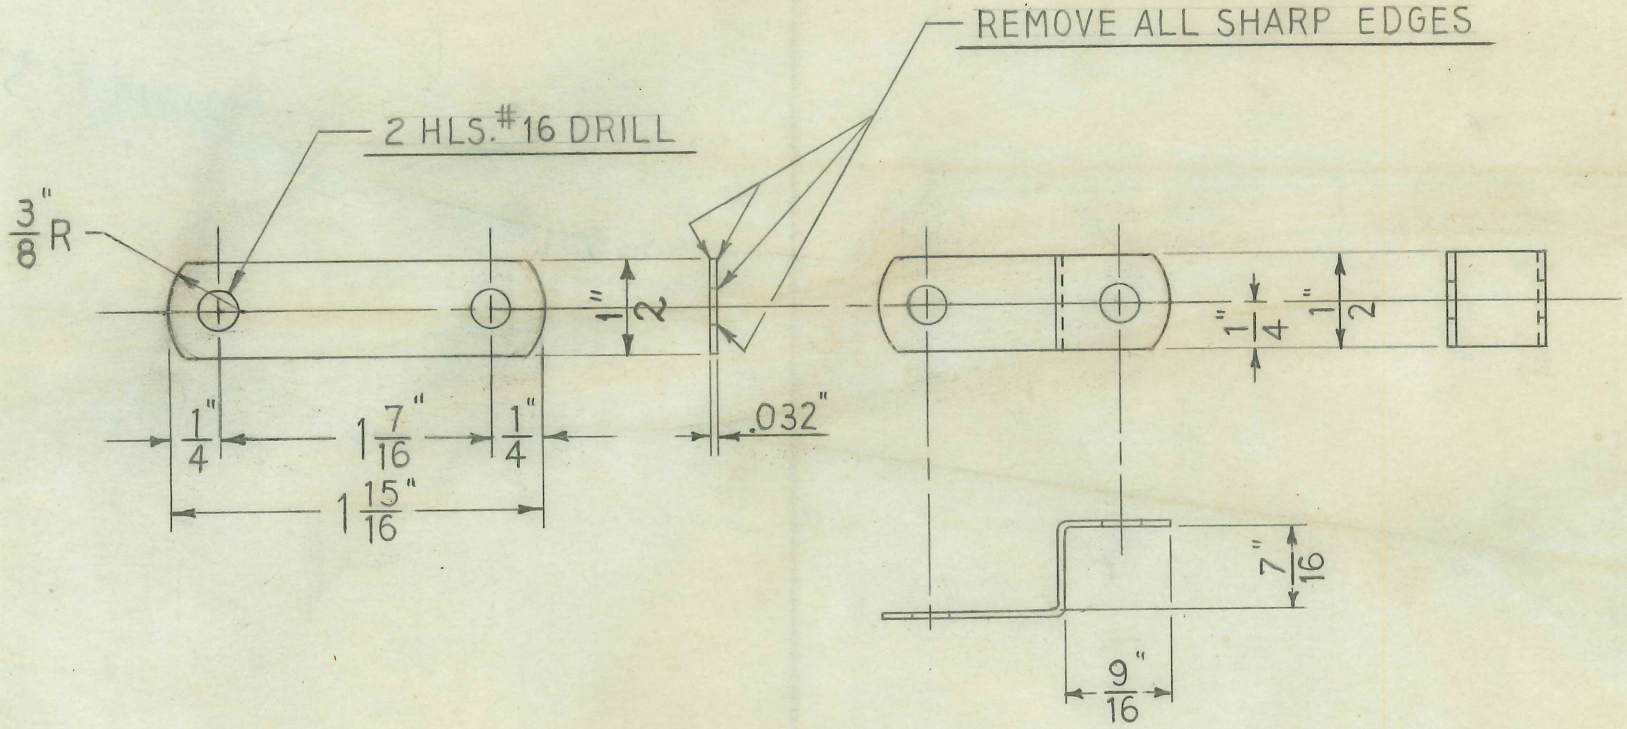

1-REQUIRED

FOLDER #118

TITLE: FISCHER ADJUSTABLE IND. ELECTRODE COIL SEGMENT - RIGHT

H. G. FISCHER & CO.
FRANKLIN PARK, ILLINOIS

PART NO. 16205A

DATE 1-27-50 | DR. BY J.V.W. | CH'K'D. RS

REVISION	DATE	BY

PATTERN | FINISH | SCALE FULL

DIMENSIONS
FRACTIONAL ± .015
DECIMAL ± .005
ANGULAR ± ½°
UNLESS OTHERWISE SPECIFIED

TOOLS: BENDING FIX. # 9222 (PCE. #16195)

MATERIAL: #8 GA. (.1285") BARE COPPER WIRE

DEVELOPED LENGTH = $7\frac{3}{8}$"

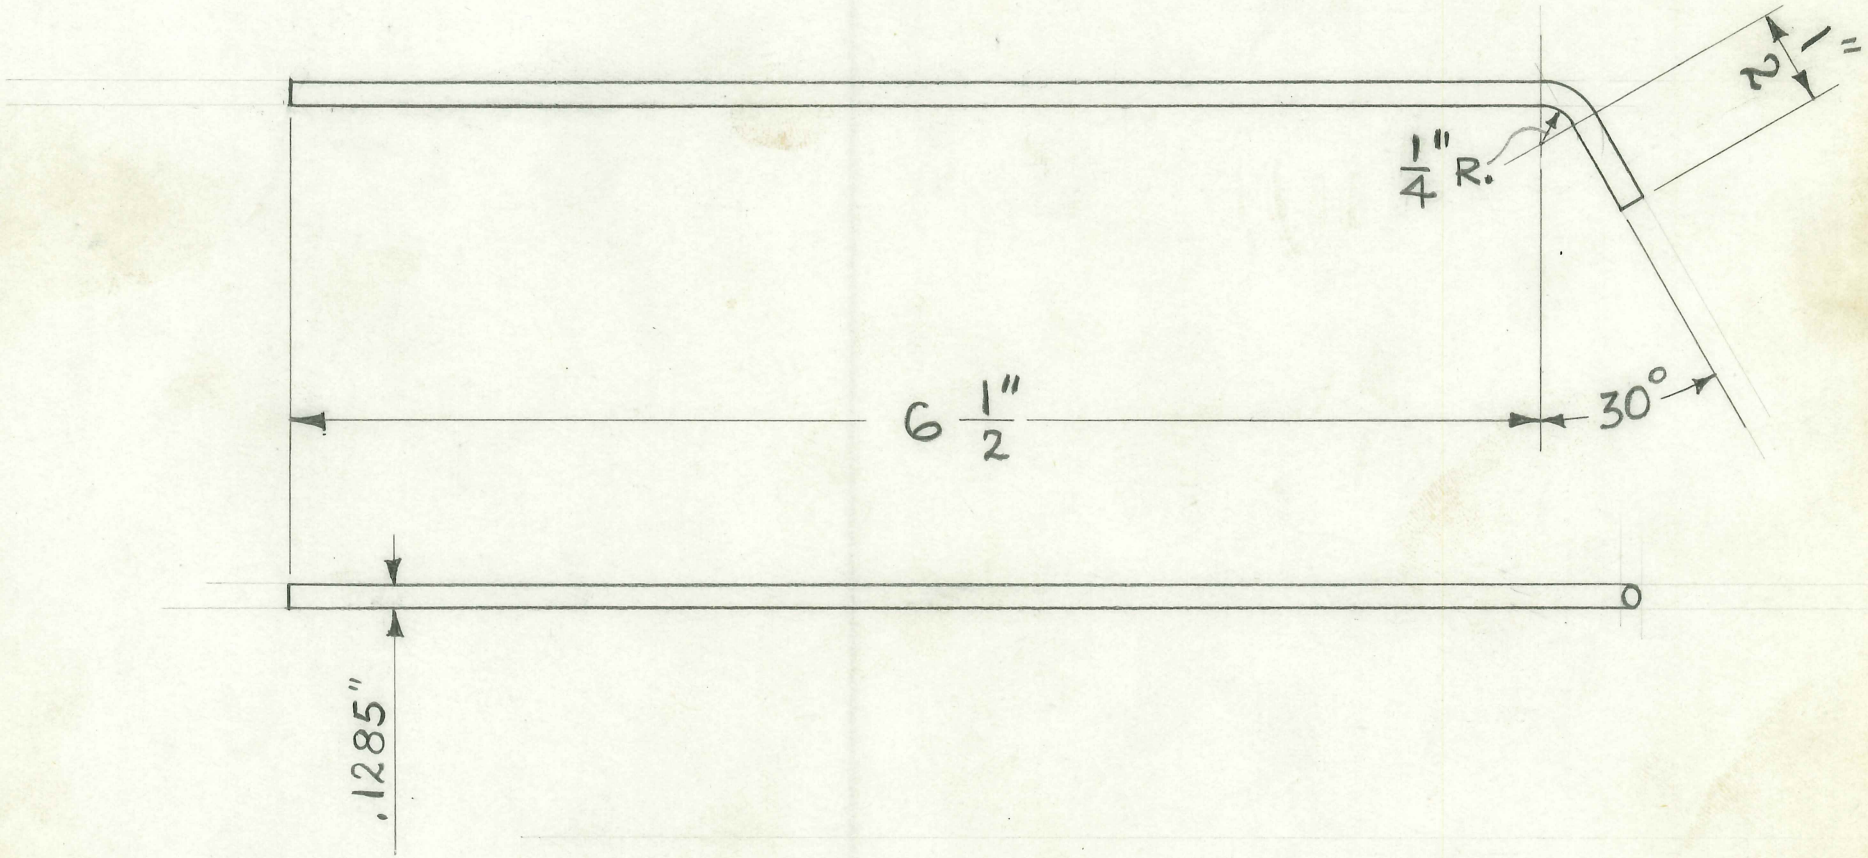

1 REQUIRED

FOLDER #118

TITLE

FISCHER INDUCTION ELECTRODE INSULATOR

H. G. FISCHER & CO.
FRANKLIN PARK, ILLINOIS

PART NO. 16206F

DATE 6-7-49 | DR. BY W.J. | CH'K'D. J.N.W.

REVISION	DATE	BY

PATTERN | FINISH | SCALE FULL

TOOLS GRINDING PLATE PCE. #16206F
RADIUS C'BORE PCE. #16206F

MATERIAL FROM 16206

DIMENSIONS UNLESS OTHERWISE SPECIFIED
FRACTIONAL ± .015
DECIMAL ± .005
ANGULAR ± ½°

DRILL JIG #11073
VISE JAWS #11074

1 REQUIRED

2 HLS. 5/8" DRILL. REMOVE EDGES BOTH SIDES WITH 1/16" RADIUS C'BORE

#18 DRILL

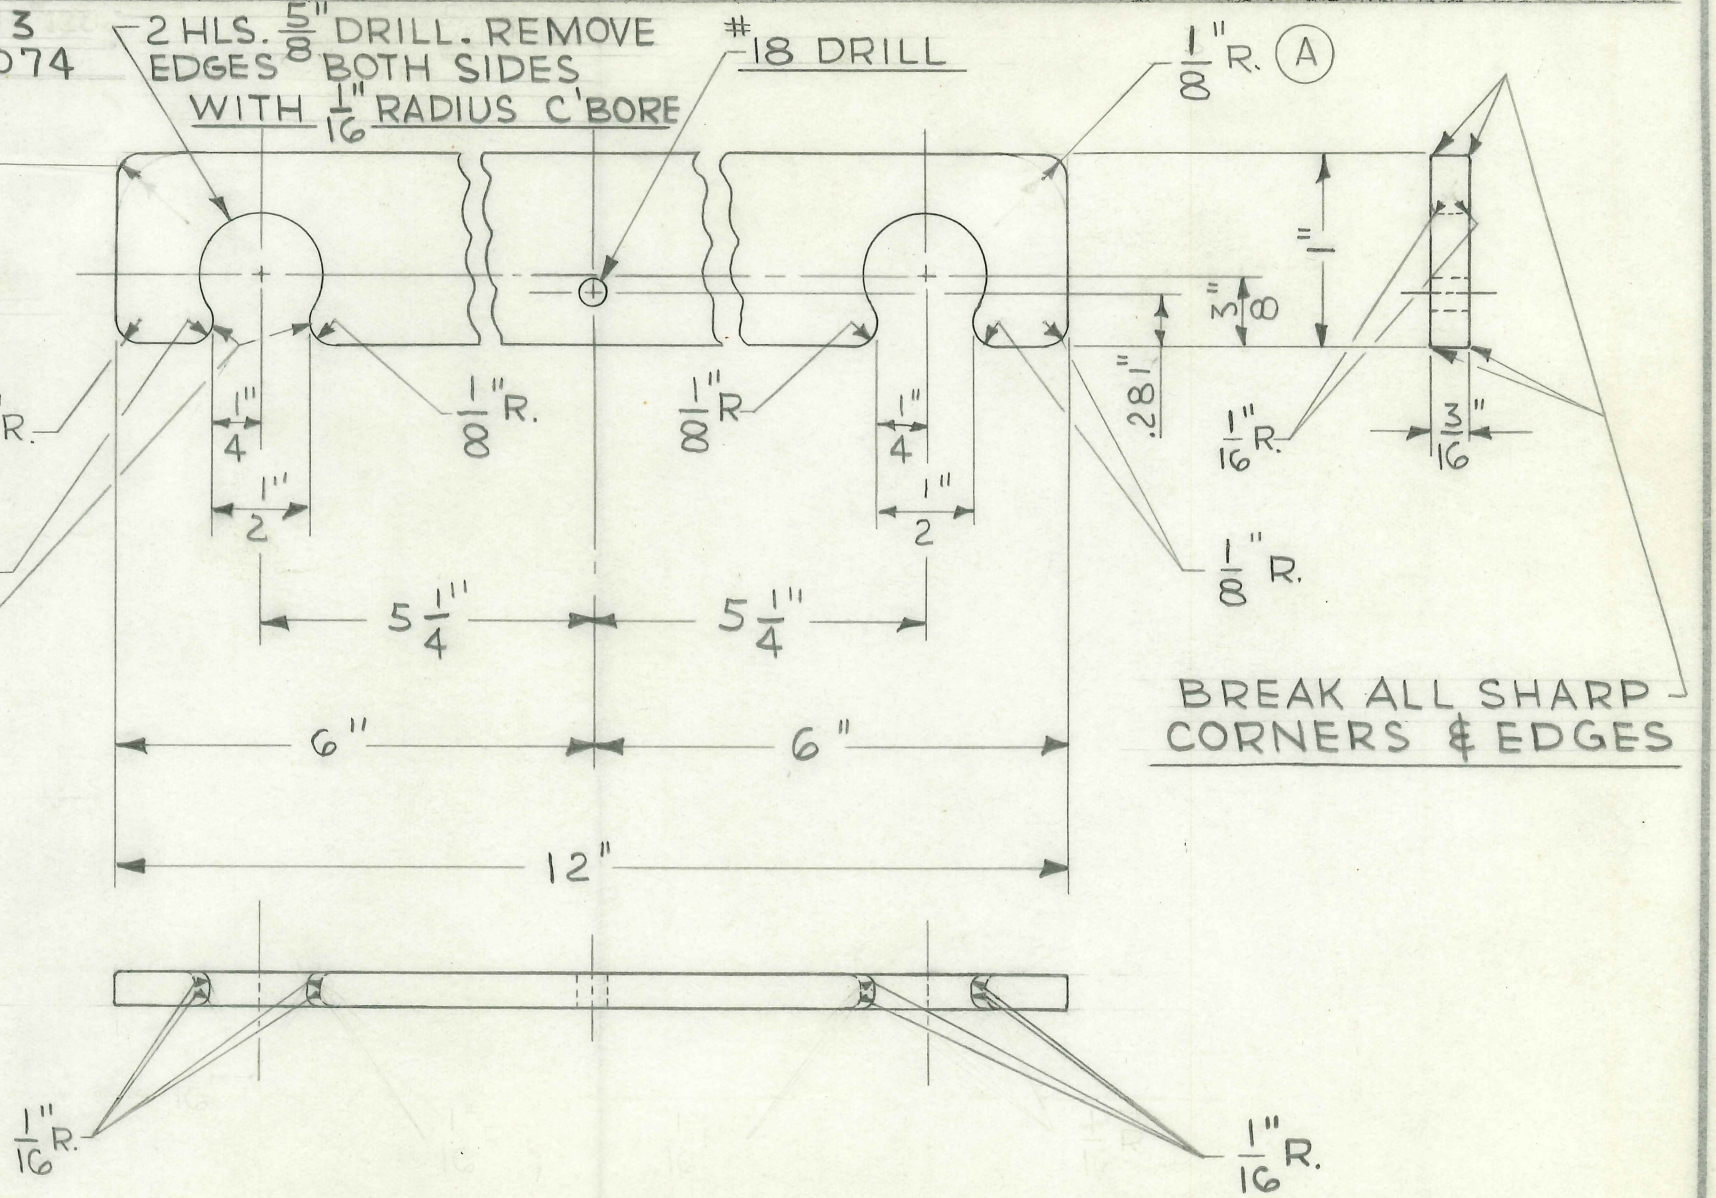

BREAK ALL SHARP CORNERS & EDGES

FILE EDGES AROUND SLOT TO APPROX. 1/16" RADIUS TOP & BOTTOM SIDES

FOLDER #118

TITLE
FISCHER INDUCTION ELECTRODE CLAMP SUPPORT

H. G. FISCHER & CO.
FRANKLIN PARK, ILLINOIS

DATE 5-18-49 | DR. BY W. J. | CH'K'D. J.V.W.

PART NO. 16207A

REVISION	DATE	BY

PATTERN | FINISH WHITE NICKEL #13 | SCALE FULL

TOOLS DRILL JIG #11034
BENDING FIX. #11013

MATERIAL 20 GA.(.032") HALF HARD SHEET BRASS

DIMENSIONS
FRACTIONAL ± .015
DECIMAL ± .005
ANGULAR ± ½°
UNLESS OTHERWISE SPECIFIED

GRAIN TO RUN IN THIS DIRECTION

REMOVE ALL SHARP CORNERS & EDGES BEFORE BENDING

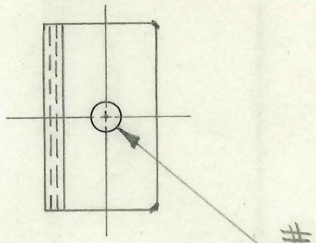

#18 DRILL

LENGTH OF DEVELOPMENT 1 3/16"

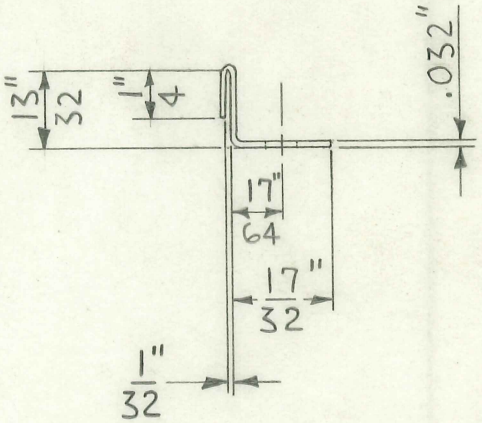

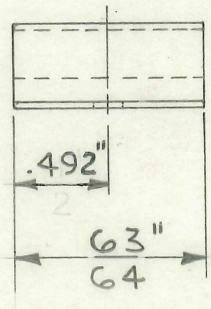

2 REQUIRED

FOLDER #118

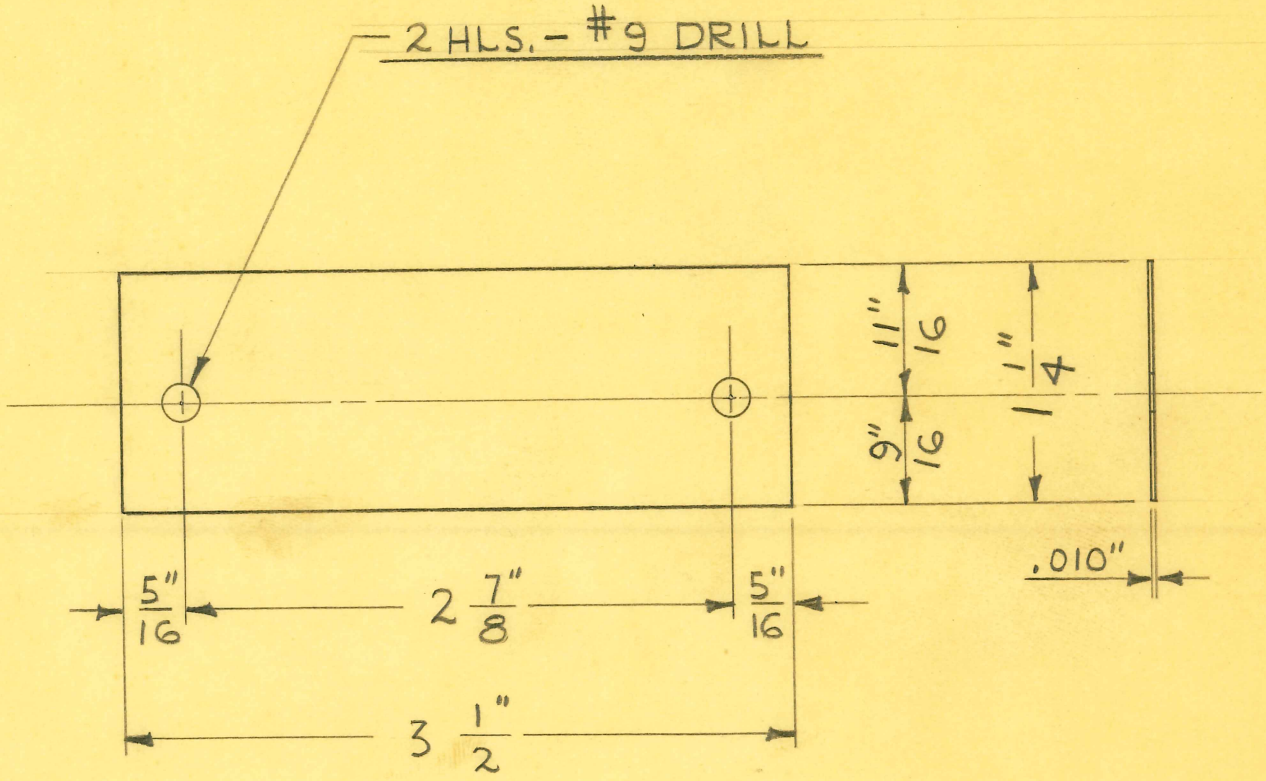

2 REQUIRED

OBSOLETE
H-22-80 J.S.

SIZE	.010" SHEET	ISSUE 4-25-46	J.V.W.
KIND	SHIM STOCK	CHANGED	
~~CHARE~~	STEEL	"	
FINISH		"	
TEMP.		"	
PATT.		"	

TITLE: MOD. "J" GALV. & CONT. CURR. GEN. SURGE UNIT - COMMUTATOR BASE SHIM

H. G. FISCHER & CO.
2335 WABANSIA AVE.
CHICAGO, ILL.

CAT. NO.

PART NO. 11559

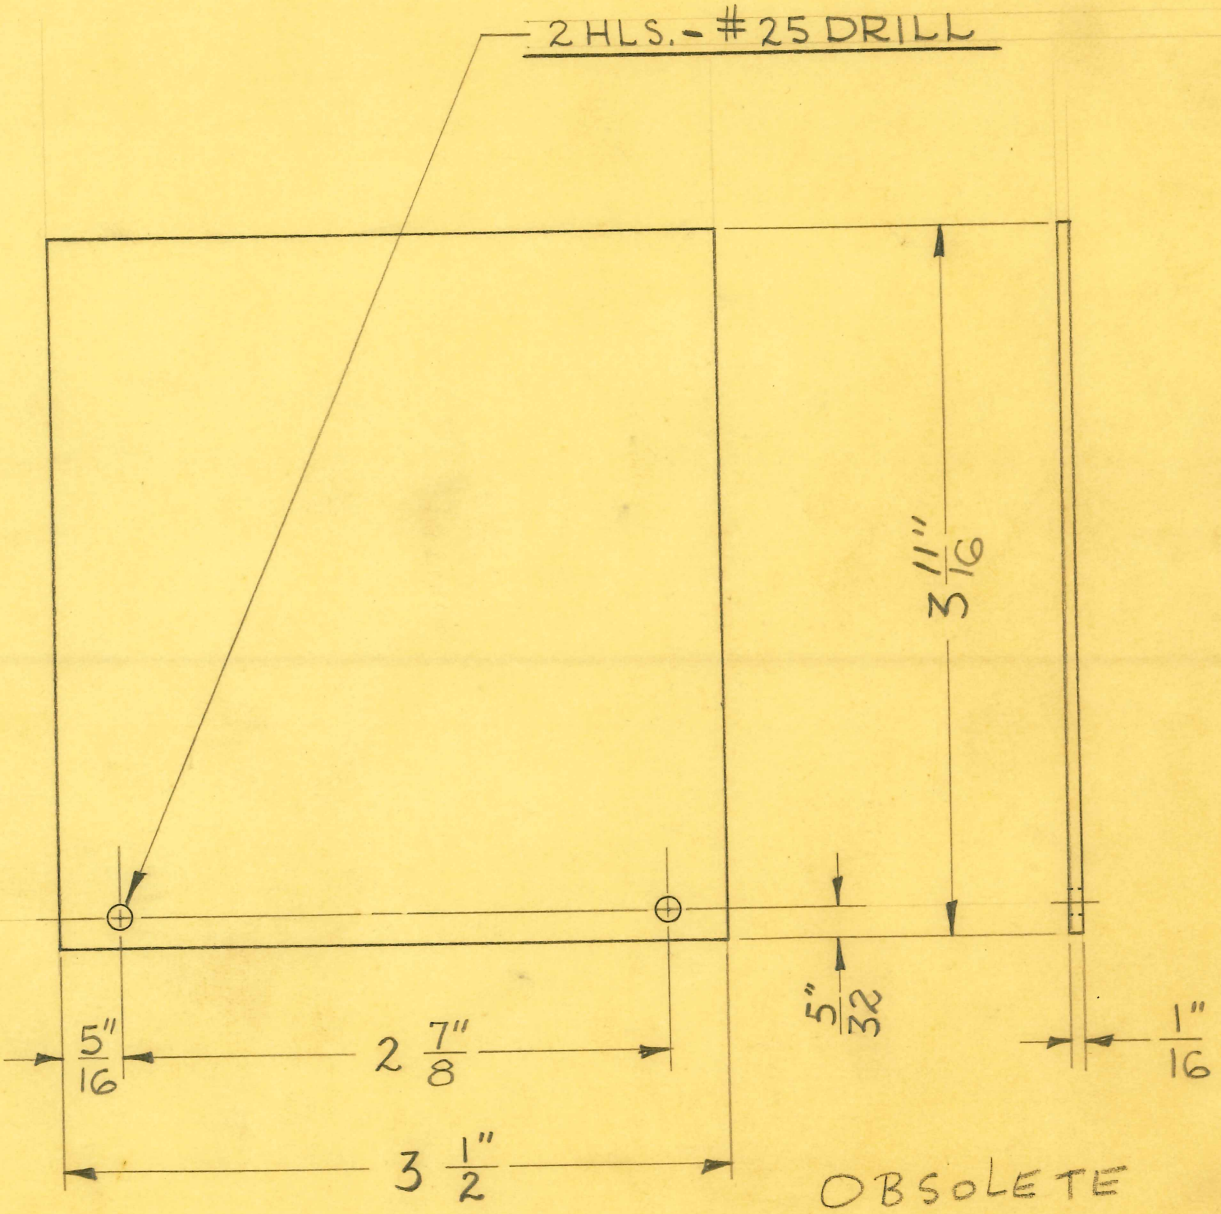

OBSOLETE
4-22-80 J.S.

1 REQUIRED

SIZE	1/16" SHEET	ISSUE 1-17-46	J.V.W.
KIND	CANVAS BASE	CHANGED	
SHAPE	BAKELITE	"	
FINISH		"	
TEMP.		"	
PATT.		"	

TITLE: FISCHER MOD. "J" GALV. & CONT. CURR. GEN. SURGE UNIT - RESISTOR SHIELD

H. G. FISCHER & CO.
2335 WABANSIA AVE.
CHICAGO, ILL.

CAT. NO.

PART NO. 11561

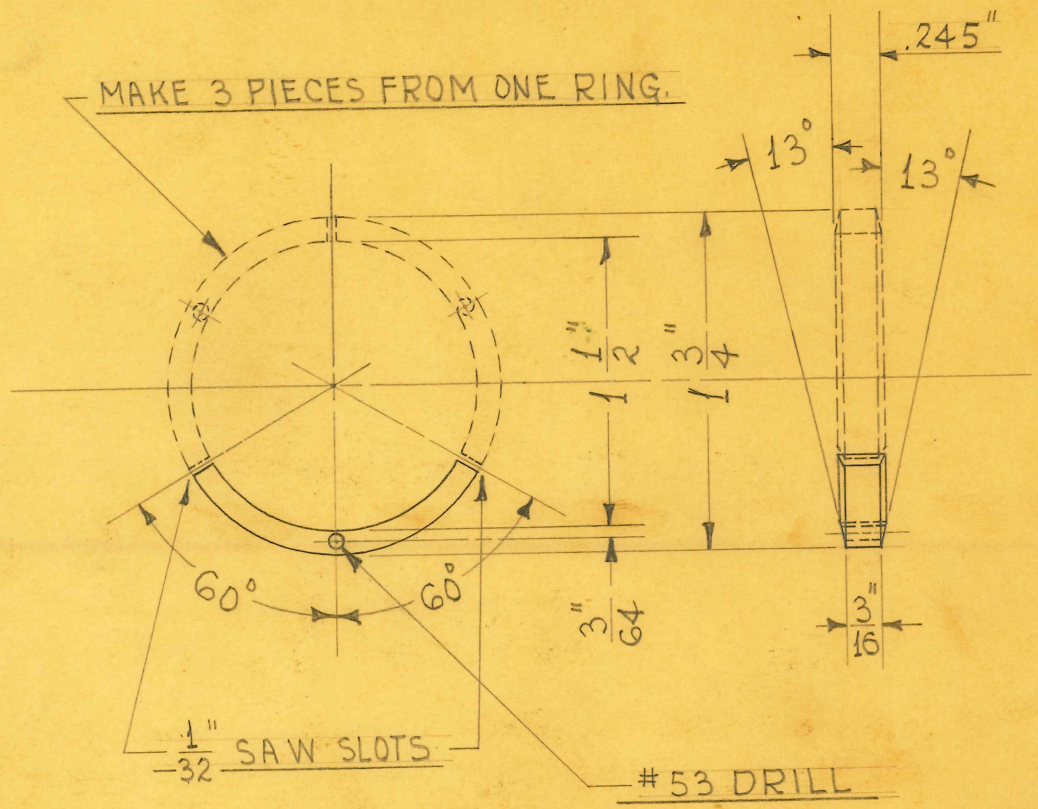

1 REQUIRED

OBSOLETE
4-22-80 J.S.

SIZE	1¾" O.D. X 1½" I.D.	ISSUE 11-15-43	H.E.
KIND	BRASS TUBING	CHANGED	
SHAPE		"	
FINISH		"	
TEMP.		"	
PATT.		"	

TITLE: FISCHER MOD. "J" GALV. & CONT. CURR. GEN. SURGE UNIT ~ COLLECTOR RING ~ SPLIT BRASS RING

H. G. FISCHER & CO.
2335 WABANSIA AVE.
CHICAGO. ILL.

CAT. NO.

PART NO. 11566

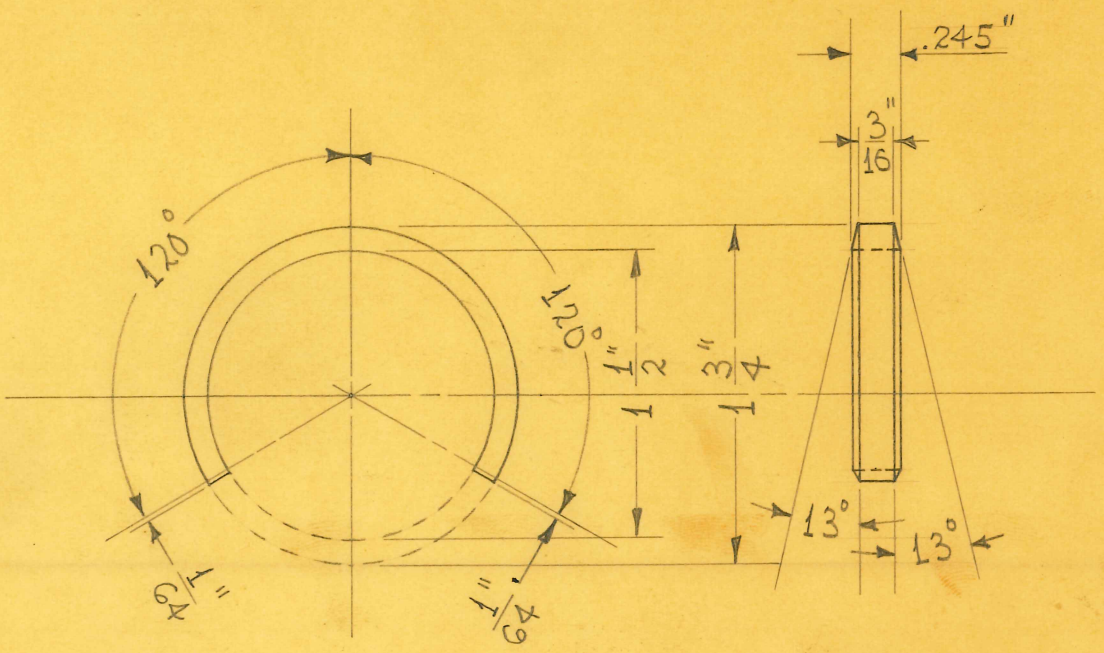

1 REQUIRED

OBSOLETE
4/22/80 J.S

SIZE	1/4" SHEET	ISSUE 11-15-43	HE.
KIND	BLK. BAKELITE	CHANGED	
SHAPE		"	
FINISH		"	
TEMP.		"	
PATT.		"	

TITLE: FISCHER MOD. "J" GALV. & CONT. CURR. GEN. SURGE UNIT - COLLECTOR RING - SPLIT BAKELITE RING

H. G. FISCHER & CO.
2338 WABANSIA AVE.
CHICAGO. ILL.

CAT. NO.

PART NO. 11566 1/2

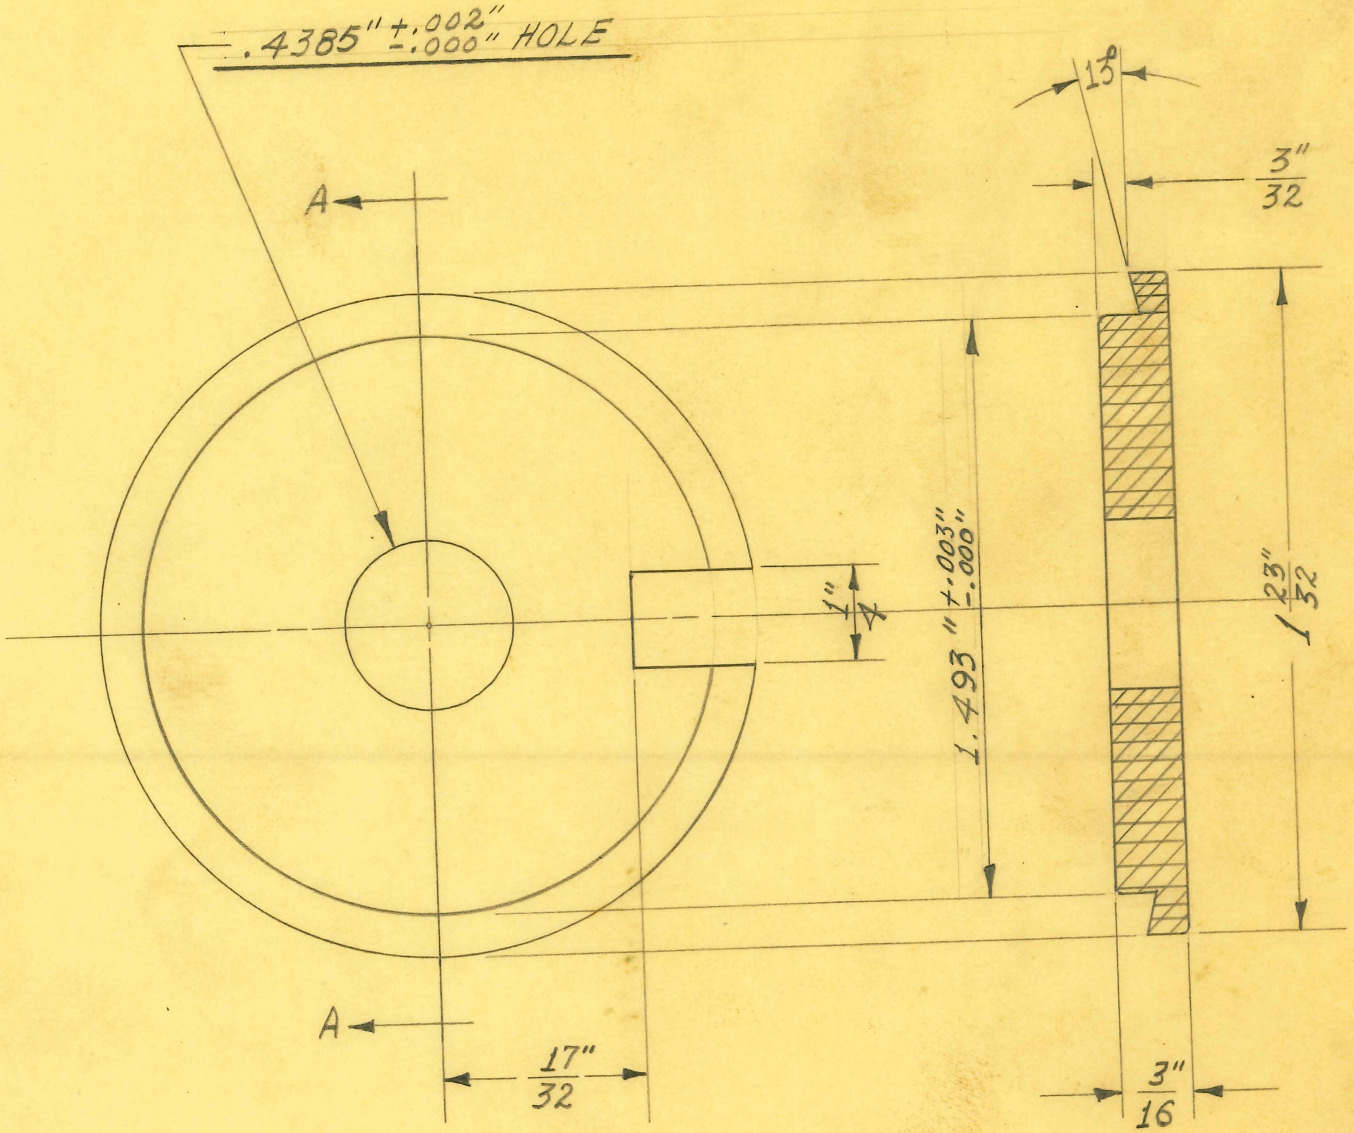

SECTION THRU A-A

SCALE ½ DOUBLE SIZE

OBSOLETE
4-22-80 J.S.

1 REQUIRED

SIZE	3/16" SHEET	ISSUE 12-7-39	J.W.
KIND	BAKELITE	CHANGED	
SHAPE		"	
FINISH		"	
TEMP.		"	
PATT.		"	

TITLE: FISCHER MOD. "J" GALV. & CONT. CURR. GEN. SURGE UNIT - COLLECTOR RING - SPLIT RING SUPPORT DISC - SLOTTED

H. G. FISCHER & CO.
2335 WABANSIA AVE.
CHICAGO, ILL.

CAT. NO.

PART NO. 11567

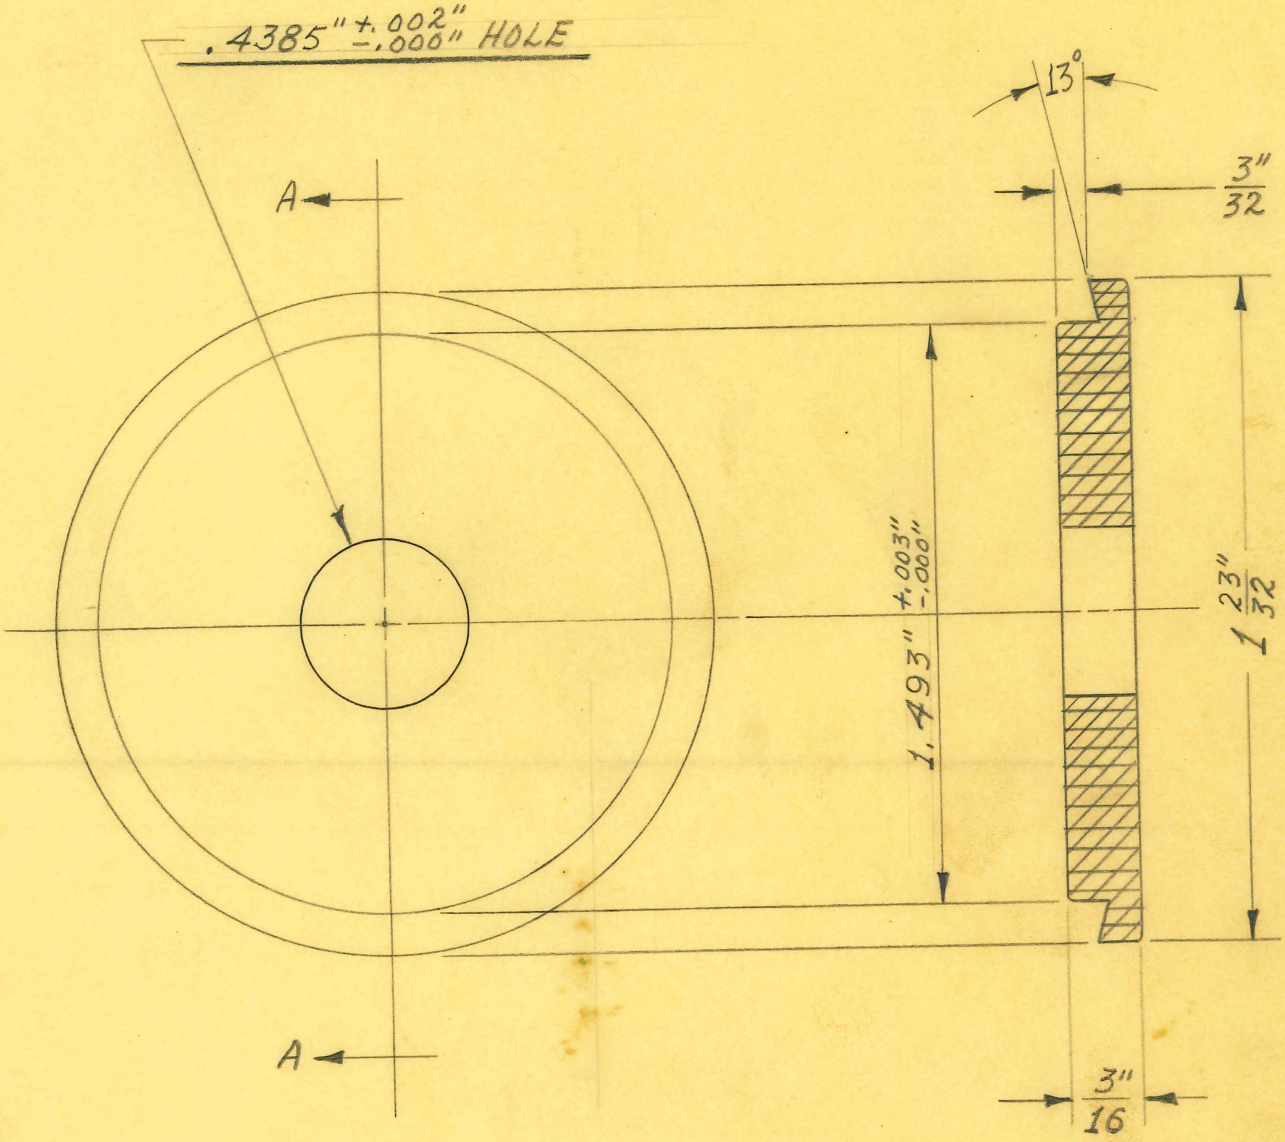

SECTION THRU A-A

SCALE ÷ DOUBLE SIZE

OBSOLETE
4-22-80 J.S.

1 REQUIRED

SIZE	3/16" SHEET	ISSUE 12-7-39	J.W.
KIND	BAKELITE	CHANGED	
SHAPE		"	
FINISH		"	
TEMP.		"	
PATT.		"	

TITLE: FISCHER MOD. "J" GALV. & CONT. CURR. GEN. SURGE UNIT - COLLECTOR RING - SPLIT RING SUPPORT DISC

H. G. FISCHER & CO.
2335 WABANSIA AVE.
CHICAGO, ILL.

CAT. NO.

PART NO. 11568

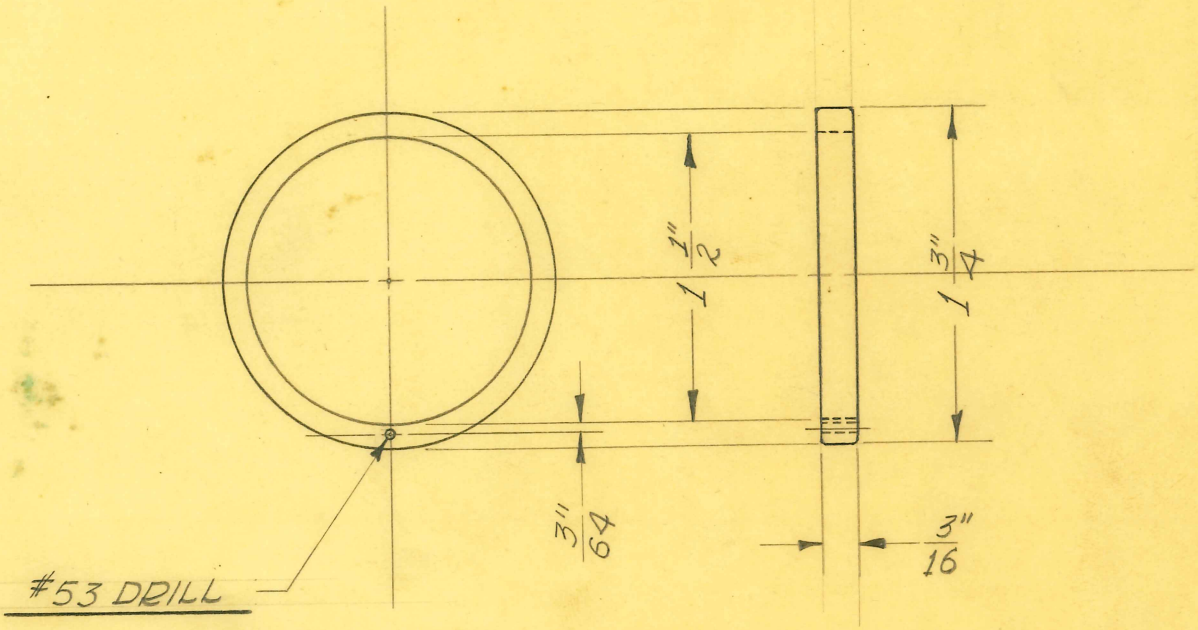

3 REQUIRED

OBSOLETE
4-22-80 J.S.

SIZE	1¾"O.D.X1½"I.D.	ISSUE 12-7-39	J.W.
KIND	BRASS	CHANGED	
SHAPE	TUBING	"	
FINISH		"	
TEMP.		"	
PATT.		"	

TITLE: FISCHER MOD. "J" GALV. & CONT. CURR. GEN. SURGE UNIT- COLLECTOR RING

H. G. FISCHER & CO.
2335 WABANSIA AVE.
CHICAGO, ILL.

CAT. NO.

PART NO. 11570

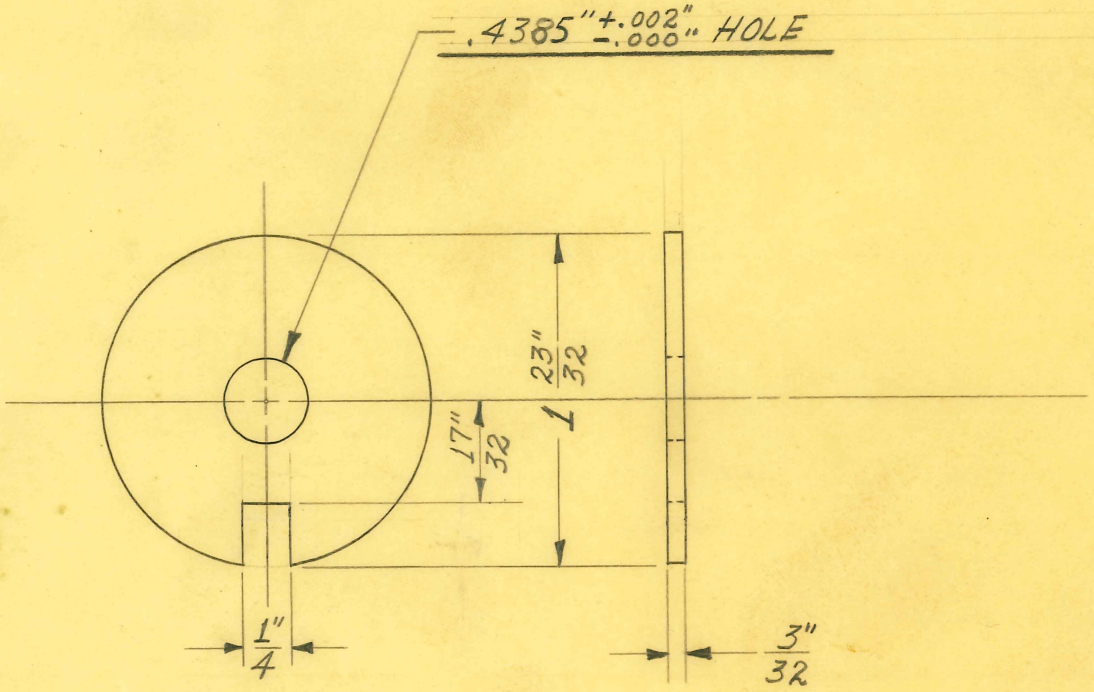

3 REQUIRED

OBSOLETE
4-22-80 J.S.

SIZE	3/32" SHEET	ISSUE 12-6-39	J.W.
KIND	BAKELITE	CHANGED	
SHAPE		"	
FINISH		"	
TEMP.		"	
PATT.		"	

TITLE: FISCHER MOD. "J" GALV. & CONT. CURR. GEN. SURGE UNIT - COLLECTOR RING INS. DISC

H. G. FISCHER & CO.
2335 WABANSIA AVE.
CHICAGO, ILL.

CAT. NO.

PART NO. 11571

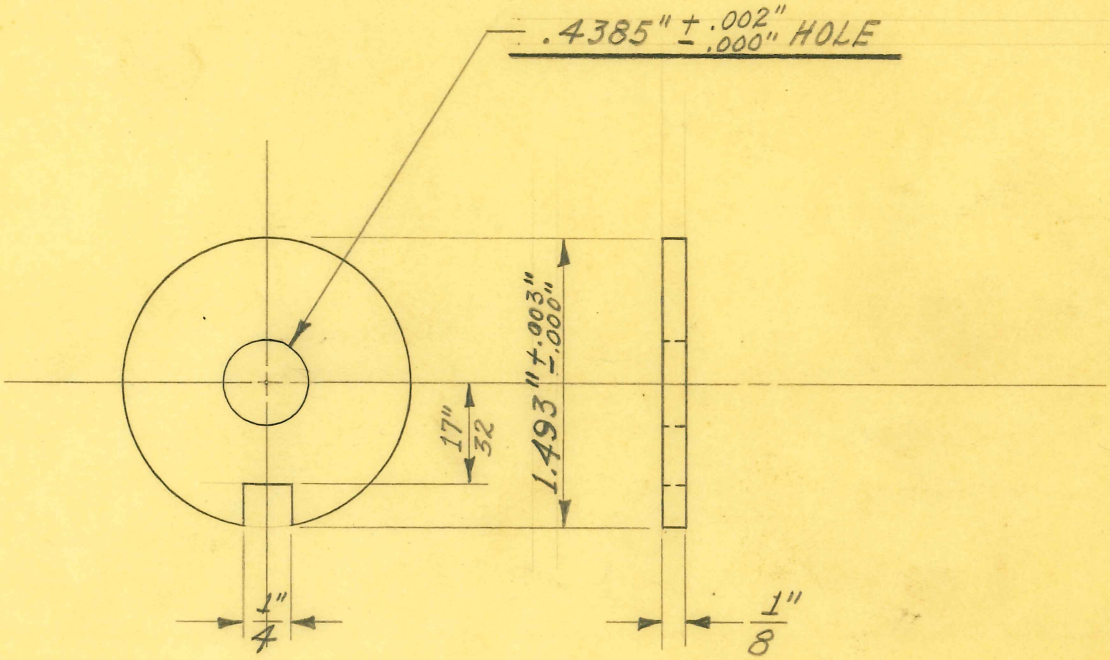

3 REQUIRED

OBSOLETE
4-22-80 J.S.

SIZE	1/8" SHEE	ISSUE 12-7-39	J.W.
KIND	CANVAS BASE	CHANGED	
[redacted]	BAKELITE	"	
FINISH		"	
TEMP.		"	
PATT.		"	

TITLE:
FISCHER MOD. "J" GALV. & CONT. CURR. GEN.
SURGE UNIT - COLLECTOR RING SUPPORT DISC

H. G. FISCHER & CO.
2335 WABANSIA AVE.
CHICAGO, ILL.

CAT. NO.

PART NO. 11572

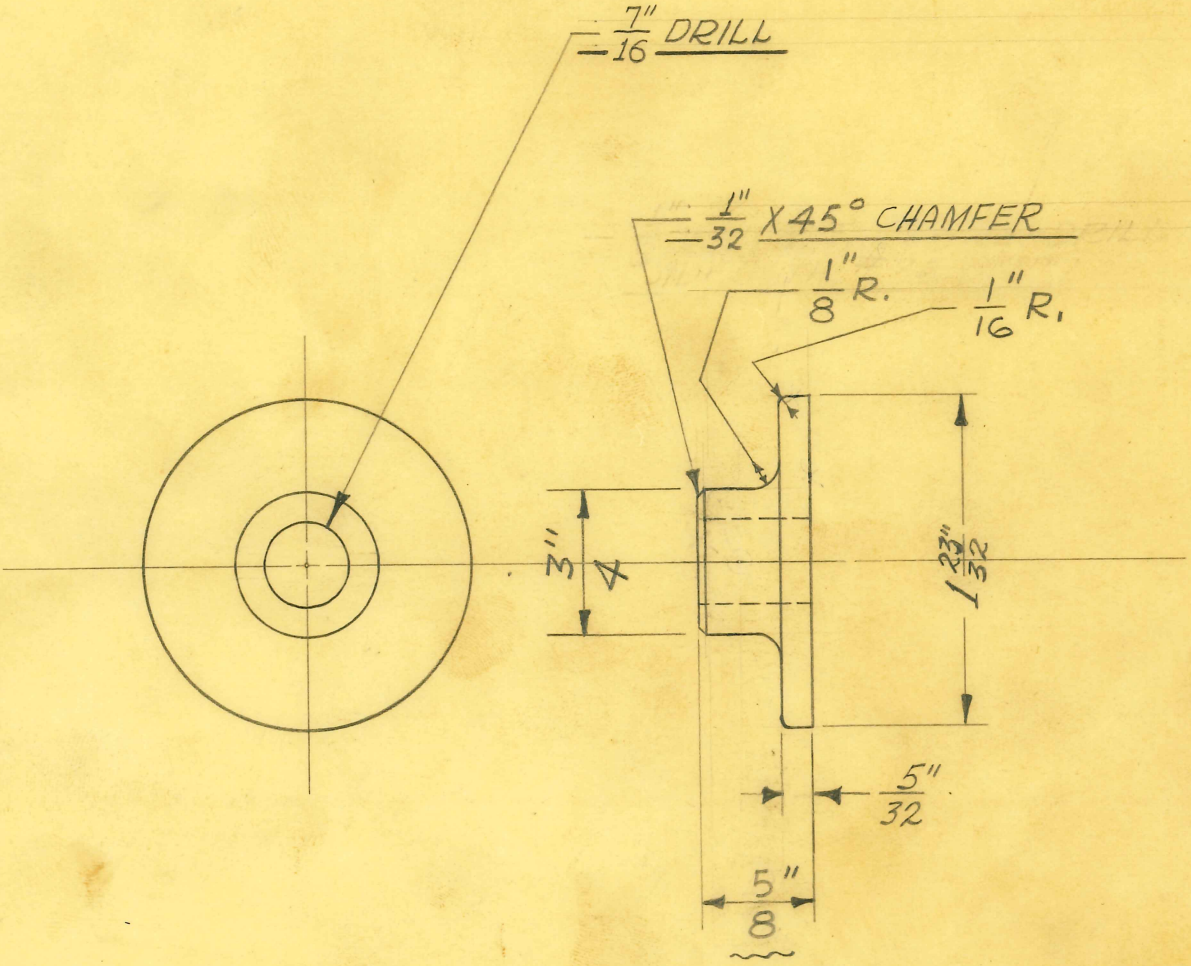

1 REQUIRED

OBSOLETE
4-22-80 J.S.

1 3/4" DIA. BRASS ROD

SIZE	~~IRON~~	ISSUE 12-6-39	J.W.
KIND	~~CASTING~~	CHANGED	
SHAPE		"	
FINISH	BLACK #81	"	
TEMP.		"	
PATT.	~~1470~~	"	

TITLE:
FISCHER MOD. "J" GALV. & CONT. CURR. GEN. SURGE UNIT - COLLECTOR RING SHAFT FLANGE -UPPER

H. G. FISCHER & CO.
2335 WABANSIA AVE.
CHICAGO, ILL.

CAT. NO.

PART NO. 11573A

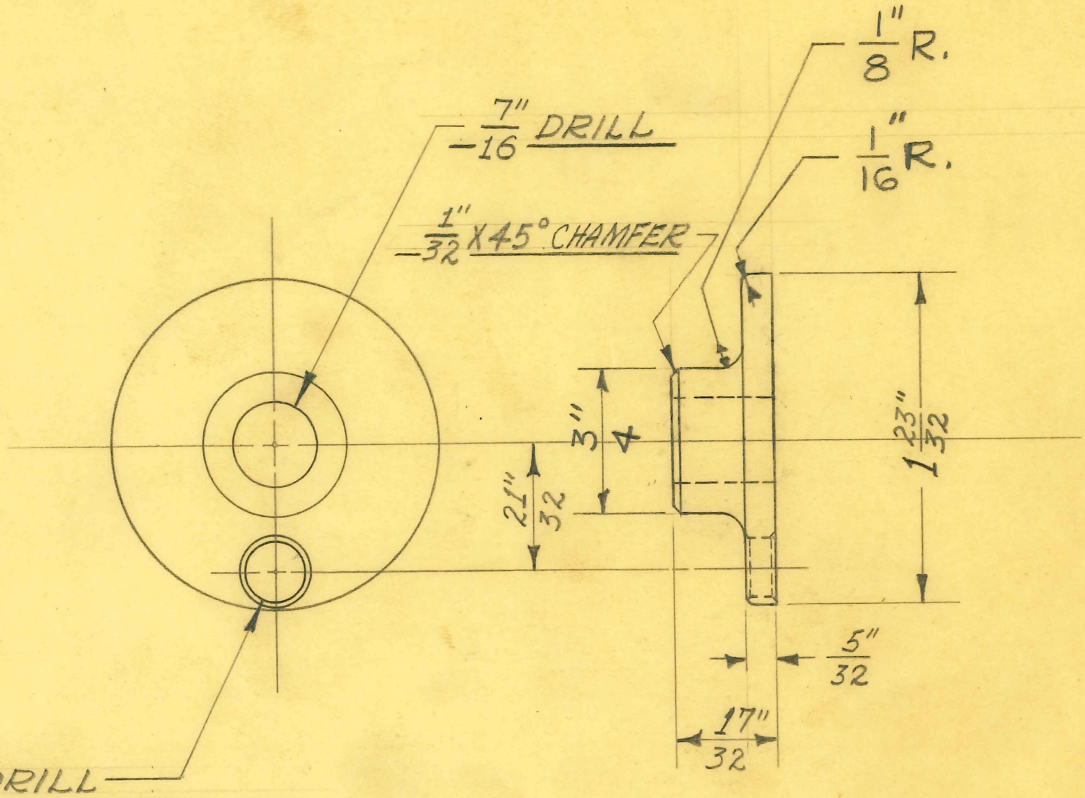

1 REQUIRED

OBSOLETE
4-22-80 J.S

1 3/4" DIA. BRASS ROD

SIZE	~~IRON~~	ISSUE 12-6-39	J.W.
KIND	~~CASTING~~	CHANGED	
SHAPE		"	
FINISH	BLACK #81	"	
TEMP.		"	
PATT.	~~1470~~	"	

TITLE: FISCHER MOD. "J" GALV. & CONT. CURR. GEN. SURGE UNIT-COLLECTOR RING SHAFT FLANGE-LOWER

H. G. FISCHER & CO.
2335 WABANSIA AVE.
CHICAGO, ILL.

CAT. NO.

PART NO. 11574A

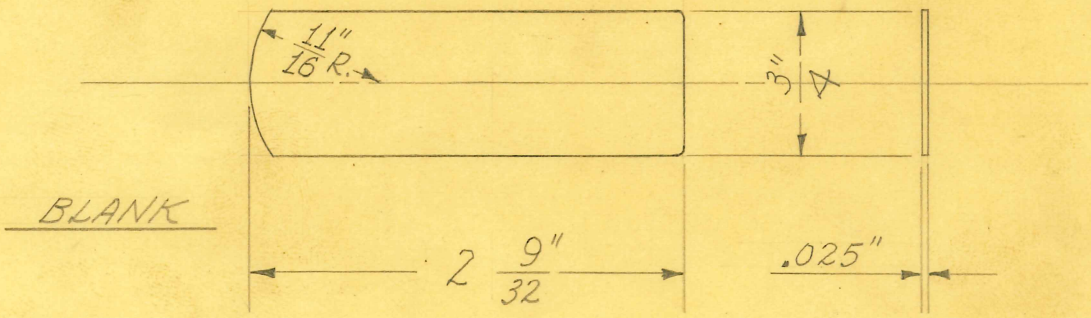

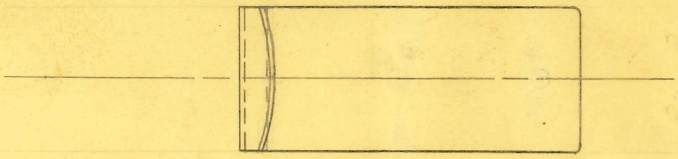

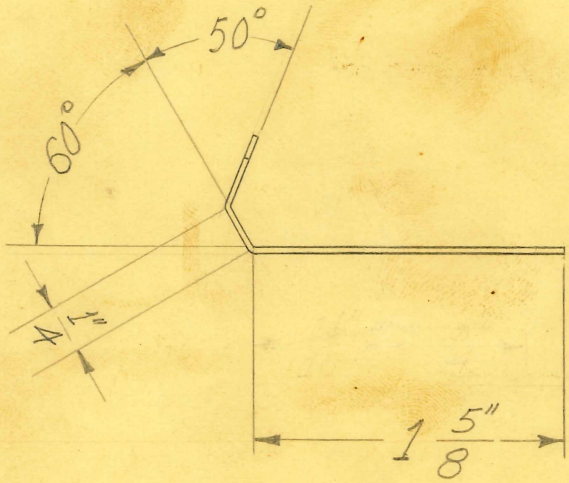

OBSOLETE
4-22-80

4 REQUIRED

SIZE	.025" SHEET	ISSUE 5-17-38	J.W.
KIND	PHOS. BRONZE	CHANGED 1-11-39	J.W.
SHAPE		"	
FINISH		"	
TEMP.		"	
PATT.		"	

TITLE: FISCHER MOD. "J" GALV. & CONT. CURR. GEN. CABINET DOOR SPRING CLIP

H. G. FISCHER & CO.
2335 WABANSIA AVE.
CHICAGO, ILL.

CAT. NO.

PART NO. 11122

BLANK

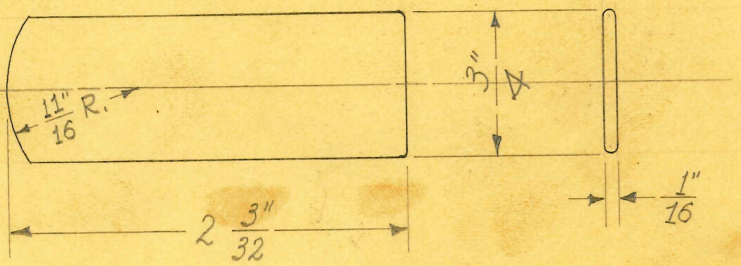

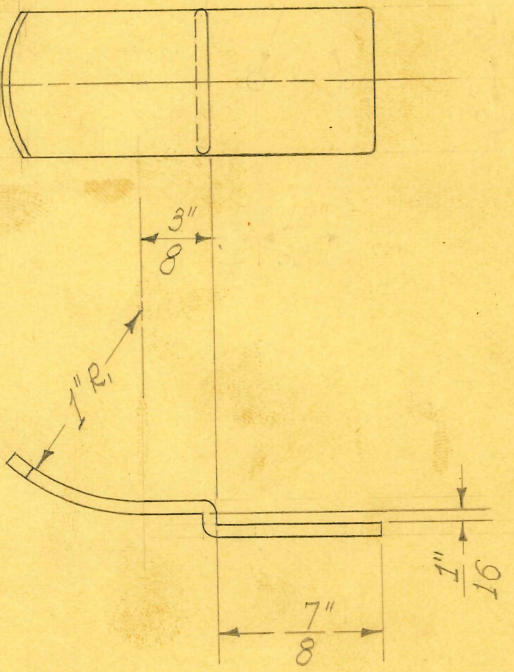

OBSOLETE
4-22-80

2 REQUIRED

SIZE	3/4" X 1/16"	ISSUE 8-23-38	J.W.	**TITLE:** FISCHER MOD. "J" GALV. & CONT. CURR. GEN. CABINET DOOR CLIP - REAR
KIND	FLAT WIRE	CHANGED 1-11-39	J.W.	
SHAPE		"		
FINISH		"		
TEMP.		"		
PATT.		"		

H. G. FISCHER & CO.
2335 WABANSIA AVE.
CHICAGO, ILL.

CAT. NO.

PART NO. 11123A

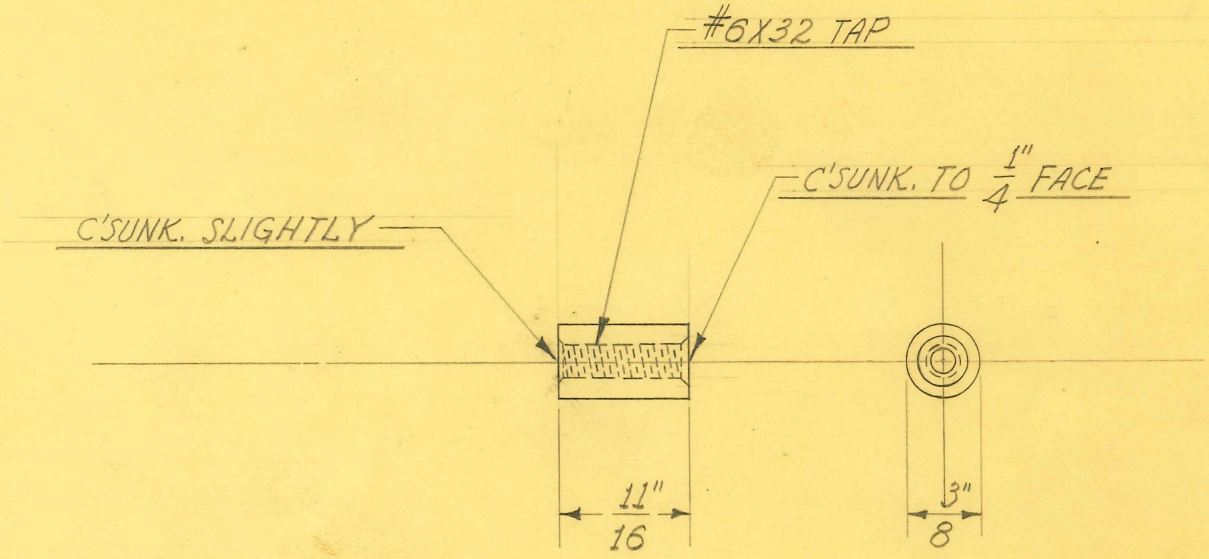

4 REQUIRED

OBSOLETE
4-22-80

SIZE	3/8" DIAM.	ISSUE 2-16-38	J.W.
KIND	BRASS ROD.	CHANGED	
SHAPE		"	
FINISH		"	
TEMP.		"	
PATT.		"	

TITLE: FISCHER MOD. "J" GALV. & CONT. CURR. GEN. 3 POINT SWITCH SPACER

H. G. FISCHER & CO.
2335 WABANSIA AVE.
CHICAGO, ILL.

CAT. NO.

PART NO. 11133

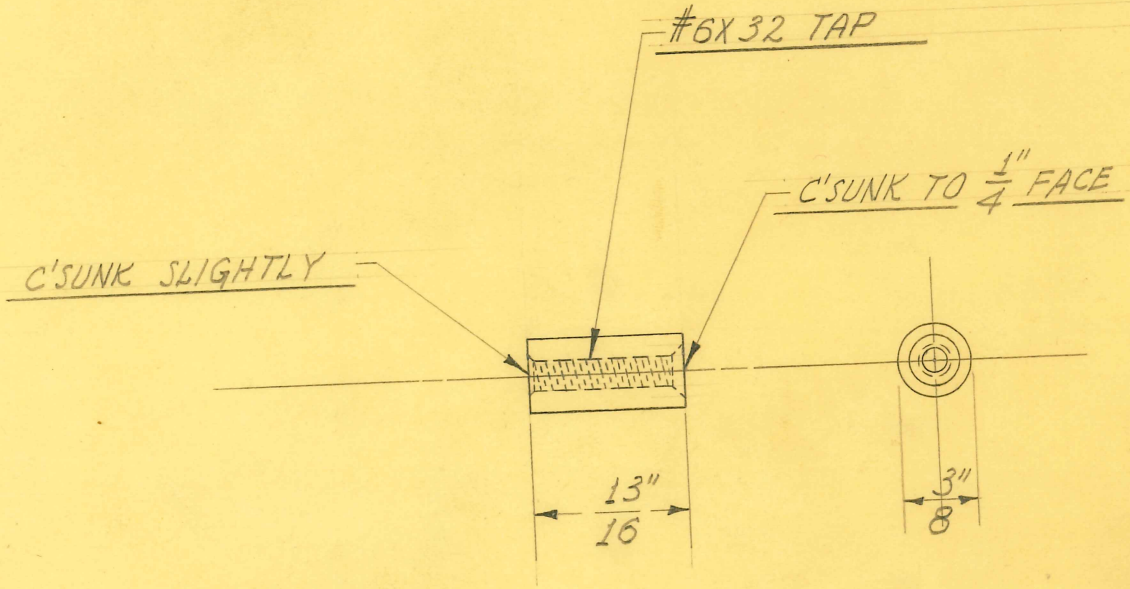

4 REQUIRED

OBSOLETE
4-12-80

SIZE	3/8" DIAM.	ISSUE 2-16-38	J.W.
KIND	BRASS ROD	CHANGED	
SHAPE		"	
FINISH		"	
TEMP.		"	
		"	

TITLE: FISCHER MOD. "J" GALV. & CONT. CURR. GEN. 15 POINT SWITCH SPACER

H. G. FISCHER & CO.
2335 WABANSIA AVE.
CHICAGO, ILL.

CAT. NO.

PART NO. 11148

1 FULL TURN – $\frac{11}{16}$" TRAVEL – CUT WITH $\frac{1}{4}$" END MILL – USE MILLING FIXTURE TOOL #6470

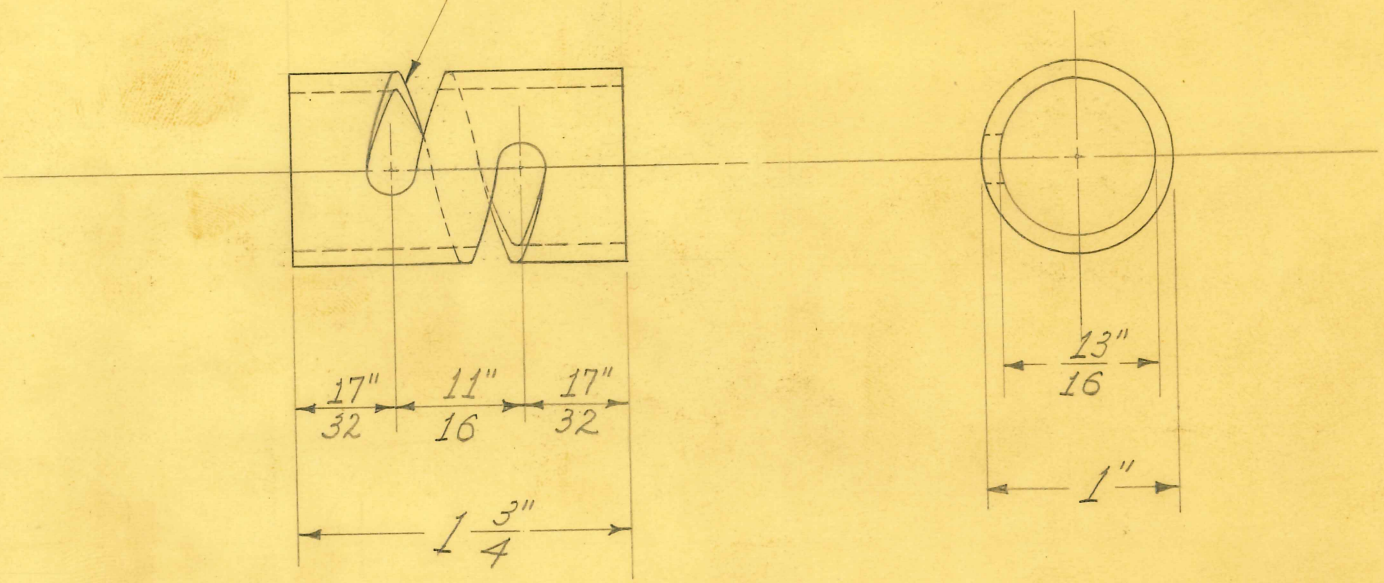

1 REQUIRED

OBSOLETE
4-22-80

SIZE	1" O.D. X $\frac{13}{16}$" I.D.	ISSUE 5-13-38	J.W.
KIND	BRASS TUBING	CHANGED	
SHAPE		"	
FINISH		"	
TEMP.		"	
PATT.		"	

TITLE: FISCHER MOD. "J" GALV. & CONT. CURR. GEN. SURGE UNIT – VARIABLE SURGE REG. SPIRAL CAM

H. G. FISCHER & CO.
2335 WABANSIA AVE.
CHICAGO, ILL.

CAT. NO.

PART NO. 11163

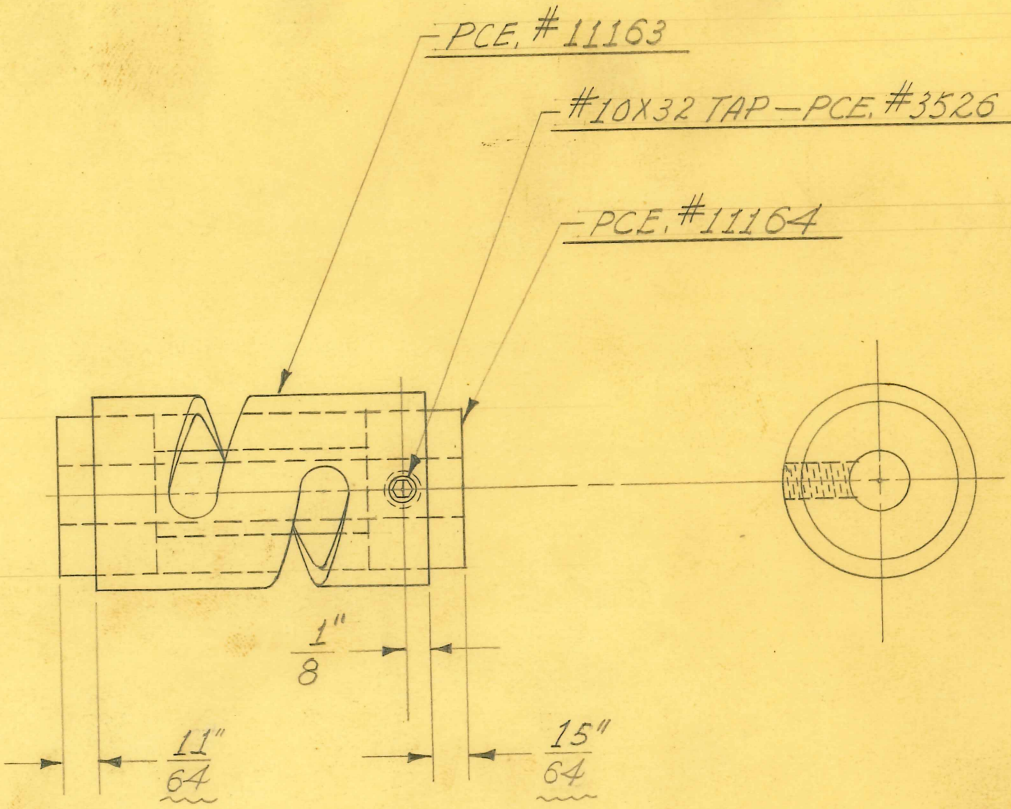

1 REQUIRED

OBSOLETE
4-22-80

SIZE		ISSUE 5-16-38	J.W.	**TITLE:** FISCHER MOD. J" GALV. & CONT. CURR. GEN. SURGE UNIT-VARIABLE SURGE REG. SPIRAL CAM ASSEMBLY
KIND		CHANGED 9-26-38	J.W.	
SHAPE		per C.M. " 12-6-38	J.W.	
FINISH		"		
TEMP.		"		
PATT.		"		

H. G. FISCHER & CO.
2335 WABANSIA AVE.
CHICAGO, ILL.

CAT. NO.

PART NO. 11163G

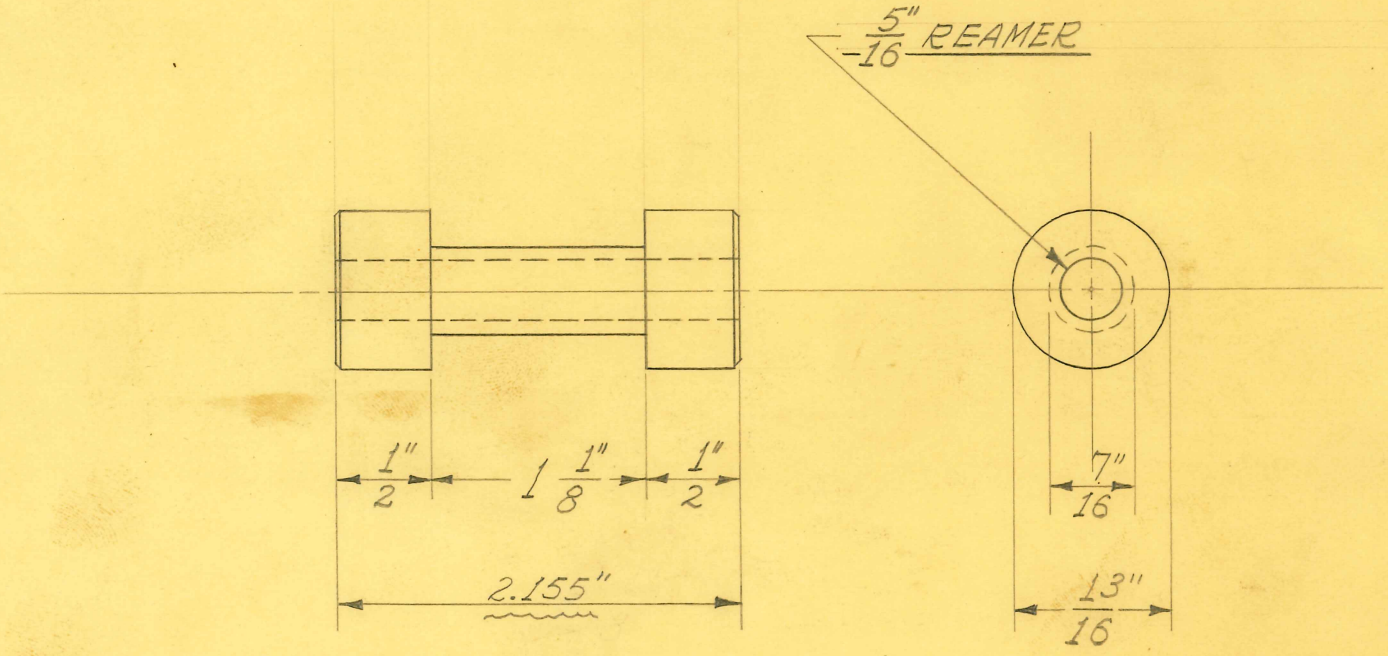

1 REQUIRED

OBSOLETE
4-22-80

SIZE	13/16" DIAM.	ISSUE 5-13-38	J.W.	**TITLE:** FISCHER MOD. "J" GALV. & CONT. CURR. GEN. SURGE UNIT - VARIABLE SURGE REG. SPIRAL CAM BUSHING
KIND	BRASS ROD	CHANGED 9-26-38	J.W.	
SHAPE		"		
FINISH		"		
TEMP.		"		
PATT.		"		

H. G. FISCHER & CO.
2335 WABANSIA AVE.
CHICAGO, ILL.

CAT. NO.

PART NO. 11164

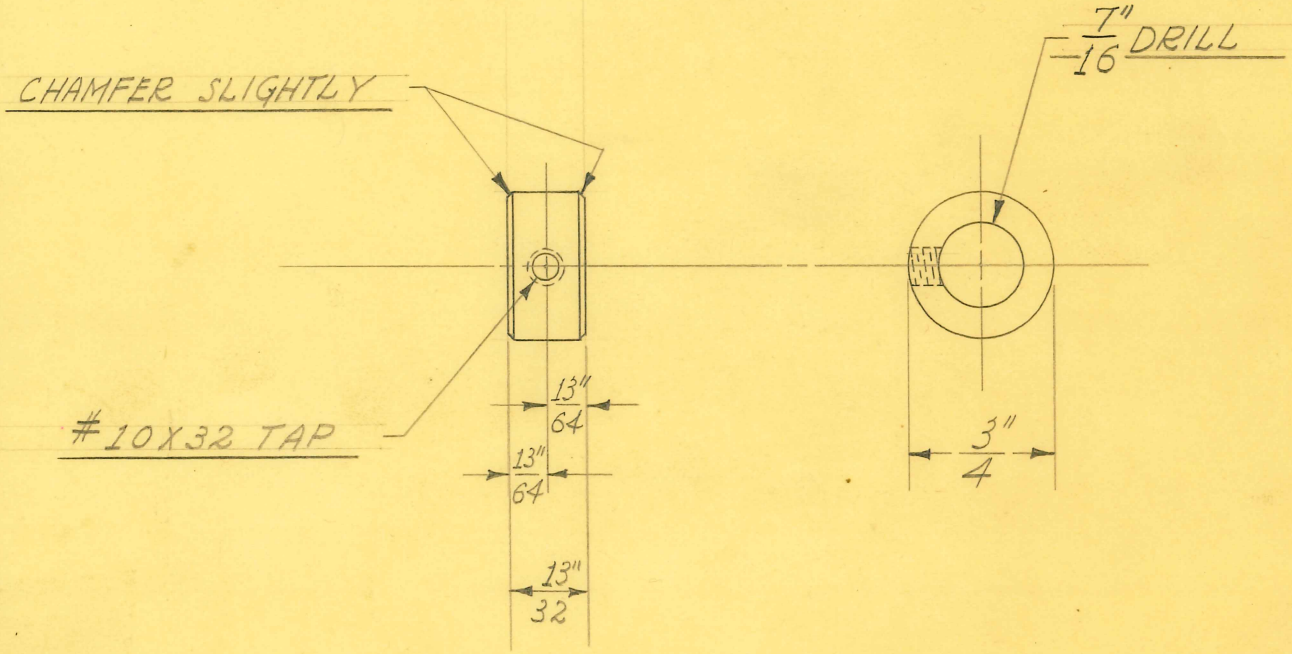

1 REQUIRED

OBSOLETE
4-22-80

SIZE	3/4" DIAM.	ISSUE 5-12-38	J.W.	**TITLE:** FISCHER MOD. "J" GALV. & CONT. CURR. GEN. SURGE UNIT - COLLECTOR RING SHAFT CLAMP RING
KIND	C.R. STEEL	CHANGED		
SHAPE	ROD	"		
FINISH		"		
TEMP.		"		
PATT.		"		

H. G. FISCHER & CO.
2335 WABANSIA AVE.
CHICAGO, ILL.

CAT. NO.

PART NO. 11167

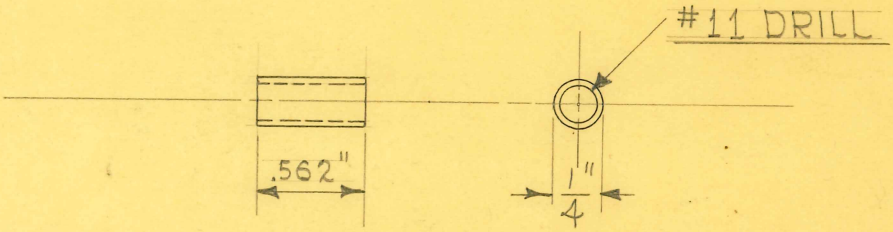

1 REQUIRED

OBSOLETE
4-22-80

SIZE	1/4" DIAM.	ISSUE 5-13-38	A.E.
KIND	C.R. STEEL	CHANGED	
SHAPE		"	
FINISH		"	
TEMP.		"	
PATT.		"	

TITLE:
FISCHER MOD. "J" GALV. & CONT. CURR. GEN.-
SURGE UNIT-FRICTION RING REG. ARM CONN.
LINK SWIVEL BUSHING

H. G. FISCHER & CO.
2335 WABANSIA AVE.
CHICAGO, ILL.

CAT. NO.

PART NO. 11173

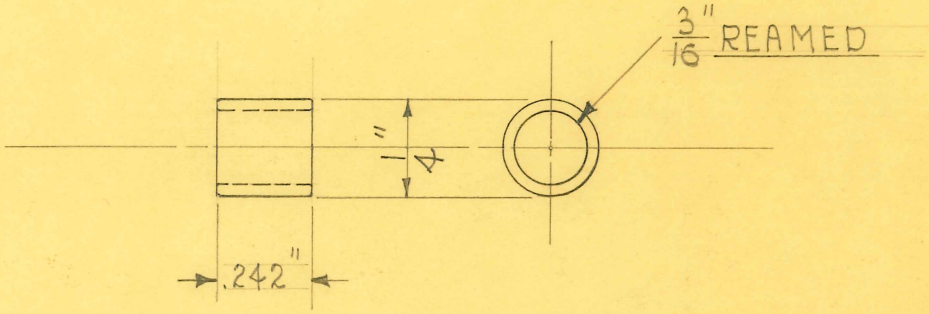

1 REQUIRED

SCALE ~ 1" = 1/2"

OBSOLETE

4-22-80

SIZE	1/4" DIAM.	ISSUE 5-16-38	A.E.
KIND	C.R. STEEL	CHANGED	
SHAPE		"	
FINISH		"	
TEMP.		"	
PATT.		"	

TITLE: FISCHER MOD. "J" GALV. & CONT. CURR. GEN.- SURGE UNIT-FRICTION RING REG. ARM CONN. LINK-SPIRAL CAM FOLLOWER ROLLER

H. G. FISCHER & CO.
2335 WABANSIA AVE.
CHICAGO, ILL.

CAT. NO.

PART NO. 11176

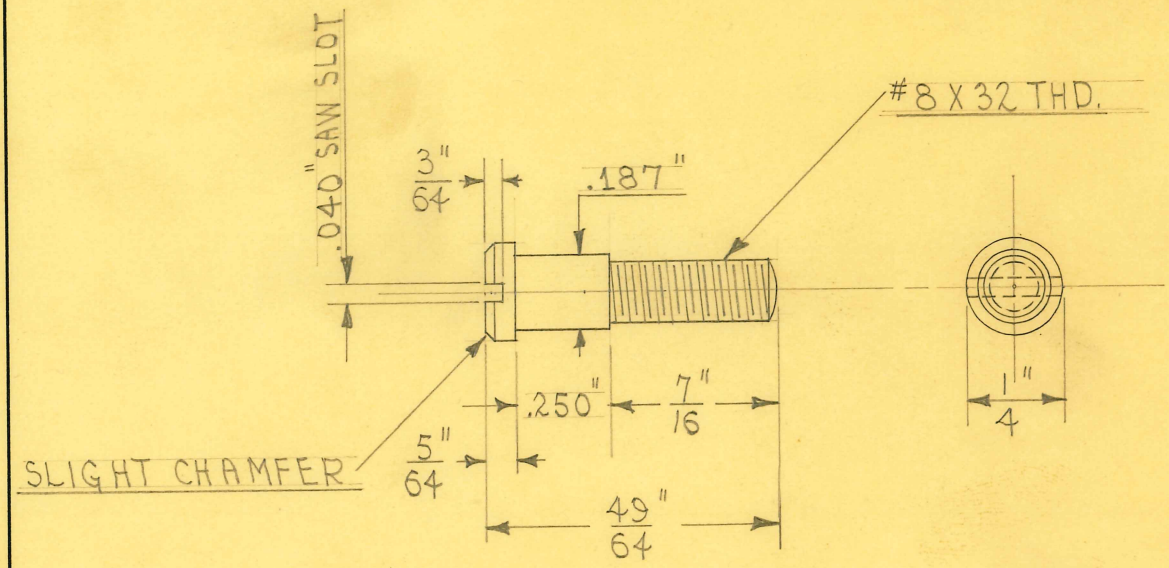

SCALE ≈ 1" = 1/2"

1 REQUIRED

OBSOLETE
4-22-80

SIZE	1/4" DIAM.	ISSUE 5-16-38	A.E.
KIND	C.R. STEEL	CHANGED	
SHAPE		"	
FINISH		"	
TEMP.		"	
PATT.		"	

TITLE: FISCHER MOD. "J" GALV. & CONT. CURR. GEN.- SURGE UNIT-FRICTION RING REG. ARM CONN. LINK SPIRAL CAM FOLLOWER SCREW

H. G. FISCHER & CO.
2335 WABANSIA AVE.
CHICAGO, ILL.

CAT. NO.

PART NO. 11176 1/2

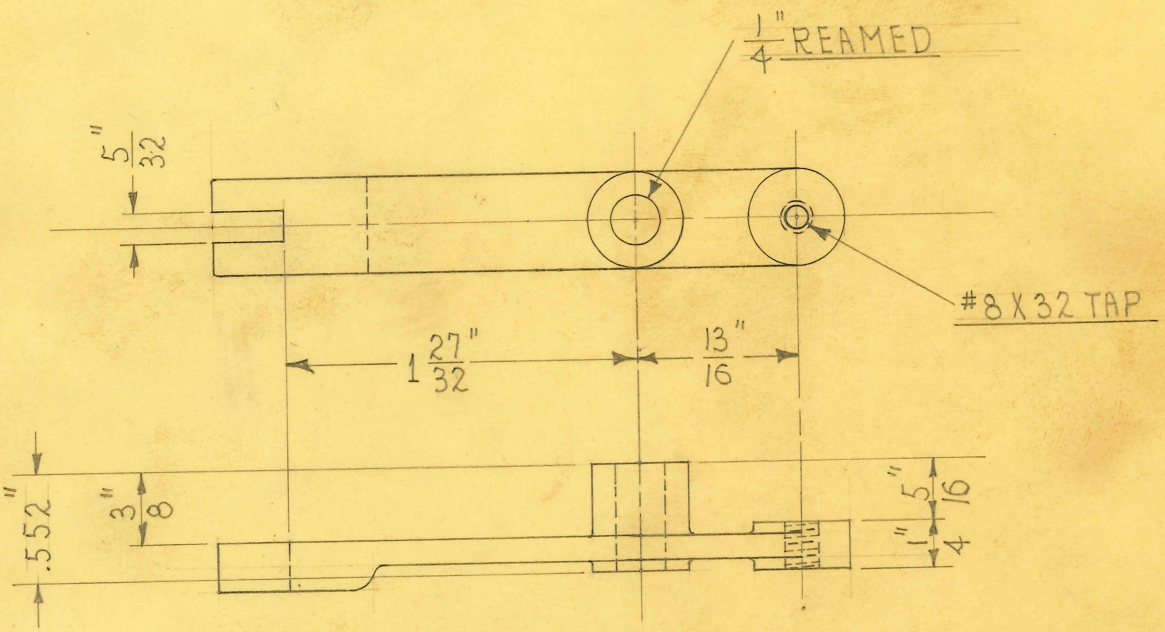

1 REQUIRED

OBSOLETE
4-12-80

SIZE		ISSUE 5-16-38	A.E.
KIND	BRASS CASTING	CHANGED	
SHAPE		"	
FINISH	DIP #7	"	
TEMP.		"	
PATT.	1222	"	

TITLE: FISCHER MOD. "J" GALV. & CONT. CURR. GEN.-SURGE UNIT-FRICTION RING REGULATOR ARM CONN. LINK

H. G. FISCHER & CO.
2335 WABANSIA AVE.
CHICAGO, ILL.

CAT. NO.

PART NO. 11177F

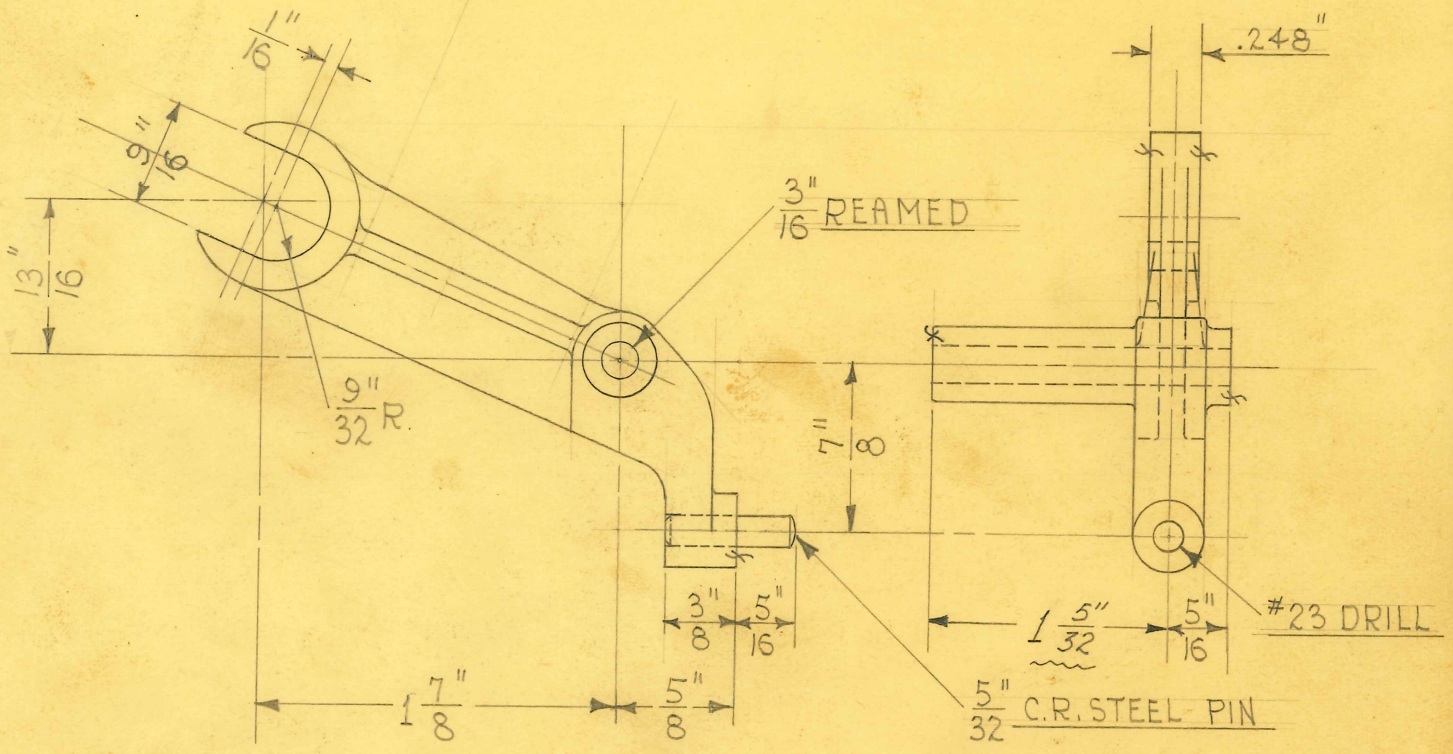

1 REQUIRED

OBSOLETE
4-22-80

SIZE		ISSUE 5-13-38	A.E.
KIND	BRASS CASTING	CHANGED	
SHAPE		"	
FINISH		"	
TEMP.		"	
PATT.	1221	"	

TITLE: FISCHER MOD. "J" GALV. & CONT. CURR. GEN.- SURGE UNIT FRICTION RING REGULATOR ARM

H. G. FISCHER & CO.
2335 WABANSIA AVE.
CHICAGO, ILL.

CAT. NO.

PART NO. 11178GF

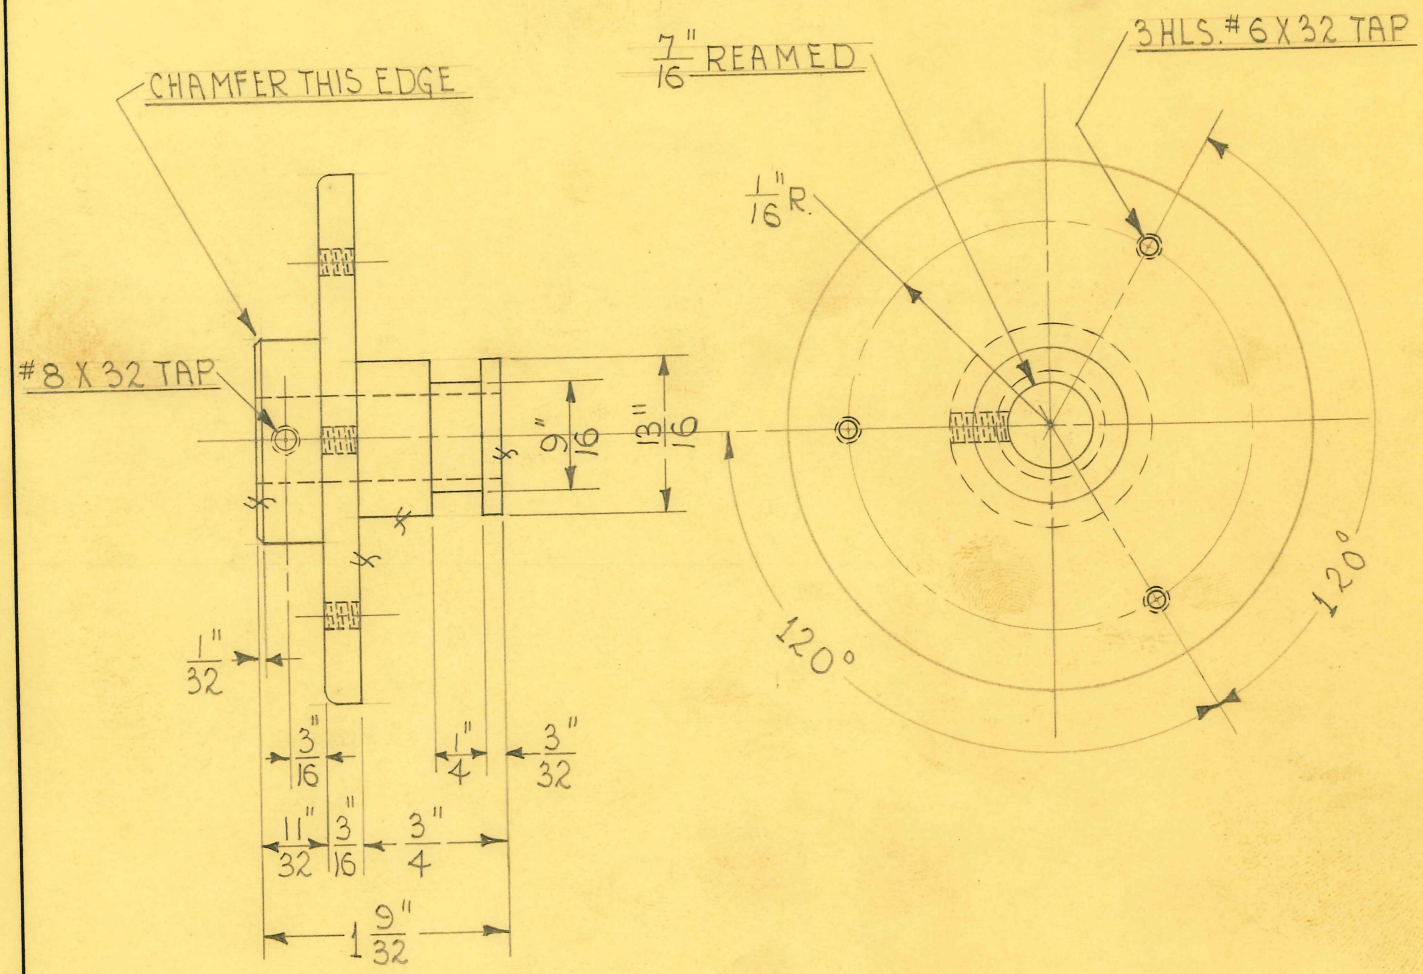

1 REQUIRED

OBSOLETE
4-22-80

SIZE		ISSUE 5-11-38	A.E.
KIND	IRON CASTING	CHANGED	
SHAPE		"	
FINISH	BLACK #80	"	
TEMP.		"	
PATT.	1219	"	

TITLE: FISCHER MOD. "J" GALY. & CONT. CURR. GEN.- SURGE UNIT RUBBER RING SUPPORT

H. G. FISCHER & CO.
2335 WABANSIA AVE.
CHICAGO, ILL.

CAT. NO.

PART NO. 11181 F

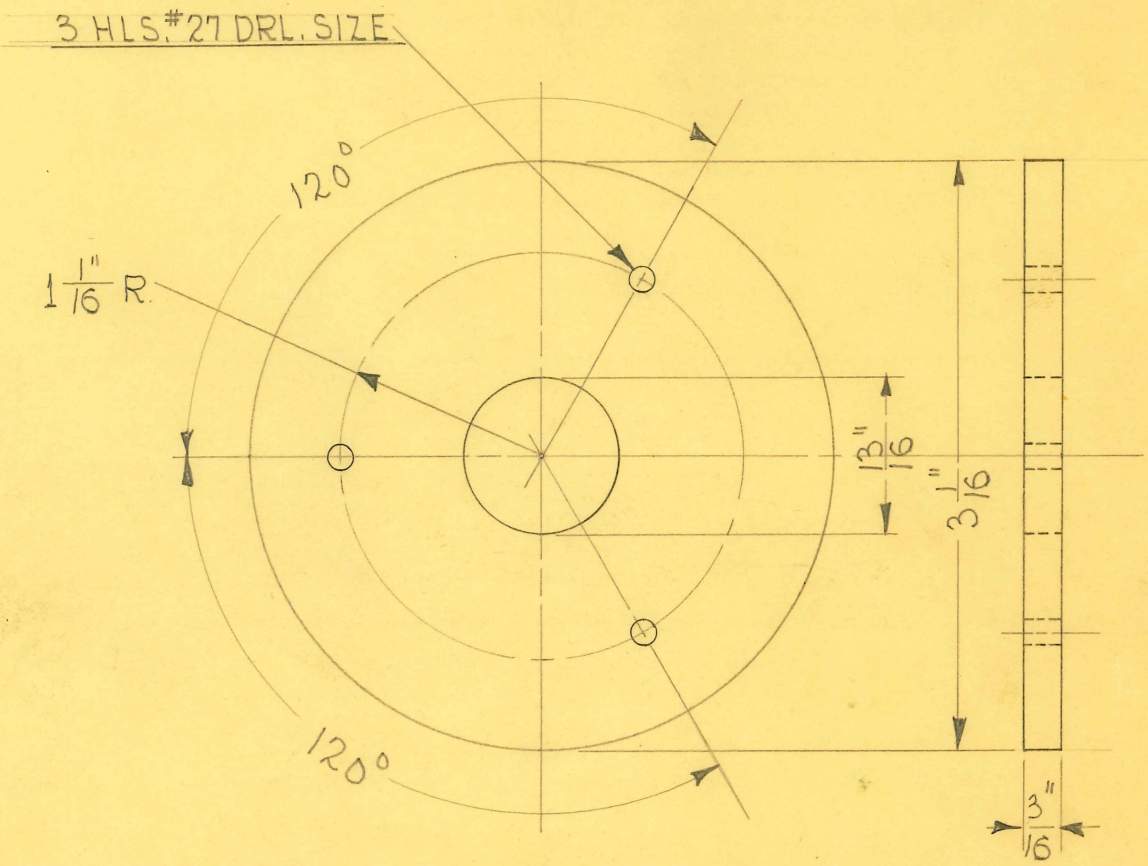

1 REQUIRED

OBSOLETE
4-22-80

SIZE	3/16" PARA GUM	ISSUE 5-11-38	A.E.
KIND	SOFT SHEET	CHANGED	
SHAPE	RUBBER	"	
FINISH		"	
TEMP.		"	
PATT.		"	

TITLE: FISCHER MOD. "J" GALV. & CONT. CURR. GEN. - SURGE UNIT RUBBER RING

H. G. FISCHER & CO.
2335 WABANSIA AVE.
CHICAGO, ILL.

CAT. NO.

PART NO. 11182

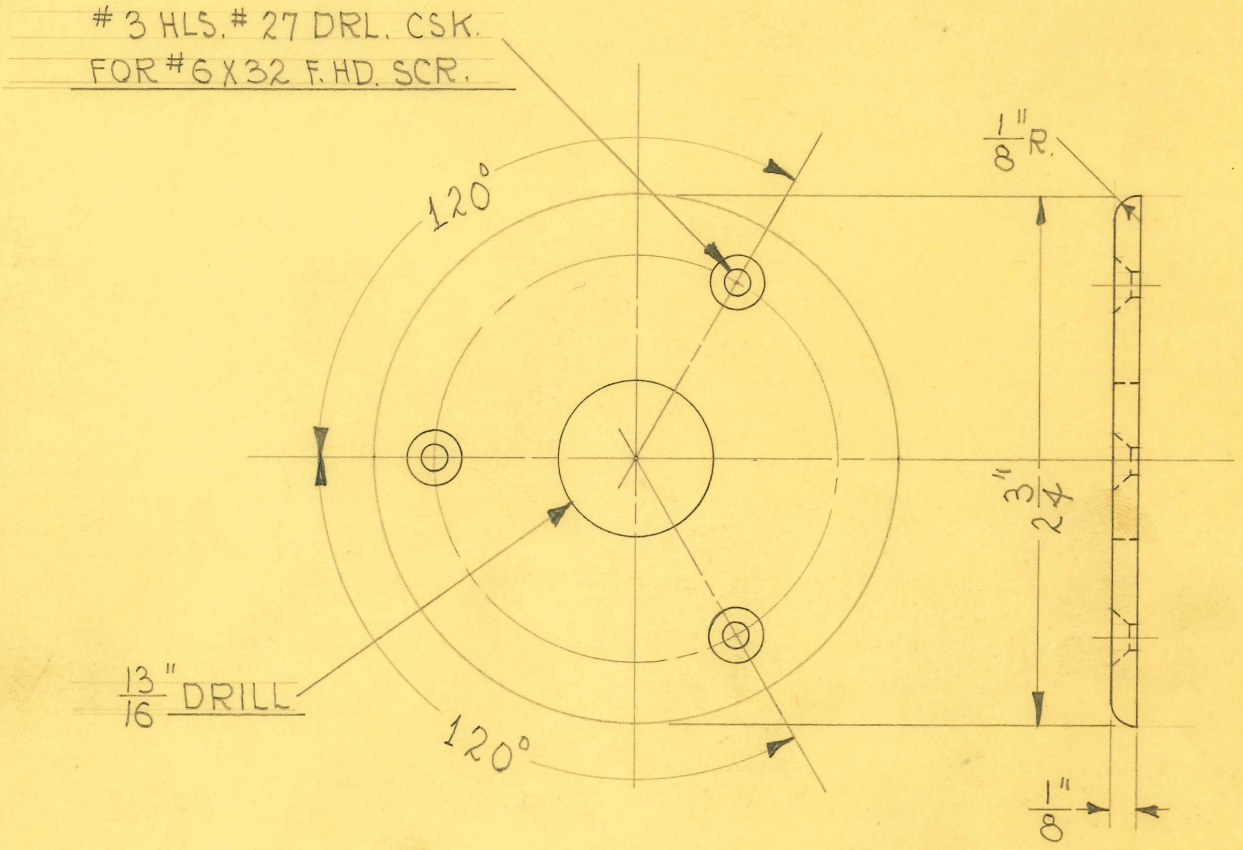

1 REQUIRED

OBSOLETE
4-22-80

SIZE	1/8" SHEET	ISSUE 5-11-38	A.E.
KIND	BRASS	CHANGED	
SHAPE		"	
FINISH	DIP #7	"	
TEMP.		"	
PATT.		"	

TITLE: FISCHER MOD. "J" GALV. & CONT. CURR. GEN.- SURGE UNIT-RUBBER RING CLAMP DISC.

H. G. FISCHER & CO.
2335 WABANSIA AVE.
CHICAGO, ILL.

CAT. NO.

PART NO. 11183

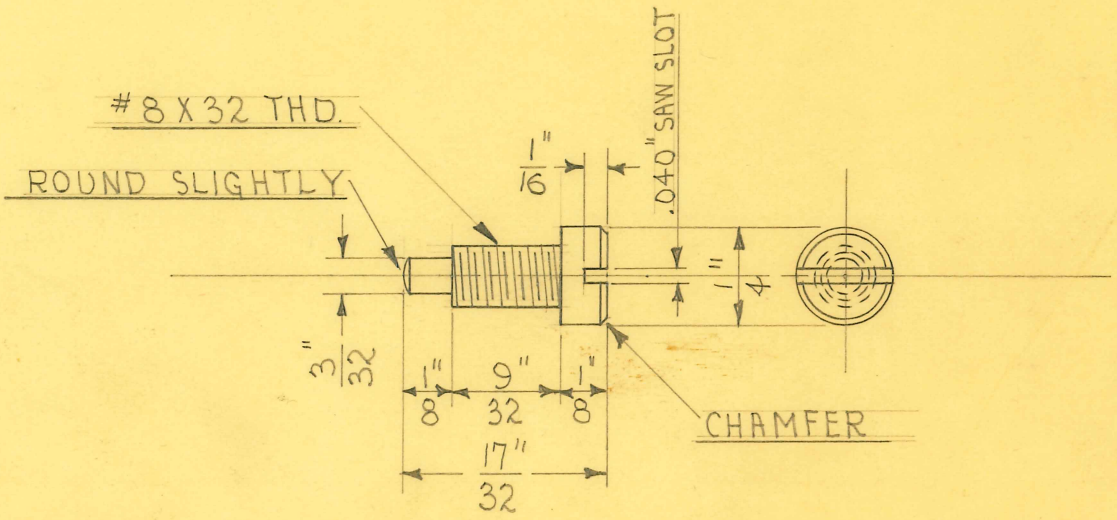

SCALE ~ 1" = 1/2"

1 REQUIRED

OBSOLETE
4-22-80

SIZE	1/4" DIAM.	ISSUE 5-12-38	J.E.
KIND	DRILL ROD	CHANGED	
SHAPE		"	
FINISH		"	
TEMP.		"	
PATT.		"	

TITLE: FISCHER MOD. "J" GALV. & CONT. CURR. GEN. - SURGE UNIT - RUBBER RING SUPP. SET SCREW

H. G. FISCHER & CO.
2335 WABANSIA AVE.
CHICAGO, ILL.

CAT. NO.

PART NO. 11184

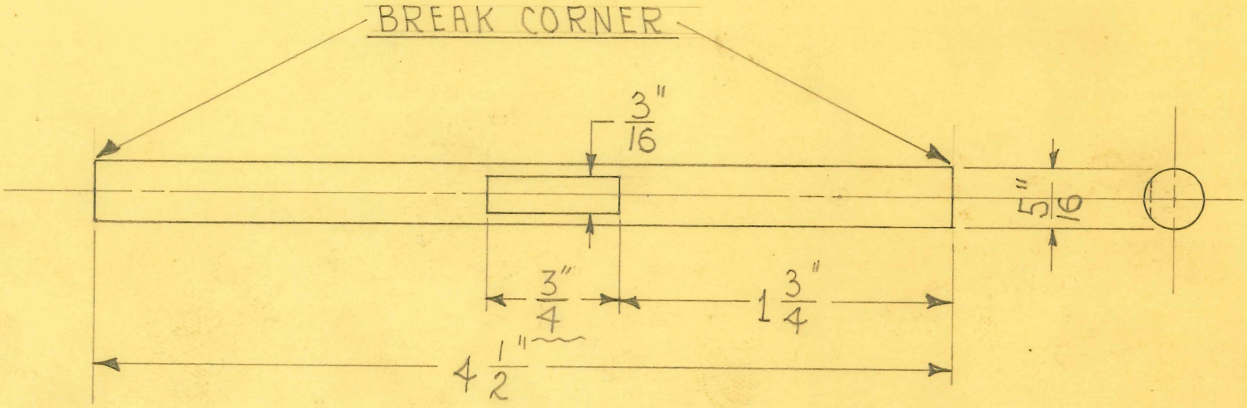

1 REQUIRED

OBSOLETE
4-22-80

SIZE	5/16" DIAM.	ISSUE 5-12-38	A.E.
KIND	C.R. STEEL	CHANGED	
SHAPE		"	
FINISH		"	
TEMP.		"	
PATT.		"	

TITLE: FISCHER MOD. "J" GALV. & CONT. CURR. GEN. - SURGE UNIT FRICTION DISC SHAFT

H. G. FISCHER & CO.
2335 WABANSIA AVE.
CHICAGO, ILL.

CAT. NO.

PART NO. 11186

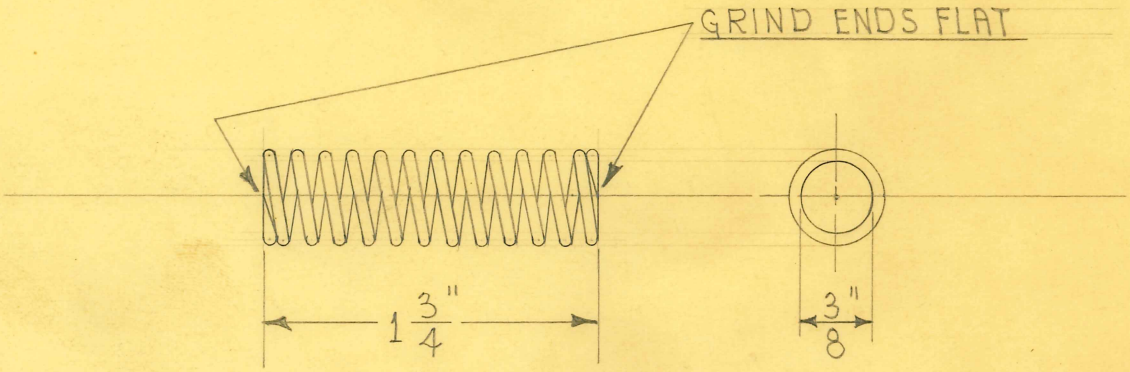

13 TURNS

1 REQUIRED

OBSOLETE

4-22-80

SIZE	.049"	ISSUE 5-12-38	A.E.
KIND	MUSIC WIRE	CHANGED	
SHAPE		"	
FINISH		"	
TEMP.		"	
PATT.		"	

TITLE: FISCHER MOD. "J" GALV. & CONT. CURR. GEN.- SURGE UNIT - FRICTION DISC SPRING

H. G. FISCHER & CO.
2335 WABANSIA AVE.
CHICAGO, ILL.

CAT. NO.

PART NO. 11187

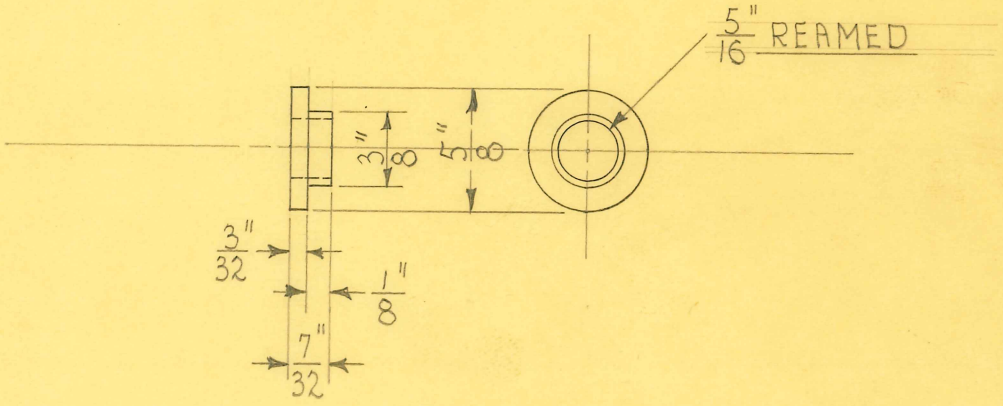

1 REQUIRED

OBSOLETE
4-22-80

SIZE	5/8" DIAM.	ISSUE 5-12-38	H.E.
KIND	C.R. STEEL	CHANGED	
SHAPE		"	
FINISH		"	
TEMP.		"	
PATT.		"	

TITLE: FISCHER MOD. "J" GALV. & CONT. CURR. GEN.-SURGE UNIT FRICTION DISC SPRING BUSHING

H. G. FISCHER & CO.
2335 WABANSIA AVE.
CHICAGO, ILL.

CAT. NO.

PART NO. 11188

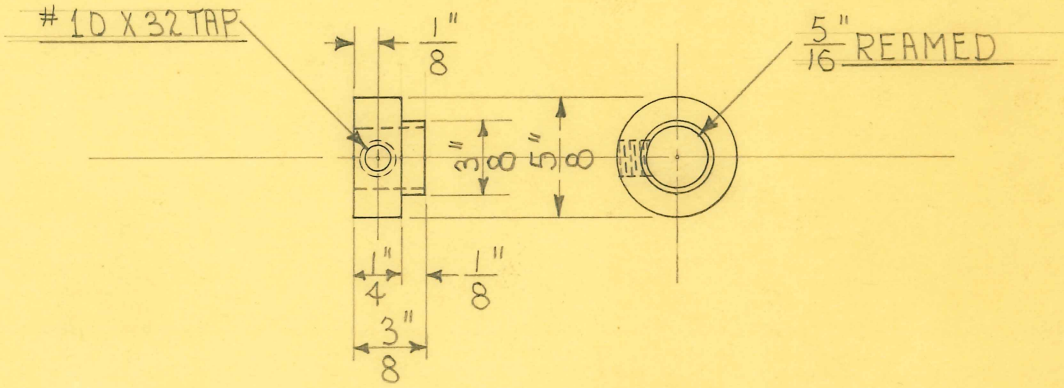

1 REQUIRED

OBSOLETE
4-22-80

SIZE	5/8" DIAM.	ISSUE 5-12-38	J.E.
KIND	C.R. STEEL	CHANGED	
SHAPE		"	
FINISH		"	
TEMP.		"	
PATT.		"	

TITLE: FISCHER MOD. "J" GALV. & CONT. CURR. GEN.-SURGE UNIT - FRICTION DISC SPG. TENSION BUSHING

H. G. FISCHER & CO.
2335 WABANSIA AVE.
CHICAGO, ILL.

CAT. NO.

PART NO. 11189

TITLE
DIA. PRECISION CONTROL UNIT
NAME PLATE

H. G. FISCHER & CO.
FRANKLIN PARK, ILLINOIS

PART NO. 6624B

DATE 1-19-50 DR. BY W.J. CH'K'D. J.V.W.

REVISION	DATE	BY

PATTERN | FINISH | SCALE FULL

TOOLS | MATERIAL 23 GA. (.022") SHEET ALUM.

DIMENSIONS UNLESS OTHERWISE SPECIFIED
FRACTIONAL ± .015
DECIMAL ± .005
ANGULAR ± ½°

EMBLEMS ARE MINIATURE
OF CROWE-PLATE FISCHER
NO 18506

4 HLS. #50 DRILL

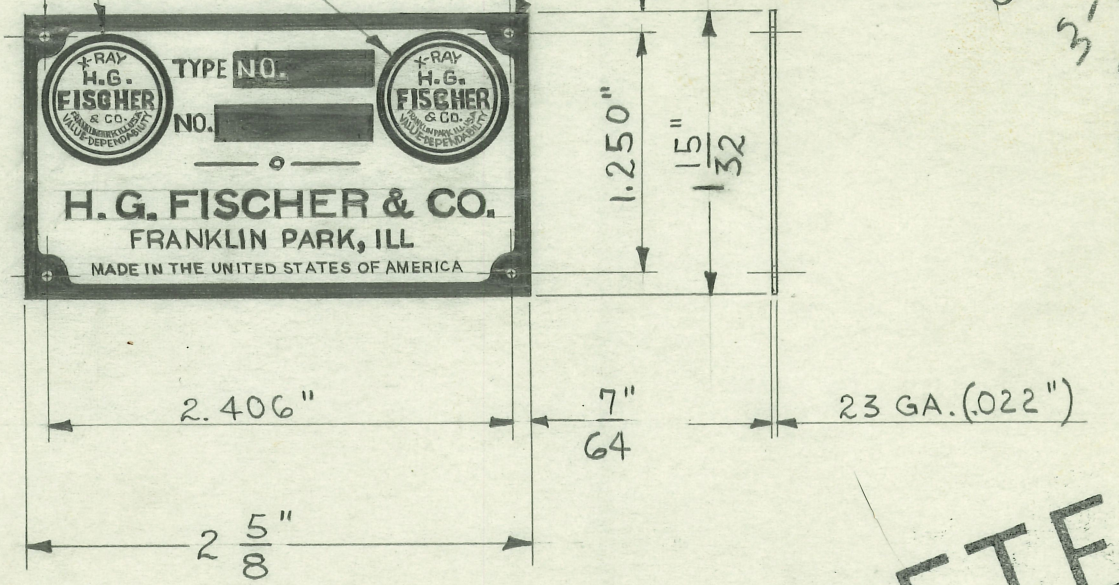

Obsolete
3-21-51

NOTE:
ETCHED - #270 FINISH
BLACK BACKGROUND

OBSOLETE

TITLE FISCHER MOD. "400" DELUXE DIATHERMY NAME PLATE	H. G. FISCHER & CO. FRANKLIN PARK, ILLINOIS		PART NO. 16437B
	DATE 12-4-51	DR. BY W.J.	CH'K'D. J.V.W.
PATTERN	FINISH SEE NOTE	SCALE FULL	DIMENSIONS: FRACTIONAL ± .015; DECIMAL ± .005; ANGULAR ± ½°; UNLESS OTHERWISE SPECIFIED
TOOLS	MATERIAL .031" SHEET BRASS		

REVISION		DATE	BY
A	WAS CHANGED	7-13-54	W.J.

1 REQUIRED

(A)

REHABILITATION EQUIPMENT WAS (VALUE – DEPENDABILITY)

LETTERS & BORDER SATIN CHROME. BACK-GROUND BLACK ENAMEL

2 1/8"

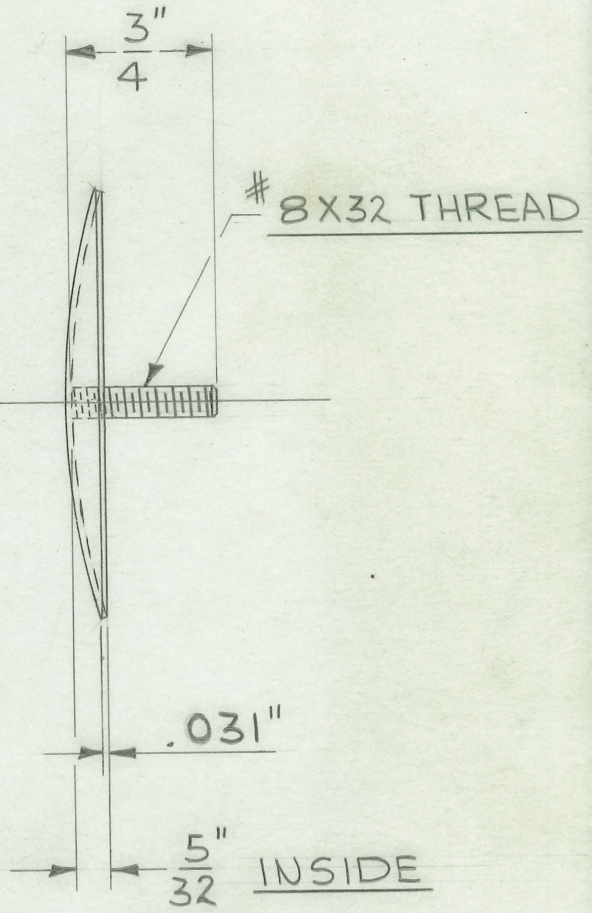

FOLDER #128

#8X32X$\frac{3}{4}$" FLAT HEAD SCREW

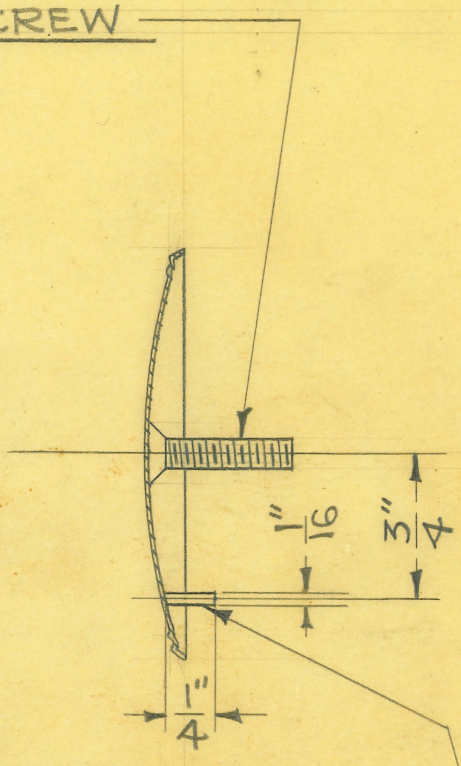

THIS PIN MUST BE BRAZED IN SUCH A POSITION THAT THE FISCHER NAME SLANTS UPWARD AND THE UP AND DOWN PORTIONS OF THE LETTERS SUCH AS "F-I-H AND R" ARE IN THE VERTICAL PLANE AS SHOWN

OBSOLETE

SIZE		ISSUE 12-28-45	J.V.W.	**TITLE:** FISCHER TRADEMARK NAME PLATE PART NO. 3398A - BLUE NO. 3399A - RED
KIND		CHANGED		
SHAPE		"		
FINISH		"		
TEMP.		"		
PATT.		"		

H. G. FISCHER & CO. 2335 WABANSIA AVE. CHICAGO. ILL.	CAT. NO.	PART NO. 3398A 3399A

TITLE

SERIAL NO. PLATE

H. G. FISCHER & CO.
FRANKLIN PARK, ILLINOIS

PART NO. 3259 1/2 E

DATE 3-16-51 | DR. BY J.V.W. | CH'K'D.

REVISION		DATE	BY
A	WAS CHANGED	7-13-54	W.J.

PATTERN | FINISH SEE NOTE | SCALE FULL

TOOLS | MATERIAL .005" TO .010" SHEET ALUMINUM

DIMENSIONS UNLESS OTHERWISE SPECIFIED
FRACTIONAL ± .015
DECIMAL ± .005
ANGULAR ± ½°

Obsolete

FINISH

LETTERING, RECTANGULAR BLOCKS & BORDER – BRIGHT ANODIZED ALUMINUM
BACKGROUND – BLACK ANODIZED

THIS EMBLEM PER SAMPLE TO BE FURNISHED BY H.G. FISCHER & CO.

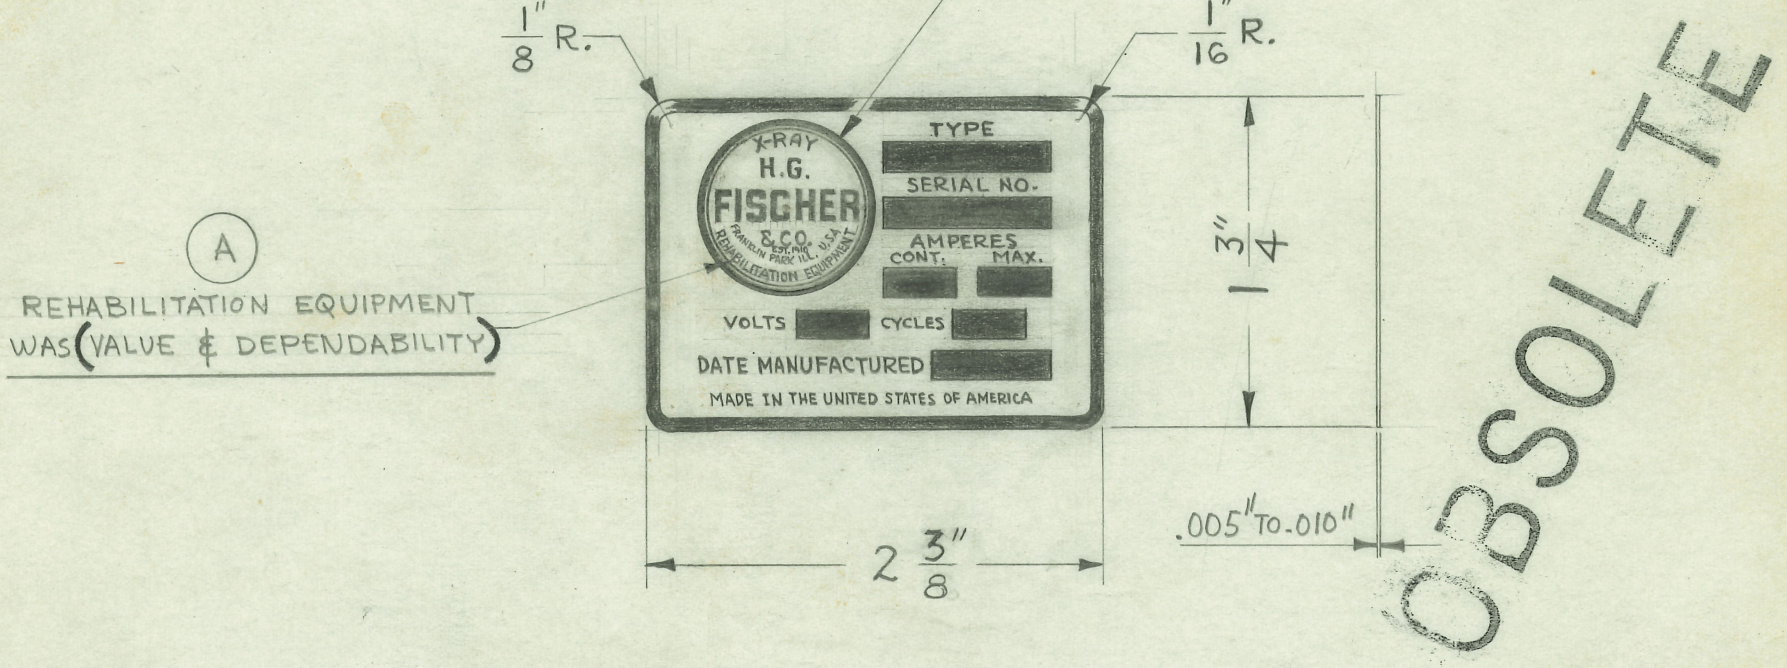

OBSOLETE

SELF ADHERING ADHESIVE BACKED (WITH WATER LOOSENING CELLOPHANE PROTECTIVE FILM)

TITLE: FISCHER STICK ON EMBLEM

H. G. FISCHER & CO.
FRANKLIN PARK, ILLINOIS

16481A

DATE 7-9-54 | DR BY W.J. | CH'K'D.

REVISION	DATE	BY
A WAS CHANGED	7-13-54	W.J.

PATTERN | FINISH SEE NOTE | SCALE FULL

TOOLS | MATERIAL .005" TO .010" SHEET ALUMINUM

DIMENSIONS UNLESS OTHERWISE SPECIFIED
FRACTIONAL ± .015
DECIMAL ± .005
ANGULAR ± ½°

SELF ADHERING ADHESIVE BACKED (WITH WATER LOOSENING CELLOPHANE PROTECTIVE FILM)

(A) REHABILITATION EQUIPMENT WAS (VALUE - DEPENDABILITY)

LETTERS & BORDER
SATIN CHROME. BACKGROUND
BLACK ENAMEL

1 1/4"

.005" TO .010"

FOLDER #128

TITLE SERIAL NO. PLATE

H. G. FISCHER & CO.
FRANKLIN PARK, ILLINOIS

PART NO. 3259½C

DATE 1-2-51 DR. BY J.N.W. CH'K'D. [illegible]

REVISION	DATE	BY

PATTERN | FINISH | SCALE FULL

TOOLS | MATERIAL #24GA.(.020") SHEET ALUMINUM

DIMENSIONS
FRACTIONAL ± .015
DECIMAL ± .005
ANGULAR ± ½°
UNLESS OTHERWISE SPECIFIED

THIS EMBLEM IS MINIATURE
OF CROWE PLATE
FISCHER NO. 18506

ETCHED #270 FINISH
BLACK BACKGROUND

4 HLS.-#50 DRILL

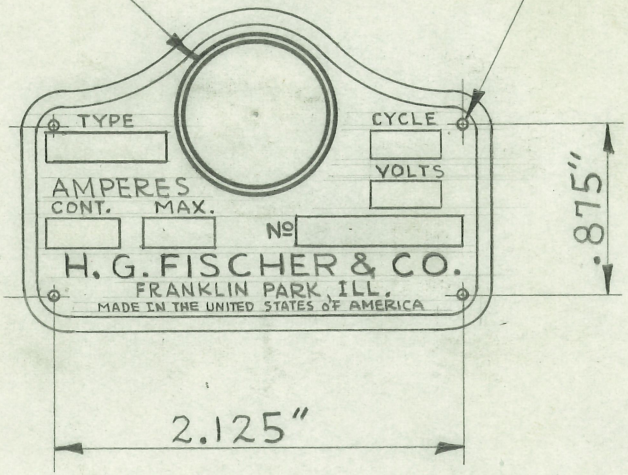

OBSOLETE

obsolete
3-21-51

TITLE NAME PLATE

H. G. FISCHER & CO.
FRANKLIN PARK, ILLINOIS

PART NO. 3259 1/2B

DATE 1-9-50 | DR. BY W.J. | CH'K'D. J.V.W.

REVISION	DATE	BY

PATTERN | FINISH | SCALE FULL

TOOLS | MATERIAL 24 GA. (.020") SHEET ALUM.

DIMENSIONS
FRACTIONAL ± .015
DECIMAL ± .005
ANGULAR ± ½°
UNLESS OTHERWISE SPECIFIED

THIS EMBLEM IS MINIATURE OF CROWE-PLATE FISCHER NO. 18506

4 HLS. #50 DRILL

Obsolete 1-2-51

INCREASE SIZE OF RECTANGLE TO $\frac{1}{2}$" LENGTH

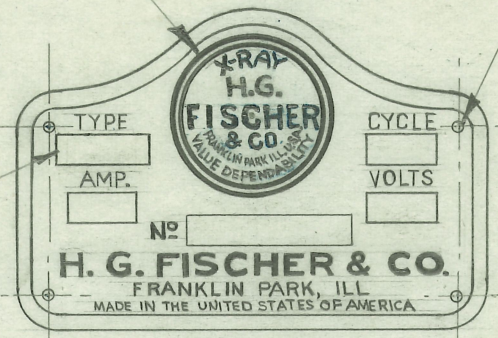

.875"

2.125"

24 GA. (.020")

ETCHED - #270 FINISH

BLACK BACKGROUND

OBSOLETE

TITLE

SERIAL NO. PLATE

H. G. FISCHER & CO.
FRANKLIN PARK, ILLINOIS

PART NO. 3259 1/2 F

DATE 12-5-57 | DR BY J.V.W. | CH'K'D.

REVISION	DATE	BY

PATTERN | FINISH SEE NOTE | SCALE FULL

TOOLS | MATERIAL FOIL ALUMINUM

DIMENSIONS
FRACTIONAL ± .015
DECIMAL ± .005
ANGULAR ± ½°
UNLESS OTHERWISE SPECIFIED

USED ON	QTY
32760GT	1

WORDING, RECTANGULAR BLOCKS, & BORDER - POLISHED ANODIZED ALUMINUM, BACKGROUND - BLACK ANODIZED.

THIS EMBLEM PER SAMPLE FUNISHED BY H.G.F. & CO.

1" / 8 R. ON 4 CORNERS

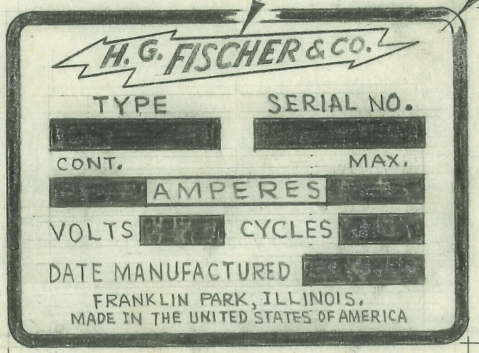

3" / 4

2 3" / 8

.003" TO .005"

Obsolete see revision A Redrawn E.C.O. 1096

SELF ADHERING ADHESIVE BACKED (WITH WATER LOOSENING CELLOPHANE PROTECTIVE FILM)

FOLDER # 45

TITLE: NAME PLATE	H. G. FISCHER & CO. FRANKLIN PARK, ILLINOIS		PART NO. 3259 1/2 A
	DATE 11-23-48	DR. BY W.J.	CH'K'D. J.V.W.
PATTERN	FINISH	SCALE FULL	DIMENSIONS: FRACTIONAL ± .015; DECIMAL ± .005; ANGULAR ± ½°; UNLESS OTHERWISE SPECIFIED
TOOLS	MATERIAL: 24 GA.(.020") SHEET ALUM.		

REVISION	DATE	BY

X X Obsolete
1-12-50 W.J.

OBSOLETE

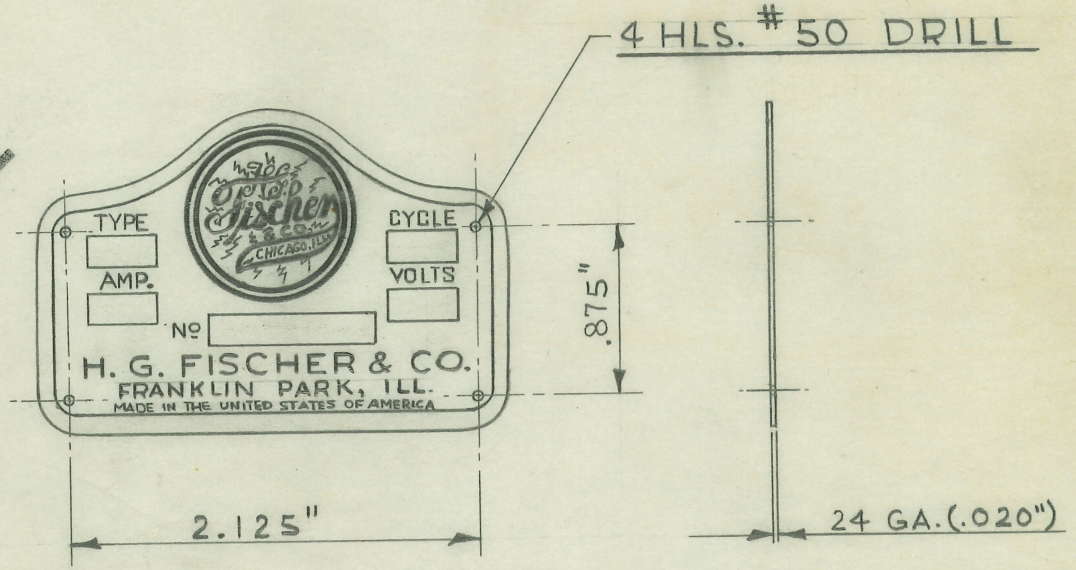

TITLE	H. G. FISCHER & CO. FRANKLIN PARK, ILLINOIS	PART NO.
SERIAL NO. PLATE		3259½

DATE	DR. BY	CH'K'D.
4/16/71	AHP	

PATTERN	FINISH	SCALE
	SEE NOTE	FULL

MATERIAL: FOIL ALUMINUM

TOOLS:

DIMENSIONS—UNLESS OTHERWISE SPECIFIED:
FRACTIONAL ± .015
DECIMAL ± .005
ANGULAR ± 1/2°
THREAD CHAMFER
UP TO 5/16 D. - 1/32 X 45°
3/8 D. & OVER - 1/16 X 45°
REMOVE ALL BURRS & SHARP CORNERS

USED ON	QTY.	USED ON	QTY.
32760GT	1	28248G	1
28247G	1		

	REVISION	DATE	BY
A	REDESIGNED & REDRAWN ECO 1096	4-16-71	AHP

NOTE: WORDING, RECTANGULAR BLOCKS & BORDER - POLISHED ANODIZED ALUMINUM
BACKGROUND - BLACK ANODIZED

OBSOLETE
DATE 2/17/72
REFER TO REV. B
FOR DETAILS SEE E. C. O. # 1589
ENGINEER
DRAFTSMAN Andy P.

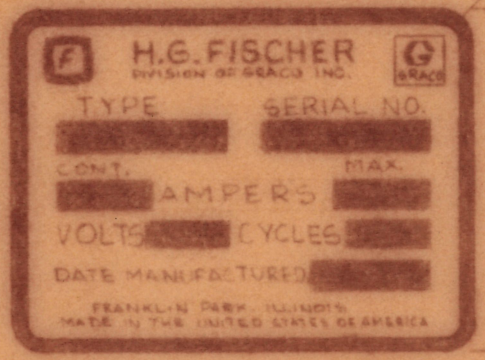

2 3/8

.003 TO .005

SELF ADHERING ADHESIVE BACKED (WITH WATER LOOSENING CELLOPHANE PROTECTIVE FILM)

DO NOT SCALE DRAWING.

TITLE: SERIAL NO. PLATE

H. G. FISCHER & CO.
FRANKLIN PARK, ILLINOIS

PART NO. 3259½

DATE 4/16/71 | DR. BY AHP | CH'K'D.

PATTERN | FINISH SEE NOTE | SCALE FULL

MATERIAL: FOIL ALUMINUM

TOOLS:

DIMENSIONS—UNLESS OTHERWISE SPECIFIED:
FRACTIONAL ± .015
DECIMAL ± .005
ANGULAR ± 1/2°
THREAD CHAMFER
UP TO 5/16 D. - 1/32 X 45°
3/8 D. & OVER - 1/16 X 45°
REMOVE ALL BURRS & SHARP CORNERS

USED ON	QTY.	USED ON	QTY.
3276DGT	1	2824BG	1
2824TG	1		

	REVISION	DATE	BY
A	REDESIGNED & REDRAWN ECO 1096	4-16-71	AHP
B	WAS AMPERS ECO 1589	2/11/72	AHP
C		4-24	MA

NOTE: WORDING, RECTANGULAR BLOCKS & BORDER - POLISHED ANODIZED ALUMINUM
BACKGROUND - BLACK ANODIZED

REDESIGNED & REDRAWN
ECO# 0457 6-17-75
R.R.

OBSOLETE
DATE.....
REFER TO.....
FOR DETAILS SEE E.C.O. #.....
ENGINEER.....
DRAFTSMAN.....

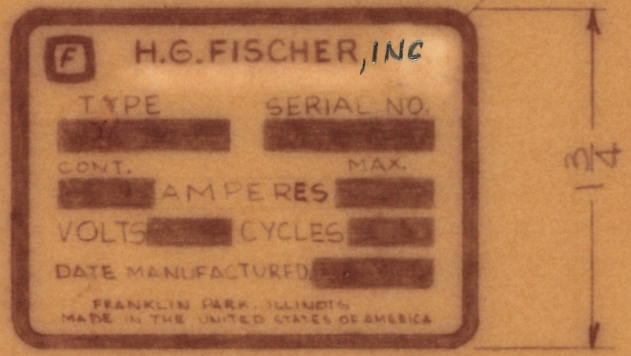

1/8 R, 4 CORNERS

1¼

2 3/8

.003 TO .005

OBSOLETE
R TO.....
ETAILS SEE E.C.O. #.....
NEER.....
N.....

SELF ADHERING - ADHESIVE BACKED 3M #467

DO NOT SCALE DRAWING.

TITLE
FISCHER NAME PLATE SPACER

H. G. FISCHER & CO.
FRANKLIN PARK, ILLINOIS

PART NO. 3396 1/2

DATE 1-31-55 | DR BY W.J. | CH'K'D. J.W.W.

REVISION	DATE	BY

PATTERN | FINISH | SCALE FULL

TOOLS | MATERIAL 1" 1/2 DIA. BRASS ROD

DIMENSIONS
FRACTIONAL ± .015
DECIMAL ± .005
ANGULAR ± 1/2°
UNLESS OTHERWISE SPECIFIED

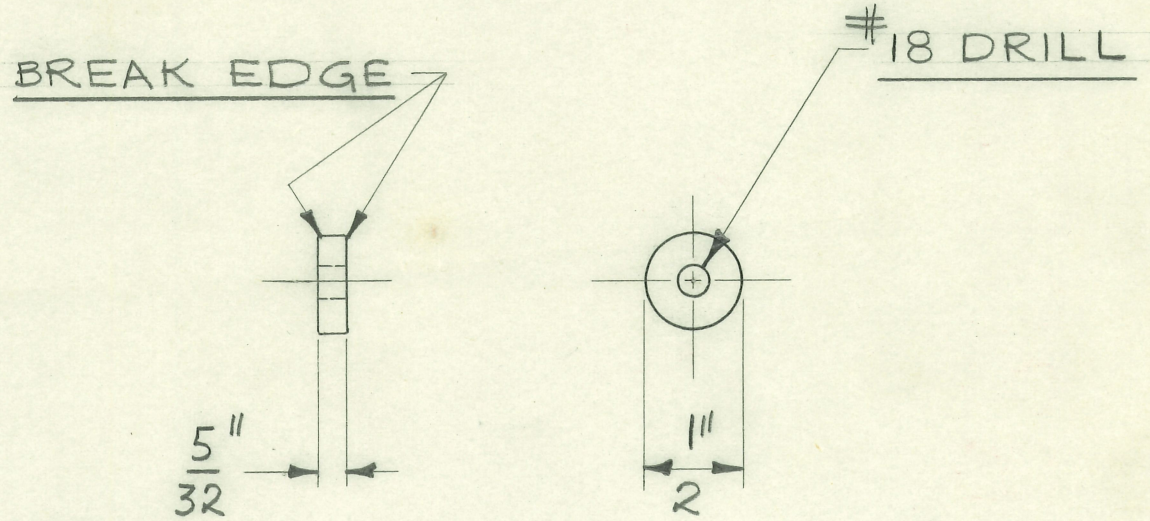

2 REQUIRED

OBSOLETE

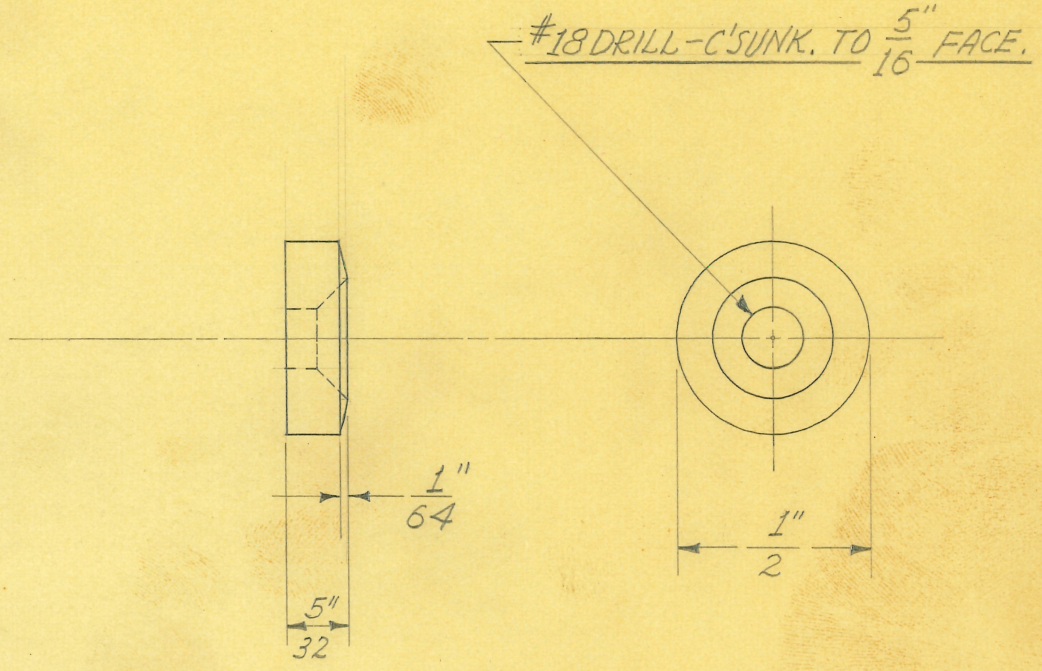

SCALE ~ 2 DIAMETERS

1 REQUIRED

OBSOLETE

SIZE	½" DIAM.	ISSUE 9-6-38	J.W.	TITLE: FISCHER TRADE MARK PLATE-SPACER
KIND	BRASS ROD	CHANGED		
SHAPE		"		
FINISH		"		
TEMP.		"		
PATT.		"		

H. G. FISCHER & CO.
2335 WABANSIA AVE.
CHICAGO, ILL.

CAT. NO.

PART NO. 3396

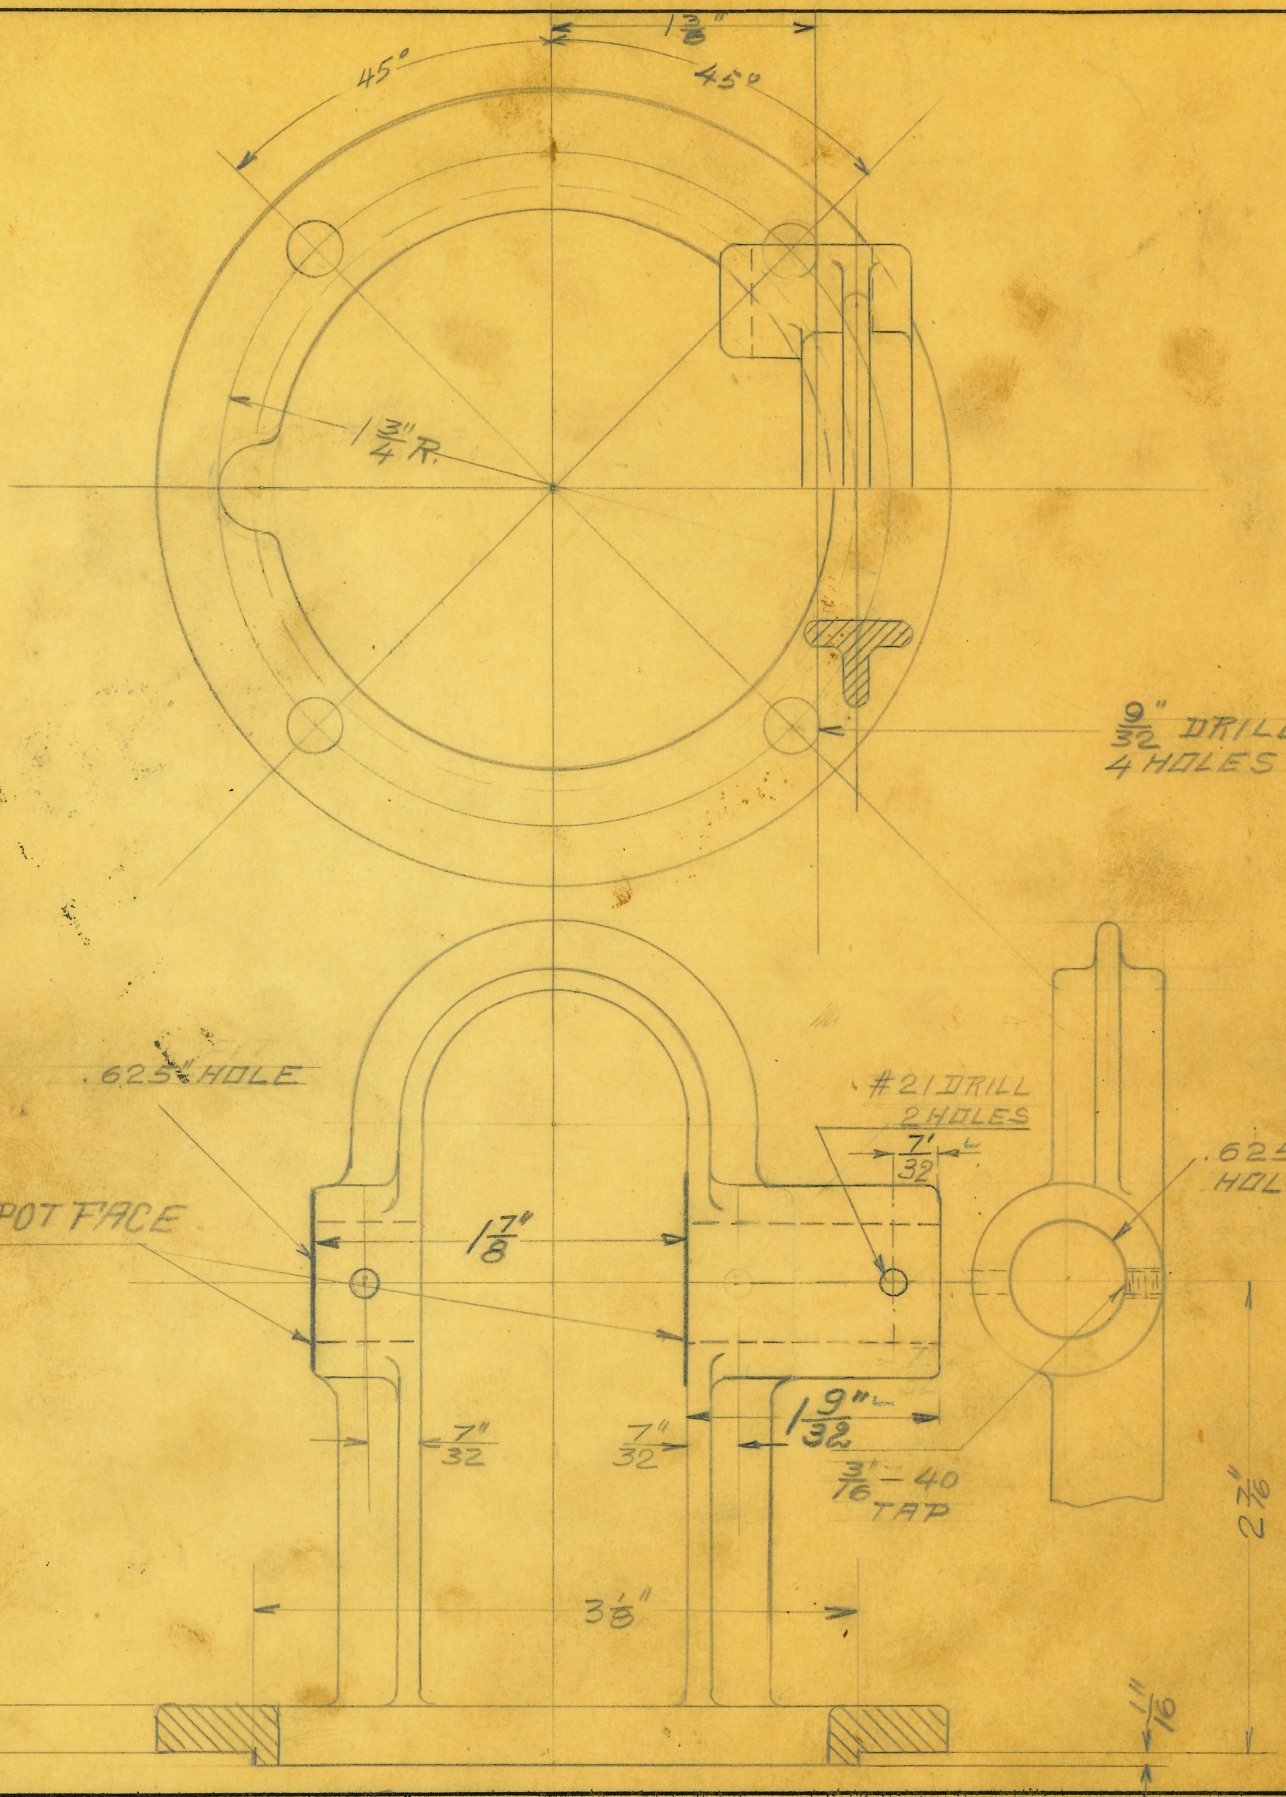

OBSOLETE

(1)

SIZE		ISSUE 8-19-26	CP
KIND	C. IRON	CHANGED	
SHAPE		" "	
FINISH		" "	
TEMP.		" "	
PATT.		" "	

TITLE: WORM-GEAR-SUPPORT
WAVE-GENERATOR

H. G. FISCHER & CO.
2335 WABANSIA AVE.
CHICAGO, ILL.

CAT. NO.

PART NO. 5352 F.A.

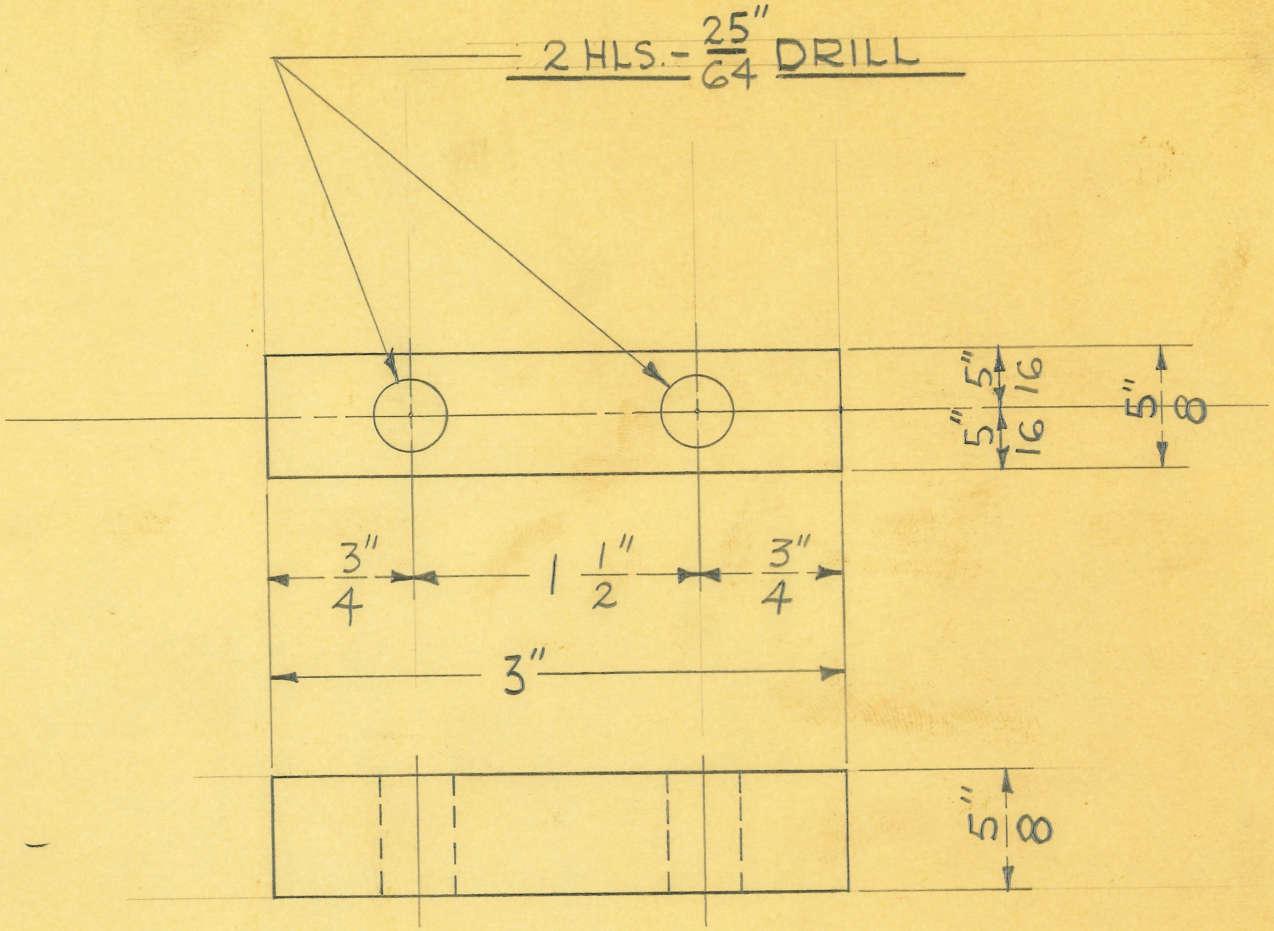

2 REQUIRED

OBSOLETE

SIZE	5/8" SQUARE	ISSUE	10-29-46	J.V.W.
KIND	COPPER	CHANGED		
SHAPE	BAR	"		
FINISH		"		
TEMP.		"		
PATT.		"		

TITLE: WAVE GEN.-ARMATURE-BASE-SEGMENT

H. G. FISCHER & CO.
2335 WABANSIA AVE.
CHICAGO, ILL.

CAT. NO.

PART NO. 5498

TITLE
FISCHER WAVE GEN. SELECTOR SWITCH - FLAT SPRING CONTACT (.797)

H. G. FISCHER & CO.
FRANKLIN PARK, ILLINOIS

PART NO. 5591

PATTERN	FINISH	SCALE
~	~	1=1/4

DATE 12-14-66 | DR. BY B.K. | CH'K'D. J.V.W.

MATERIAL .010 x .250 BRONZE

TOOLS CUT OFF & PERFORATING DIE # 14340
BENDING DIE # D-122

DIMENSIONS—UNLESS OTHERWISE SPECIFIED:
FRACTIONAL ± .015
DECIMAL ± .005
ANGULAR ± 1/2°

THREAD CHAMFER
UP TO 5/16 D. - 1/32 X 45°
3/8 D. & OVER - 1/16 X 45°

REMOVE ALL BURRS & SHARP CORNERS

USED ON	QTY.	USED ON	QTY.
5423GB	1		
207346	1		

REVISION	DATE	BY

-BLANK-

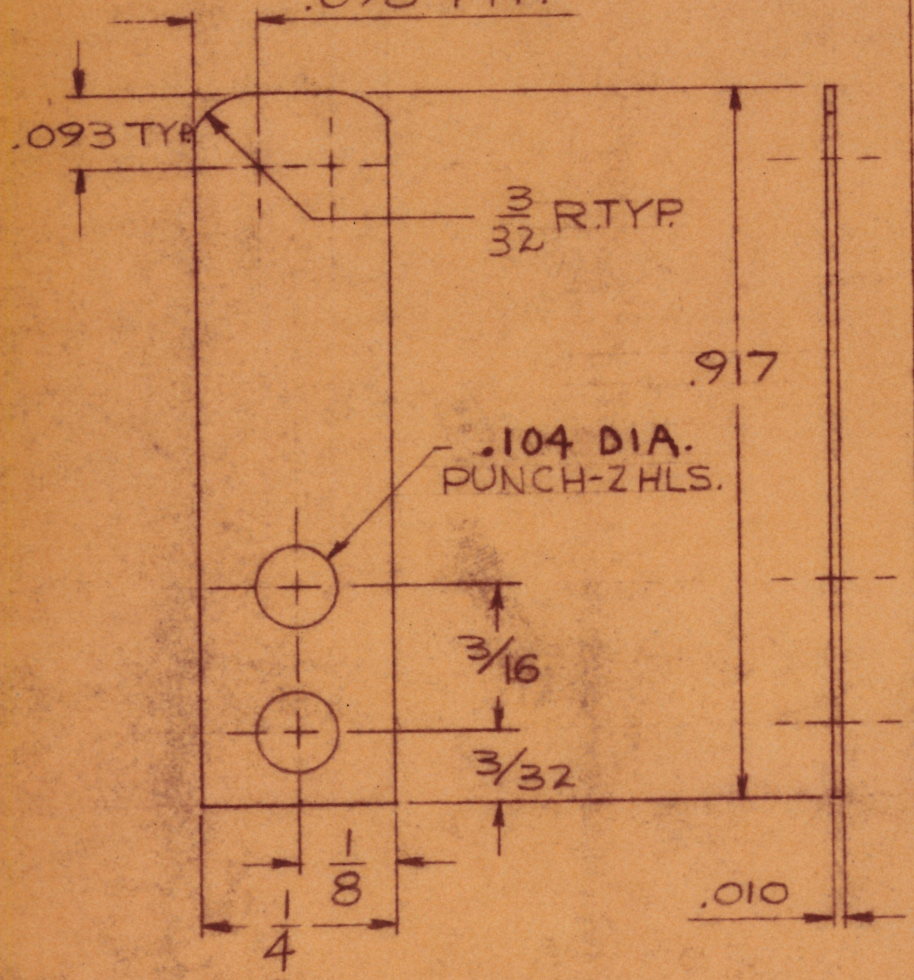

-FORM-

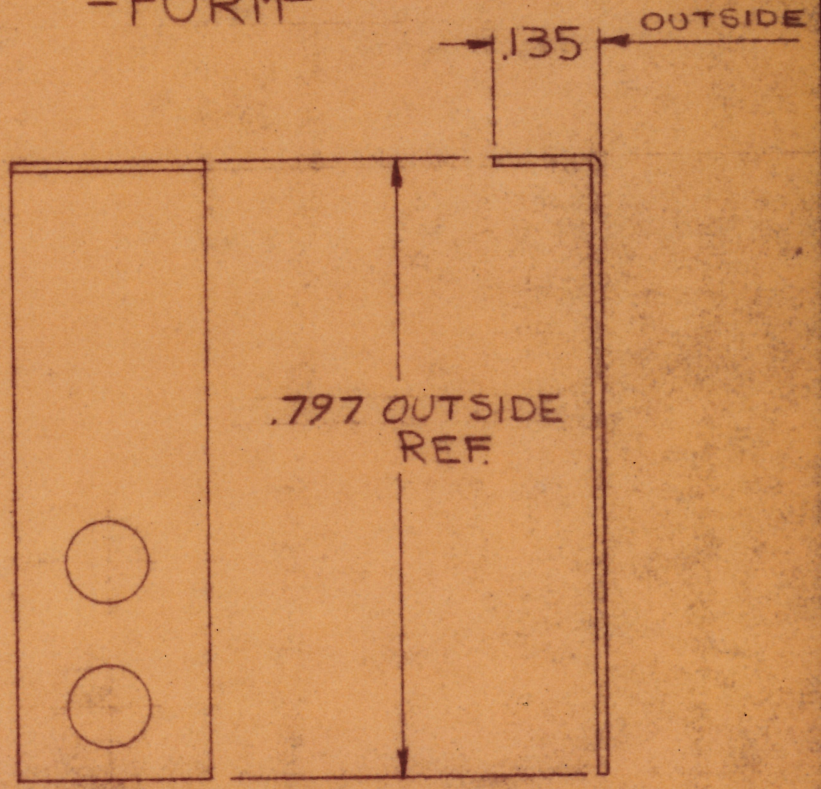

OBSOLETE

DO NOT SCALE DRAWING.

TITLE
FISCHER WAVE GEN. SELECTOR SWITCH - FLAT SPRING CONTACT (.767)

PATTERN " | FINISH " | SCALE 1" = 1/4

MATERIAL
.010 X 250 BRONZE

TOOLS CUT OFF & PERFORATING DIE # 14340
BENDING DIE # D-122

H. G. FISCHER & CO.
FRANKLIN PARK, ILLINOIS

PART NO. 5590

DATE 2-14-66 | DR. BY B.K. | CH'K'D. J.V.W.

DIMENSIONS—UNLESS OTHERWISE SPECIFIED:
FRACTIONAL ± .015
DECIMAL ± .005
ANGULAR ± 1/2°
THREAD CHAMFER
UP TO 5/16 D. - 1/32 X 45°
3/8 D. & OVER - 1/16 X 45°

REMOVE ALL BURRS & SHARP CORNERS

USED ON	QTY.	USED ON	QTY.
5423GB	1		
20734G	1		

REVISION	DATE	BY

—BLANK—

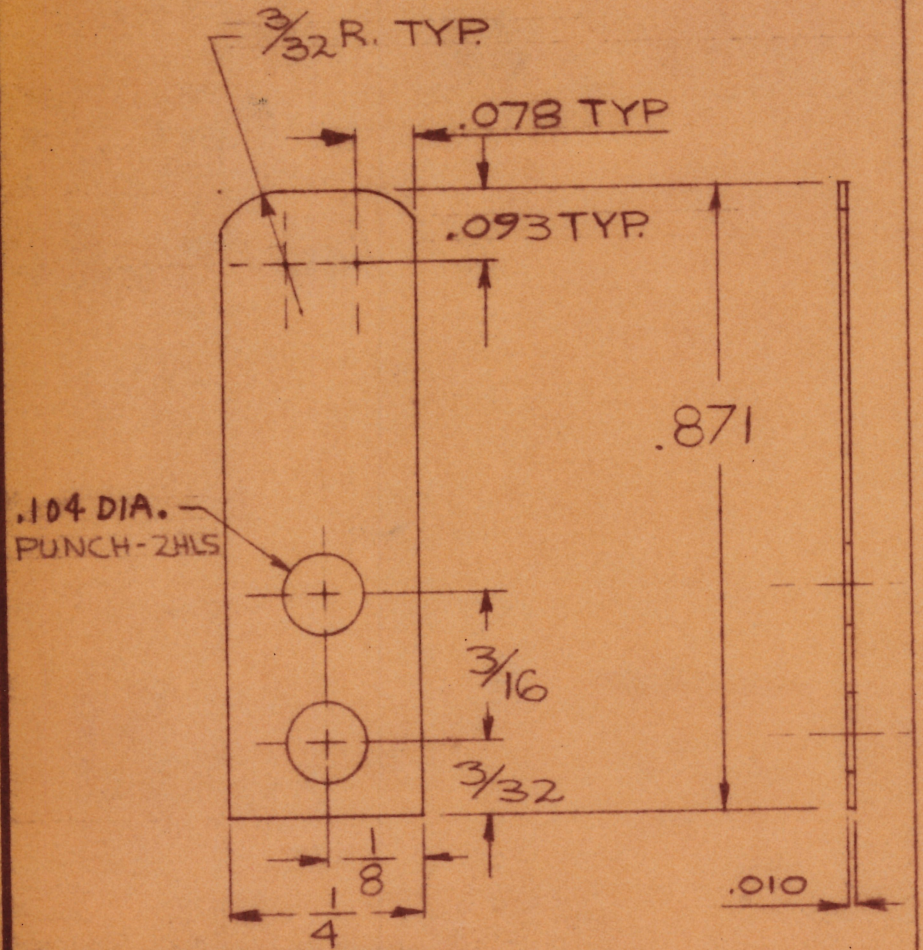

DO NOT SCALE DRAWING.

—FORM—

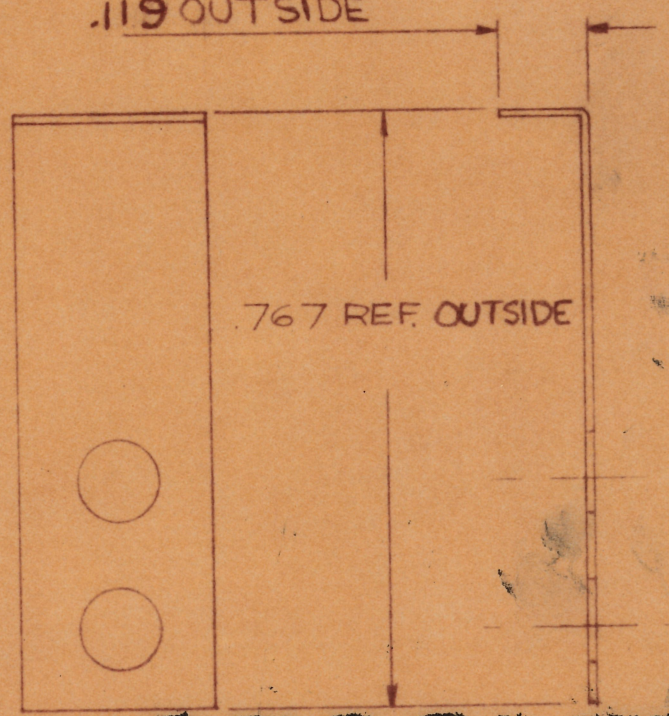

OBSOLETE

TITLE: FISCHER WAVE GEN. SELECTOR SWITCH - FLAT SPRING CONTACT (.737)

H. G. FISCHER & CO.
FRANKLIN PARK, ILLINOIS

PART NO. 5589

DATE 12-14-66 | DR. BY B.K. | CH'K'D. J.V.W.

REVISION	DATE	BY

PATTERN " | FINISH " | SCALE 1"=1/4

MATERIAL: .010 X .250 BRONZE

TOOLS: CUT OFF & PERFORATING DIE # 14340
BENDING DIE # D-122

DIMENSIONS—UNLESS OTHERWISE SPECIFIED:
FRACTIONAL ± .015
DECIMAL ± .005
ANGULAR ± 1/2°
THREAD CHAMFER
UP TO 5/16 D. - 1/32 X 45°
3/8 D. & OVER - 1/16 X 45°
REMOVE ALL BURRS & SHARP CORNERS

USED ON	QTY.	USED ON	QTY.
5423GB	1		
20734G	1		

-BLANK-

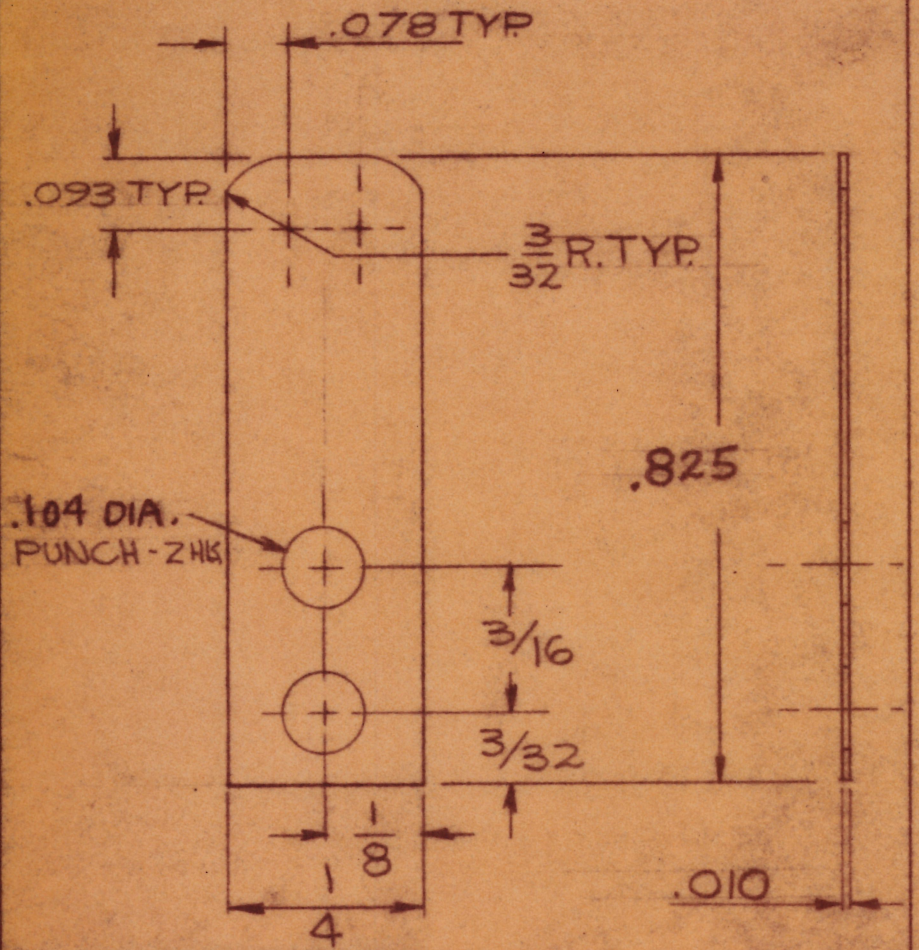

DO NOT SCALE DRAWING.

-FORM-

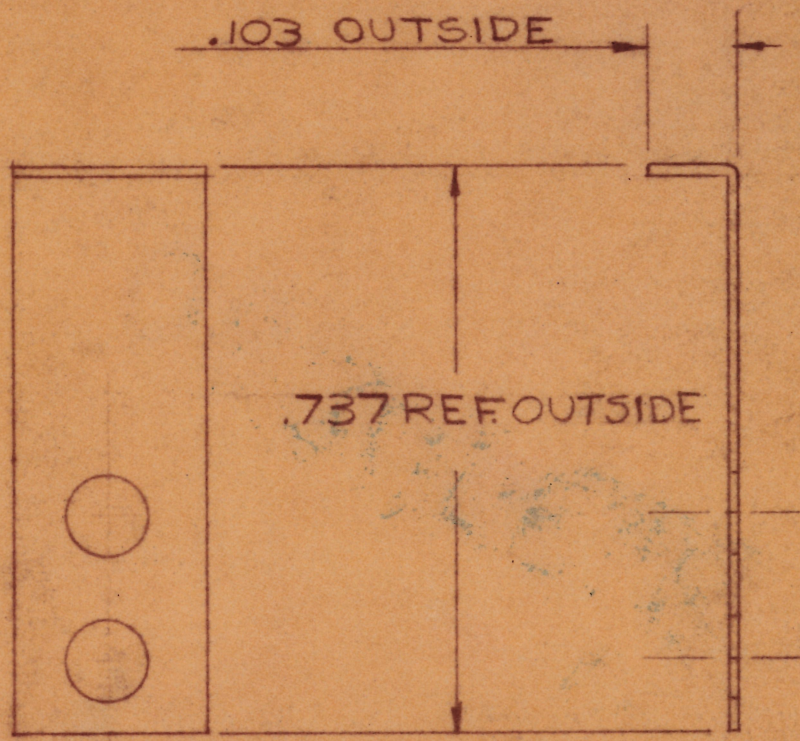

OBSOLETE

TITLE: FISCHER WAVE GEN. SELECTOR SWITCH - FLAT SPRING CONTACT (.706)

H. G. FISCHER & CO.
FRANKLIN PARK, ILLINOIS

PART NO. 5588

DATE 12-14-66 | DR. BY B.K. | CH'K'D. J.V.W.

REVISION	DATE	BY

PATTERN | FINISH | SCALE 4 X SIZE

MATERIAL: BRONZE .010 X .250

TOOLS: CUT OFF & PERFORATING DIE # 14340
BENDING DIE # D-122

DIMENSIONS—UNLESS OTHERWISE SPECIFIED:
FRACTIONAL ± .015
DECIMAL ± .005
ANGULAR ± 1/2°
THREAD CHAMFER
UP TO 5/16 D. - 1/32 X 45°
3/8 D. & OVER - 1/16 X 45°
REMOVE ALL BURRS & SHARP CORNERS

USED ON	QTY.	USED ON	QTY.
5423GB	1		
20734G	1		

- BLANK -

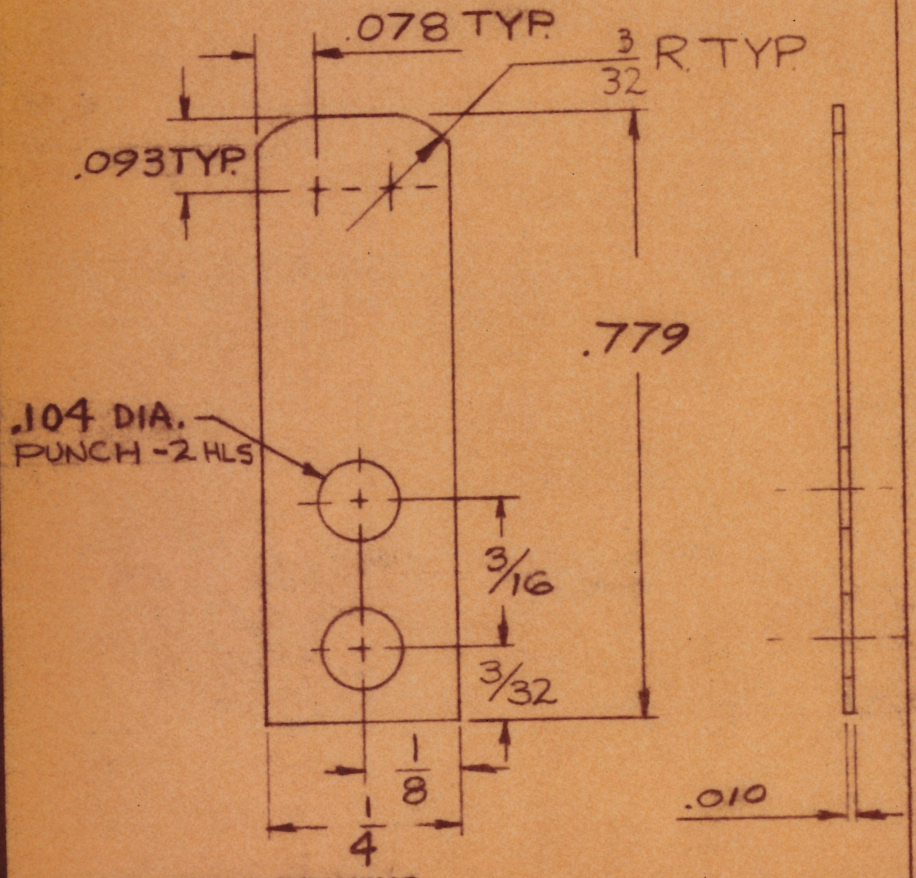

DO NOT SCALE DRAWING.

- FORM -

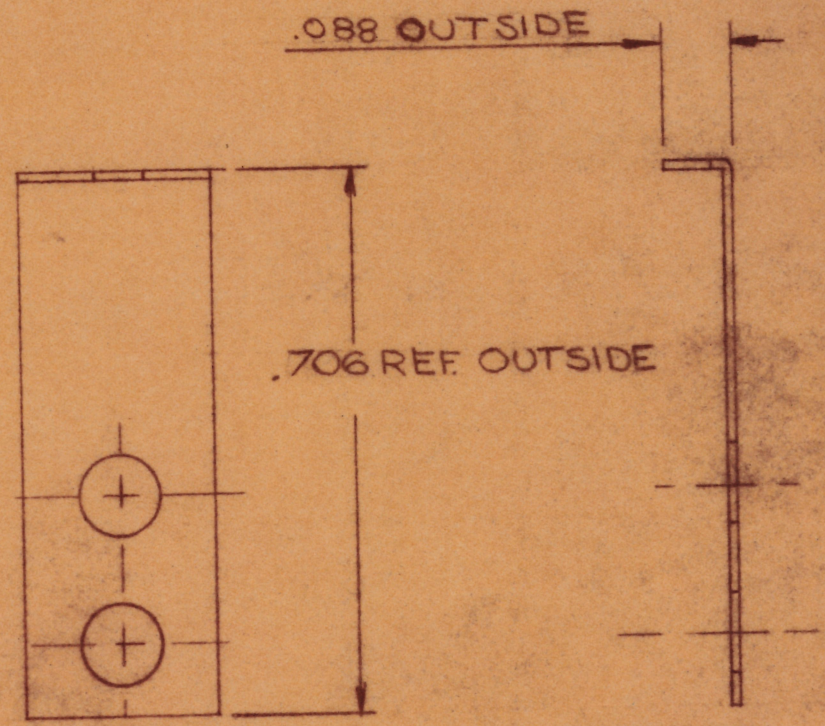

OBSOLETE

.041 piano wire

10 turns wound on

9/32" core

total length 1 7/8"

OBSOLETE

SIZE		ISSUE	
KIND	Piano Wire	CHANGED	
SHAPE		" "	
FINISH		" "	
TEMP.		" "	
PATT.		" "	

TITLE: Friction disc spring
Wave Generator

H. G. FISCHER & CO.
2335 WABANSIA AVE.
CHICAGO, ILL.

CAT. NO.

PART NO. 5355 1/4

TITLE: FISCHER WAVE GEN. SELECTOR SWITCH CONTACT SETS

H. G. FISCHER & CO.
FRANKLIN PARK, ILLINOIS

REDRAWN DATE 4-2-64 | DR BY DAK | CH'K'D. RS

PART NO. 5423GA

REVISION	DATE	BY

PATTERN | FINISH | SCALE DOUBLE

DIMENSIONS
FRACTIONAL ± .015
DECIMAL ± .005
ANGULAR ± ½°
UNLESS OTHERWISE SPECIFIED

TOOLS: CUT OFF & PERFORATING DIE # 1538

MATERIAL: BRONZE .010 X .250

BENDING DIE #D-122

USED ON	QTY.
14085G	1

CUT OFF & PERFORATING DIE # 14340

OBSOLETE

OBSOLETE
BK.

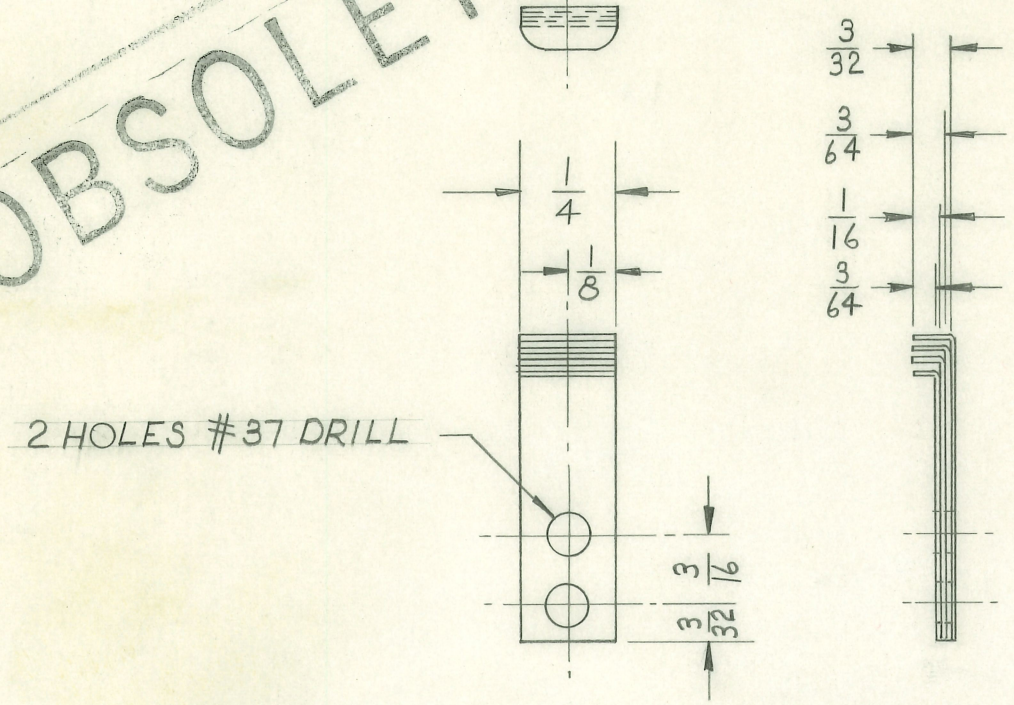

4 PIECES CUT TO FOLLOWING LENGTHS

STRIP LENGTH $3\frac{3}{4}$

CUT OFF .747 – BEND $\frac{3}{64}$ INSIDE
CUT OFF .793 – BEND $\frac{1}{16}$ "
CUT OFF .839 – BEND $\frac{5}{64}$ "
CUT OFF .885 – BEND $\frac{3}{32}$ "

OBSOLETE

TITLE
FISCHER WAVE GEN. SELECTOR SWITCH-CONTACT SET ASSEM.

H. G. FISCHER & CO.
FRANKLIN PARK, ILLINOIS

PART NO. 5423GC

PATTERN	FINISH	SCALE
"	"	4X's SIZE

MATERIAL "

TOOLS "

DATE 12-14-66 | DR. BY B.E. | CH'K'D. J.V.W.

DIMENSIONS—UNLESS OTHERWISE SPECIFIED:
FRACTIONAL ± .015
DECIMAL ± .005
ANGULAR ± 1/2°
THREAD CHAMFER
UP TO 5/16 D. - 1/32 X 45°
3/8 D. & OVER - 1/16 X 45°
REMOVE ALL BURRS & SHARP CORNERS

USED ON	QTY.	USED ON	QTY.
20720GA	2		

REVISION	DATE	BY
REMOVED 5464 1/2 ITEM 1		

ITEM	AMT.	NAME	PART NO.#
1		~~CONTACT SET ASSEMBLY~~	~~5423 1/2~~
2	1	CONTACT (.706)	5588
3	1	CONTACT (.737)	5589
4	1	CONTACT (.767)	5590
5	1	CONTACT (.797)	5591

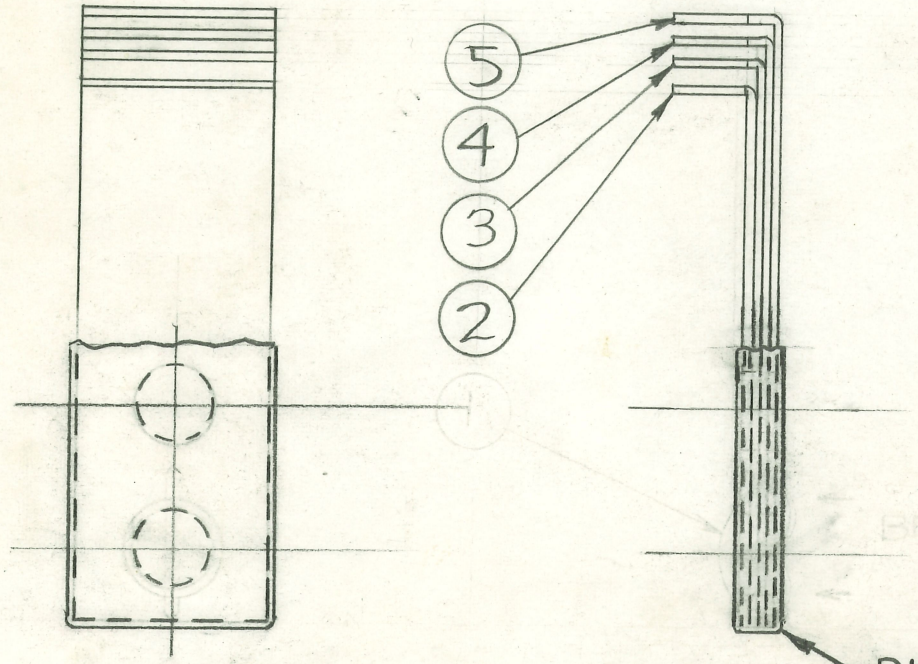

DIP CONTACT SET IN # D5300
GREEN DIP SEAL

OBSOLETE
E.C.O. 1108
Andy P.

DO NOT SCALE DRAWING.

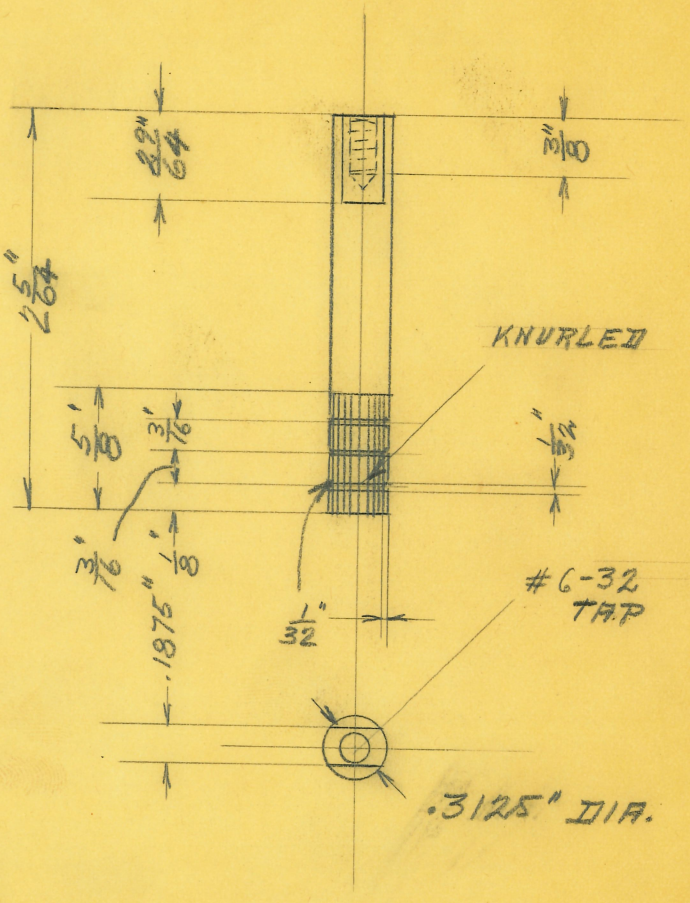

OBSOLETE

(1)

SIZE		ISSUE 6-15-26	C.
KIND	G.R. STEEL	CHANGED	
SHAPE		" "	
FINISH		" "	
TEMP.		" "	
PATT		" "	

TITLE: SHAFT FOR POLARITY-SWITCH

H. G. FISCHER & CO.
2335 WABANSIA AVE.

CAT. NO.

PART NO. 5472

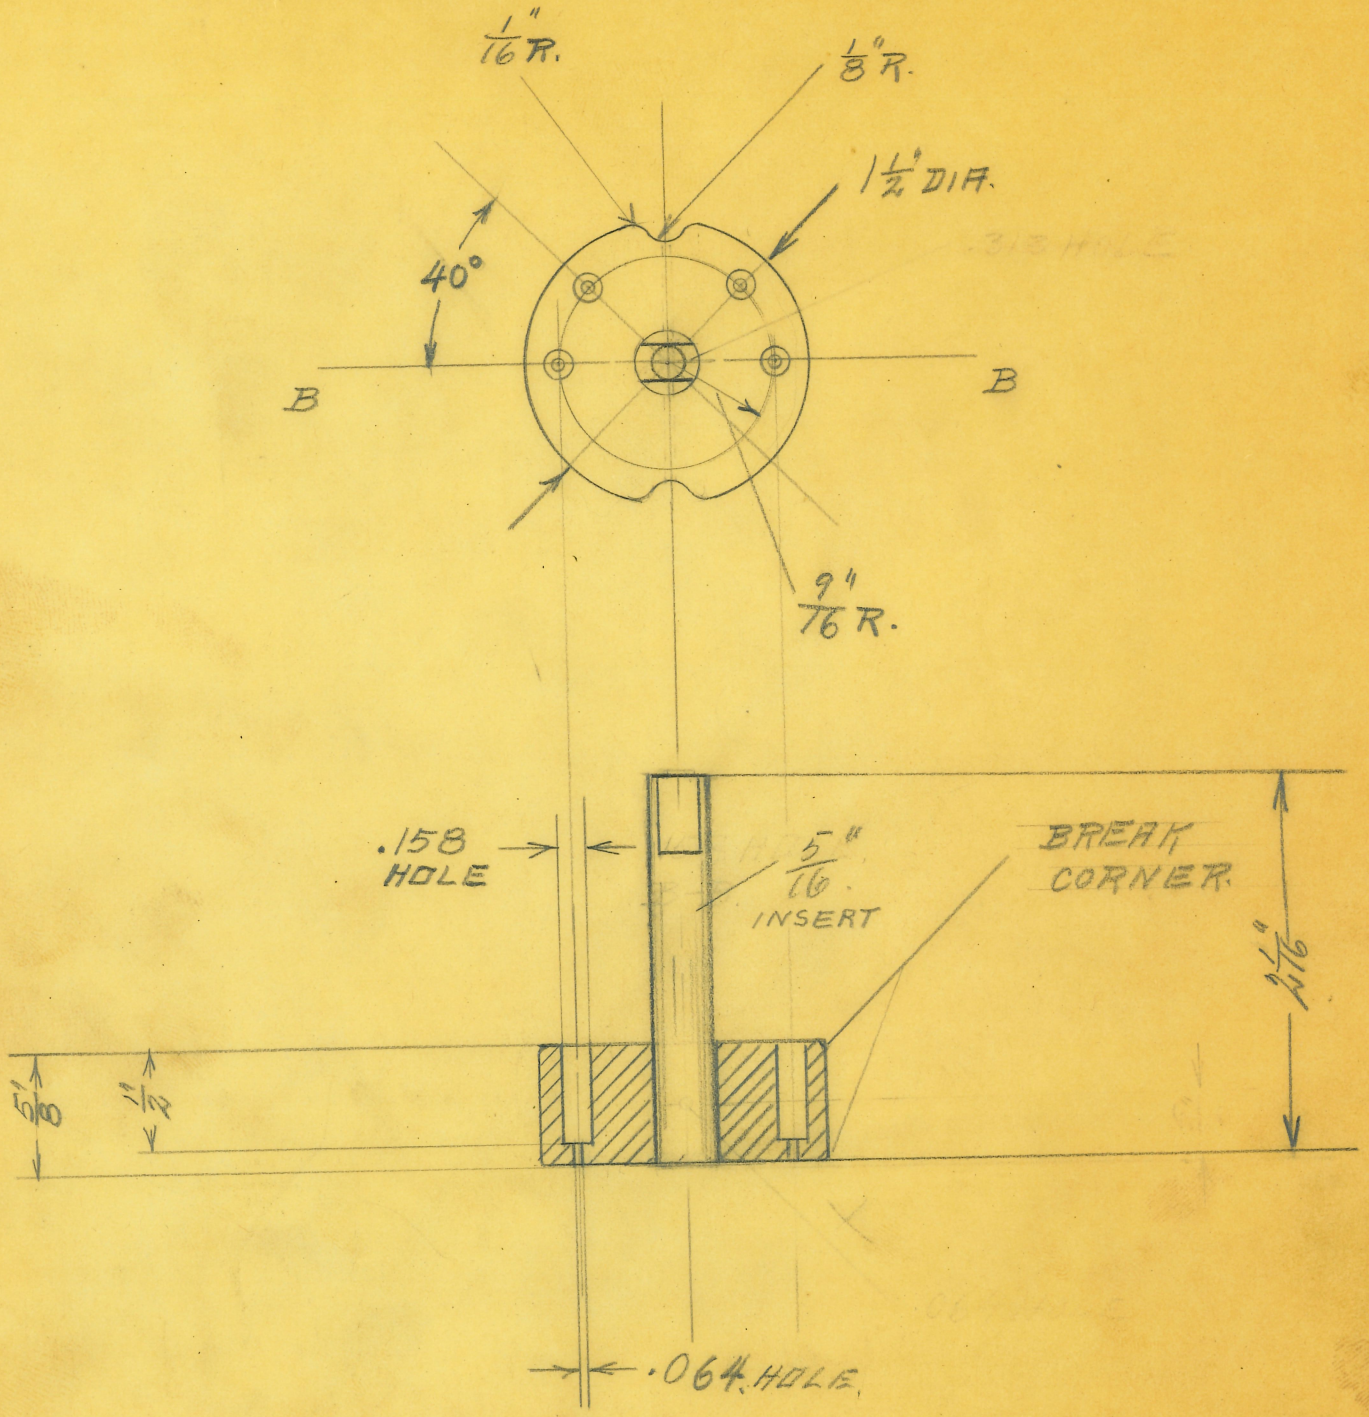

OBSOLETE

SIZE		ISSUE 4-19-26	L.
KIND	BAKELITE	CHANGED	
SHAPE		" "	
FINISH		" "	
TEMP.		" "	
PATT.		" "	

TITLE: CONTACT-SUPPORT & SHAFT POLARITY SWITCH.

H. G. FISCHER & CO.
2335 WABANSIA AVE.
CHICAGO, ILL.

CAT. NO.

PART NO. 5472G

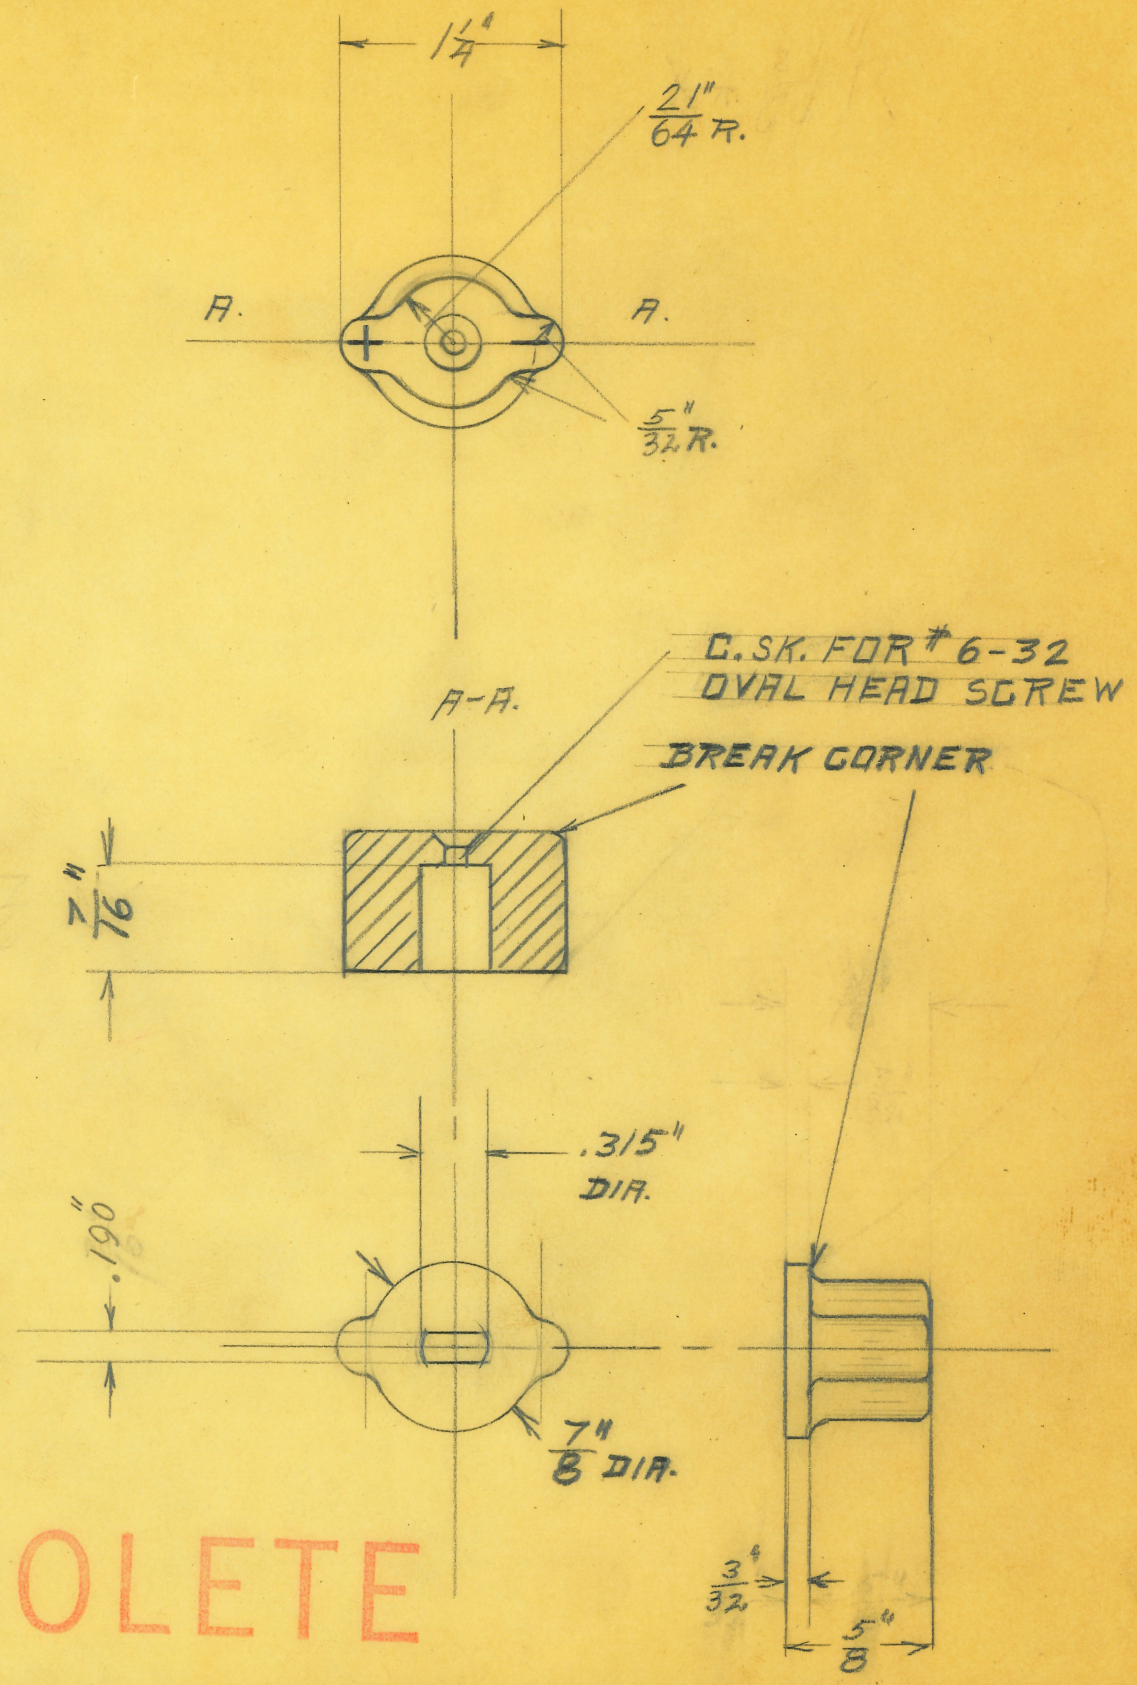

OBSOLETE

SIZE		ISSUE 4-26-26	Q.	TITLE: KNOB FOR POLARITY-SWITCH		
KIND	BAKELITE	CHANGED				
SHAPE		" "				
FINISH		" "				
TEMP.		" "		H. G. FISCHER & CO. 2335 WABANSIA AVE. CHICAGO, ILL.	CAT. NO.	PART NO. 5473
PATT.		" "				

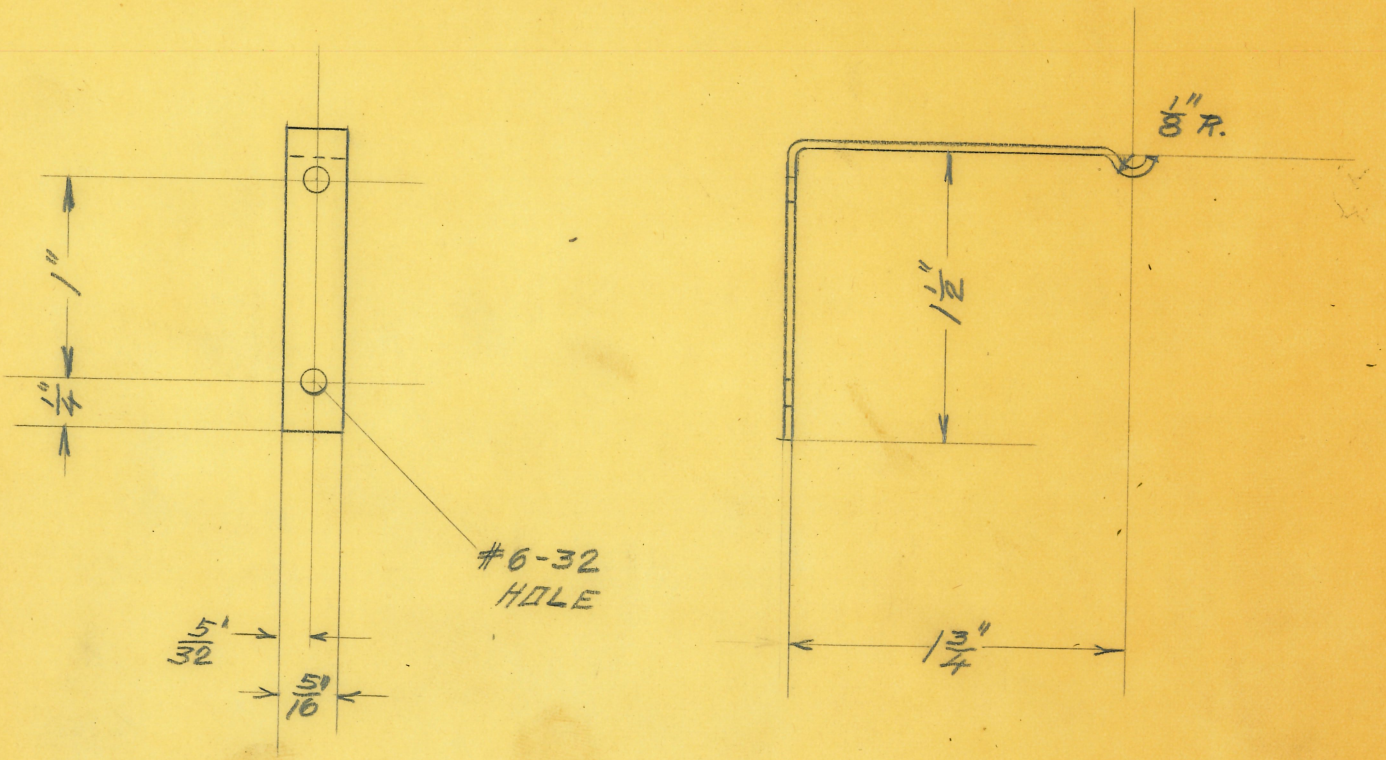

#14 B.& S. GA.
SHEET BRASS

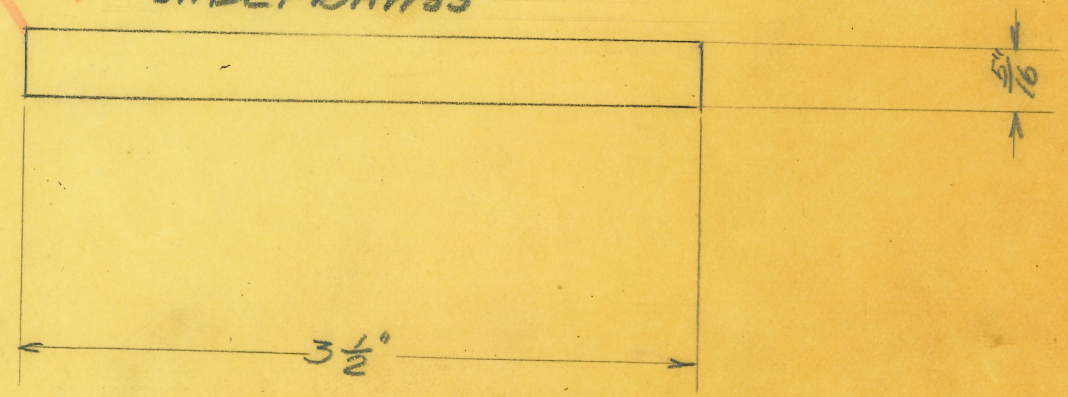

OBSOLETE

(1)

SIZE		ISSUE 6-21-26	C
KIND	BRASS	CHANGED	
SHAPE		" "	
FINISH		" "	
TEMP.		" "	
PATT.		" "	

TITLE: SPRING
POLARITY SWITCH

H. G. FISCHER & CO.
2335 WABANSIA AVE.
CHICAGO, ILL.

CAT. NO.

PART NO. 5474

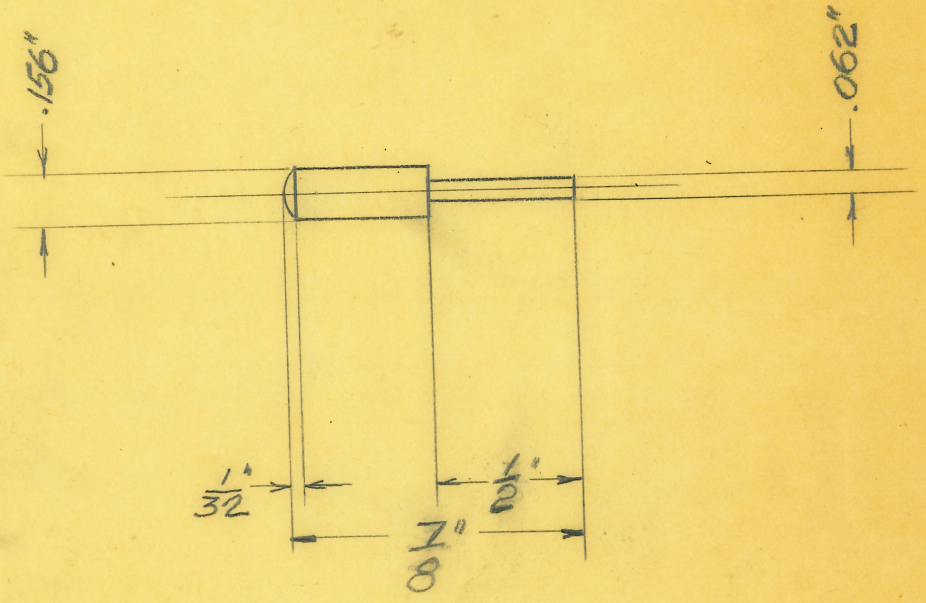

OBSOLETE

(4)

SIZE		ISSUE 6-21-26	C.
KIND	BRASS	CHANGED	
SHAPE		" "	
FINISH	~~~	" "	
TEMP.		" "	
PART		" "	

TITLE: CONTACT PIN
POLARITY SWITCH

H. G. FISCHER & CO.
2335 WABANSIA AVE.
CHICAGO, ILL.

CAT. NO.

PART NO. 5475

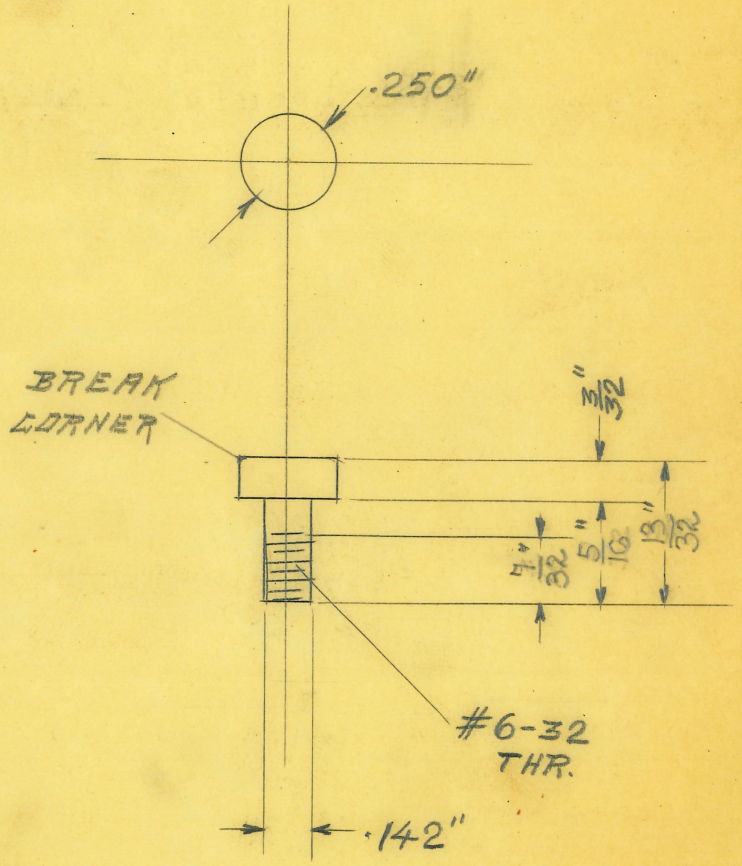

OBSOLETE

(6)

SIZE		ISSUE 7-19-26	(a)
KIND	BRASS	CHANGED	
SHAPE		" "	
FINISH		" "	
TEMP.		" "	
PATT.		" "	

TITLE:
CONTACT SCREW
POLARITY SCREW

H. G. FISCHER & CO.
2335 WABANSIA AVE.
CHICAGO, ILL.

CAT. NO.

PART NO. 5476

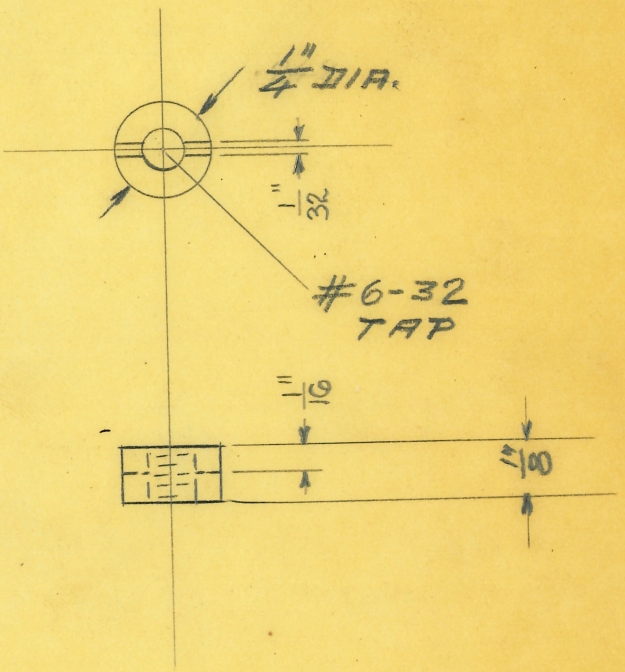

OBSOLETE

(6)

SIZE		ISSUE 7-19-26	℄	TITLE: NUT FOR CONTACT SCREW POLARITY SWITCH	
KIND	BRASS	CHANGED			
SHAPE		" "			
FINISH		" "			
TEMP.		" "		H. G. FISCHER & CO. 2335 WABANSIA AVE. CHICAGO, ILL.	CAT. NO.
PATT.		" "			PART NO. 5477

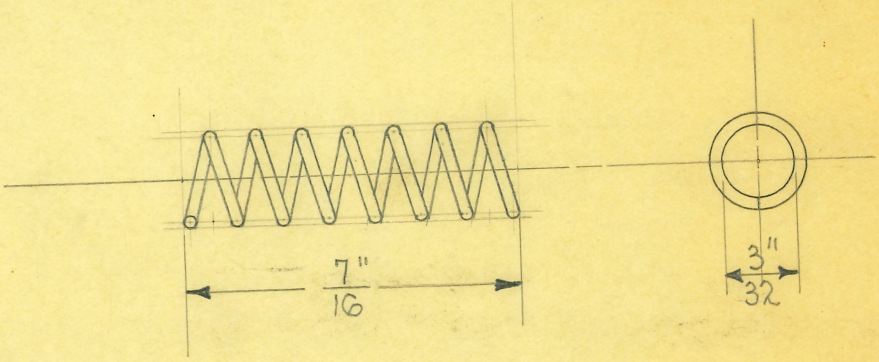

SCALE ~ 4 DIAMETERS

7 TURNS

OBSOLETE

SIZE	.014"	ISSUE 3-17-36	A.E.
KIND	PIANO WIRE	CHANGED	
SHAPE		"	
FINISH		"	
TEMP.		"	
DATE		"	

TITLE: WAVE GEN. POLARITY SWITCH CONTACT PIN SPRING

H. G. FISCHER & CO.
2335 WABANSIA AVE.
CHICAGO, ILL.

CAT. NO.

PART NO. 5478

HALF SIZE

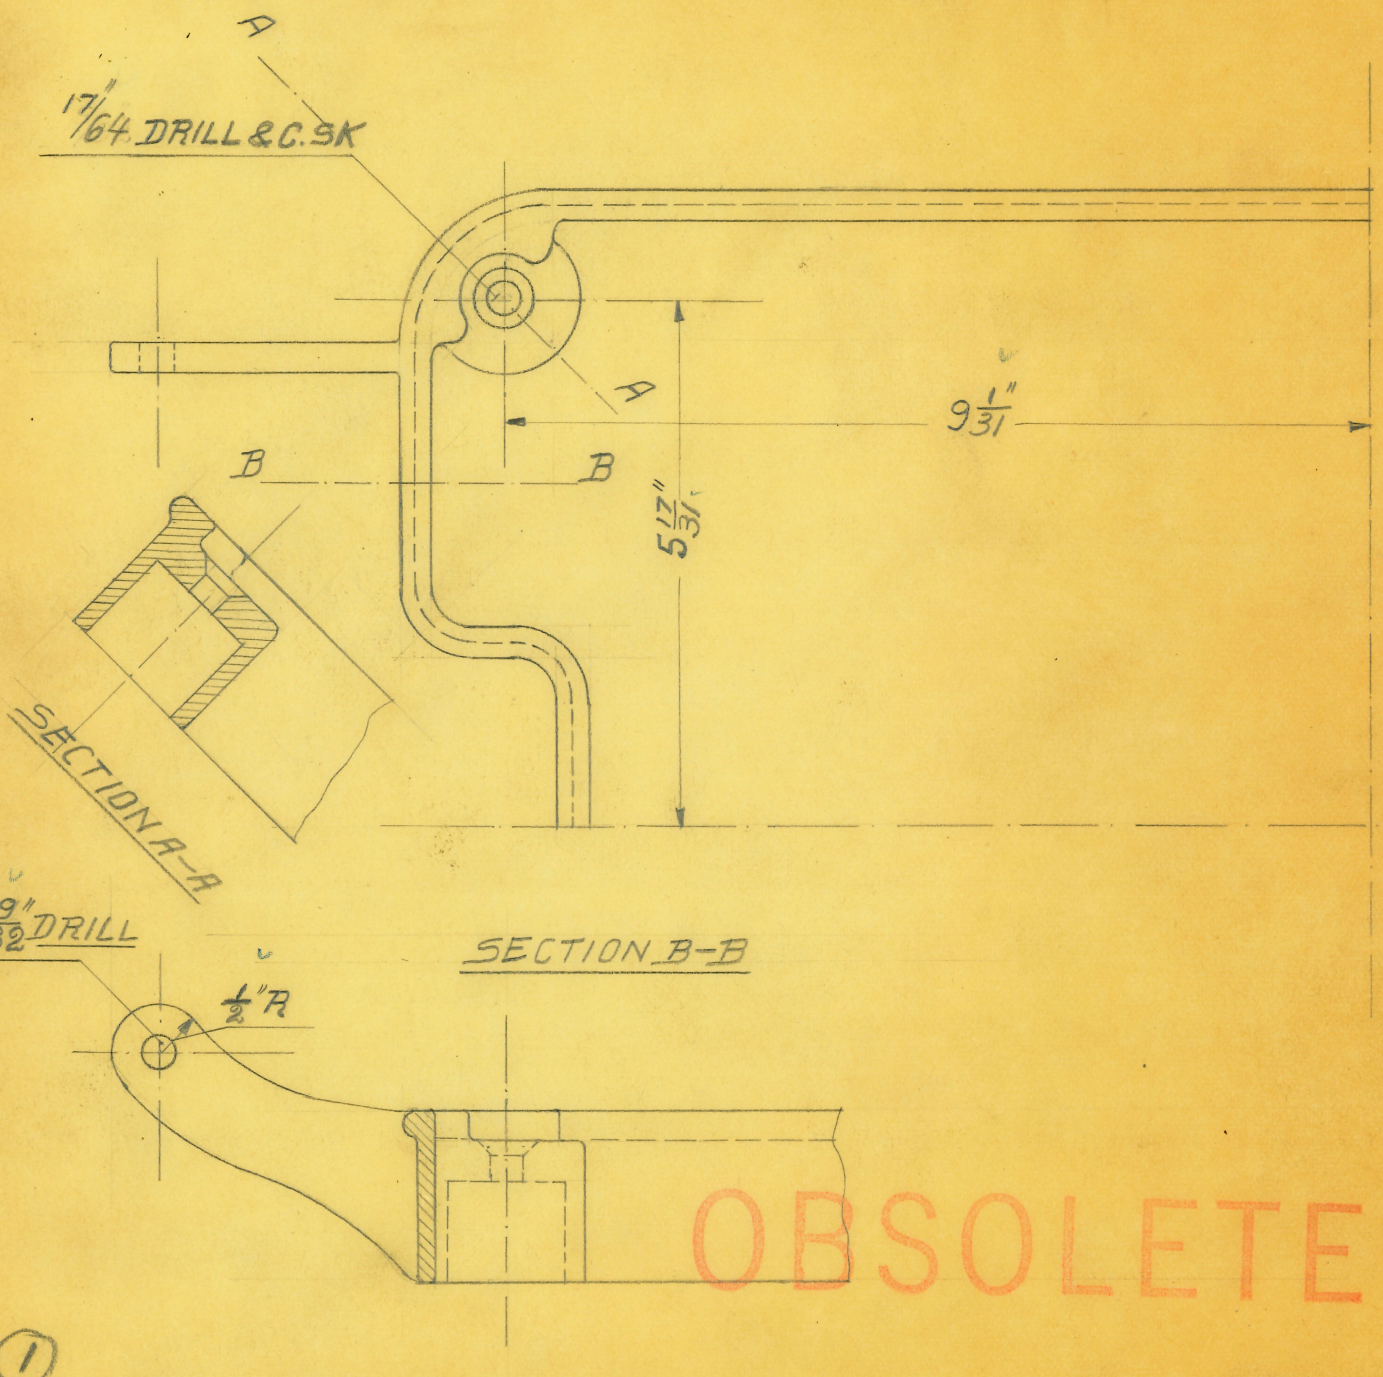

OBSOLETE

(1)

SIZE		ISSUE 4/2027	P.D.
KIND	CAST IRON	CHANGED	
SHAPE		" "	
FINISH	CRYSTALIZED	" "	
TEMP.		" "	
PATT.		" "	

TITLE: UPPER FRAME
LOW VOLT GEN. STAND

H. G. FISCHER & CO.
2335 WABANSIA AVE.
CHICAGO, ILL.

CAT. NO.

PART NO. 5481 F

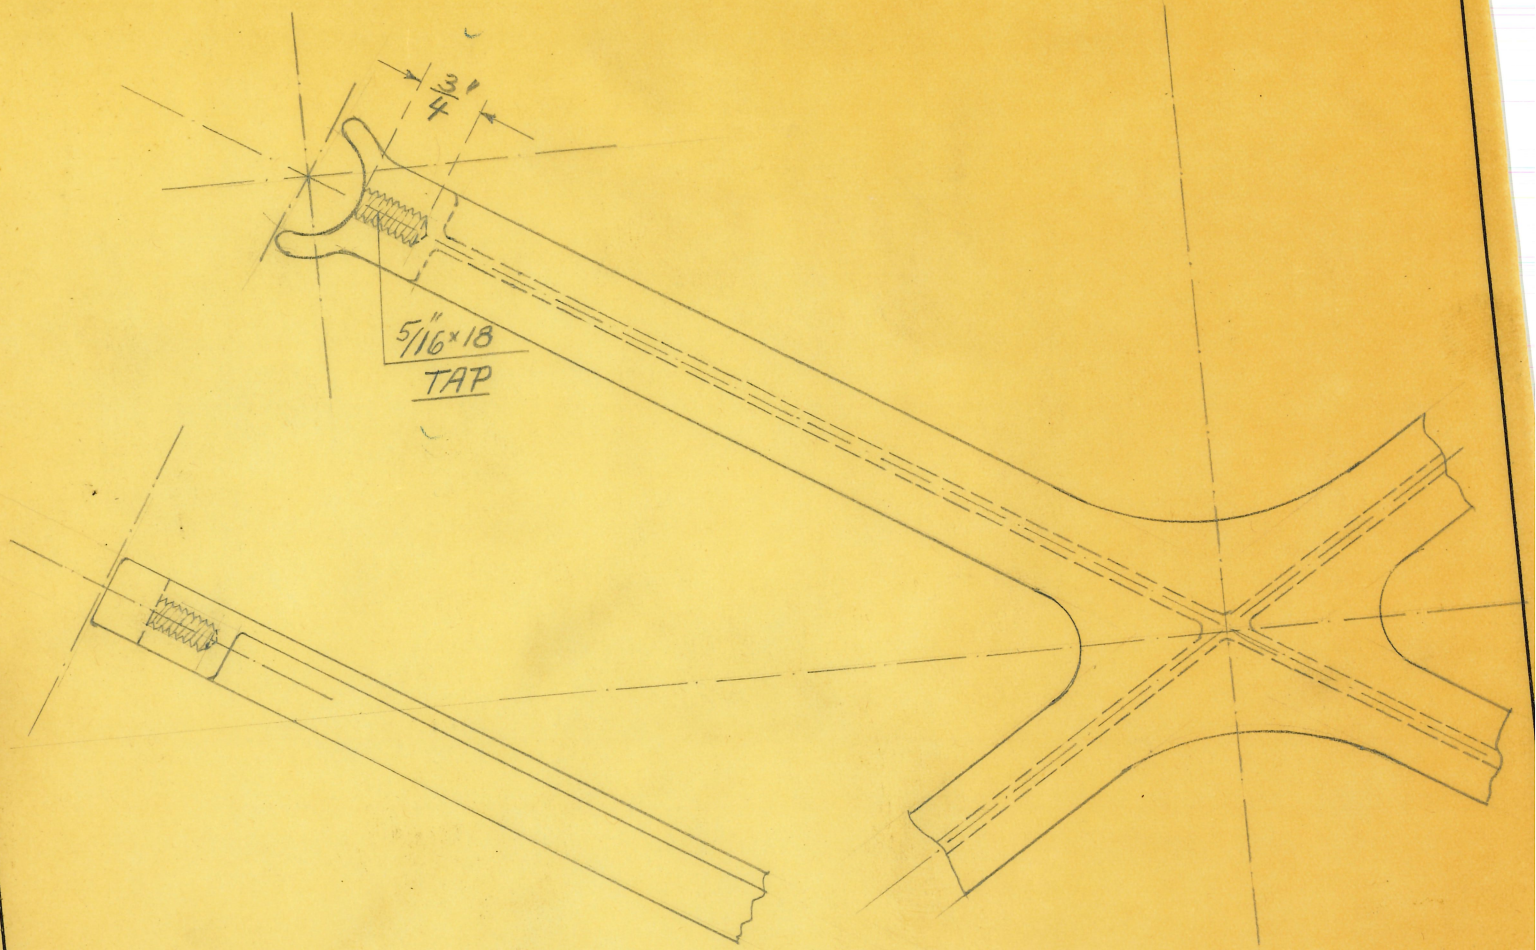

HALF SIZE

OBSOLETE

(1)

SIZE		ISSUE 4/2027	J.D.
KIND	CAST IRON	CHANGED	
SHAPE		" "	
FINISH	CRYSTALIZED	" "	
TEMP.		" "	
		" "	

TITLE: LOWER FRAME
LOW VOLT GEN. STAND

H. G. FISCHER & CO.
2335 WABANSIA AVE.
CHICAGO, ILL.

CAT. NO.

PART NO. 5482

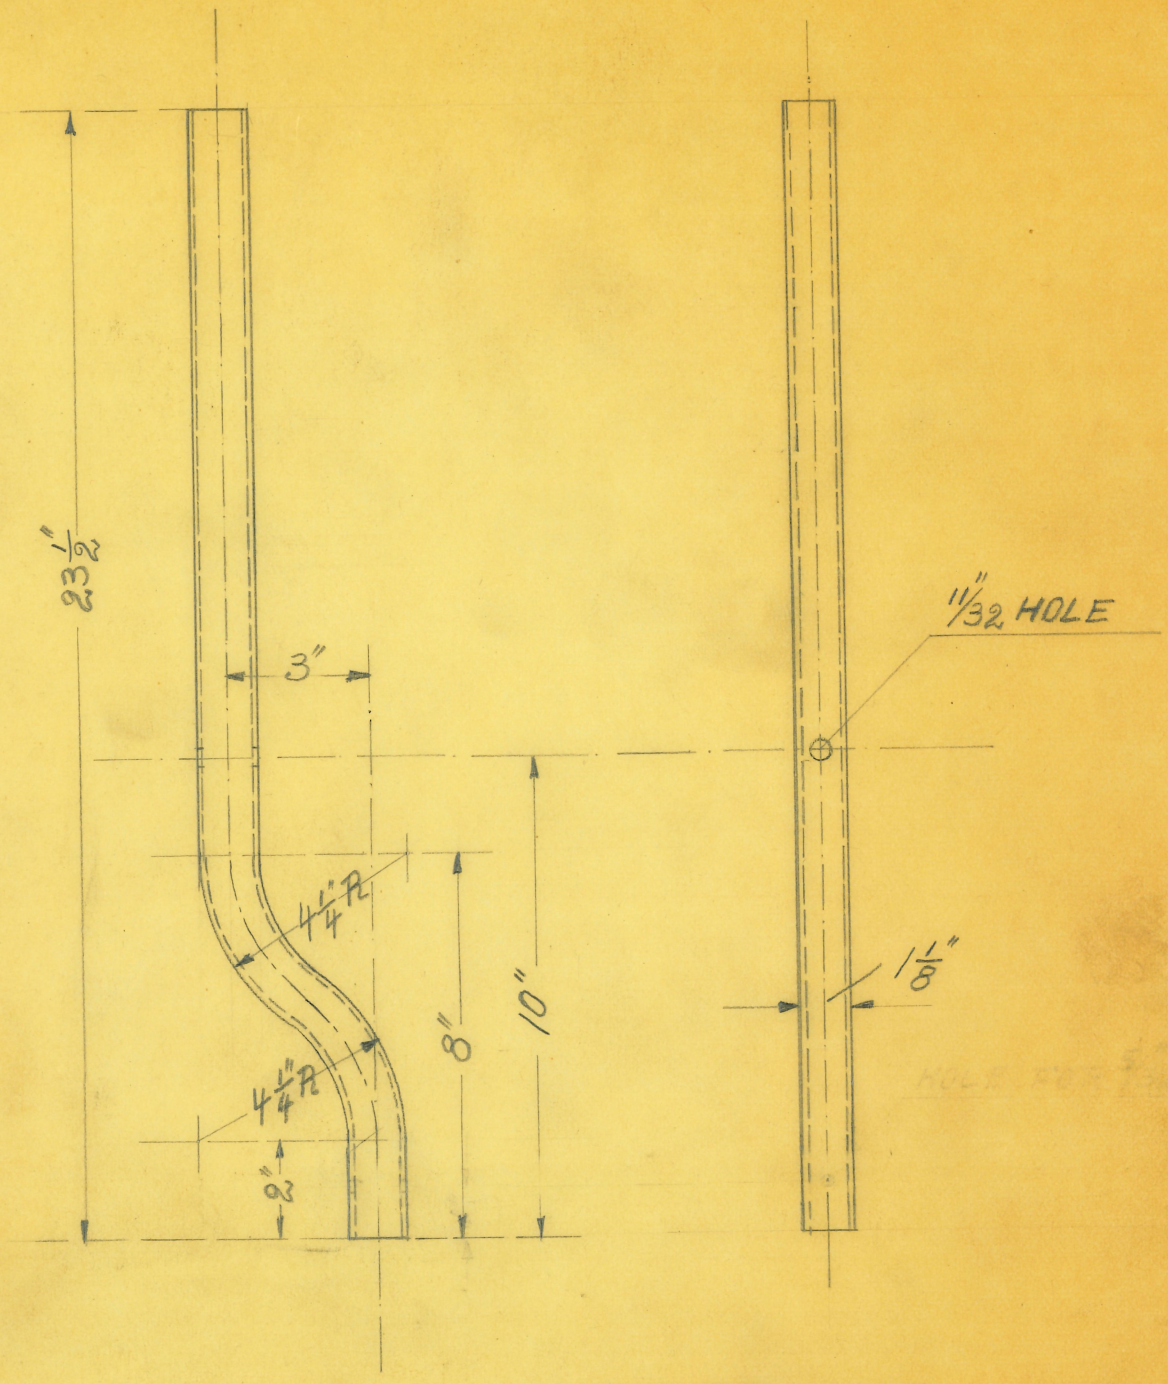

QUARTER SIZE

OBSOLETE

(4)

SIZE		ISSUE 4/20/27	P8.
KIND	1" I.D. x 1 1/8" O.D.	CHANGED	
SHAPE	TUBING	" "	
FINISH		" "	
TEMP.		" "	
PATT.		" "	

TITLE: LEG
LOW VOLT GENERATOR STAND

H. G. FISCHER & CO.
2335 WABANSIA AVE.
CHICAGO, ILL.

CAT. NO.

PART NO. 5483 F

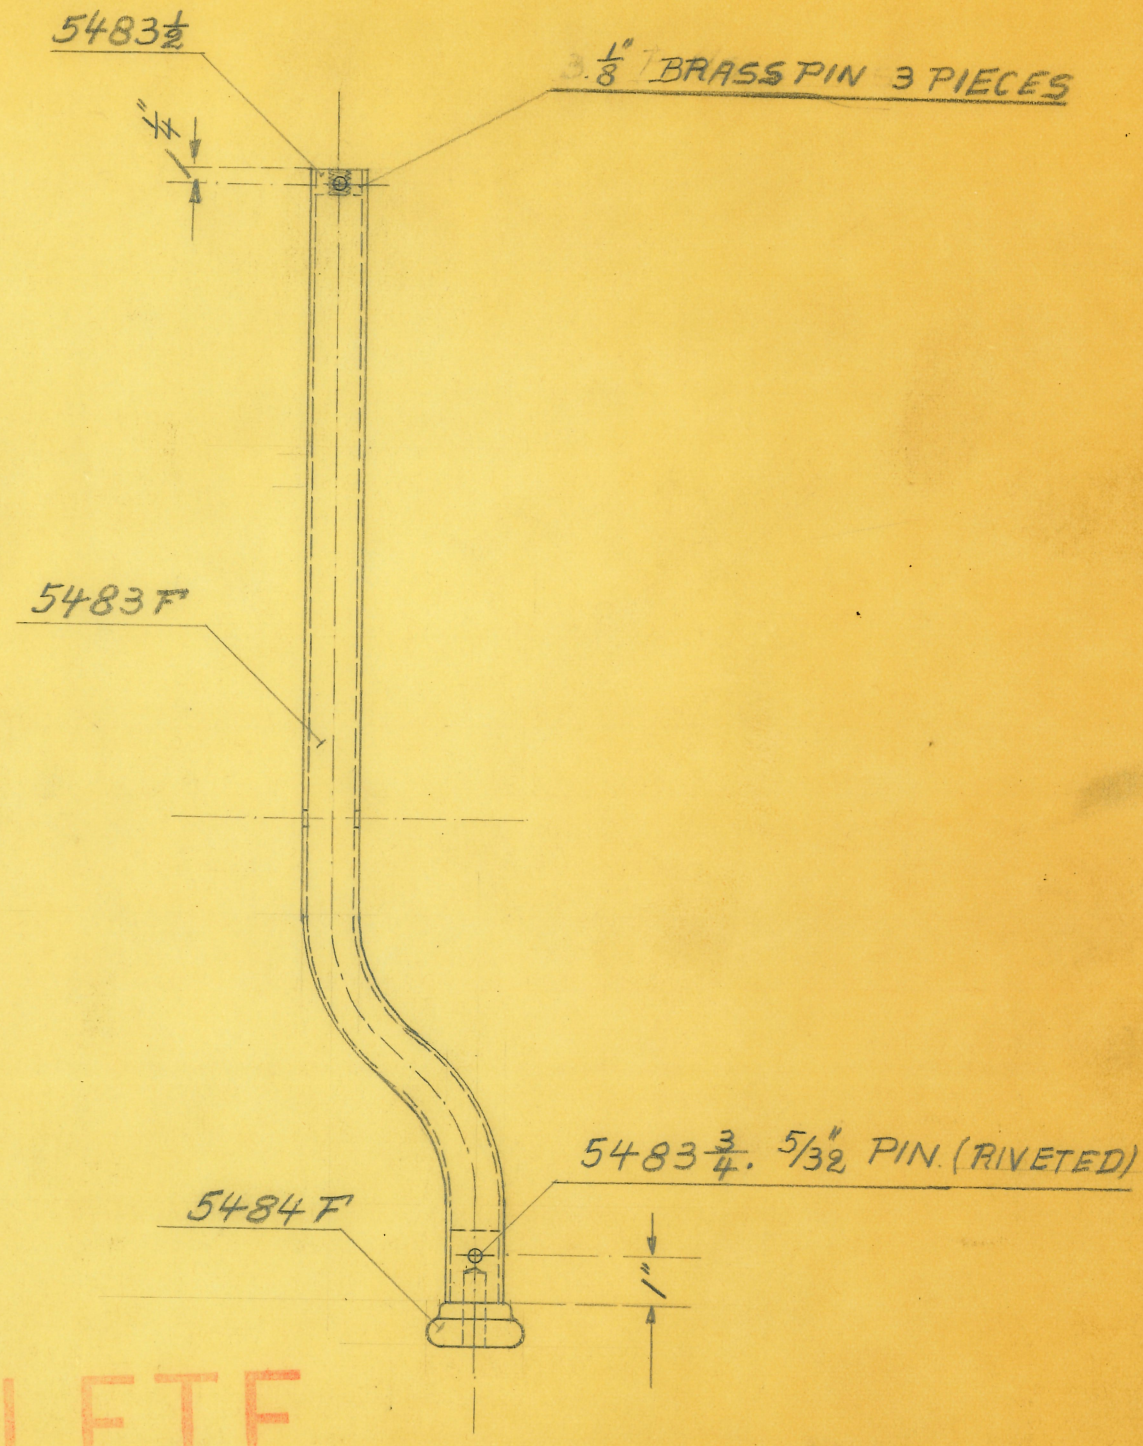

OBSOLETE

SIZE		ISSUE 20/4 27	P.B.
KIND		CHANGED	
SHAPE		" "	
FINISH	CRISTALIZED	" "	
TEMP.		" "	
PATT.		" "	

TITLE: LEG ASSEM.
LOW VOLT GEN. STAND

H. G. FISCHER & CO.
2335 WABANSIA AVE.
CHICAGO, ILL.

CAT. NO.

PART NO. 5483G

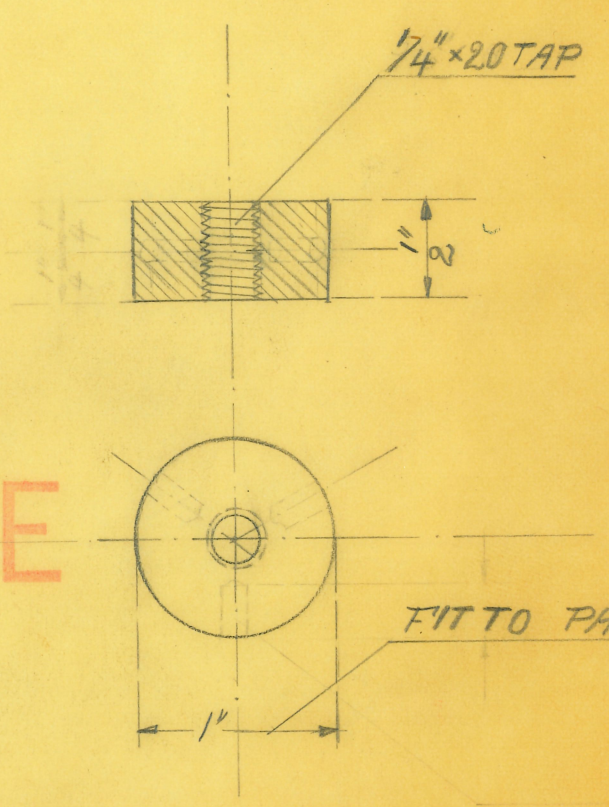

FULL SIZE

OBSOLETE

(4)

SIZE		ISSUE 4/2027	P.D.
KIND	C.R. STEEL	CHANGED	
~~SHAPE~~	ROD	" "	
FINISH		" "	
TEMP.		" "	
PATT.		" "	

TITLE: LEG PLUG
LOW VOLT GEN. STAND

H. G. FISCHER & CO.
2335 WABANSIA AVE.
CHICAGO, ILL.

CAT. NO.

PART NO. 5483 1/2

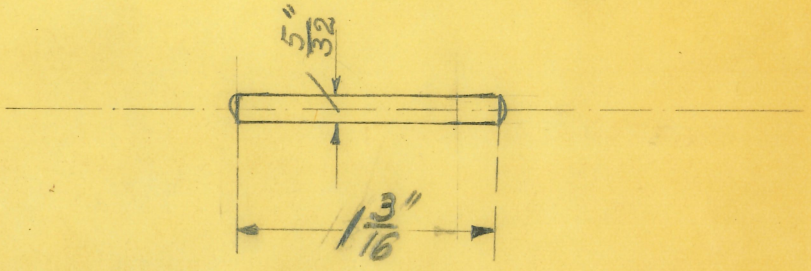

OBSOLETE

SIZE		ISSUE 29/427	P.B.	TITLE: PIN FOR CASTER SOCKET LOW VOLT GENERATOR		
KIND	C.R. STEEL	CHANGED				
SHAPE		" "				
FINISH		" "				
TEMP.		" "		H. G. FISCHER & CO. 2335 WABANSIA AVE. CHICAGO, ILL.	CAT. NO.	PART NO. 5483 3/4
PATT.		" "				

FIT PART No. 5483 F

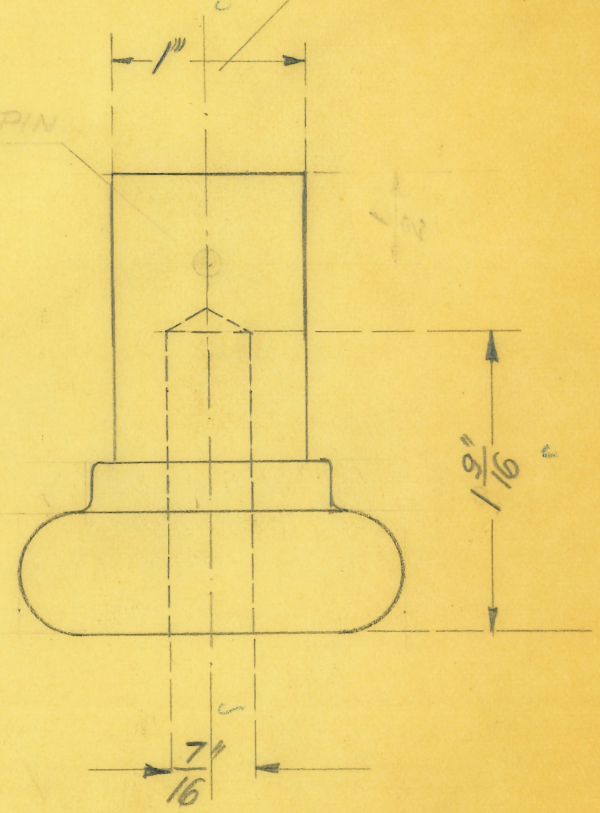

FULL SIZE

OBSOLETE

(4)

SIZE		ISSUE 4/20 27	P.D.
KIND	CAST IRON	CHANGED	
SHAPE		" "	
FINISH		" "	
TEMP.		" "	
PATT.		" "	

TITLE: CASTER SOCKET
LOW VOLT GEN. STAND

H. G. FISCHER & CO.
2335 WABANSIA AVE.
CHICAGO, ILL.

CAT. NO.

PART NO. 5484 F

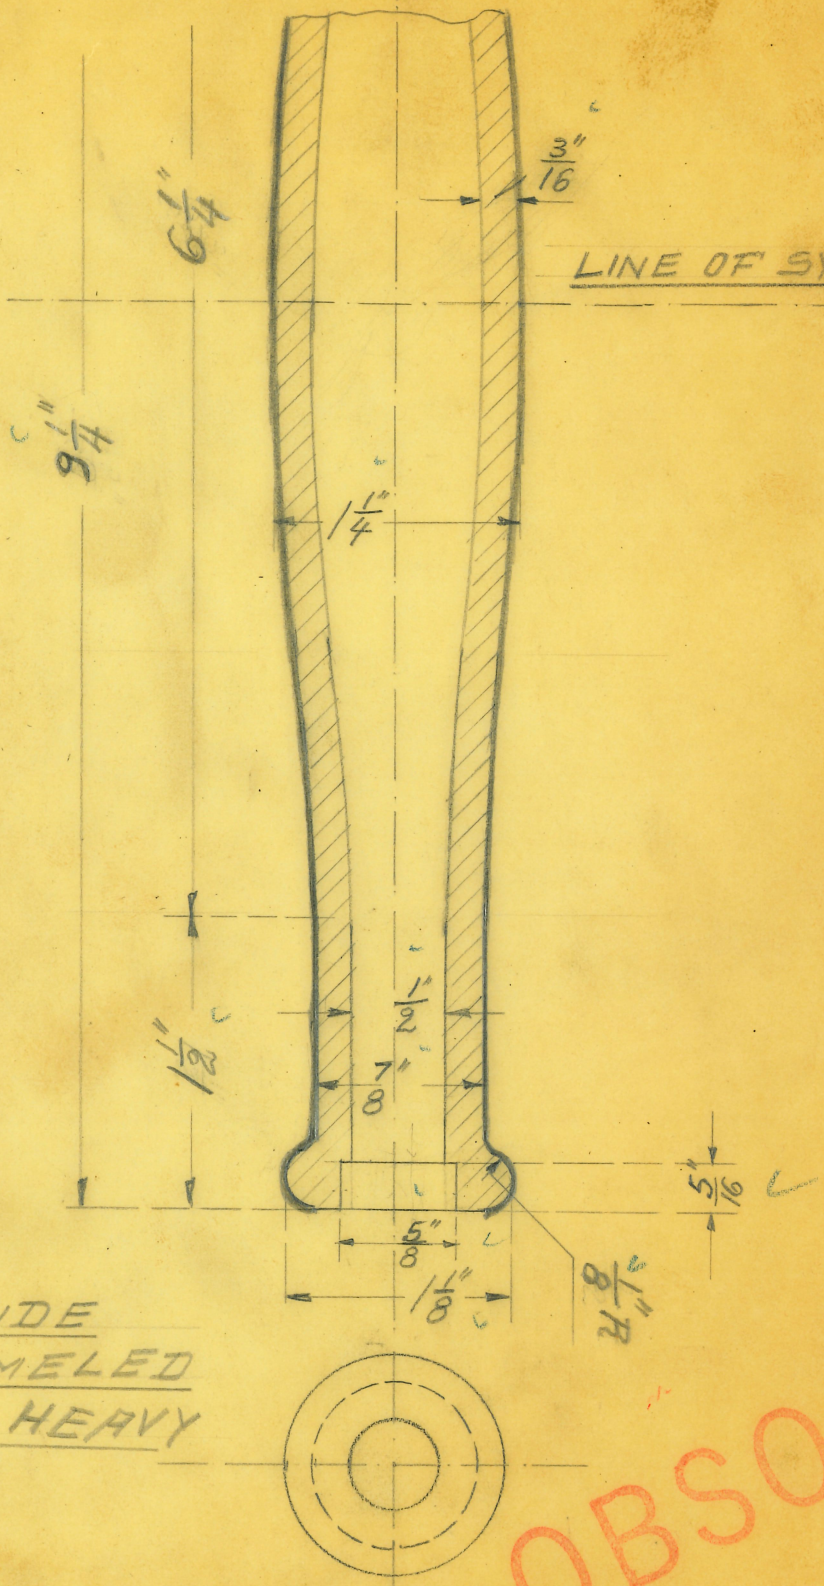

NOTE: OUTSIDE WHITE ENAMELED AS FAR AS HEAVY LINE

(2)

OBSOLETE

SIZE		ISSUE 4/2027	P.D.
KIND	CAST IRON	CHANGED	
SHAPE		" "	
FINISH	PORCELAIN ENAMELED	" "	
TEMP.		" "	
PATT.		" "	

TITLE: HANDLE FOR STAND LOW VOLT GENERATOR

H. G. FISCHER & CO.
2335 WABANSIA AVE.
CHICAGO, ILL.

CAT. NO.

PART NO. 5485 F

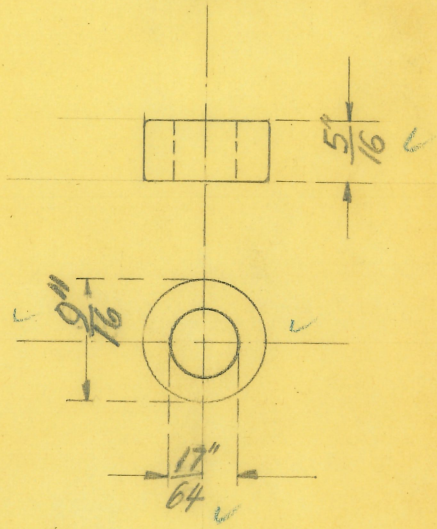

OBSOLETE

(4)

SIZE		ISSUE 4/2027	9.8.
KIND	C.R. STEEL	CHANGED	
SHAPE		" "	
FINISH		" "	
TEMP.		" "	
PATT.		" "	

TITLE: BUSHING FOR STAND HANDLE
LOW VOLT GENERATOR

H. G. FISCHER & CO.
2335 WABANSIA AVE.
CHICAGO, ILL.

CAT. NO.

PART NO. 5485 1/2 A

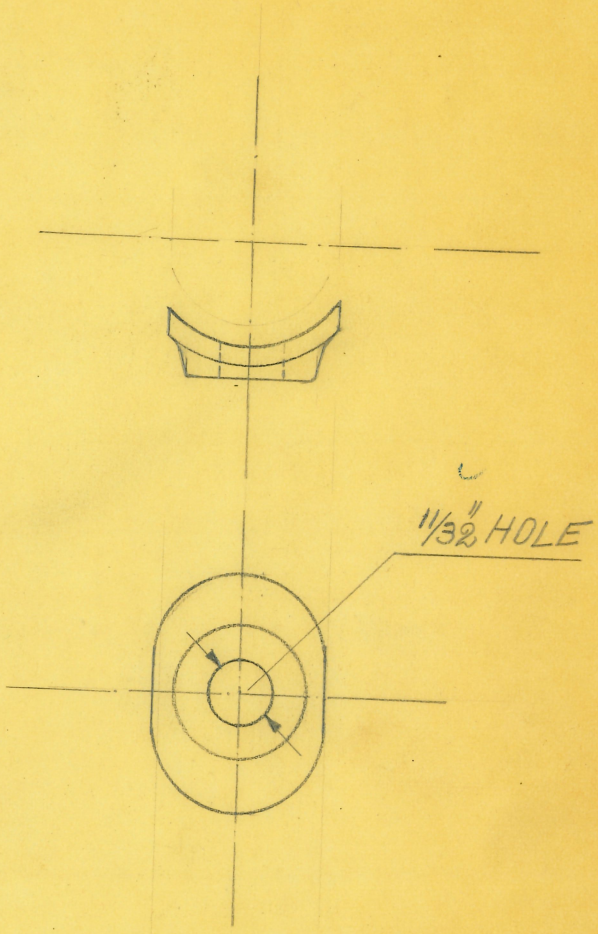

FULL SIZE

OBSOLETE

(4)

SIZE		ISSUE 4/2027	P.D.
KIND	BRASS	CHANGED	
SHAPE		" "	
FINISH	CRYSTALIZED	" "	
TEMP.		" "	
PATT.		" "	

TITLE: CLAMP WASHER
LOW VOLT GEN. STAND

H. G. FISCHER & CO.
2335 WABANSIA AVE.
CHICAGO, ILL.

CAT. NO.

PART NO. 5486 F

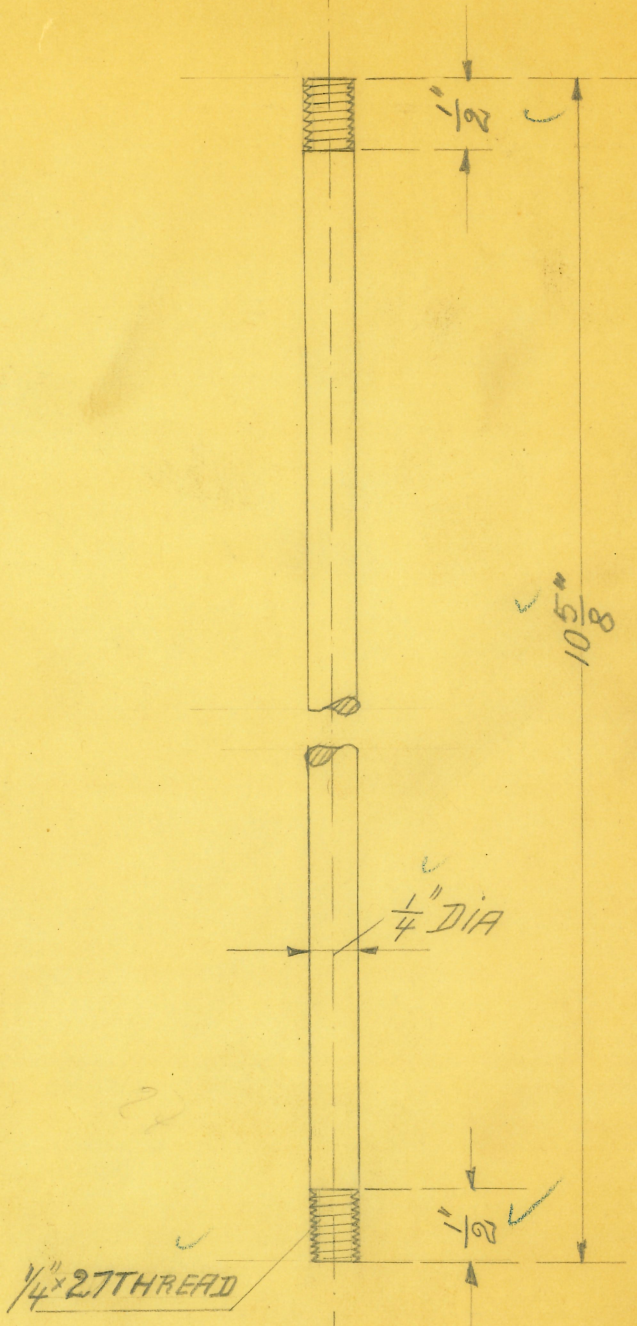

OBSOLETE

(2)

SIZE		ISSUE 4/20/27	P.D.
KIND	C.R. STEEL	CHANGED	
SHAPE		" "	
FINISH		" "	
TEMP.		" "	
PATT.		" "	

TITLE: CENTER ROD FOR STAND HANDLE
LOW VOLT GENERATOR

H. G. FISCHER & CO.
2335 WABANSIA AVE.
CHICAGO, ILL.

CAT. NO.

PART NO. 5487

NOTE: INSIDE WHITE ENAMELED

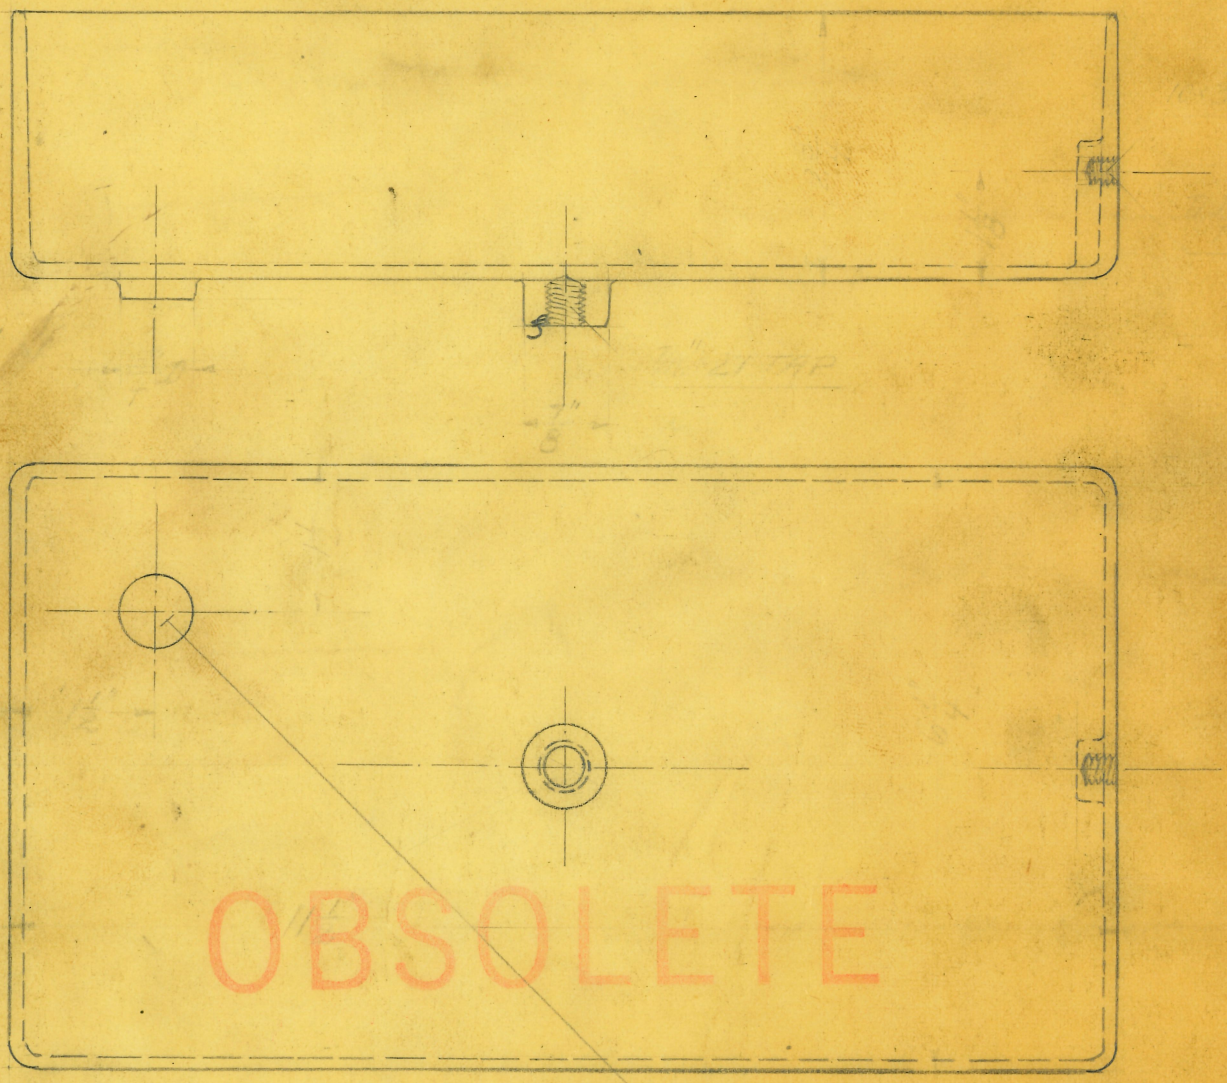

OBSOLETE

NO TAPHOLE OTHERWISE

SAME AS PART NO. 5488½

SIZE		ISSUE 4/2027	P.B.
KIND	CAST IRION	CHANGED	
SHAPE		" "	
FINISH	PORCELAIN ENAMELED	" "	
TEMP.		" "	
PATT.		" "	

TITLE: PAN

LOW VOLT GENERATOR

H. G. FISCHER & CO.
2335 WABANSIA AVE.
CHICAGO, ILL.

CAT. NO.

PART NO. 5488F

NOTE: INSIDE WHITE ENAMELED.

HALF SIZE

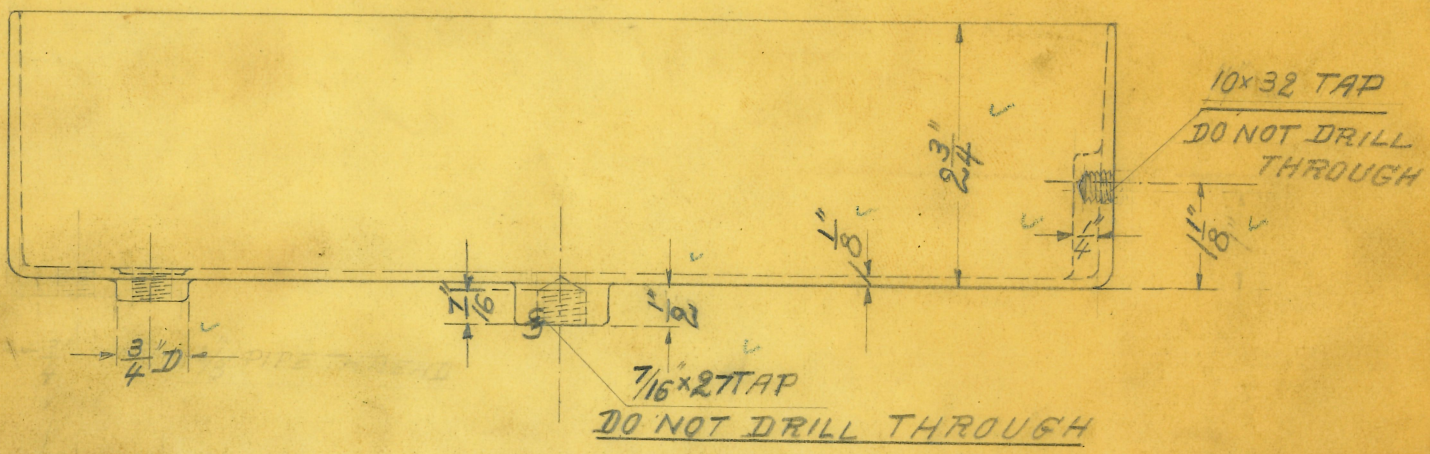

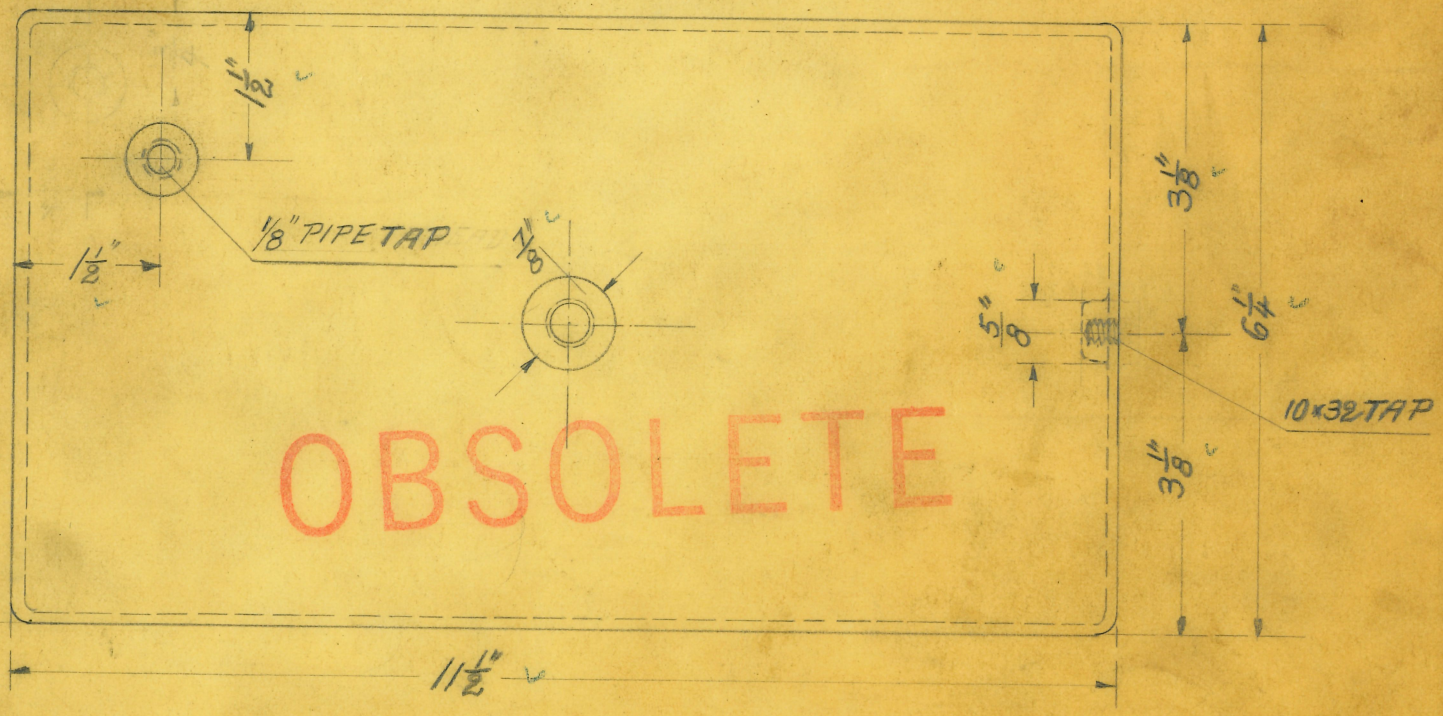

(2)

SIZE		ISSUE 4-20-27	PB	TITLE: PAN LOW VOLT GENERATOR
KIND	CAST IRON	CHANGED		
SHAPE		" "		
FINISH	PORCELAIN ENAMELED	" "		
TEMP.		" "		
PATT.		" "		

H. G. FISCHER & CO.
2335 WABANSIA AVE.
CHICAGO, ILL.

CAT. NO.

PART NO. 5488 1/2

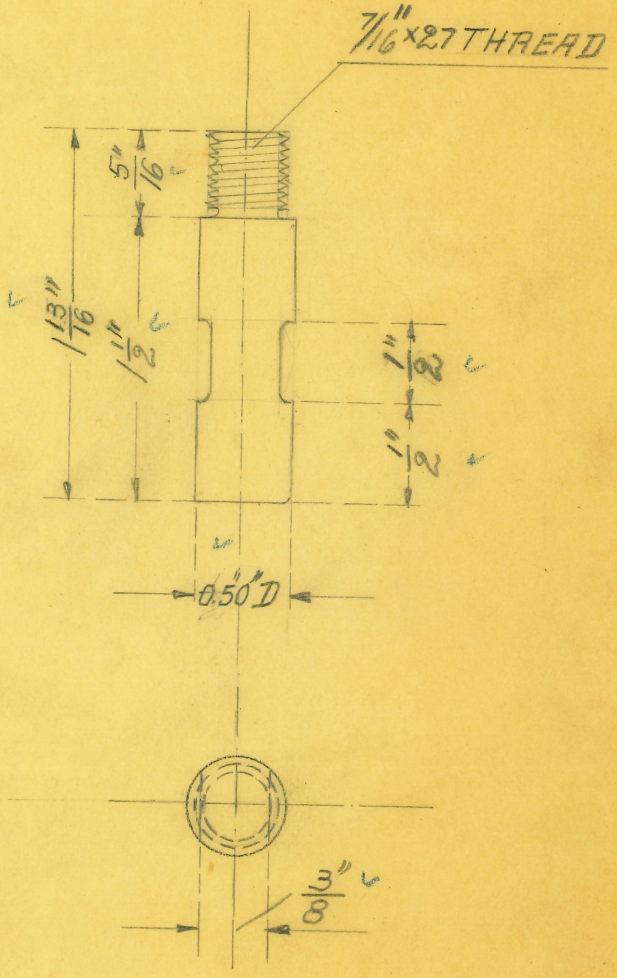

OBSOLETE

(2)

SIZE		ISSUE 4/2027	JD
KIND	BRASS	CHANGED	
SHAPE		" "	
FINISH		" "	
TEMP.		" "	
PATT.		" "	

TITLE: SWIVEL PIN FOR PAN
LOW VOLT GENERATOR

H. G. FISCHER & CO.
2335 WABANSIA AVE.
CHICAGO, ILL.

CAT. NO.

PART NO. 5489

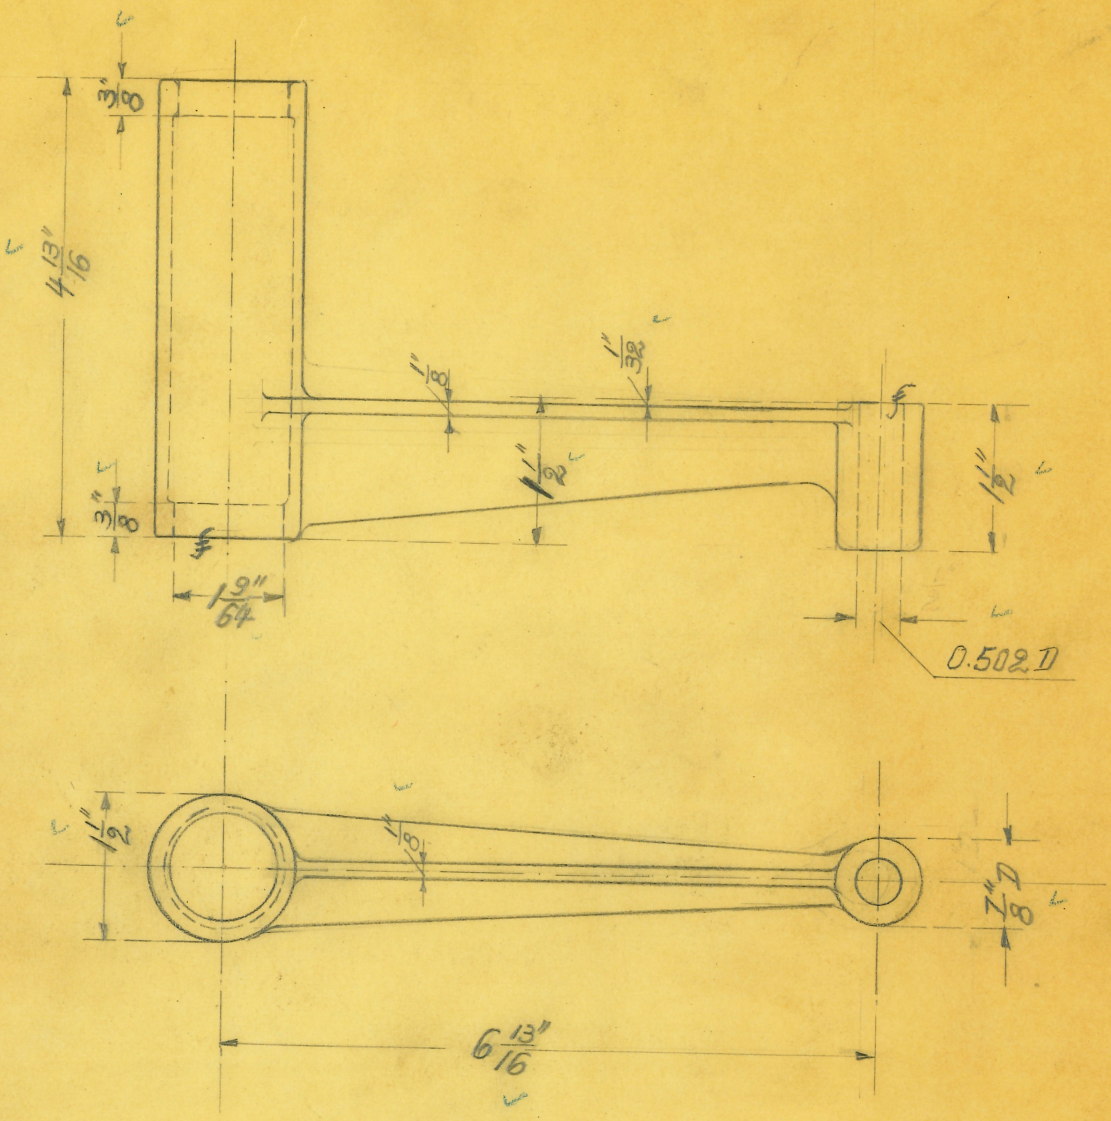

HALF SIZE

OBSOLETE

(2)

SIZE		ISSUE 4/2027	PF
KIND	CAST IRON	CHANGED	
SHAPE		" "	
FINISH		" "	
TEMP.		" "	
PATT.		" "	

TITLE: PAN SUPPORT
LOW VOLT GENERATOR

H. G. FISCHER & CO.
2335 WABANSIA AVE.
CHICAGO, ILL.

CAT. NO.

PART NO. 5490 F

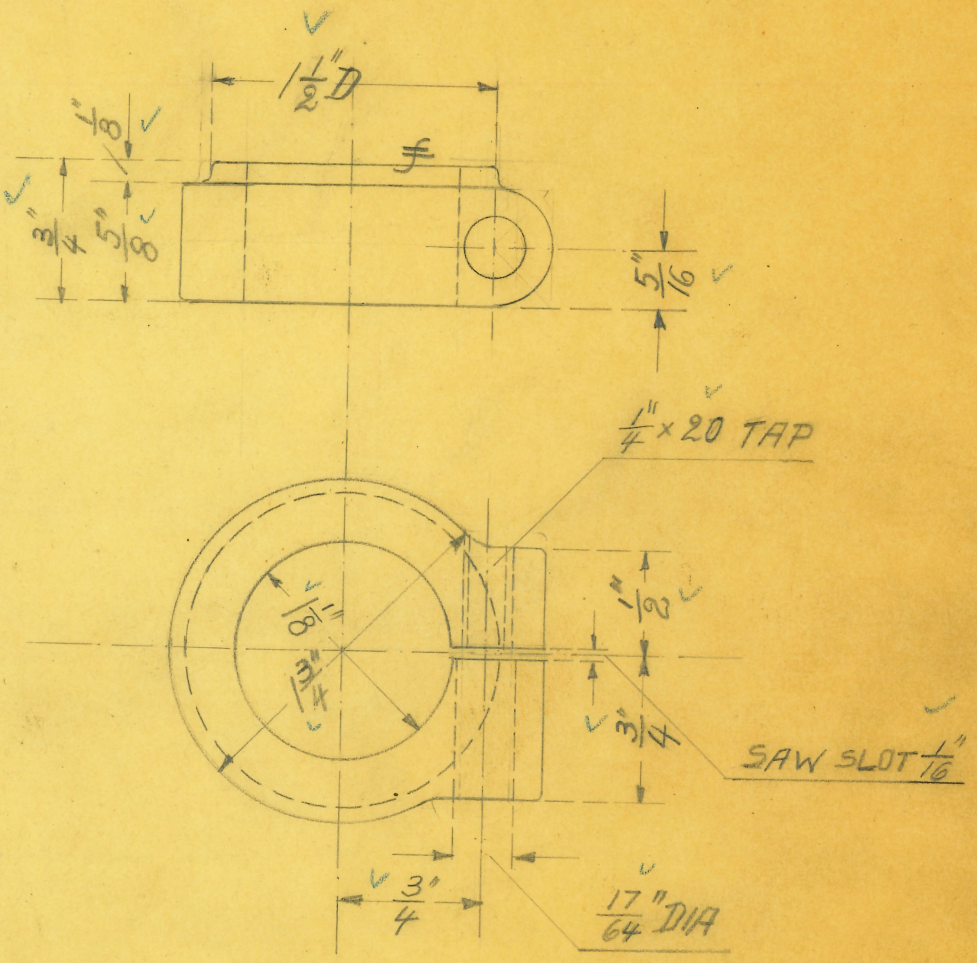

OBSOLETE

(2)

SIZE		ISSUE 4/2027	PD
KIND	CAST IRON	CHANGED	
SHAPE		" "	
FINISH		" "	
TEMP.		" "	
PATT.		" "	

TITLE: PAN SUPPORT CLAMP
LOW VOLT GENERATOR

H. G. FISCHER & CO.
2335 WABANSIA AVE.
CHICAGO, ILL.

CAT. NO.

PART NO. 5491 F

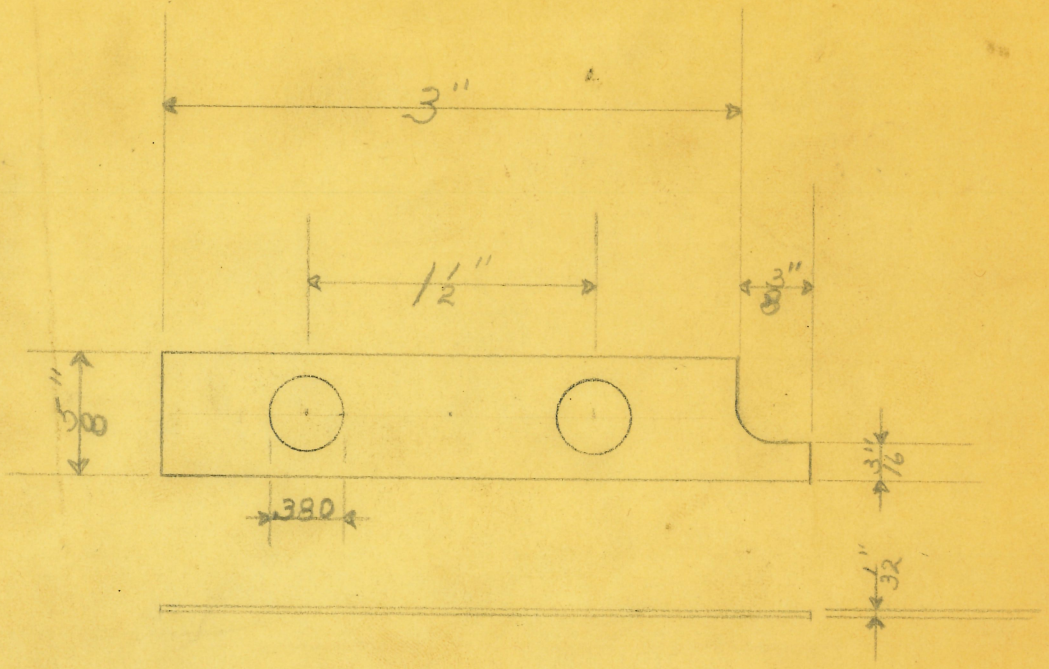

OBSOLETE

(39)

SIZE		ISSUE	
KIND	COPPER	CHANGED	
SHAPE		" "	
FINISH		" "	
TEMP.		" "	
PATT.		" "	

TITLE: WAVEGEN. ARMATURE SEGMENT

H. G. FISCHER & CO.
2335 WABANSIA AVE.
CHICAGO, ILL.

CAT. NO.

PART NO. 5495

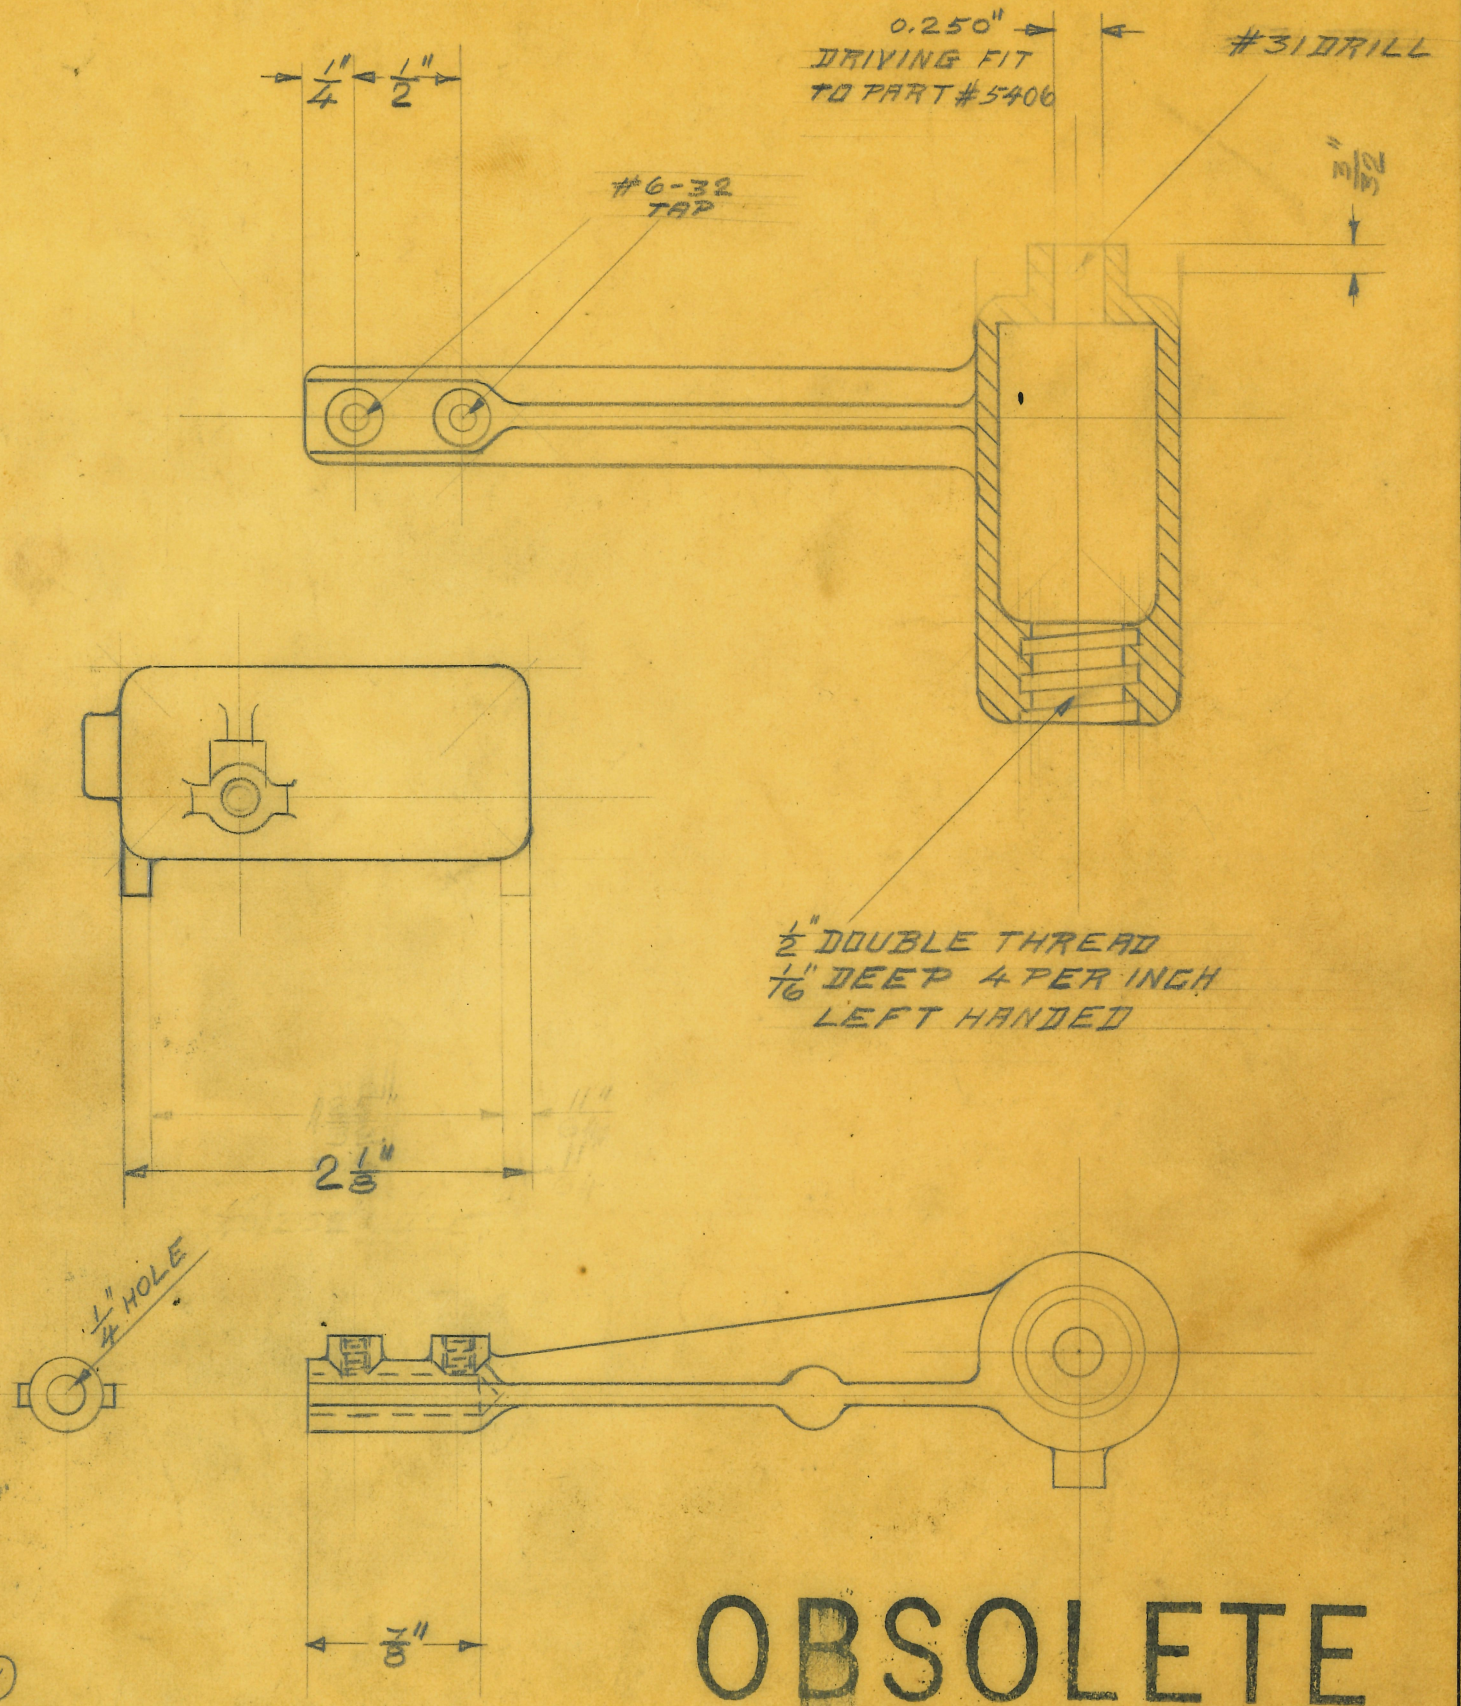

OBSOLETE

SIZE		ISSUE 7-8-26	E.	TITLE: POINTER-SUPPORT WAVE-GENERATOR	
KIND	BRASS	CHANGED			
SHAPE		" "12-14-26	W.T.		
FINISH	W.P.	" "			
TEMP.		" "		H. G. FISCHER & CO. 2335 WABANSIA AVE. CHICAGO, ILL.	CAT. NO.
PATT.	9212-944	" "			PART NO. 5350F.A

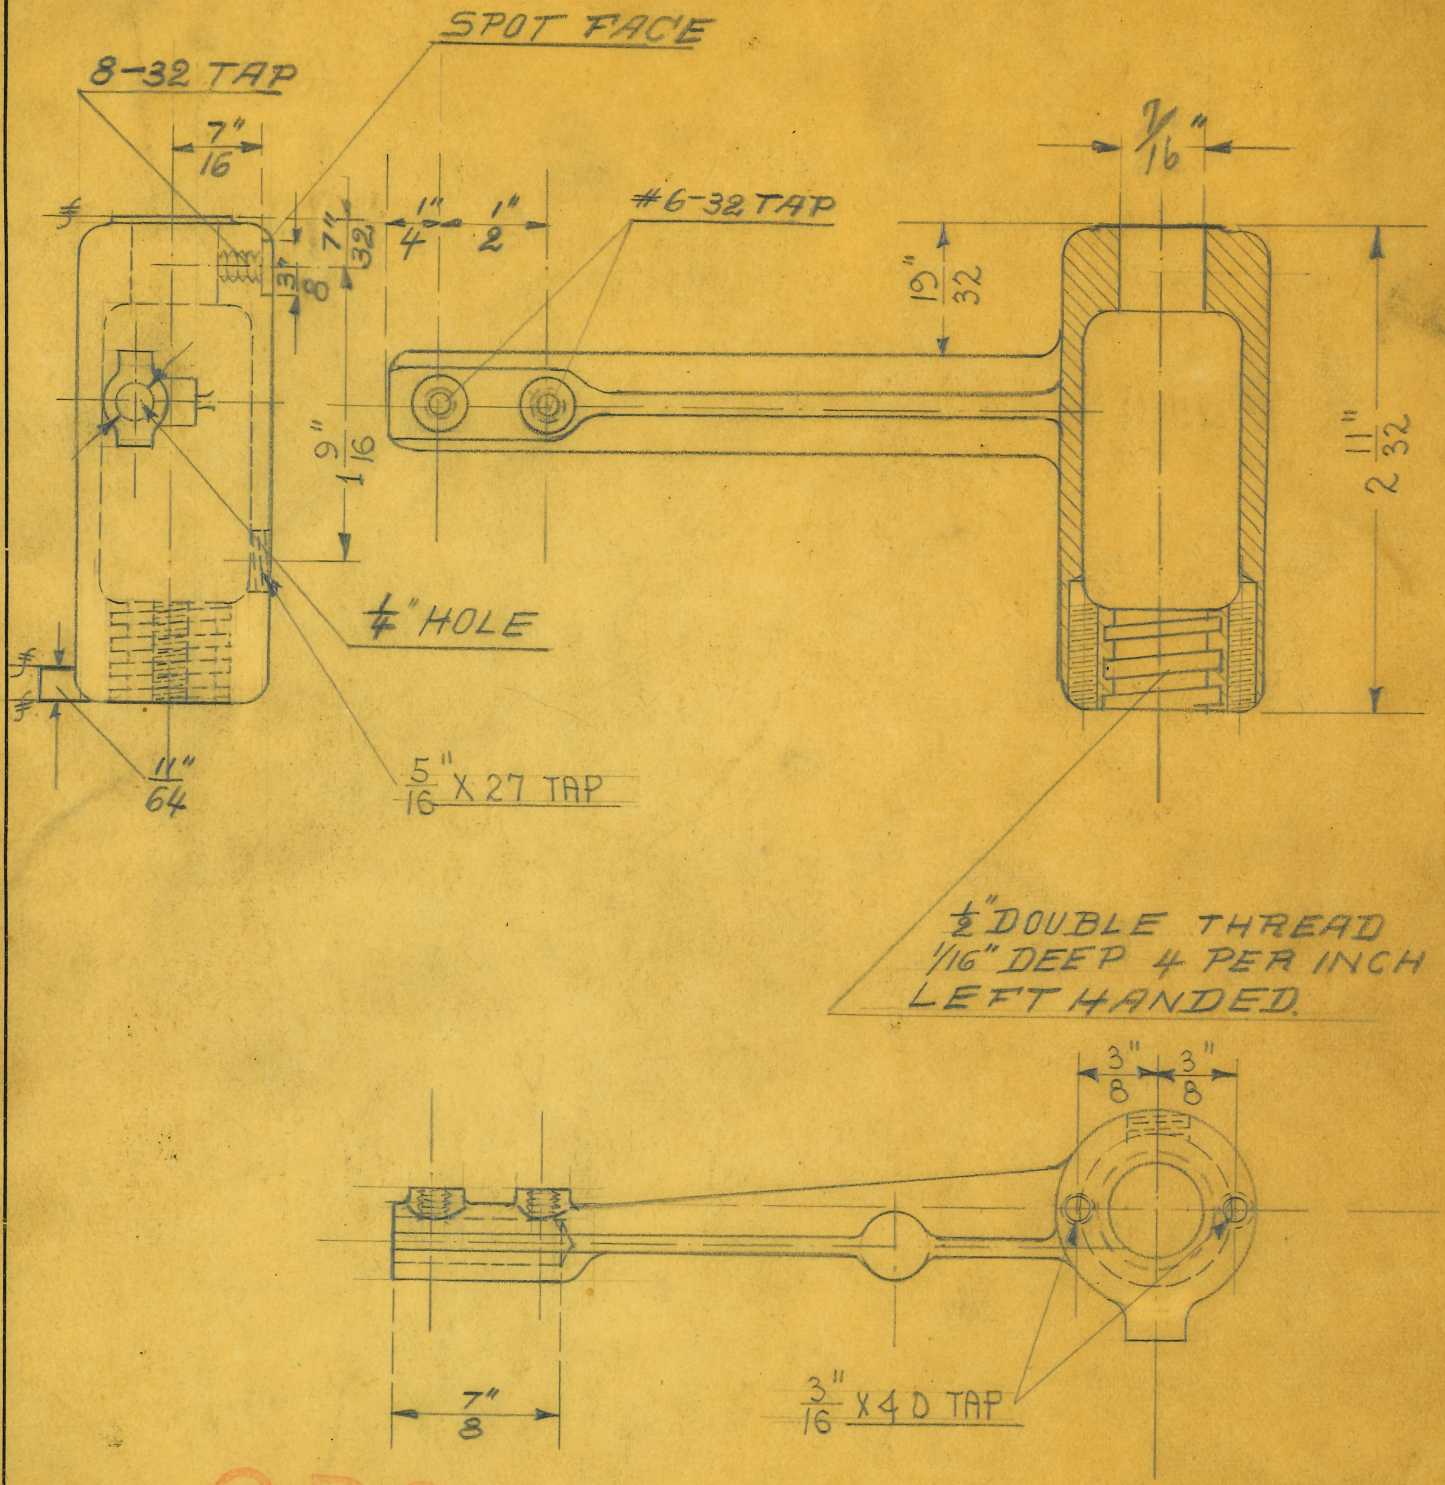

OBSOLETE

(1)

SIZE		ISSUE	
KIND	BRASS	CHANGED	
SHAPE		" "	
FINISH	W.P.	" "	
TEMP.		" "	
PATT.		" "	

TITLE: POINTER SUPPORT
LOW VOLT GENERATOR

H. G. FISCHER & CO.
2335 WABANSIA AVE.
CHICAGO, ILL.

CAT. NO.

PART NO. 5350FB

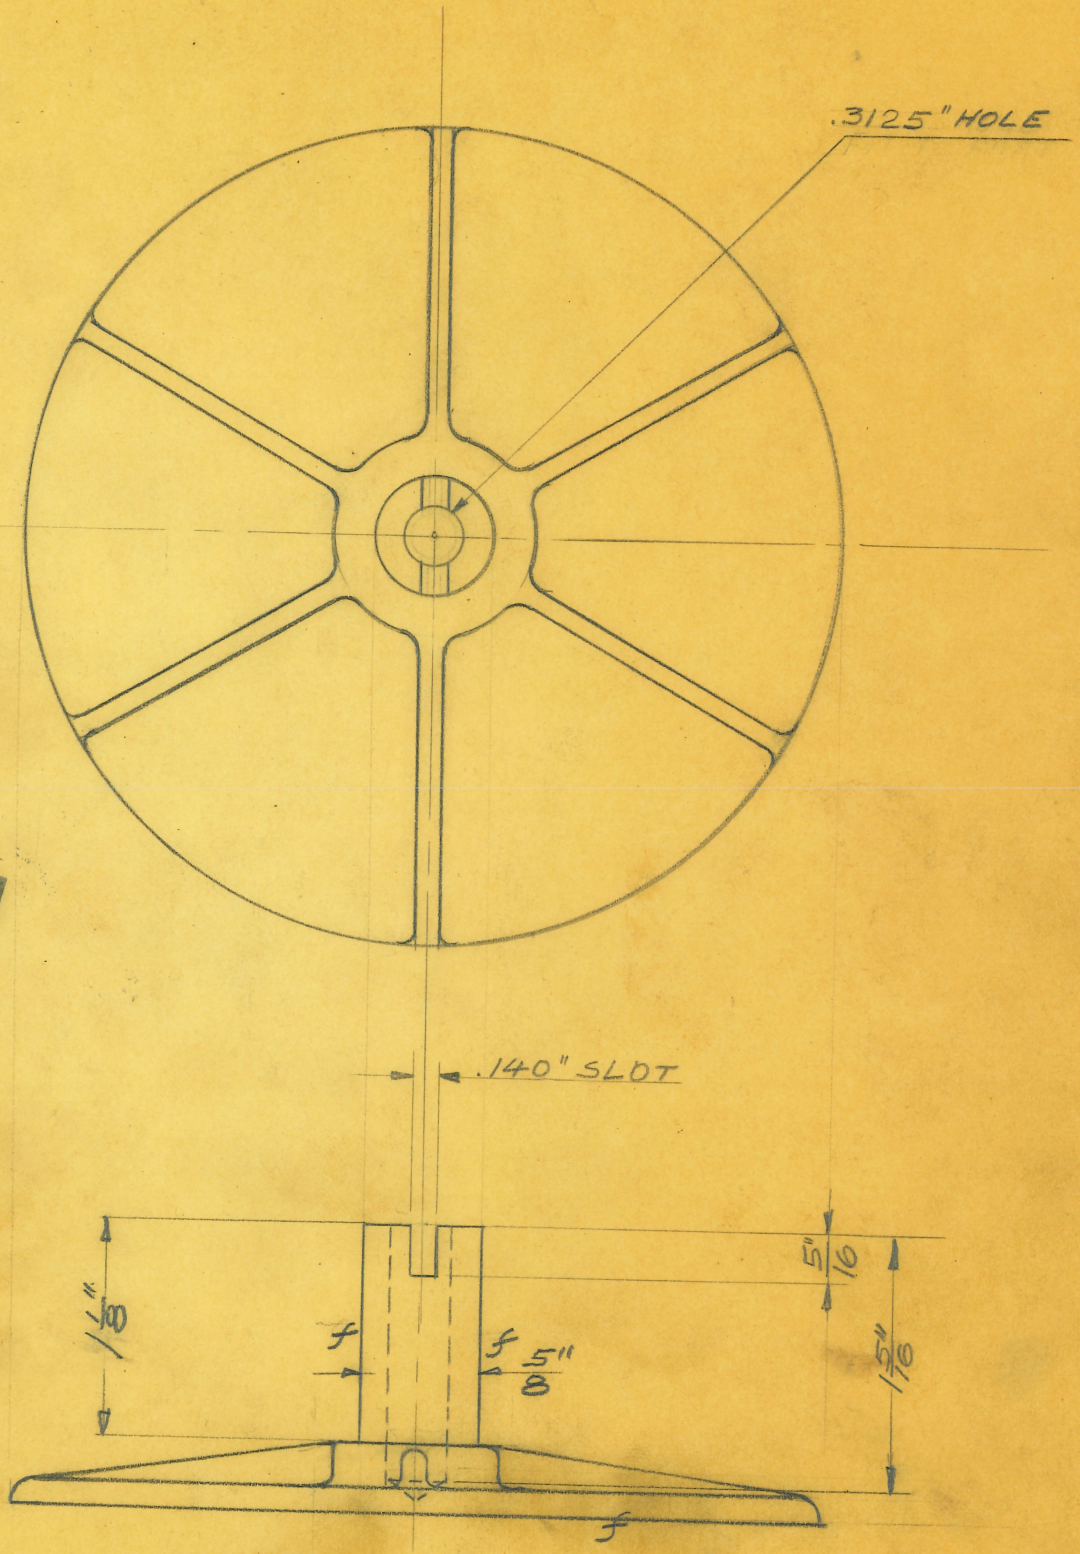

OBSOLETE

1

SIZE		ISSUE 10-20-26	O.J.
KIND	BRASS CASTING	CHANGED	
SHAPE		" "11-29-26	O.J.
FINISH		" "	
TEMP.		" "	
PATT.		" "	

TITLE:

WAVE-GENERATOR FRICTION DISC

H. G. FISCHER & CO.
2335 WABANSIA AVE.
CHICAGO, ILL.

CAT. NO.

PART NO. 5351F.A.

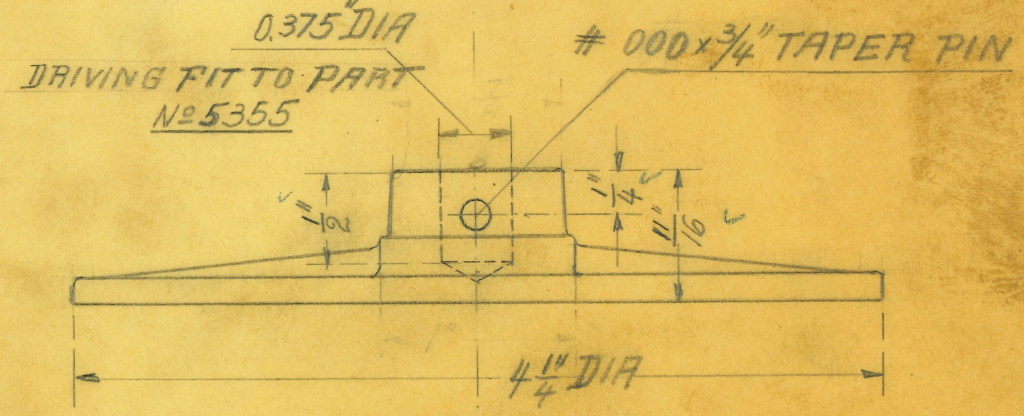

OBSOLETE

(1)

SIZE		ISSUE 4/2027 PB	TITLE: FRICTION DISC LOW VOLT GENERATOR.	
KIND	CAST IRON	CHANGED		
SHAPE		" "		
FINISH		" "		
TEMP.		" "		
PATT.		" "		
			H. G. FISCHER & CO. 2335 WABANSIA AVE. CHICAGO, ILL.	CAT. NO.
				PART NO. 5351 F, 7.B.

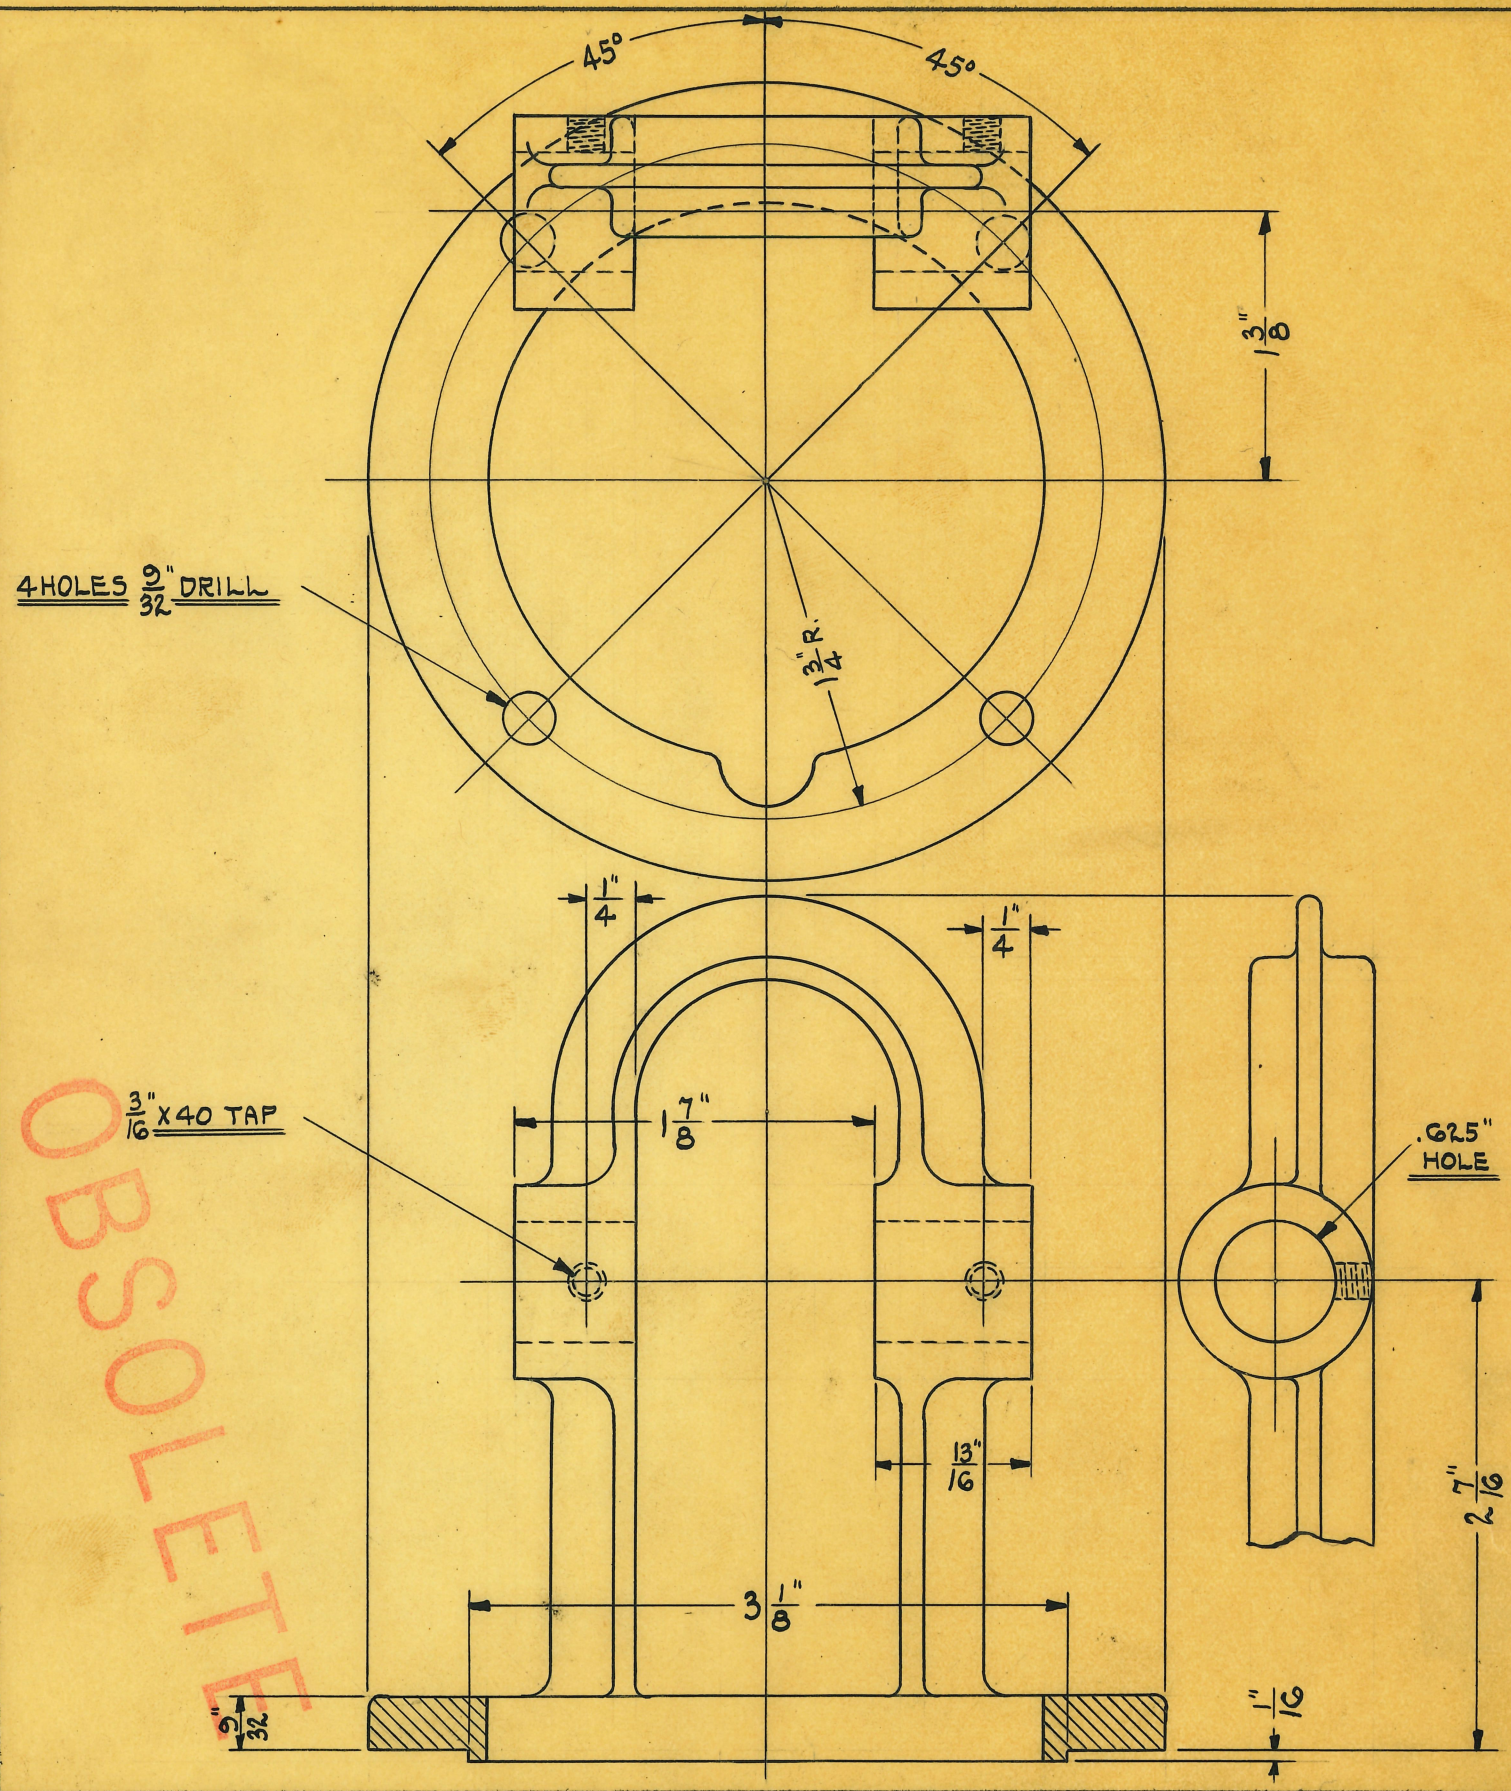

OBSOLETE

SIZE		ISSUE	H.E.	6-16-30	TITLE: WAVE GENERATOR WORM GEAR SUPPORT
KIND	C. IRON	CHANGED			
SHAPE		" "			
FINISH	BLACK JAPAN	" "			
TEMP.		" "			
PATT.		" "			

H. G. FISCHER & CO.
2335 WABANSIA AVE.
CHICAGO, ILL.

CAT. NO.

PART NO. 5352FAB

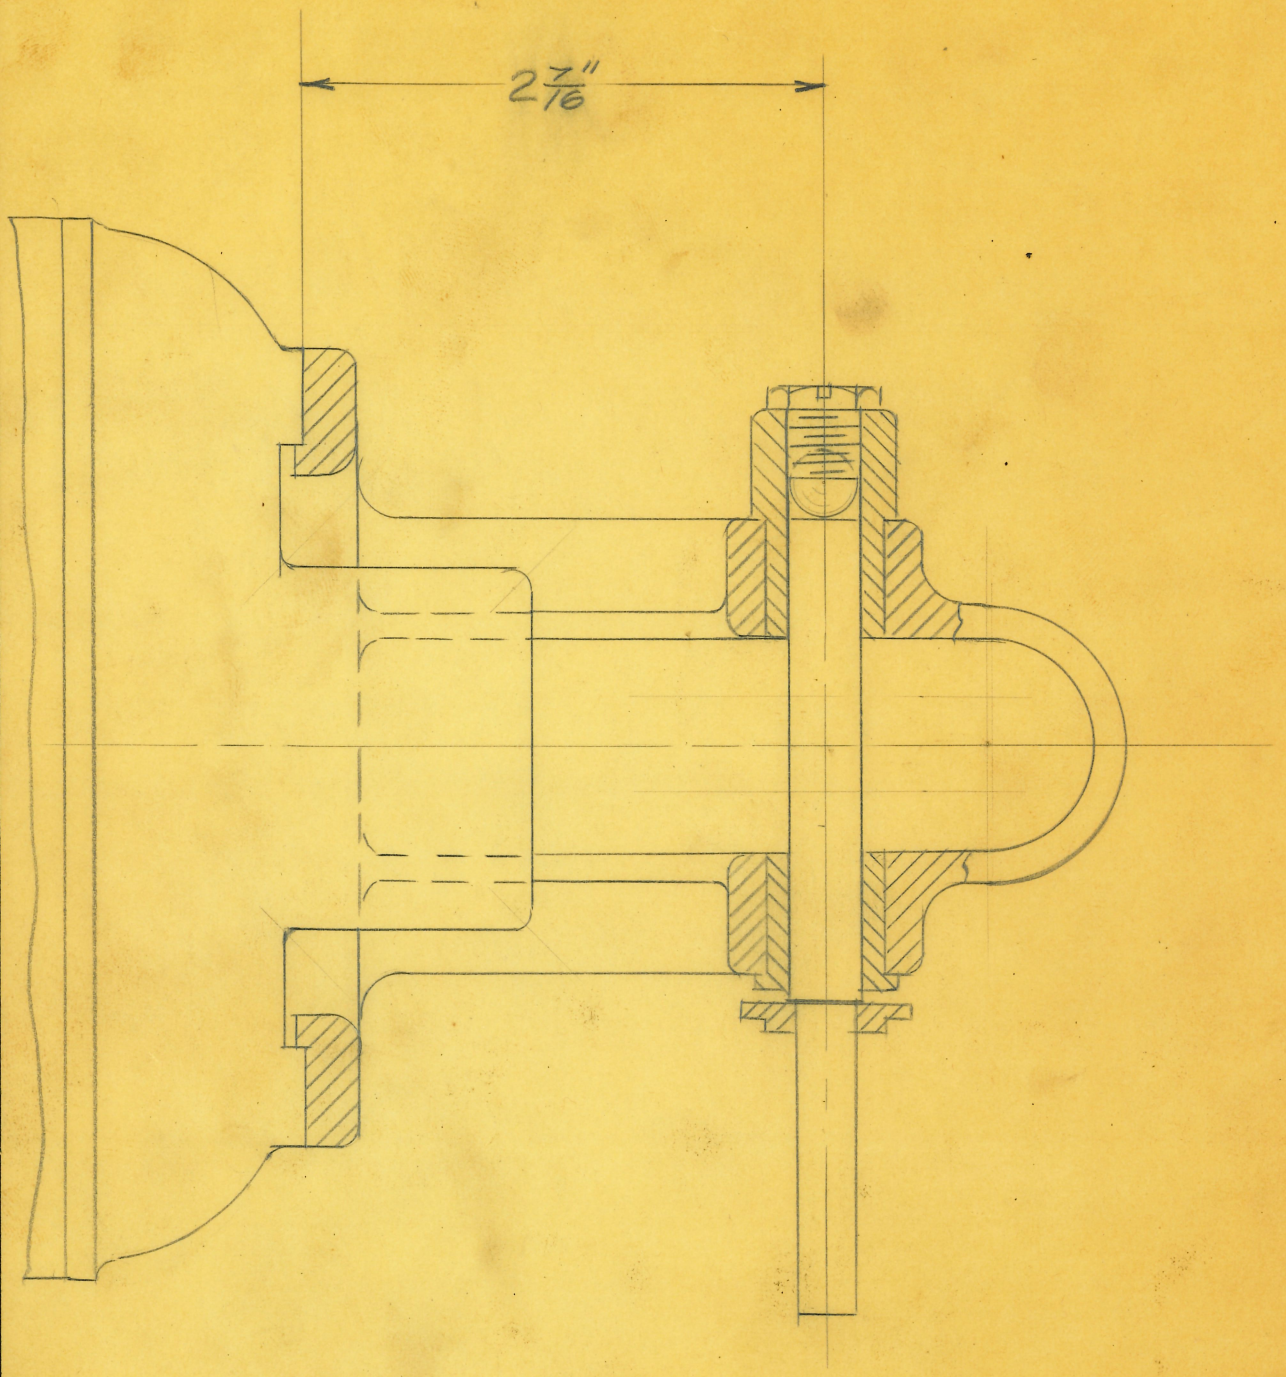

OBSOLETE

SIZE		ISSUE 8-11-26	E.J.
KIND		CHANGED	
SHAPE		" "	
FINISH		" "	
TEMP.		" "	
PATT.		" "	

TITLE:

ASSEMBLY OF WORMGEAR
WAVE-GENERATOR

H. G. FISCHER & CO.
2335 WABANSIA AVE.
CHICAGO, ILL.

CAT. NO.

PART NO. 5352G

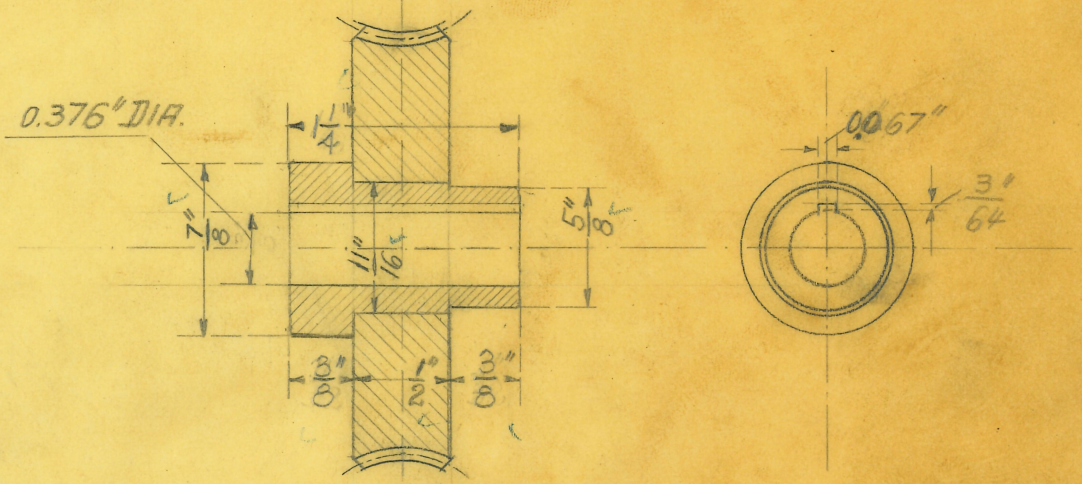

OBSOLETE

(1)

SIZE		ISSUE	
KIND		CHANGED	
SHAPE		" "	
FINISH		" "	
TEMP.		" "	
PATT.		" "	

TITLE:

WORM GEAR ASSEMBLY
LOW VOLT GENERATOR

H. G. FISCHER & CO.
2335 WABANSIA AVE.
CHICAGO, ILL.

CAT. NO.

PART NO. 5352 1/2 GA

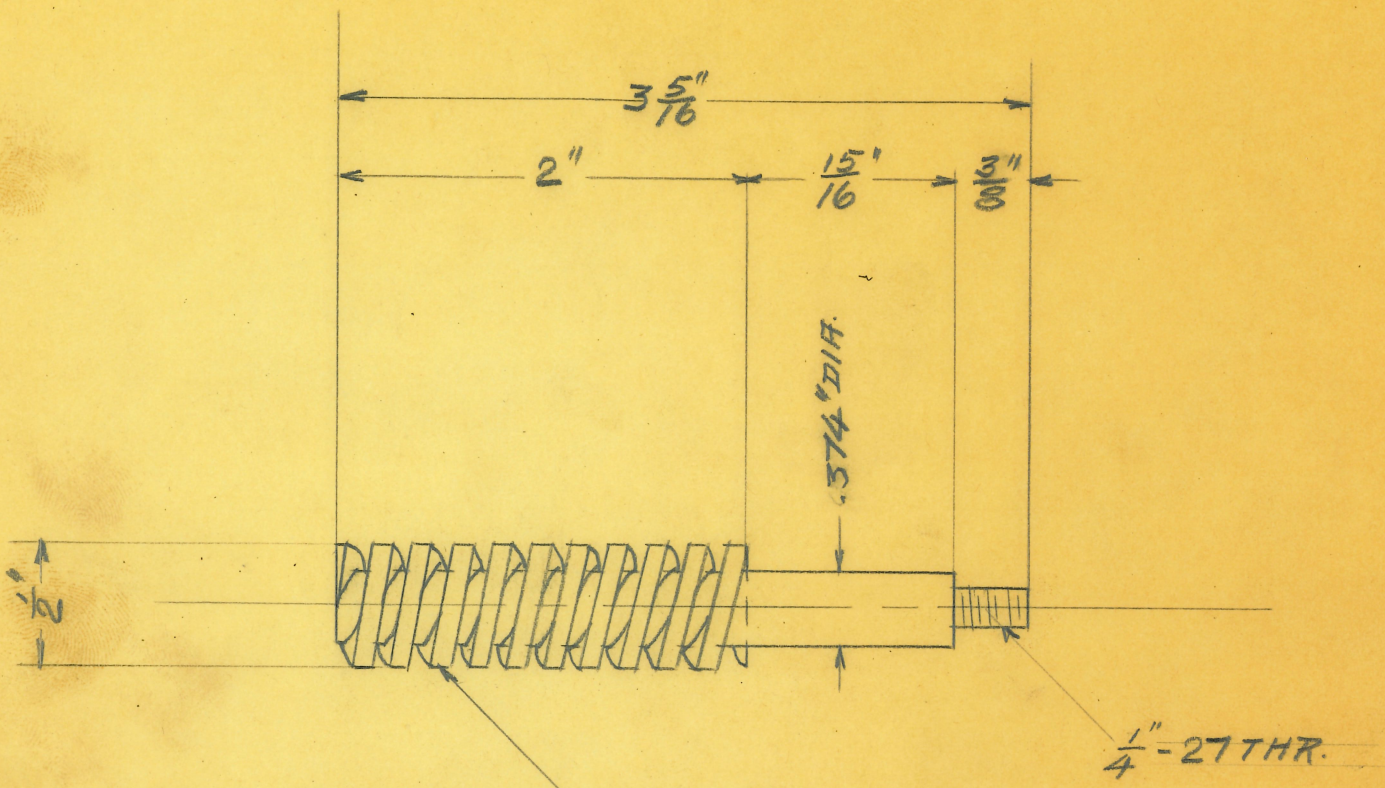

OBSOLETE

(1)

SIZE		ISSUE 7-12-26	©
KIND	C.R. STEEL	CHANGED	
SHAPE		" "	
FINISH		" "	
TEMP.		" "	
PATT.		" "	

TITLE:

REGULATING SCREW
WAVE-GENERATOR

H. G. FISCHER & CO.
2335 WABANSIA AVE.
CHICAGO, ILL.

CAT. NO.

PART NO. 5353

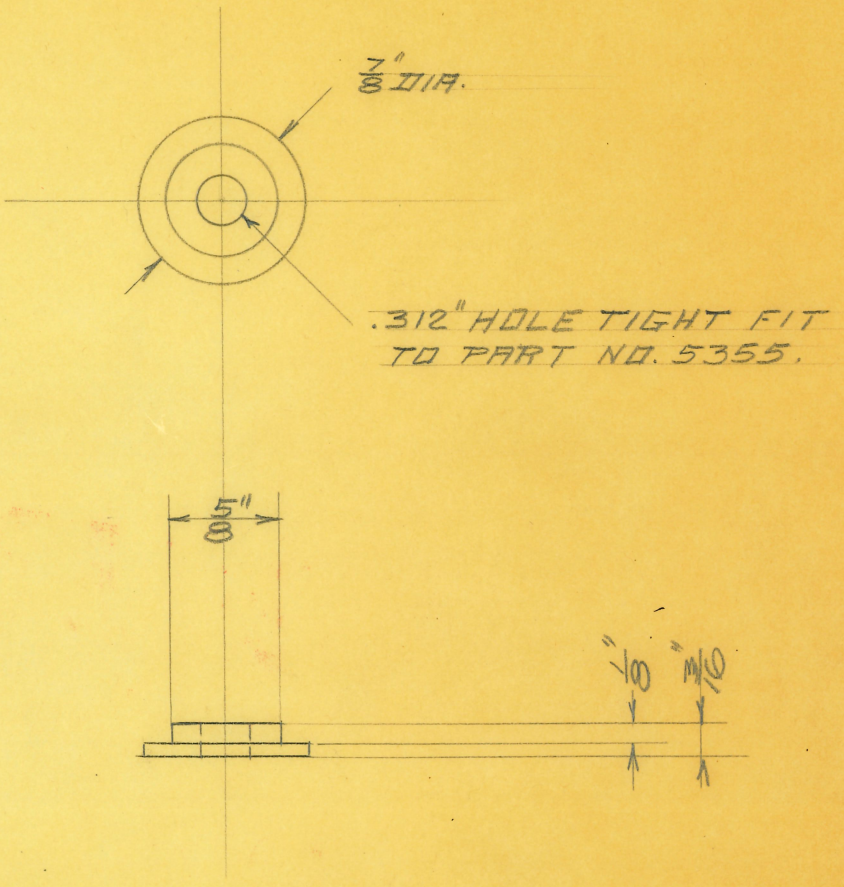

OBSOLETE

(1)

SIZE		ISSUE 9-13-26	EJ
KIND	BRASS	CHANGED	
SHAPE		" "	
FINISH		" "	
TEMP.		" "	
PATT.		" "	

TITLE: WAVE-GENERATOR SPRINGHOLDER

H. G. FISCHER & CO.
2335 WABANSIA AVE.
CHICAGO, ILL.

CAT. NO.

PART NO. 5354

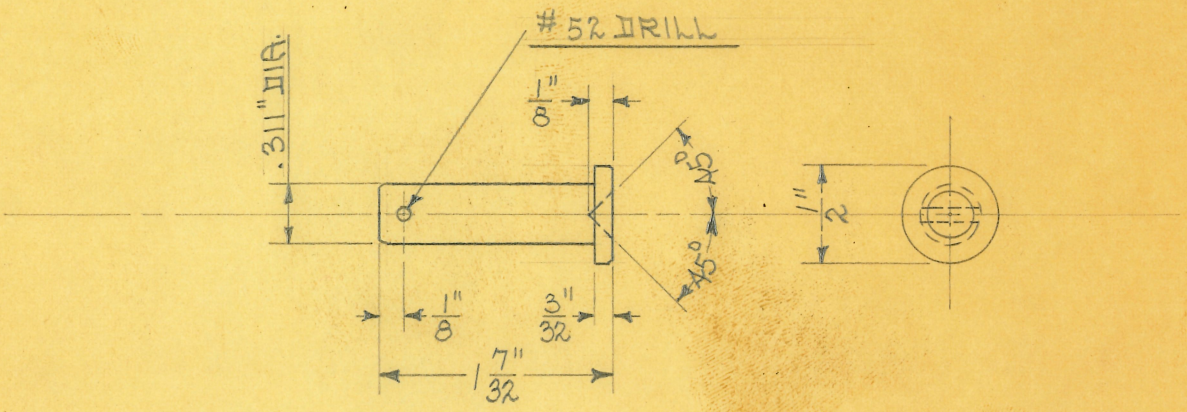

SCALE ~ FULL SIZE

1 REQ'D.

OBSOLETE

SIZE	1/2"	ISSUE 4-20-27	P.D.	TITLE: WAVE GEN. WORM GEAR SHAFT PISTON
KIND	BRASS ROD	CHANGED 9-1-31	A.E.	
SHAPE		" "		
FINISH	W.P.	" "		
TEMP.		" "		H. G. FISCHER & CO. 2335 WABANSIA AVE. CHICAGO, ILL. — CAT. NO. — PART NO. 5354 1/2
PATT.		" "		

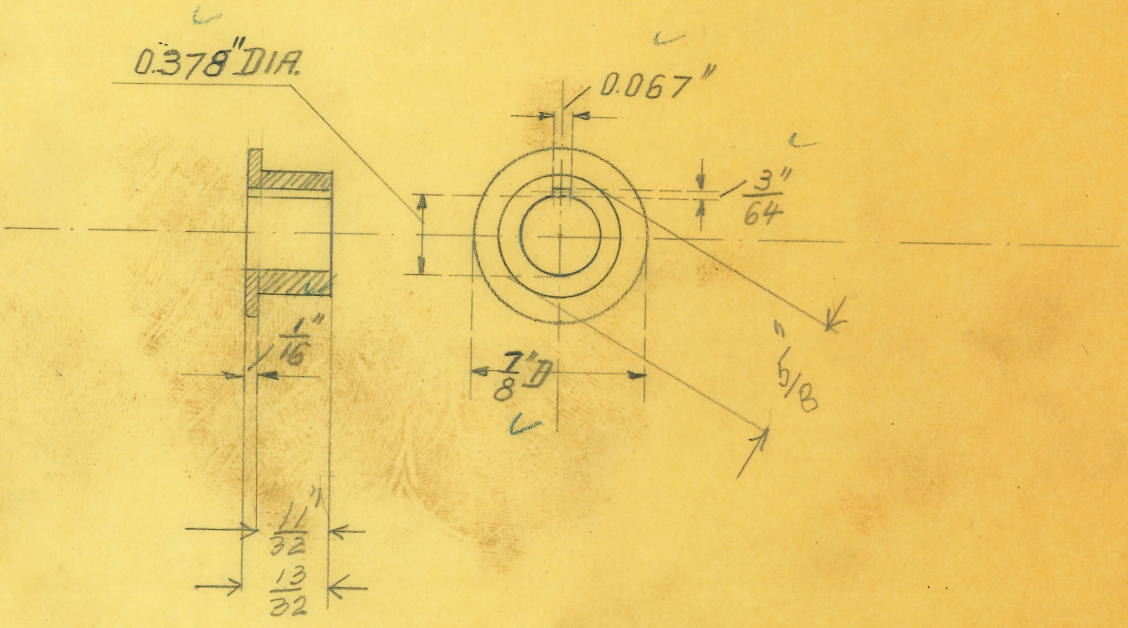

OBSOLETE

(1)

SIZE		ISSUE 4/2027	P.O.	TITLE: WASHER FOR WORM GEAR LOW VOLT GENERATOR
KIND	BRASS	CHANGED		
SHAPE		" "		
FINISH		" "		
TEMP.		" "		H. G. FISCHER & CO. 2335 WABANSIA AVE. CHICAGO, ILL.
PATT.		" "		CAT. NO.

PART NO. 5354 3/4

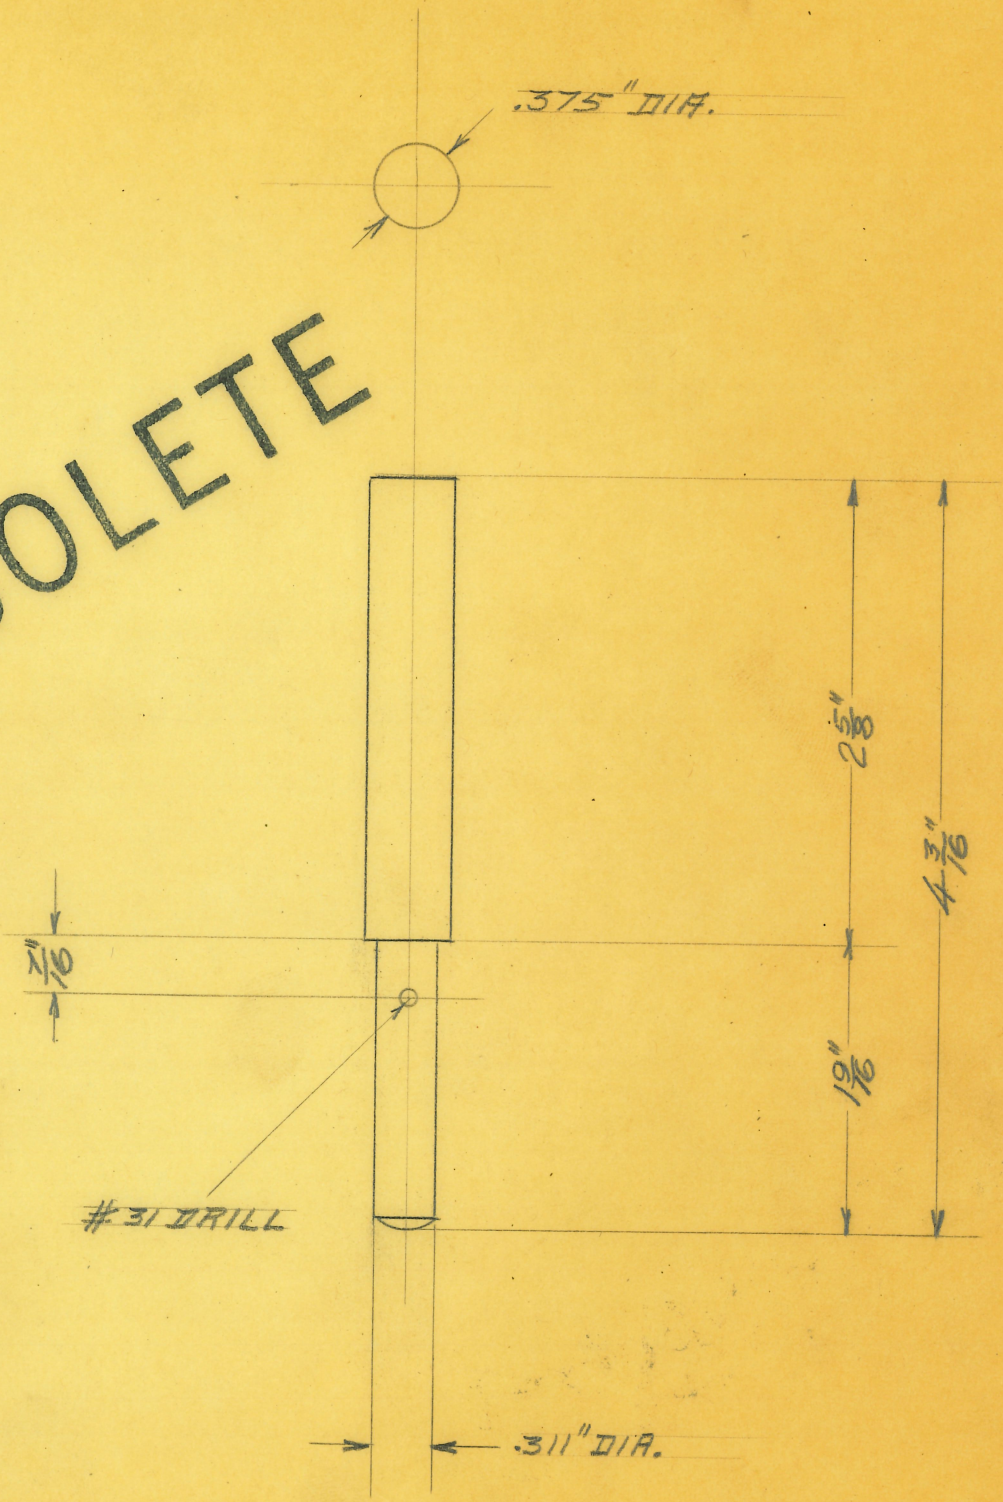

OBSOLETE

(1)

SIZE		ISSUE 7-30-26	C.
KIND	DRILL ROD	CHANGED 11-27-31	"
SHAPE		" "	
FINISH		" "	
TEMP.		" "	
PATT.		" "	

TITLE: SHAFT FOR WORMGEAR WAVE-GENERATOR

H. G. FISCHER & CO.
2335 WABANSIA AVE.
CHICAGO, ILL.

CAT. NO.

PART NO. 5355

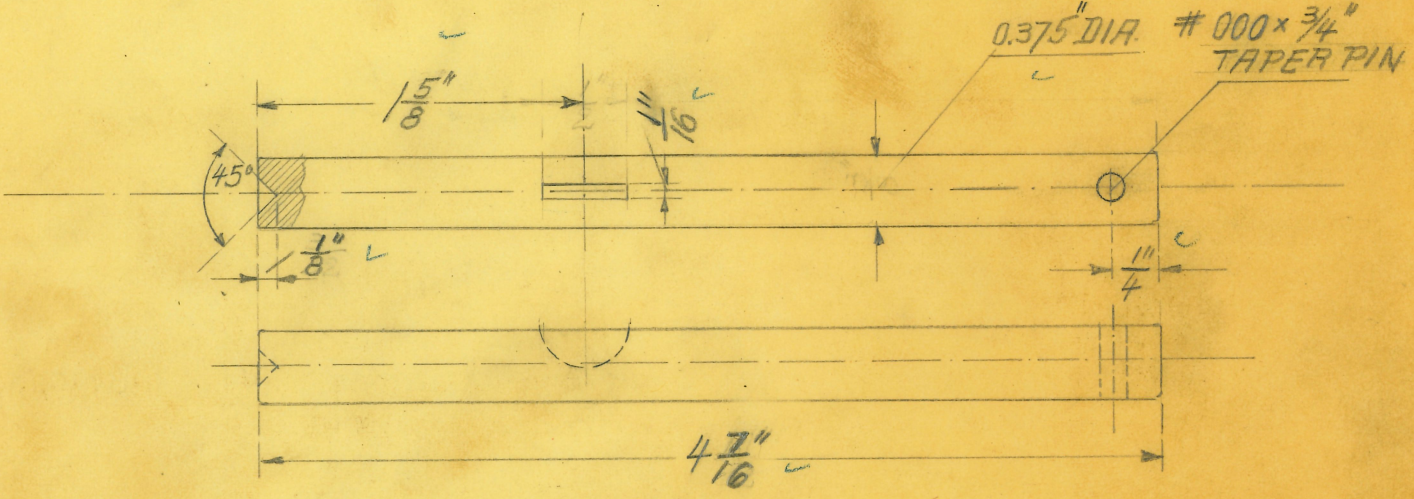

OBSOLETE

(1)

SIZE		ISSUE 4/2027	P8
KIND	DRILL ROD	CHANGED	
SHAPE		" "	
FINISH		" "	
TEMP.		" "	
PATT.		" "	

TITLE: SHAFT FOR WORM GEAR
LOW VOLT GENERATOR

H. G. FISCHER & CO.
2335 WABANSIA AVE.
CHICAGO, ILL.

CAT. NO.

PART NO. 5355 A

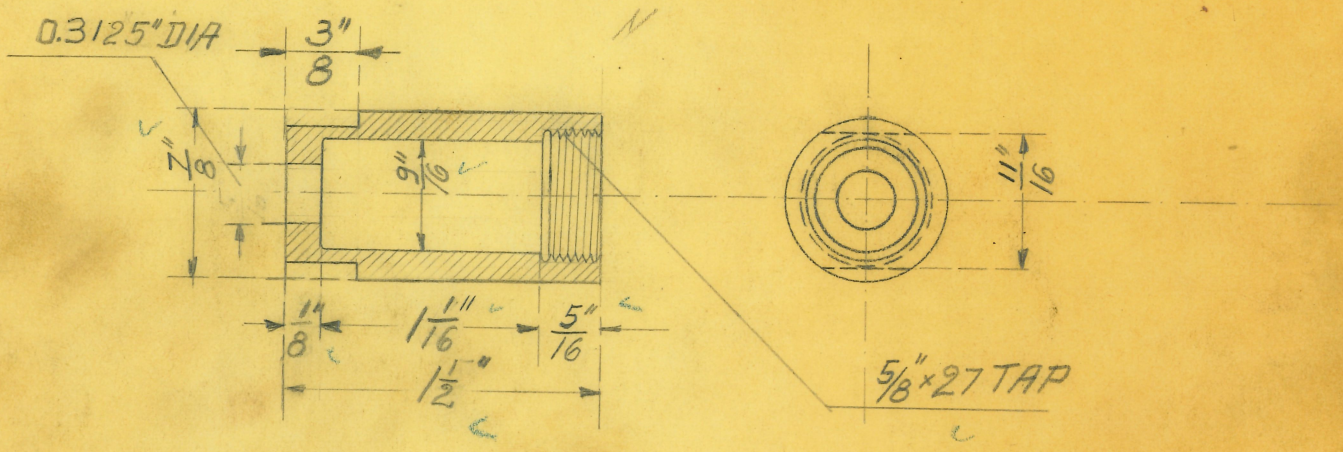

OBSOLETE

(1)

SIZE	7/8"	ISSUE	
KIND	BRASS	CHANGED	
SHAPE		" "	
FINISH	W.P.	" "	
TEMP.		" "	
PATT.		" "	

TITLE: CAP FOR WORM GEAR SPRING
LOW VOLT GENERATOR

H. G. FISCHER & CO.
2335 WABANSIA AVE.
CHICAGO, ILL.

CAT. NO.

PART NO. 5355 1/2

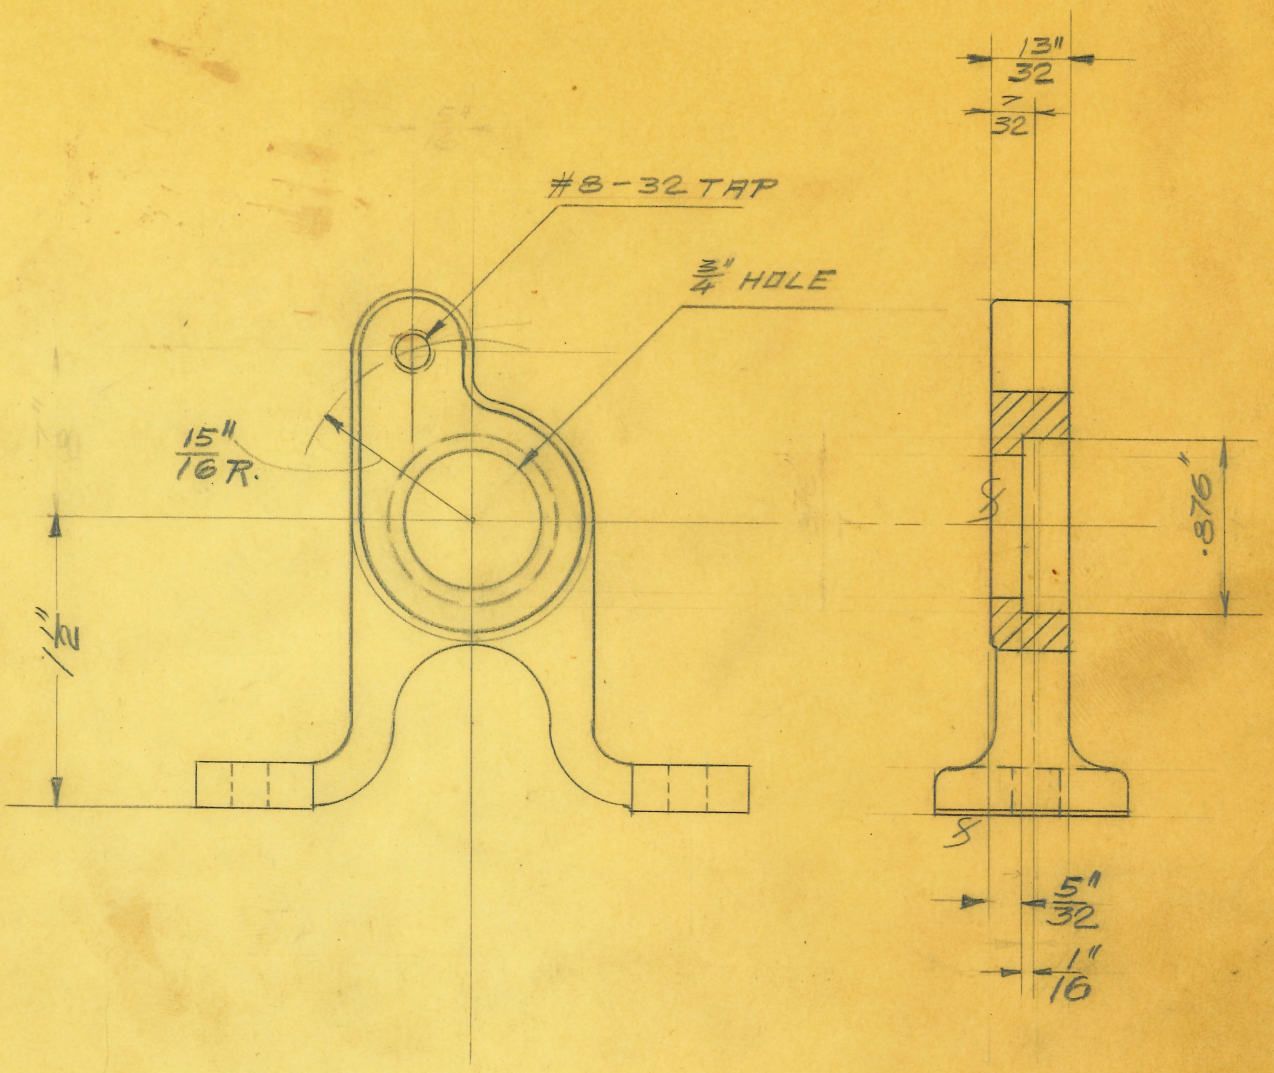

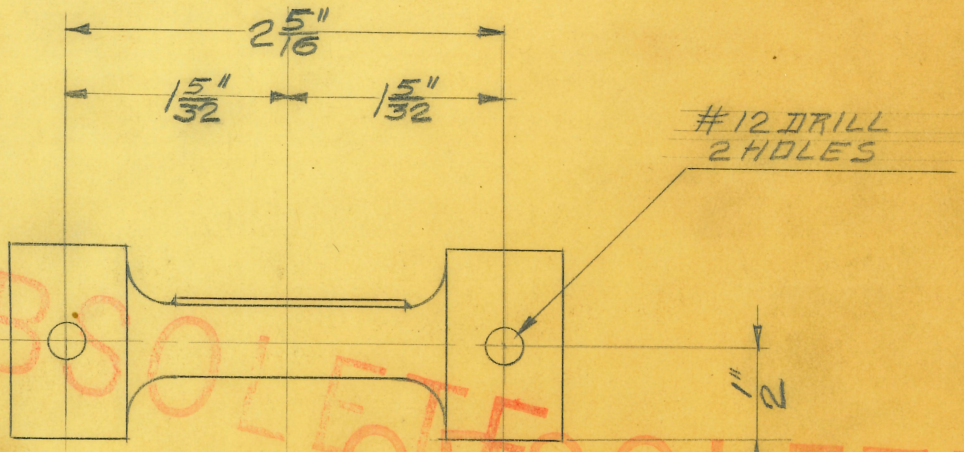

OBSOLETE
OBSOLETE

/

SIZE		ISSUE 10-25-26	E.P.
KIND	BRASS CASTING	CHANGED	
SHAPE		" " 11-27-26	E.P.
FINISH	BL. ENAMEL	" "	
TEMP.		" "	
PATT.		" "	

TITLE: WAVE-GENERATOR MOVABLE BRUSH HOLD. SUP.

H. G. FISCHER & CO.
2335 WABANSIA AVE.
CHICAGO, ILL.

CAT. NO.

PART NO. 5356 AF

X

SECTION C-C

#6-32 TAP

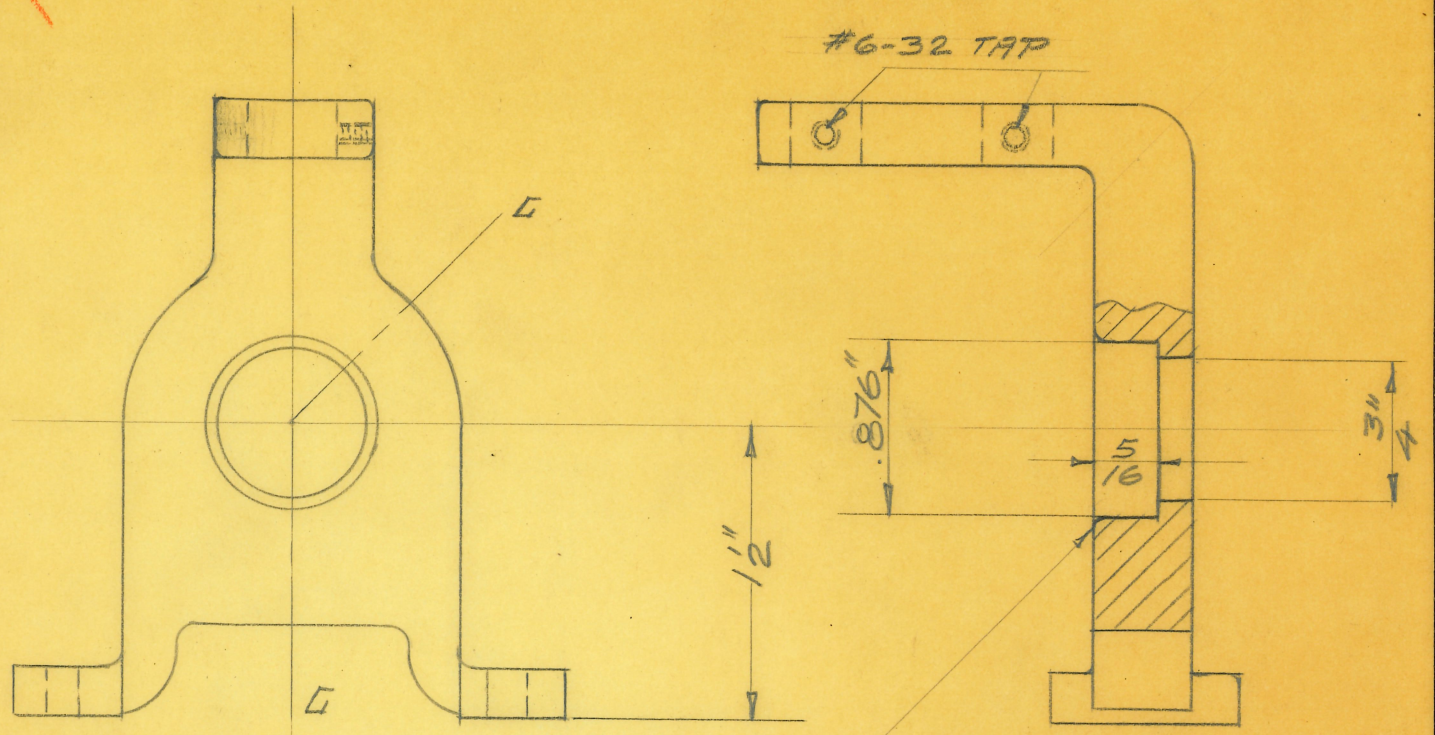

BREAK CORNER

#6-32 TAP

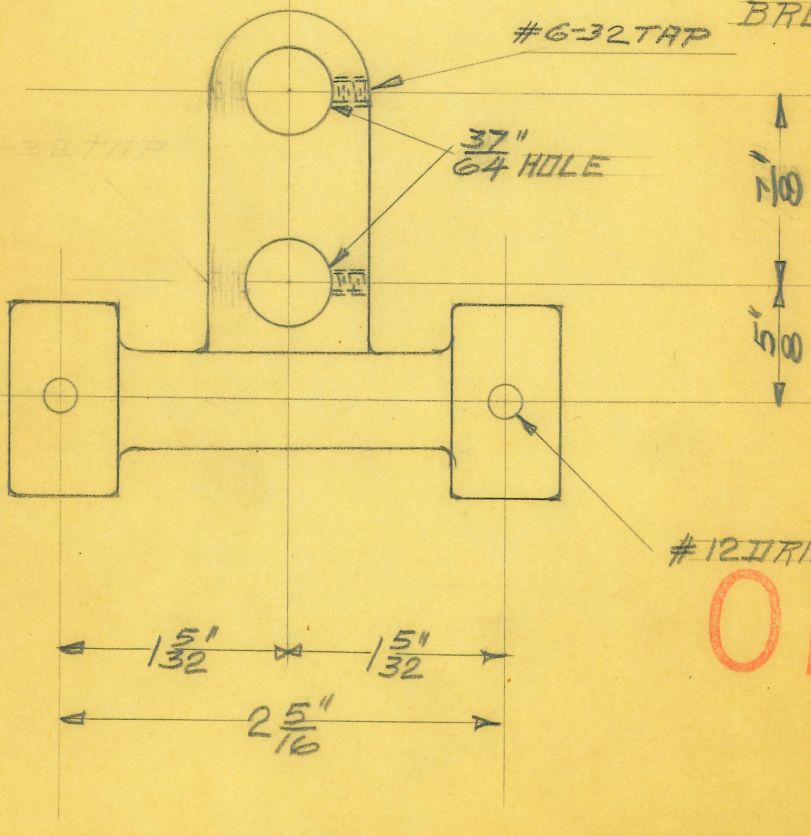

OBSOLETE

(1)

SIZE		ISSUE 9-14-26	GP.
KIND	BRASS CASTING	CHANGED	
SHAPE		" "11-27-26	GP.
FINISH	BL. PAINT	" "	
TEMP.		" "	
PATT.		" "	

TITLE:

WAVE-GENERATOR

AUTOM. RHEO. SUPPORT (LEFT)

H. G. FISCHER & CO.
2335 WABANSIA AVE.
CHICAGO, ILL.

CAT. NO.

PART NO. 5356FA

X

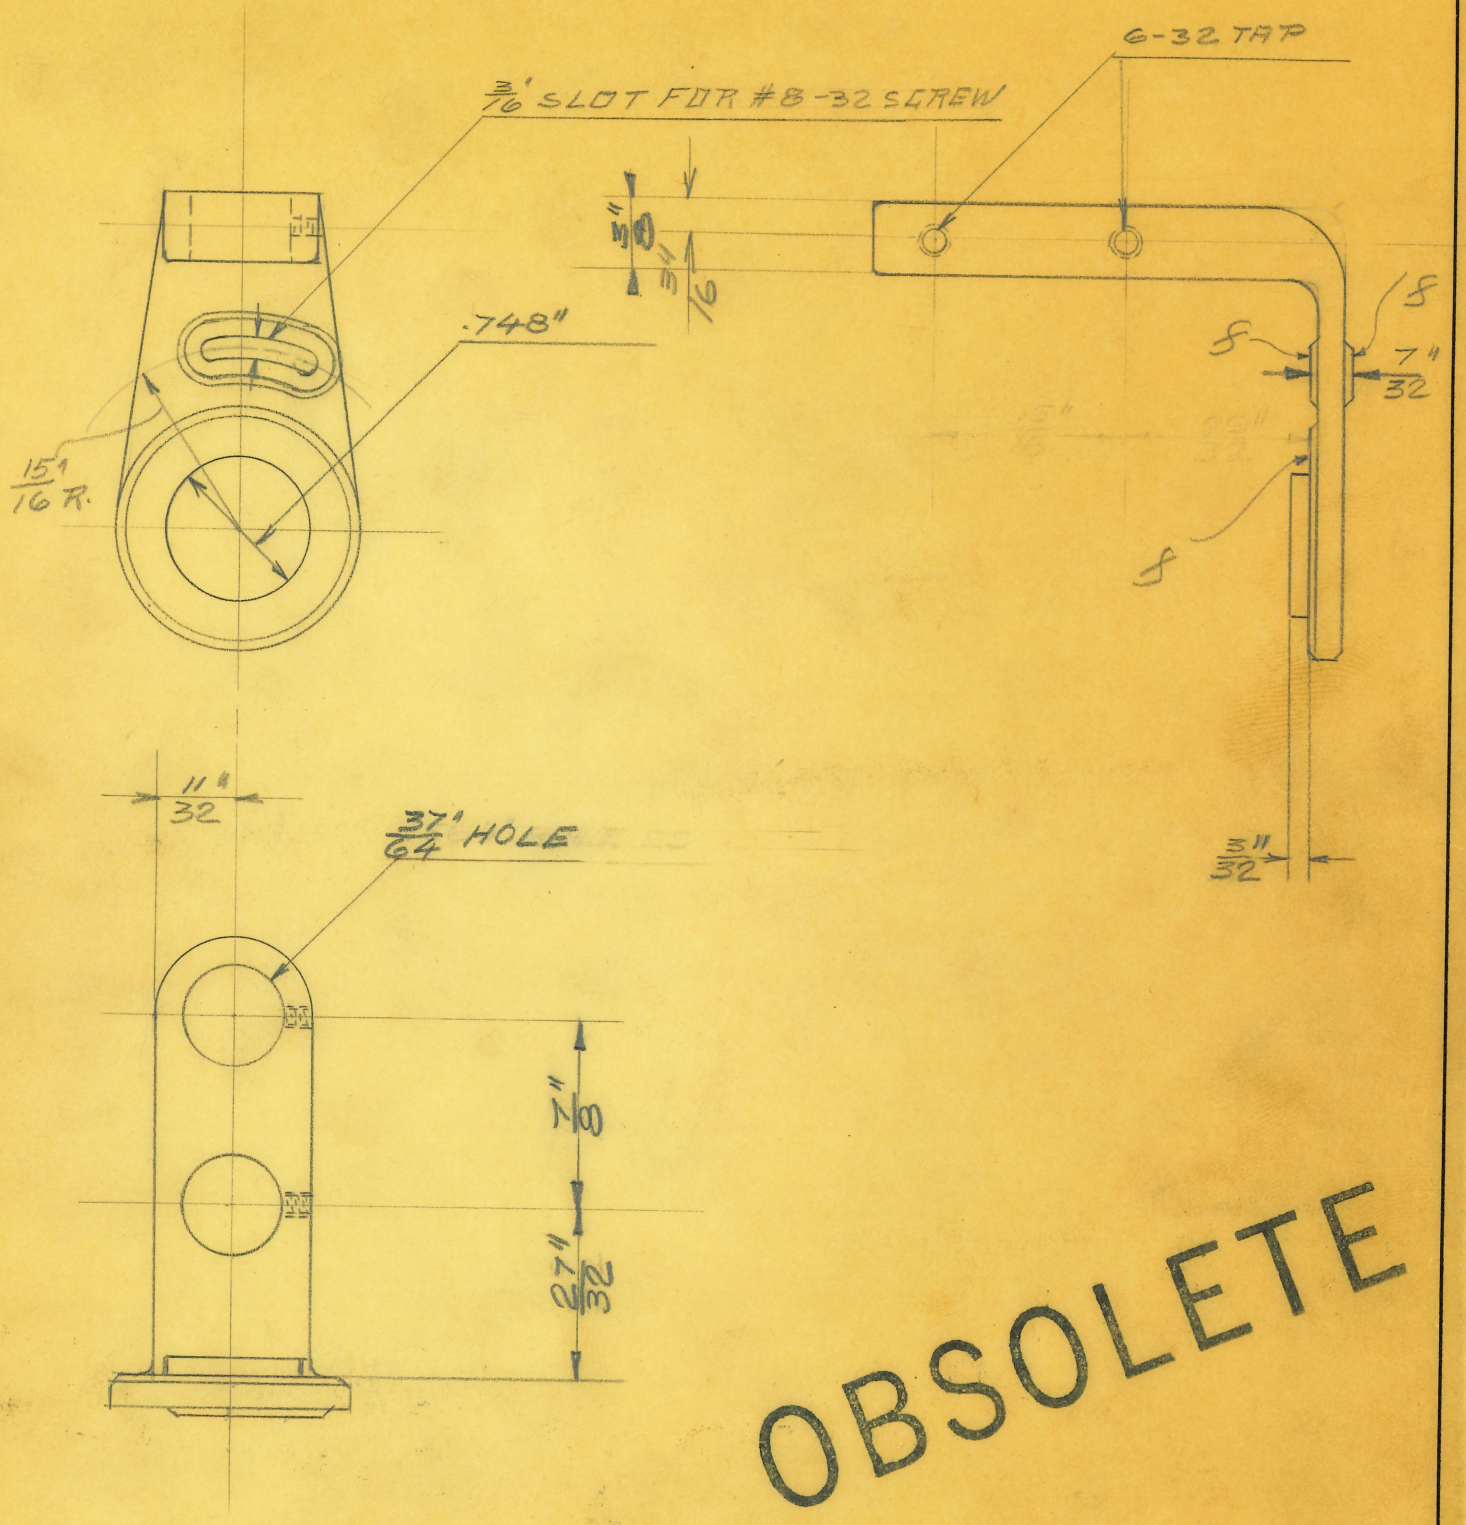

OBSOLETE

1

SIZE		ISSUED 6-25-26	GF.
KIND	CASTING	CHANGED	
SHAPE		" "11-27-26	GF.
FINISH		" "	
TEMP.		" "	
PATT.		" "	

TITLE:

WAVE-GENERATOR
MOVABLE BRUSH HOLDER

H. G. FISCHER & CO.
2335 WABANSIA AVE.
CHICAGO, ILL.

CAT. NO.

PART NO. 5356½ AF

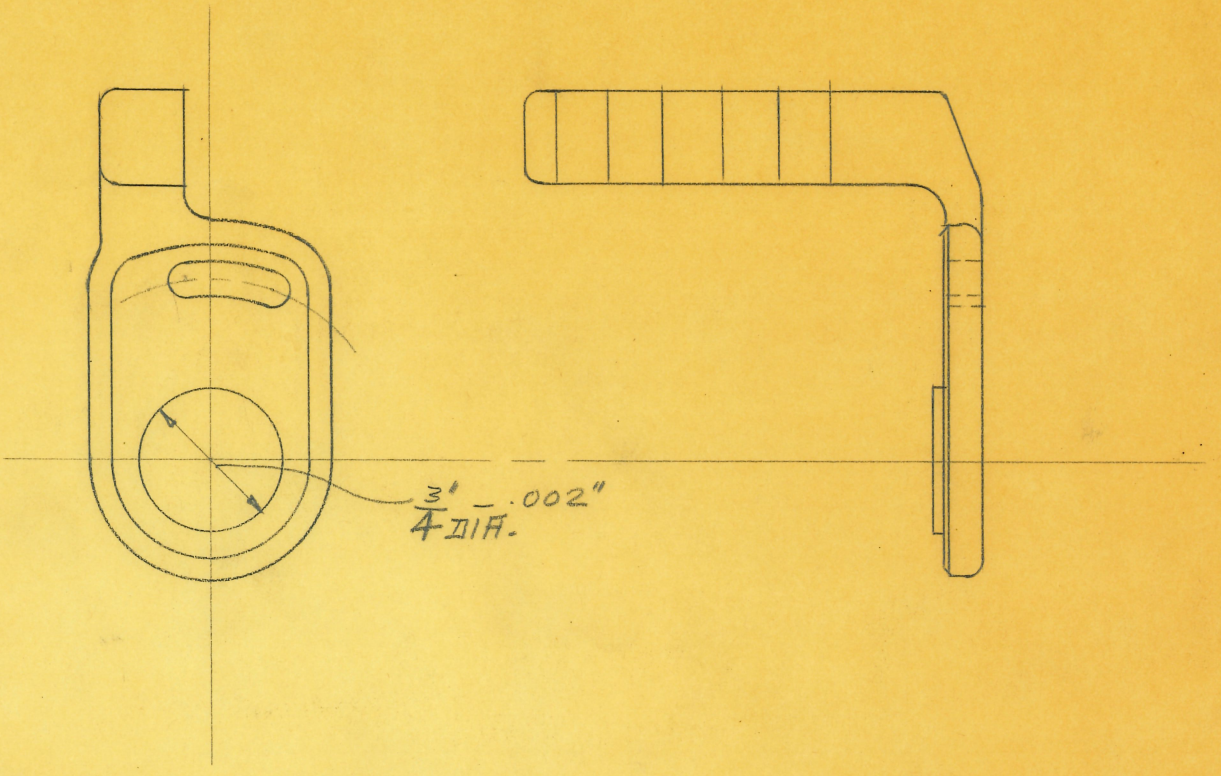

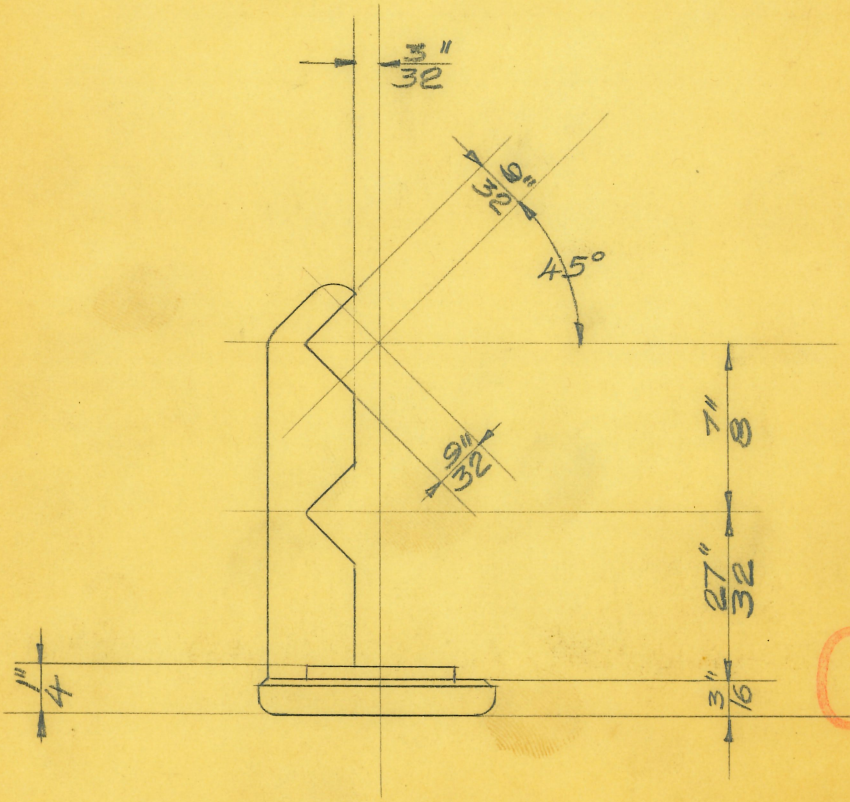

OBSOLETE

SIZE		ISSUE	
KIND	BRASS CASTING	CHANGED	
SHAPE		" "12-14-26	C.P.
FINISH	BL. ENAMEL	" "	
TEMP.		" "	
PATT.		" "	

TITLE:

WAVE-GENERATOR MOVABLE BRUSH HOLDER

H. G. FISCHER & CO.
2335 WABANSIA AVE.
CHICAGO, ILL.

CAT. NO.

PART NO. 5356½BF

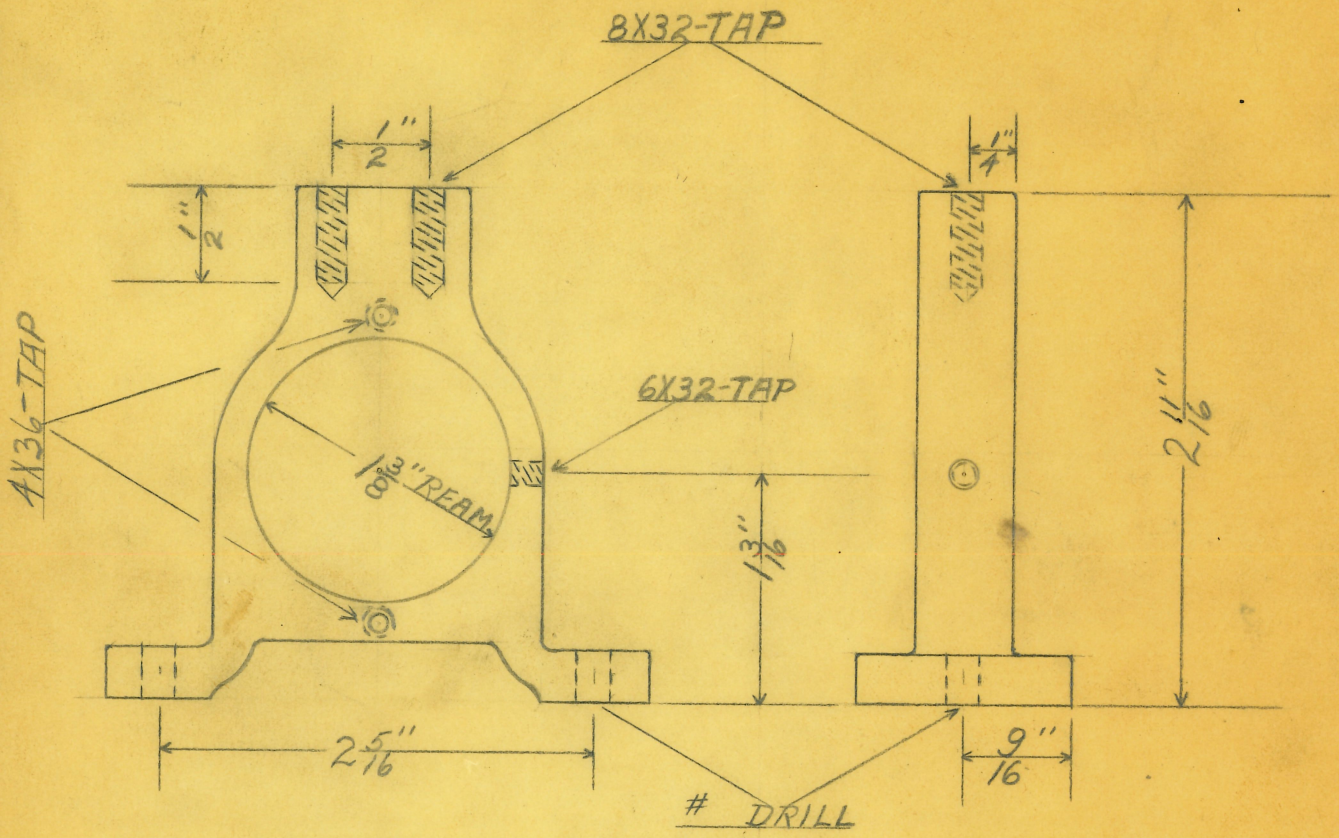

OBSOLETE

SIZE		ISSUE	4-3-28
KIND	CAST-IRON	CHANGED	
SHAPE		" "	
FINISH	BLK. JAPAN	" "	
TEMP.		" "	
PATT.		" "	

TITLE: WAVE-GEN. RHEO. SUPPORT

H. G. FISCHER & CO.
2335 WABANSIA AVE.
CHICAGO, ILL.

CAT. NO.

PART NO. 5357FA

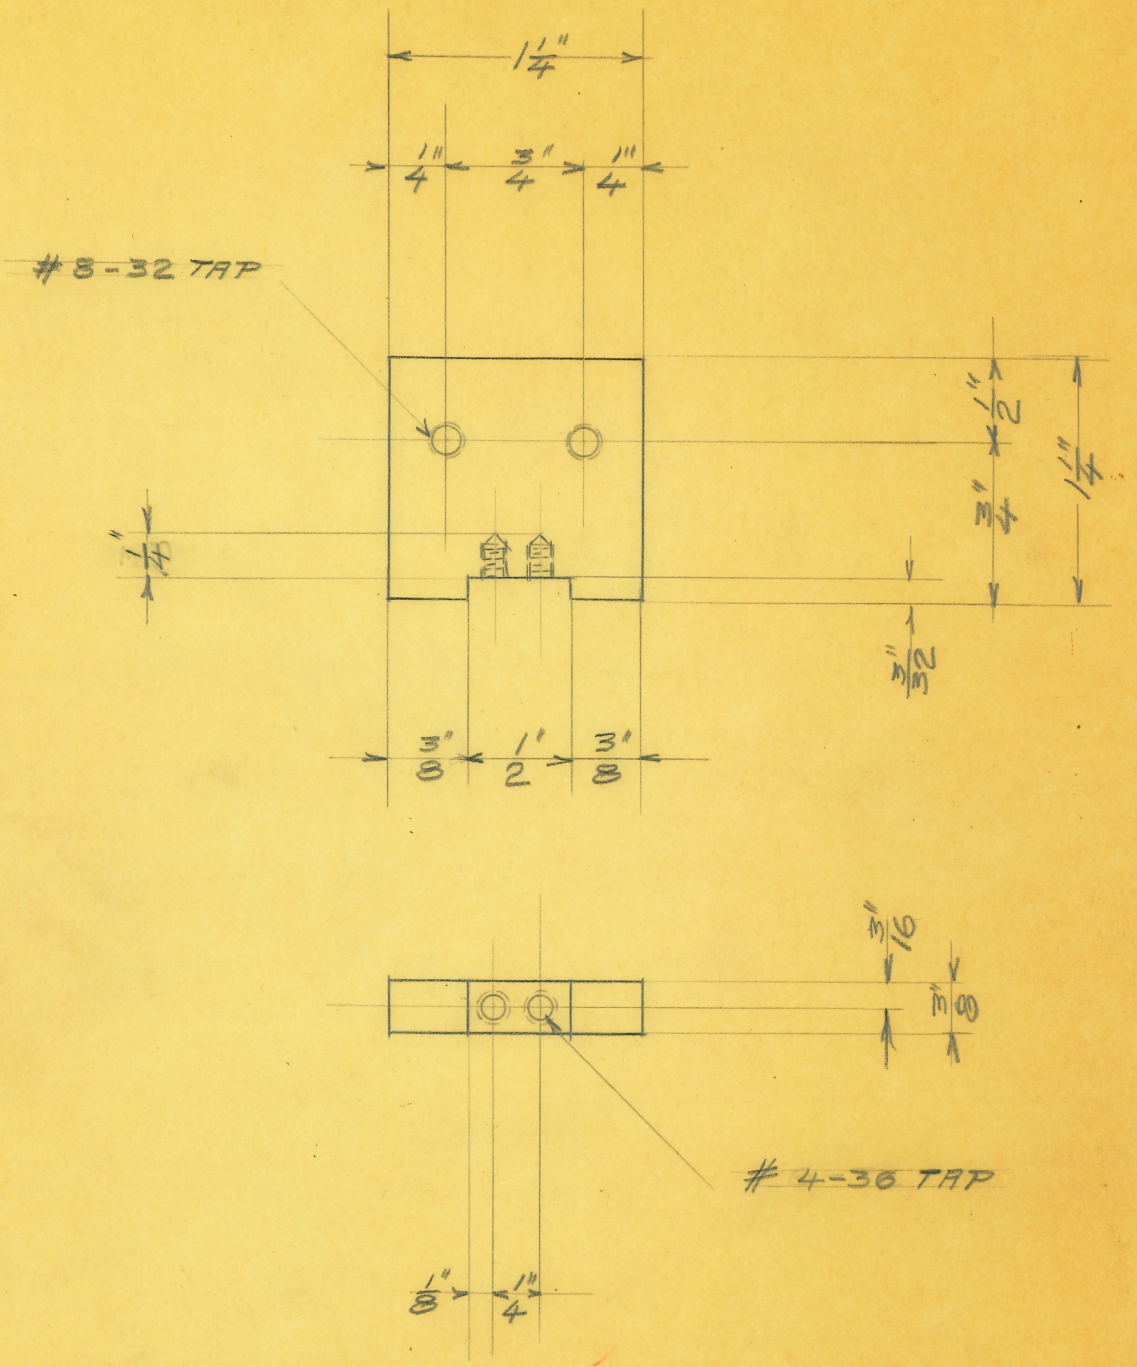

OBSOLETE

(1)

SIZE		ISSUE 9-13-26	C.P.
KIND	FIBRE	CHANGED	
SHAPE		" " 10-1-26	C.P.
FINISH		" "	
TEMP.		" "	
PATT.		" "	

TITLE: WAVE-GENERATOR SMALL CONNECTION BOARD

H. G. FISCHER & CO.
2335 WABANSIA AVE.
CHICAGO, ILL.

CAT. NO.

PART NO. 5358

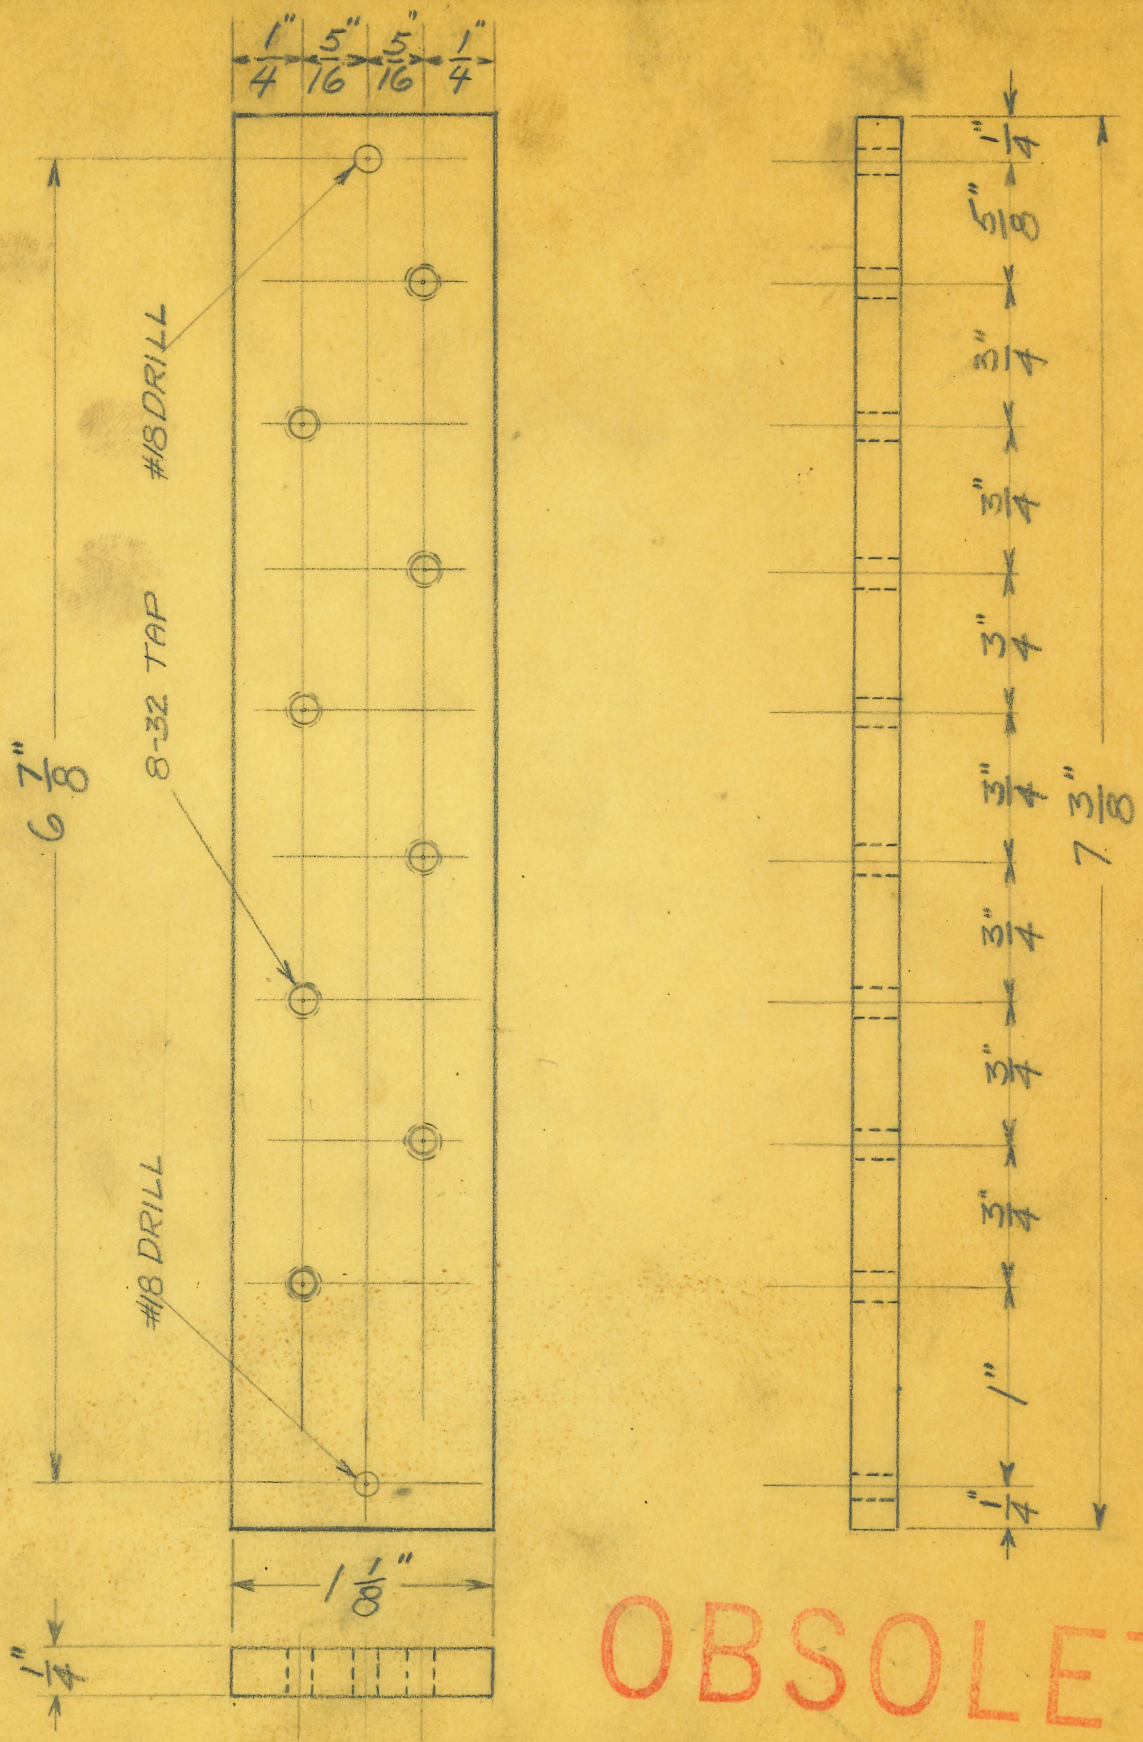

OBSOLETE

(1)

SIZE		ISSUE	
KIND	BAKELITE	CHANGED	
SHAPE		" "	
FINISH		" "	
TEMP.		" "	
PATT.		" "	

TITLE:

WAVE-GENERATOR
MAIN CONECTION BOARD

H. G. FISCHER & CO.
2335 WABANSIA AVE.
CHICAGO, ILL.

CAT. NO.

PART NO. 5358 1/2

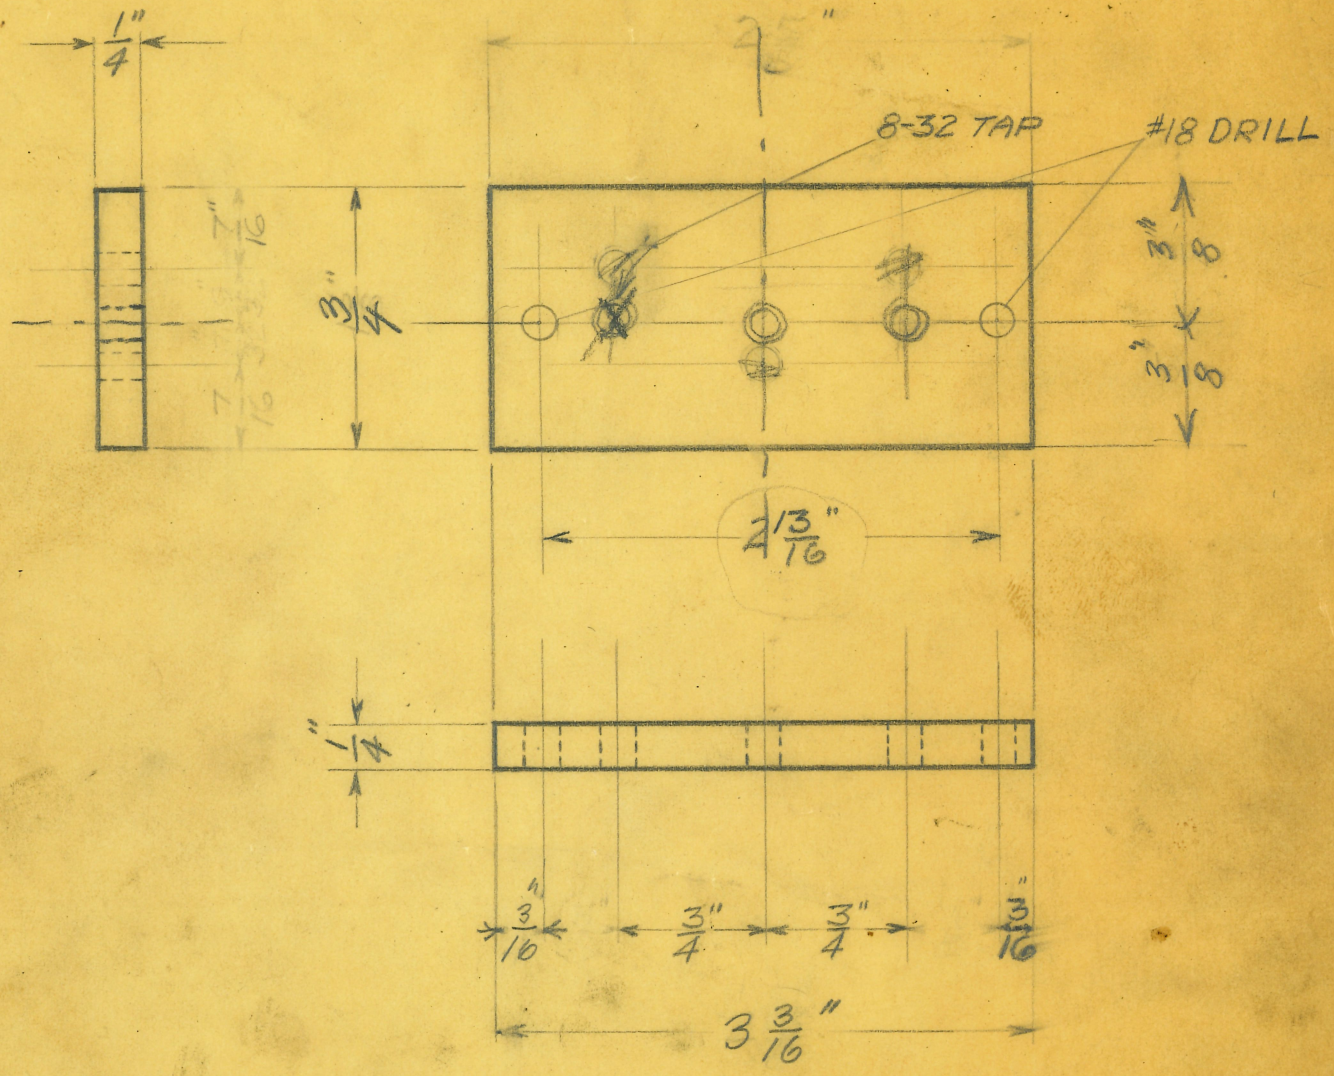

OBSOLETE

(1)

SIZE		ISSUE	
KIND	BAKELITE	CHANGED	
SHAPE		" "	
FINISH		" "	
TEMP.		" "	
PATT.		" "	

TITLE:

WAVE-GENERATOR
RIGHT CONNECTING BOARD

H. G. FISCHER & CO.
2335 WABANSIA AVE.
CHICAGO, ILL.

CAT. NO.

PART NO. 5358 1/2

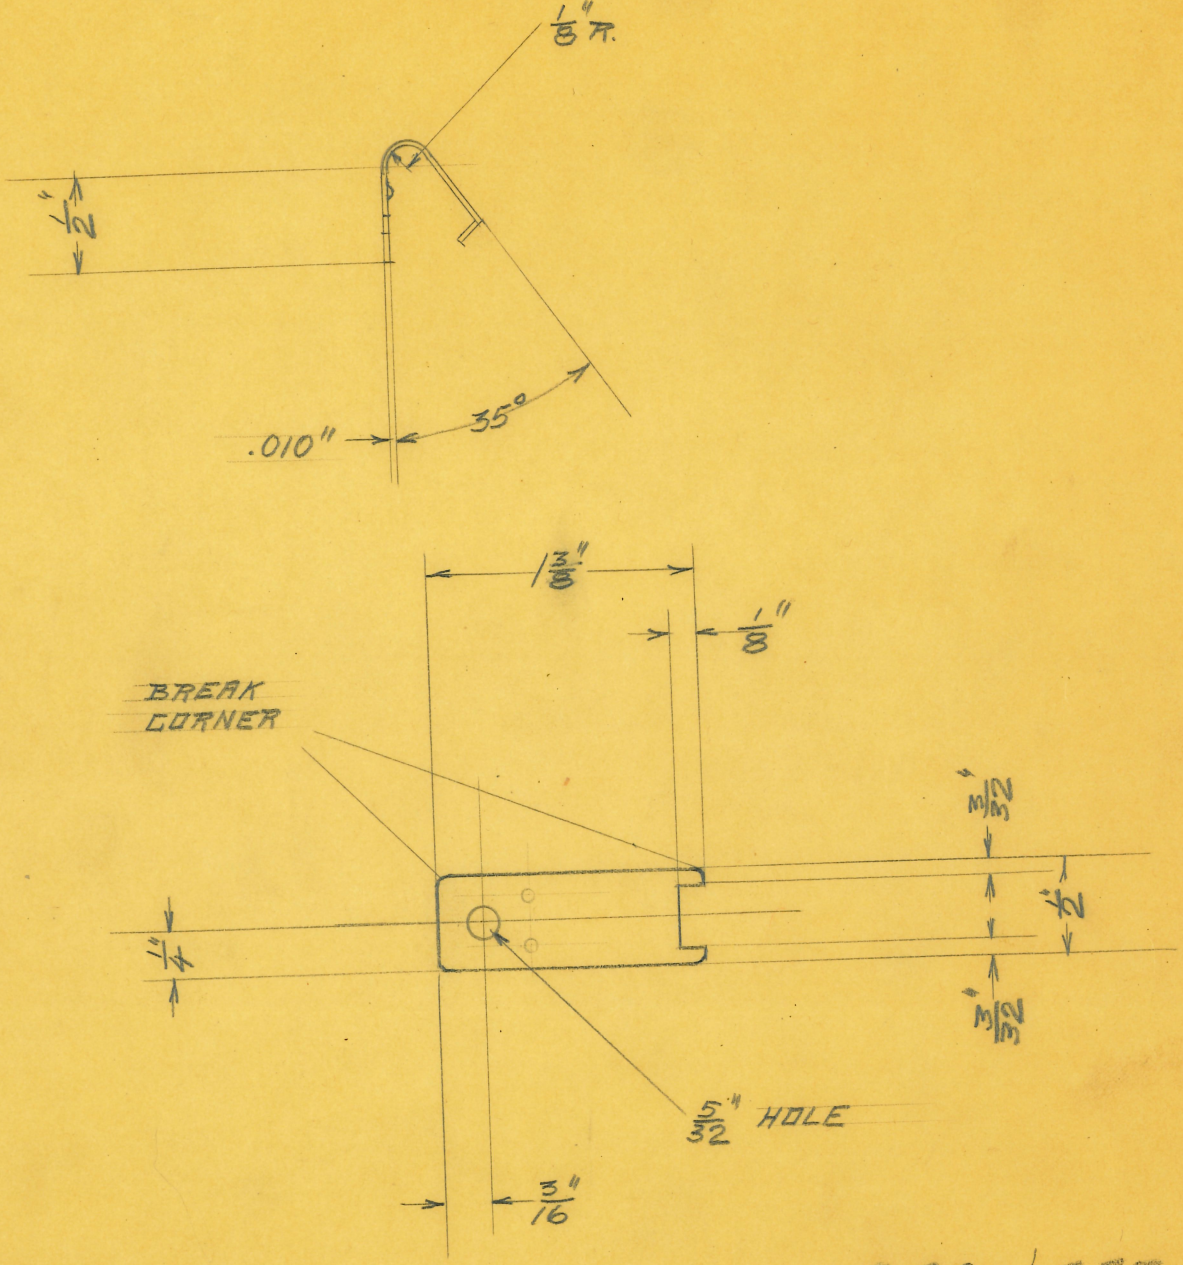

OBSOLETE

4-22-80

(2)

SIZE		ISSUE 7-26-26	C.
KIND	BRONZE	CHANGED	
SHAPE		" "	
FINISH	N.P.	" "	
TEMP.		" "	
PATT.		" "	

TITLE: CONNECTION CLIP SPRING
WAVE-GENERATOR

H. G. FISCHER & CO.
2335 WABANSIA AVE.
CHICAGO, ILL.

CAT. NO.

PART NO. 5382

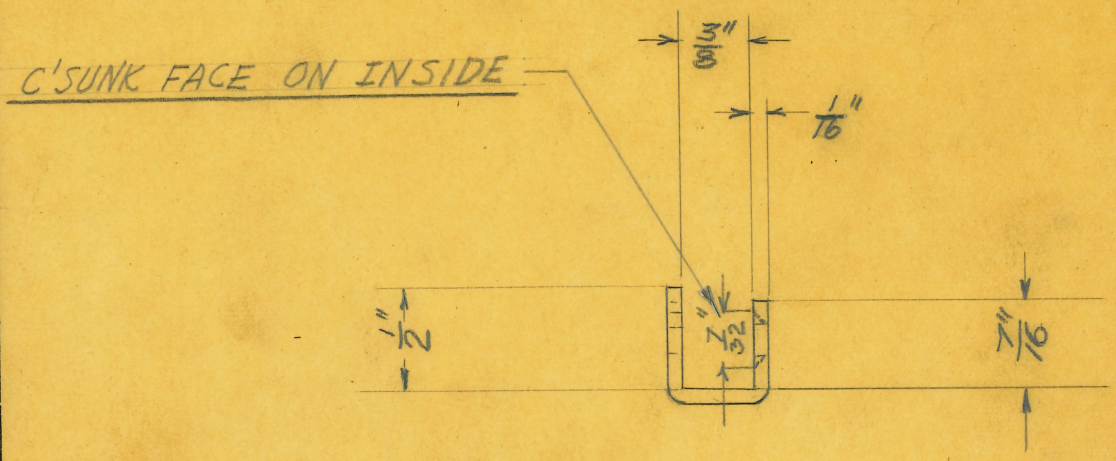

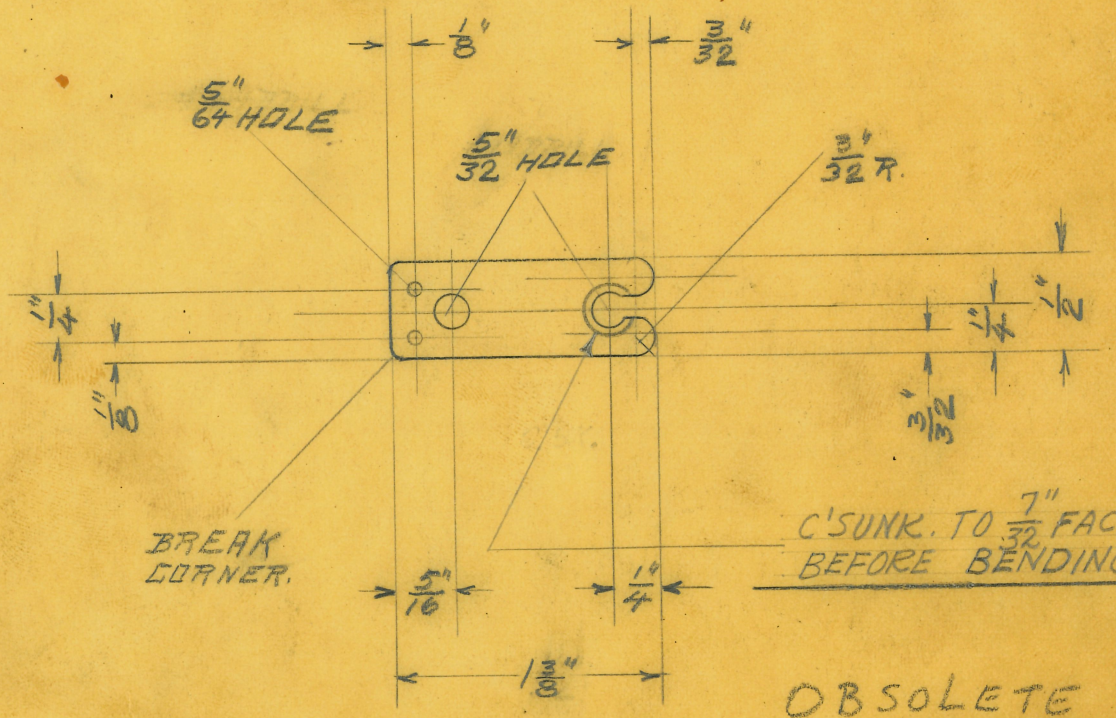

OBSOLETE

4-22-80

(2)

SIZE		ISSUE 6-25-26	W.	TITLE: CONNECTION CLIP WAVE-GENERATOR
KIND	BRASS	CHANGED		
SHAPE		" "		
FINISH	N.P.	" "		
TEMP.		" "		
PATT.		" "		

H. G. FISCHER & CO.
2335 WABANSIA AVE.
CHICAGO, ILL.

CAT. NO.

PART NO. 5383

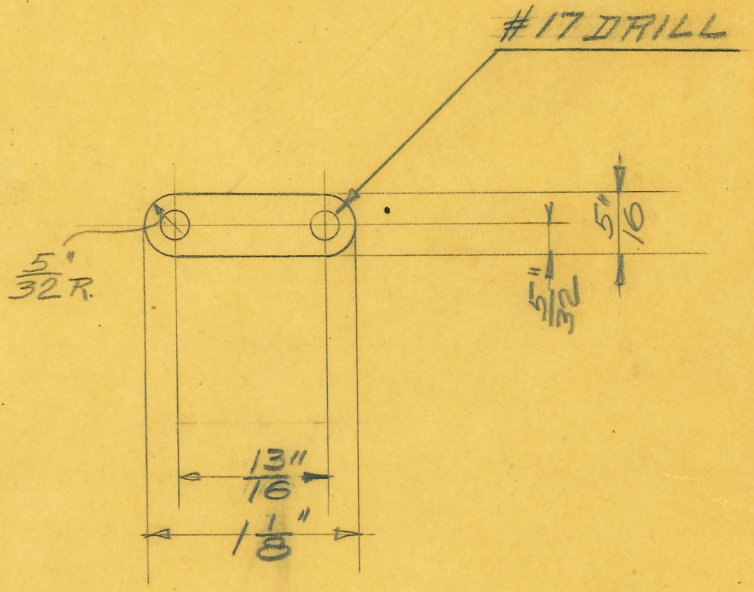

OBSOLETE

4-22-80

#30 GA. (.010") SHEET COPPER H.H.

2- REQUIRED

SIZE		ISSUE 11-24-26		TITLE: WAVE-GENERATOR (S. SWITCH) CONNECTION PLATE
KIND		CHANGED		
SHAPE		" "		
FINISH		" "		
TEMP.		" "		H. G. FISCHER & CO. 2335 WABANSIA AVE. CHICAGO, ILL.
PATT.		" "		CAT. NO.
				PART NO. 5421

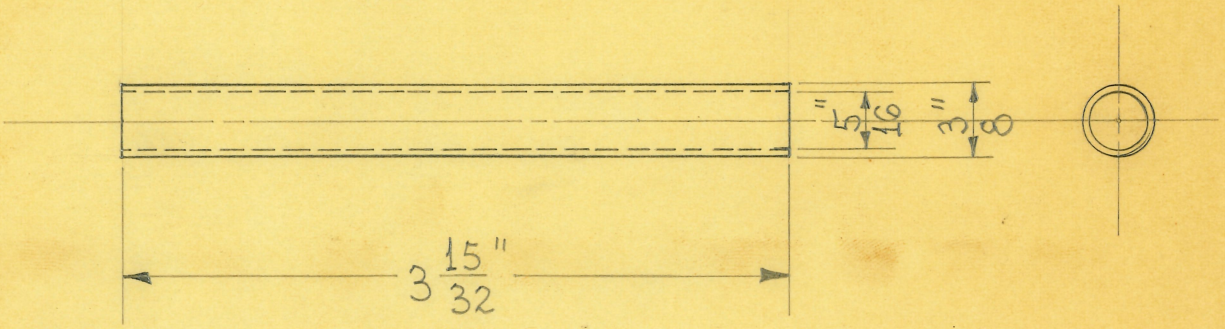

2 REQUIRED

OBSOLETE

SIZE	5/16" I.D. X 3/8" O.D.	ISSUE 9-5-44	HE.
KIND	BLK. BAKELITE	CHANGED	
SHAPE	TUBING	"	
FINISH		"	
TEMP.		"	
PATT.		"	

TITLE:

WAVE GEN. COMMUTATOR STUD INSULATOR

H. G. FISCHER & CO.
2335 WABANSIA AVE.
CHICAGO, ILL.

CAT. NO.

PART NO. 5497 1/2

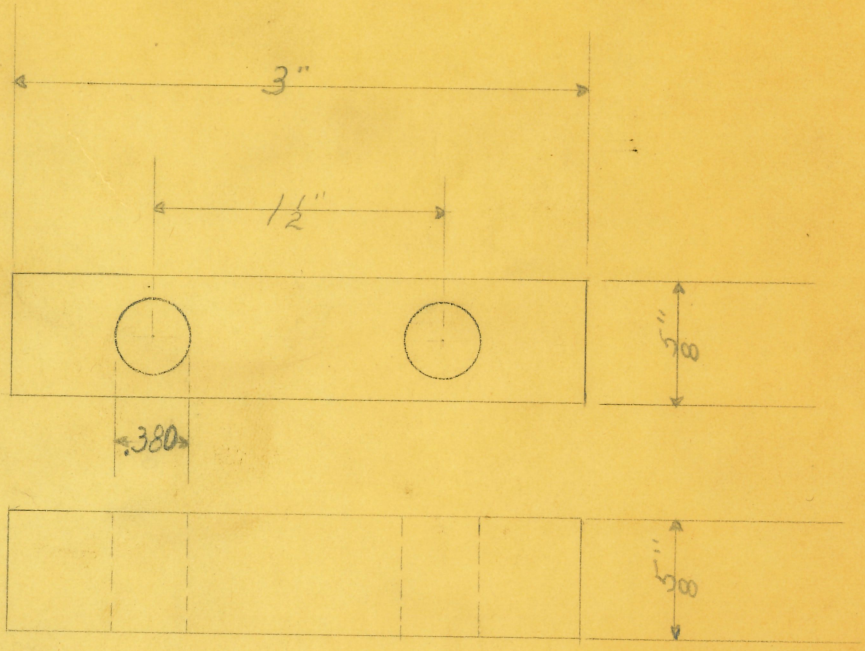

OBSOLETE

see new Tracing

(2)

SIZE		ISSUE		TITLE: WAVE-GEN.-ARMATURE-BASE-SEGMENT	
KIND	COPPER	CHANGED			
SHAPE		" "			
FINISH		" "			
TEMP.		" "		H. G. FISCHER & CO. 2335 WABANSIA AVE. CHICAGO, ILL.	CAT. NO.
PATT.		" "			PART NO. 5498

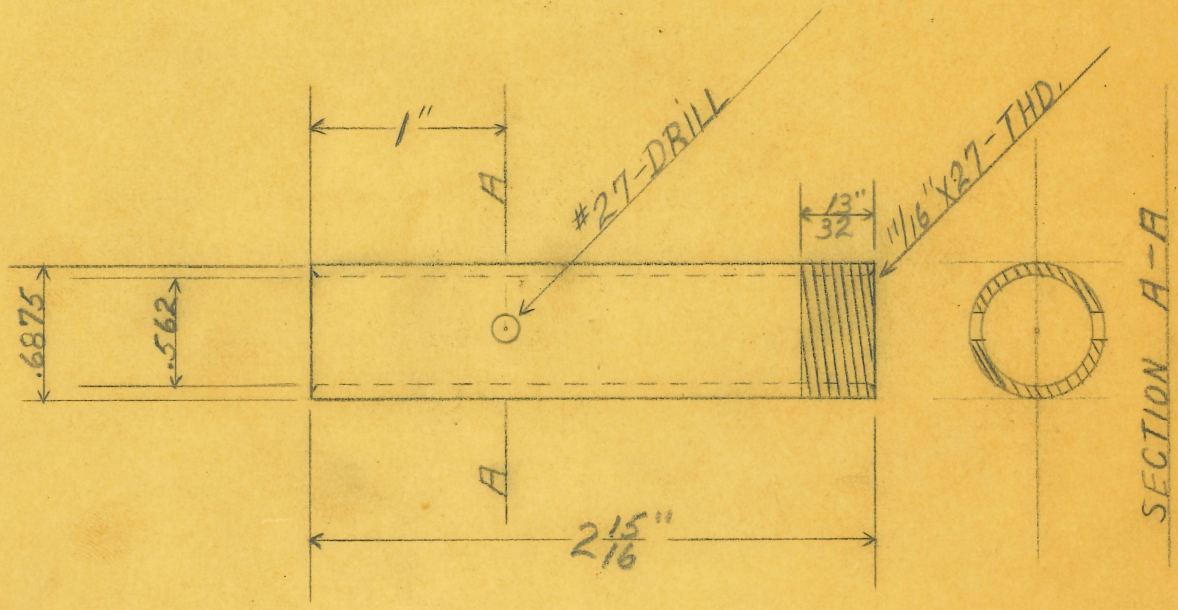

OBSOLETE

SIZE	9/16" X 11/16"	ISSUE	2-23-28
KIND	STEEL-TUBING	CHANGED	
SHAPE		" "	
FINISH	NONE	" "	
TEMP.		" "	
PATT.		" "	

TITLE: WAVE-GEN. COLLECTOR-RING-SHAFT

H. G. FISCHER & CO.
2335 WABANSIA AVE.
CHICAGO, ILL.

CAT. NO.

PART NO. 5605

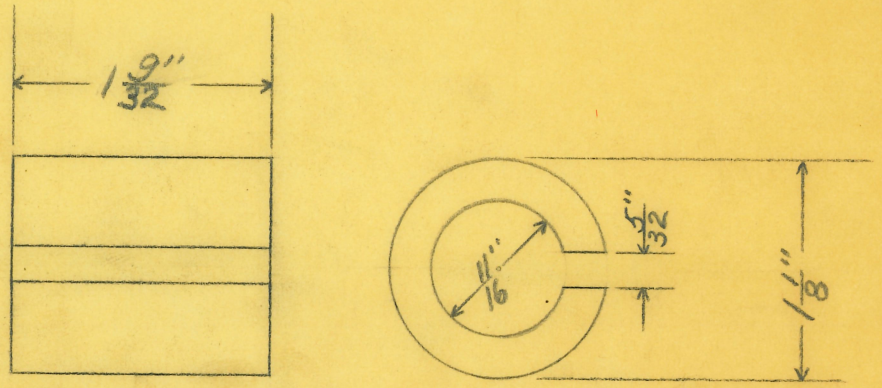

OBSOLETE

SIZE	11/16" X 1 1/8"	ISSUE	
KIND	BAKELITE	CHANGED	
SHAPE	TUBING	" "	
FINISH		" "	
TEMP.		" "	
PATT.		" "	

TITLE: WAVE-GEN. COLLECTOR-RING-SHAFT INSULATOR

H. G. FISCHER & CO.
2335 WABANSIA AVE.
CHICAGO, ILL.

CAT. NO.

PART NO. 5606

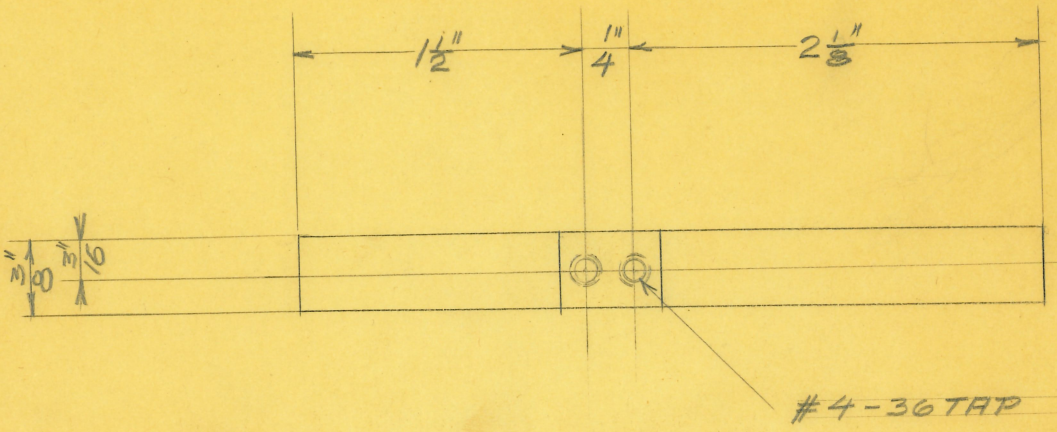

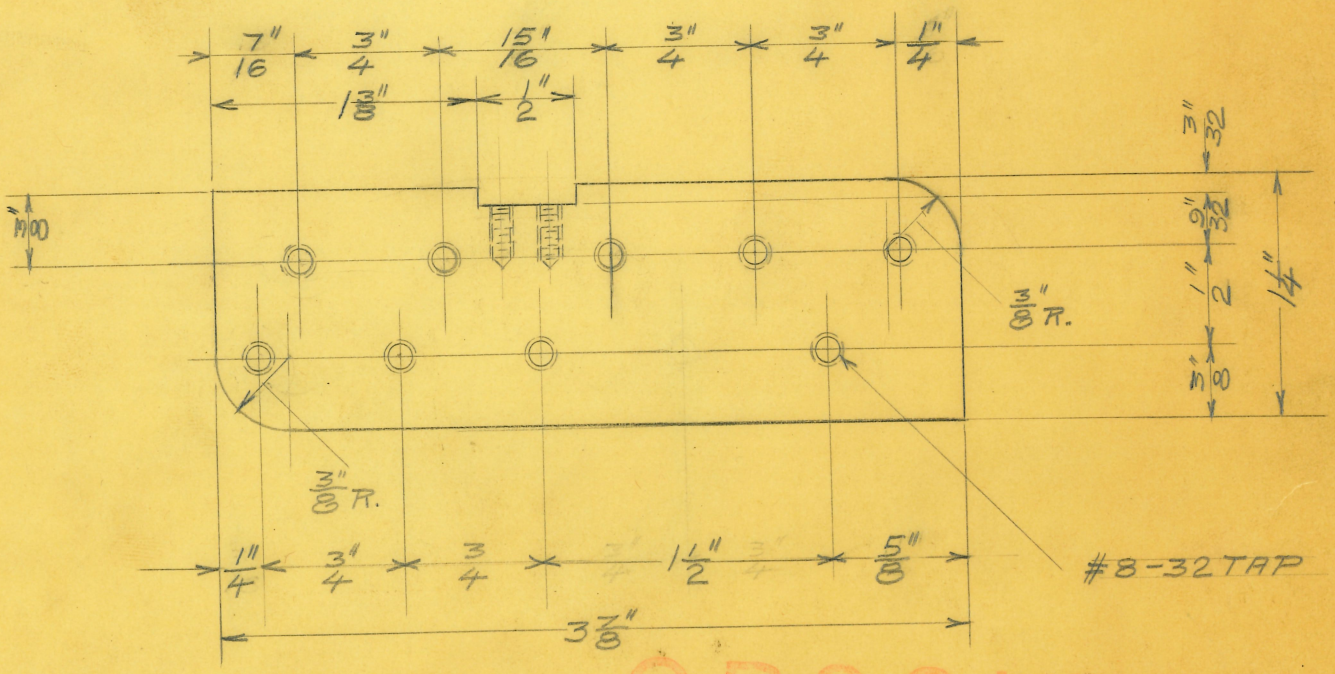

OBSOLETE

(1)

SIZE		ISSUE 10-1-26	E.P.
KIND	BL. FIBRE	CHANGED	
SHAPE		" "	
FINISH		" "	
TEMP.		" "	
PATT.		" "	

TITLE:
WAVE-GENERATOR
LARGE-CONNECTION BOARD

H. G. FISCHER & CO.
2335 WABANSIA AVE.
CHICAGO, ILL.

CAT. NO.

PART NO. 5359

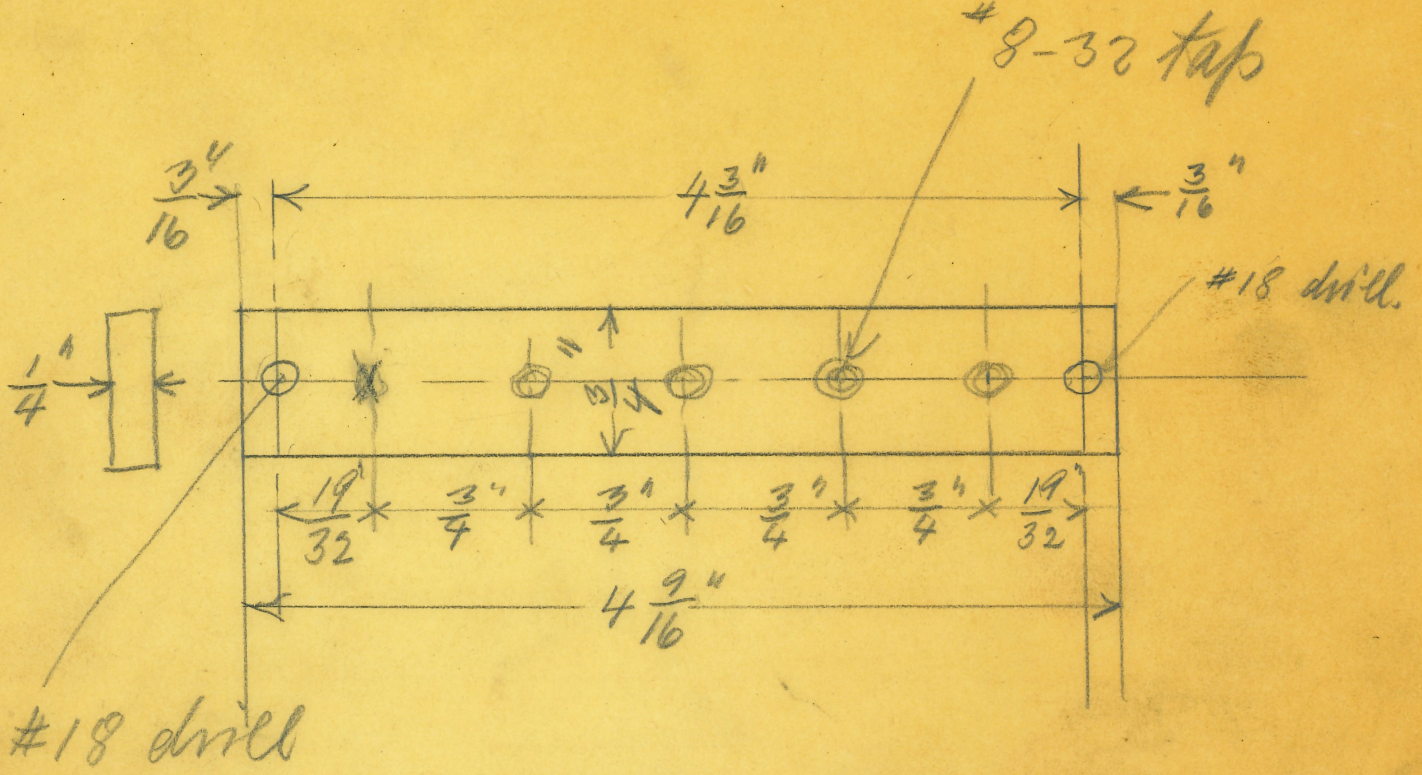

OBSOLETE

SIZE		ISSUE		TITLE: LEFT CONNECTION BOARD LOW VOLT GENERATOR.
KIND	Bakelite	CHANGED		
SHAPE		" "		
FINISH		" "		
TEMP.		" "		
PATT.		" "		

H. G. FISCHER & CO.
2335 WABANSIA AVE.
CHICAGO, ILL.

CAT. NO.

PART NO. 5359 1/2

X

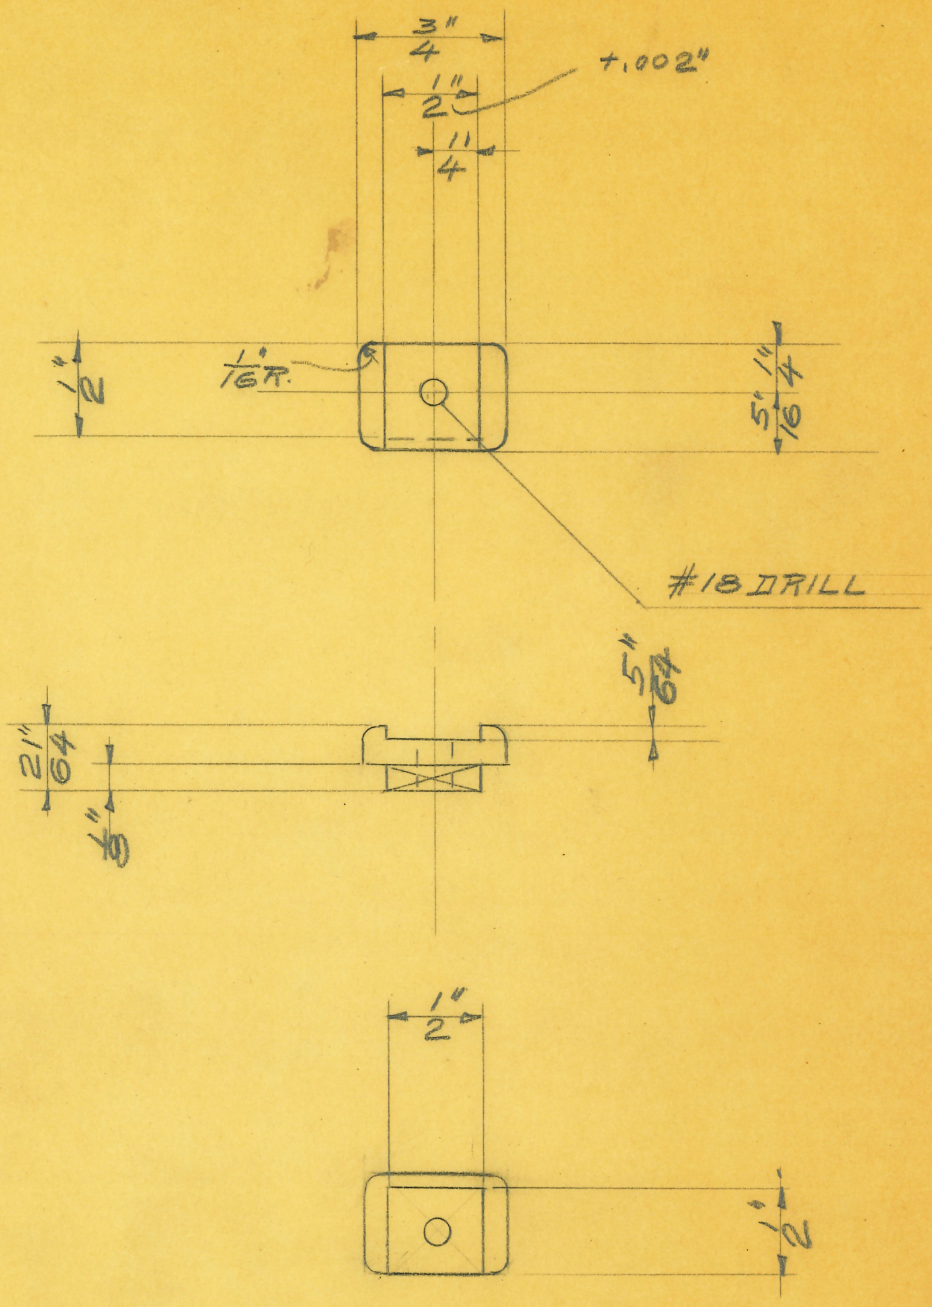

OBSOLETE

SIZE		ISSUE 11-30-26	CP	TITLE: WAVE-GENERATOR CONNECTION CLIP INSULATOR	
KIND		CHANGED			
SHAPE		" "			
FINISH		" "			
TEMP.		" "		H. G. FISCHER & CO. 2335 WABANSIA AVE. CHICAGO, ILL.	CAT. NO.
PATT.		" "			PART NO. 5346

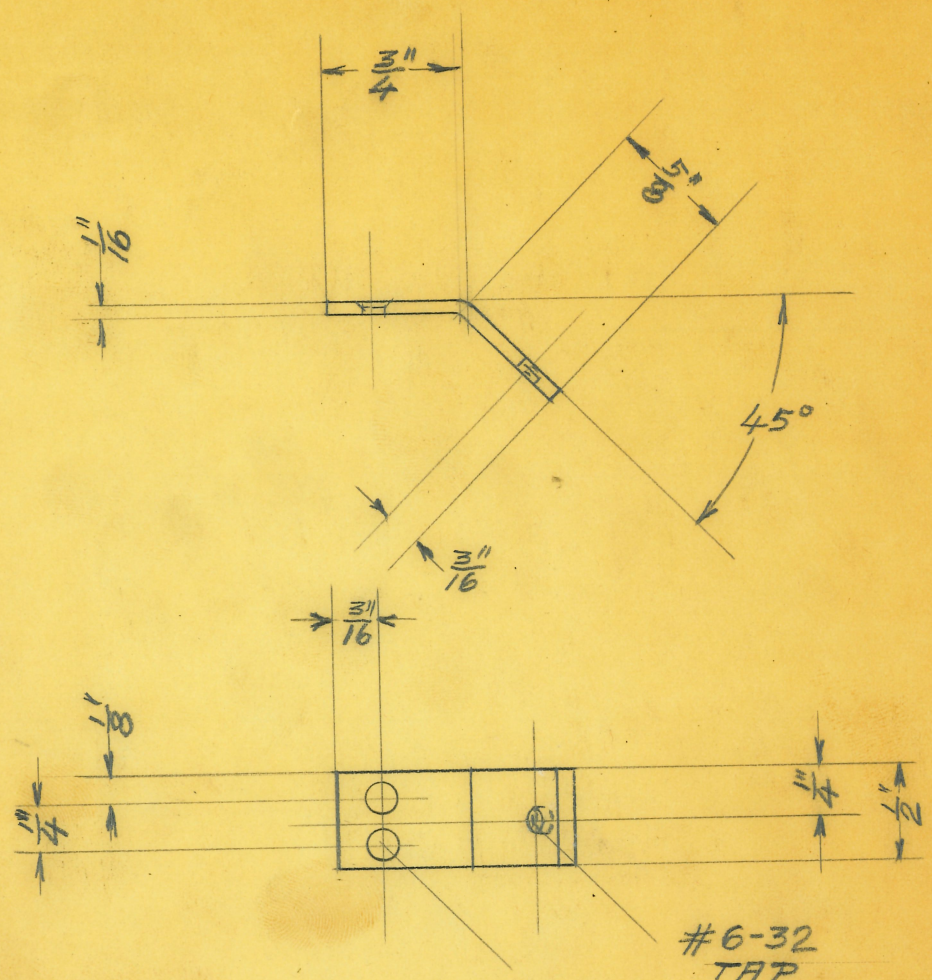

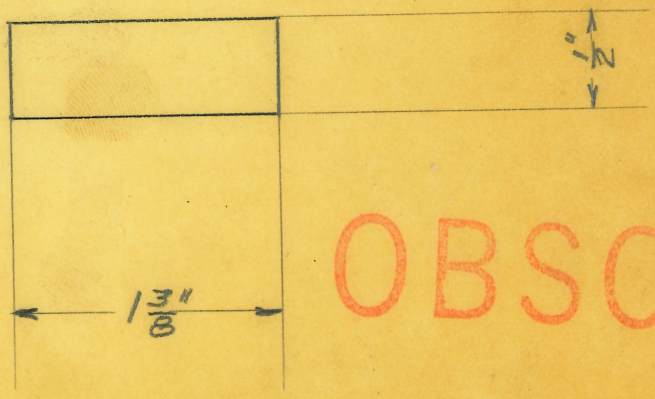

OBSOLETE

(2)

SIZE		ISSUE 6-21-26	(2)	TITLE: SUPPORT FOR CONNECTION BOARD WAVE-GENERATOR	
KIND	C.R. STEEL	CHANGED			
SHAPE		" "			
FINISH		" "			
TEMP.		" "		H. G. FISCHER & CO. 2335 WABANSIA AVE. CHICAGO, ILL.	CAT. NO. / PART NO. 5360
PATT.		" "			

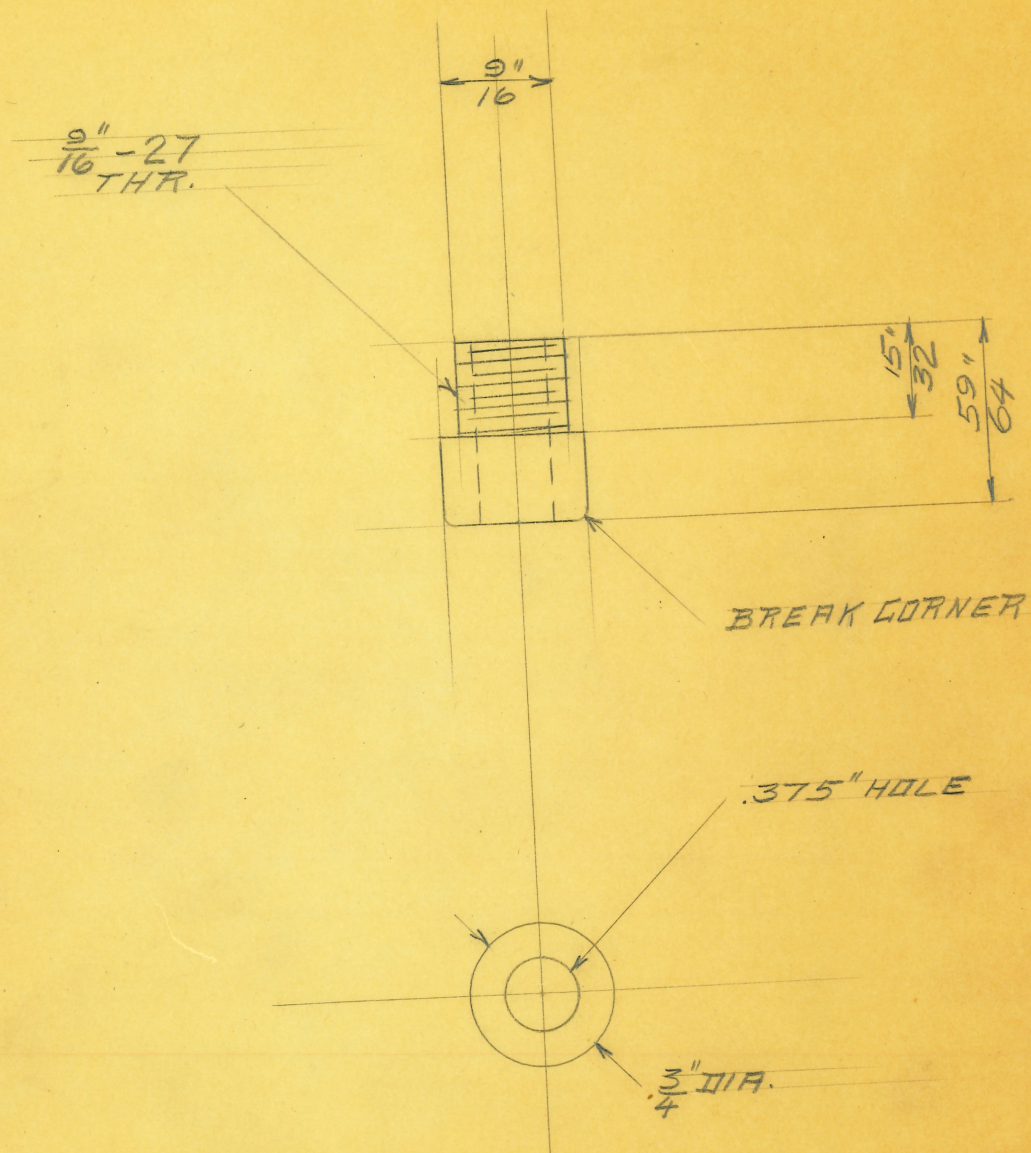

OBSOLETE

(1)

SIZE		ISSUE 9-13-26	
KIND	BRASS	CHANGED	
SHAPE		" "	
FINISH	N.P.	" "	
TEMP.		" "	
PATT.		" "	

TITLE: WAVE-GENERATOR REGULATING SCR. BUSHING

H. G. FISCHER & CO.
2335 WABANSIA AVE.
CHICAGO, ILL.

CAT. NO.

PART NO. 5361

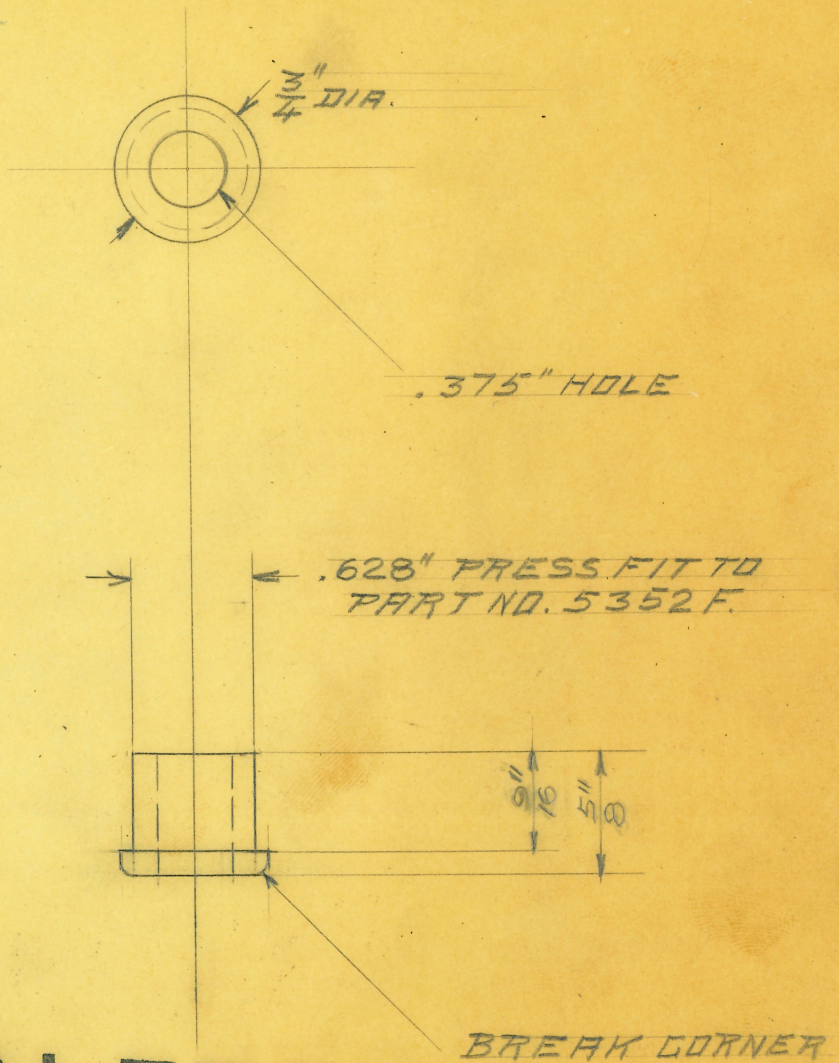

OBSOLETE

(1)

SIZE	3/4" DIA.	ISSUE 8-18-26	CP.	TITLE: #2 BUSHING FOR WORMGEAR WAVE-GENERATOR	
KIND	BRONZE	CHANGED			
SHAPE		" "			
FINISH	W.P.	" "			
TEMP.		" "		H. G. FISCHER & CO. 2335 WABANSIA AVE. CHICAGO, ILL.	CAT. NO.
PATT.		" "			PART NO. 5362

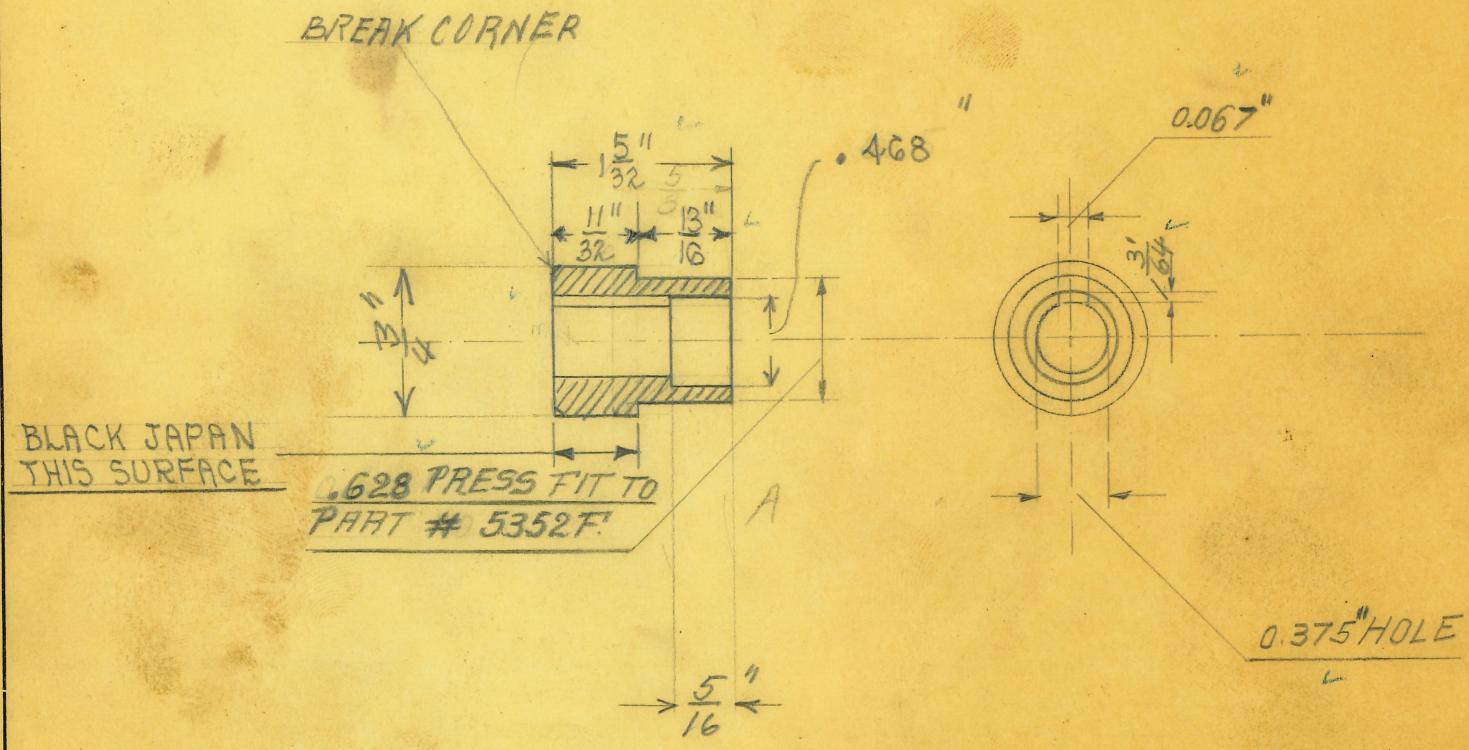

OBSOLETE

(1)

SIZE	3/4" DIA	ISSUE 4-27	P8
KIND	BEARIUM	CHANGED	
SHAPE	BRONZE	" "	
FINISH		" "	
TEMP.		" "	
PATT.		" "	

TITLE: FRONT BEARING
LOW VOLT GENERATOR

H. G. FISCHER & CO.
2335 WABANSIA AVE.
CHICAGO, ILL.

CAT. NO.

PART NO. 5362A

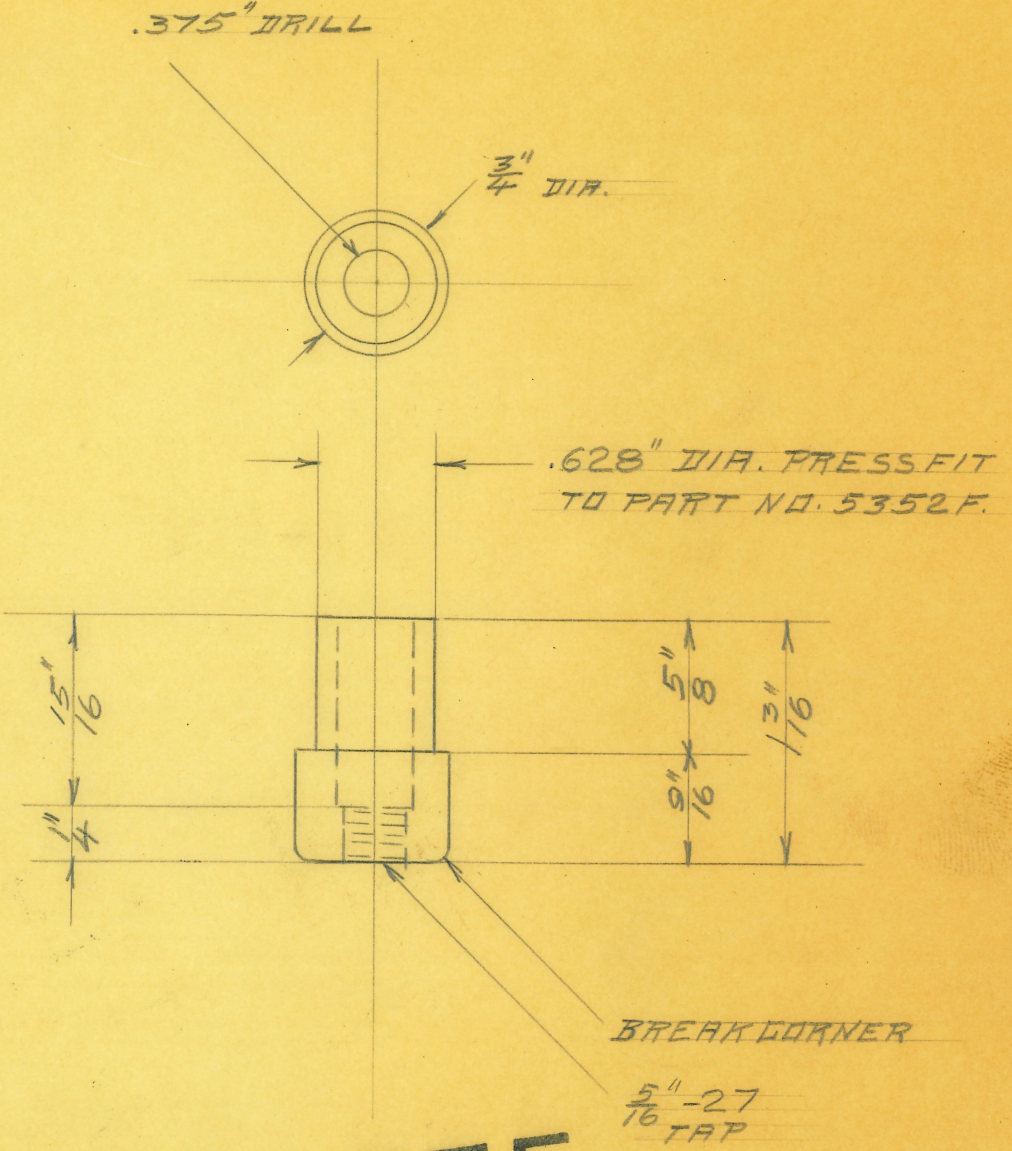

OBSOLETE

(1)

SIZE		ISSUE 9-3-26	EP.
KIND	BRONZE	CHANGED	
SHAPE		" "	
FINISH	W.P.	" "	
TEMP.		" "	
PATT.		" "	

TITLE: WAVE-GENERATOR
#3 BUSHING FOR WORM GEAR

H. G. FISCHER & CO.
2335 WABANSIA AVE.
CHICAGO, ILL.

CAT. NO.

PART NO. 5363

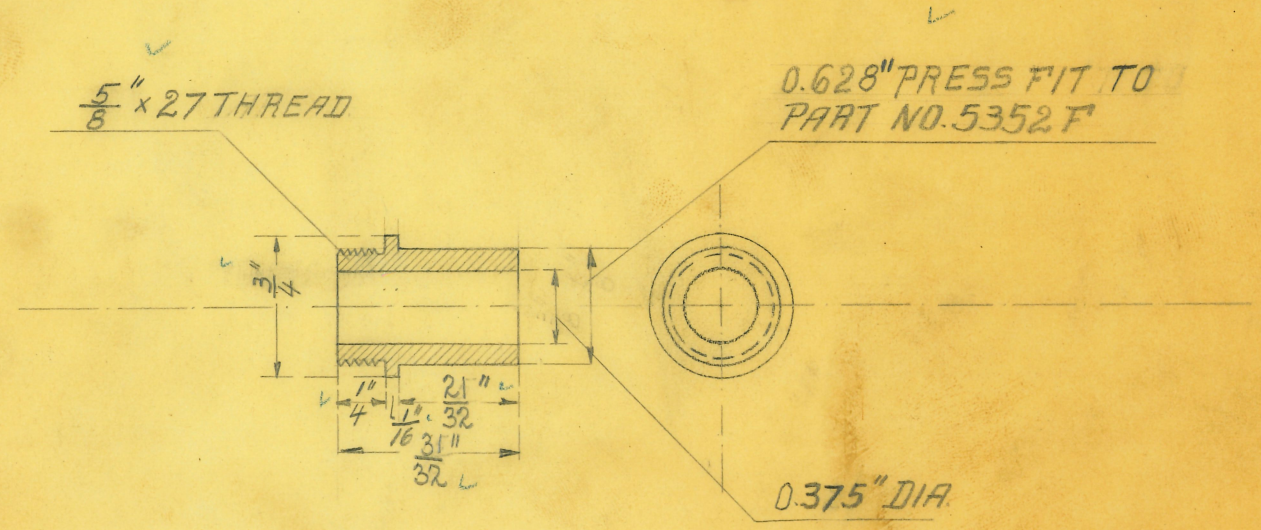

A

OBSOLETE

(1)

SIZE	3/4"	ISSUED 4/28/27 P.O.		TITLE: REAR BEARING LOW VOLT GENERATOR	
KIND	BEARIUM	CHANGED			
SHAPE	BRONZE	" "			
FINISH		" "			
TEMP.		" "			
PATT.		" "			
H. G. FISCHER & CO. 2335 WABANSIA AVE. CHICAGO, ILL.		CAT. NO.		PART NO. 5363 A	

NOTE:
DRAWN IN DOUBLE SCALE

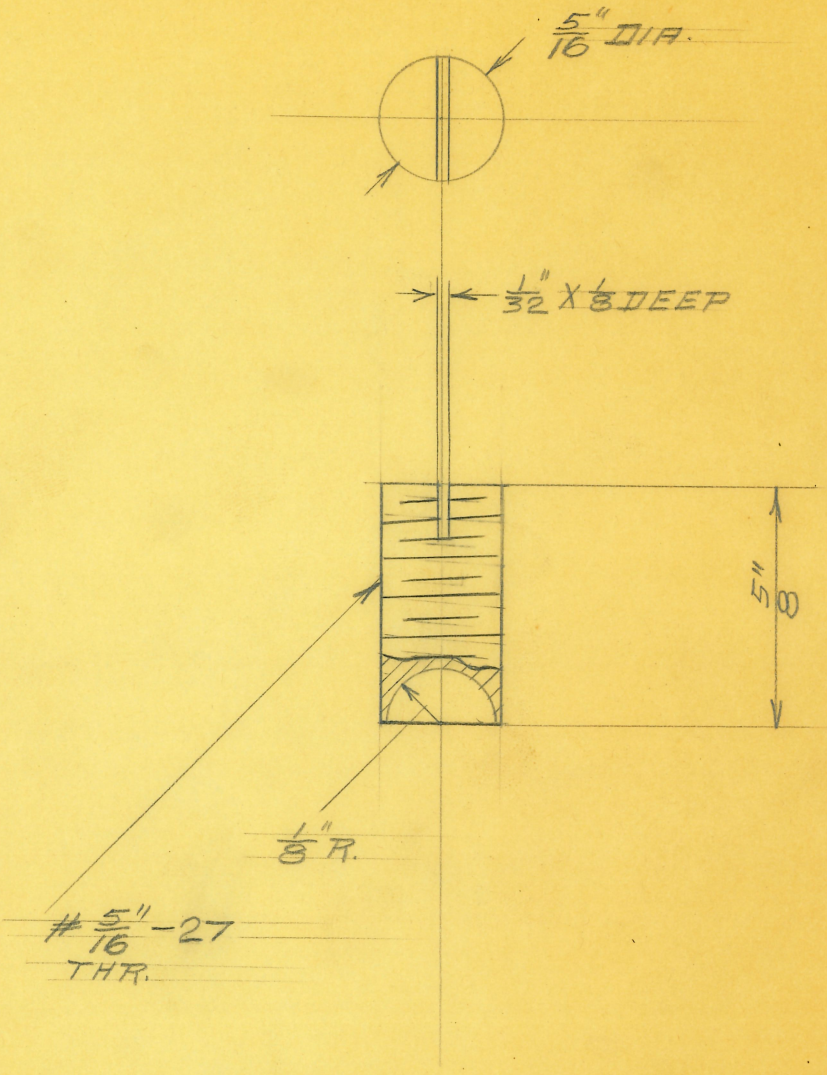

OBSOLETE

(1)

SIZE		ISSUE 9-3-26	CP.	TITLE: WAWE-GENERATOR WORM GEAR REGULATING SC.
KIND	L.R. STEEL	CHANGED		
SHAPE		" "		
FINISH		" "		
TEMP.		" "		H. G. FISCHER & CO. 2335 WABANSIA AVE. CHICAGO, ILL.
PATT.		" "		CAT. NO.
				PART NO. 5364.

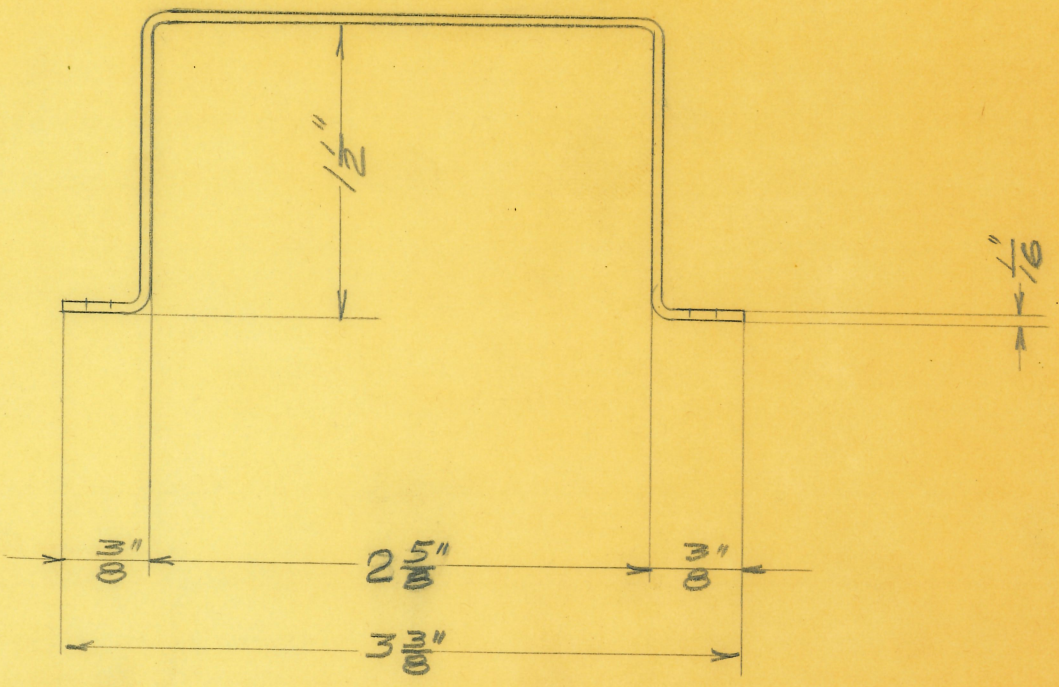

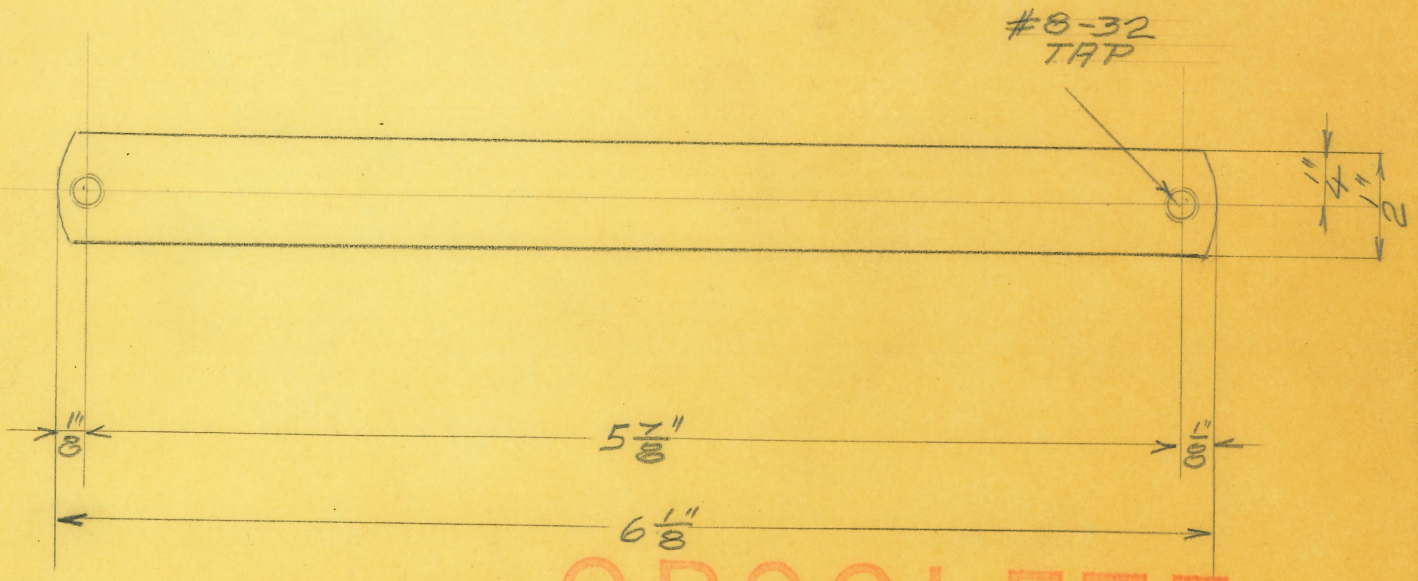

OBSOLETE

(1)

SIZE		ISSUE 9-13-26	C.P.
KIND	C.R. STEEL	CHANGED	
SHAPE		" "	
FINISH		" "	
TEMP.		" "	
PATT.		" "	

TITLE:

WAVE-GENERATOR
CONDENSER CLAMP

H. G. FISCHER & CO.
2335 WABANSIA AVE.
CHICAGO, ILL.

CAT. NO.

PART NO. 5366

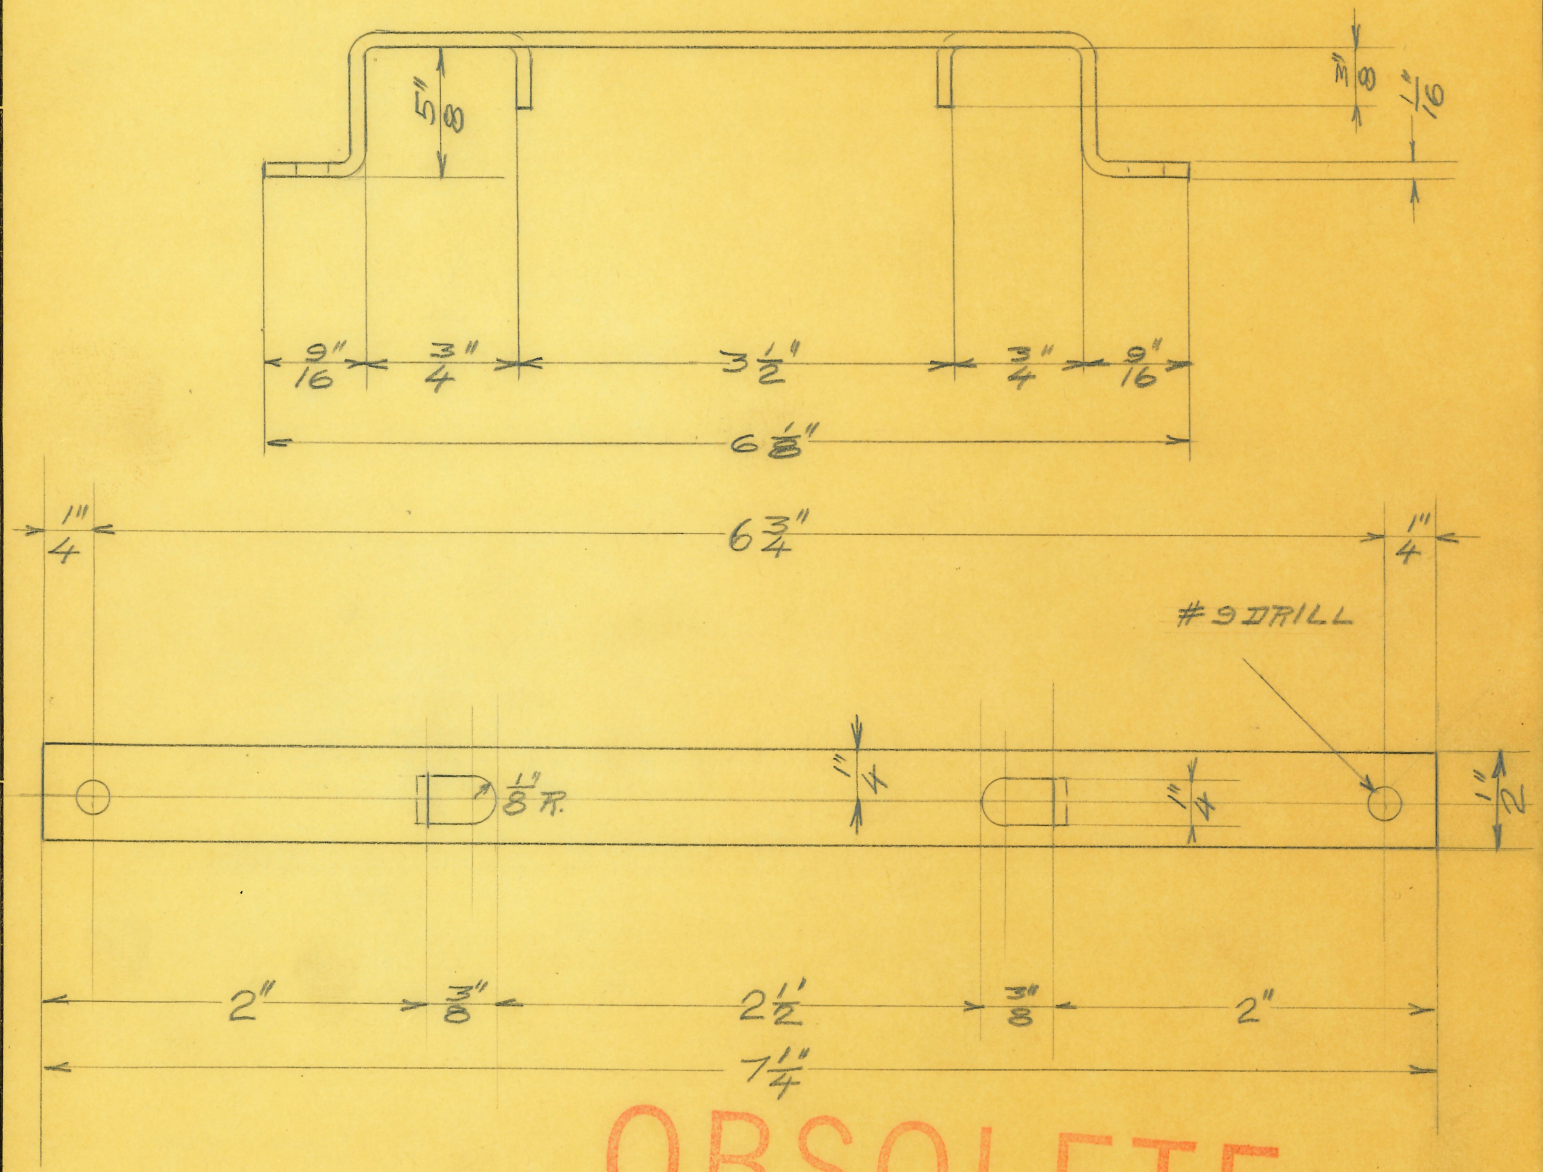

OBSOLETE

(2)

SIZE		ISSUE 9-13-26	
KIND	C.R.STEEL	CHANGED	
SHAPE		" "	
FINISH		" "	
TEMP.		" "	
PATT.		" "	

TITLE: WAVE-GENERATOR CLAMP FOR CHOKE COILS

H. G. FISCHER & CO.
2335 WABANSIA AVE.
CHICAGO, ILL.

CAT. NO.

PART NO. 5367

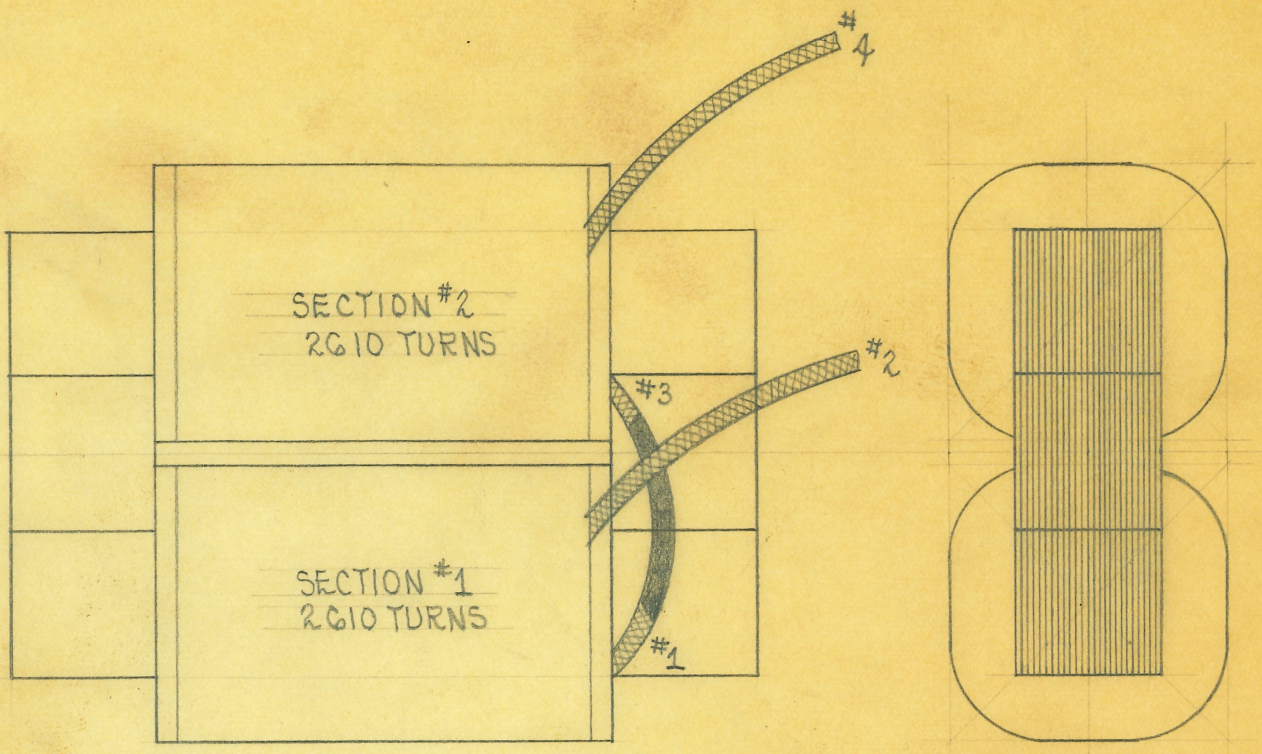

STEEL SIZES

PC. NO. 5043

CORE LAMS. CUT $3\frac{1}{8}$" X $\frac{3}{4}$"
END PIECES CUT $1\frac{9}{16}$" X $\frac{3}{4}$"
BIND CORES WITH FRICTION TAPE

WINDING DATA

SECTION #1

USE #29 ENAMEL WIRE

3 LAYER OF 5015 $\frac{1}{2}$ PAPER ON CORE. ANCHOR LEAD #1 WITH FRICTION TAPE AND WIND TO 2610 TURNS PLACING 1 LAYER OF 5015 $\frac{1}{2}$ PAPER BETWEEN EACH LAYER OF WIRE. ANCHOR END WITH FRICTION TAPE - LEAD #2. COVER WITH 5004 OILED TAPE AND SHELLAC. LEADS #1 & #2 ARE 5" &

14" RESP. OF 1648 - #20 WEATHERPROOF WIRE.

SECTION #2

WIND SAME AS SECT. #1 AND WHEN ASSEMBLED CONNECT LEADS #1 & #3 AND TAPE.

OBSOLETE

SIZE		ISSUE 3-24-32	J.E.	TITLE: WAVE GENERATOR CHOKE COIL	
KIND		CHANGED			
SHAPE		" "			
FINISH		" "			
TEMP.		" "		H. G. FISCHER & CO. 2335 WABANSIA AVE. CHICAGO, ILL.	CAT. NO.
PATT.		" "			PART NO. 5368G

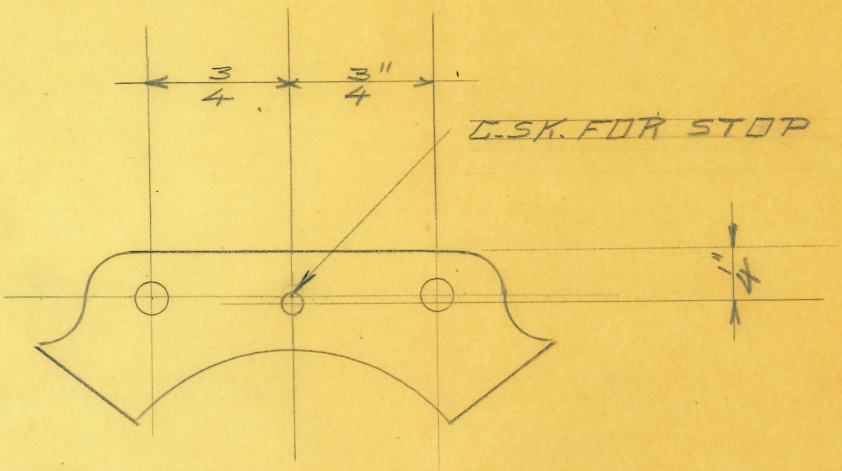

NOTE:
USE PART NO. 2243 1/4 AND SEE
DRAWING OF PART NO. 5370.

OBSOLETE

DRILL JIG # 4393
M. 11 FIX. # 4310

(2)

SIZE		ISSUE 9-13-26	
KIND		CHANGED	
SHAPE		" "	
FINISH		" "	
TEMP.		" "	
PATT.		" "	

TITLE: WAVE-GENERATOR SELECTOR SWITCH PLATE (3)

H. G. FISCHER & CO.
2335 WABANSIA AVE.
CHICAGO, ILL.

CAT. NO.

PART NO. 5369

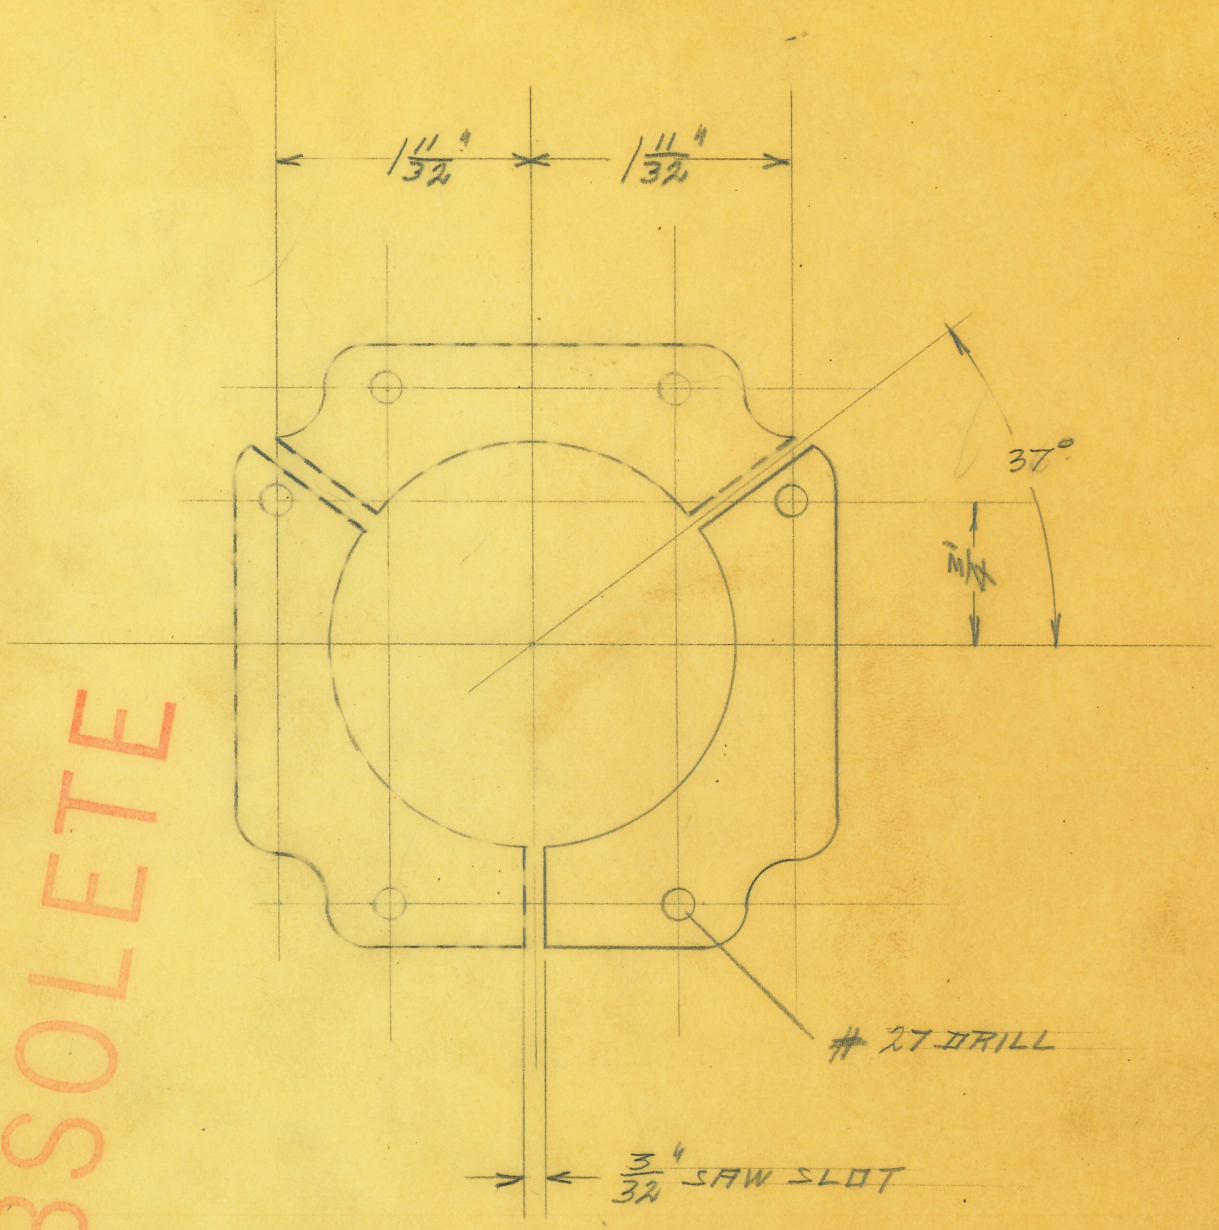

OBSOLETE

USE PART NO. 2243 1/4

Drill Jig #4393
Mill Fix. #4310

(4)

SIZE	BRASS	ISSUE 6-8-26	(2)	TITLE: WAVE-GENERATOR (2) SELECTOR SW. CONT. PLATE	
KIND		CHANGED			
SHAPE		" "			
FINISH		" "			
TEMP.		" "		H. G. FISCHER & CO. 2335 WABANSIA AVE. CHICAGO, ILL.	CAT. NO.
PATT.		" "			PART NO. 5370

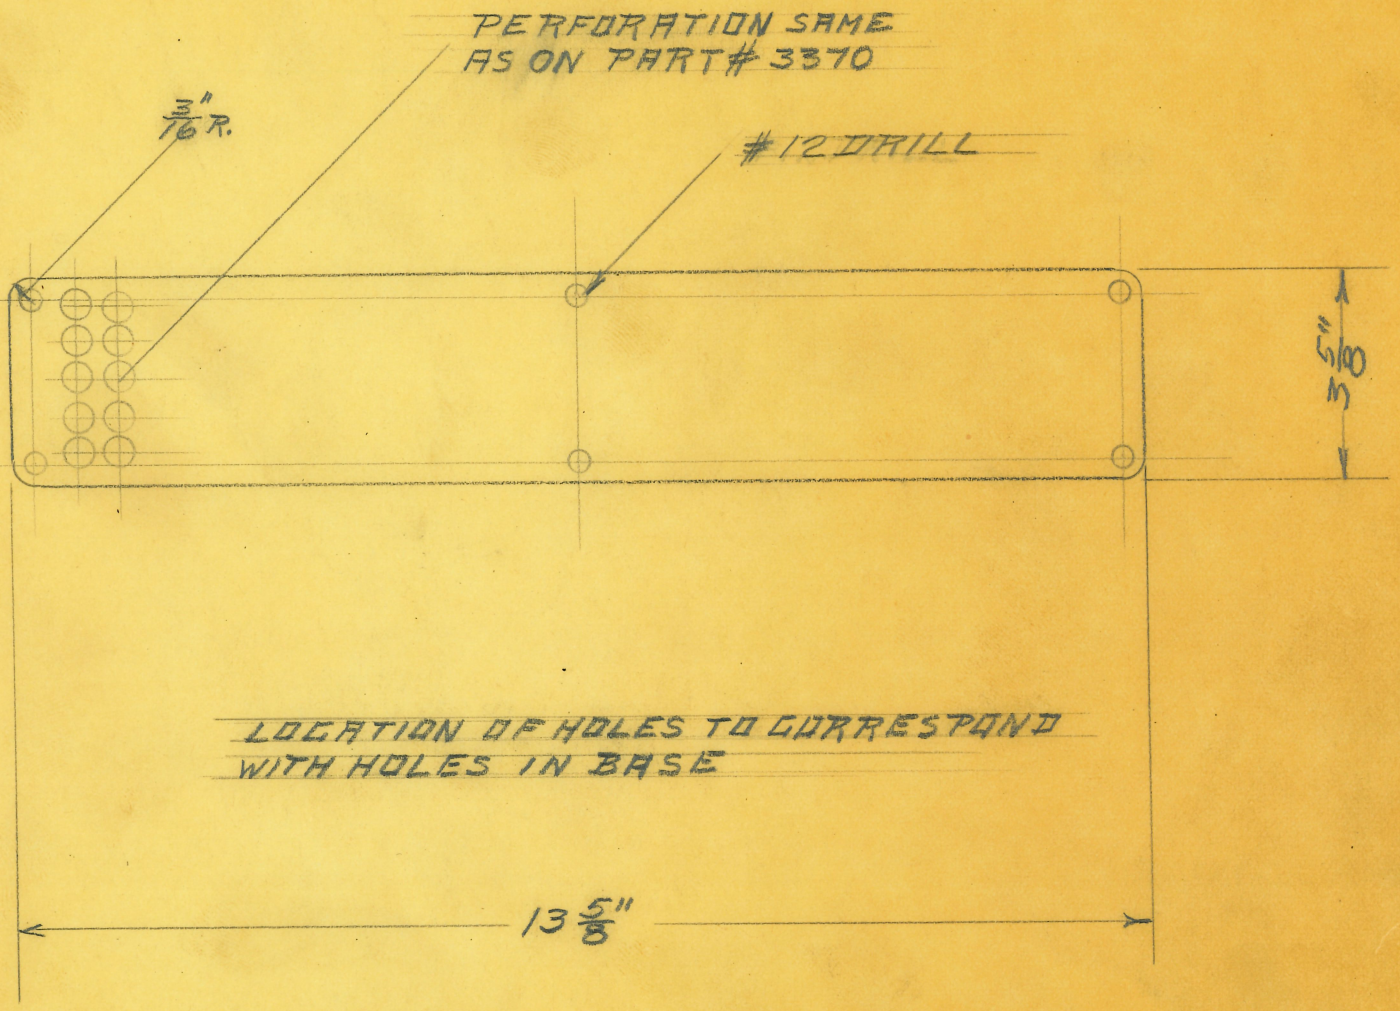

OBSOLETE

SIZE		ISSUE 6-10-26	C.	TITLE: VENTILATING PLATE for WAVE-GENERATOR	
KIND	.025" SHEET STEEL	CHANGED			
SHAPE		" "			
FINISH	BLACK LACQUER	" "			
TEMP.		" "			
PATT.		" "			
				H. G. FISCHER & CO. 2335 WABANSIA AVE. CHICAGO, ILL.	CAT. NO.
					PART NO. 5371

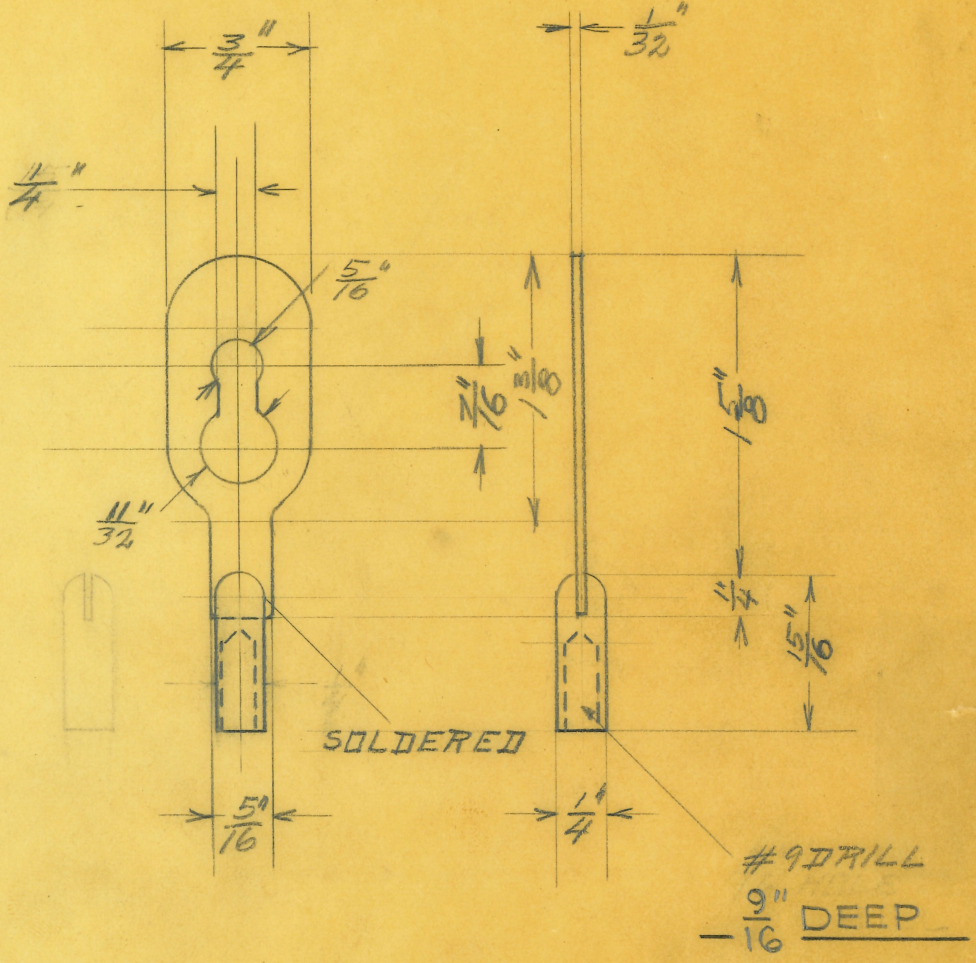

OBSOLETE

SIZE		ISSUE 6-11-26	C.	TITLE: PAD CORDTIP. WAVE-GENERATOR	
KIND	BRASS	CHANGED			
SHAPE		" "			
FINISH	N.P.	" "			
TEMP.		" "		H. G. FISCHER & CO. 2335 WABANSIA AVE. CHICAGO, ILL.	CAT. NO.
PATT.		" "			PART NO. 5372G

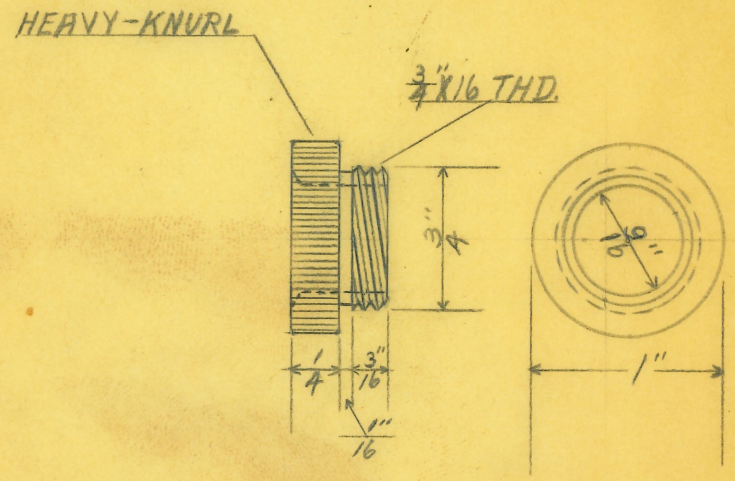

OBSOLETE

SIZE	1''	ISSUE	9-5-28	TITLE: WAVE-GEN. LINE-CORD-BUSHING		
KIND	POL. RUBBER	CHANGED				
SHAPE	ROD	" "				
FINISH	BUFF	" "				
TEMP.		" "		H. G. FISCHER & CO. 2335 WABANSIA AVE. CHICAGO, ILL.	CAT. NO.	PART NO. 5372
PATT.		" "				

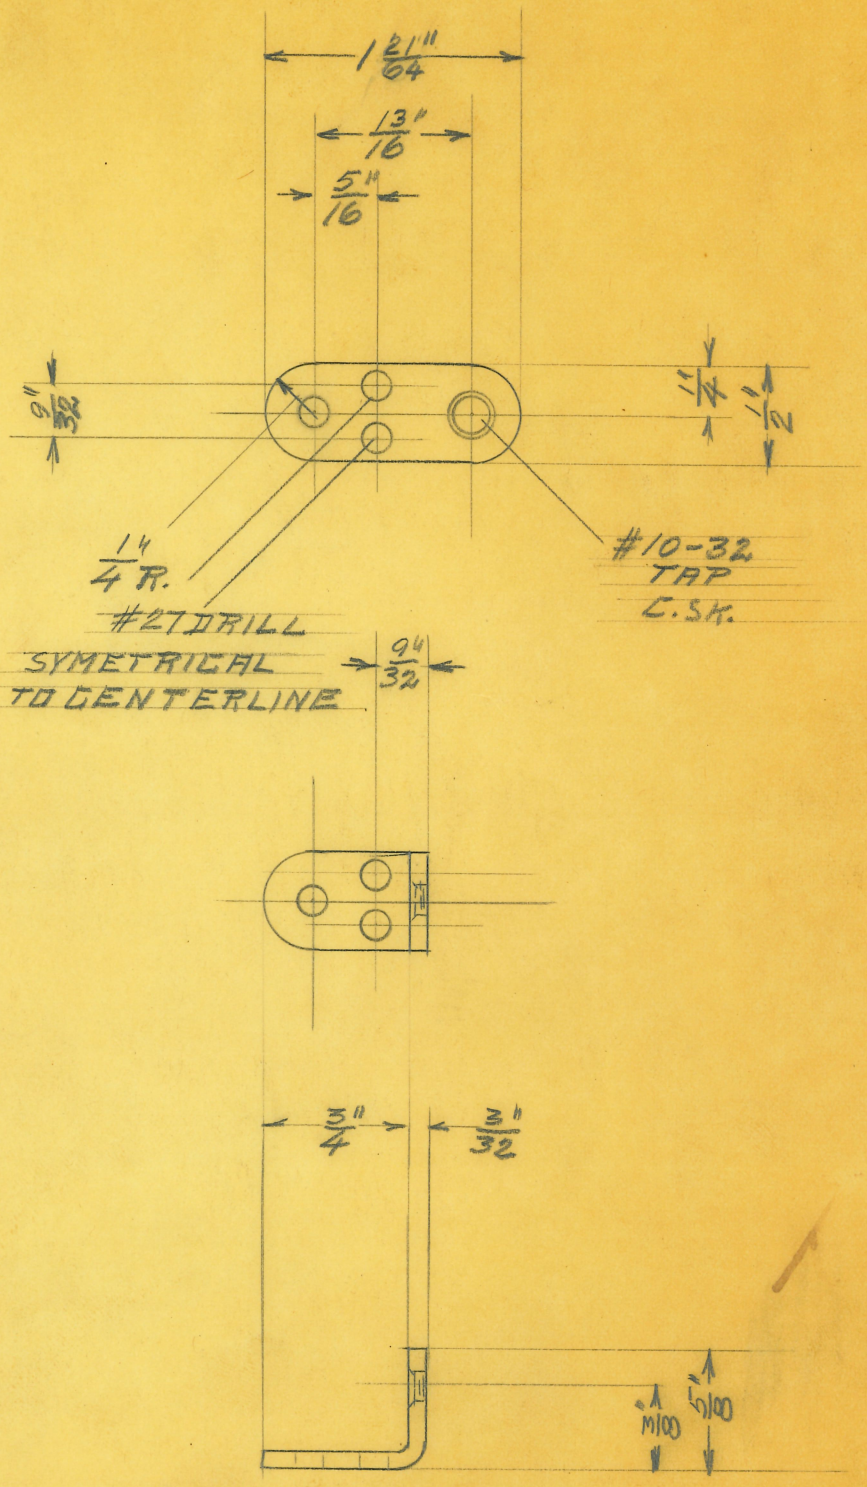

OBSOLETE

(2)

SIZE		ISSUE 6-12-26	Q.	TITLE: ANGLE-CLAMP FOR REARCASE WAVE-GENERATOR	
KIND	C.R.STEEL	CHANGED			
SHAPE		" "			
FINISH		" "			
TEMP.		" "		H. G. FISCHER & CO. 2335 WABANSIA AVE. CHICAGO, ILL.	CAT. NO.
PATT.		" "			PART NO. 5373

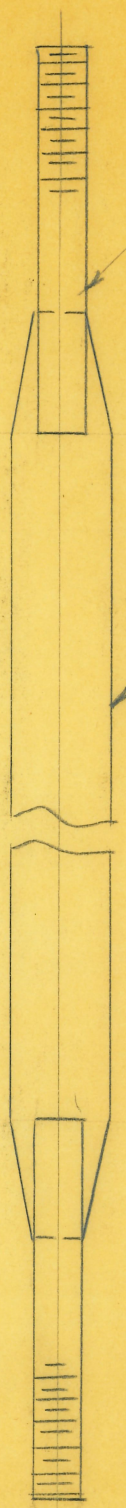

OBSOLETE

(2)

SIZE		ISSUE 9-11-26		TITLE: WAVE-GENERATOR MOTOR FASTING STRAP	
KIND		CHANGED			
SHAPE		" "			
FINISH		" "			
TEMP.		" "		H. G. FISCHER & CO. 2335 WABANSIA AVE. CHICAGO, ILL.	CAT. NO.
PATT.		" "			PART NO. 5376 G

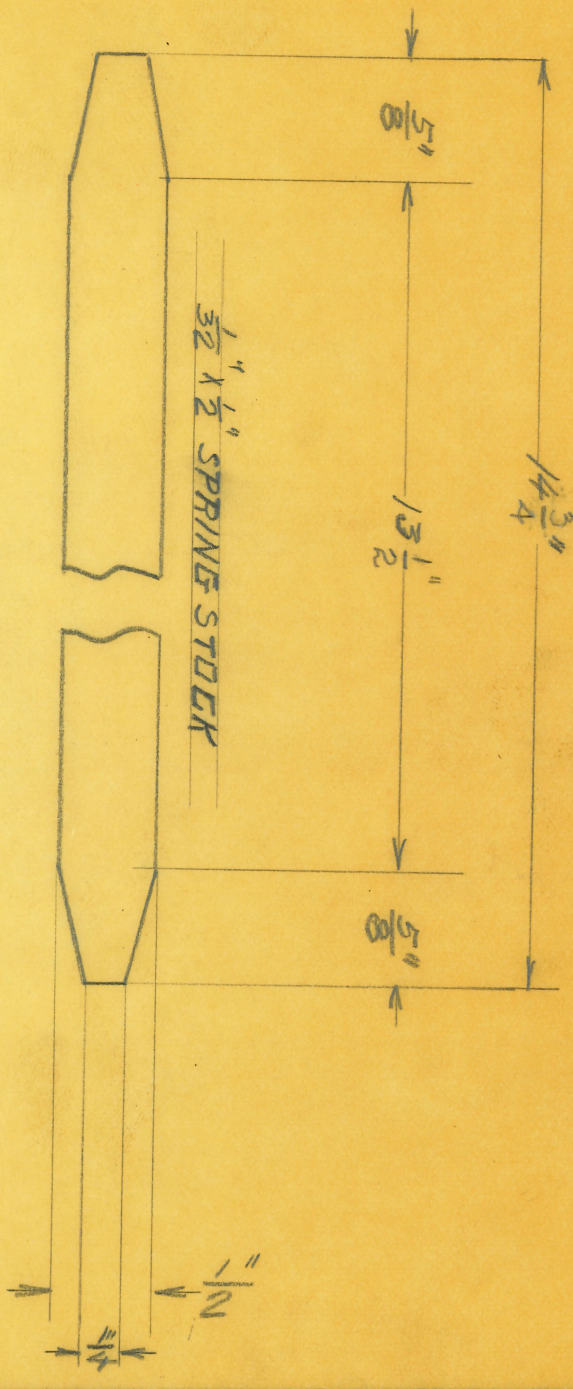

OBSOLETE

(2)

SIZE		ISSUE 6-21-26	P.
KIND	SPRING STOCK	CHANGED	
SHAPE		" "	
FINISH		" "	
TEMP.		" "	
PATT.		" "	

TITLE: MOTOR FASTING STRAP
WAVE-GENERATOR

H. G. FISCHER & CO.
2335 WABANSIA AVE.
CHICAGO, ILL.

CAT. NO.

PART NO. 5377

OBSOLETE

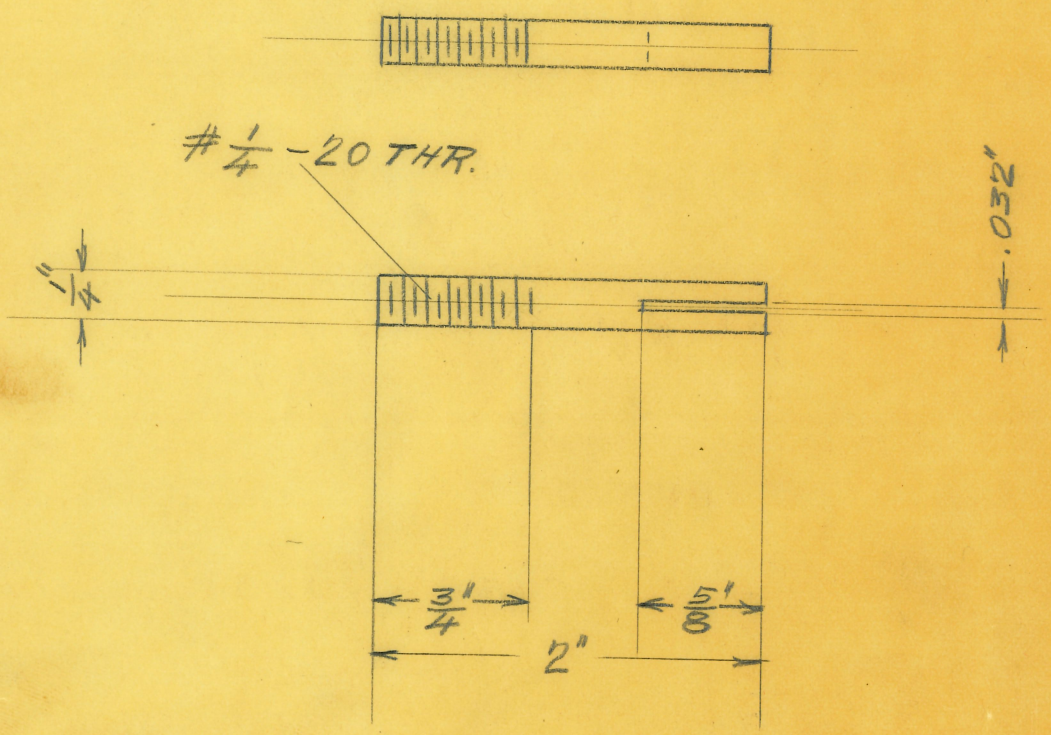

SIZE		ISSUE 6-21-26	C.	TITLE: MOTOR FASTING STUD WAVE-GENERATOR	
KIND	D. R. STEEL	CHANGED			
SHAPE		" "			
FINISH		" "			
TEMP.		" "		H. G. FISCHER & CO. 2335 WABANSIA AVE. CHICAGO, ILL.	CAT. NO.
PATT.		" "			PART NO. 5378

OBSOLETE

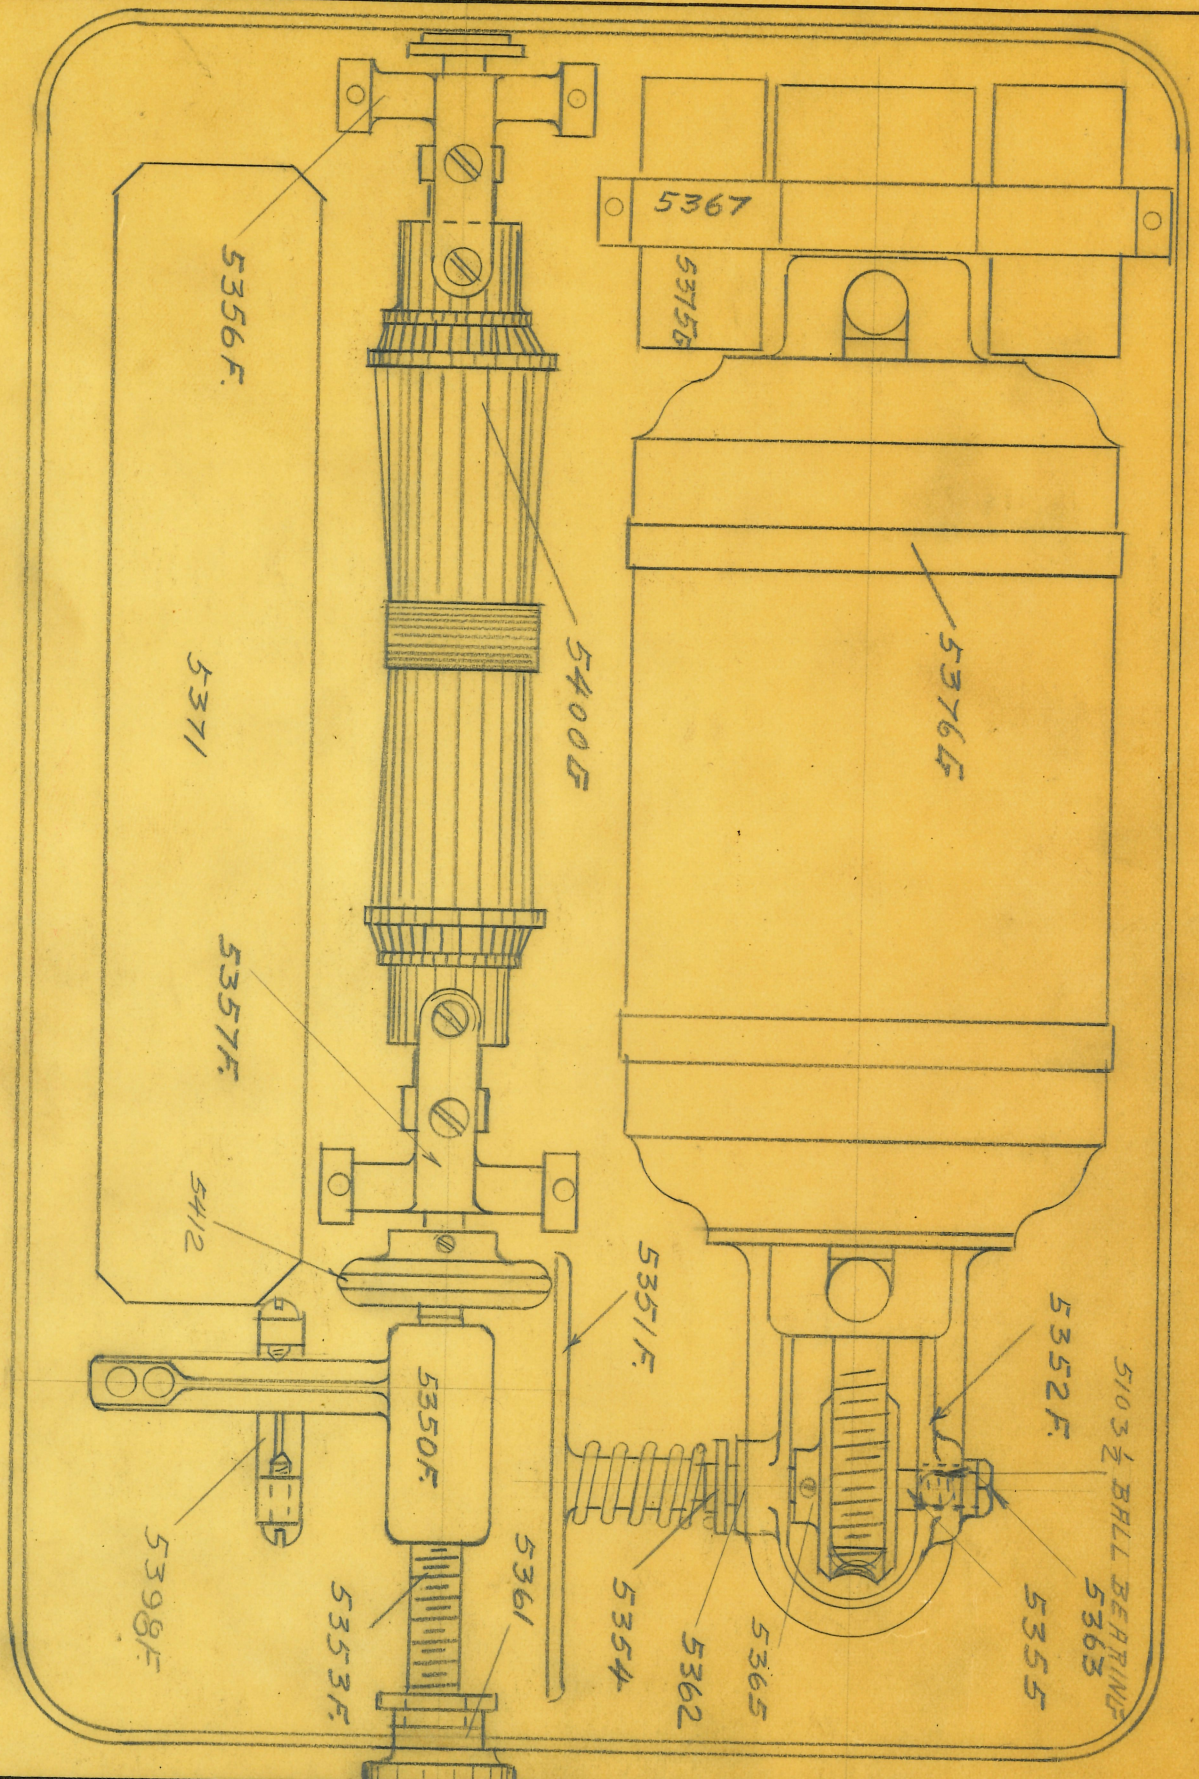

SIZE		ISSUE 6-29-26	R.	TITLE: ASSEMBLY OF BASE. WAVE-GENERATOR.	
KIND		CHANGED			
SHAPE		" "			
FINISH		" "			
TEMP.		" "			
PATT.		" "			

H. G. FISCHER & CO.
2335 WABANSIA AVE.
CHICAGO, ILL.

CAT. NO.

PART NO. 5379 G

OBSOLETE

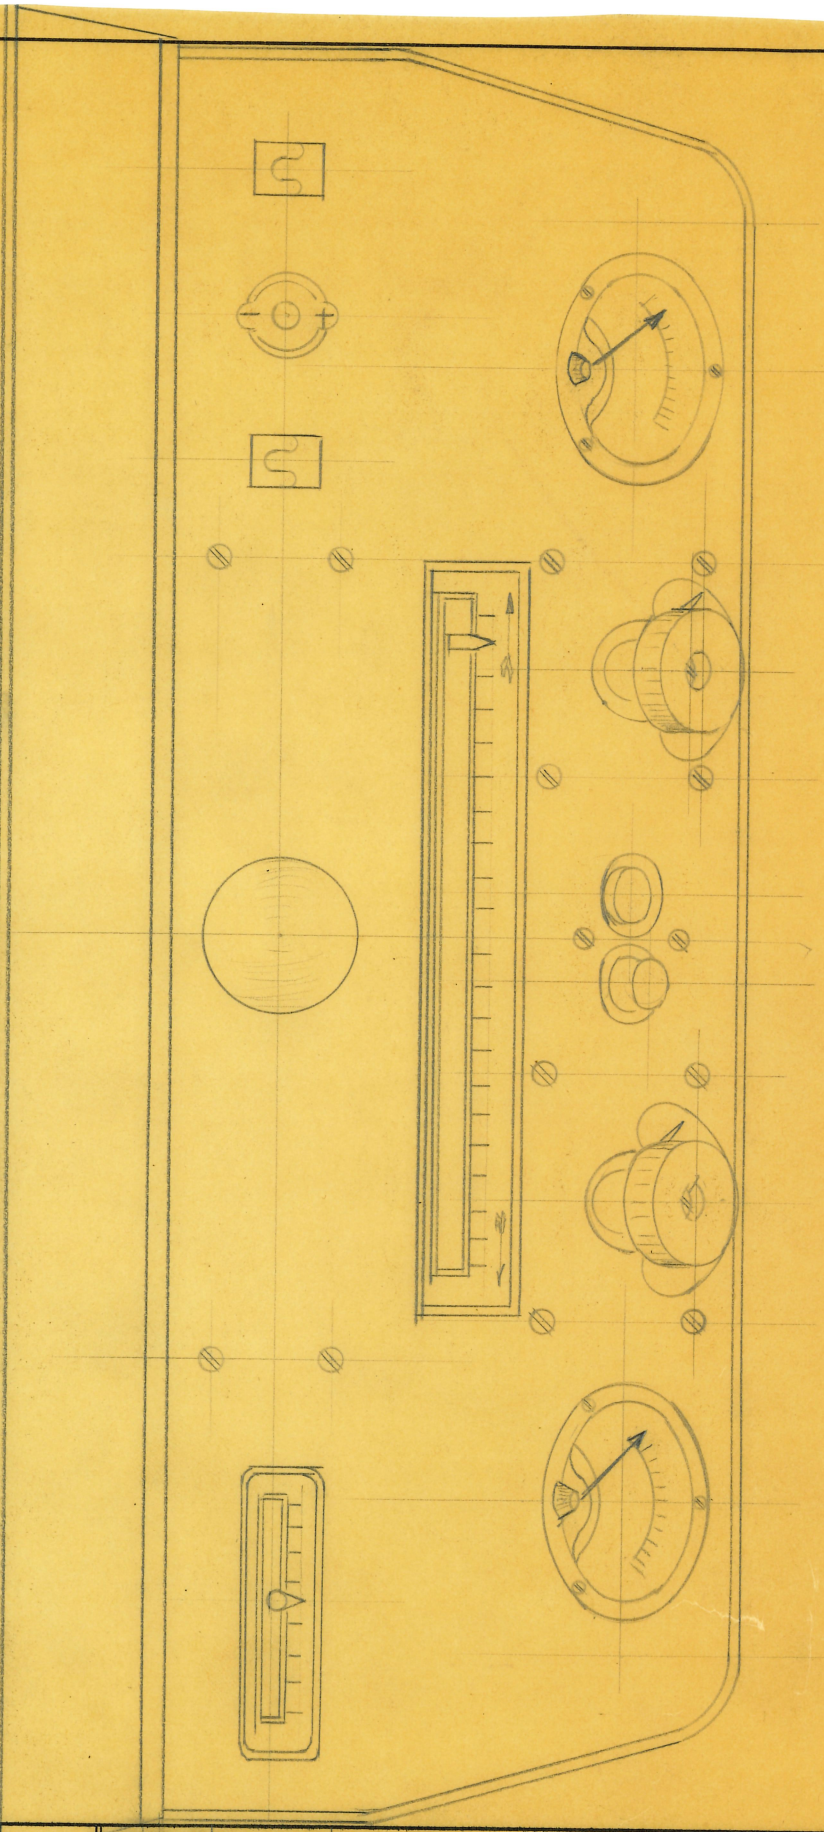

SIZE		ISSUE 9-1426	
KIND		CHANGED	
SHAPE		" "	
FINISH		" "	
TEMP.		" "	
PATT.		" "	

TITLE: WAVE-GENERATOR FRONT COMPL. ASSEMBLY

H. G. FISCHER & CO.
2335 WABANSIA AVE.
CHICAGO, ILL.

CAT. NO.

PART NO. 5380 G

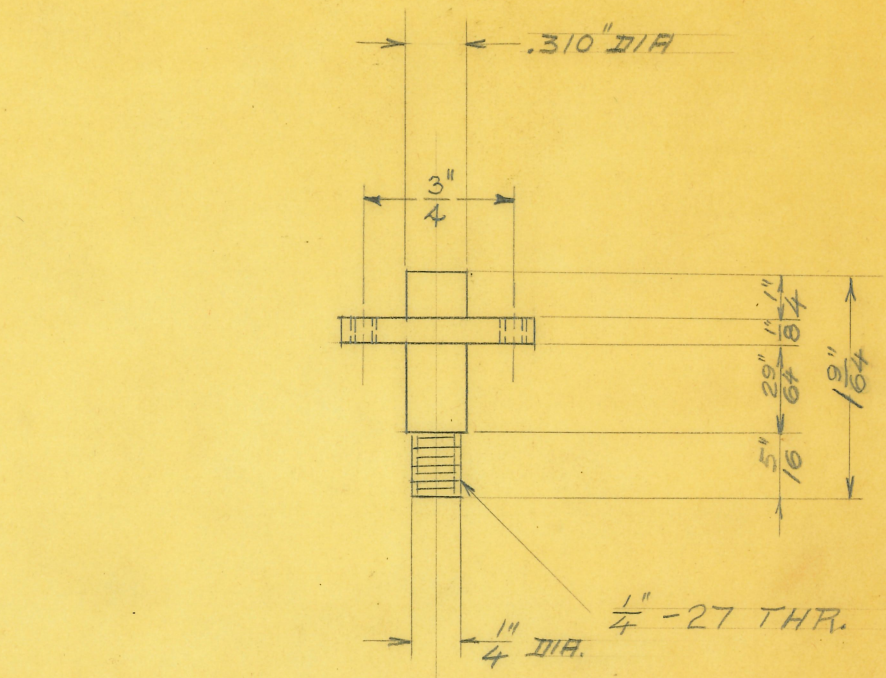

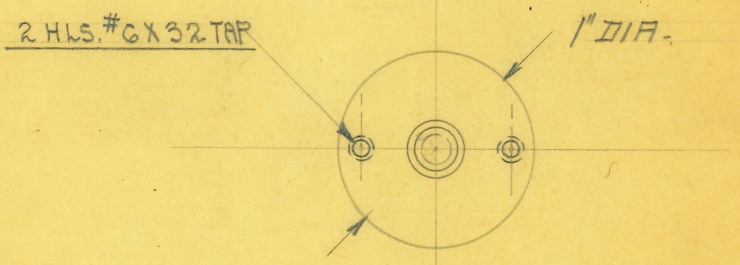

OBSOLETE

(1)

SIZE		ISSUE 9-29-26	EP	TITLE: WAVE-GENERATOR DRIVE PULLEY SHAFT (RHEOST.)
KIND	C.R. STEEL	CHANGED		
SHAPE		" "		
FINISH		" "		
TEMP.		" "		H. G. FISCHER & CO. 2335 WABANSIA AVE. CHICAGO, ILL.
PATT.		" "		CAT. NO.
				PART NO. 5388

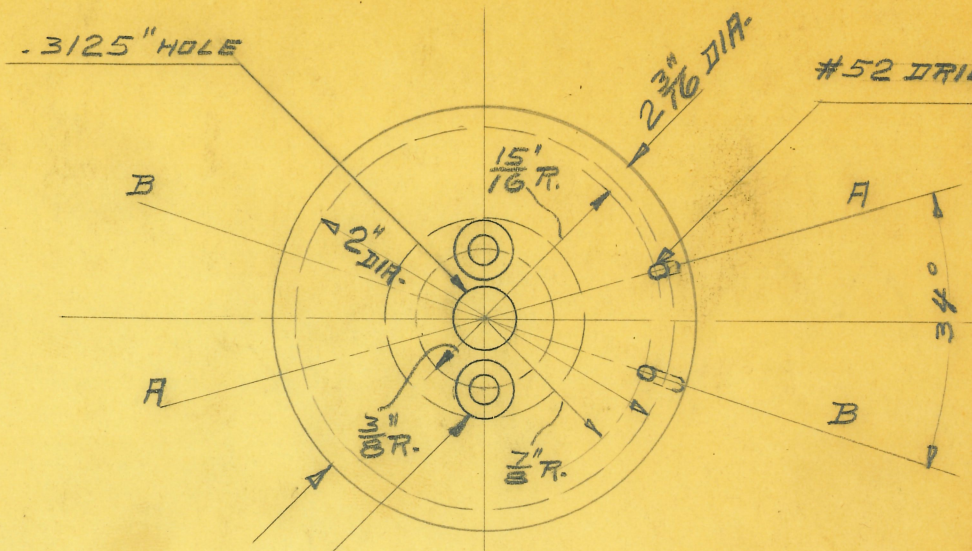

SECTION A-A.

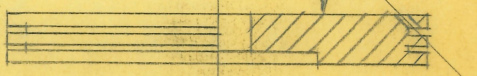

OBSOLETE

BREAK CORNERS

SECTION B-B.

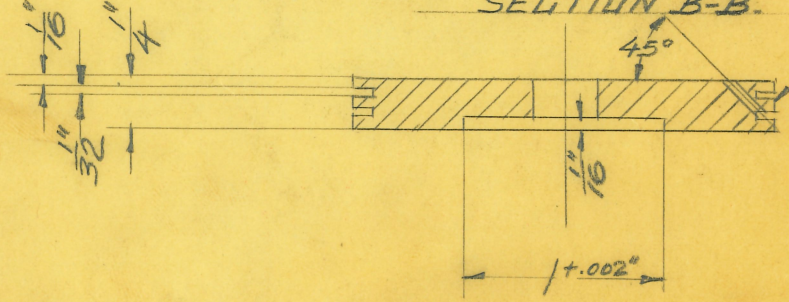

SIZE		ISSUE 11-5-26	
KIND	FIBRE	CHANGED	
SHAPE		" "	
FINISH		" "	
TEMP.		" "	
PATT.		" "	

TITLE: RESISTANCE DRIVE PULLEY WAVE-GENERATOR

H. G. FISCHER & CO.
2335 WABANSIA AVE.
CHICAGO, ILL.

CAT. NO.

PART NO. 5389A

NOTE:

DRAWN DOUBLE SCALE

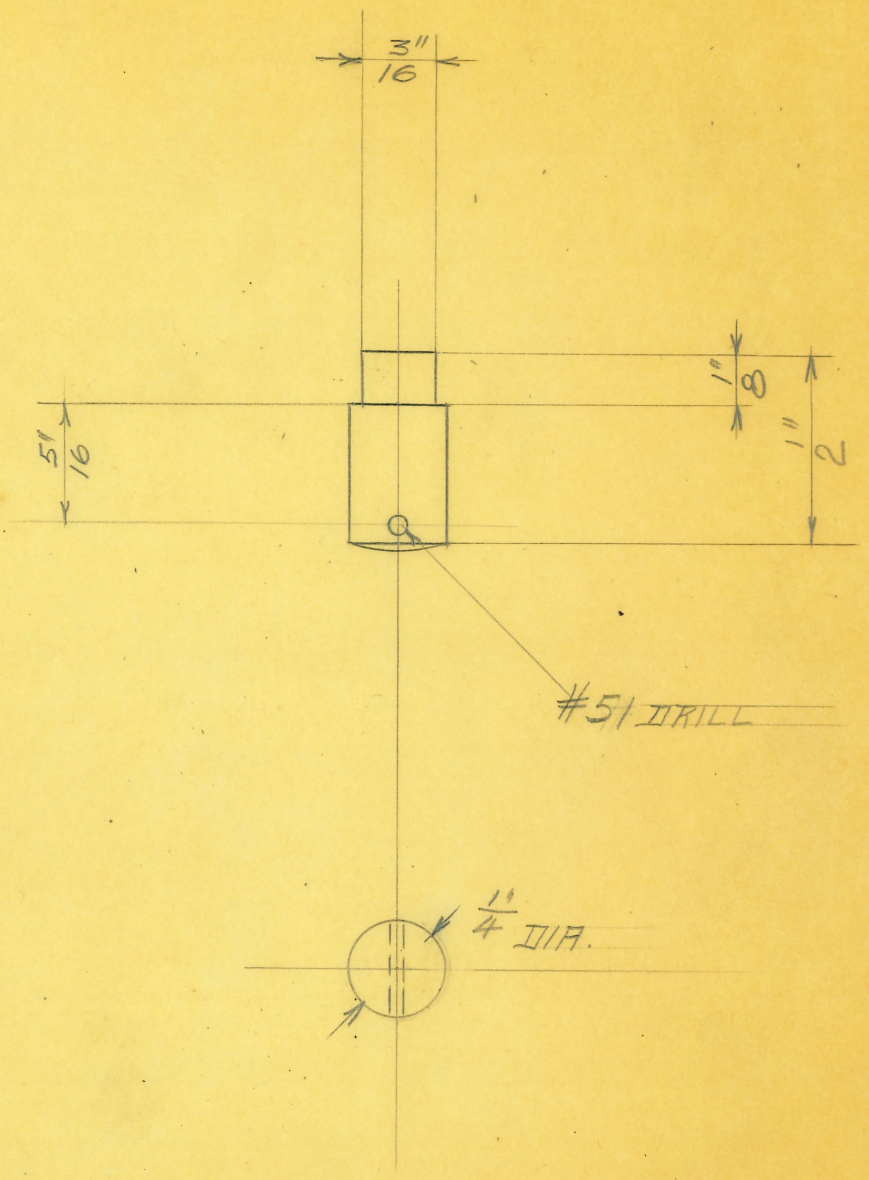

OBSOLETE

(2)

SIZE		ISSUE 9-7-26	OP.
KIND	C.R. STEEL	CHANGED	
SHAPE		" "	
FINISH		" "	
TEMP.		" "	
PATT.		" "	

TITLE: WAVE-GENERATOR RHEOST. PULLEY STUD

H. G. FISCHER & CO.
2335 WABANSIA AVE.
CHICAGO, ILL.

CAT. NO.

PART NO. 5390.

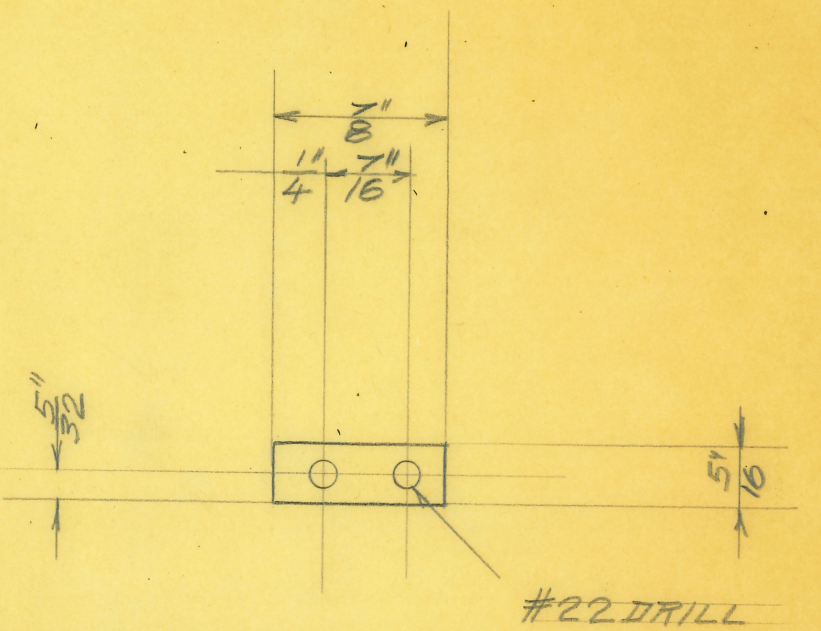

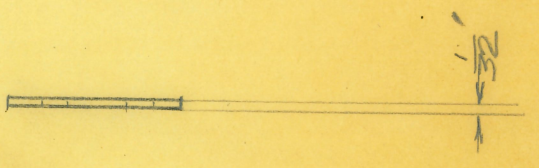

OBSOLETE

(2)

SIZE		ISSUE 9-7-26	WT
KIND	FIBROC	CHANGED	
SHAPE		" "	
FINISH		" "	
TEMP.		" "	
PATT.		" "	

TITLE:

WAVE-GENERATOR

POINTER INSULATING PLATE

H. G. FISCHER & CO.
2335 WABANSIA AVE.
CHICAGO, ILL.

CAT. NO.

PART NO. 5391

NOTE:
DRAWN DOUBLE SCALE

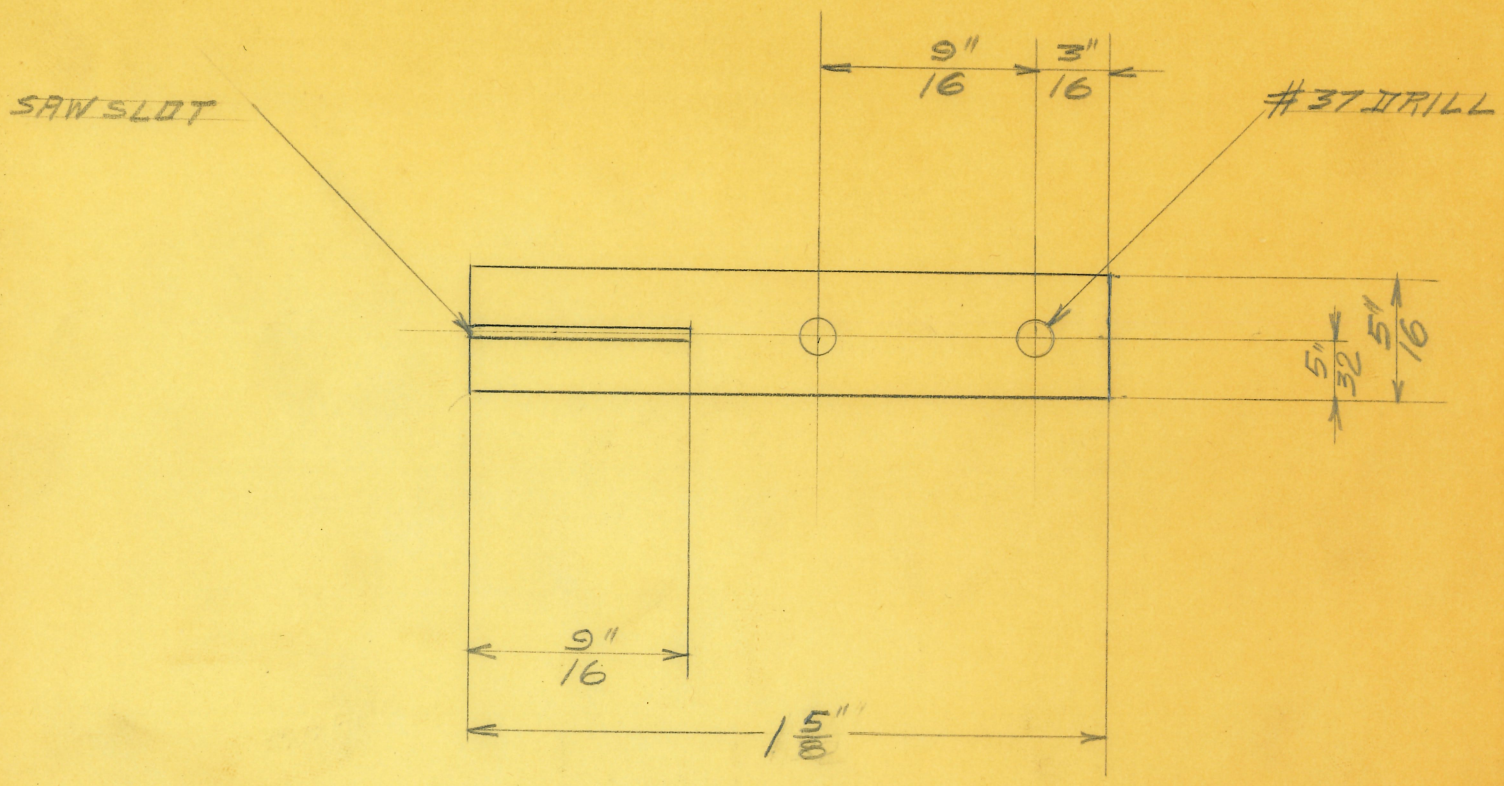

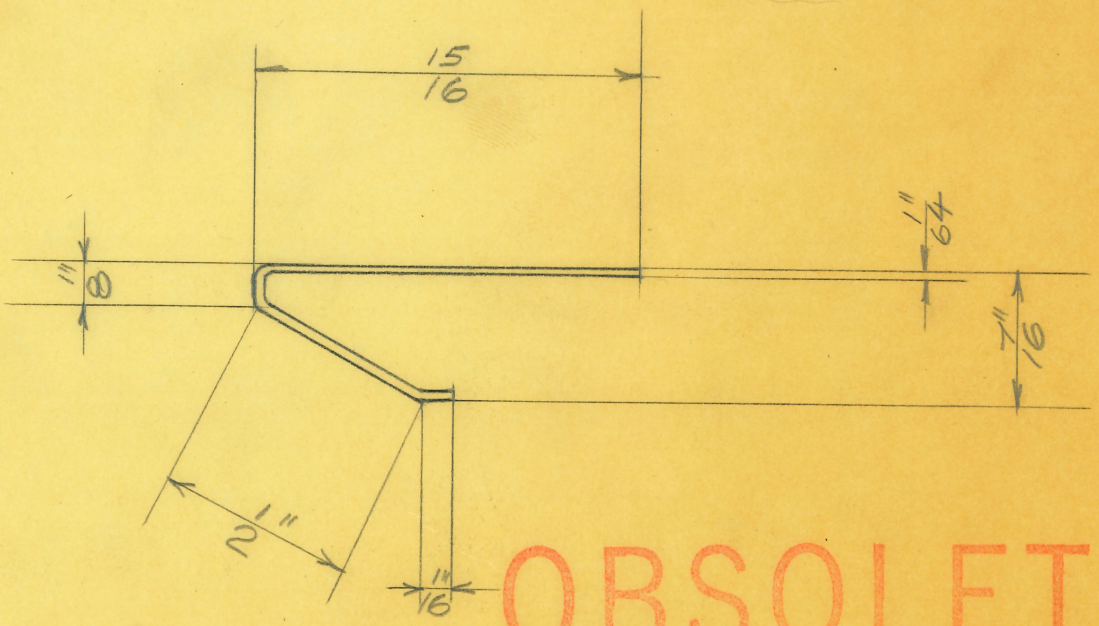

OBSOLETE

(1)

SIZE		ISSUE 9-7-26	CP
KIND	BRONZE	CHANGED	
SHAPE		" "	
FINISH		" "	
TEMP.		" "	
PATT.		" "	

TITLE:
WAVE-GENERATOR
RHEOSTAT CONTACT SPRING

H. G. FISCHER & CO.
2335 WABANSIA AVE.
CHICAGO, ILL.

CAT. NO.

PART NO. 5392

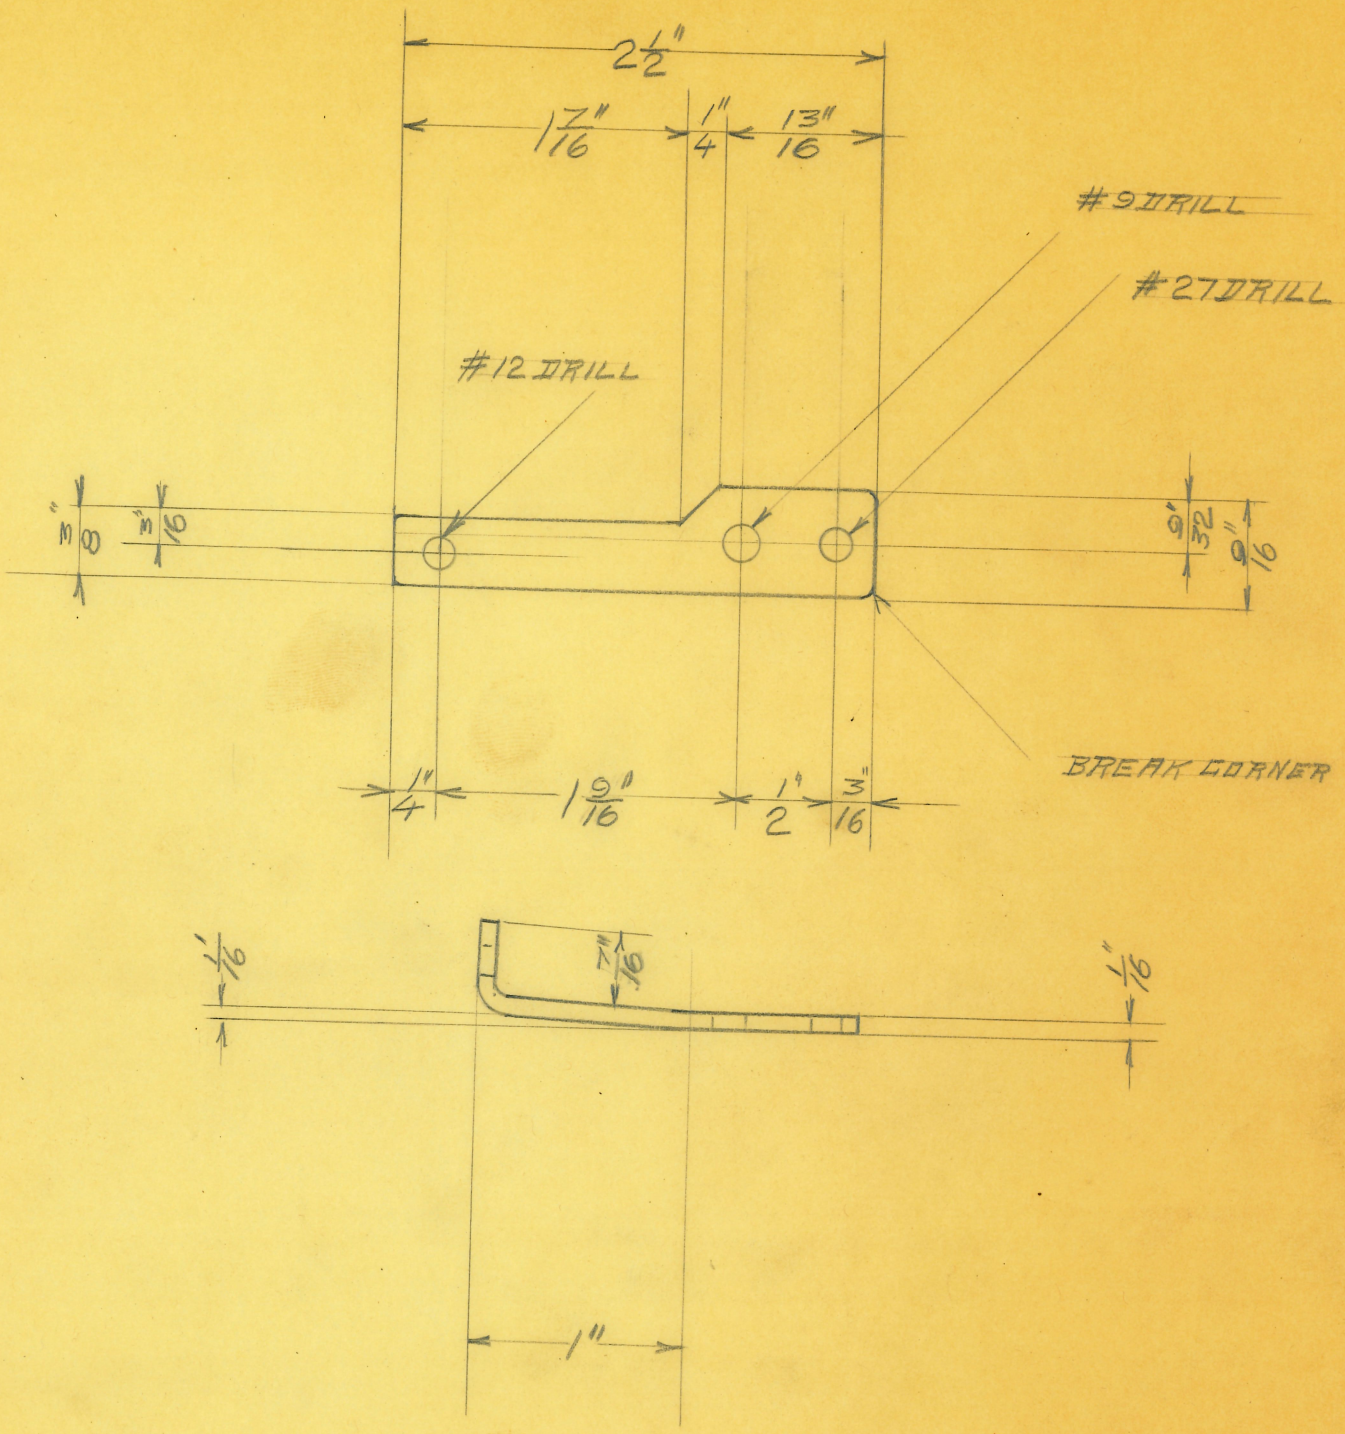

OBSOLETE

(1)

SIZE		ISSUE 9-3-26	C.P.
KIND	DRUG. STEEL	CHANGED	
SHAPE		" "	
FINISH		" "	
TEMP.		" "	
PATT.		" "	

TITLE:

WAVE-GENERATOR
PULLEY SUPPORT (LEFT)

H. G. FISCHER & CO.
2335 WABANSIA AVE.
CHICAGO, ILL.

CAT. NO.

PART NO. 5393

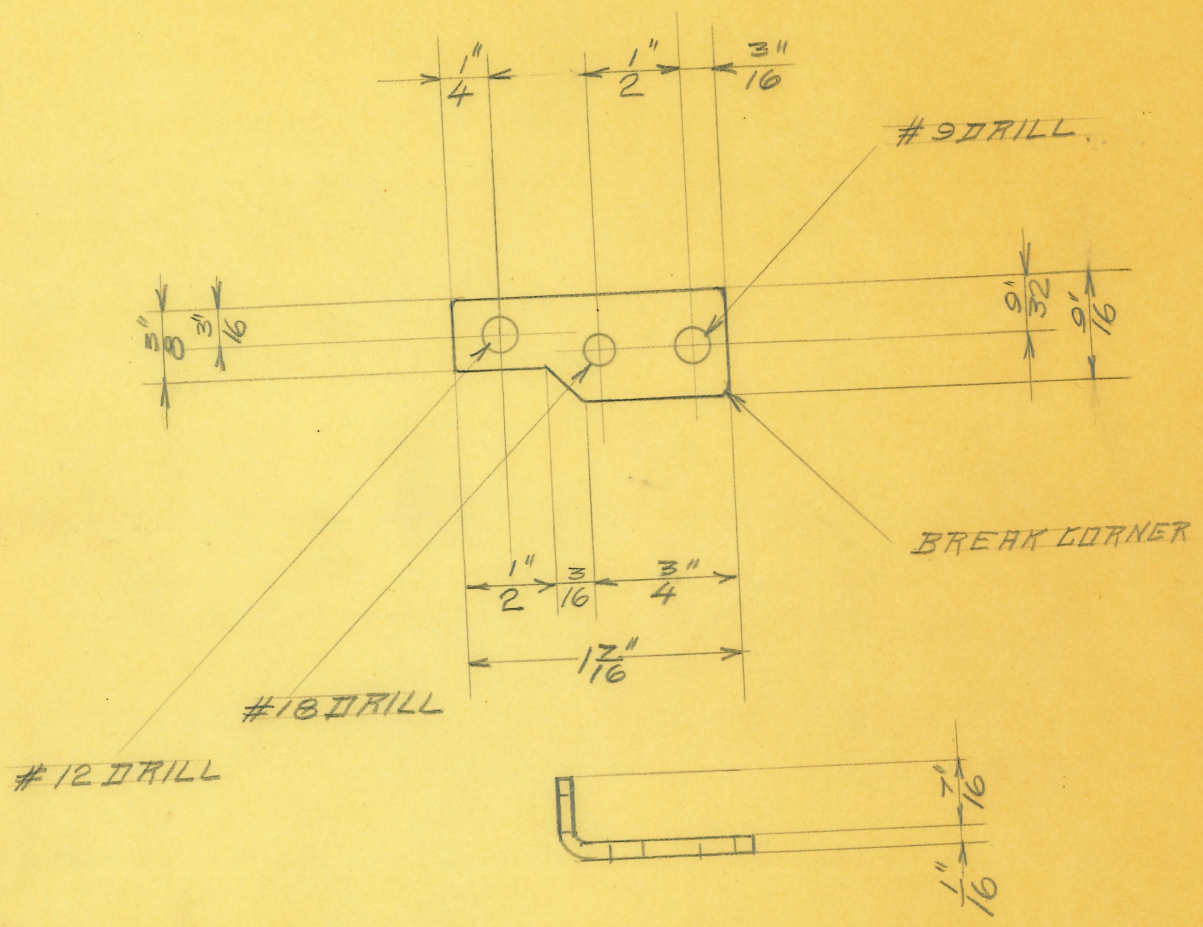

OBSOLETE

(1)

SIZE		ISSUE 9-3-26	E.P.
KIND	C.R. STEEL	CHANGED	
SHAPE		" "	
FINISH		" "	
TEMP.		" "	
PATT.		" "	

TITLE: WAVE-GENERATOR PULLEY SUPPORT (RIGHT)

H. G. FISCHER & CO.
2335 WABANSIA AVE.
CHICAGO, ILL.

CAT. NO.

PART NO. 5394.

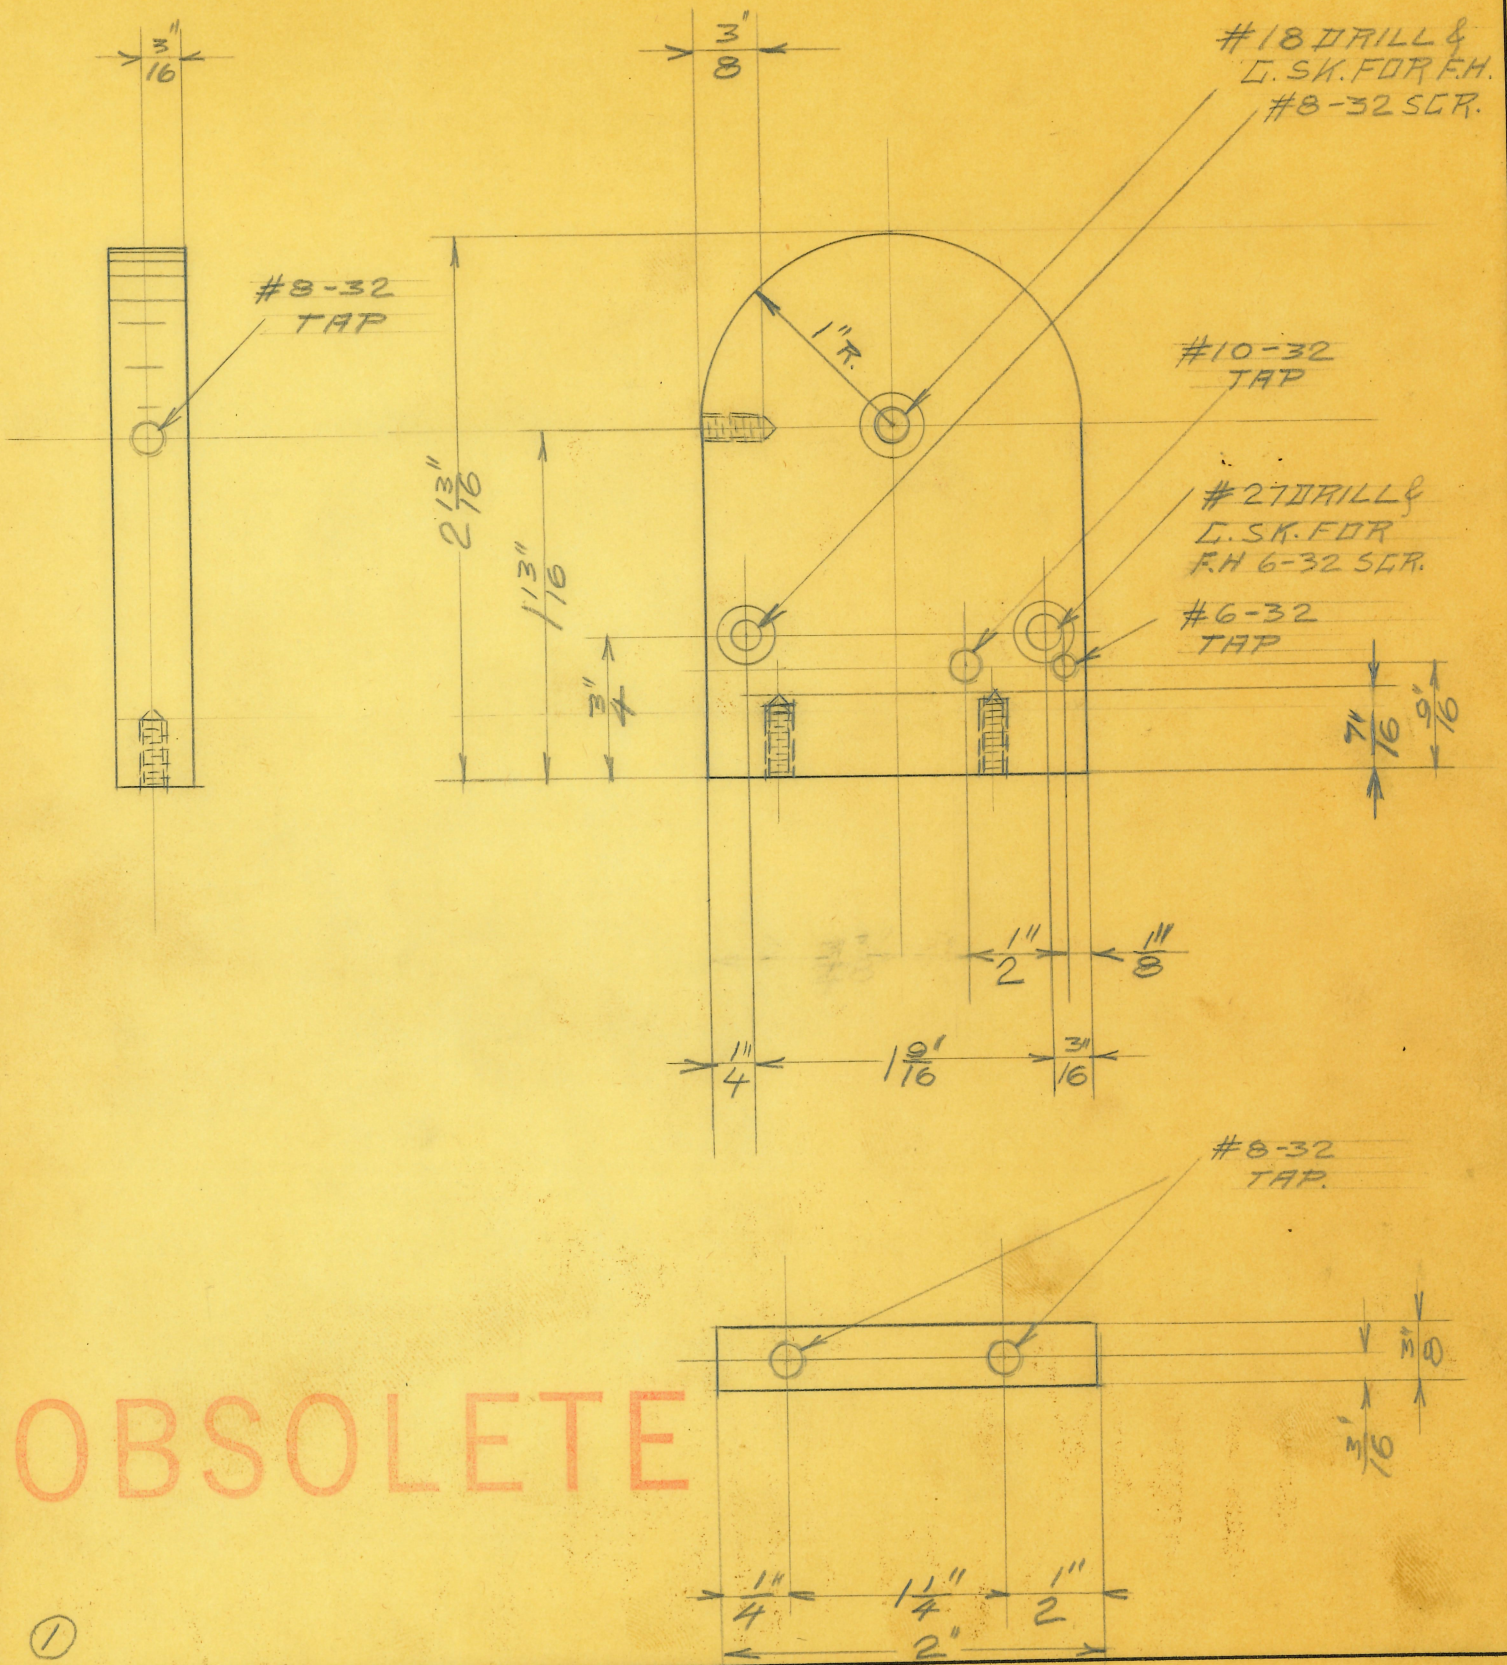

OBSOLETE

(1)

SIZE		ISSUE 9-3-26	EP.
KIND	FIBRE	CHANGED	
SHAPE		" "	
FINISH		" "	
TEMP.		" "	
PATT.		" "	

TITLE: WAVE-GENERATOR (1)
RHEOSTAT SUPPORT (LEFT)

H. G. FISCHER & CO.
2335 WABANSIA AVE.
CHICAGO, ILL.

CAT. NO.

PART NO. 5395

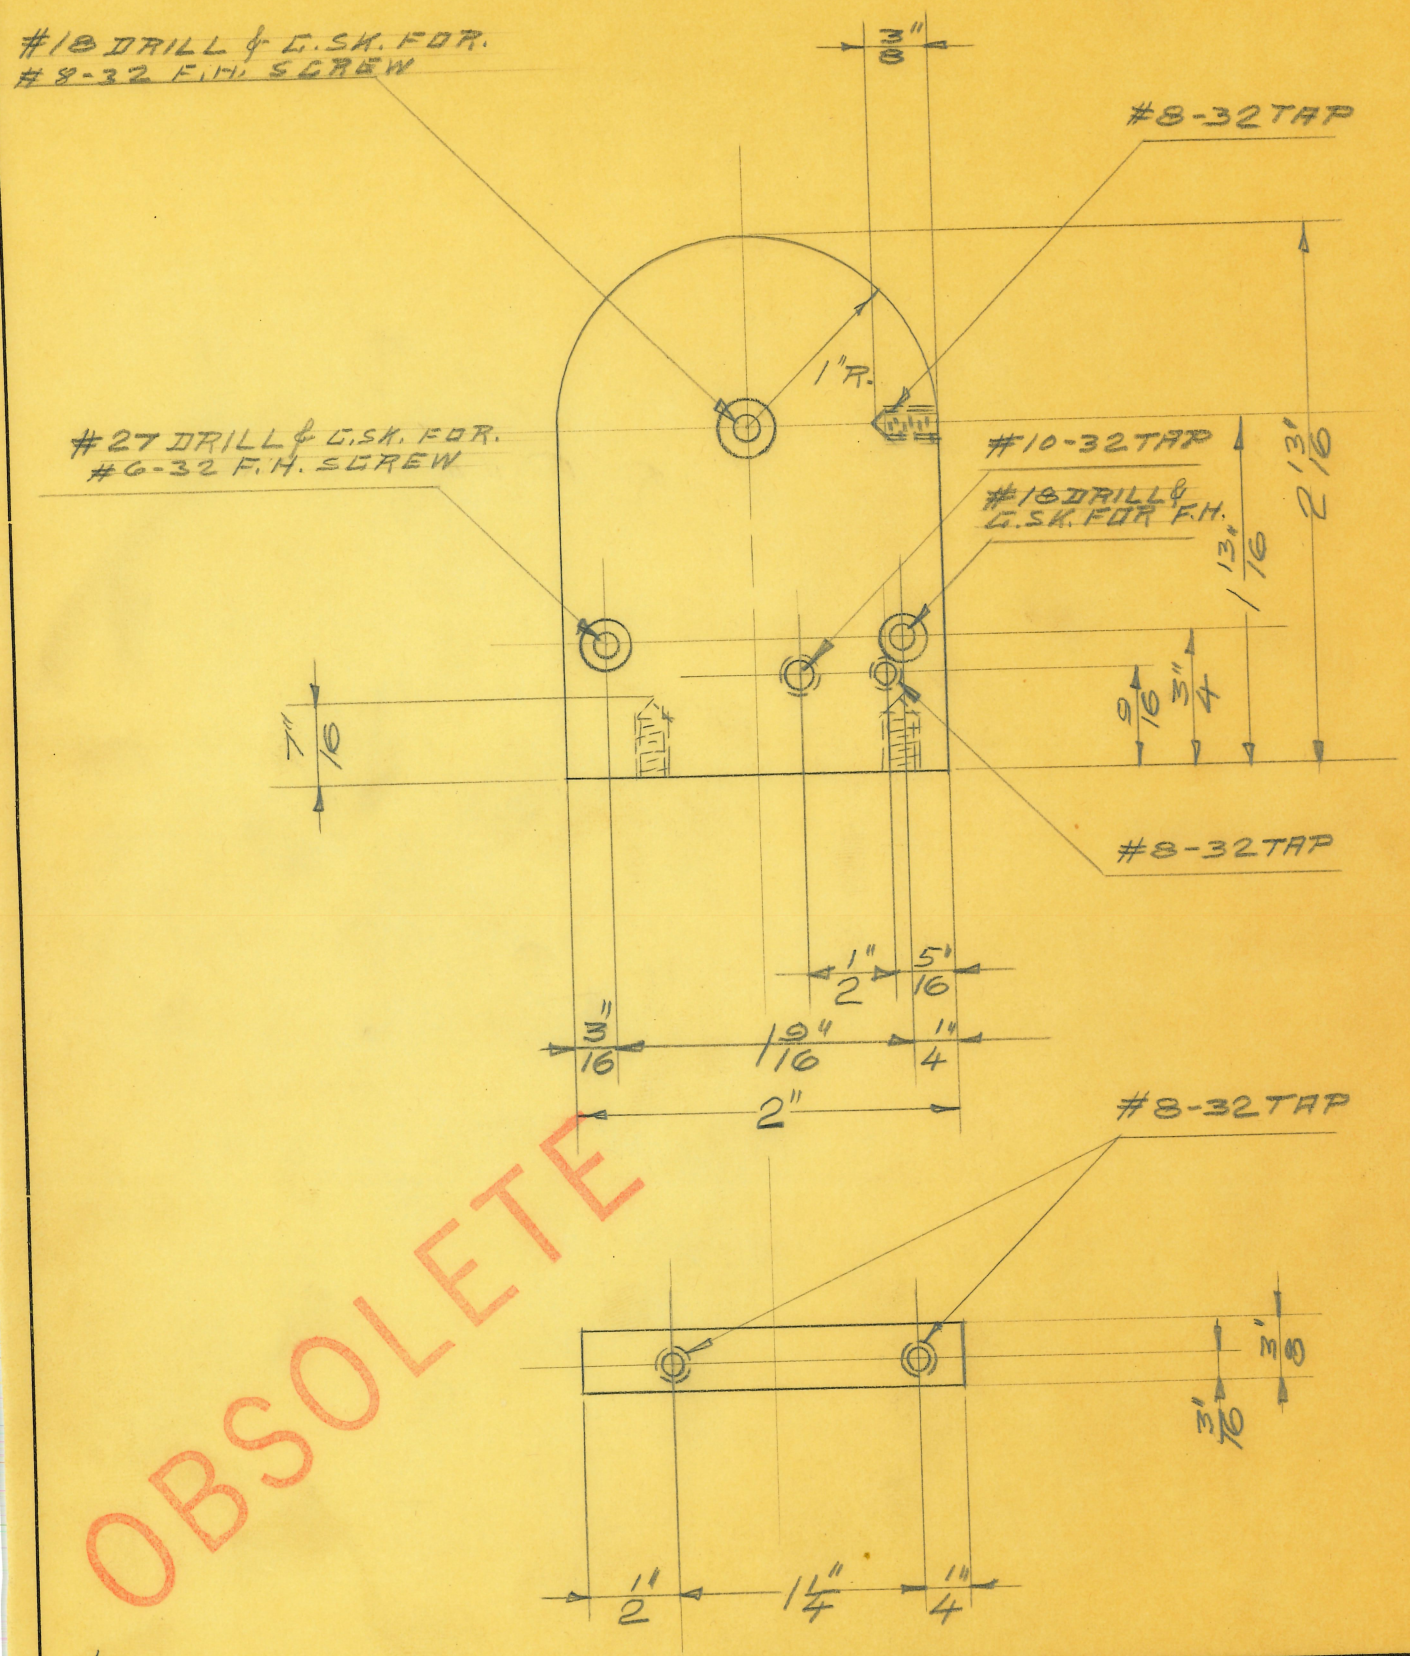

OBSOLETE

/

SIZE		ISSUE 10-30-26	CT.
KIND	FIBRE	CHANGED	
SHAPE		" "	
FINISH		" "	
TEMP.		" "	
PATT.		" "	

TITLE: WAVE-GENERATOR RHEOSTAT SUPPORT (RIGHT)

H. G. FISCHER & CO.
2335 WABANSIA AVE.
CHICAGO, ILL.

CAT. NO.

PART NO. 5396

NOTE:
DRAWN DOUBLE SCALE

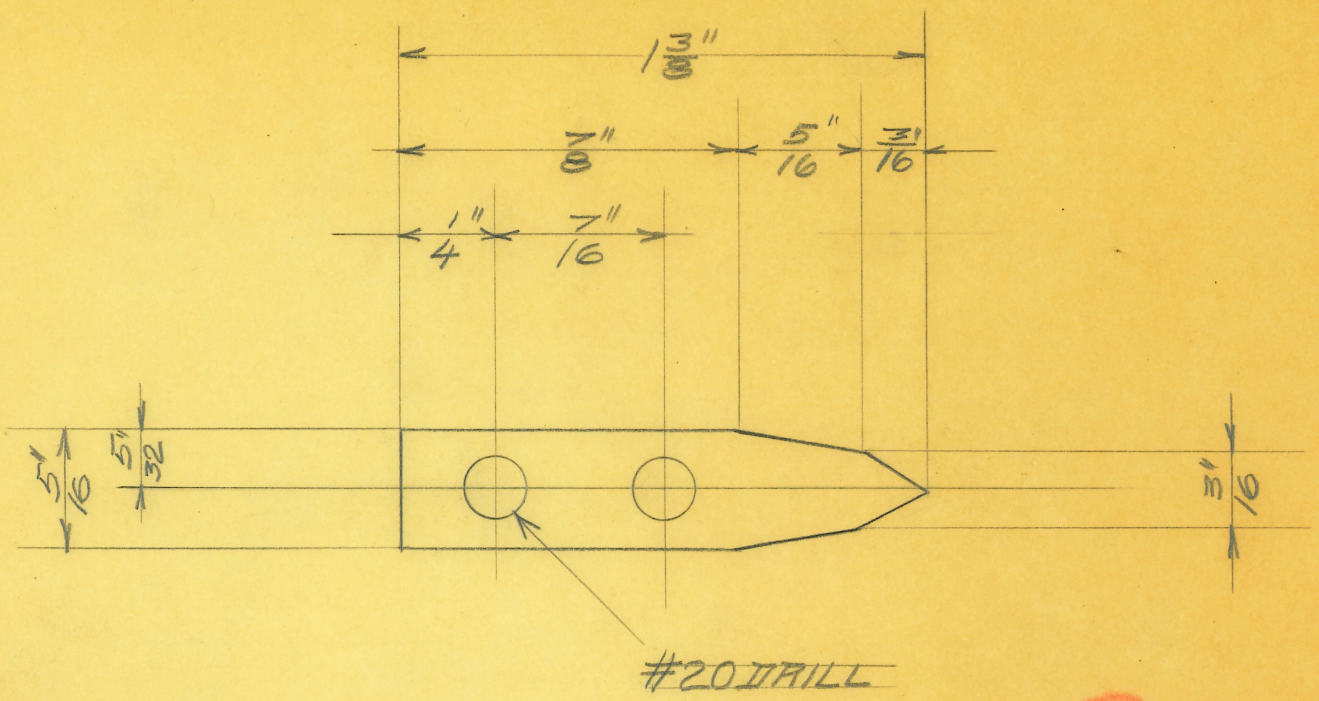

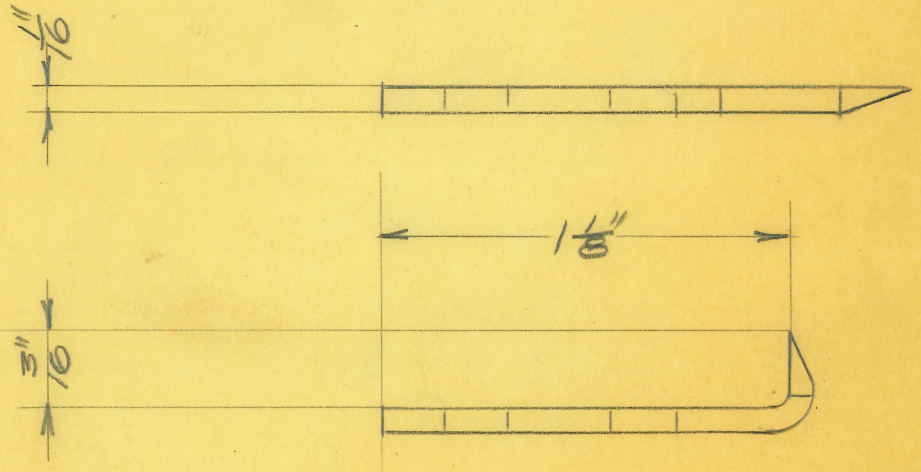

OBSOLETE

(1)

SIZE		ISSUE 9-7-26	CF
KIND	BRASS	CHANGED	
SHAPE		" "	
FINISH	N.P.	" "	
TEMP.		" "	
PATT.		" "	

TITLE: WAVE-GENERATOR RHEOSTAT POINTER

H. G. FISCHER & CO.
2335 WABANSIA AVE.
CHICAGO, ILL.

CAT. NO.

PART NO. 5397

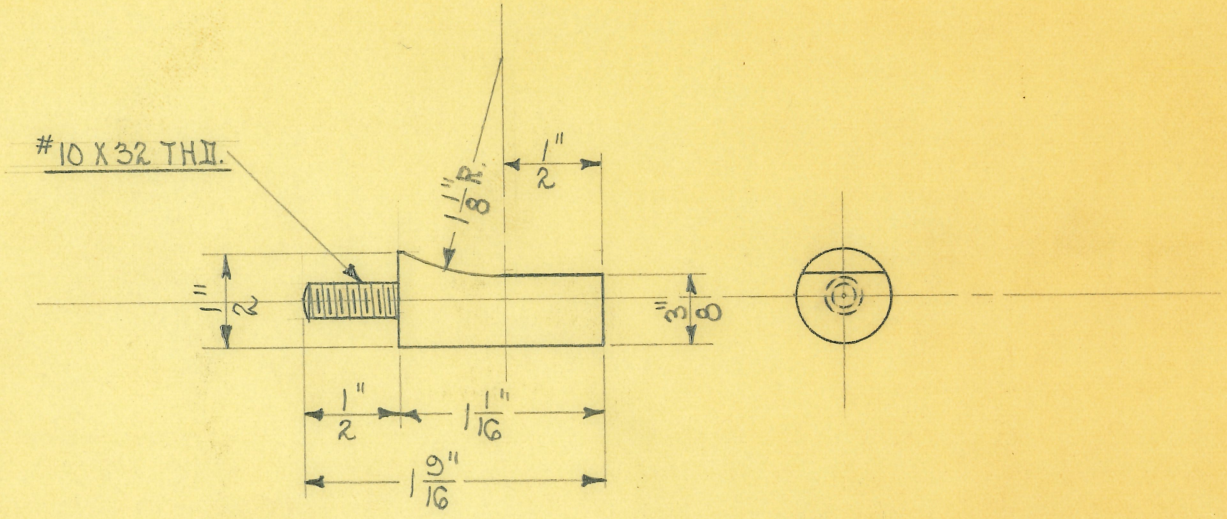

SCALE ~ FULL SIZE

OBSOLETE

SIZE	1/2"	ISSUE 1-13-32	A.E.	**TITLE:** WAVE GEN. POINTER SUPPORT STOP	
KIND	DRILL ROD	CHANGED			
SHAPE		" "			
FINISH	W.P.	" "			
TEMP.		" "		H. G. FISCHER & CO. 2335 WABANSIA AVE. CHICAGO, ILL.	CAT. NO.
PATT.		" "			PART NO. 5398A

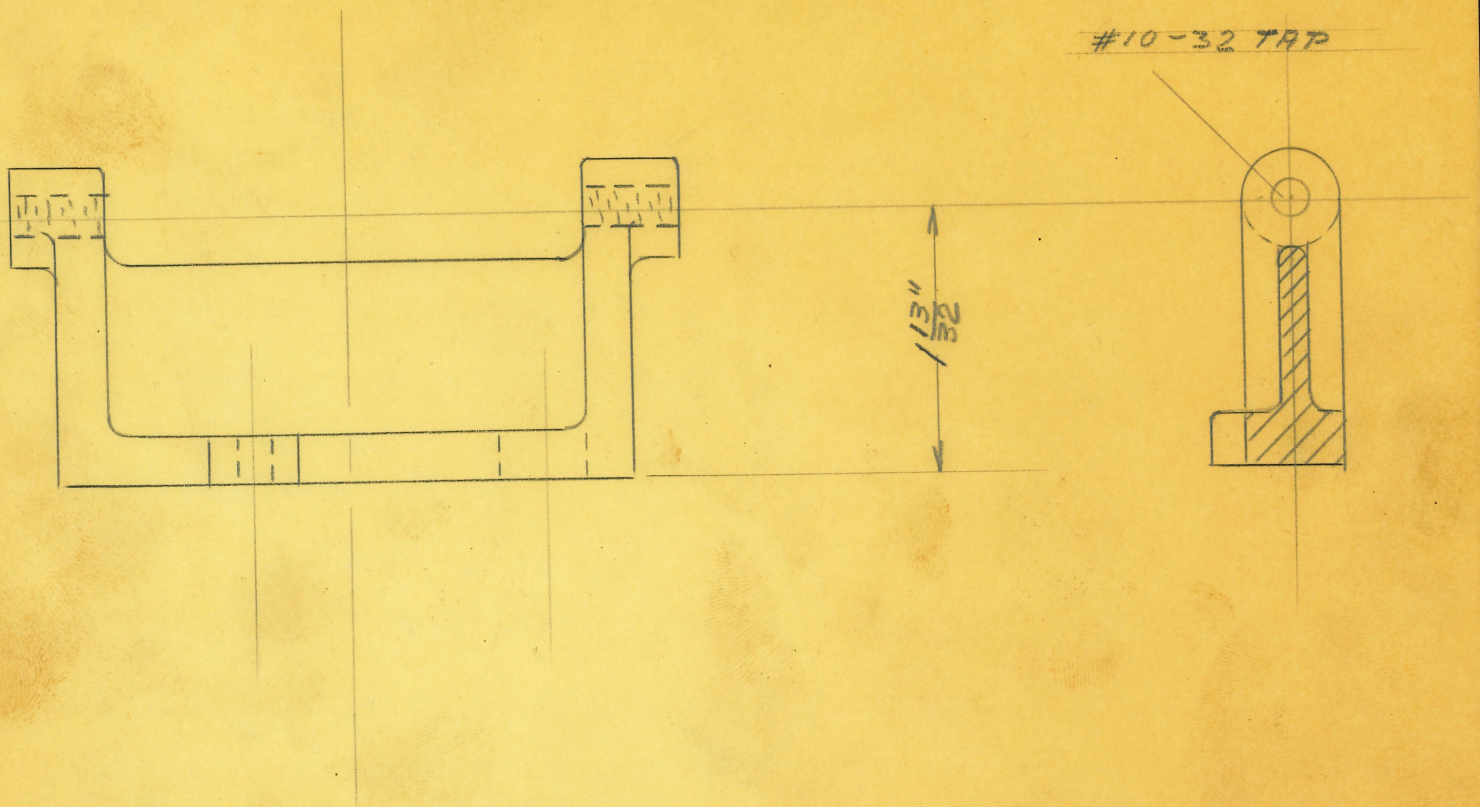

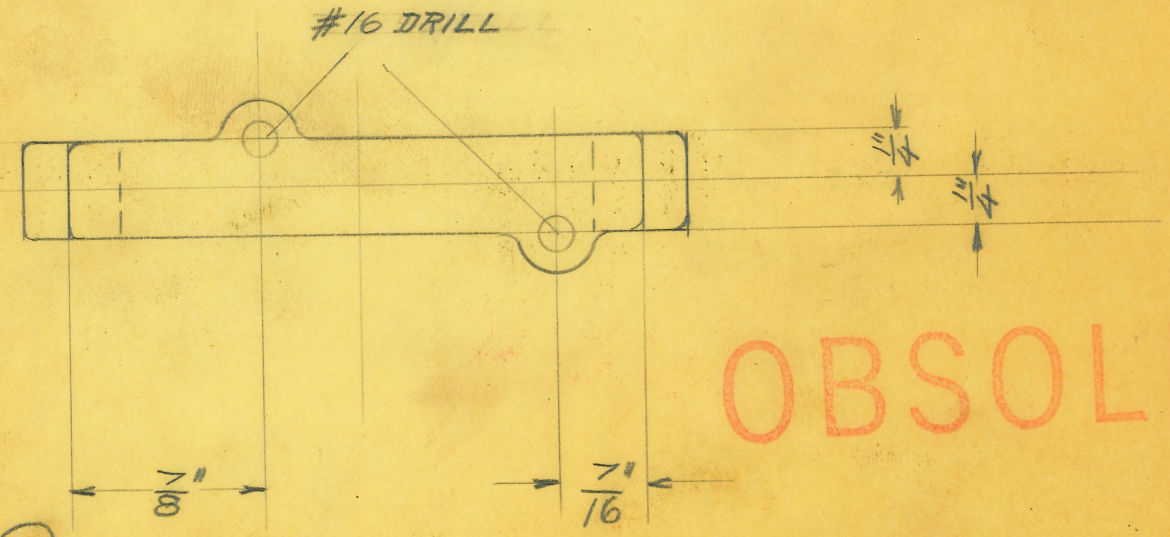

OBSOLETE

(1)

SIZE		ISSUE 7-8-26	E.	TITLE: POINTER SUPPORT STOP WAVE-GENERATOR	
KIND	BRASS	CHANGED			
SHAPE		" "			
FINISH		" "			
TEMP.		" "		H. G. FISCHER & CO. 2335 WABANSIA AVE. CHICAGO, ILL.	CAT. NO.
PATT.		" "			PART NO. 5398F

NOTE:
DRAWN DOUBLE SCALE

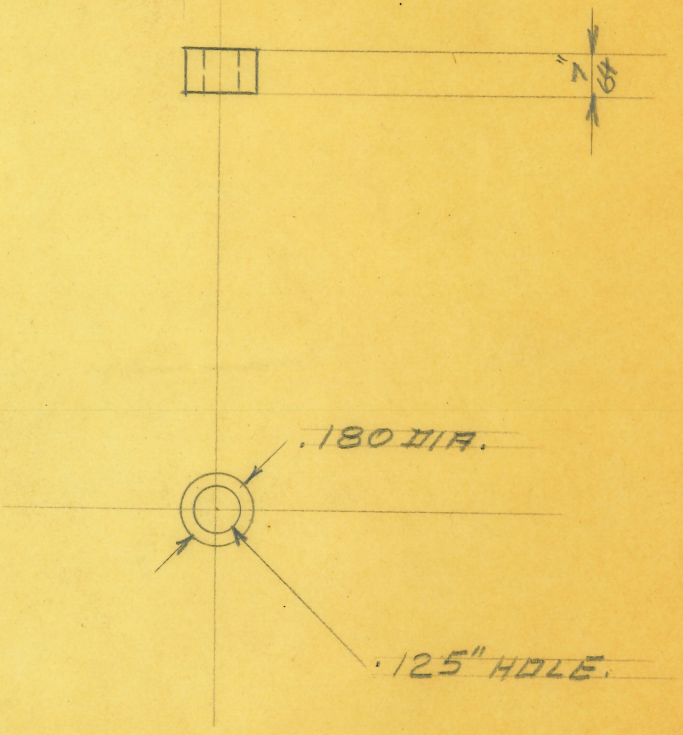

OBSOLETE

(2)

SIZE		ISSUE 9-7-26	ET.
KIND	RUBBER	CHANGED	
SHAPE		" "	
FINISH		" "	
TEMP.		" "	
PATT.		" "	

TITLE:
WAVE-GENERATOR
POINTER INSULATING RING

H. G. FISCHER & CO.
2335 WABANSIA AVE.
CHICAGO, ILL.

CAT. NO.

PART NO. 5399

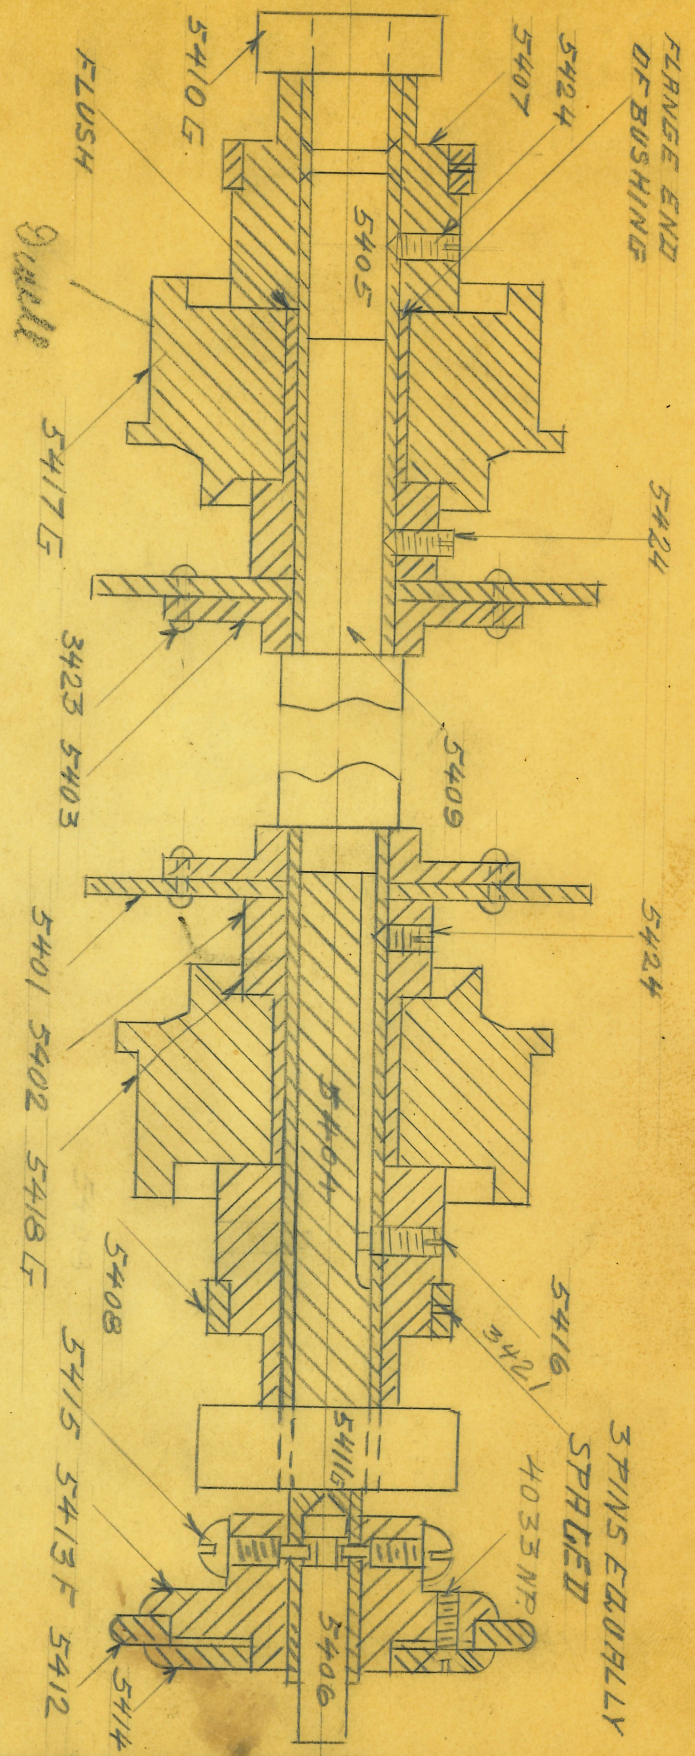

OBSOLETE

SIZE		ISSUE 7-22-26	Q.	TITLE: ASSEMBLY OF AUTOMATIC RHEOSTAT WAVE GENERATOR "2"	
KIND		CHANGED			
SHAPE		" "			
FINISH		" "			
TEMP.		" "		H. G. FISCHER & CO. 2335 WABANSIA AVE. CHICAGO, ILL.	CAT. NO.
PATT.		" "			PART NO. 5400G.

28 SLOTS ON HALF ON THE CIRCUMFERENCE

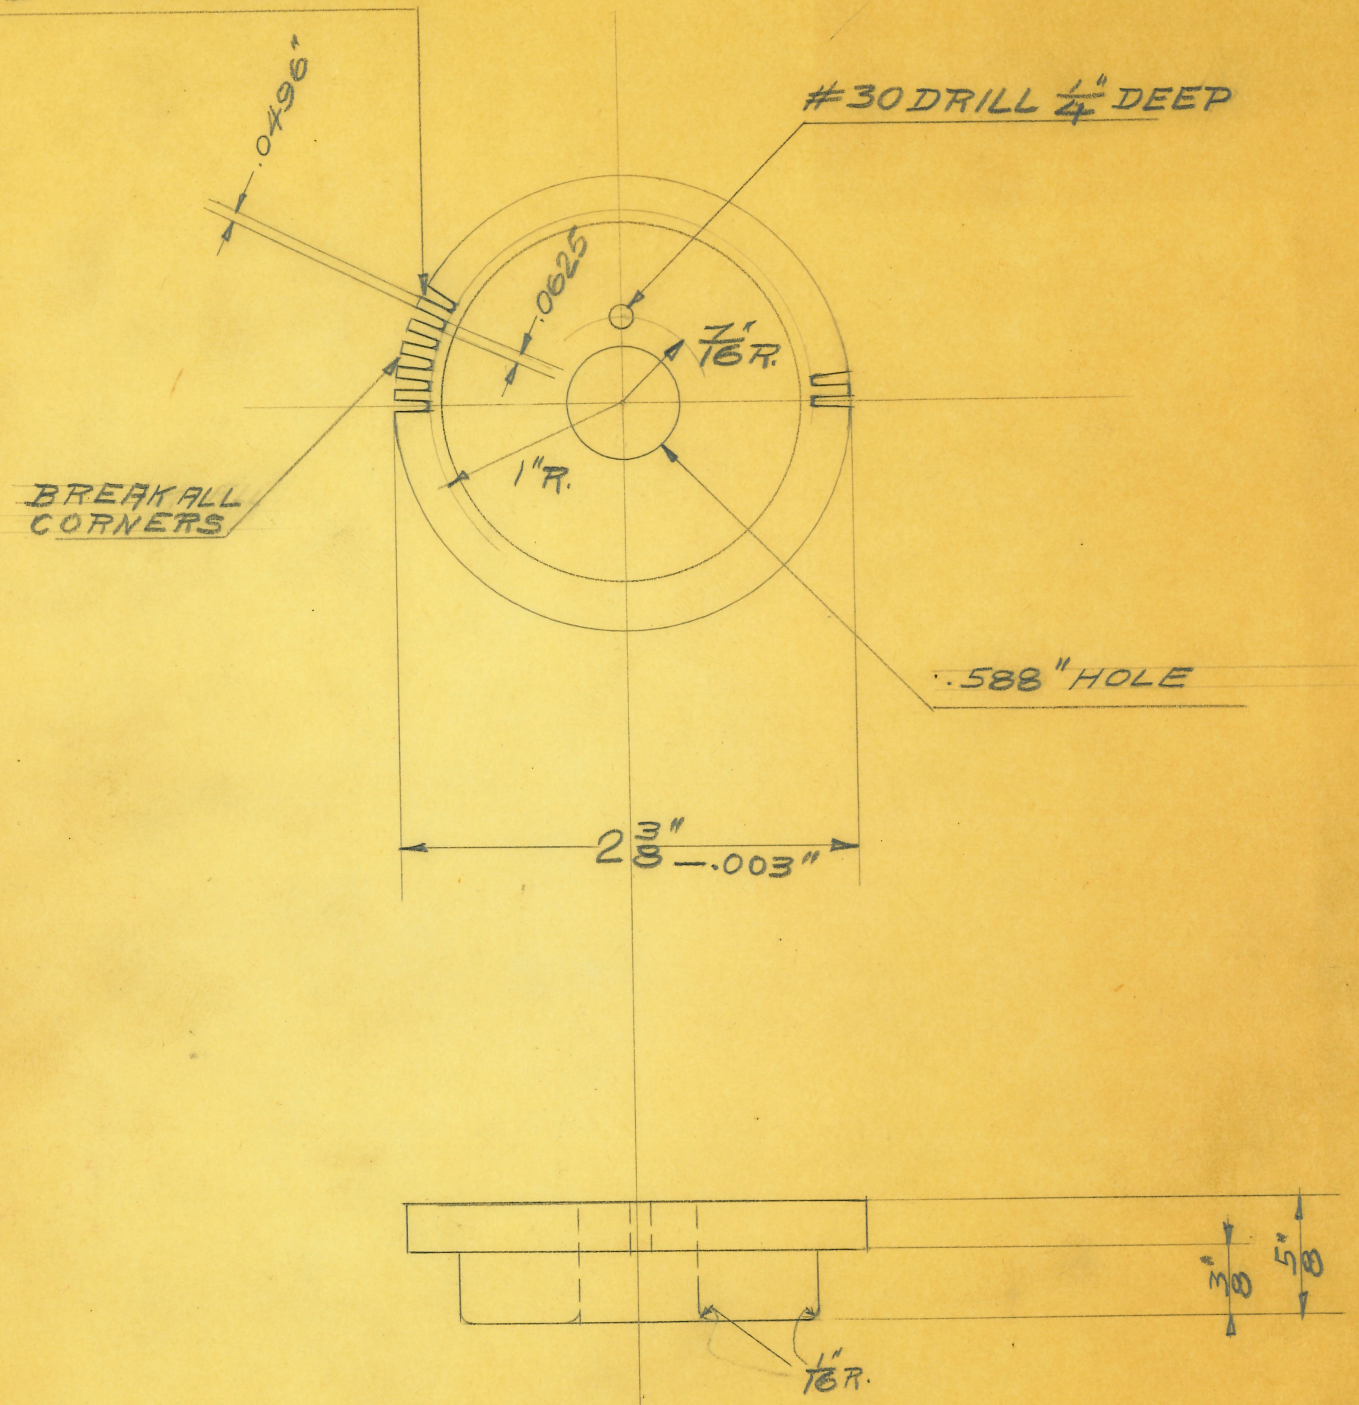

OBSOLETE

SIZE		ISSUE 11-26-26	ejp
KIND	BAKELITE	CHANGED	
SHAPE		" "	
FINISH		" "	
TEMP.		" "	
PATT.		" "	

TITLE:
WAVE-GENERATOR
WIRE SUPPORT

H. G. FISCHER & CO.
2335 WABANSIA AVE.
CHICAGO, ILL.

CAT. NO.

PART NO. 5401 A.

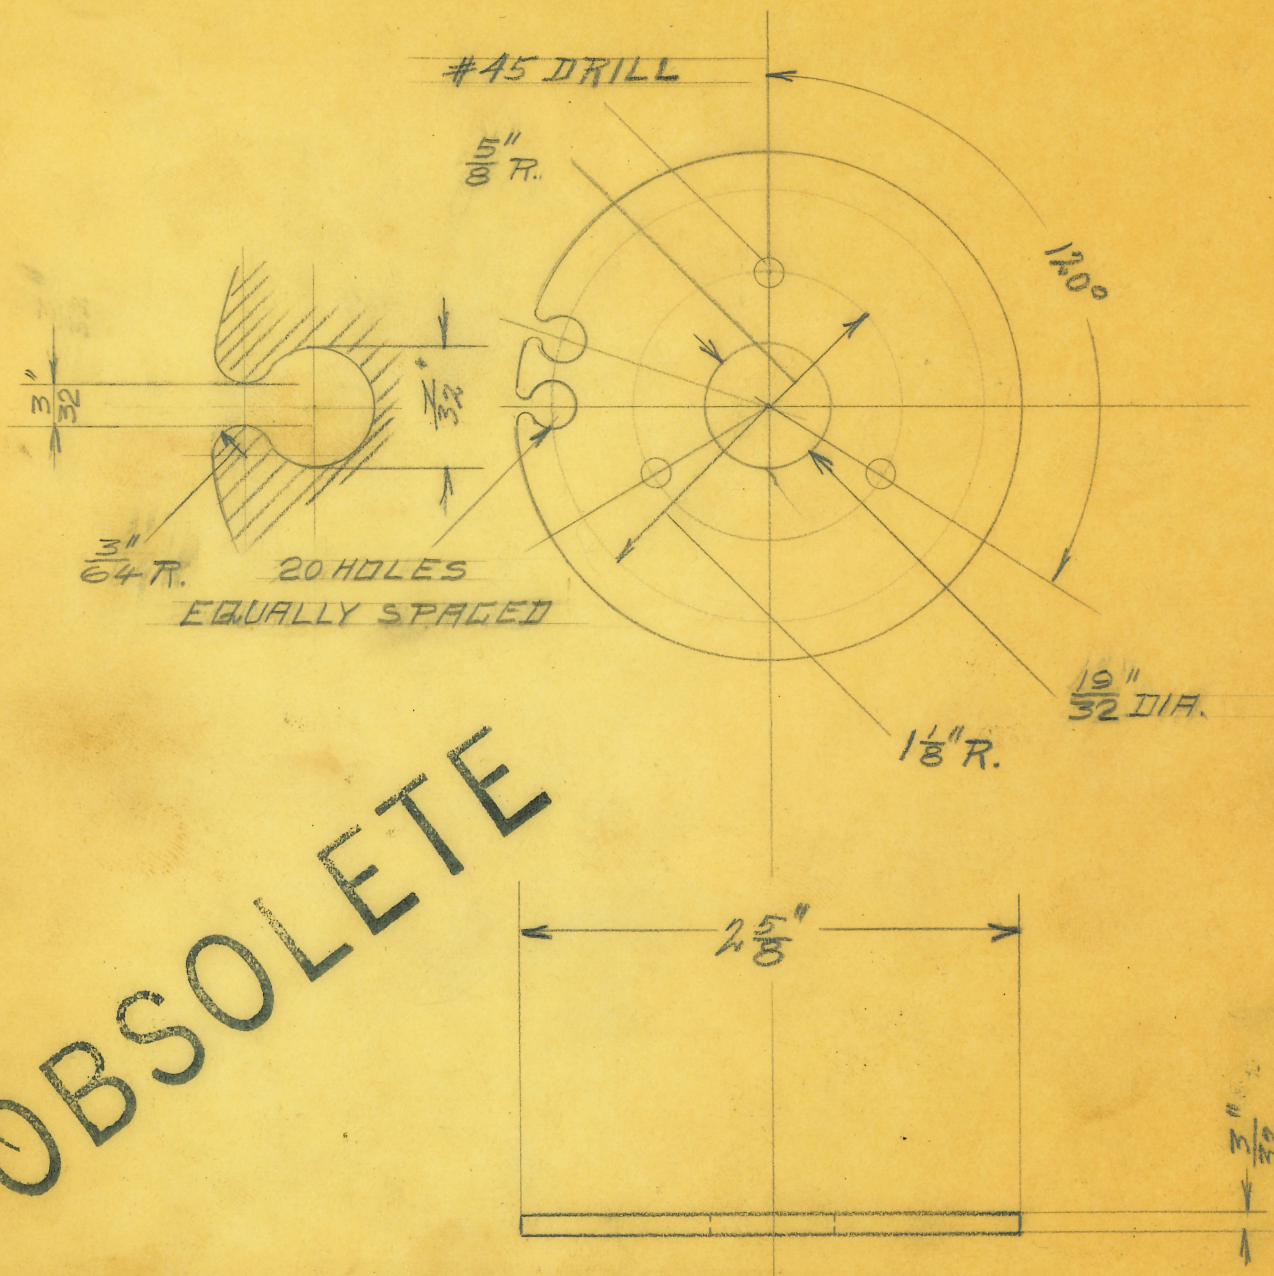

OBSOLETE

(2)

SIZE		ISSUE 4-9-26	L
KIND	FIBRE	CHANGED	
SHAPE		" "	
FINISH		" "	
TEMP.		" "	
PATT.		" "	

TITLE: WIRE SUPPORT
FOR AUTOMATIC RHEOSTAT

H. G. FISCHER & CO.
2335 WABANSIA AVE.
CHICAGO, ILL.

CAT. NO.

PART NO. 5401.

BREAK ALL CORNERS

28 SLOTS ON HALF OF THE CIRCUMFERENCE

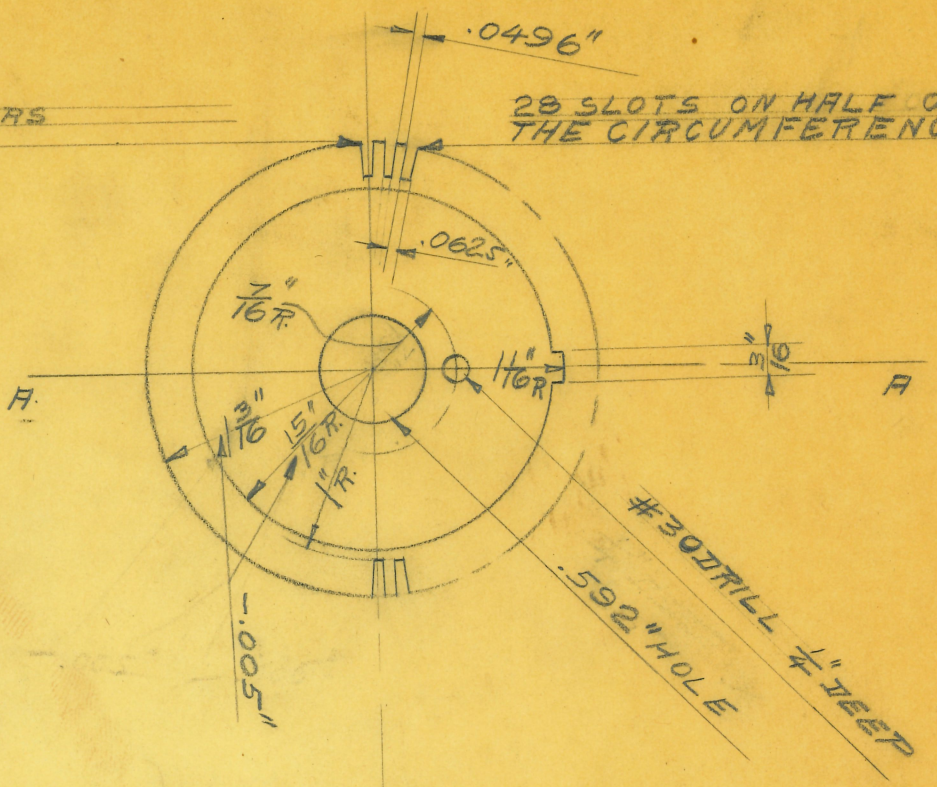

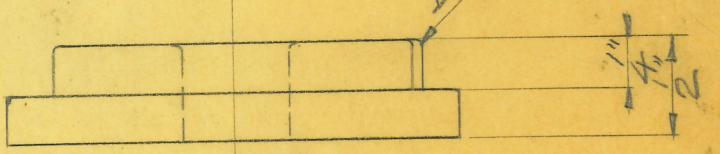

SECTION A-A.

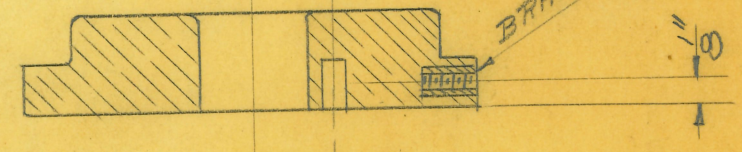

OBSOLETE

SIZE		ISSUE 11-26-26	EP	TITLE: WAVE-GENERATOR WIRE SUPPORT	
KIND	BAKELITE	CHANGED			
SHAPE		" "12-14-26	EP		
FINISH		" "			
TEMP.		" "		H. G. FISCHER & CO. 2335 WABANSIA AVE. CHICAGO, ILL.	CAT. NO.
PATT.		" "			PART NO. 5401A

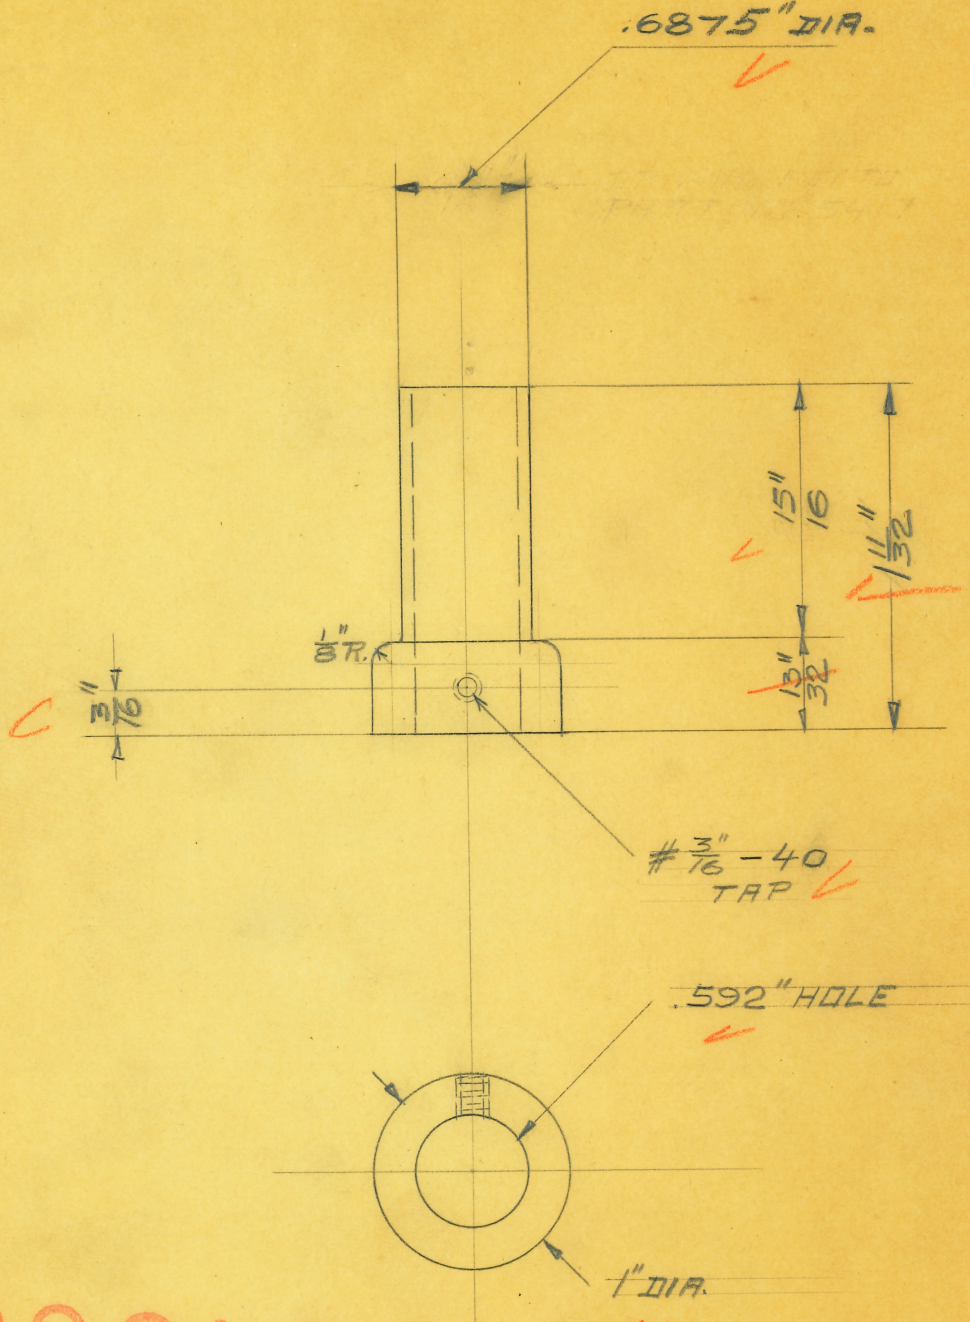

OBSOLETE

(2)

SIZE		ISSUE 9-11-26	OP.
KIND	BRASS	CHANGED	
SHAPE		" "11-26-26	OP.
FINISH	W.P.	" "	
TEMP.		" "	
PATT.		" "	

TITLE: WAVE-GENERATOR AUTOM. RHEOST. BUSHING

H. G. FISCHER & CO.
2335 WABANSIA AVE.
CHICAGO, ILL.

CAT. NO.

PART NO. 5402A

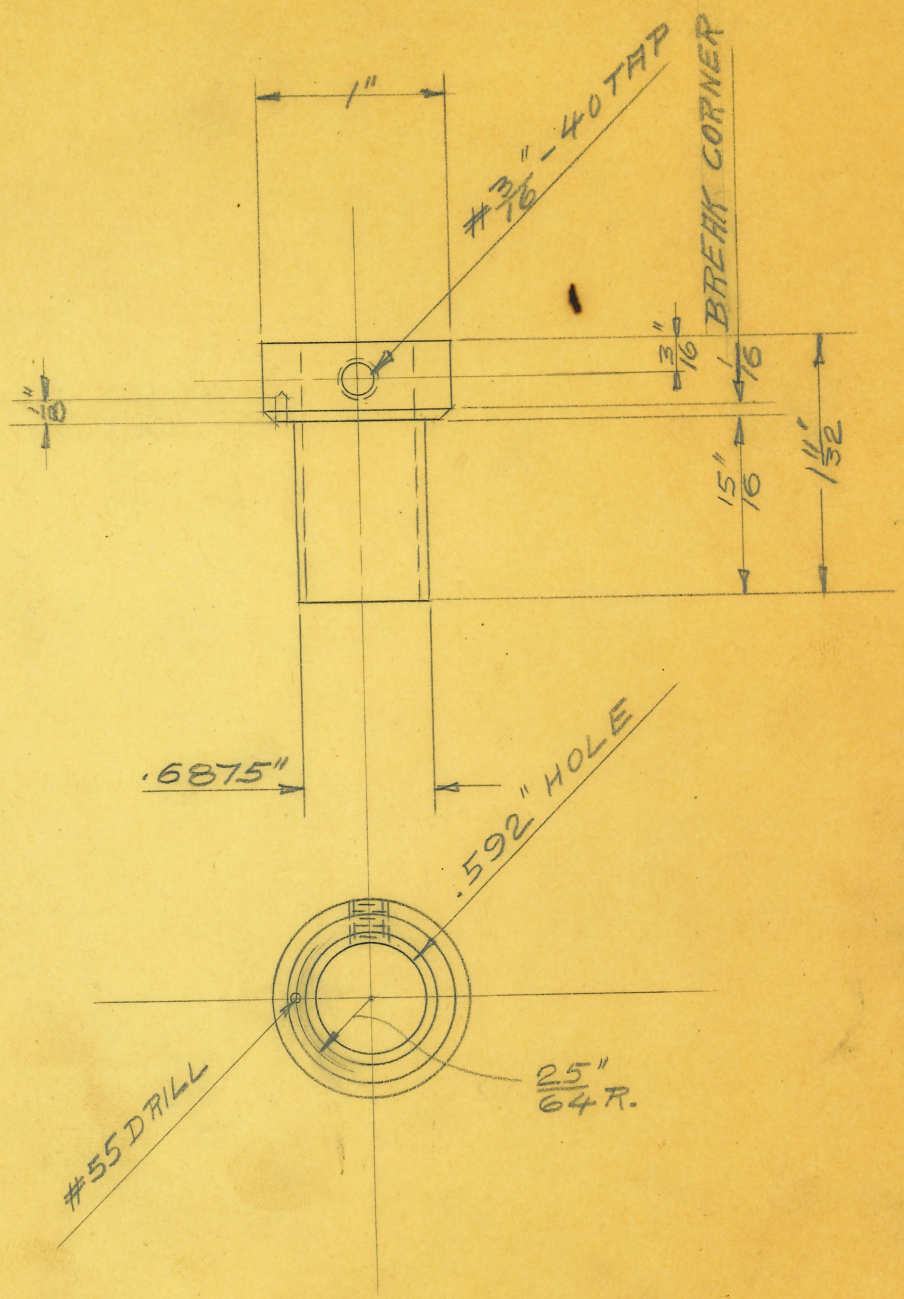

OBSOLETE

2

SIZE		ISSUE 9-12-26	EP	TITLE: WAVE-GENERATOR AUTOM. RHEOST-BUSHING
KIND	BRASS	CHANGED		
SHAPE		" "12-7-26	EP	
FINISH	W.P.	" "		
TEMP.		" "		H. G. FISCHER & CO. 2335 WABANSIA AVE. CHICAGO, ILL. — CAT. NO. — PART NO. 5402 A
PATT.		" "		

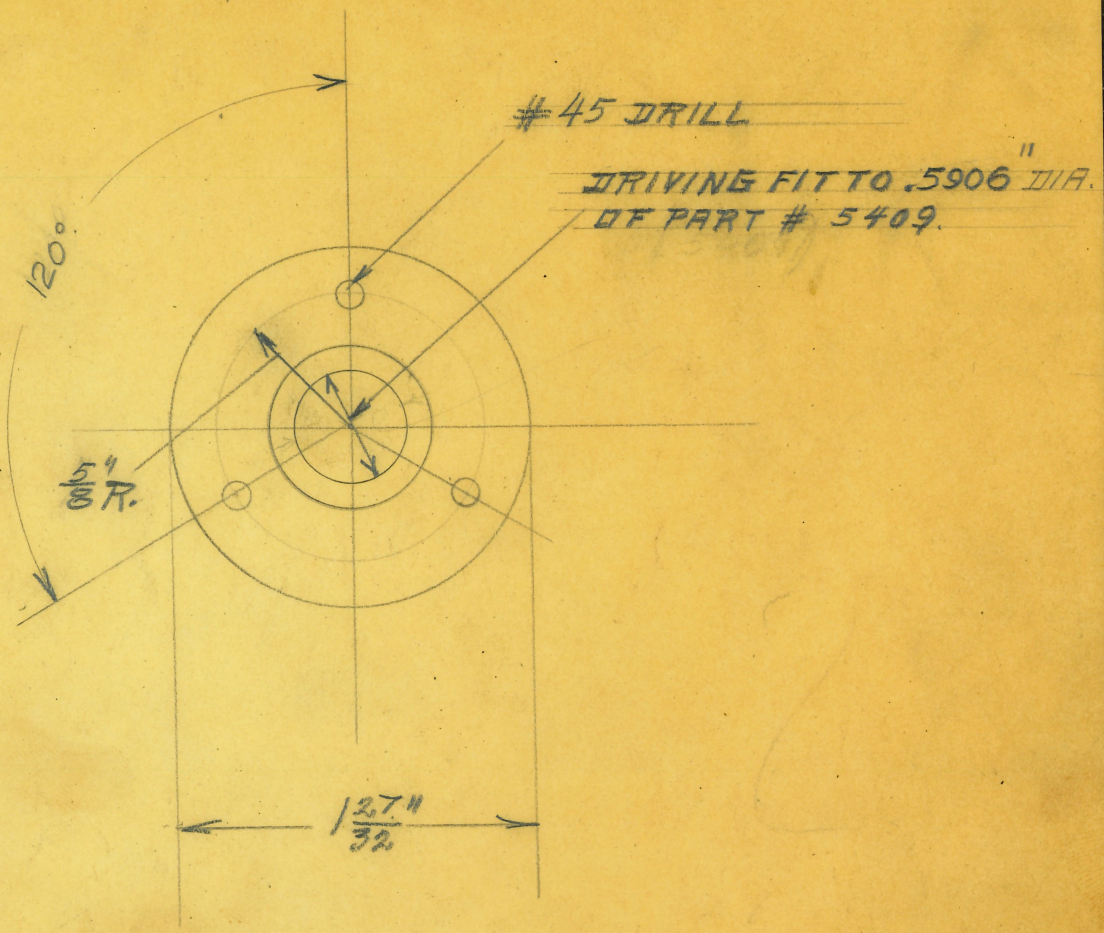

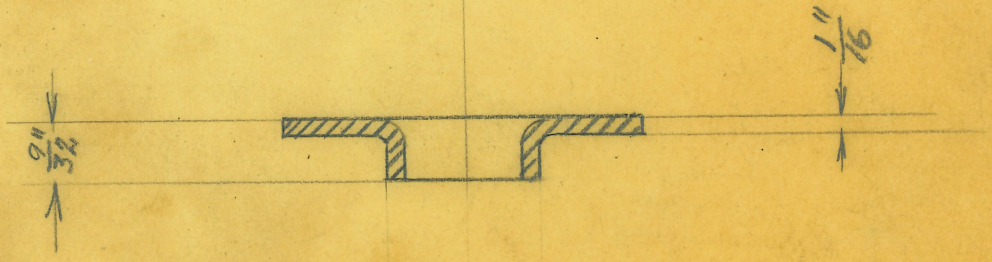

OBSOLETE

(2)

SIZE		ISSUE 4-9-26	L.	TITLE: SPACER FOR WIRE SUPPORT	
KIND	STEEL	CHANGED		H AUTOMATIC RHEOSTAT (W-G)	
SHAPE		" "			
FINISH		" "			
TEMP.		" "			
PATT.		" "			

H. G. FISCHER & CO.
2335 WABANSIA AVE.
CHICAGO, ILL.

CAT. NO.

PART NO. 5403.

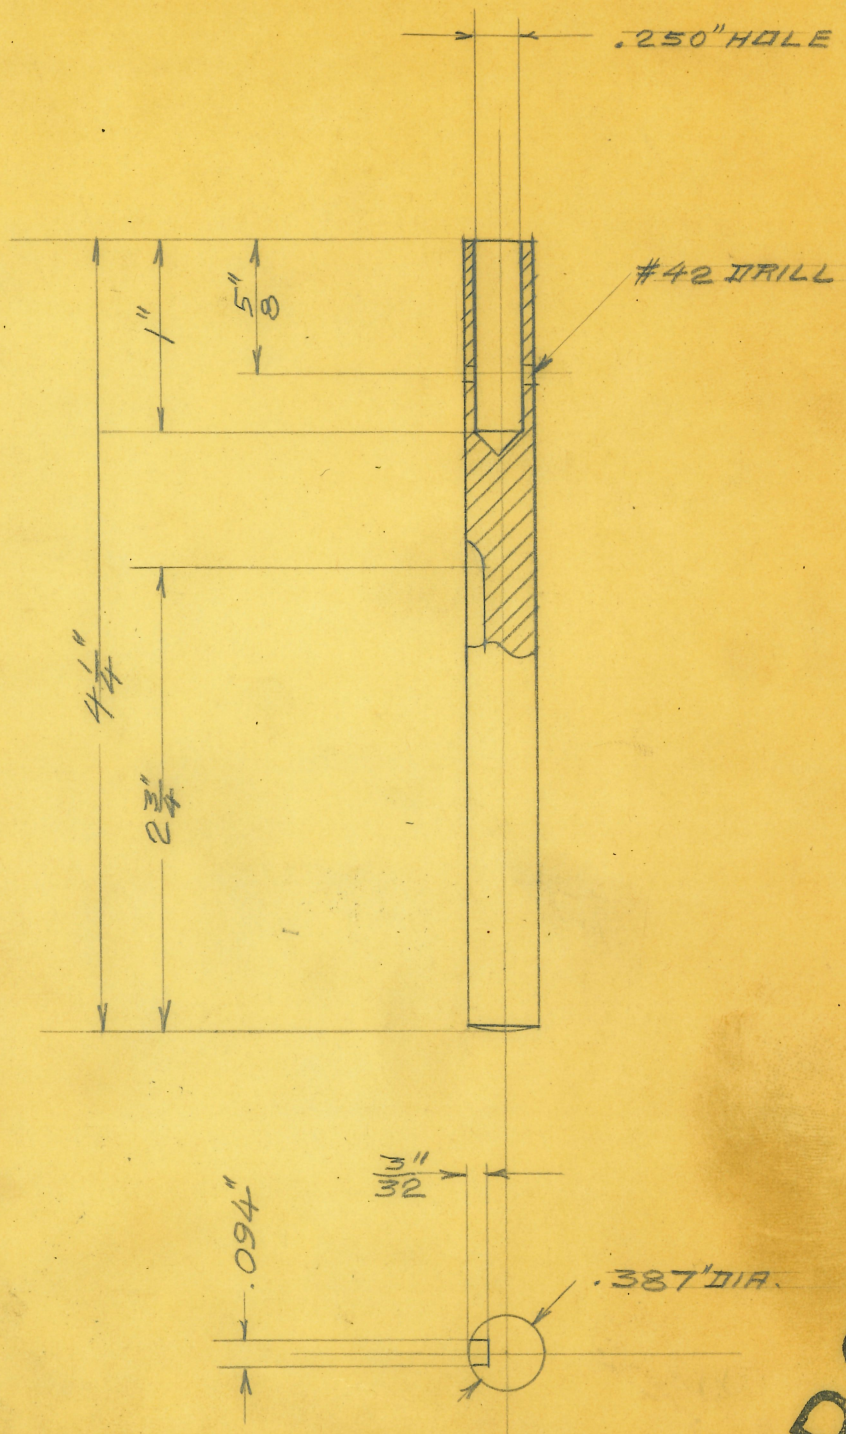

OBSOLETE

(1)

SIZE		ISSUE 9-11-26	C.P.
KIND	C.R.STEEL	CHANGED	
SHAPE		" "	
FINISH		" "	
TEMP.		" "	
PATT.		" "	

TITLE: WAV-GENERATOR
AUTOM. RHEOST. COUPLING

H. G. FISCHER & CO.
2335 WABANSIA AVE.
CHICAGO, ILL.

CAT. NO.

PART NO. 5404.

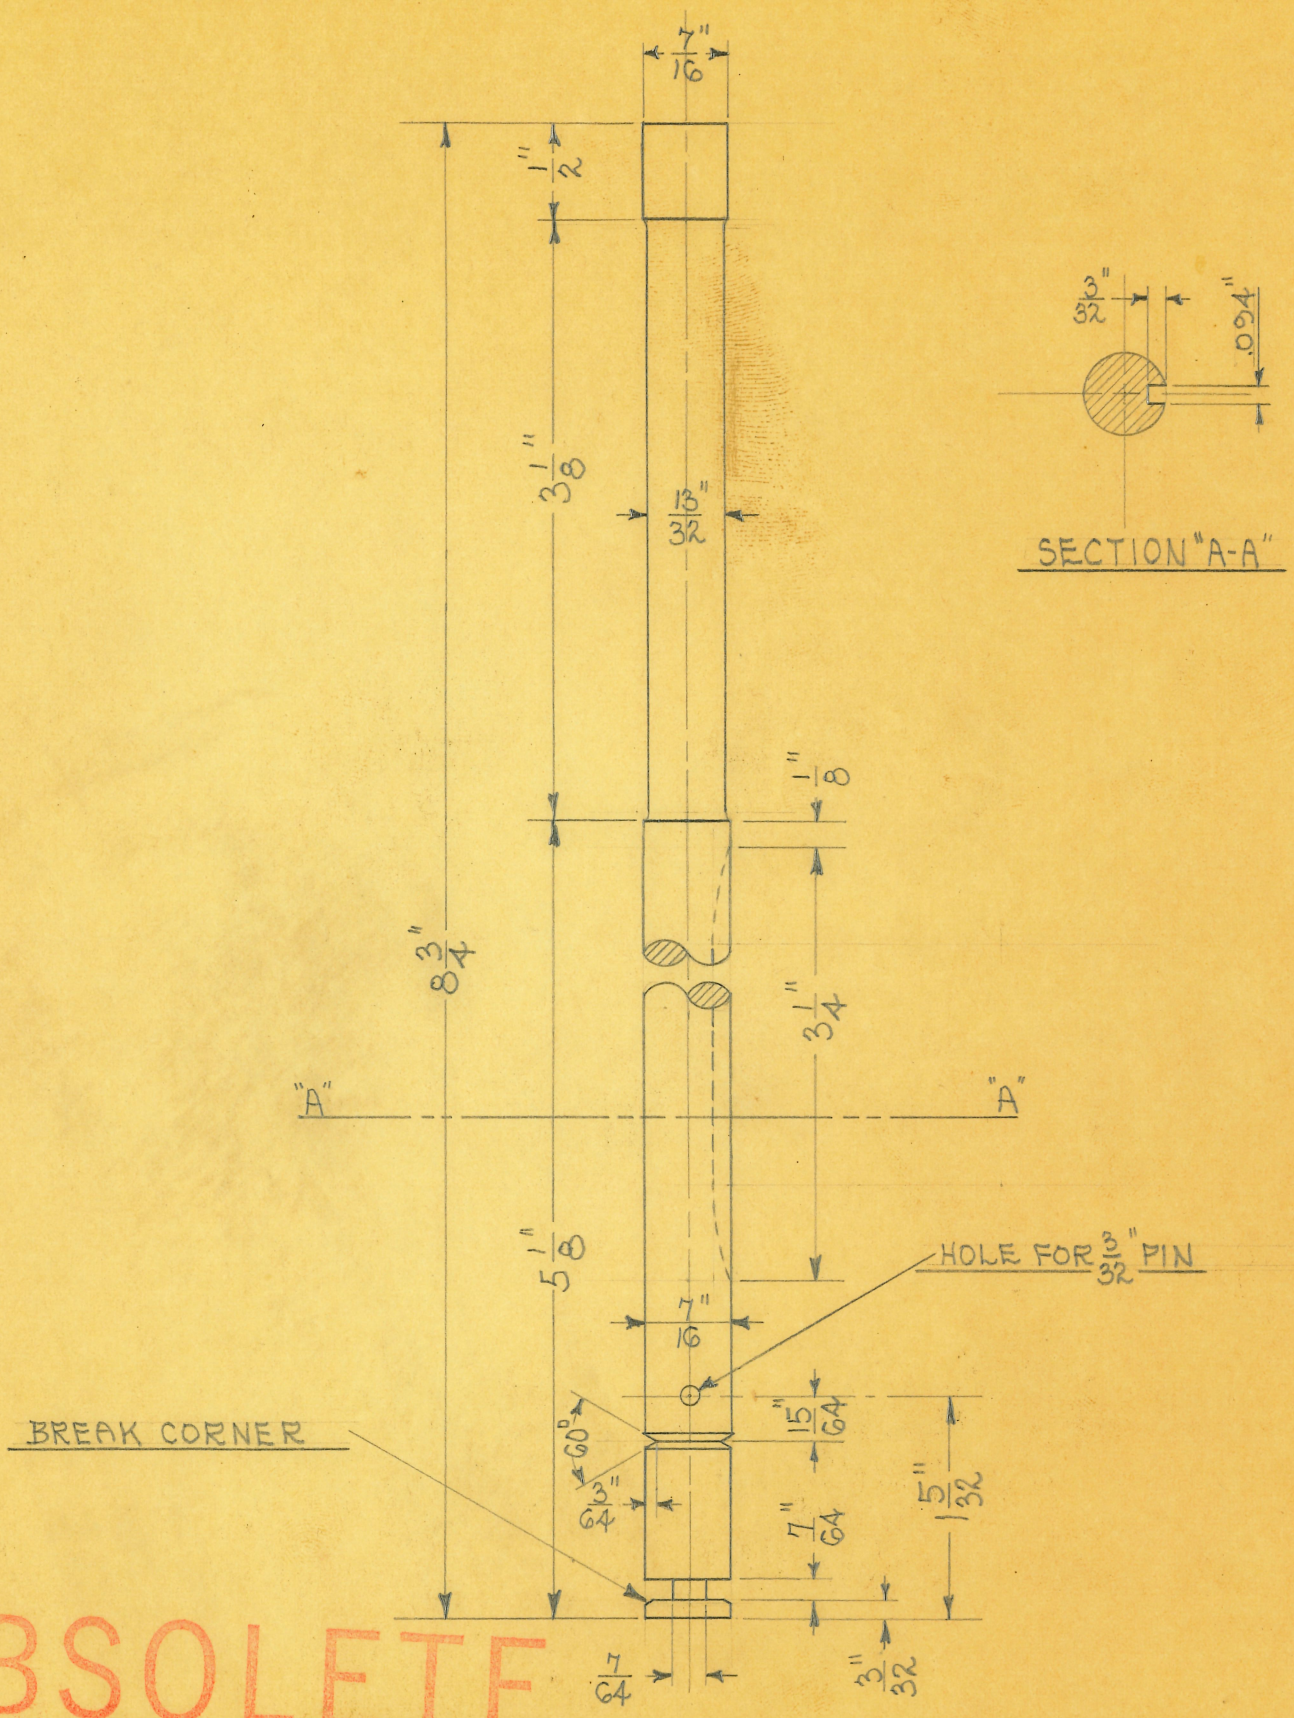

OBSOLETE

SIZE	7/16"	ISSUE 9-1-31	A/E.
KIND	DRILL ROD	CHANGED	
SHAPE		" "	
FINISH	CASE HARDEN	" "	
TEMP.		" "	
PATT.		" "	

TITLE: WAVE GEN. LEATHER RING SUPP. COUPLING

H. G. FISCHER & CO.
2335 WABANSIA AVE.
CHICAGO, ILL.

CAT. NO.

PART NO. 5404A

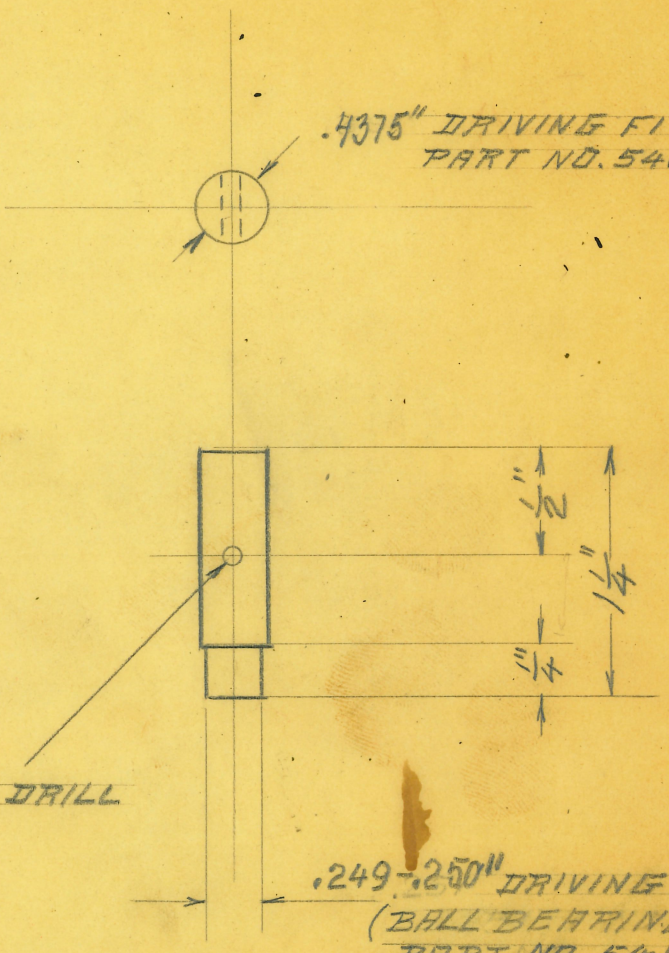

OBSOLETE

(1)

SIZE		ISSUE 7-30-26	(2)	TITLE: PLUG FOR AUTOMATIC RHEOSTAT WAVE-GENERATOR
KIND	C.R. STEEL	CHANGED		
SHAPE		" "		
FINISH		" "		
TEMP.		" "		
PATT.		" "		

H. G. FISCHER & CO.
2335 WABANSIA AVE.
CHICAGO, ILL.

CAT. NO.

PART NO. 5405

NOTE:
DRAWN DOUBLE SCALE

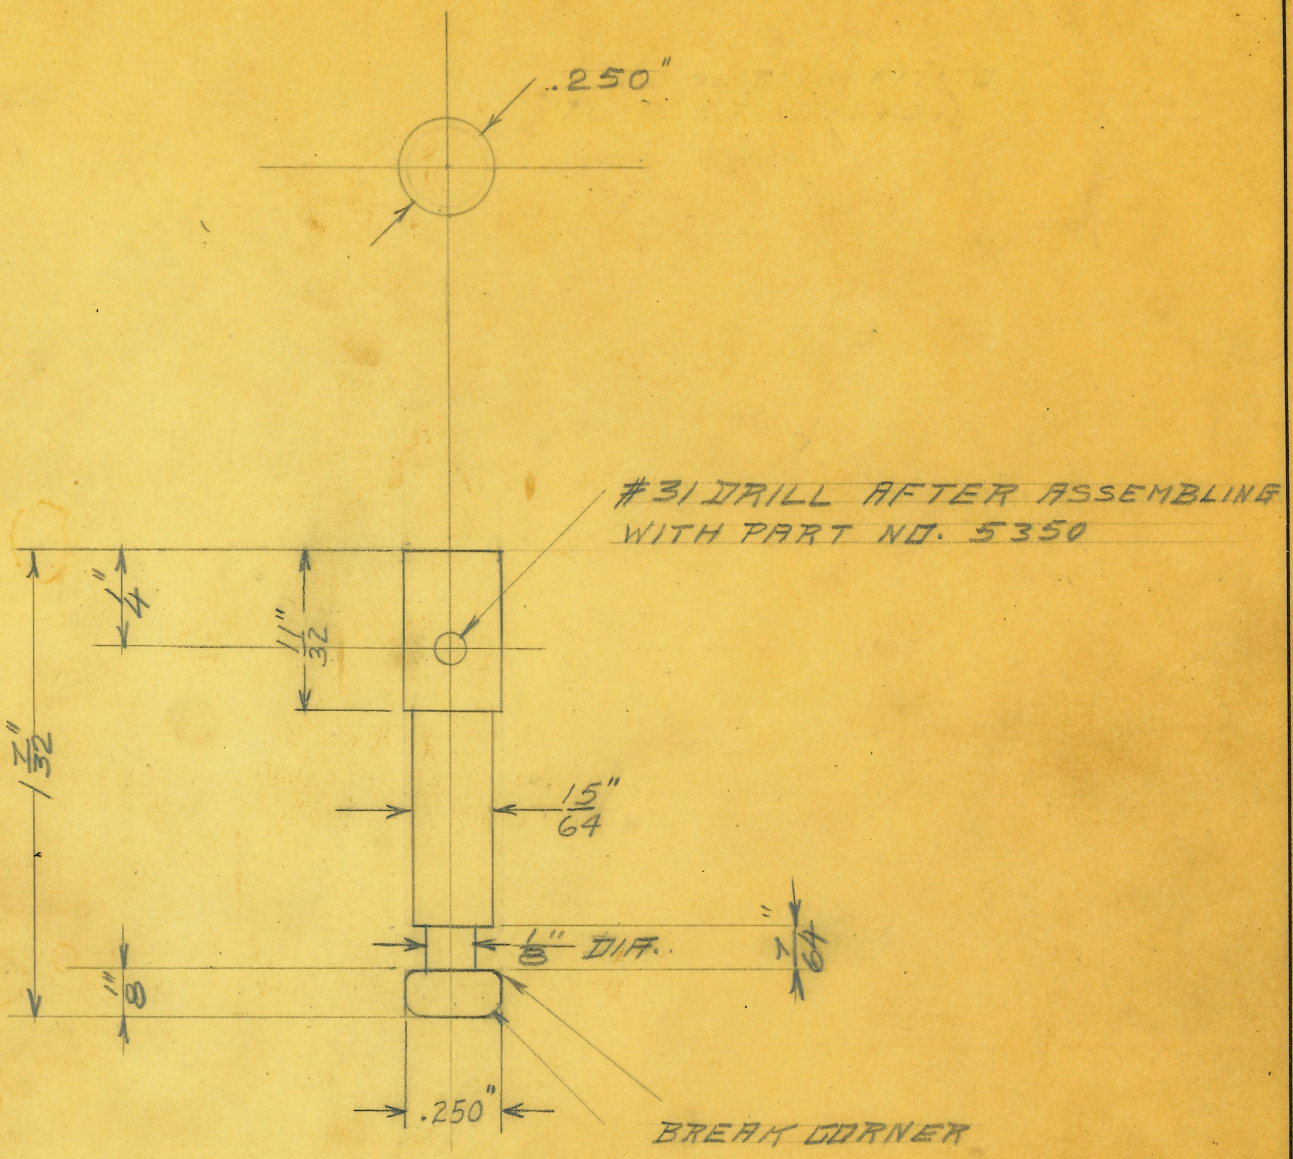

OBSOLETE

(1)

SIZE		ISSUE 9-7-26	GP
KIND	HARDENED TOOL STEEL	CHANGED	
SHAPE		" "	
FINISH		" "	
TEMP.		" "	
PATT.		" "	

TITLE:
WAVE-GENERATOR
PIN FOR AUTOMATIC RHEOSTAT.

H. G. FISCHER & CO.
2335 WABANSIA AVE.
CHICAGO, ILL.

CAT. NO.

PART NO. 5406A

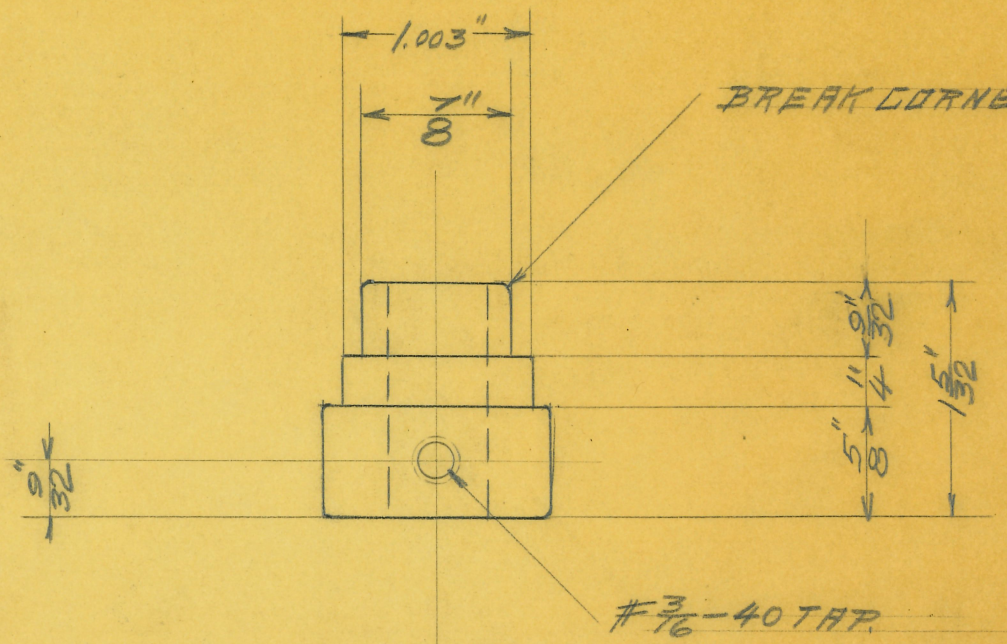

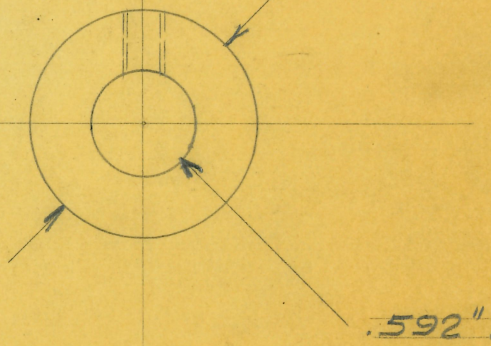

OBSOLETE

(2)

SIZE		ISSUE 9-7-26	DP.	TITLE: WAVE-GENERATOR COLLECTOR RING BUSHING	
KIND	G. FIBRE	CHANGED			
SHAPE		" "			
FINISH		" "			
TEMP.		" "			
PATT.		" "			
				H. G. FISCHER & CO. 2335 WABANSIA AVE. CHICAGO, ILL.	CAT. NO.
					PART NO. 5407

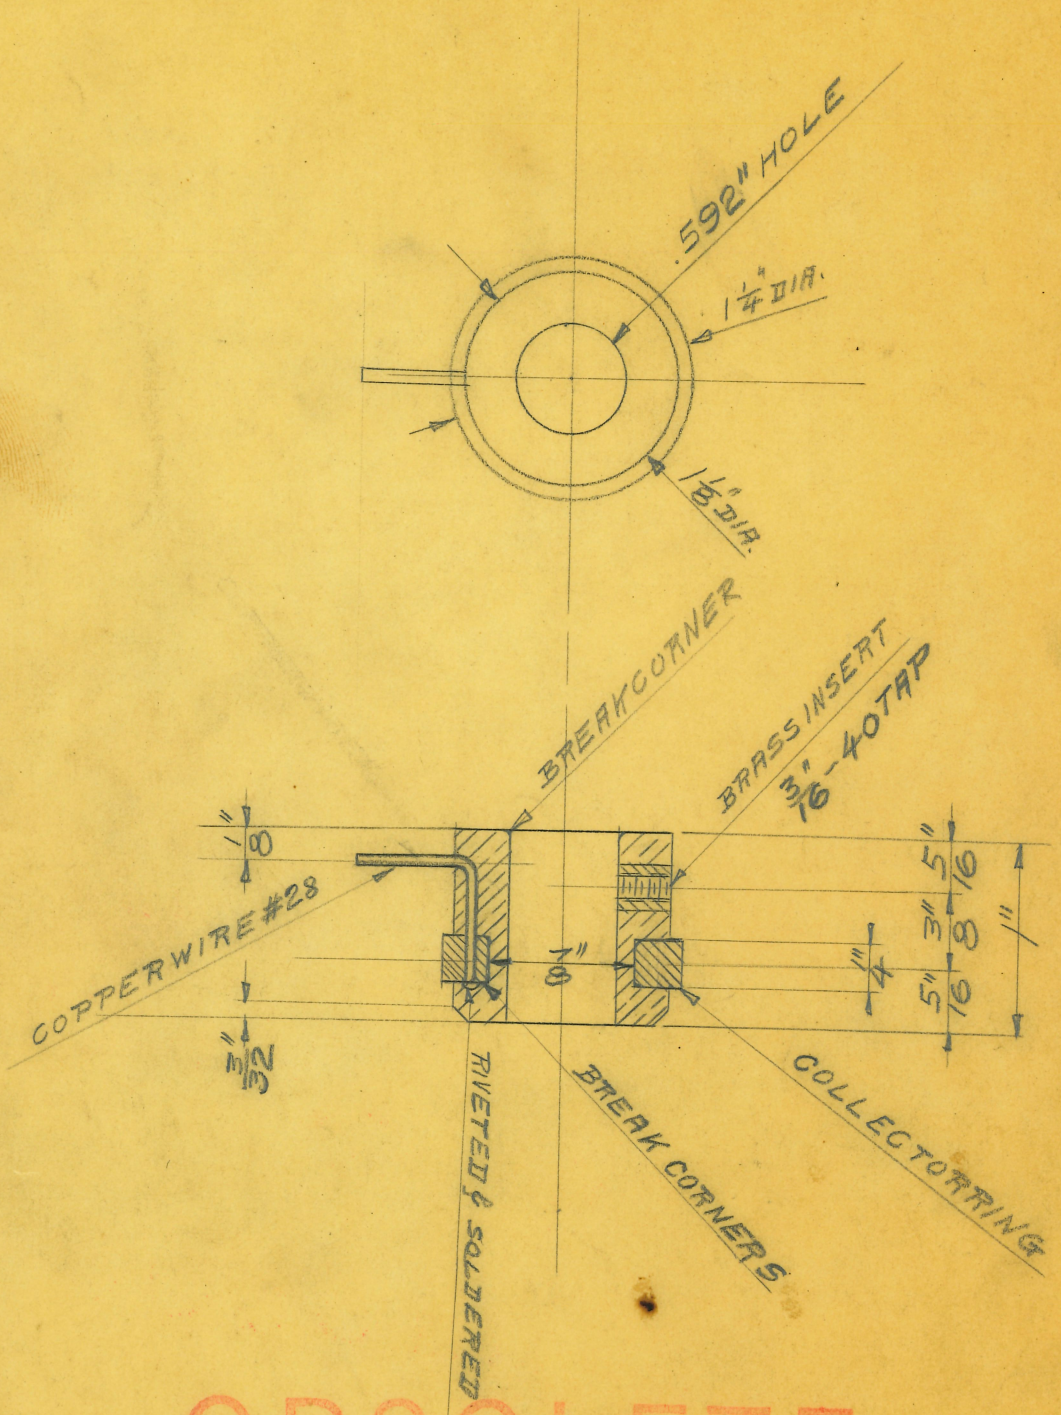

OBSOLETE

SIZE		ISSUE 5-29-26 E.P.	TITLE: WAVE-GENERATOR COLLECTOR RING BUSHING	
KIND	BAKELITE	CHANGED		
SHAPE		" " 12-14-26 E.P.		
FINISH		" "		
TEMP.		" "	H. G. FISCHER & CO. 2335 WABANSIA AVE. CHICAGO, ILL.	CAT. NO.
PATT.		" "		PART NO. 5407A

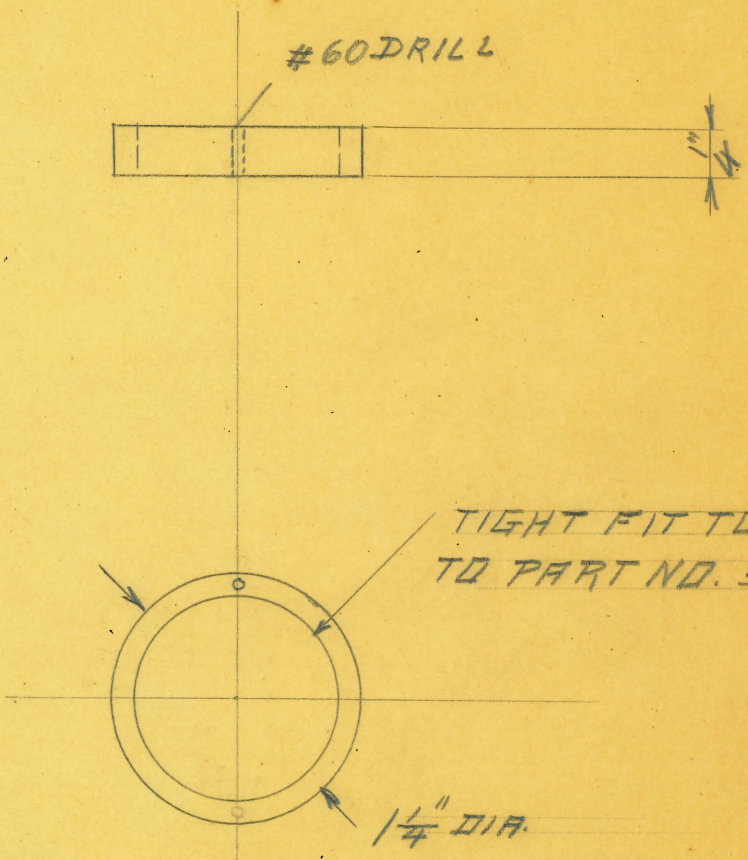

OBSOLETE

(2)

SIZE		ISSUE 9-7-26	EP.
KIND	BRASS	CHANGED	
SHAPE		" "	
FINISH		" "	
TEMP.		" "	
PATT.		" "	

TITLE: WAVE-GENERATOR COLLECTOR RING

H. G. FISCHER & CO.
2335 WABANSIA AVE.
CHICAGO, ILL.

CAT. NO.

PART NO. 5408

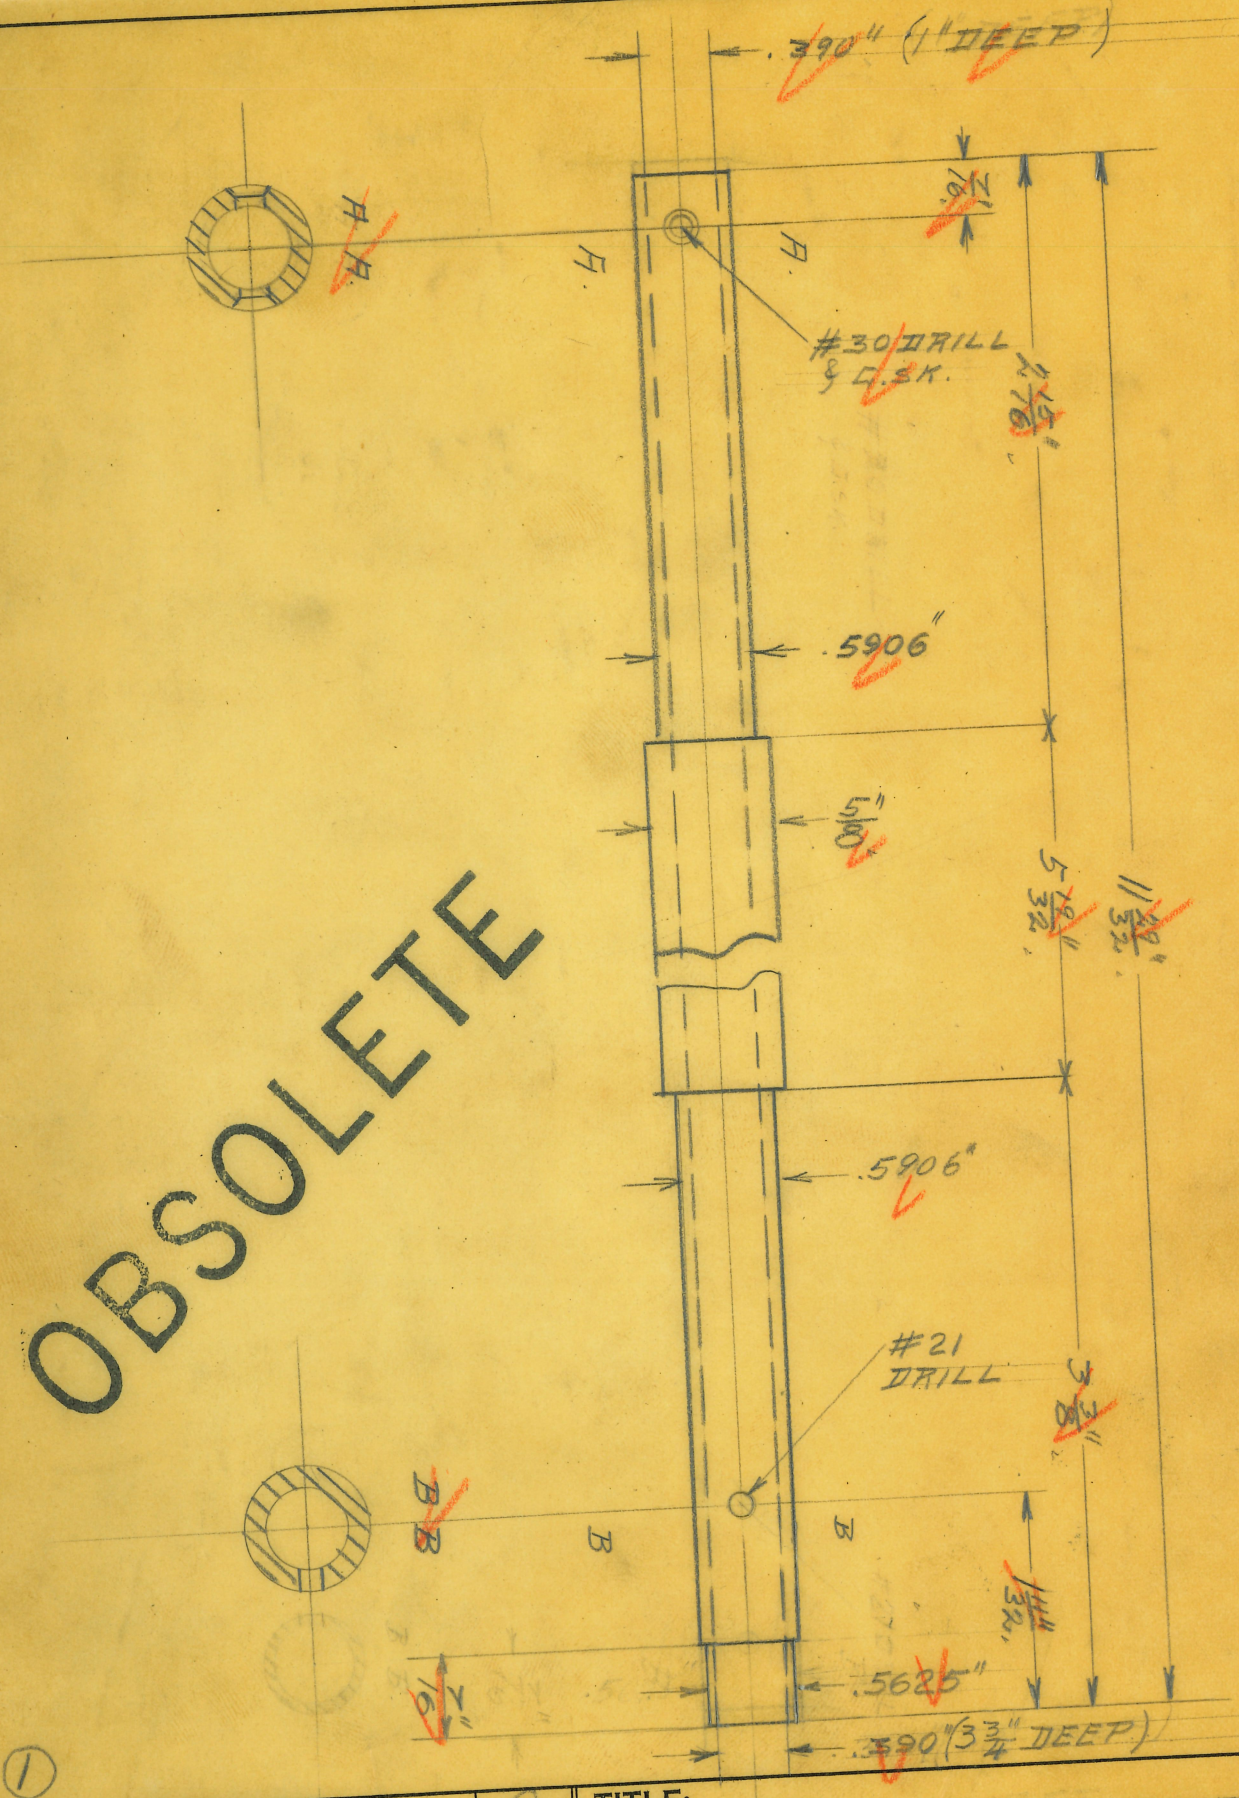

OBSOLETE

(1)

SIZE		ISSUE 5-21-26	
KIND	C.R. STEEL	CHANGED	
SHAPE		" "	
FINISH		" "	
TEMP.		" "	
PATT.		" "	

TITLE: WAVE-GENERATOR AUTOMATIC RHEOSTAT SHAFT

H. G. FISCHER & CO.
2335 WABANSIA AVE.
CHICAGO, ILL.

CAT. NO.

PART NO. 5409

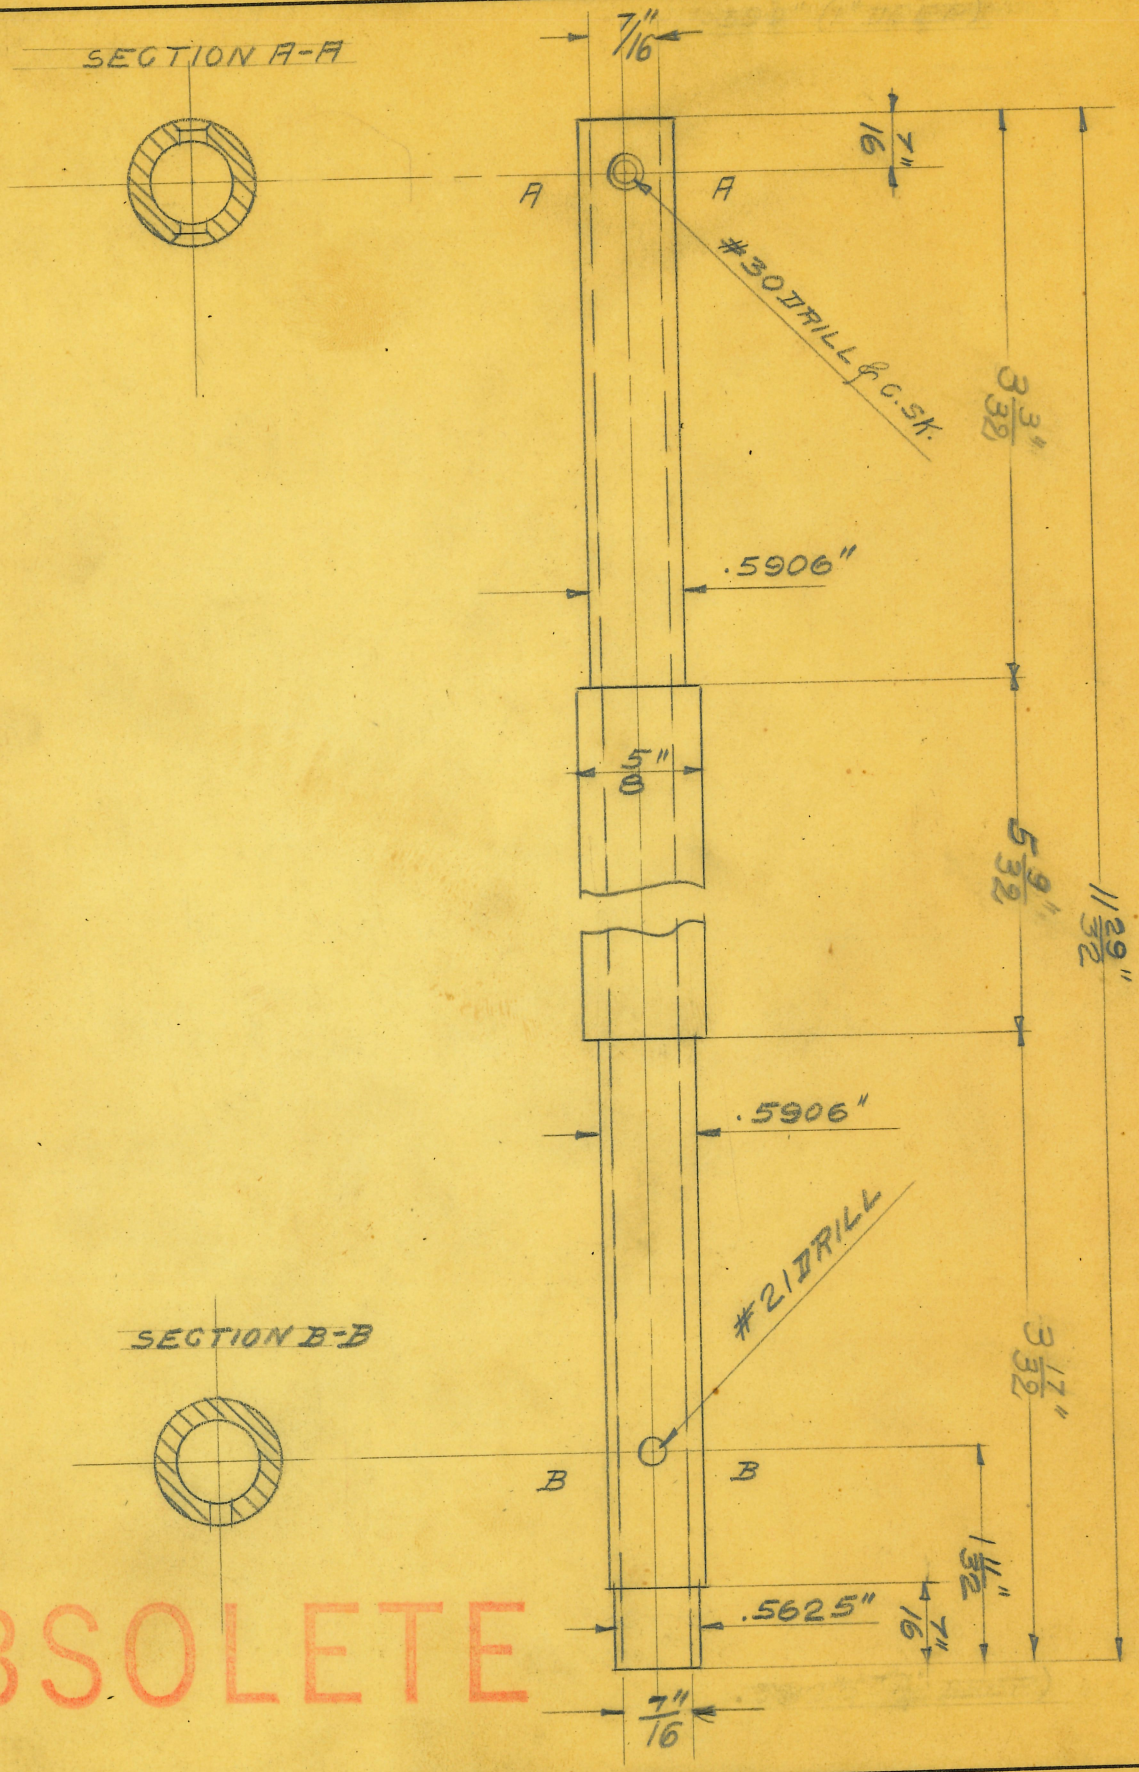

OBSOLETE

SIZE		ISSUE 5-21-26	E.P.
KIND	C.R. STEEL	CHANGED	
SHAPE		" "	
FINISH		" "	
TEMP.		" "	
PATT.		" "	

TITLE: WAVE-GENERATOR AUTOM. RHEOSTAT SHAFT

H. G. FISCHER & CO.
2335 WABANSIA AVE.
CHICAGO, ILL.

CAT. NO.

PART NO. 5409A

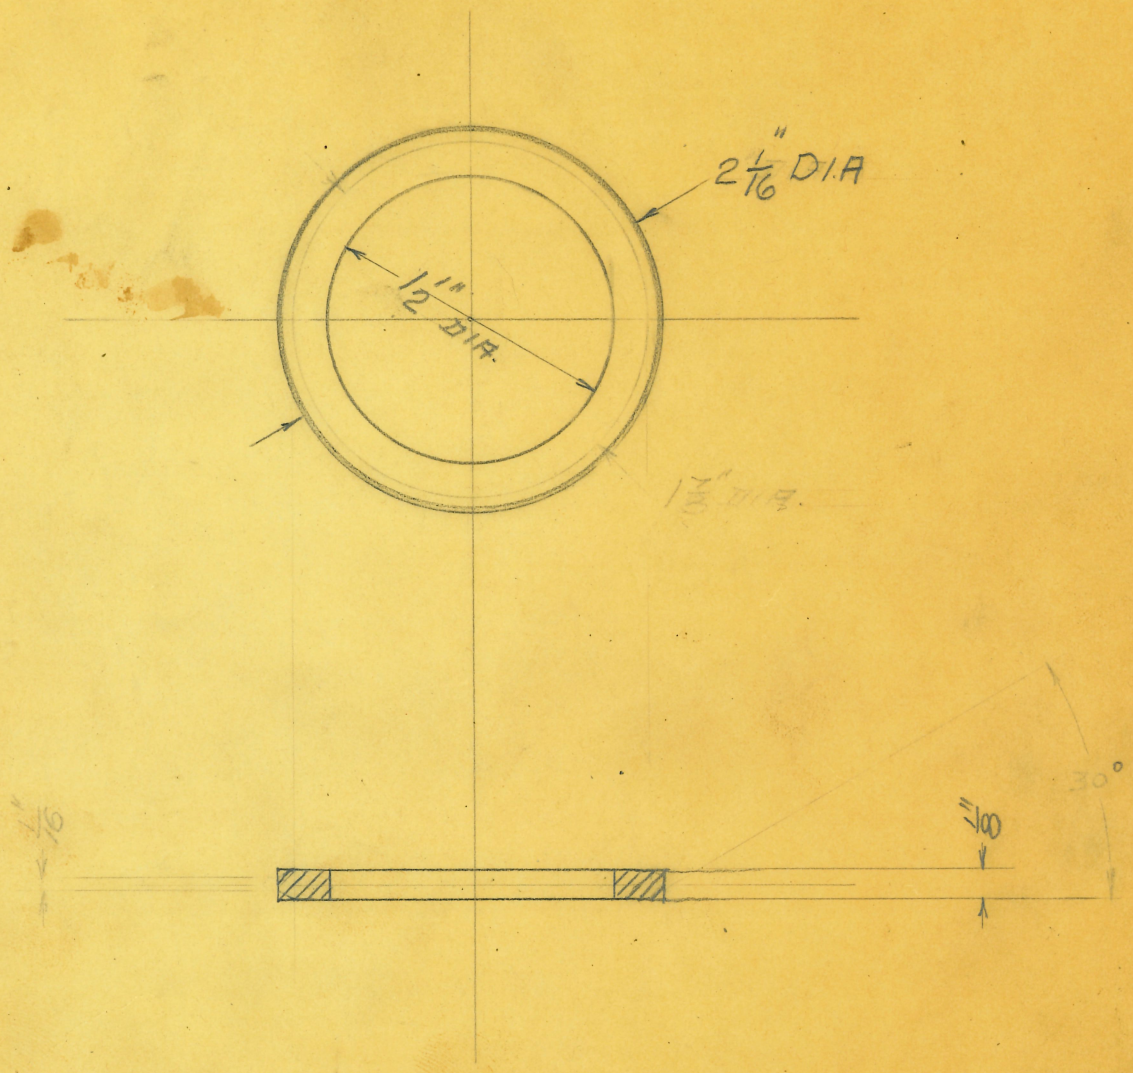

OBSOLETE

(1)

SIZE	1/8" X 2"	ISSUE 8-12-26	EJ	TITLE: LEATHERRING FOR AUTOM. RHEOS. WAVE-GENERATOR	
KIND	LEATHER	CHANGED			
SHAPE		" "			
FINISH		" "			
TEMP.		" "		H. G. FISCHER & CO. 2335 WABANSIA AVE. CHICAGO, ILL.	CAT. NO.
PATT.		" "			PART NO. 5412 A

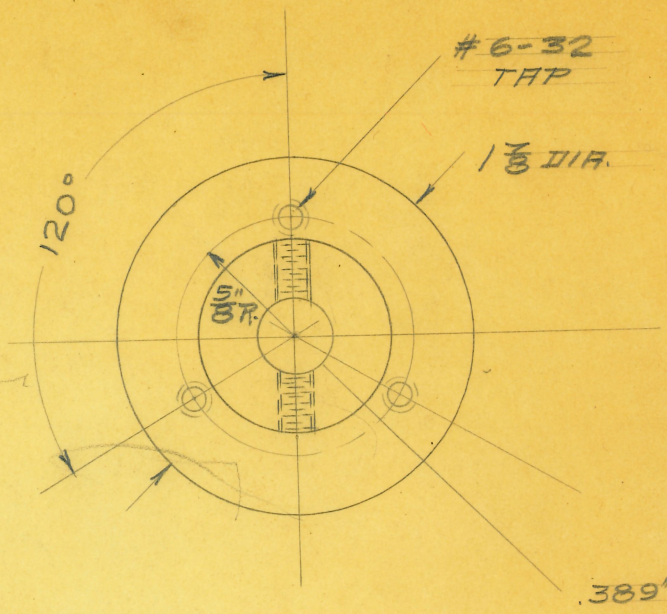

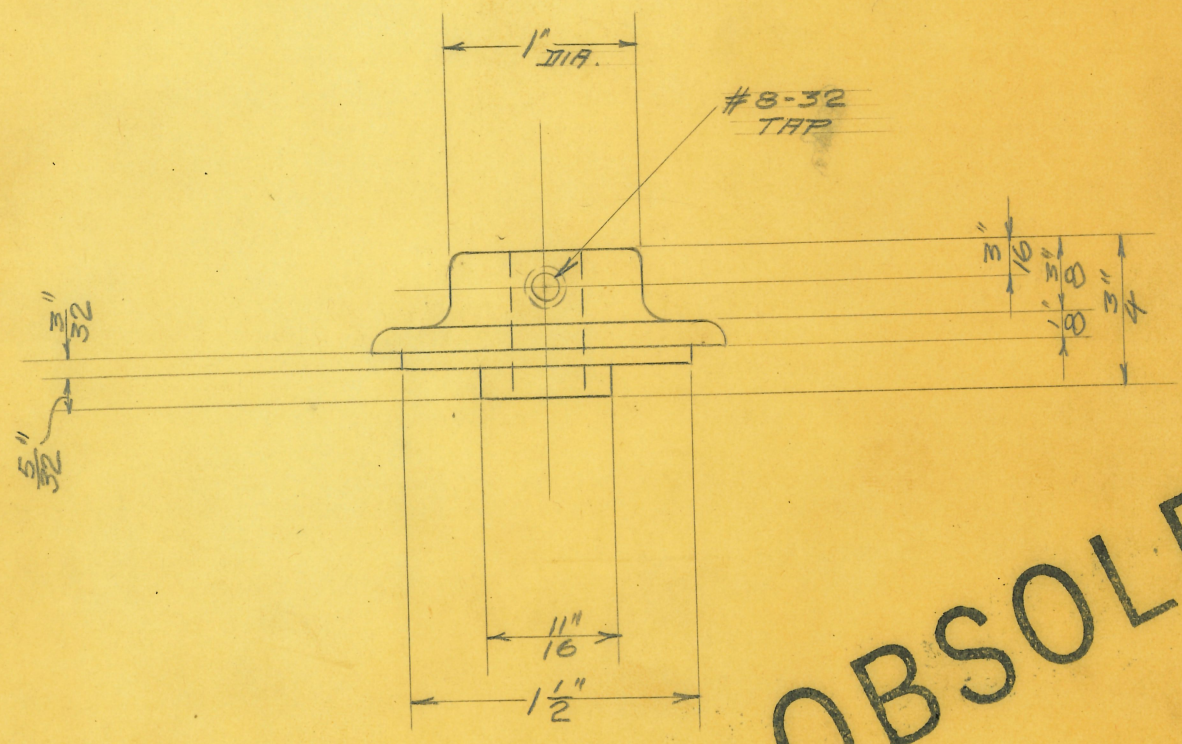

OBSOLETE

(1)

SIZE		ISSUE 9-9-26	EP
KIND	BRASS	CHANGED	
SHAPE		" "	
FINISH	W.P.	" "	
TEMP.		" "	
PATT.		" "	

TITLE: WAVE-GENERATOR LEATHERRING SUPPORT

H. G. FISCHER & CO.
2335 WABANSIA AVE.
CHICAGO, ILL.

CAT. NO.

PART NO. 5413F

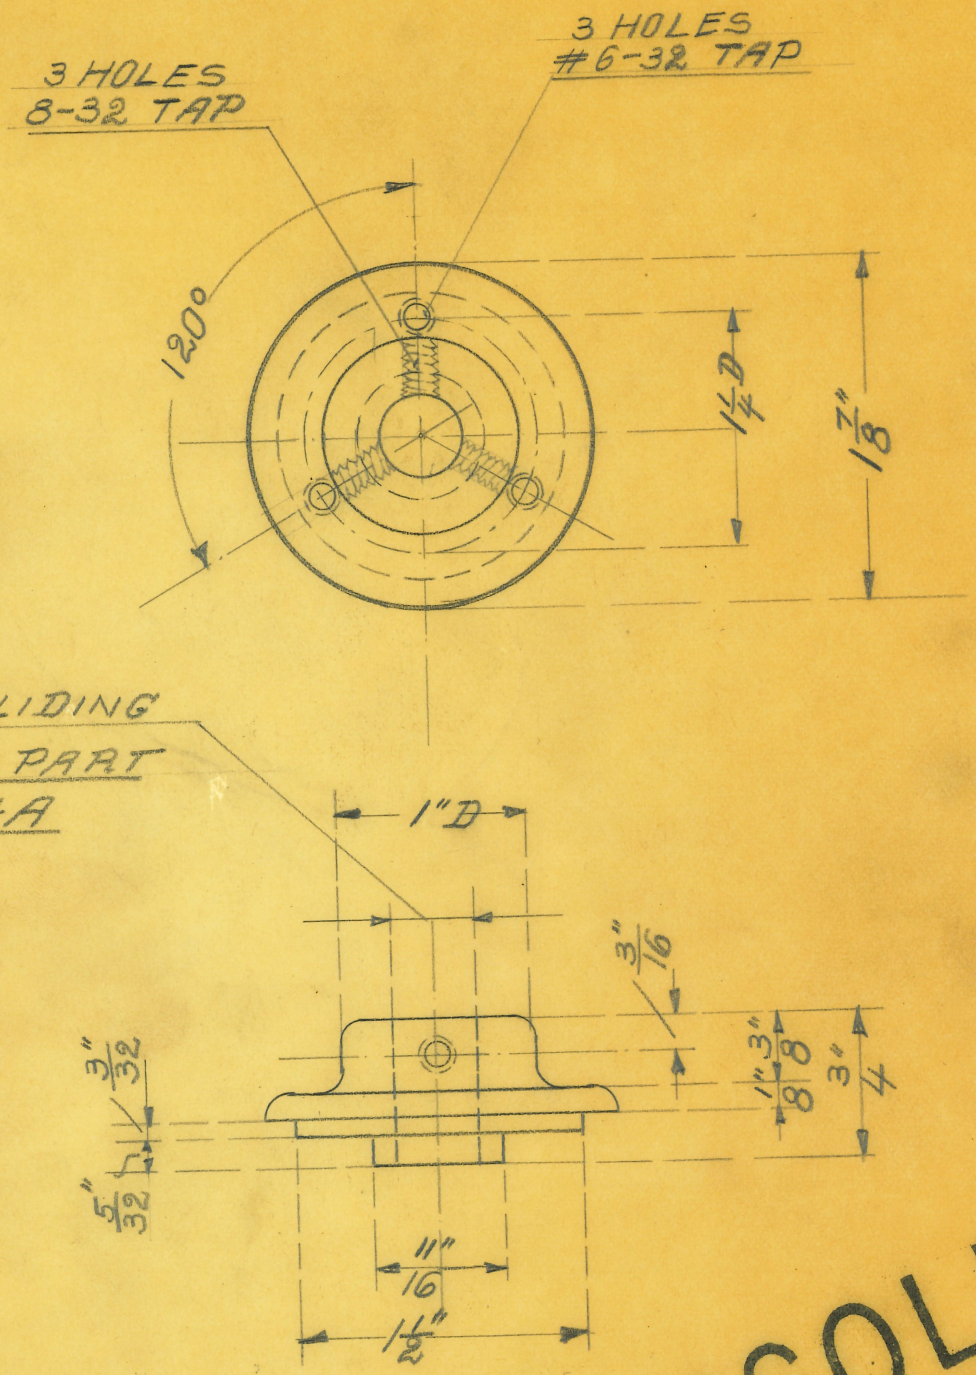

OBSOLETE

(1)

SIZE		ISSUE		TITLE: RUBBER RING SUPPORT LOW VOLT GENERATOR	
KIND	BRASS	CHANGED			
SHAPE		" "			
FINISH	W. P.	" "			
TEMP.		" "		H. G. FISCHER & CO. 2335 WABANSIA AVE. CHICAGO, ILL.	CAT. NO.
PATT.		" "			PART NO. 5413A.F.

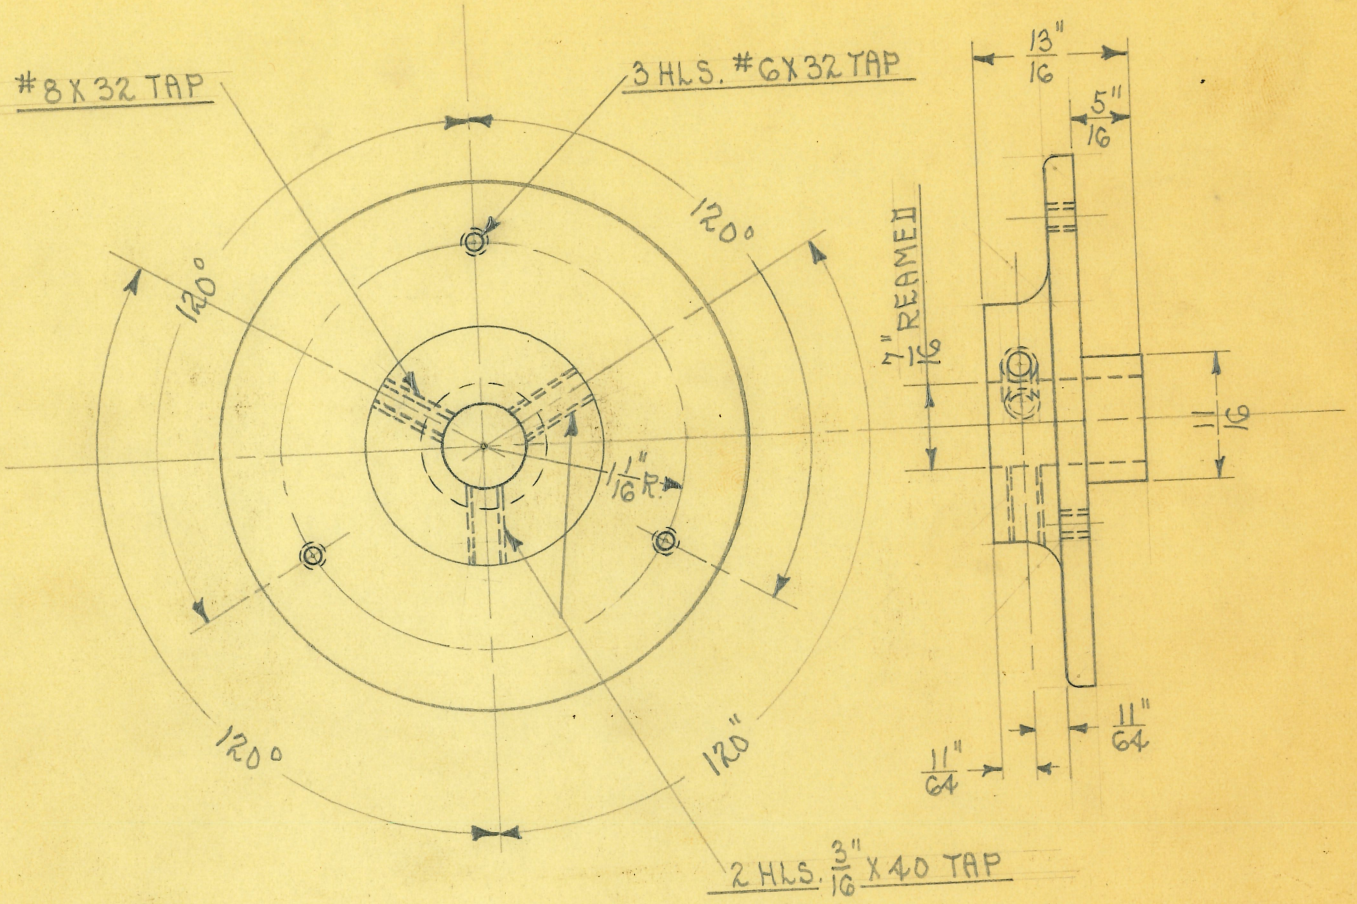

SCALE ½ FULL SIZE
FROM 802

OBSOLETE

SIZE		ISSUE 1-21-32	W.E.	**TITLE:** WAVE GEN. RUBBER RING SUPPORT
KIND		CHANGED		
SHAPE		" "		
FINISH		" "		
TEMP.		" "		H. G. FISCHER & CO. 2335 WABANSIA AVE. CHICAGO, ILL. — CAT. NO. — PART NO. 5413 FA
PATT.		" "		

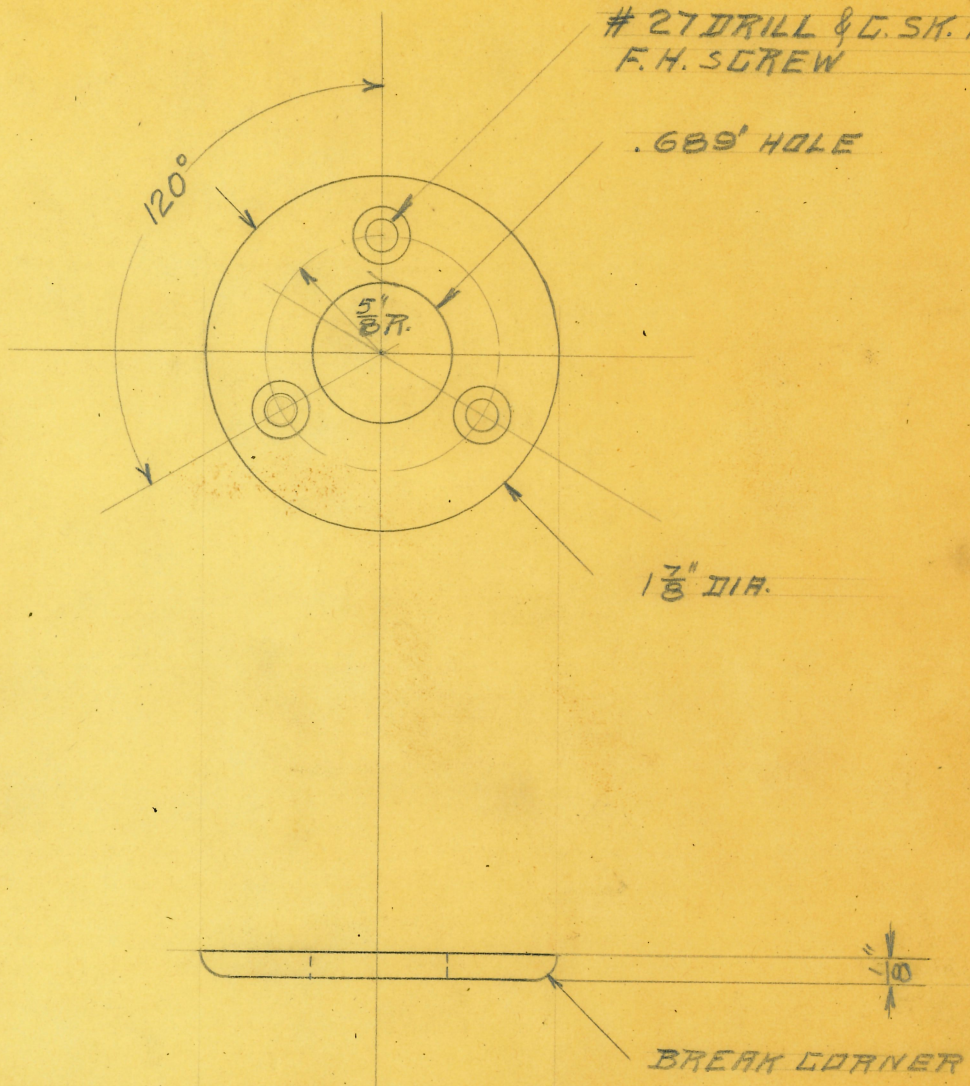

OBSOLETE

(1)

SIZE		ISSUE 9-9-26	DP
KIND	BRASS	CHANGED	
SHAPE		" "	
FINISH	W. P.	" "	
TEMP.		" "	
PATT.		" "	

TITLE: WAVE-GENERATOR LEHERRING DISC

H. G. FISCHER & CO.
2335 WABANSIA AVE.
CHICAGO, ILL.

CAT. NO.

PART NO. 5414

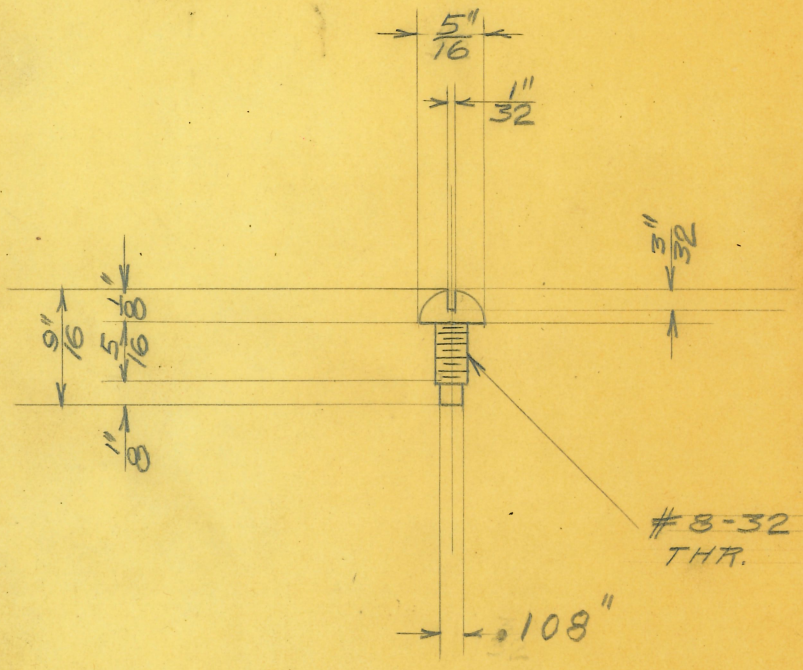

OBSOLETE

(2)

SIZE	SCREW	ISSUE 9-9-26	EP.	TITLE: WAVE-GENERATOR AUTOMAT. RHEOST. SCREW #1
KIND	C.R. STEEL	CHANGED		
SHAPE	CASE	" "		
FINISH	HARDEN	" "		
TEMP.		" "		H. G. FISCHER & CO. 2335 WABANSIA AVE. CHICAGO, ILL.
PATT.		" "		CAT. NO.

PART NO. 5415 A

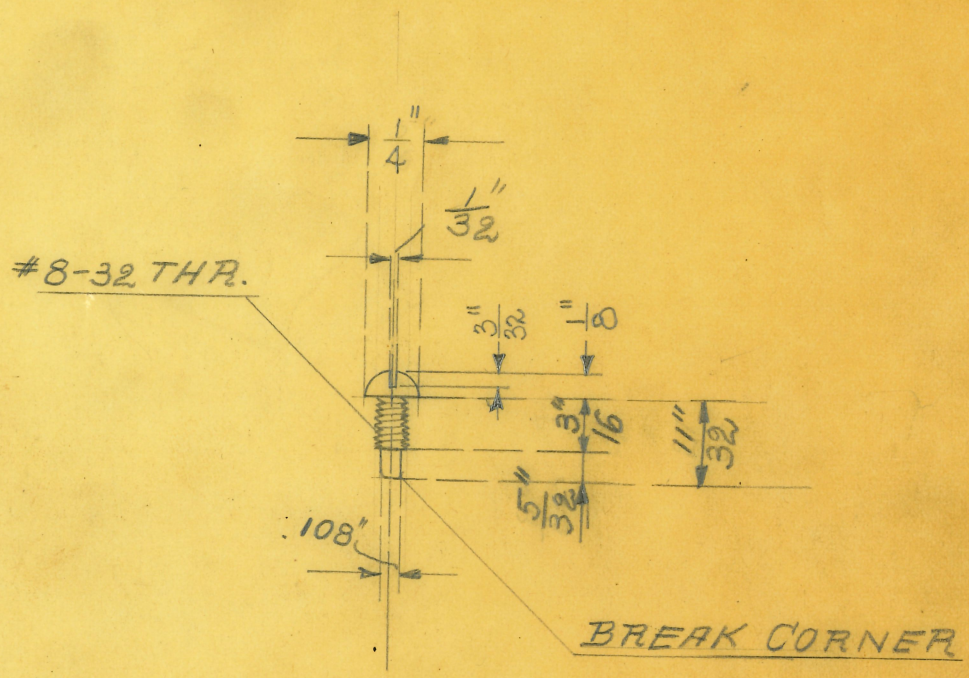

OBSOLETE

(1)

SIZE		ISSUE	
KIND	C R STEEL	CHANGED	
SHAPE		" "	
FINISH	CASE HARD.	" "	
TEMP.		" "	
PATT.		" "	

TITLE: WAVE GENERATOR
AUT. RHEOSTAT. SCREW #1

H. G. FISCHER & CO.
2335 WABANSIA AVE.
CHICAGO, ILL.

CAT. NO.

PART NO. 5415 B

NOTE:
DRAWN IN DOUBLE SCALE

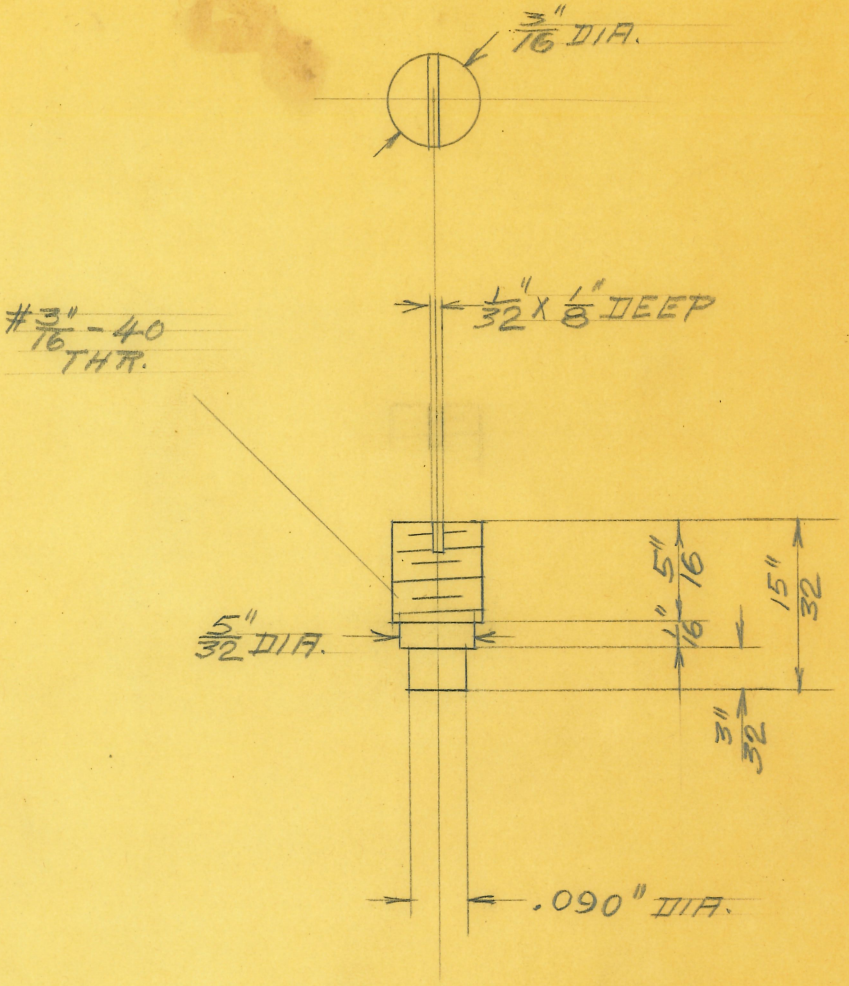

OBSOLETE

(1)

SIZE		ISSUE 9-3-26	DP
KIND	TOOLSTEEL	CHANGED	
SHAPE		" "	
FINISH		" "	
TEMP.		" "	
PATT.		" "	

TITLE: WAVE-GENERATOR
AUTOM. RHEOST. SCREW #2

H. G. FISCHER & CO.
2335 WABANSIA AVE.
CHICAGO, ILL.

CAT. NO.

PART NO. 5416

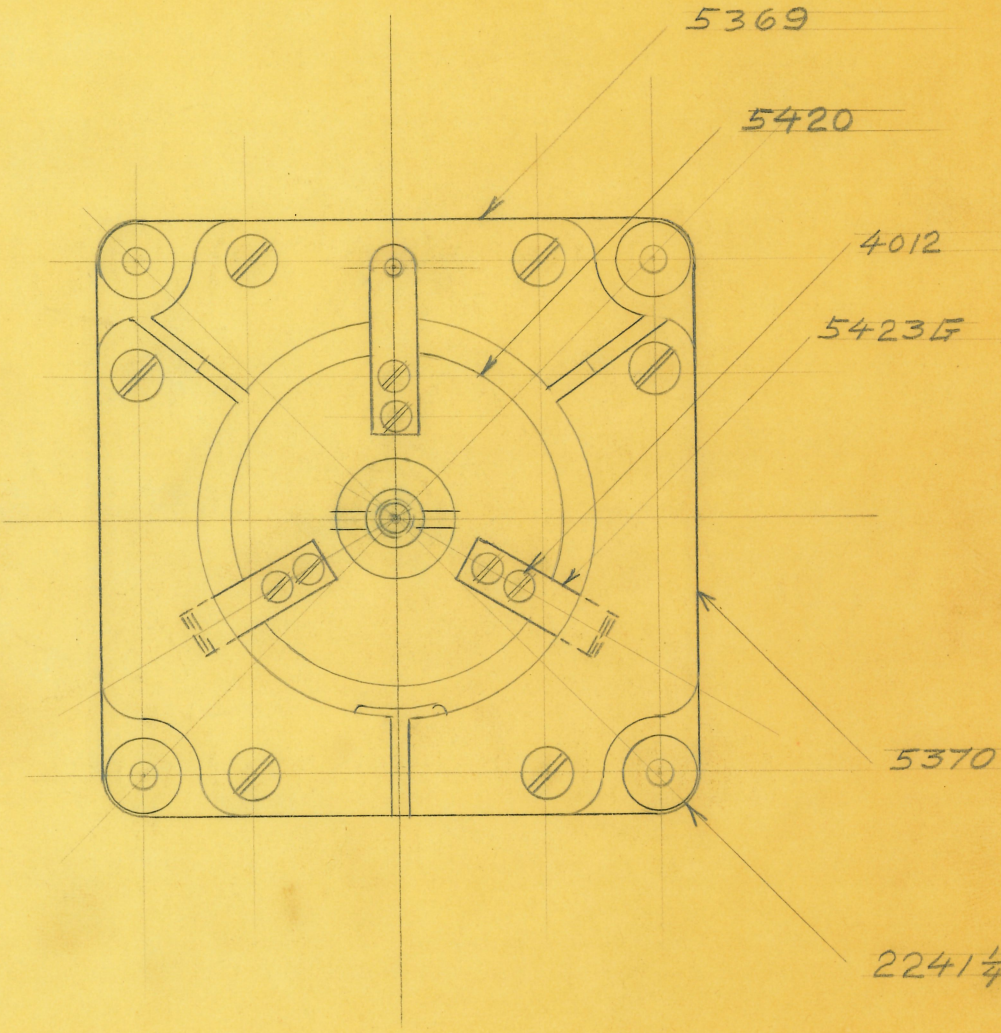

OBSOLETE

(1)

SIZE		ISSUE 9-10-26	CP.
KIND		CHANGED	
SHAPE		" "	
FINISH		" "	
TEMP.		" "	
PATT.		" "	

TITLE: WAVE-GENERATOR SELECTOR SWITCH 2 PT.

H. G. FISCHER & CO.
2335 WABANSIA AVE.
CHICAGO, ILL.

CAT. NO.

PART NO. 5419G

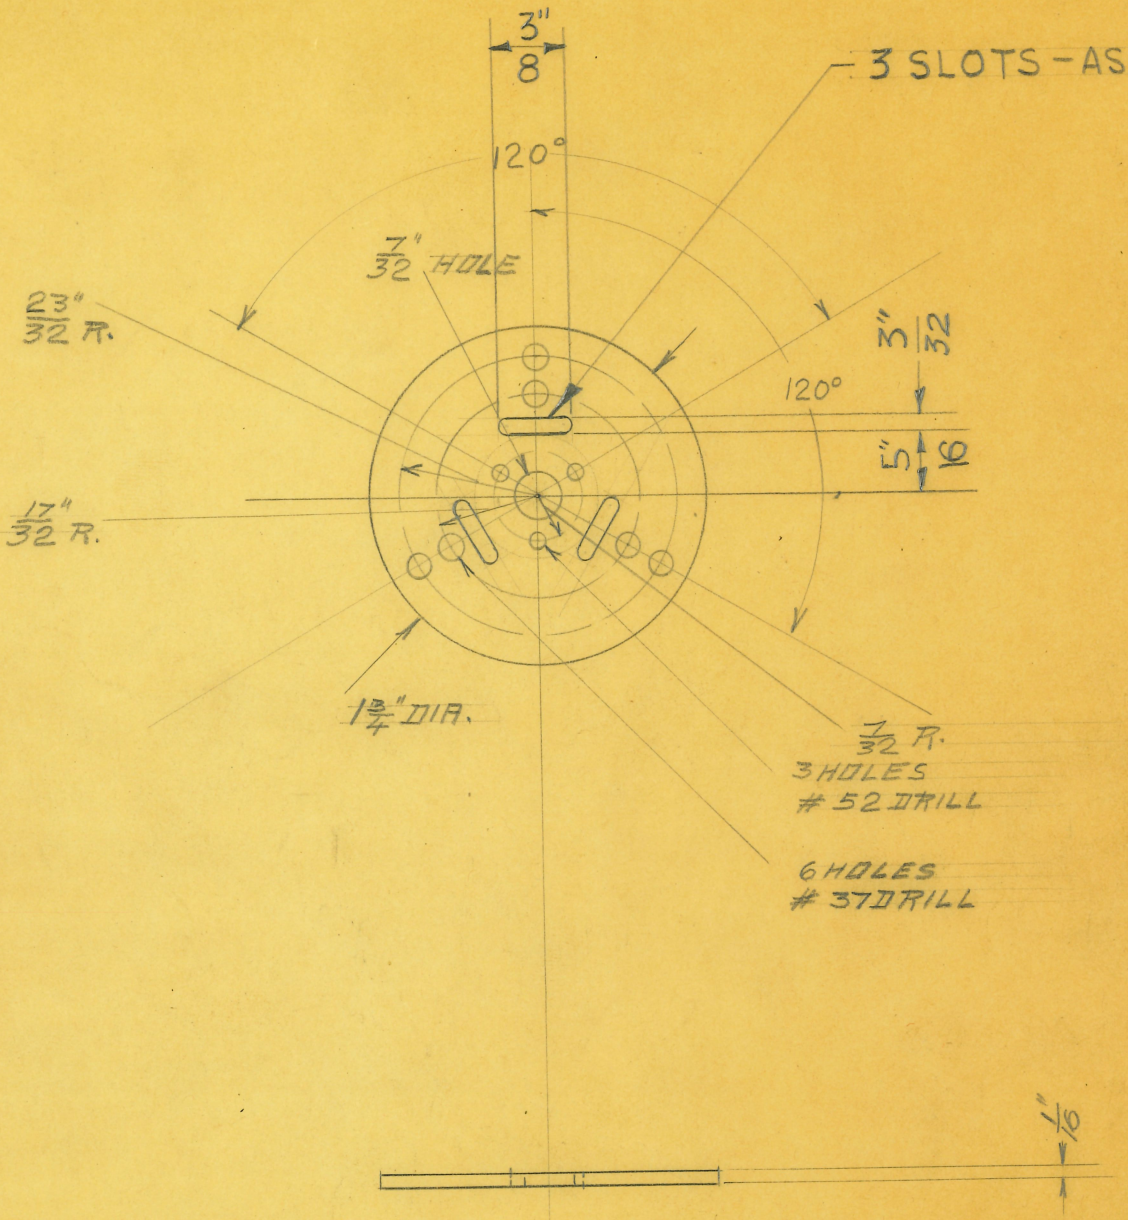

OBSOLETE

(1)

SIZE		ISSUE 8-27-26	C.P.
KIND	BAKELITE	CHANGED 3-5-41	J.V.W.
SHAPE		" "	
FINISH		" "	
TEMP.		" "	
PATT.		" "	

TITLE: WAVE-GENERATOR SELECTOR SWITCH CONT. DISC

H. G. FISCHER & CO.
2335 WABANSIA AVE.
CHICAGO, ILL.

CAT. NO.

PART NO. 5420FA

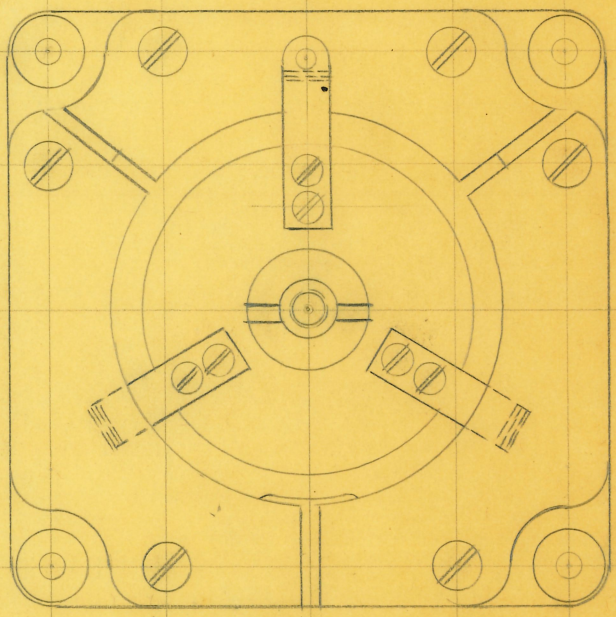

OBSOLETE

(1)

SIZE		ISSUE 9-10-26	GP.
KIND		CHANGED	
SHAPE		" "	
FINISH		" "	
TEMP.		" "	
PATT.		" "	

TITLE: WAVE-GENERATOR SELECTOR SWITCH 3 PT.

H. G. FISCHER & CO.
2335 WABANSIA AVE.
CHICAGO, ILL.

CAT. NO.

PART NO. 5420F

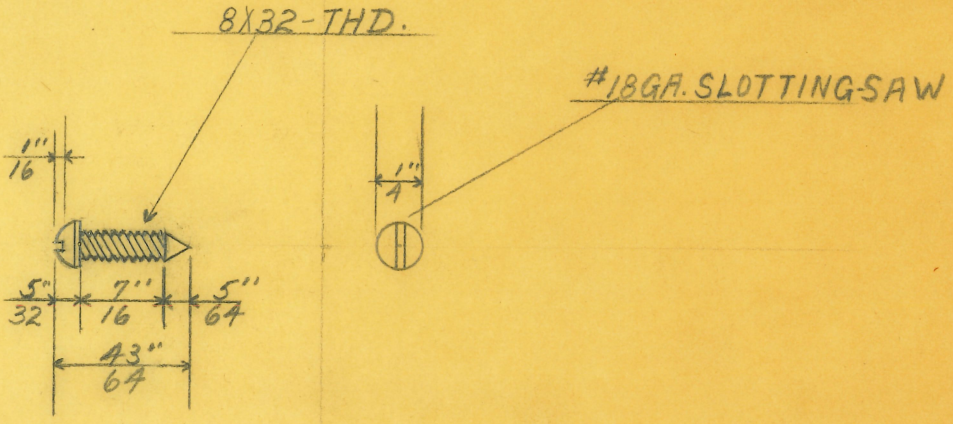

OBSOLETE

SIZE	1/4"	ISSUE		TITLE: WAVE-GEN.-RUB.-RING-SUPP. SCREW		
KIND	SCR. STOCK	CHANGED				
SHAPE		" "				
FINISH		" "				
TEMP.		" "		H. G. FISCHER & CO. 2335 WABANSIA AVE. CHICAGO, ILL.	CAT. NO.	PART NO. 5422A
PATT.		" "				

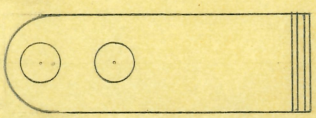

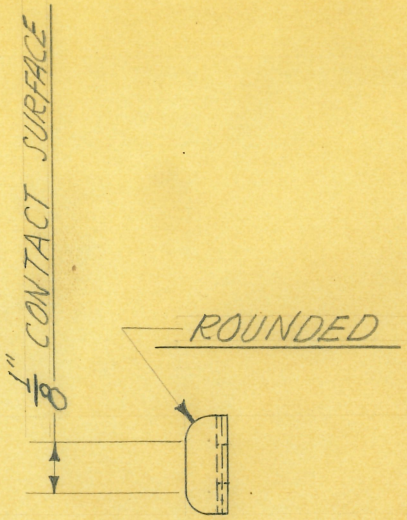

SCALE ÷ DOUBLE SIZE

3 REQUIRED

OBSOLETE

SIZE		ISSUE 10-25-37	J.W.
KIND	FROM 5463G	CHANGED 3-5-41	J.V.W.
SHAPE		"	
FINISH		"	
TEMP.		"	
PATT.		"	

TITLE: WAVE GENERATOR 15 PT. SWITCH CONTACT SET

H. G. FISCHER & CO.
2335 WABANSIA AVE.
CHICAGO, ILL.

CAT. NO.

PART NO. 5423 1/2 GA

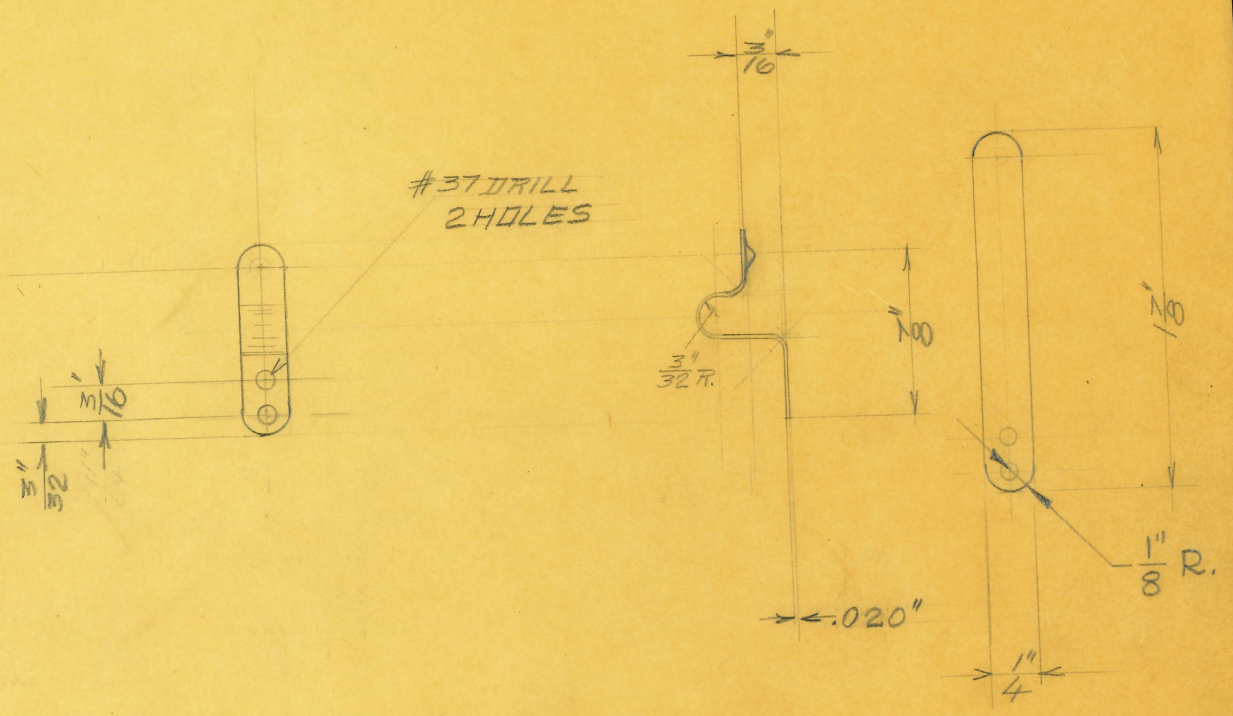

OBSOLETE

(2)

SIZE		ISSUE 9-10-26	
KIND	BRONZE	CHANGED 3-5-41	J.V.W.
SHAPE		" "	
FINISH		" "	
TEMP.		" "	
PATT.		" "	

TITLE: WAVE-GENERATOR SELECTOR SWITCH STOP

H. G. FISCHER & CO.
2335 WABANSIA AVE.
CHICAGO, ILL.

CAT. NO.

PART NO. 5423

NOTE
DOUBLE SCALE

4 SINGLE BRONZE SPRINGS .010"

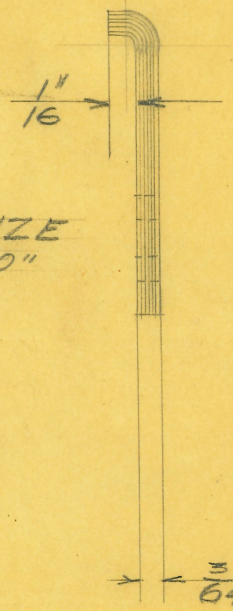

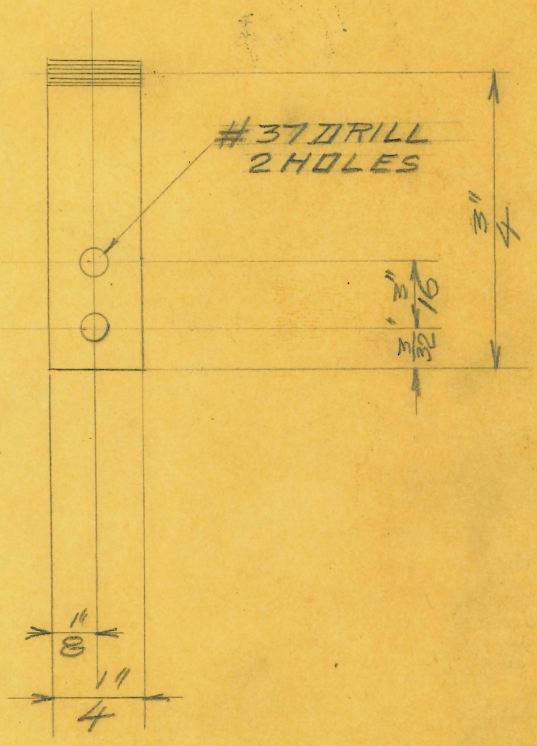

OBSOLETE

obsolete

SIZE		ISSUE 9-10-26	GP.
KIND	BRONZE	CHANGED	
SHAPE		" "	
FINISH		" "	
TEMP.		" "	
PATT.		" "	

TITLE: WAVE-GENERATOR SELECTOR SW. CONT. SETS

H. G. FISCHER & CO.
2335 WABANSIA AVE.
CHICAGO, ILL.

CAT. NO.

PART NO. 5423G.

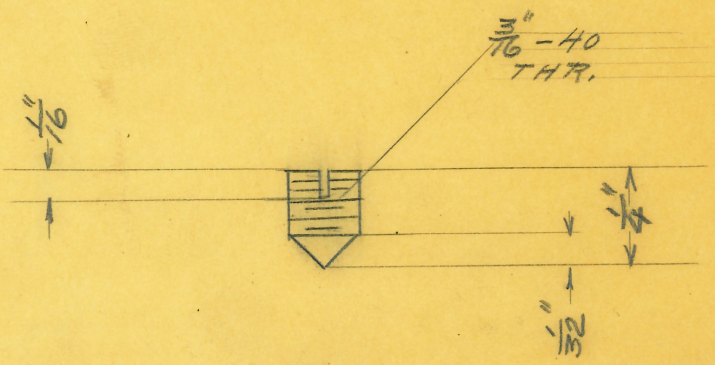

NOTE:
SCREW STOCK
CASE HARDEN

OBSOLETE

(3)

SIZE		ISSUE 7-22-20	Q.	TITLE: SET SCREW FOR AUTOMATIC RHEOSTAT (W. G.)	
KIND		CHANGED			
SHAPE		" "			
FINISH		" "			
TEMP.		" "		H. G. FISCHER & CO. 2335 WABANSIA AVE. CHICAGO, ILL.	CAT. NO.
PATT.		" "			PART NO. 5424

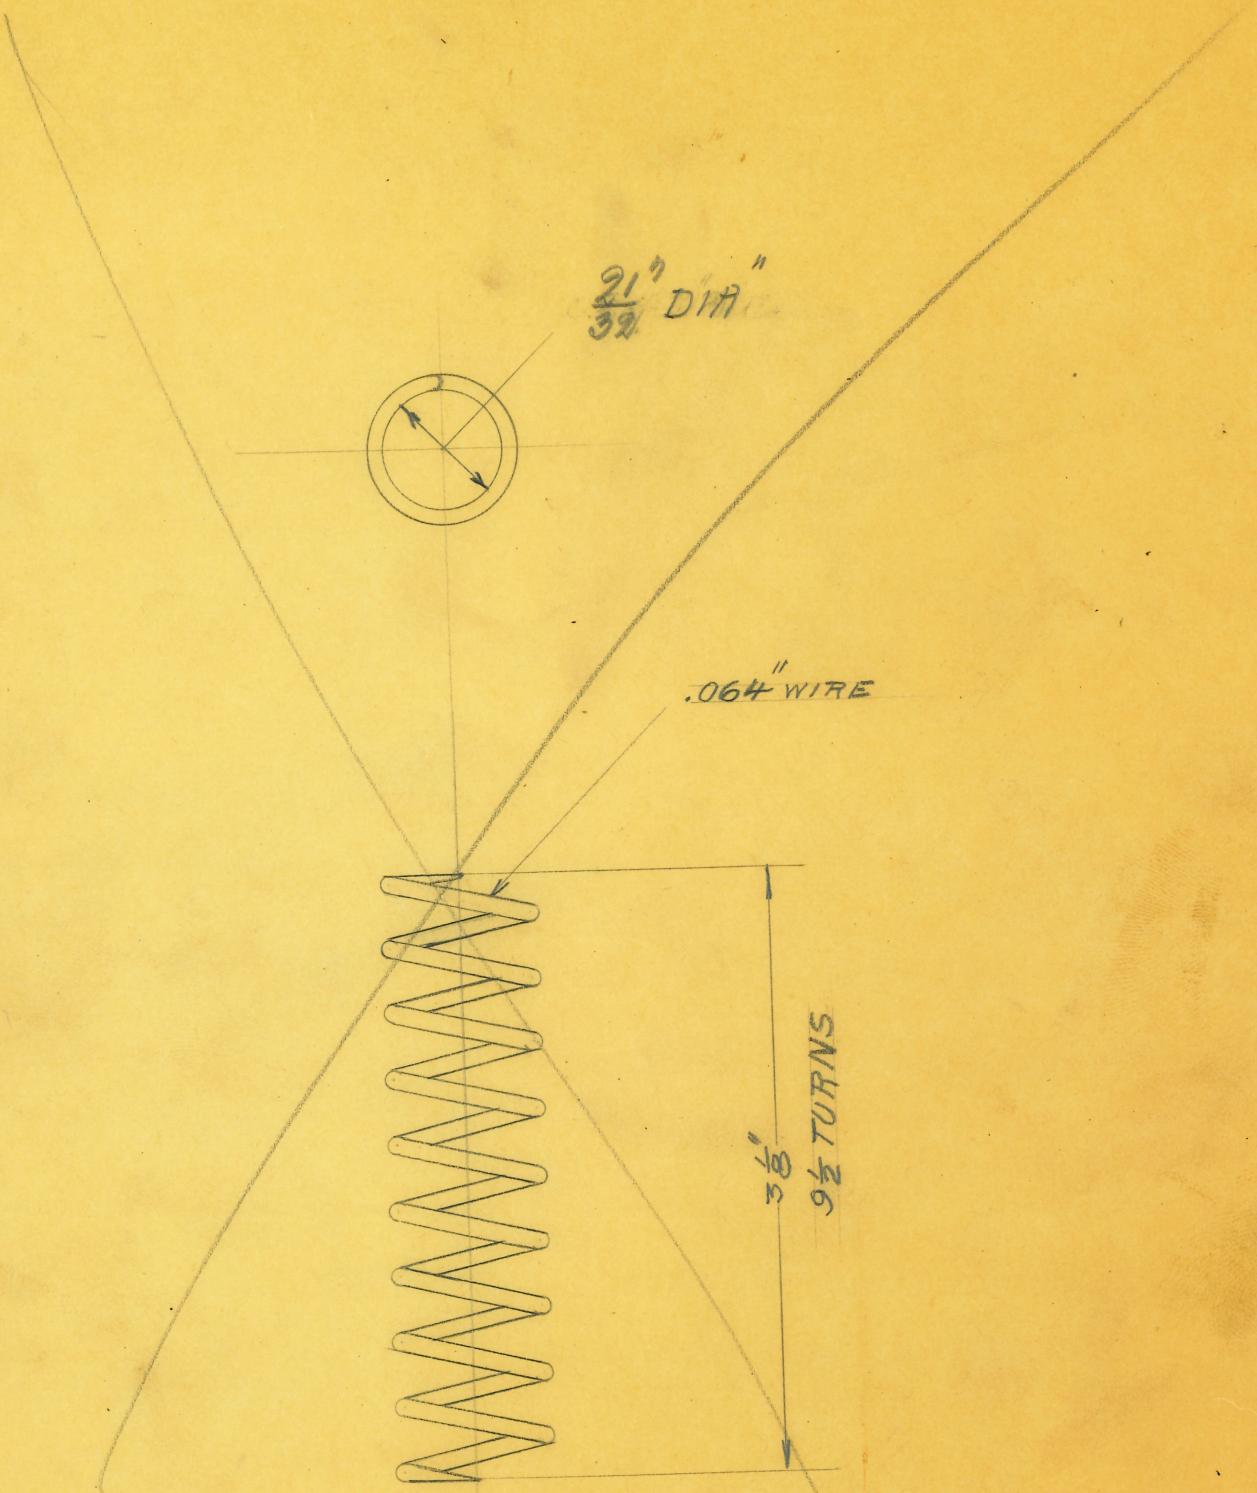

OBSOLETE

(1)

SIZE		ISSUE 7-25-26	Q.	TITLE: FRICTION DISC SPRING WAVE-GENERATOR	
KIND		CHANGED			
SHAPE		" "			
FINISH		" "			
TEMP.		" "		H. G. FISCHER & CO. 2335 WABANSIA AVE. CHICAGO, ILL.	CAT. NO.
PATT.		" "			PART NO. 5425

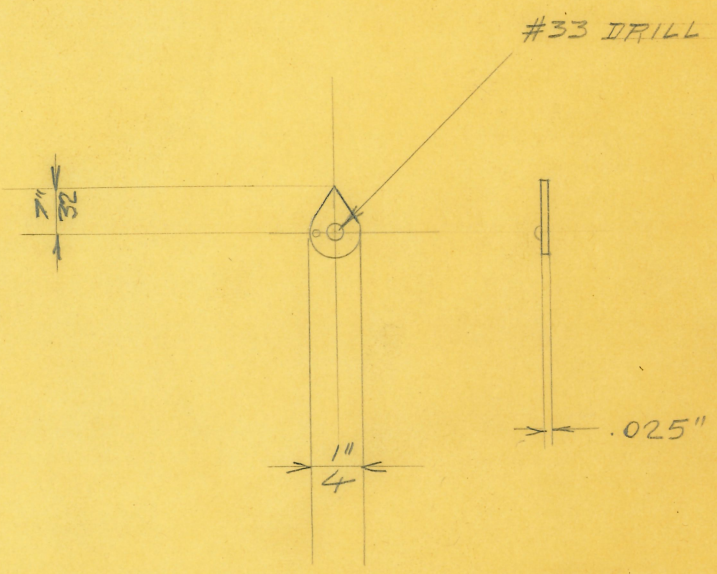

OBSOLETE

(1)

SIZE		ISSUE 9-2-26	E.P.
KIND	BRASS	CHANGED	
SHAPE		" "	
FINISH	N.P.	" "	
TEMP.		" "	
PATT.		" "	

TITLE: WAVE GENERATOR
SURGE INDICATOR

H. G. FISCHER & CO.
2335 WABANSIA AVE.
CHICAGO, ILL.

CAT. NO.

PART NO. 5426

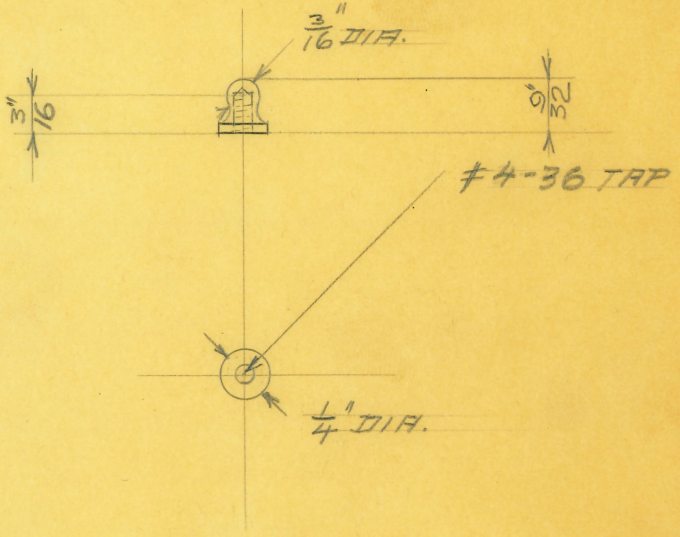

OBSOLETE

(1)

SIZE		ISSUE 9-2-26	CP.
KIND	BRASS	CHANGED	
SHAPE		" "	
FINISH	N.F.	" "	
TEMP.		" "	
PATT.		" "	

TITLE:
WAVE GENERATOR
SURGE INDICATOR KNOB

H. G. FISCHER & CO.
2335 WABANSIA AVE.
CHICAGO, ILL.

CAT. NO.

PART NO. 5427

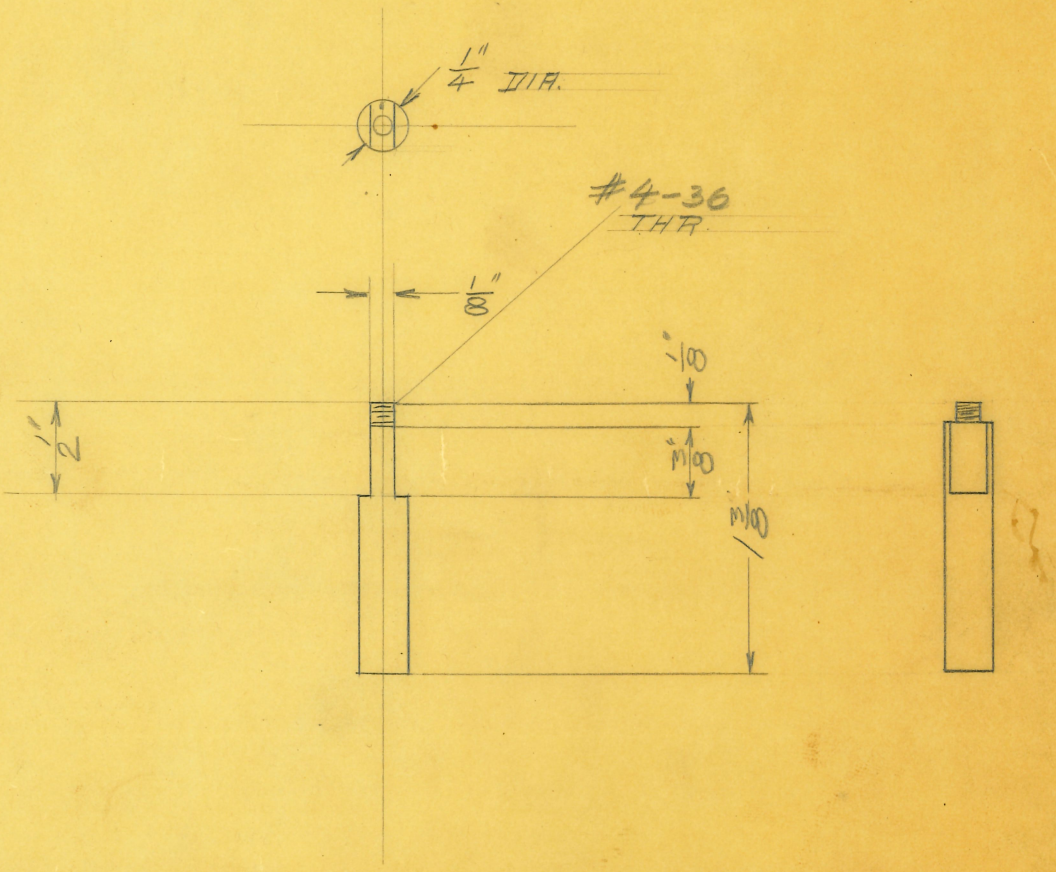

OBSOLETE

(1)

SIZE		ISSUE 9-2-26	C.P.
KIND	C.R. STEEL	CHANGED	
SHAPE		" "	
FINISH	W.P.	" "	
TEMP.		" "	
PATT.		" "	

TITLE:

WAVE GENERATOR

SURGE INDICATOR STUD

H. G. FISCHER & CO.
2335 WABANSIA AVE.
CHICAGO, ILL.

CAT. NO.

PART NO. 5428

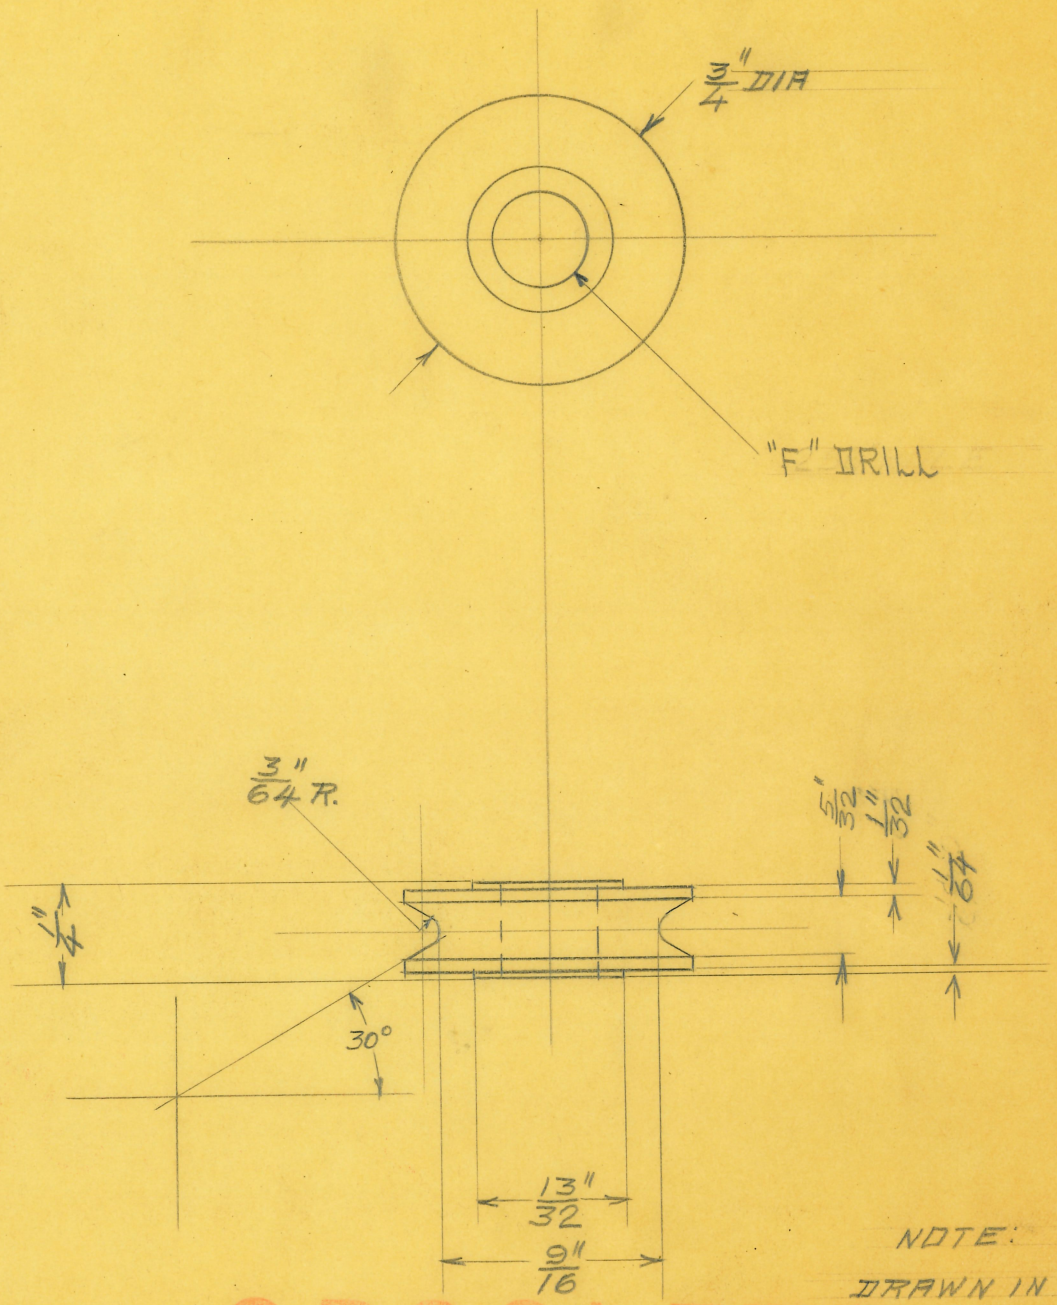

NOTE:
DRAWN IN DOUBLE SCALE

OBSOLETE

(2)

SIZE		ISSUE 8-5-26	E.P.
KIND	BRASS	CHANGED	
SHAPE		" "	
FINISH		" "	
TEMP.		" "	
PATT.		" "	

TITLE: RESISTANCE COIL PULLEY
WAVE-GENERATOR

H. G. FISCHER & CO.
2335 WABANSIA AVE.
CHICAGO, ILL.

CAT. NO.

PART NO. 5429

#8-32
TAP

OBSOLETE

#8-32
TAP

(1)

SIZE		ISSUE 9-3-26	
KIND	C.R.STEEL	CHANGED	
SHAPE		" "	
FINISH		" "	
TEMP.		" "	
PATT.		" "	

TITLE: WAVE-GENERATOR
RHEOSTAT SLIDE ROD

H. G. FISCHER & CO.
2335 WABANSIA AVE.
CHICAGO, ILL.

CAT. NO.

PART NO. 5430

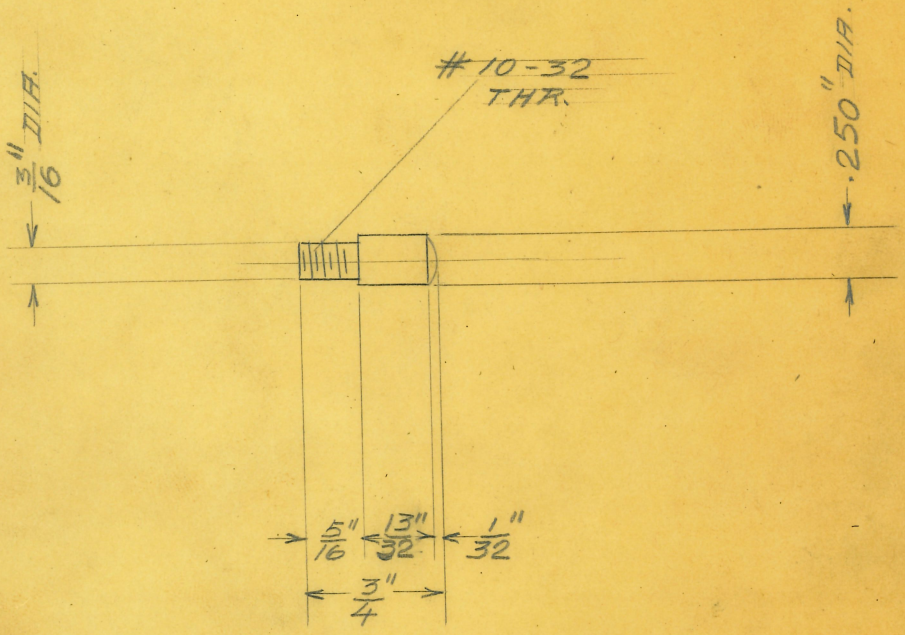

OBSOLETE

(1)

SIZE	1/4"	ISSUE 8-11-26	E.P.
KIND	DRILL ROD	CHANGED	
SHAPE		" "	
FINISH		" "	
TEMP.		" "	
ATT.		" "	

TITLE: WAVE-GENERATOR
DOWELL PIN

H. G. FISCHER & CO.
2335 WABANSIA AVE.
CHICAGO, ILL.

CAT. NO.

PART NO. 5431

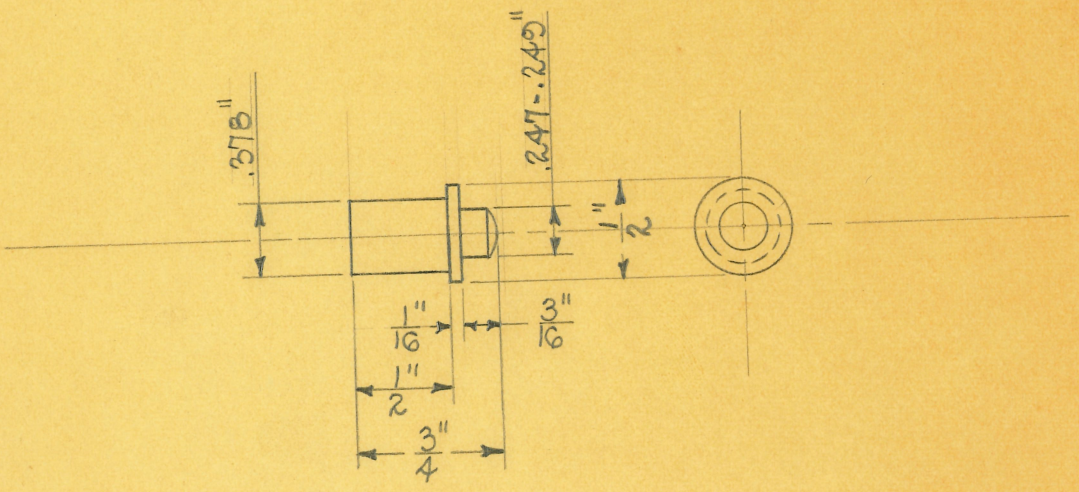

SCALE ÷ FULL SIZE

OBSOLETE

SIZE	1/2"	ISSUE 11-24-31	A.E.	TITLE: WAVE GEN. MOTOR DOWEL PIN
KIND	DRILL ROD	CHANGED		
SHAPE		" "		
FINISH		" "		
TEMP.		" "		
PATT.		" "		

H. G. FISCHER & CO.
2335 WABANSIA AVE.
CHICAGO, ILL.

CAT. NO.

PART NO. 5431A

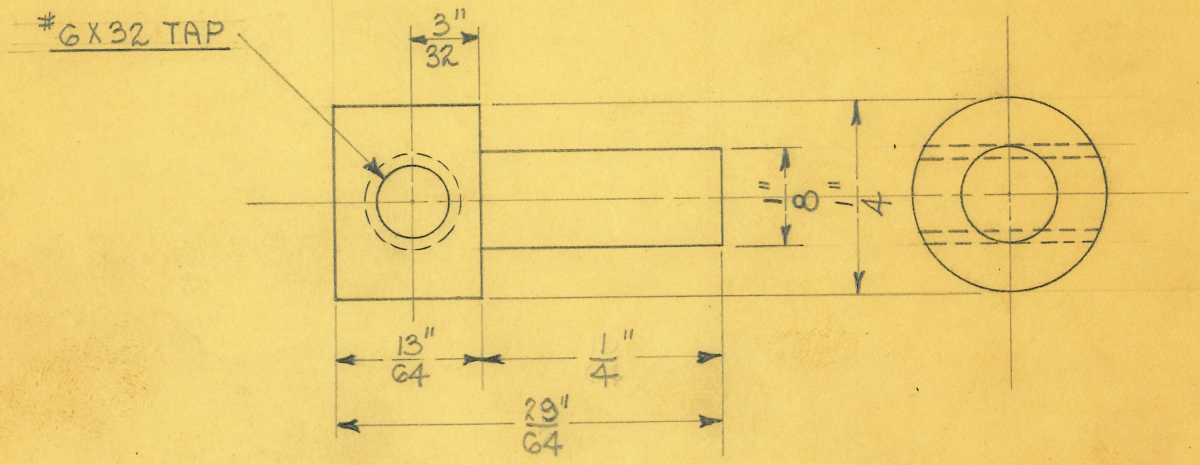

SCALE ~ 4 DIAMETERS
2 REQUIRED

OBSOLETE

SIZE	1/4"	ISSUE 1-30-31	A.E.	TITLE: WAVE GEN. LINESWITCH LOCKING STUD
KIND	BRASS ROD	CHANGED		
SHAPE		" "		
FINISH		" "		
TEMP.		" "		H. G. FISCHER & CO. 2335 WABANSIA AVE. CHICAGO, ILL. — CAT. NO. — PART NO. 5432
PATT.		" "		

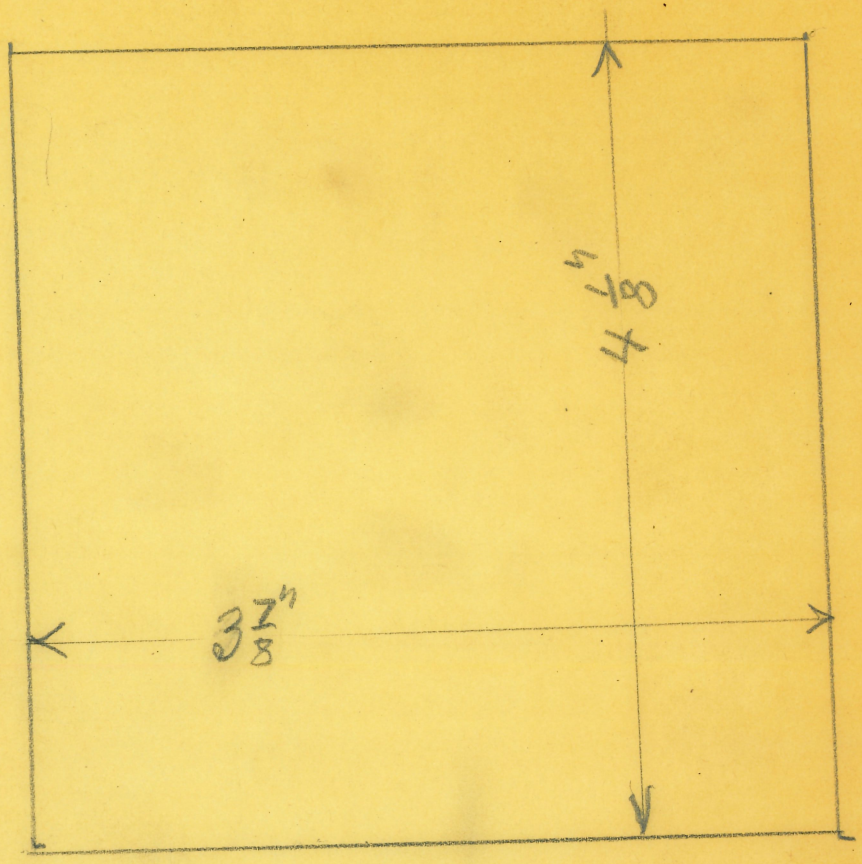

OBSOLETE

OBSOLETE

SIZE		ISSUE	
KIND	1/32 FIBER	CHANGED	
SHAPE		" "	
FINISH		" "	
TEMP.		" "	
PATT.		" "	

TITLE: INSULATOR FOR CONDENSER LOW VOLT GENERATOR.

H. G. FISCHER & CO.
2335 WABANSIA AVE.
CHICAGO, ILL.

CAT. NO.

PART NO. 5437

(1)

OBSOLETE

SIZE		ISSUE	
KIND	FIBRE	CHANGED	
SHAPE		" "	
FINISH		" "	
TEMP.		" "	
PATT.		" "	

TITLE:

WAVE-GENERATOR
INSULATING STRAP FOR CONDENSERS

H. G. FISCHER & CO.
2335 WABANSIA AVE.
CHICAGO, ILL.

CAT. NO.

PART NO. 5437 1/4

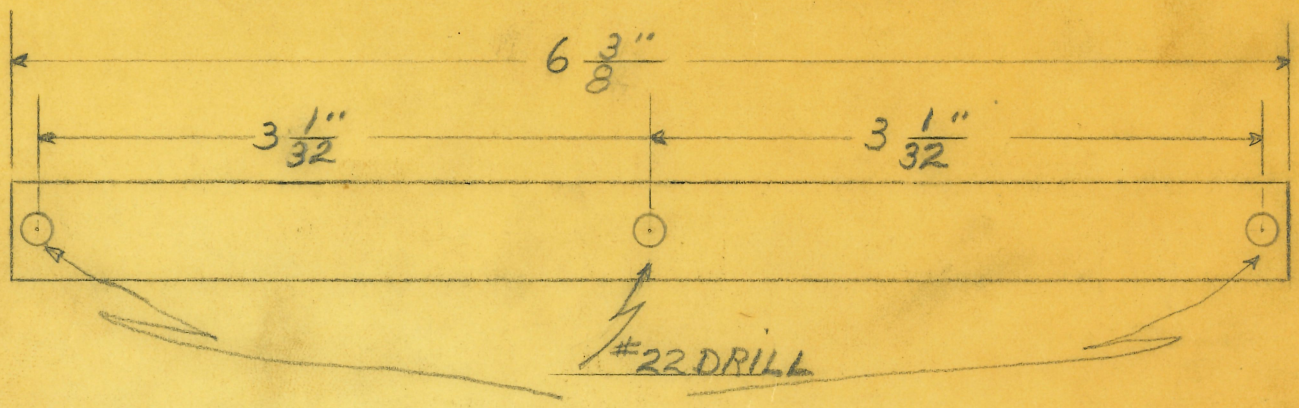

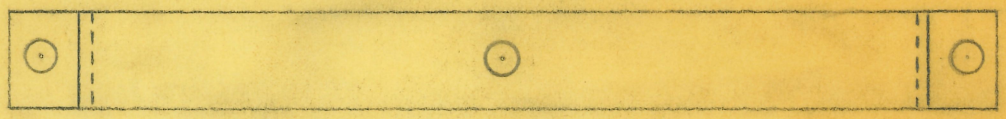

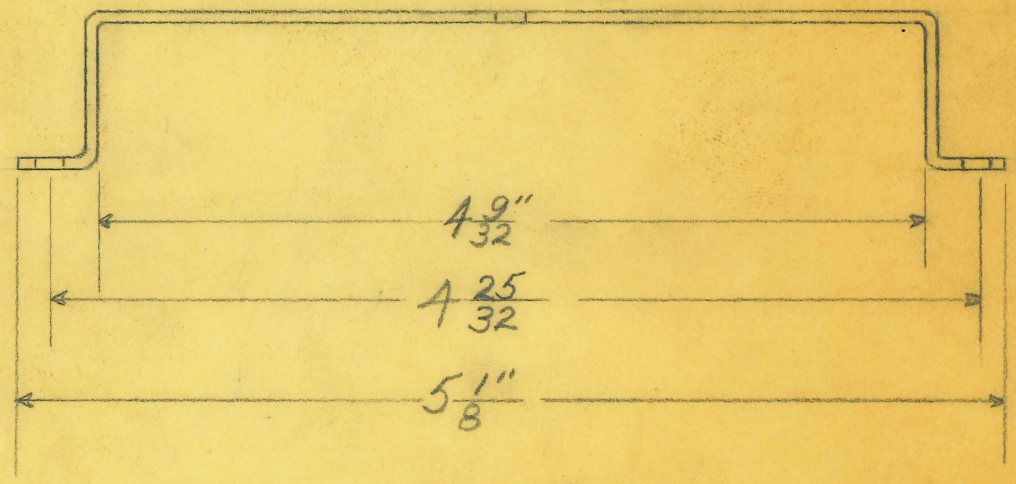

OBSOLETE

SIZE	1/16" X 1/2"	ISSUE		TITLE: WAVE-GEN. CONDENSER-CLAMP
KIND	COLD-ROLLED	CHANGED		
SHAPE	WIRE	" "		
FINISH		" "		
TEMP.		" "		H. G. FISCHER & CO. 2335 WABANSIA AVE. CHICAGO, ILL. — CAT. NO. — PART NO. 5437 1/2
PATT.		" "		

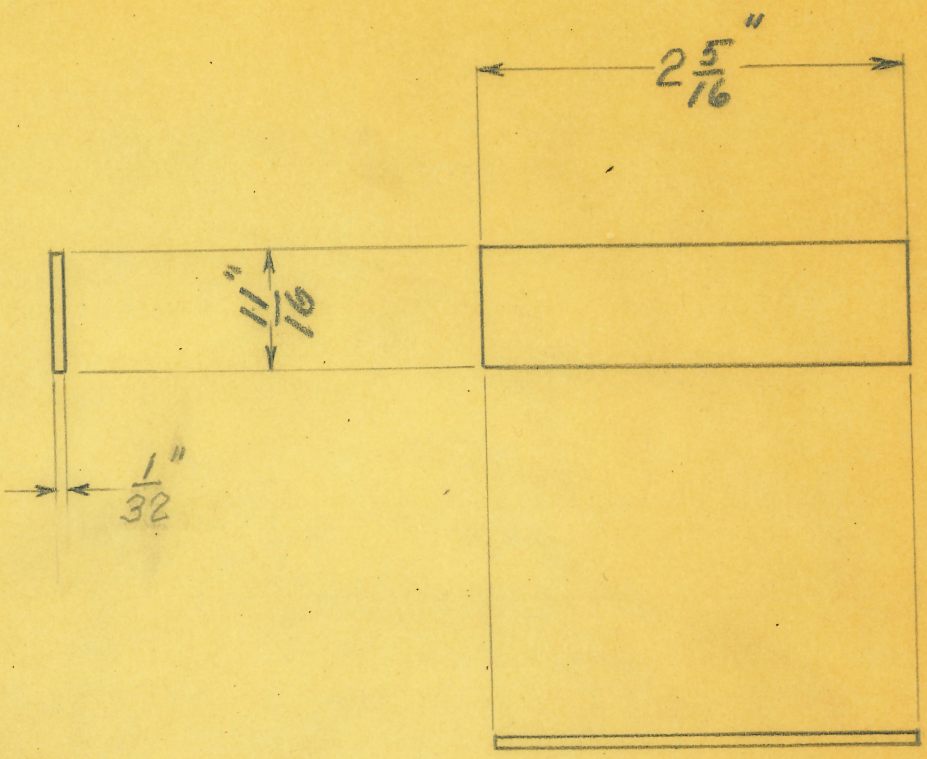

OBSOLETE

(4)

SIZE		ISSUE	
KIND	FIBRE	CHANGED	
SHAPE		" "	
FINISH		" "	
TEMP.		" "	
PATT.		" "	

TITLE:

WAVE-GENERATOR
INSULATING STRAP FOR CHOKECOILS

H. G. FISCHER & CO.
2335 WABANSIA AVE.
CHICAGO, ILL.

CAT. NO.

PART NO. 5439 1/4

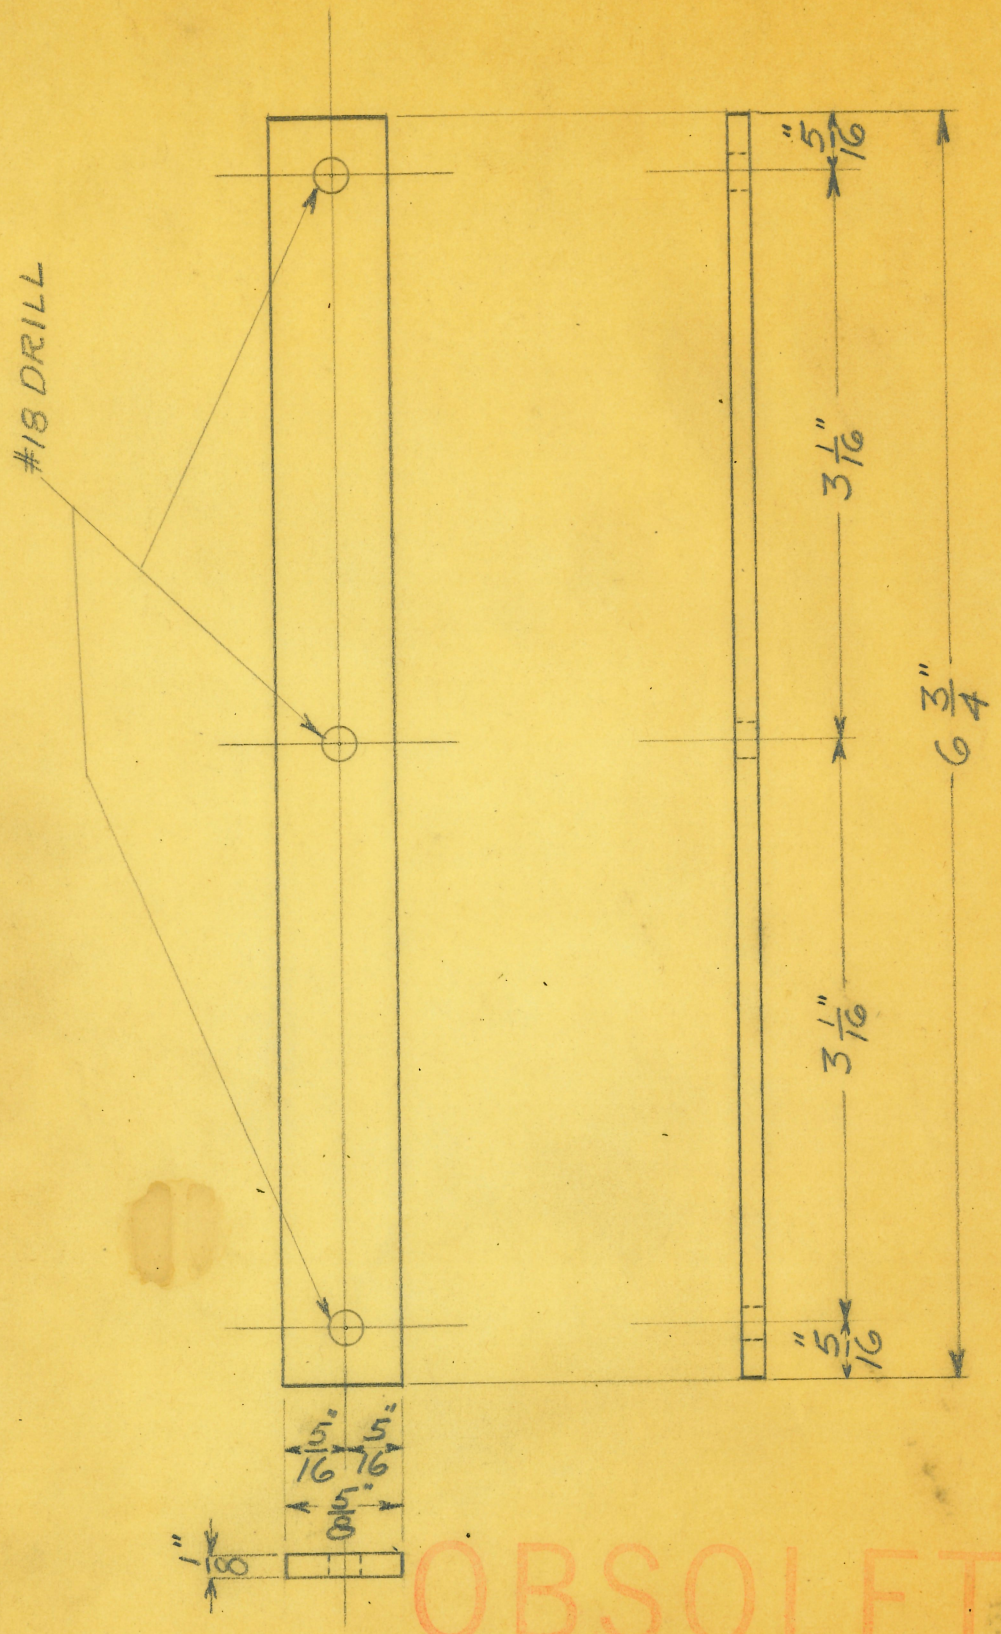

OBSOLETE

(2)

SIZE		ISSUE	
KIND	C.R. STEEL	CHANGED	
SHAPE		" "	
FINISH		" "	
TEMP.		" "	
PATT.		" "	

TITLE:

WAVE-GENERATOR
CLAMP FOR CHOKE COILS

H. G. FISCHER & CO.
2335 WABANSIA AVE.
CHICAGO, ILL.

CAT. NO.

PART NO. 5439 1/2

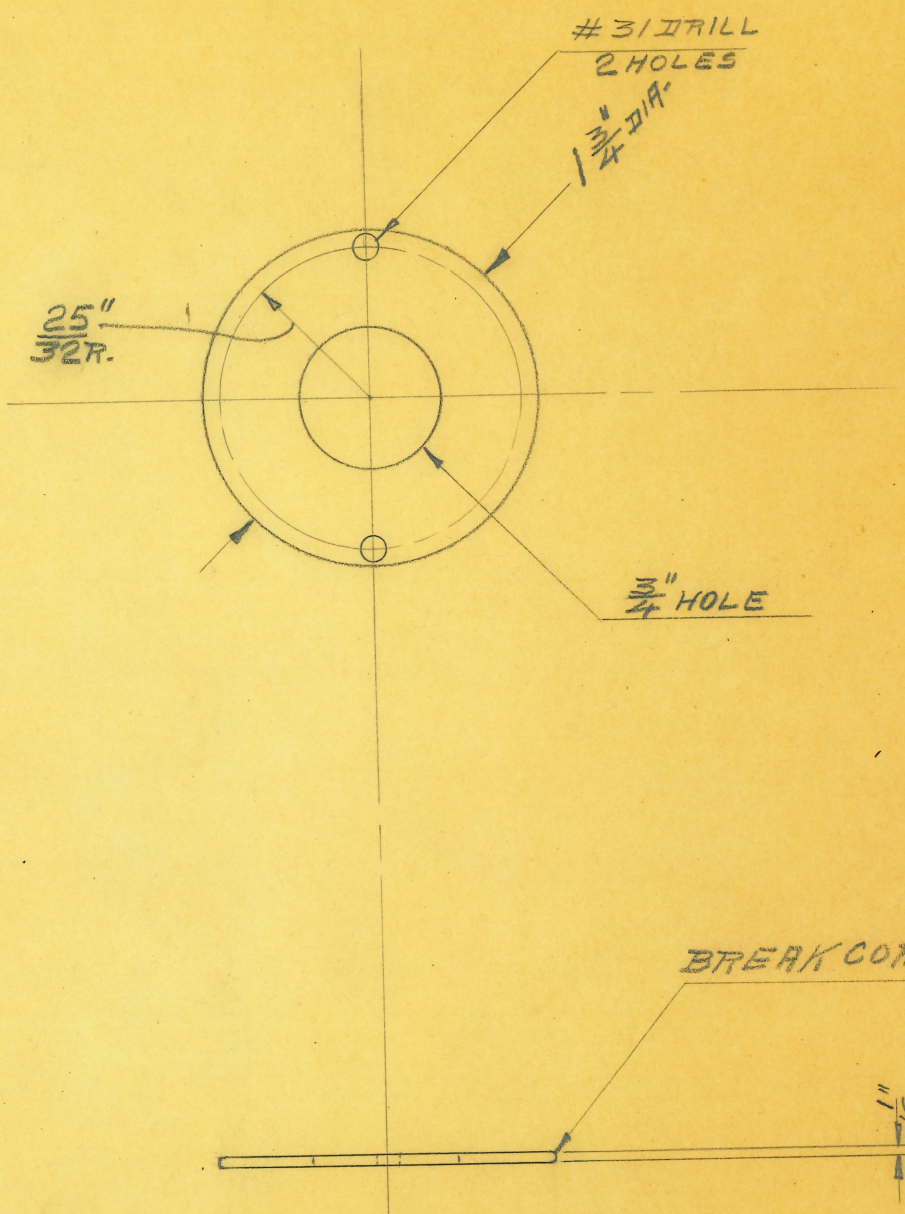

OBSOLETE

SIZE		ISSUE 11-22-26	EJ.
KIND	C.R. STEEL	CHANGED	
SHAPE		" "	
FINISH	B. ENAMEL	" "	
TEMP.		" "	
PATT.		" "	

TITLE: WAVE-GENERATOR
RHEO. BEAR. WASHER

H. G. FISCHER & CO.
2335 WABANSIA AVE.
CHICAGO, ILL.

CAT. NO.

PART NO. 5444

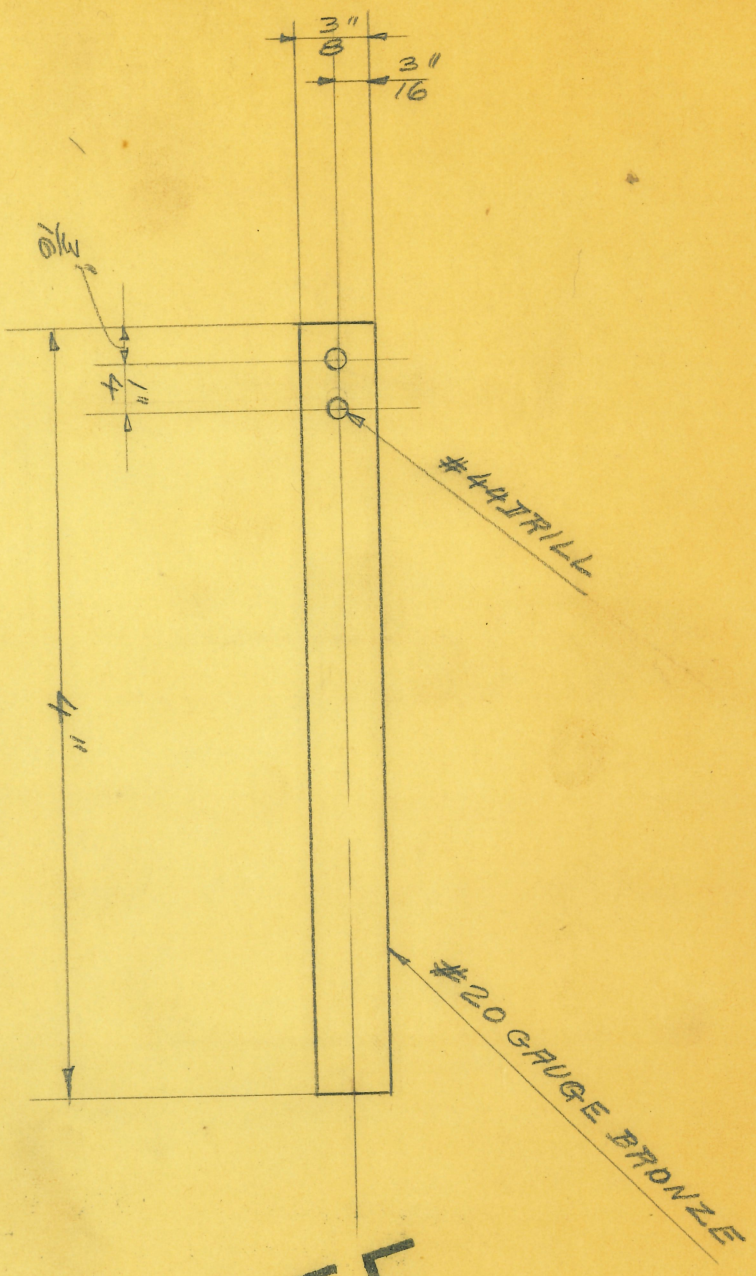

OBSOLETE

SIZE		ISSUE 12-17-26	DP	TITLE: WAVE-GENERATOR WORM GEAR COVER SPRING	
KIND	BRONZE	CHANGED			
SHAPE		" "			
FINISH		" "			
TEMP.		" "		H. G. FISCHER & CO. 2335 WABANSIA AVE. CHICAGO, ILL.	CAT. NO.
PATT.		" "			PART NO. 5448

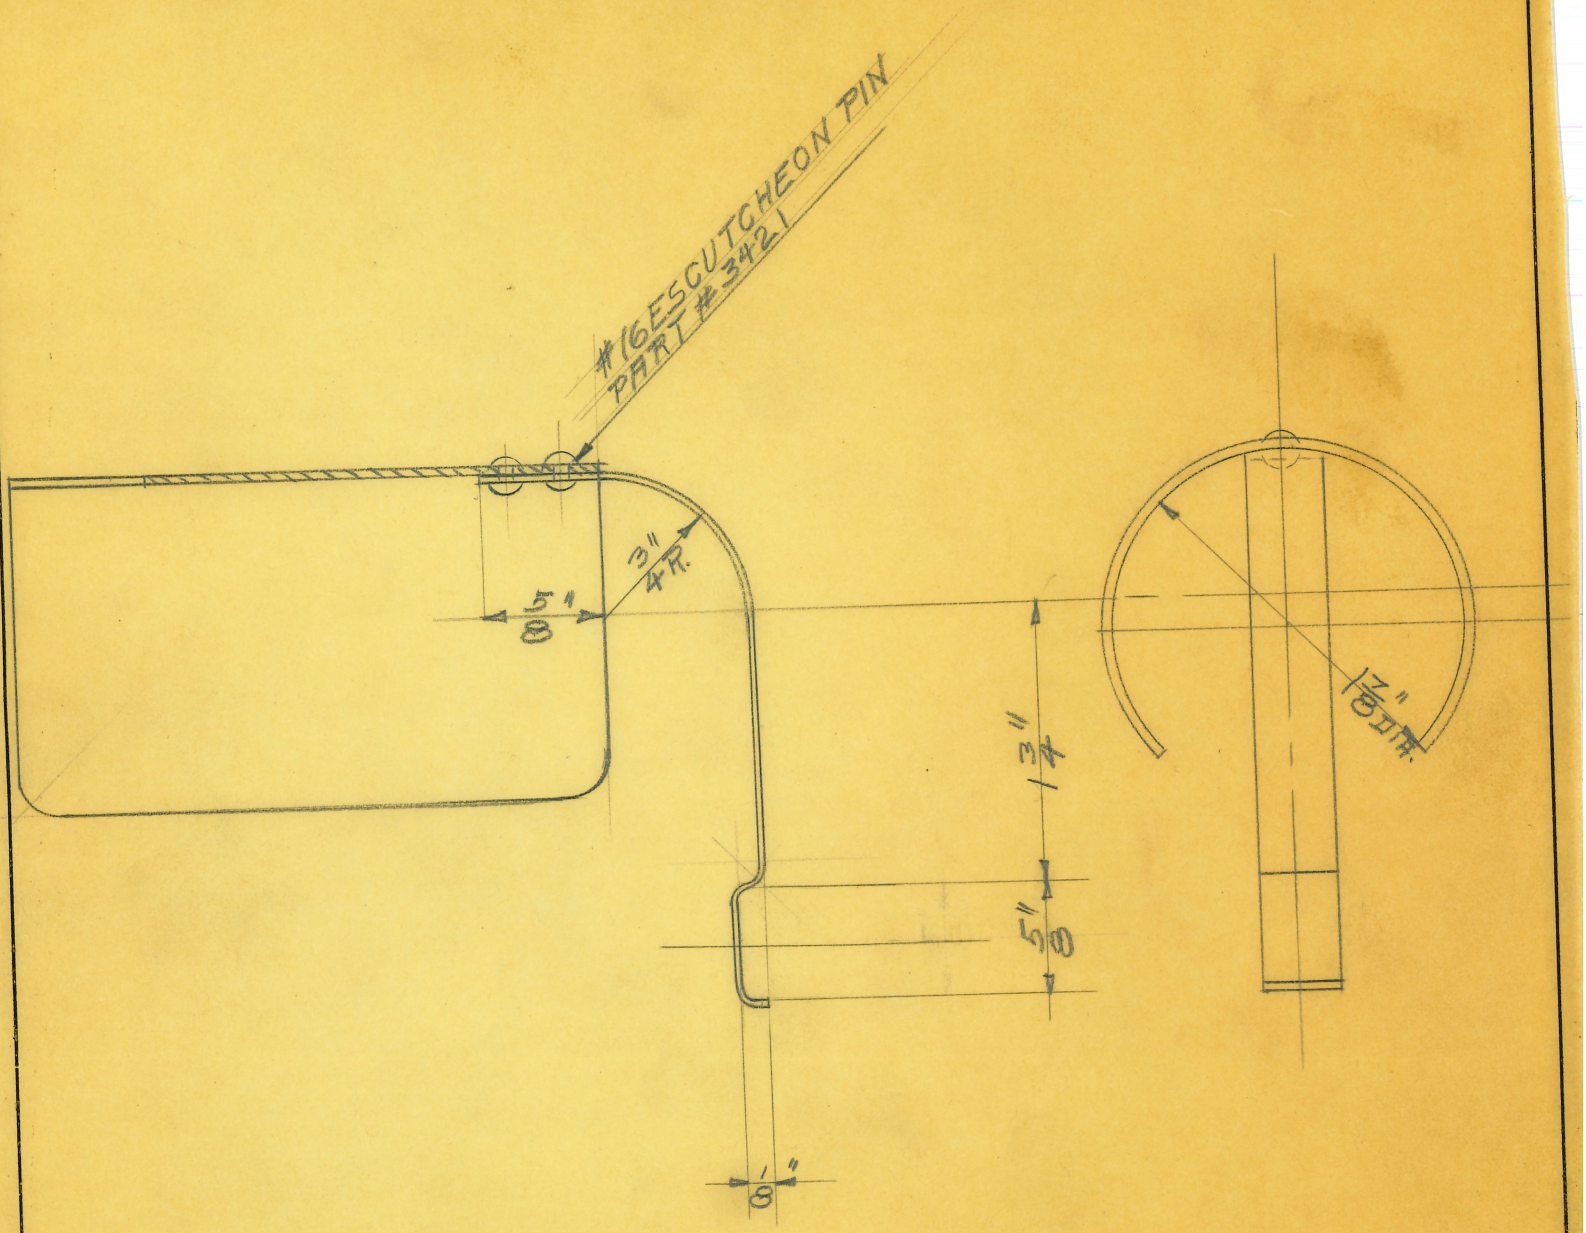

OBSOLETE

(1)

SIZE		ISSUE 12-17-26	EF	TITLE: WAVE-GENERATOR WORM GEAR COVER	
KIND		CHANGED			
SHAPE		" "			
FINISH		" "			
TEMP.		" "		H. G. FISCHER & CO. 2335 WABANSIA AVE. CHICAGO, ILL.	CAT. NO.
PATT.		" "			PART NO. 5447G

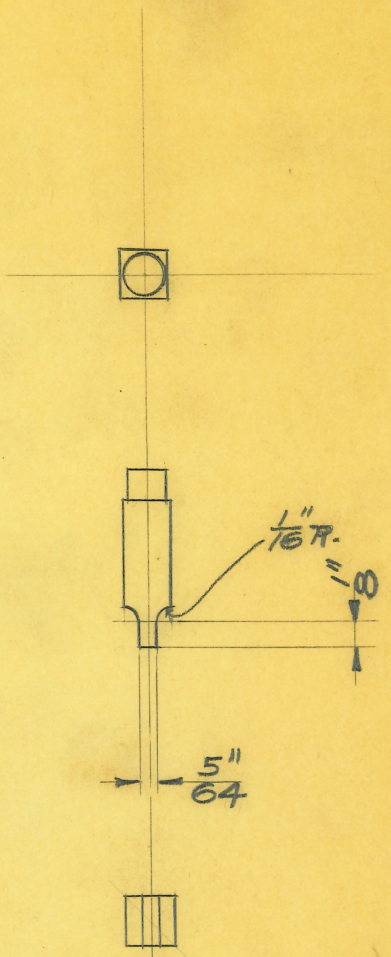

NOTE:
USE PART NO. 5445

OBSOLETE

SIZE		ISSUE 11-27-26		TITLE: WAVE-GENERATOR COMMUTATOR BRUSH (CARBON)	
KIND		CHANGED			
SHAPE		" "			
FINISH		" "			
TEMP.		" "		H. G. FISCHER & CO. 2335 WABANSIA AVE. CHICAGO, ILL.	CAT. NO.
PATT.		" "			PART NO. 5445 F.

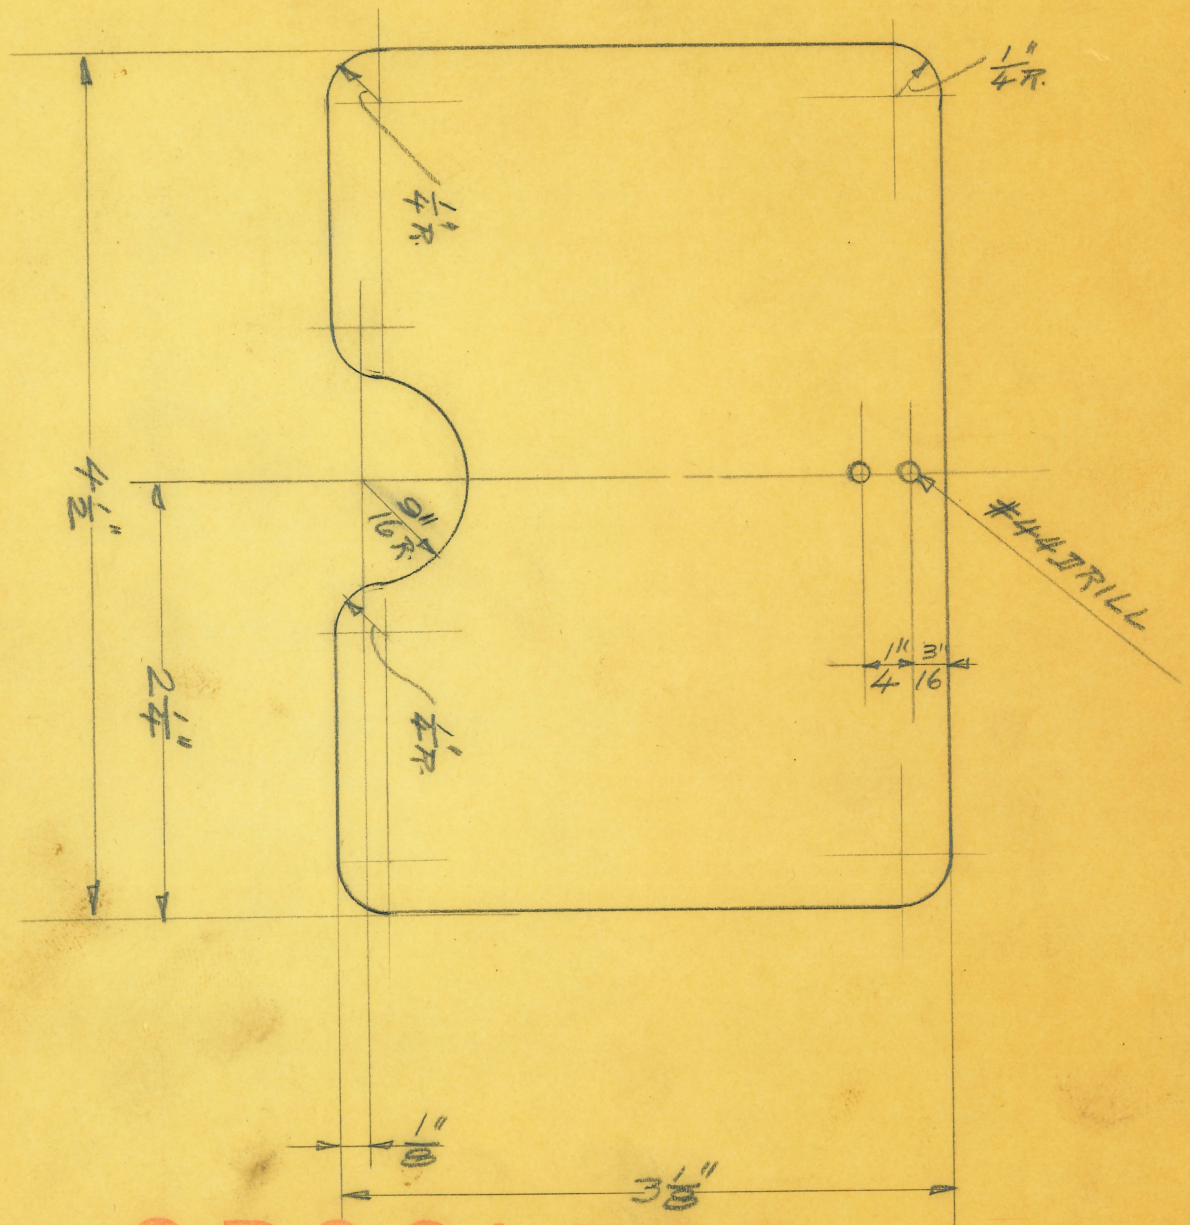

OBSOLETE

SIZE		ISSUE 12-17-26	CP.	TITLE: WAVE GENERATOR WORM GEAR COVER PLATE
KIND	.025 STEEL	CHANGED		
SHAPE		" "		
FINISH		" "		
TEMP.		" "		H. G. FISCHER & CO. 2335 WABANSIA AVE. CHICAGO, ILL. — CAT. NO. — PART NO. 5447
PATT.		" "		

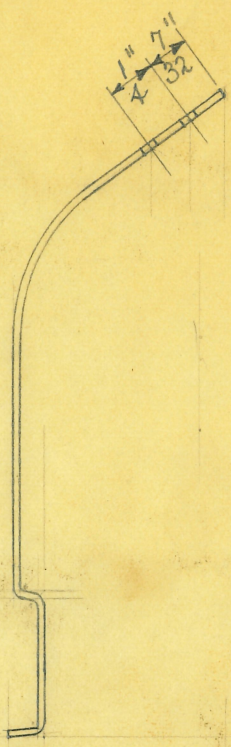

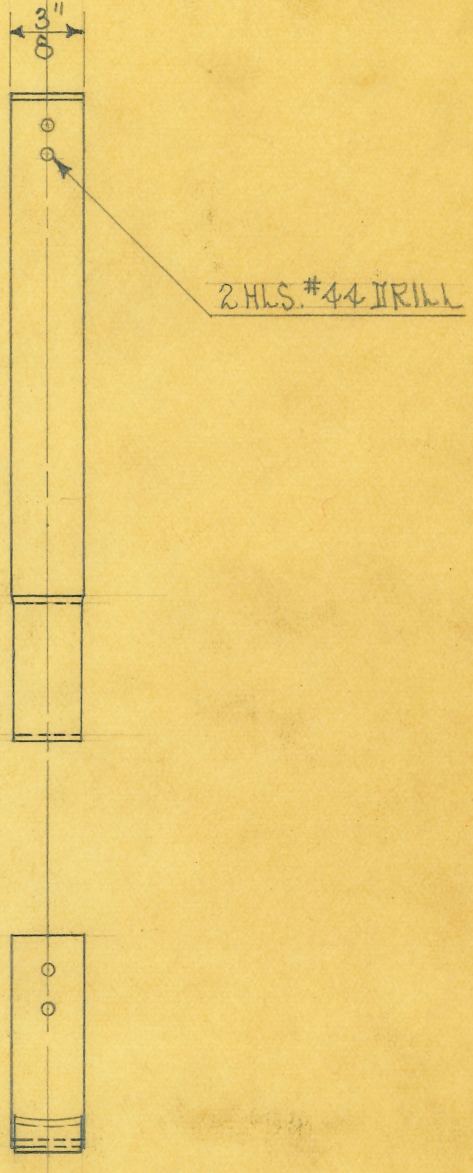

DEVELOPED LENGTH - 4"

BENDING FIXTURE

PEFORATING DIE #4491

FORMING DIE #4490

OBSOLETE

SIZE	#20 B.&S. GA.	ISSUE 10-21-32	H.E.	TITLE: WAVE GEN. WORM GEAR COVER SPRING
KIND	PHOS. BRONZE	CHANGED		
SHAPE		" "		
FINISH		" "		
TEMP.		" "		H. G. FISCHER & CO. 2335 WABANSIA AVE. CHICAGO, ILL. — CAT. NO. — PART NO. 5448
PATT.		" "		

NOTE:
DOUBLE SCALE

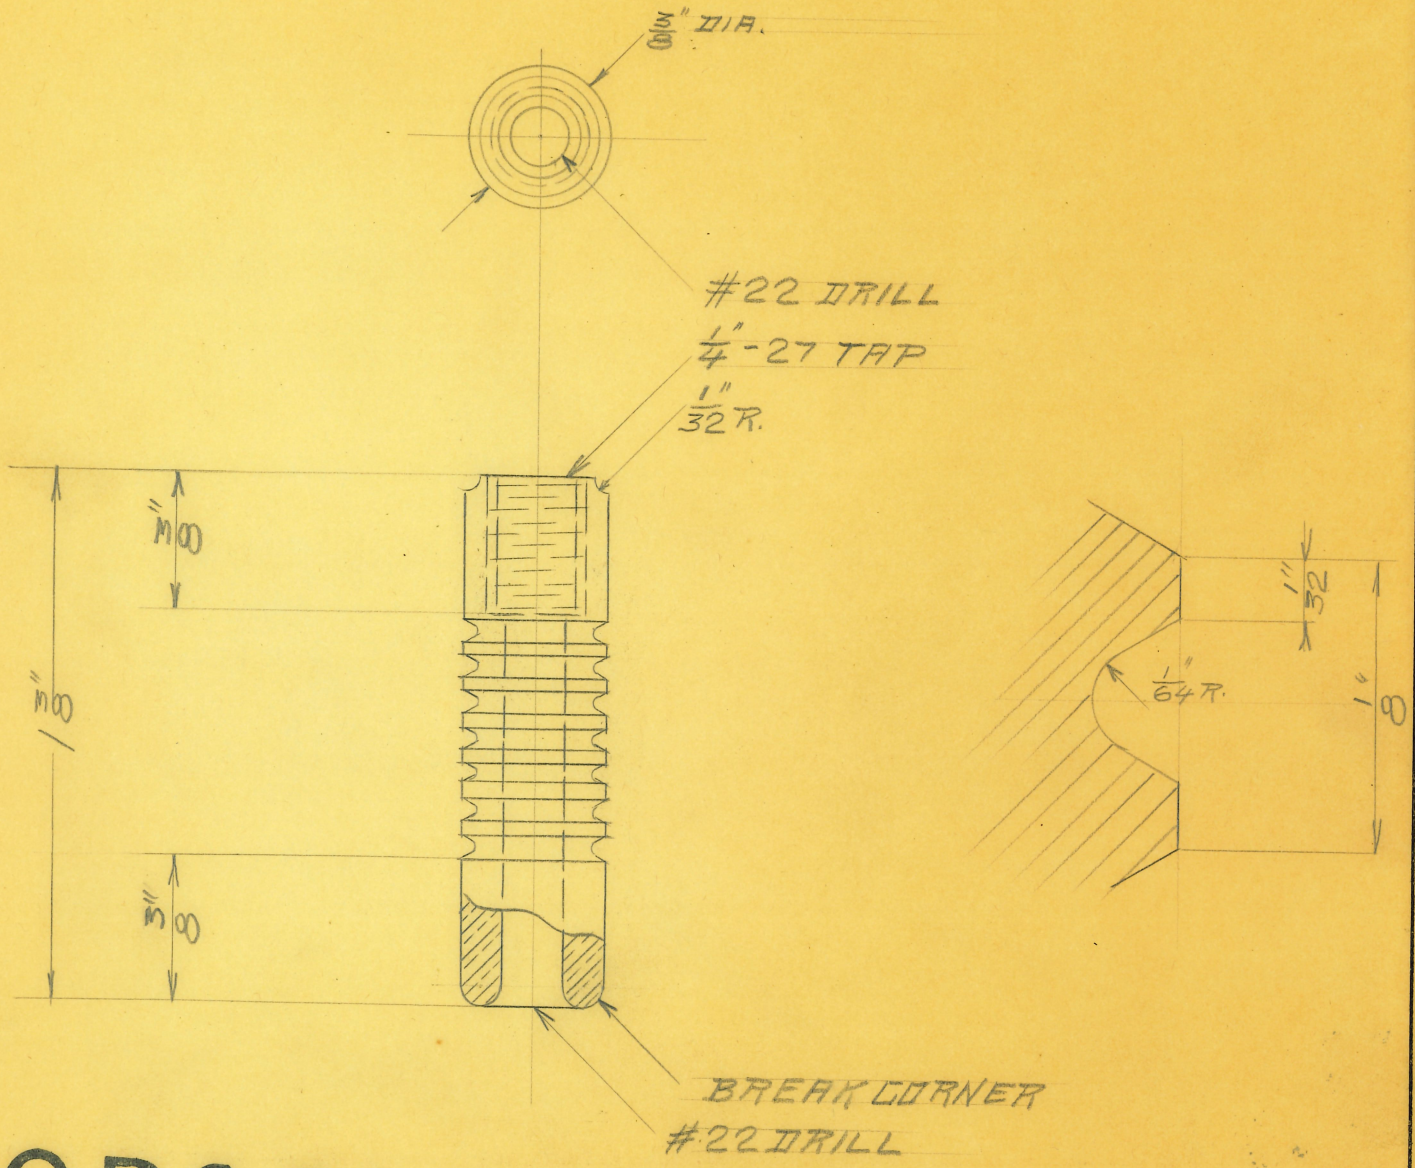

OBSOLETE

(2)

SIZE		ISSUE 9-10-26	CP.	TITLE: BATTERY-GALVANIC CORD TIP SLEEVE
KIND	H. RUBBER	CHANGED		
SHAPE		" "		
FINISH		" "		
TEMP.		" "		H. G. FISCHER & CO. 2335 WABANSIA AVE. CHICAGO, ILL. / CAT. NO. / PART NO. 5451
PATT.		" "		

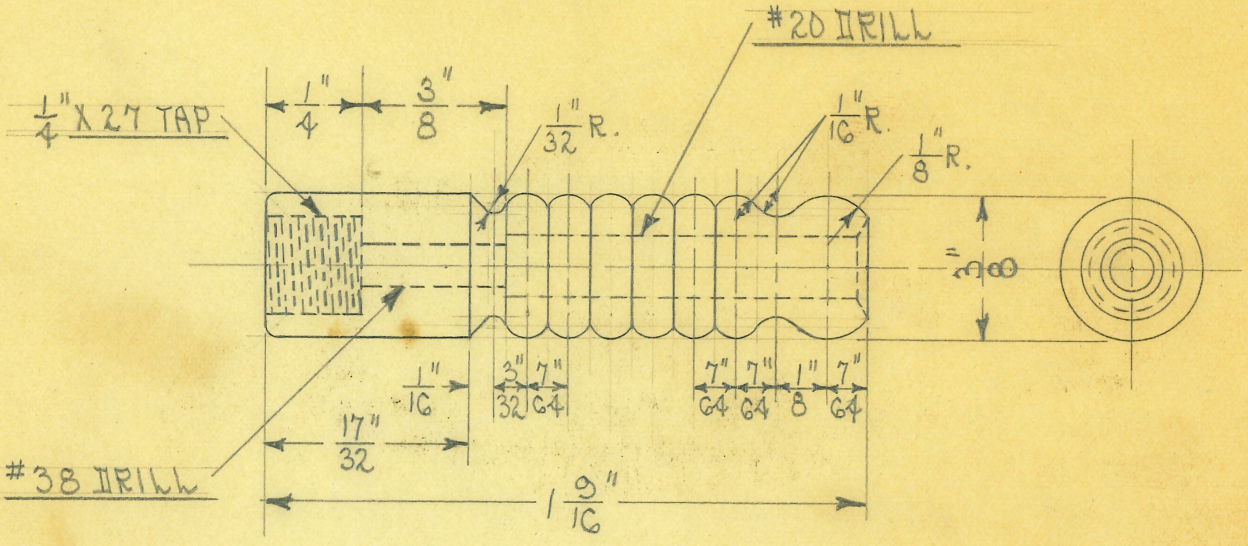

SCALE ~ 2 DIAMETERS

OBSOLETE

SIZE	3/8"	ISSUE 5-16-32	A.E.	TITLE: PORT. BATT. GAL. GEN. CORD TIP SLEEVE
KIND	POL. RUB. ROD	CHANGED		
SHAPE		" "		
FINISH		" "		
TEMP.		" "		H. G. FISCHER & CO. 2335 WABANSIA AVE. CHICAGO, ILL. / CAT. NO. / PART NO. 5451
PATT.		" "		

NOTE:
DOUBLE SCALE

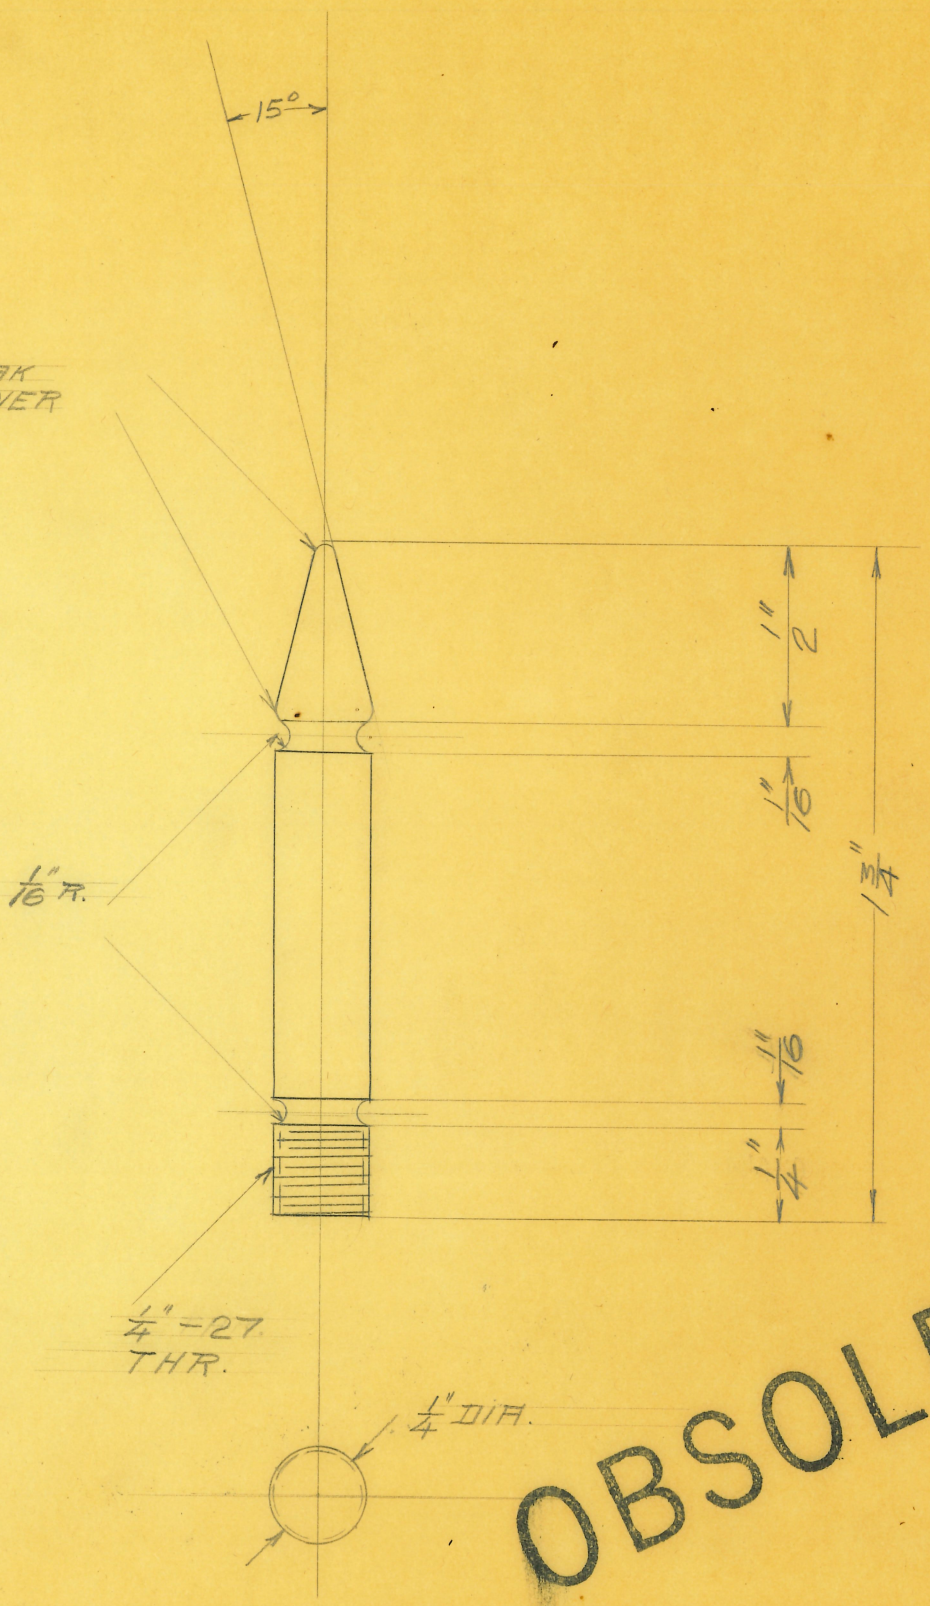

OBSOLETE

(2)

SIZE		ISSUE 9-10-26	EP.
KIND	BRASS	CHANGED	
SHAPE		" "	
FINISH	N.P	" "	
TEMP.		" "	
PATT.		" "	

TITLE: BATTERY - GALVANIC CORD TIP

H. G. FISCHER & CO.
2335 WABANSIA AVE.
CHICAGO, ILL.

CAT. NO.

PART NO. 5452

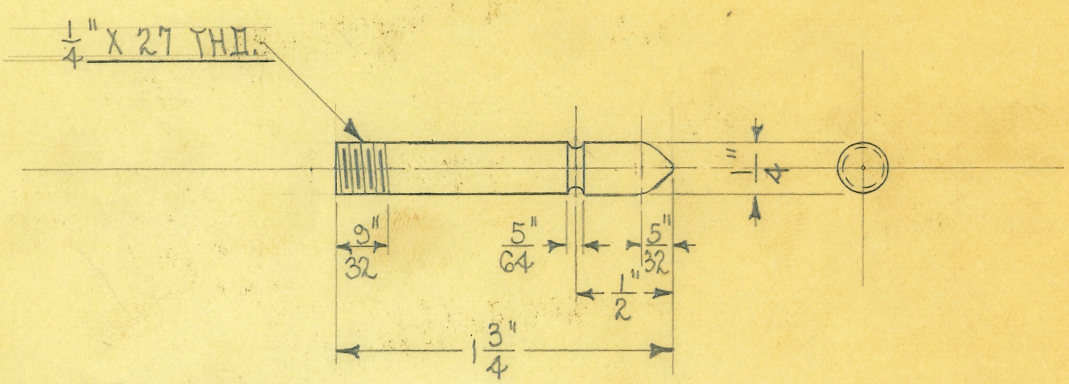

OBSOLETE

SIZE	1/4"	ISSUE 5-14-32	
KIND	BRASS ROD	CHANGED	
SHAPE		" "	
FINISH	W.P.	" "	
TEMP.		" "	
PATT.		" "	

TITLE: PORT. BATT. GAL. GEN. CORD TIP

H. G. FISCHER & CO.
2335 WABANSIA AVE.
CHICAGO, ILL.

CAT. NO.

PART NO. 5452

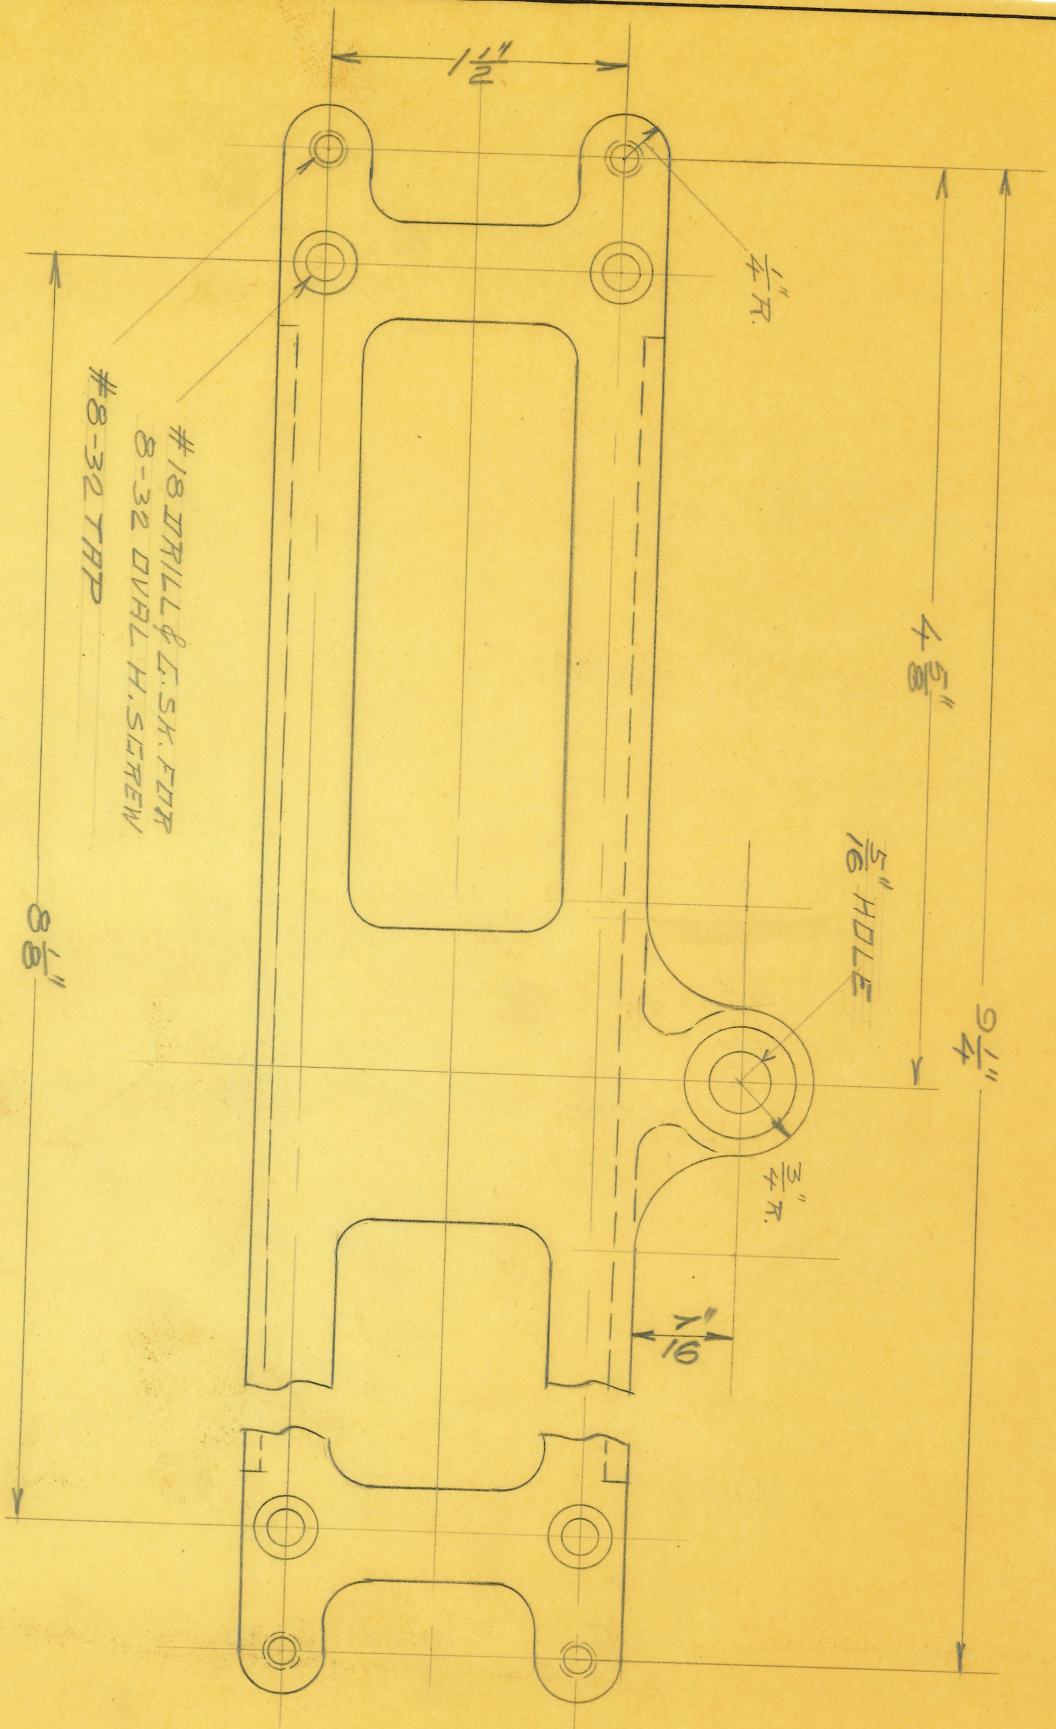

OBSOLETE

(1)

SIZE	CASTING	ISSUE 10-26	EP
KIND	BRASS	CHANGED	
SHAPE		" "	
FINISH	W.R	" "	
TEMP.		" "	
CATT.	333-9210	" "	

TITLE:

BATTERY - GALVANIC

RHEOSTAT SUPPORT CATING

H. G. FISCHER & CO.
2335 WABANSIA AVE.
CHICAGO, ILL.

CAT. NO.

PART NO. 5454 F.

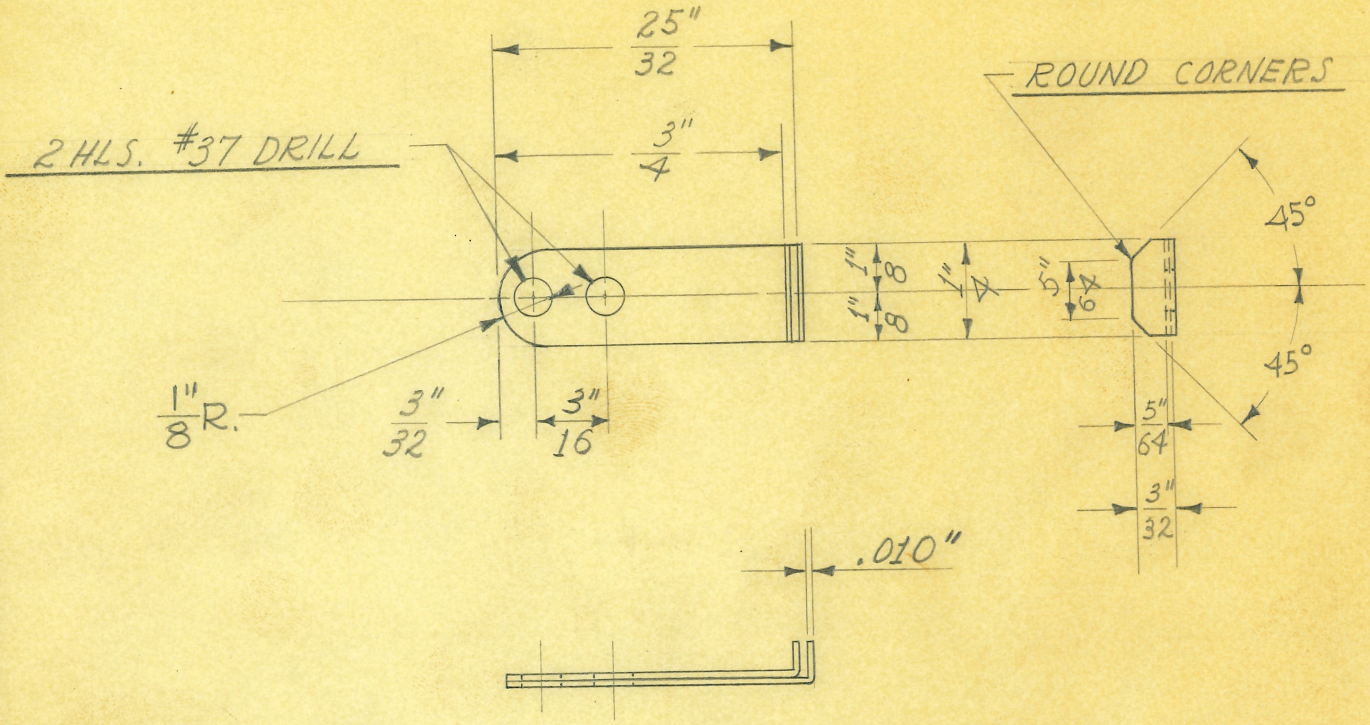

SCALE ÷ DOUBLE SIZE

6 REQUIRED

OBSOLETE

SIZE	.010" X 250"	ISSUE 10-25-37	J.W.
KIND	SHEET BRONZE	CHANGED 3-5-41	J.V.W.
SHAPE		"	
FINISH		"	
TEMP.		"	
PATT.		"	

TITLE: WAVE GENERATOR SELECTOR SWITCH CONTACT SET (2)

H. G. FISCHER & CO.
2335 WABANSIA AVE.
CHICAGO, ILL.

CAT. NO.

PART NO. 5463GA

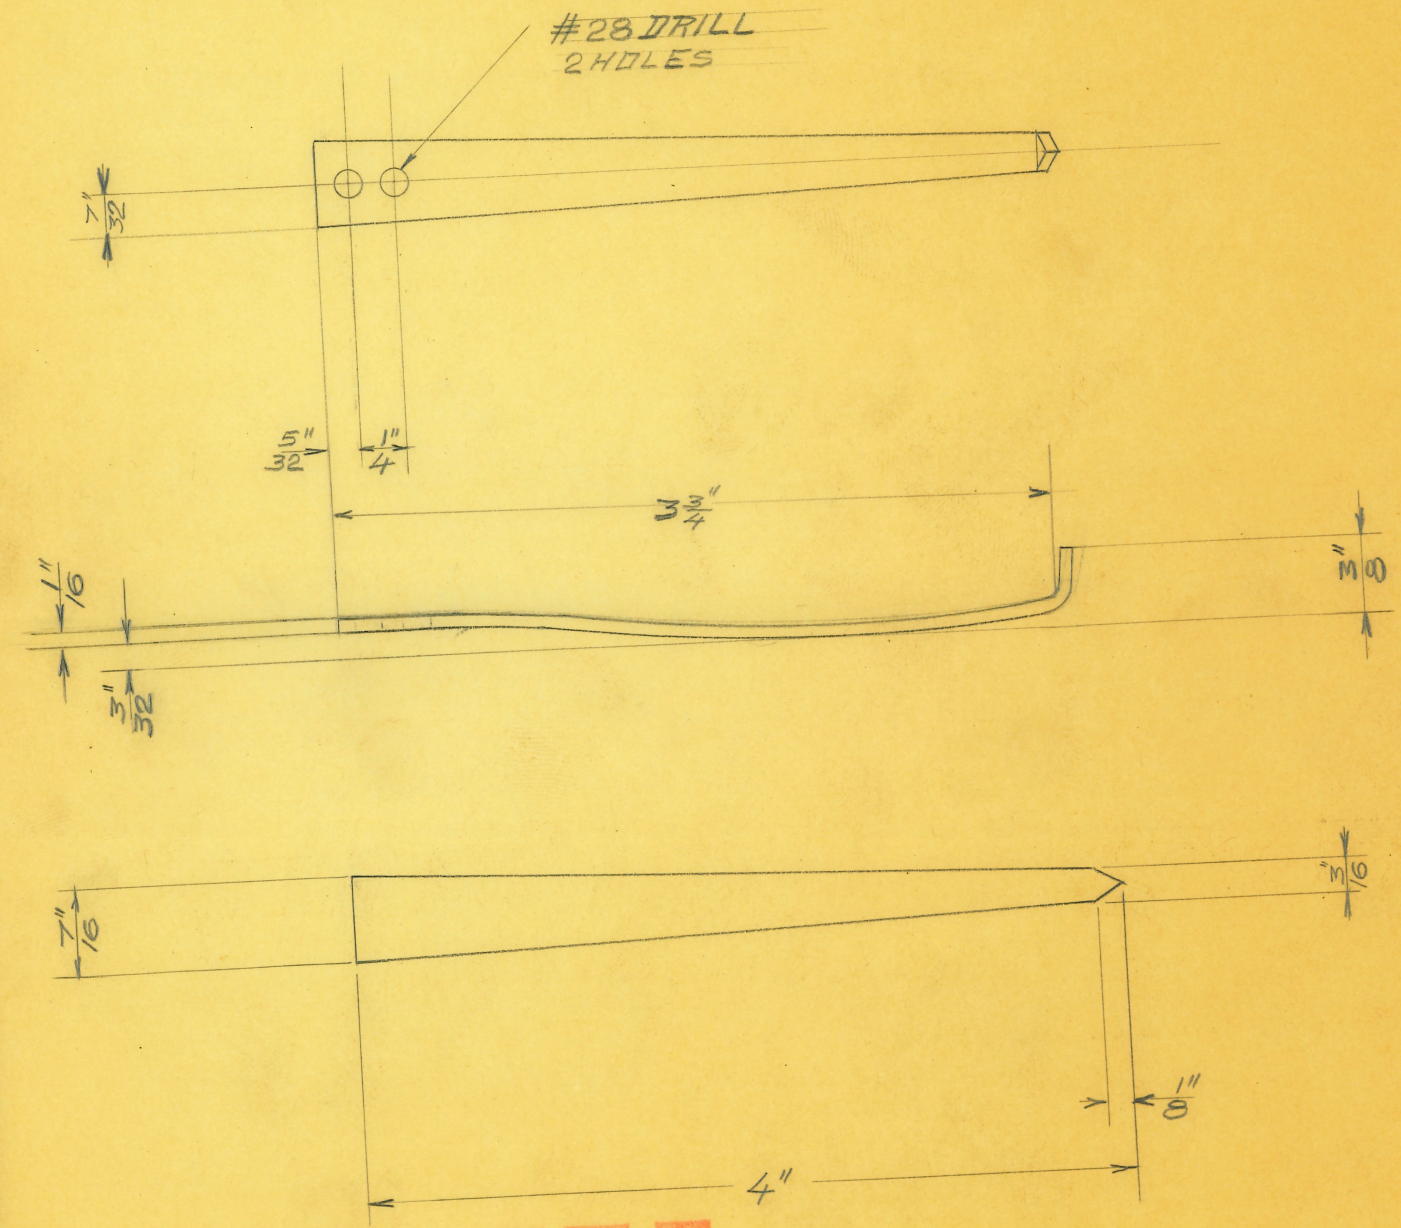

OBSOLETE

SIZE		ISSUE 10-1-26	E.P.
KIND	BRASS	CHANGED	
SHAPE		" "	
FINISH	N.P.	" "	
TEMP.		" "	
PATT.		" "	

TITLE: BATTERY - GALVANIC INICATOR POINT

H. G. FISCHER & CO.
2335 WABANSIA AVE.
CHICAGO, ILL.

CAT. NO.

PART NO. 5469

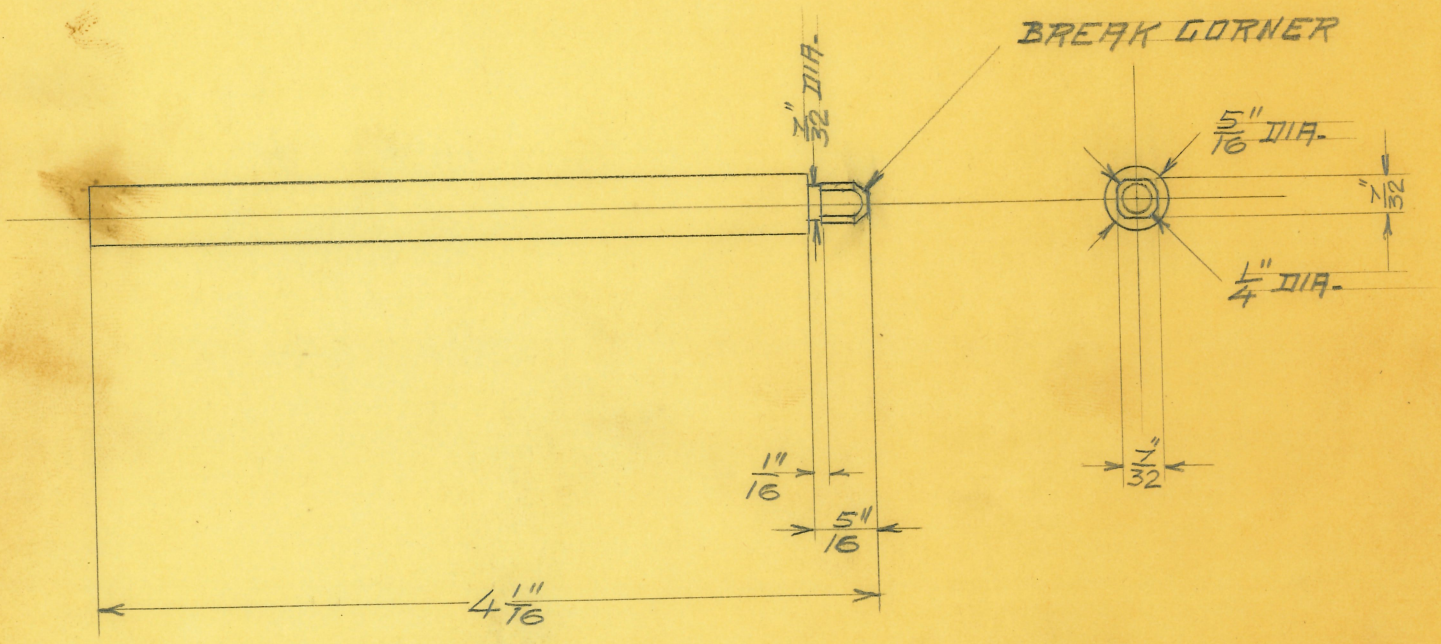

OBSOLETE

(1)

SIZE		ISSUE 10-1-26	EP
KIND	BRASS	CHANGED	
SHAPE		" "	
FINISH		" "	
TEMP.		" "	
PATT.		" "	

TITLE: BATTERY-GALVANIC INDICATOR SHAFT

H. G. FISCHER & CO.
2335 WABANSIA AVE.
CHICAGO, ILL.

CAT. NO.

PART NO. 5470

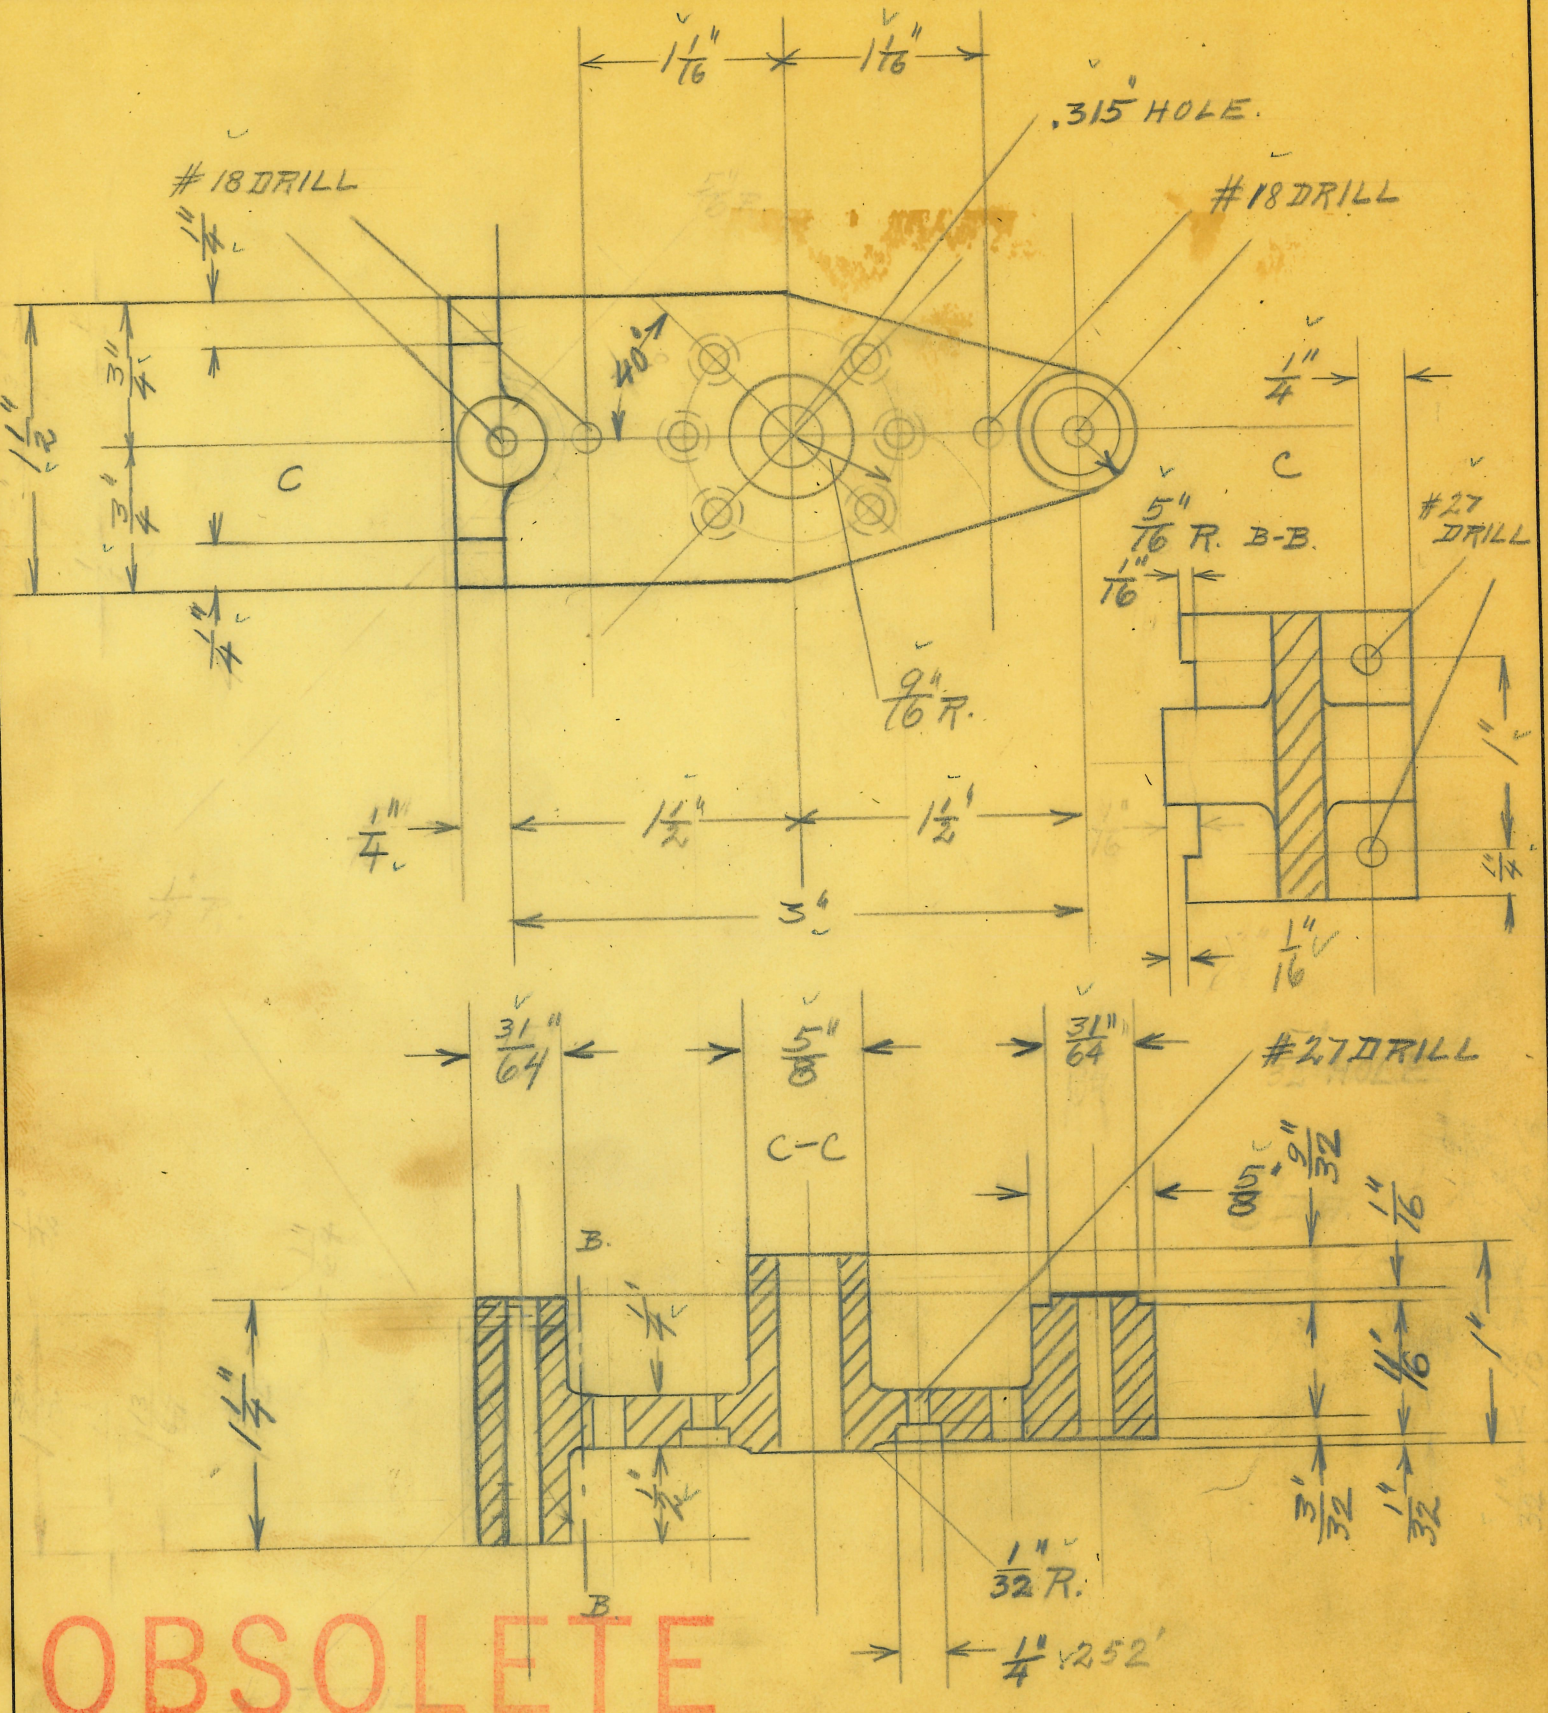

OBSOLETE

SIZE		ISSUE 4-19-26		TITLE: BASE FOR POLARITY-SWITCH	
KIND	BAKELITE	CHANGED 4-26-26			
SHAPE		" "			
FINISH		" "			
TEMP.		" "		H. G. FISCHER & CO. 2335 WABANSIA AVE. CHICAGO, ILL.	CAT. NO.
PATT.		" "			PART NO. 5471

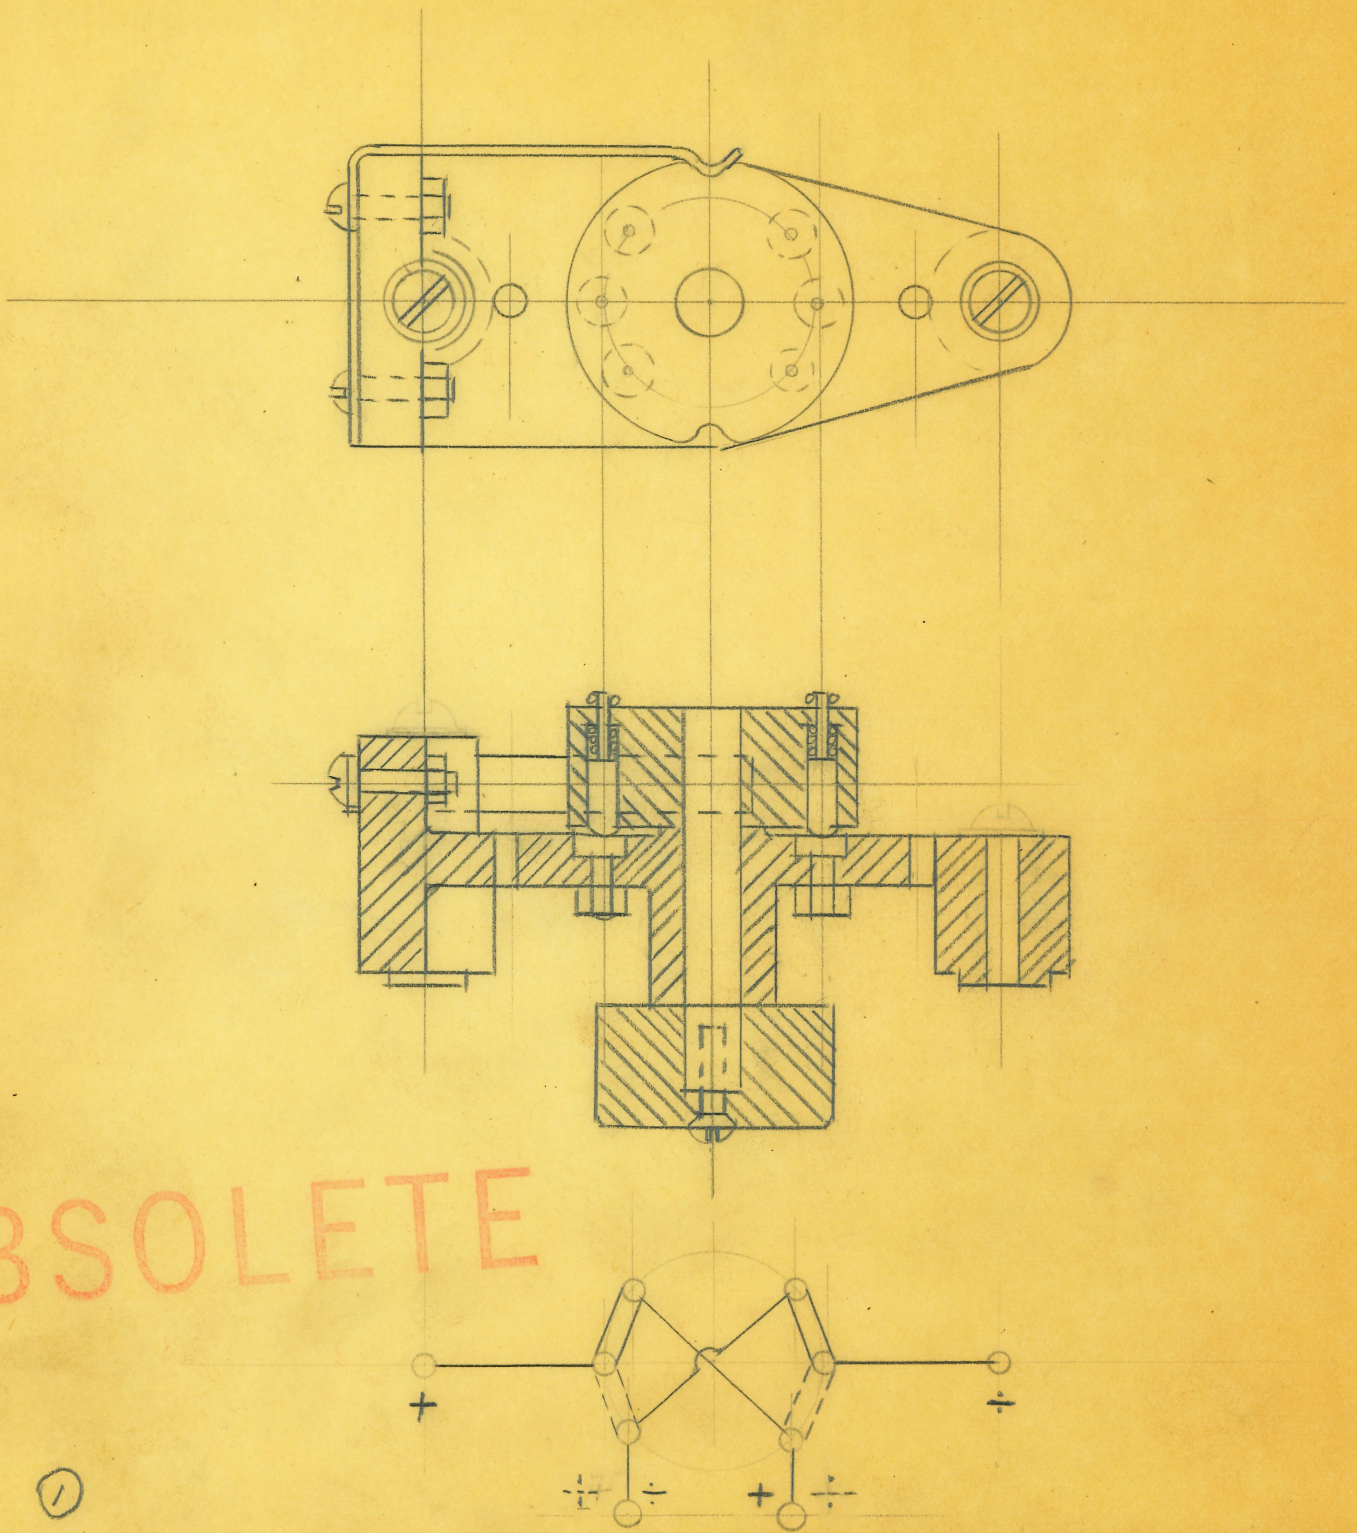

OBSOLETE

(1)

SIZE		ISSUE 7-15-26	C.	TITLE: ASSEMBLY OF POLARITY-SWITCH
KIND		CHANGED		
SHAPE		" "		
FINISH		" "		
TEMP.		" "		H. G. FISCHER & CO. 2335 WABANSIA AVE. CHICAGO, ILL. — CAT. NO. — PART NO. 5471G
PATT.		" "		

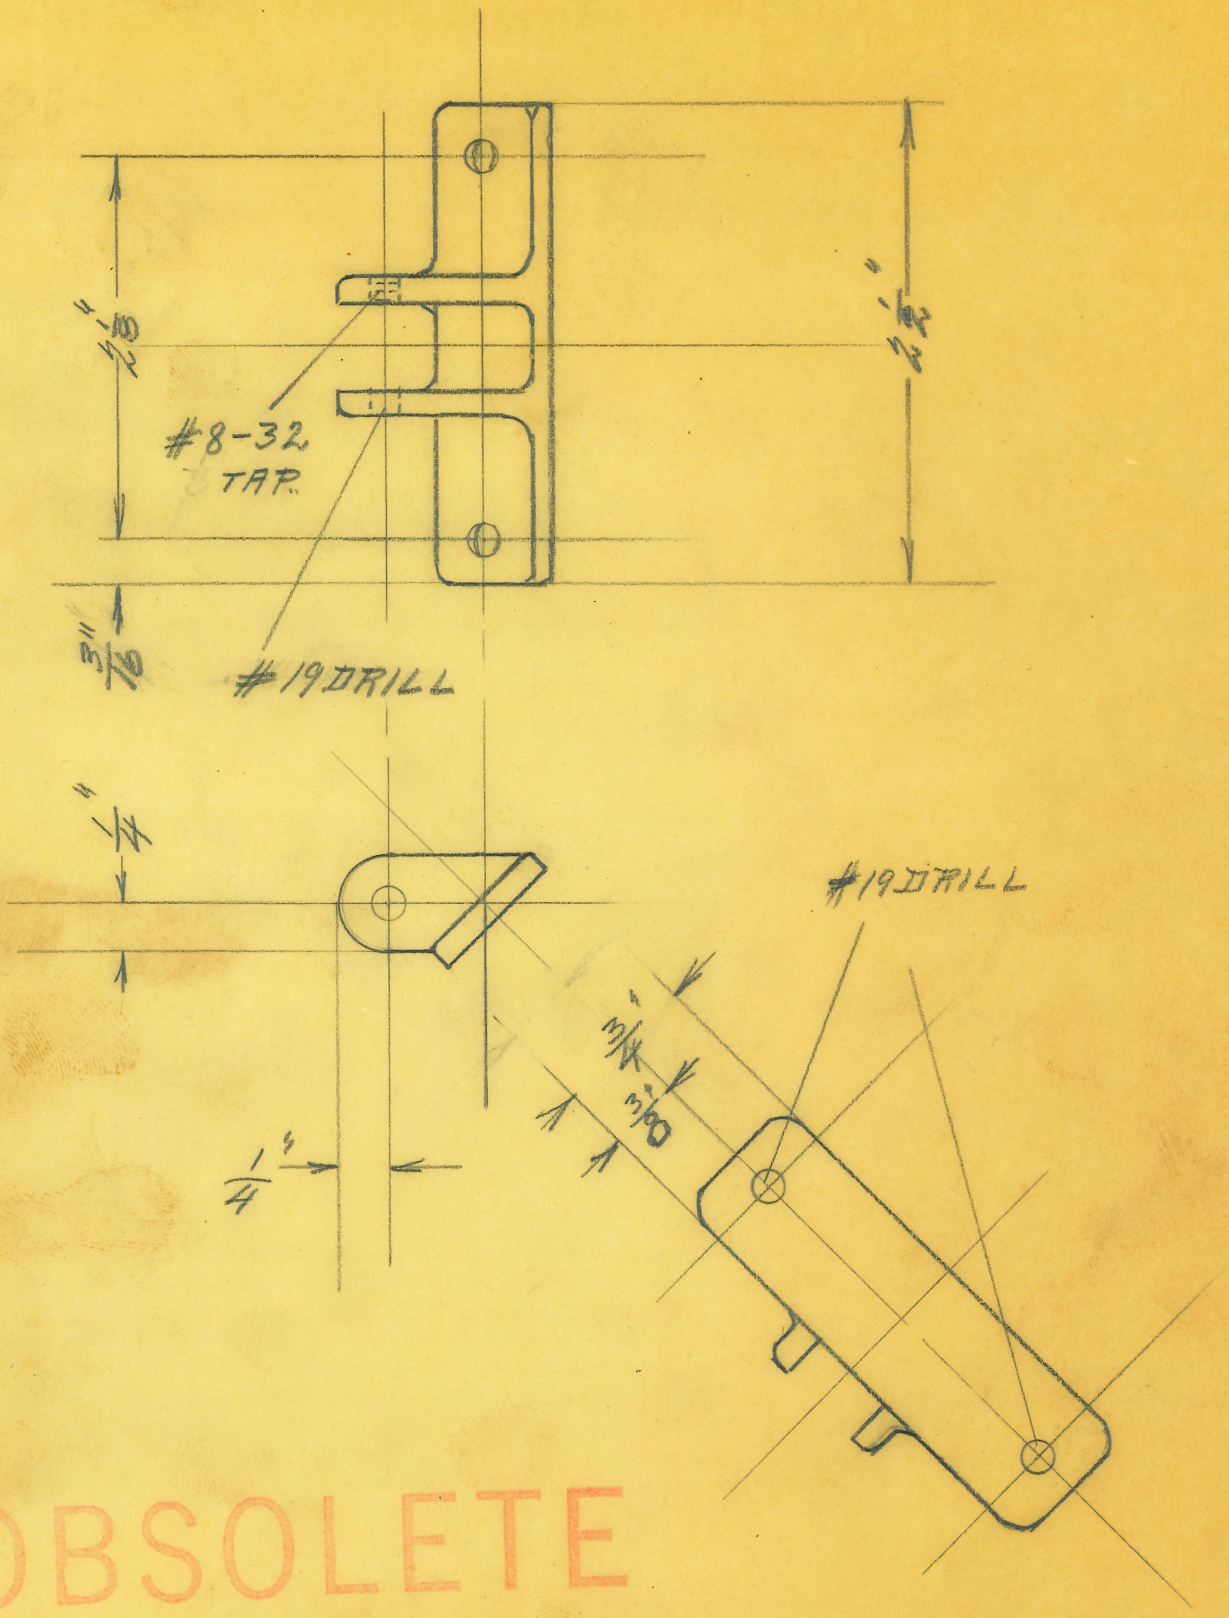

OBSOLETE

SIZE		ISSUE 4-22-26	C.	TITLE: ROLLER SUPPORT FOR WALL LAMP.	
KIND	BRASS	CHANGED			
SHAPE		" "			
FINISH	CRYSTAL. E.	" "			
TEMP.		" "		H. G. FISCHER & CO. 2335 WABANSIA AVE. CHICAGO, ILL.	CAT. NO.
PATT.		" "			PART NO. 5701.

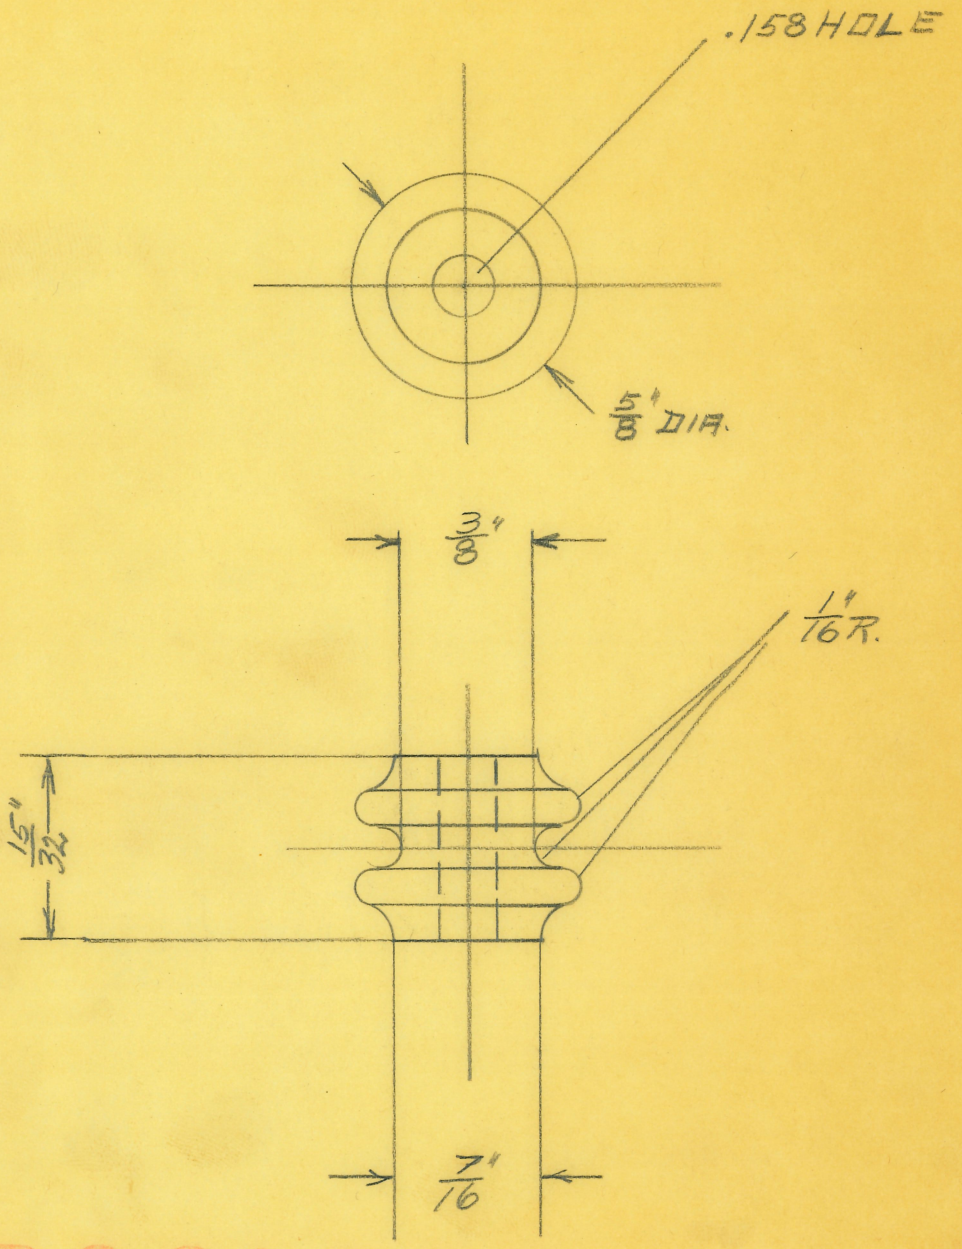

OBSOLETE

SIZE		ISSUE 4-22-26	C.
KIND	BRASS	CHANGED	
SHAPE		" "	
FINISH		" "	
TEMP.	WHITEN	" "	
PATT.		" "	

TITLE: ROLLER FOR WALL LAMP.

H. G. FISCHER & CO.
2335 WABANSIA AVE.
CHICAGO, ILL.

CAT. NO.

PART NO. 5702.

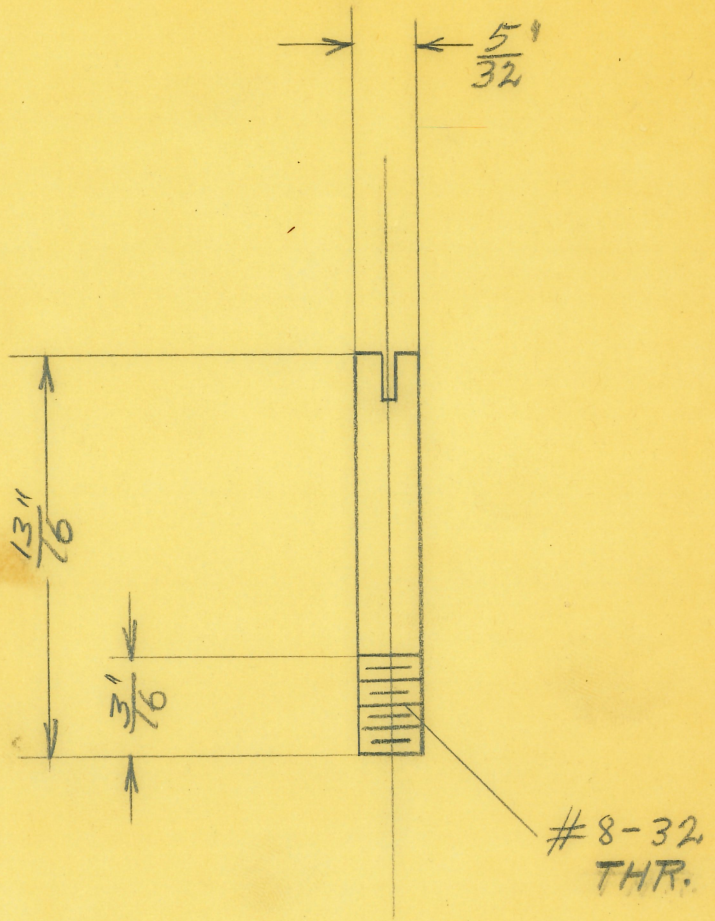

OBSOLETE

SIZE		ISSUE 4-22-26	C.	TITLE: SHAFT FOR ROLLER. WALL LAMP		
KIND	BRASS	CHANGED				
SHAPE		" "				
FINISH	WHITEN	" "				
TEMP.		" "		H. G. FISCHER & CO. 2335 WABANSIA AVE. CHICAGO, ILL.	CAT. NO.	PART NO. 5703
PATT.		" "				

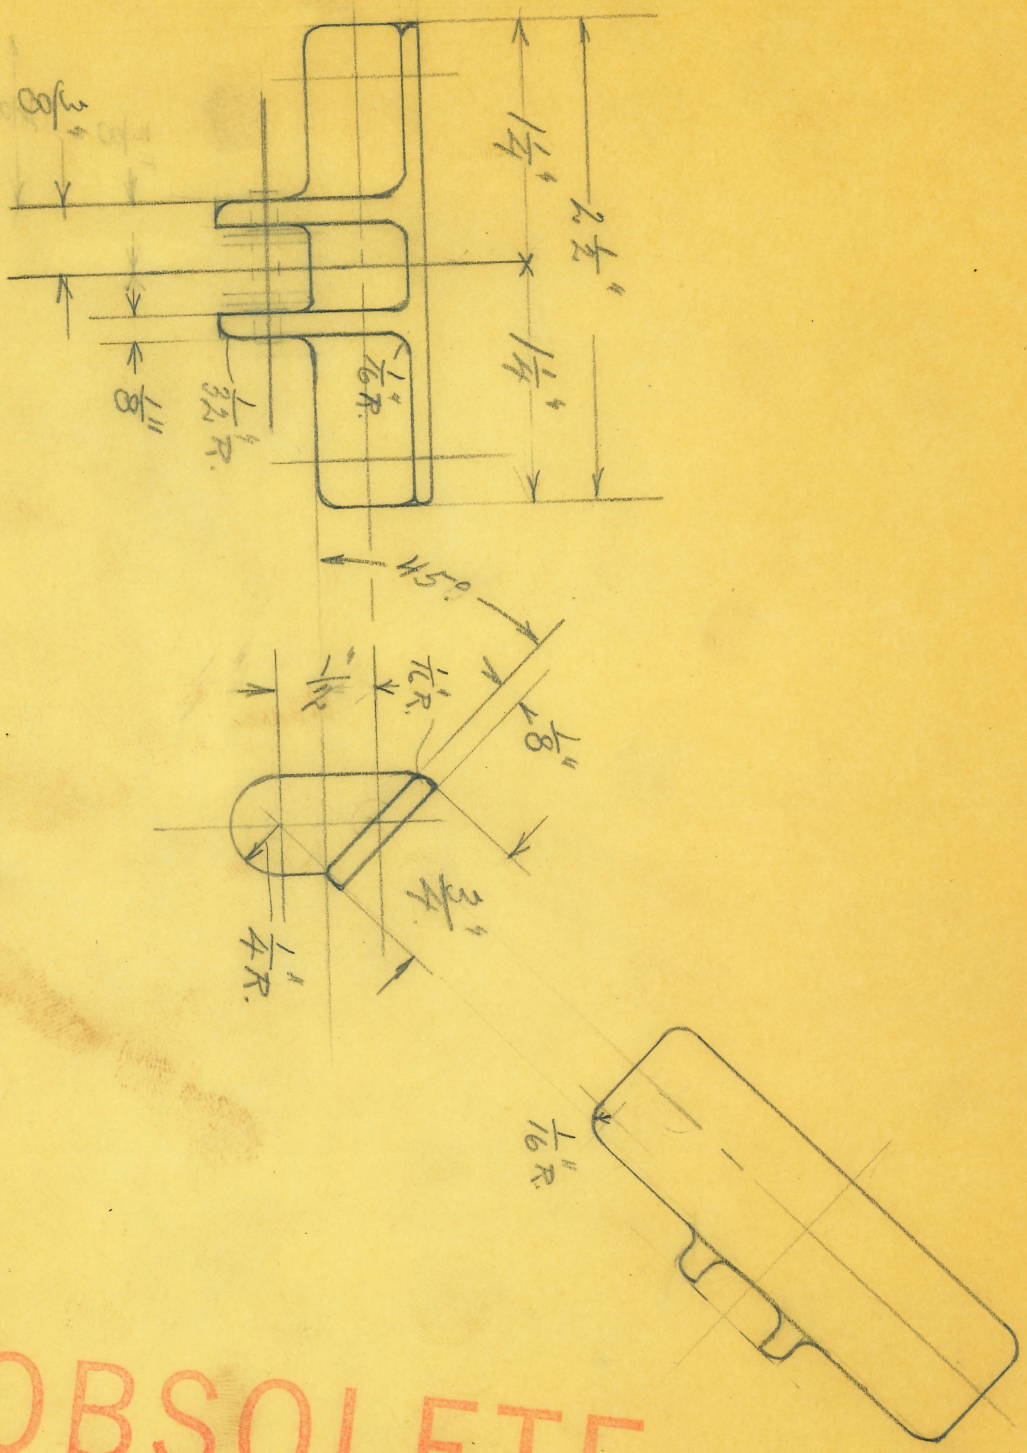

OBSOLETE

SIZE		ISSUE F. 126-26 C.P.	TITLE: ROLLER SUPPORT FOR WALL LAMP.		
KIND	BRASS.	CHANGED			
SHAPE		" "			
FINISH		" "			
TEMP.		" "	H. G. FISCHER & CO. 2335 WABANSIA AVE. CHICAGO, ILL.	CAT. NO.	PART NO. 5704
PATT.	WOOD	" "			

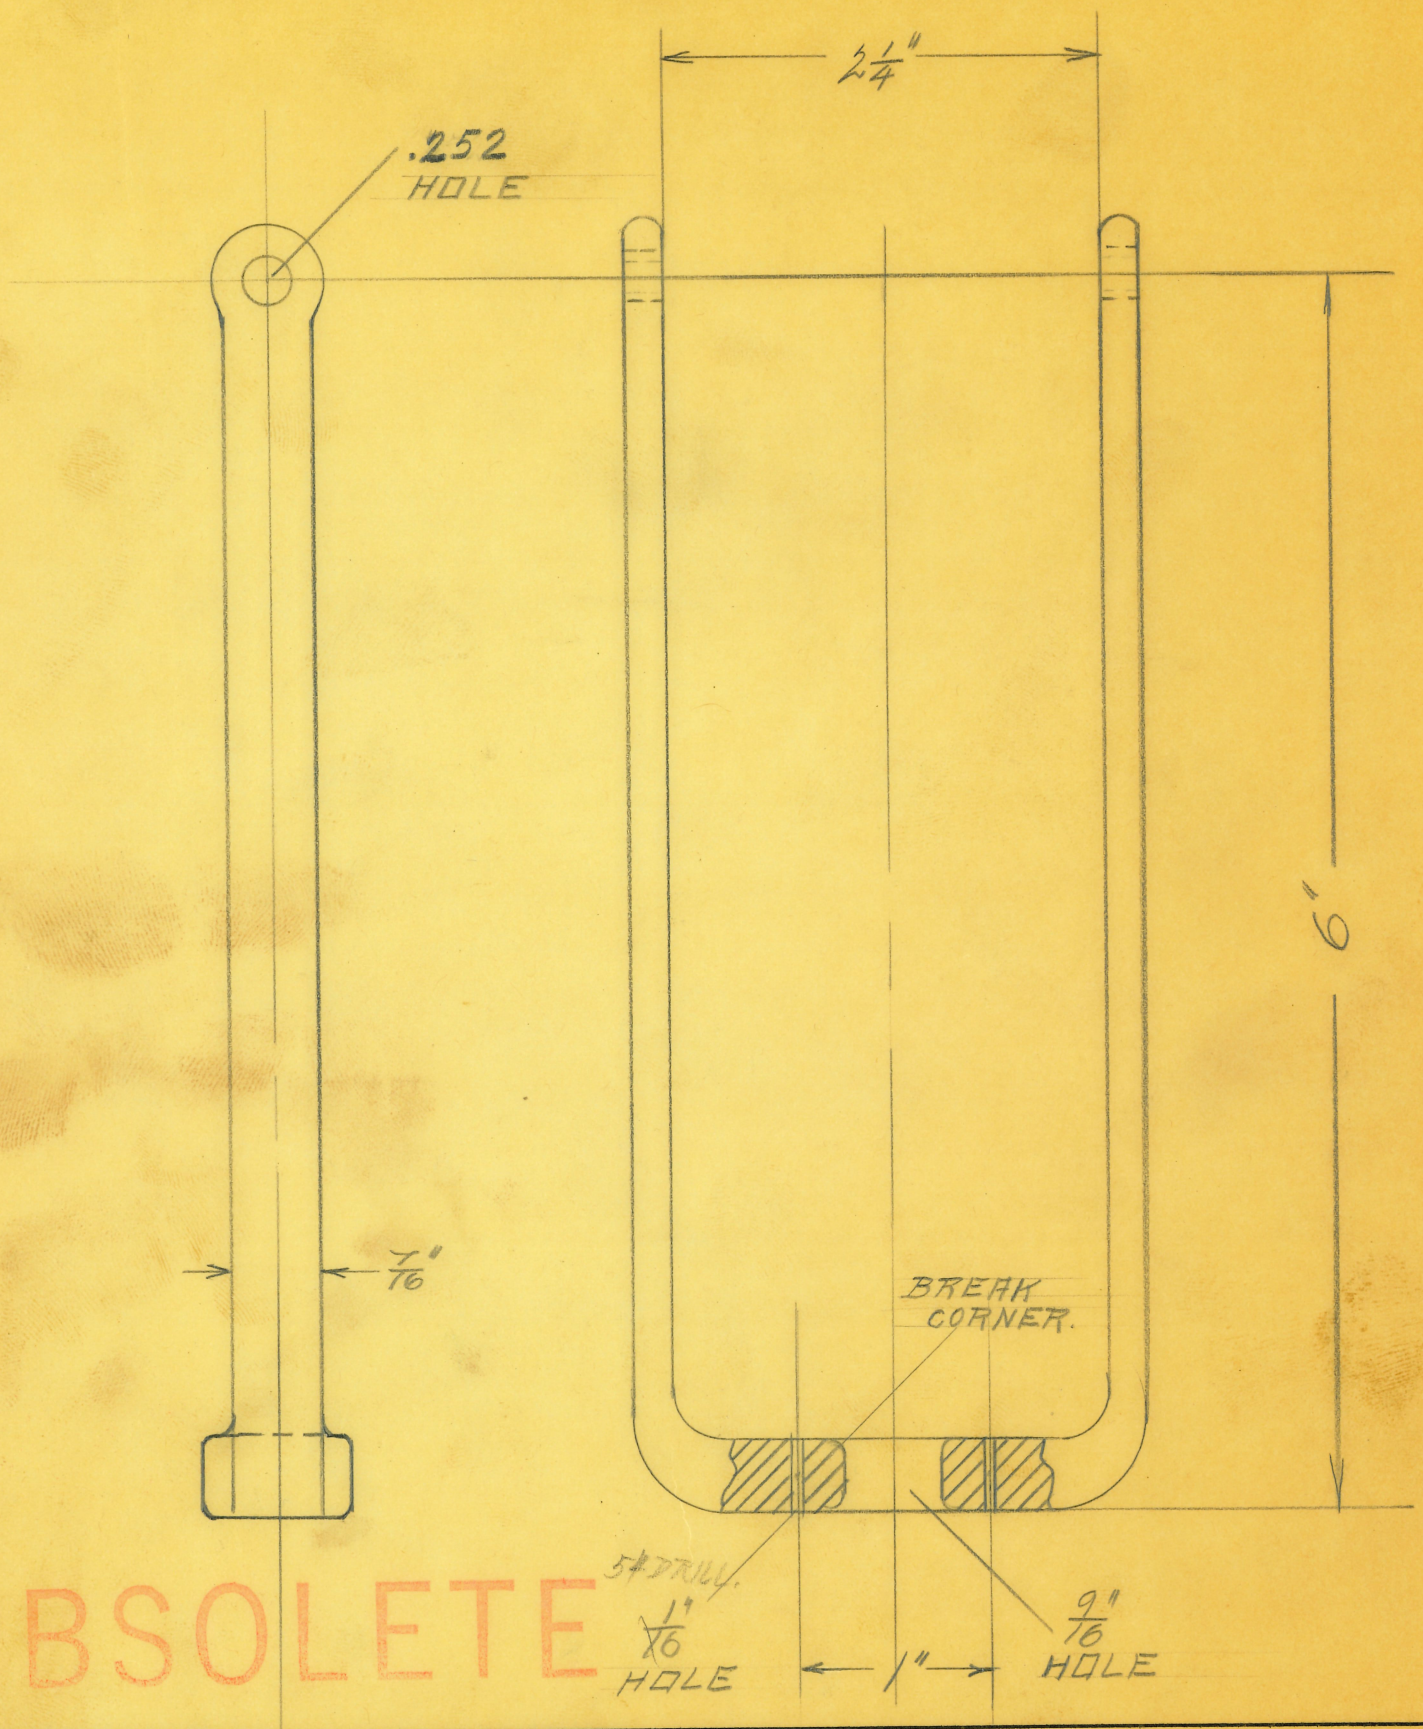

OBSOLETE

SIZE		ISSUE 4-23-26	E.
KIND	BRASS	CHANGED	
SHAPE		" "	
FINISH	CRYSTAL E.	" "	
TEMP.		" "	
PATT.		" "	

TITLE: STOPSOKE FOR WALL LAMP.

H. G. FISCHER & CO.
2335 WABANSIA AVE.
CHICAGO, ILL.

CAT. NO.

PART NO. 5704.F

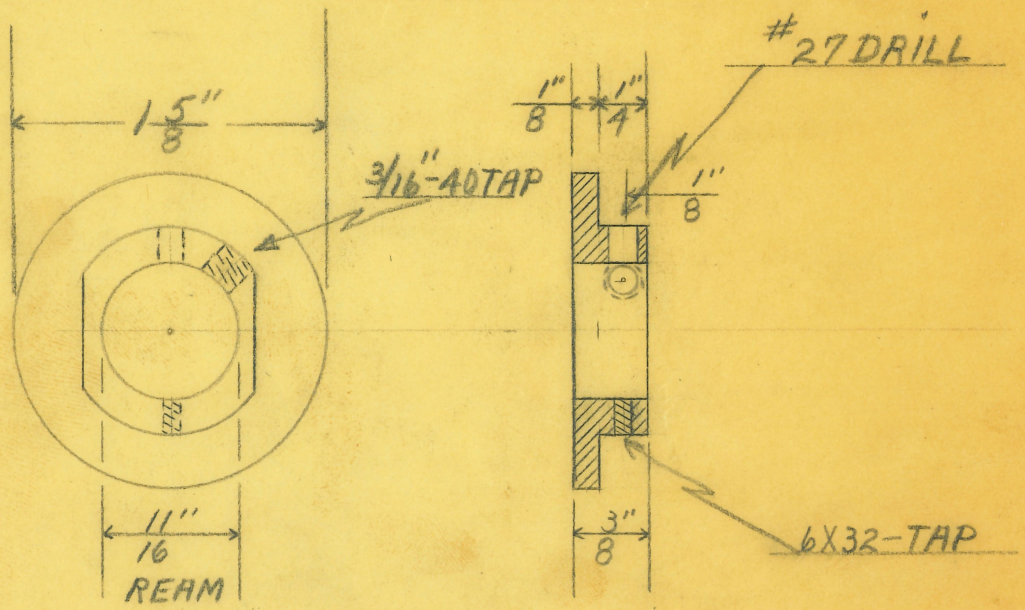

OBSOLETE

This drawing has been retraced

SIZE		ISSUE		TITLE: WAVE-GEN. COLLECTOR-RING-SHAFT-FLANGE FROM-5608		
KIND	CAST-IRON	CHANGED				
SHAPE		" "				
FINISH	BLK-JAPAN	" "				
TEMP.		" "		H. G. FISCHER & CO. 2335 WABANSIA AVE. CHICAGO, ILL.	CAT. NO.	PART NO. 5607F
PATT.		" "				

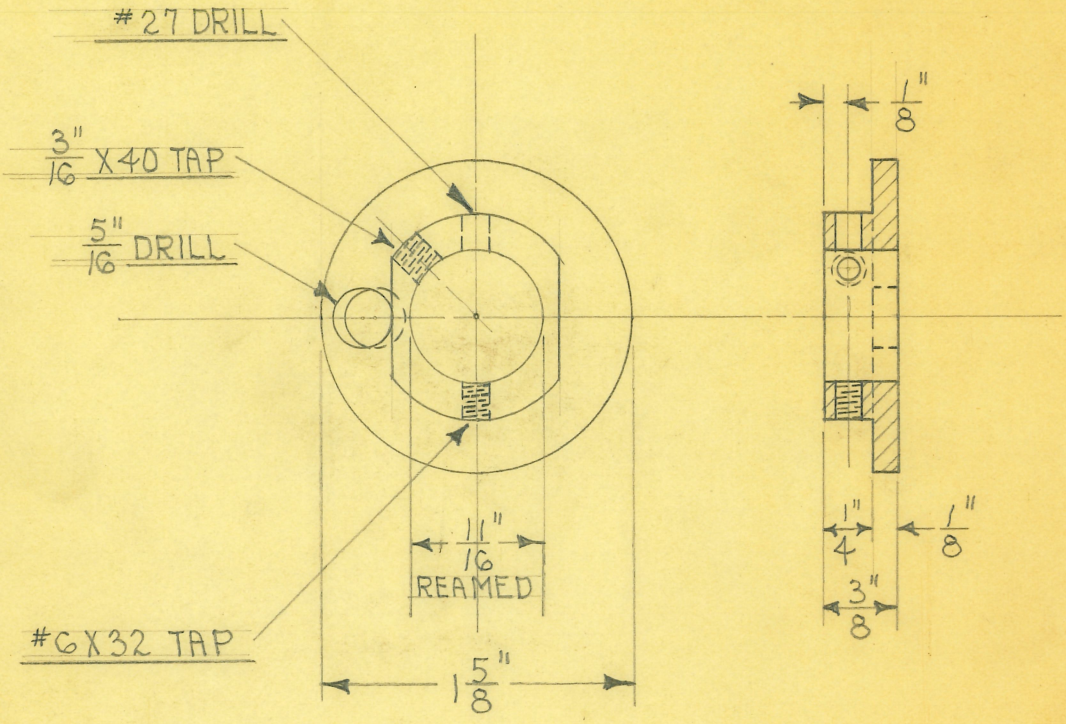

OBSOLETE

SIZE		ISSUE	
KIND	IRON CASTING	CHANGED	
SHAPE		"	
FINISH	BLACK JAPAN	"	
TEMP.		"	
PATT.		"	

TITLE: WAVE GEN. COLLECTOR RING SHAFT FLANGE FROM 5608

H. G. FISCHER & CO.
2335 WABANSIA AVE.
CHICAGO, ILL.

CAT. NO.

PART NO. 5607F

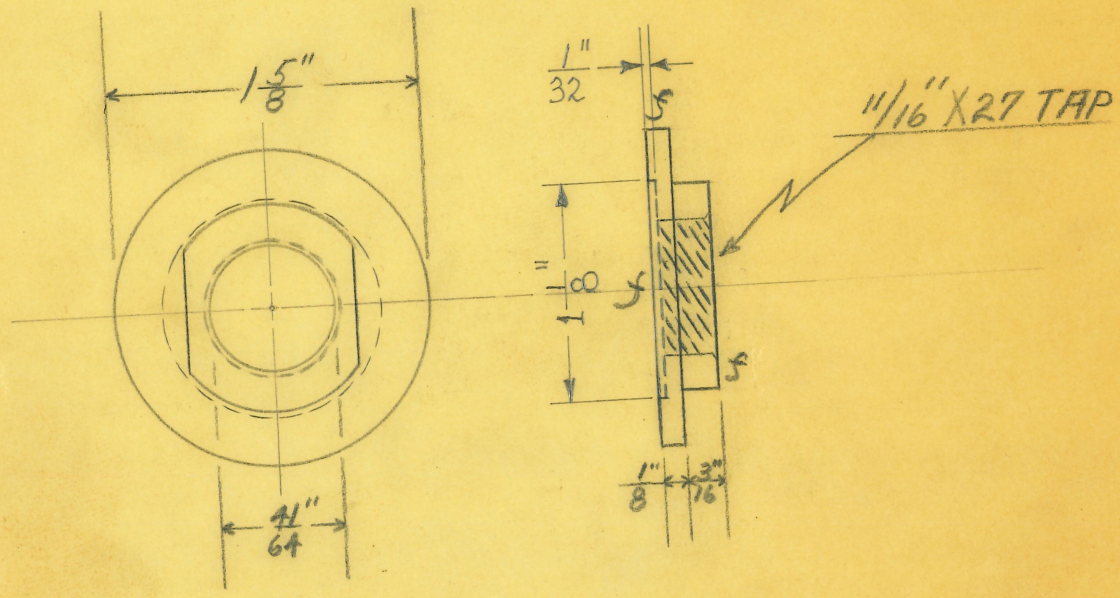

OBSOLETE

SIZE		ISSUE		TITLE: WAVE-GEN. COLLECTOR-RING-SHAFT-NUT	
KIND	CAST-IRON	CHANGED			
SHAPE		" "			
FINISH	BLK-JAPAN	" "		H. G. FISCHER & CO. 2335 WABANSIA AVE. CHICAGO, ILL.	CAT. NO.
TEMP.		" "			PART NO. 5608F
PATT.		" "			

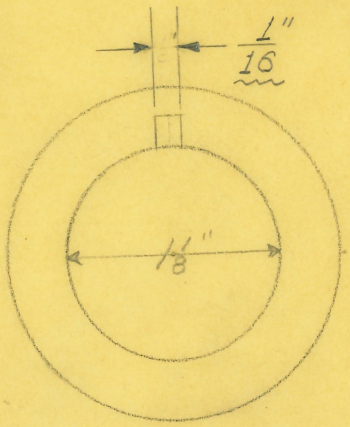

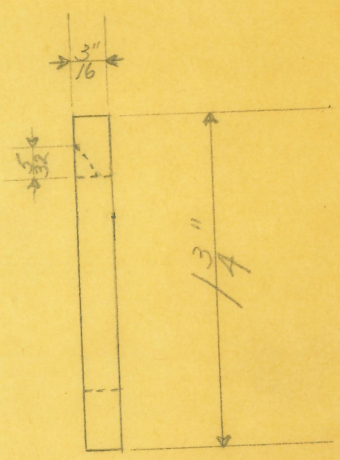

OBSOLETE

(3)

SIZE		ISSUE		TITLE: WAVE-GEN. COLLECTOR-RING
KIND	BRASS	per J.B. CHANGED 11-14-38	J.W.	
SHAPE		" "		
FINISH		" "		
TEMP.		" "		
PATT.		" "		

H. G. FISCHER & CO.
2335 WABANSIA AVE.
CHICAGO, ILL.

CAT. NO.

PART NO. 5609

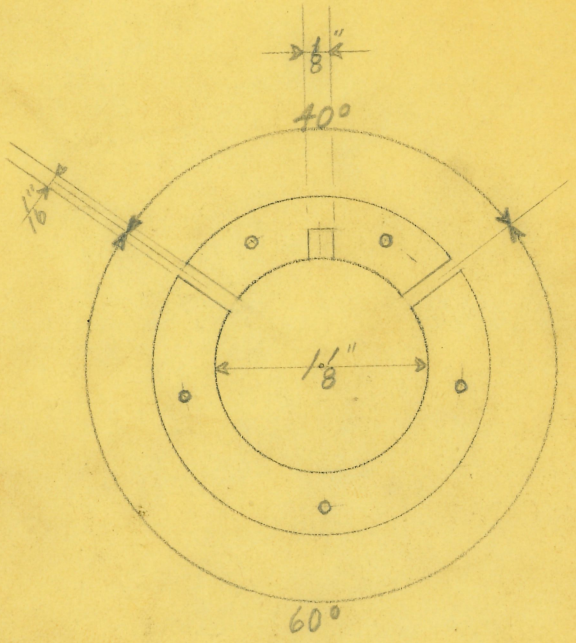

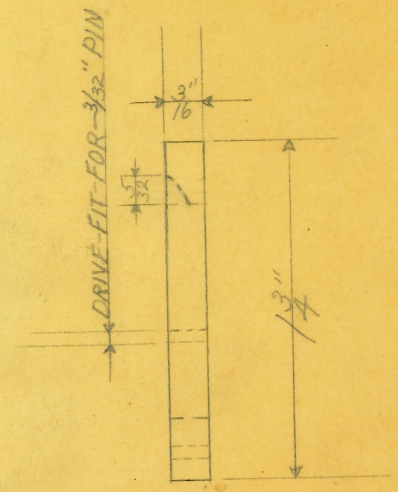

OBSOLETE

(1)

SIZE		ISSUE		TITLE: WAVE-GEN.-SPLIT-COLLECTOR-RING.			
KIND	BRASS	CHANGED					
SHAPE		" "					
FINISH		" "					
TEMP.		" "		H. G. FISCHER & CO. 2335 WABANSIA AVE. CHICAGO, ILL.	CAT. NO.	PART NO.	5610
PATT.		" "					

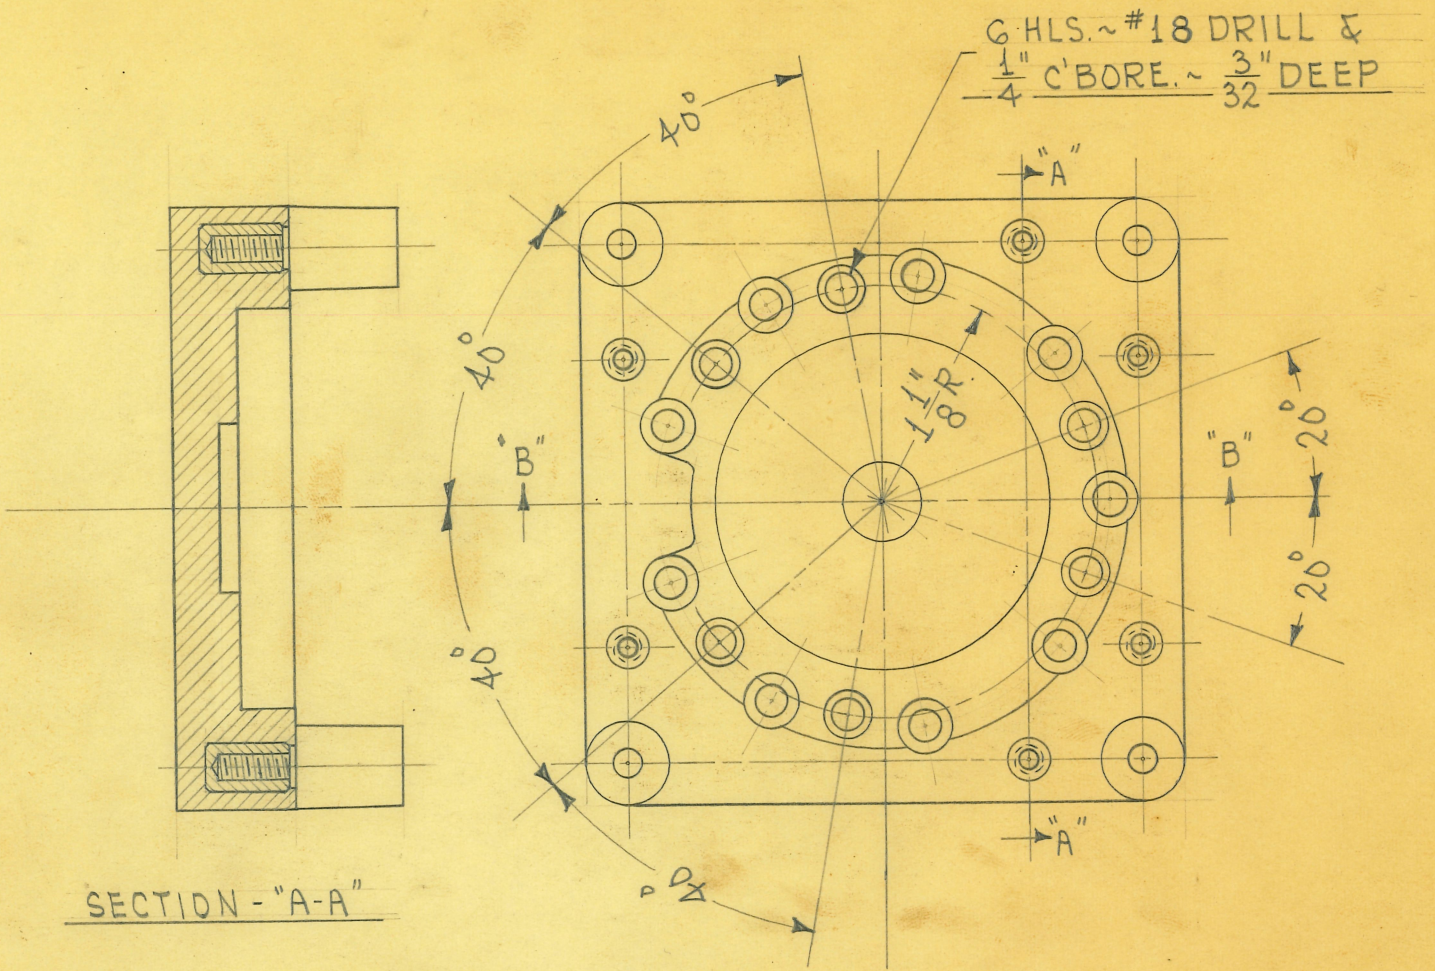

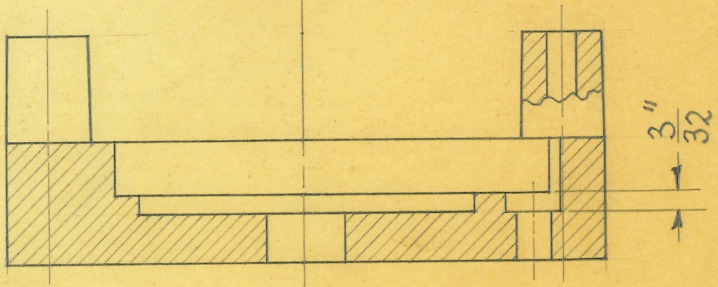

SECTION - "B-B"

OBSOLETE

SIZE	FROM #2241/4	ISSUE 4-11-45	HE.	TITLE: WAVE GEN. 15 POINT SWITCH BASE.
KIND	MOLDED	CHANGED		
SHAPE	BAKELITE	"		
FINISH		"		
TEMP.		"		
PATT.		"		

H. G. FISCHER & CO.
2335 WABANSIA AVE.
CHICAGO. ILL.

CAT. NO.

PART NO. 5620

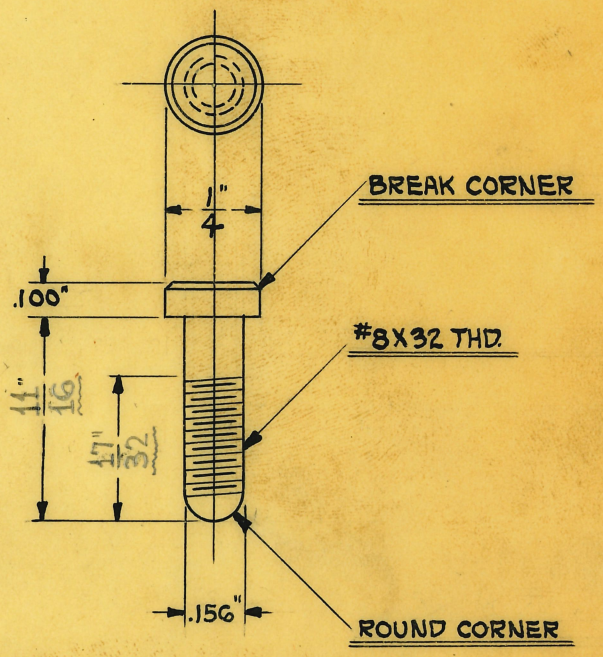

SCALE ~ 2 DIAMETERS

OBSOLETE

SIZE	1/4"	ISSUE H.E.	2-12-30	TITLE: WAVE GENERATOR 15 PT. SWITCH CONTACT POINT	
KIND	BRASS ROD	CHANGED H.E.	12-6-44		
SHAPE		" "			
FINISH		" "			
TEMP.		" "		H. G. FISCHER & CO. 2335 WABANSIA AVE. CHICAGO, ILL.	CAT. NO.
PATT.		" "			PART NO. 5621A

3 HLS.~ # 52 DRILL & CSK. FOR RIVETING ON SMOOTH SIDE OF RATCHET

.218" DIA. HOLE

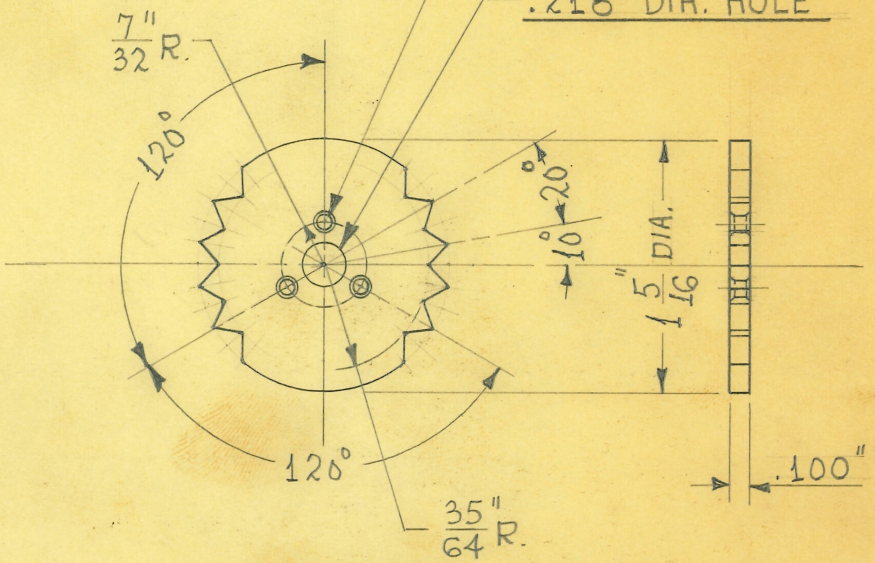

BLANKING DIE # 4519

1 REQUIRED

NOTE:

CASE HARDENED

OBSOLETE

SIZE	.100" X 1 5/8"	ISSUE 4-9-45	HE.
KIND	SHEARED	CHANGED	
SHAPE	C.R. STEEL	"	
FINISH	CAD. # 23	"	
TEMP.		"	
PATT.		"	

TITLE: 15 POINT SWITCH RATCHET

H. G. FISCHER & CO.
2338 WABANSIA AVE.
CHICAGO. ILL.

CAT. NO.

PART NO. 5624

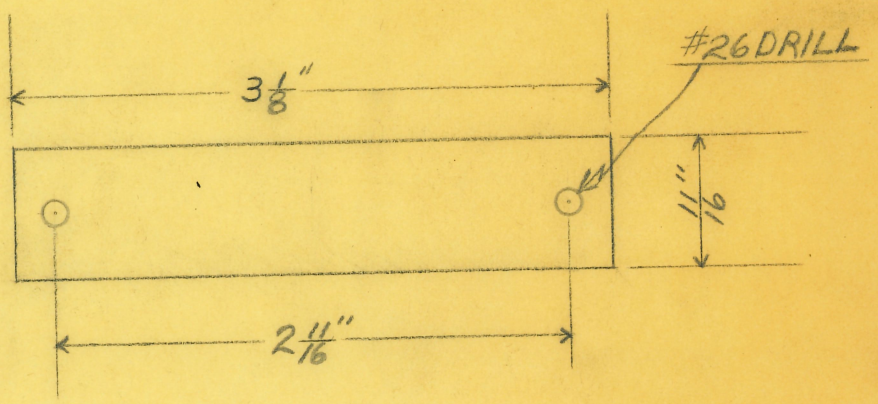

OBSOLETE

SIZE		ISSUE	
KIND	1/16" BAKALITE	CHANGED	
SHAPE		" "	
FINISH		" "	
TEMP.		" "	
PATT.		" "	

TITLE: WAVE GEN. 15 PT. SW. INSULATOR

H. G. FISCHER & CO.
2335 WABANSIA AVE.
CHICAGO, ILL.

CAT. NO.

PART NO. 5625

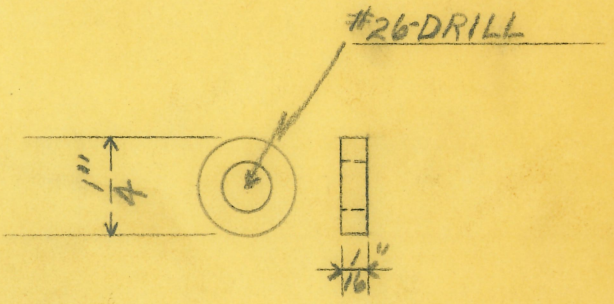

DOUBLE-SCALE

OBSOLETE

SIZE		ISSUE		TITLE: WAVE-GEN. 15PT. SW. CONTACT PLATE INSULATING BUSHING		
KIND		CHANGED				
SHAPE		" "				
FINISH		" "				
TEMP.		" "		H. G. FISCHER & CO. 2335 WABANSIA AVE. CHICAGO, ILL.	CAT. NO.	PART NO. 5625 1/2
PATT.		" "				

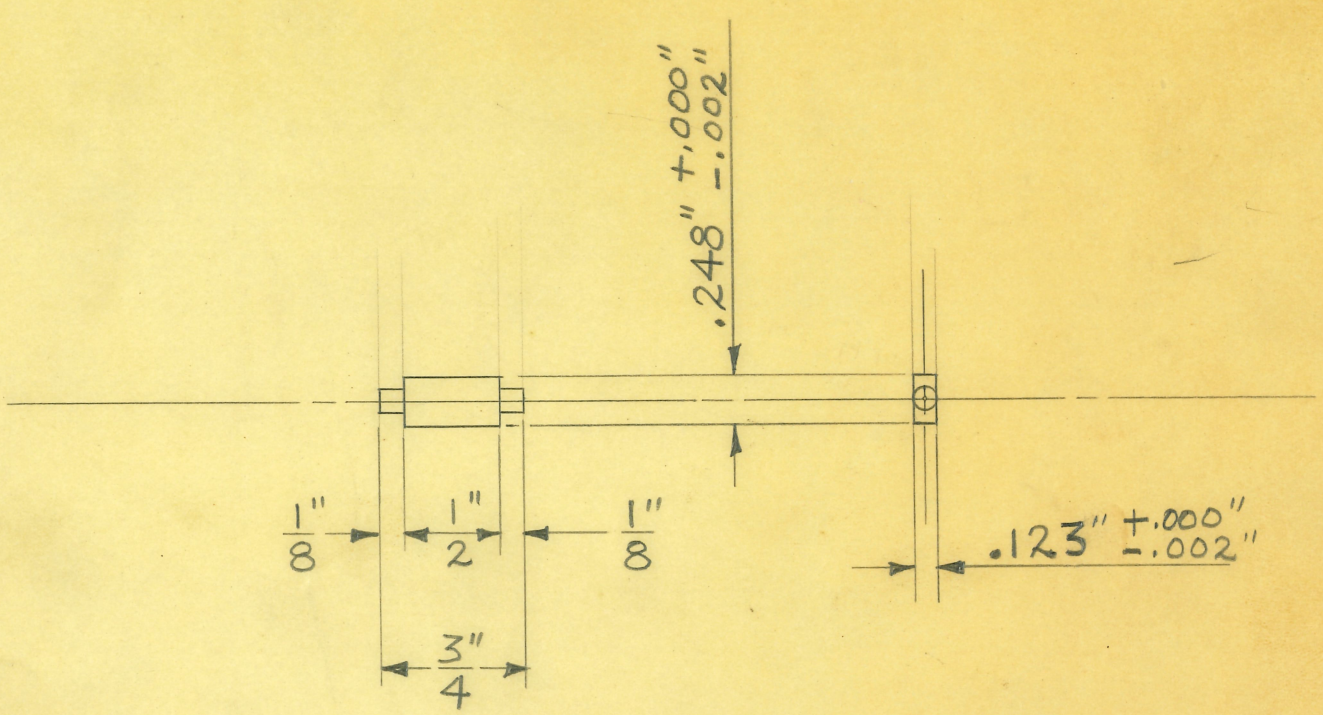

OBSOLETE

KEYSTONE GRADE
S-312 KEYSTONE CARBON CO.

SIZE		ISSUE 8-22-46	J.V.W.
KIND		CHANGED	
SHAPE		"	
FINISH		"	
TEMP.		"	
PATT.		"	

TITLE: FISCHER MOD. "J" GALV. & CONT. CURR. GEN. COMMUTATOR & COLL. RING BRUSH

H. G. FISCHER & CO.
2335 WABANSIA AVE.
CHICAGO, ILL.

CAT. NO.

PART NO. 5627

2HLS.-#10X32 TAP

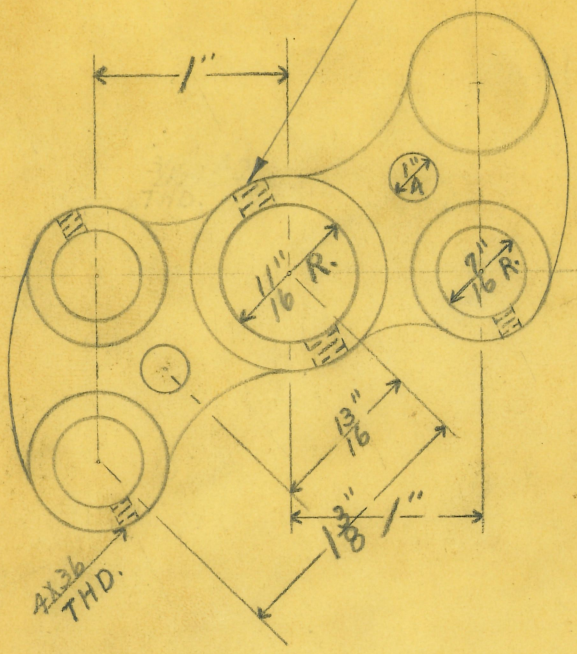

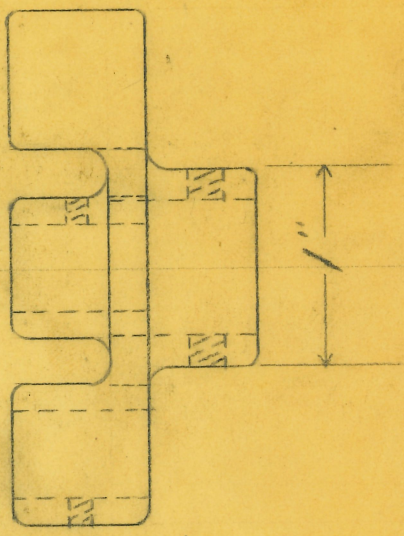

OBSOLETE

SIZE		ISSUE CHAS. M.	2-23-28	TITLE: WAVE-GEN. REVOLVING-BRUSH-HOLDER
KIND	CAST-IRON	CHANGED		
SHAPE		" "		
FINISH	BLACK-JAPAN	" "		
TEMP.		" "		H. G. FISCHER & CO. 2335 WABANSIA AVE. CHICAGO, ILL. — CAT. NO. — PART NO. 5628FA
PATT.		" "		

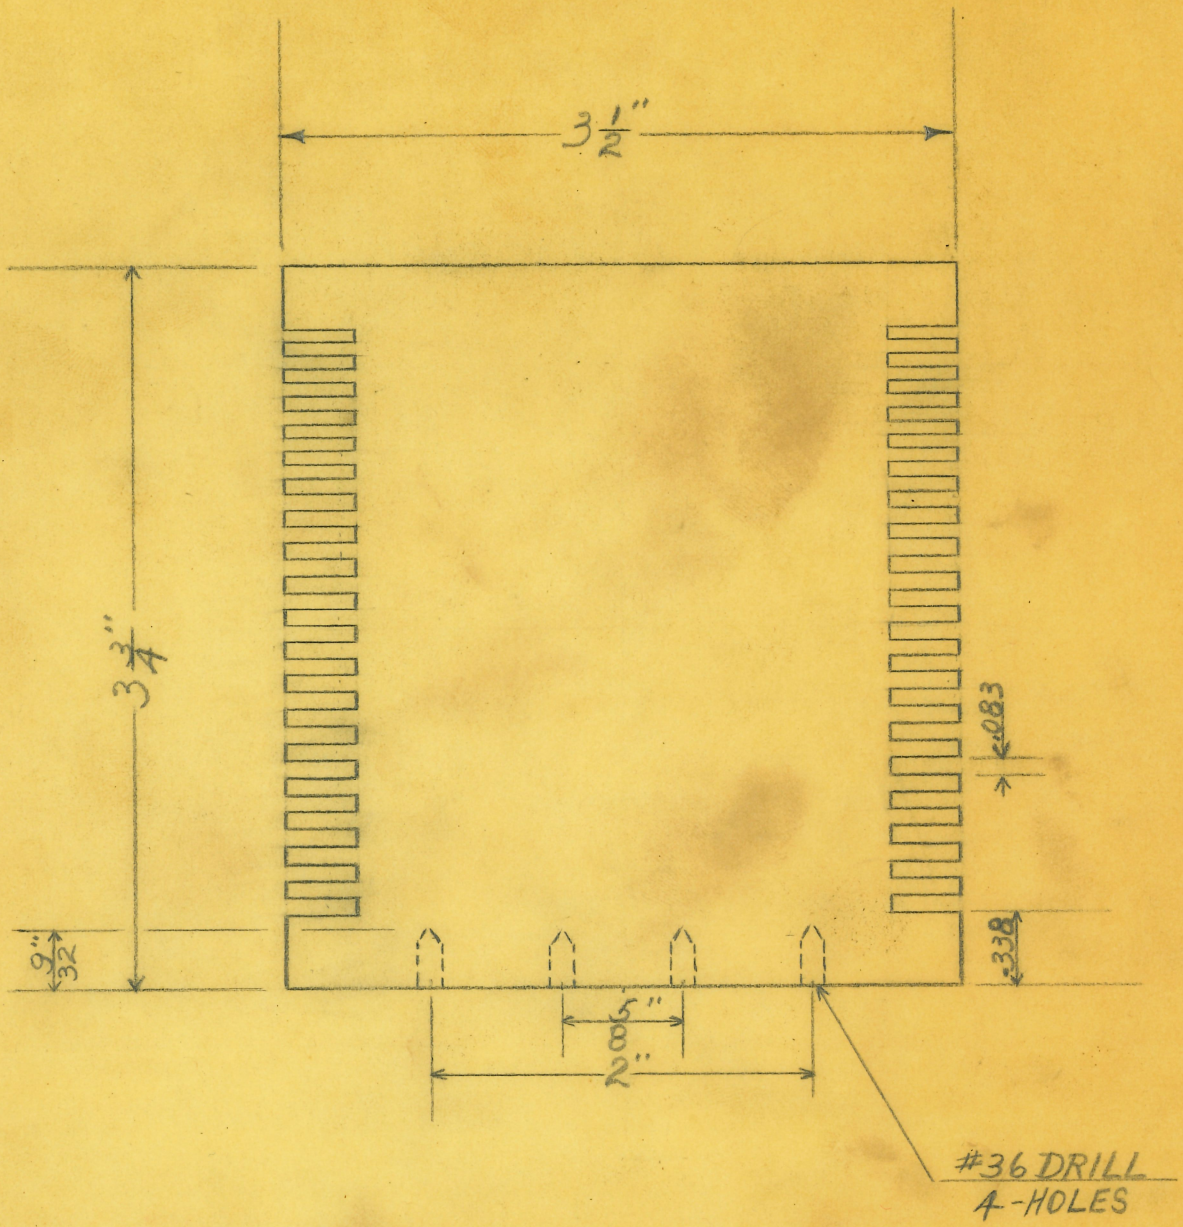

OBSOLETE

SIZE	1/4"	ISSUE		TITLE: WAVE-GEN.-RESISTANCE-COIL-BLOCK.		
KIND	BIRCH	CHANGED				
SHAPE		" "				
FINISH	NATURAL	" "				
TEMP.		" "		H. G. FISCHER & CO. 2335 WABANSIA AVE. CHICAGO, ILL.	CAT. NO.	PART NO. 5630F
PATT.		" "				

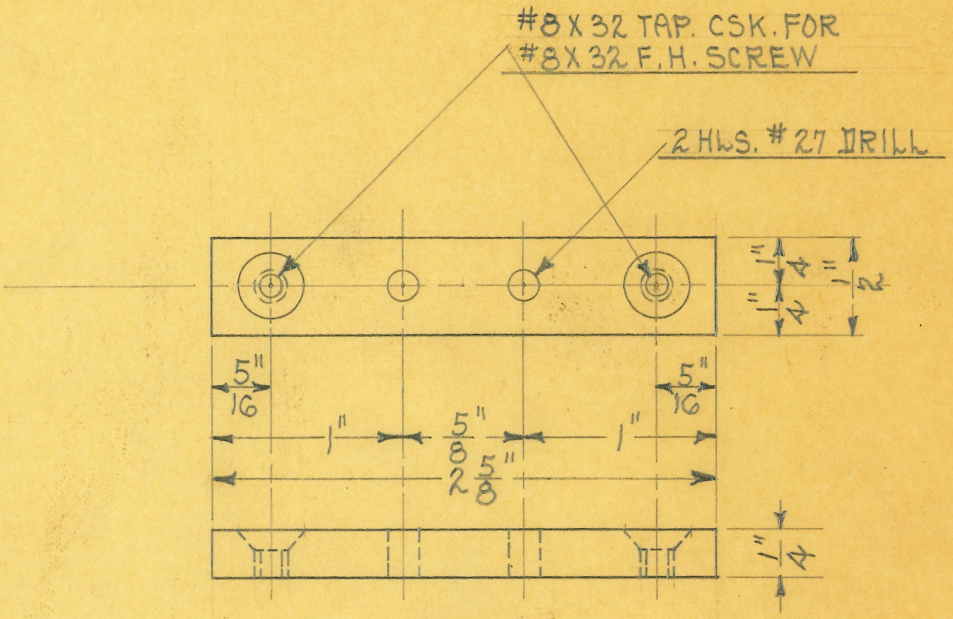

SCALE ~ FULL SIZE

OBSOLETE

SIZE	1/4"	ISSUE 9-2-31	A.E.	TITLE: WAVE GEN. RESIS. COIL CONN. BLOCK
KIND	BAKELITE	CHANGED		
SHAPE		" "		
FINISH		" "		
TEMP.		" "		H. G. FISCHER & CO. 2335 WABANSIA AVE. CHICAGO, ILL. — CAT. NO. — PART NO. 5632
PATT.		" "		

OBSOLETE

(1)

SIZE		ISSUE		TITLE: WAVE-GEN.-BRUSH-HOLDER	
KIND	C.R.STEEL	CHANGED			
SHAPE		" "			
FINISH	BLK. JAPAN	" "			
TEMP.		" "		H. G. FISCHER & CO. 2335 WABANSIA AVE. CHICAGO, ILL.	CAT. NO.
PATT.		" "			PART NO. 5634

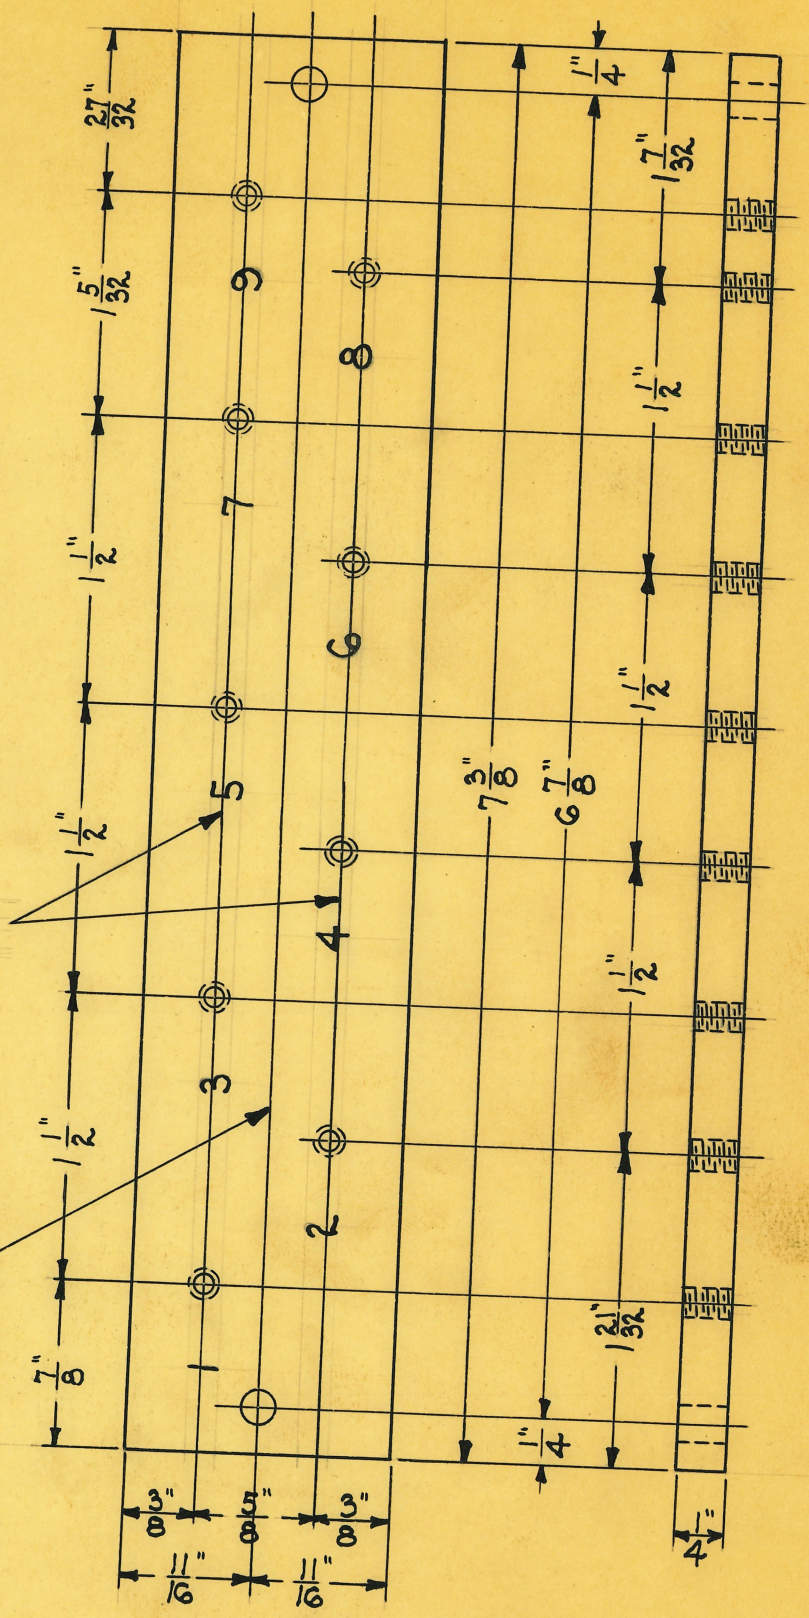

DRILL JIG # 4534

1/4"X1 3/8"X7 3/8"	ISSUE 10-16-30	H.E.	TITLE: WAVE GEN. REAR CONNECTION BOARD
BAKELITE	CHANGED		
STRIP	" "		
	" "		
	" "		
	" "		

OBSOLETE

H. G. FISCHER & CO.
2335 WABANSIA AVE.
CHICAGO, ILL.

CAT. NO.

PART NO. 5636

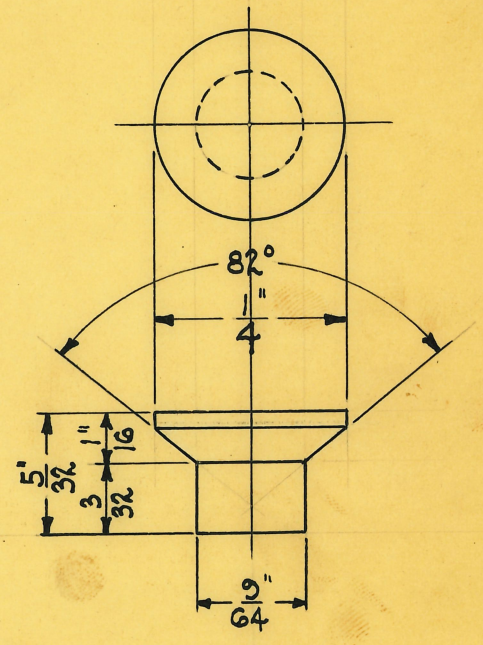

SCALE ~ 4 DIAMETERS

OBSOLETE

SIZE	1/4"	ISSUE 10-16-30	A.E.
KIND	BRASS ROD	CHANGED	
SHAPE	ROUND	" "	
FINISH		" "	
TEMP.		" "	
PATT.		" "	

TITLE: WAVE GEN. COMMUTATOR BRUSH SPRING CONTACT

H. G. FISCHER & CO.
2335 WABANSIA AVE.
CHICAGO, ILL.

CAT. NO.

PART NO. 5637

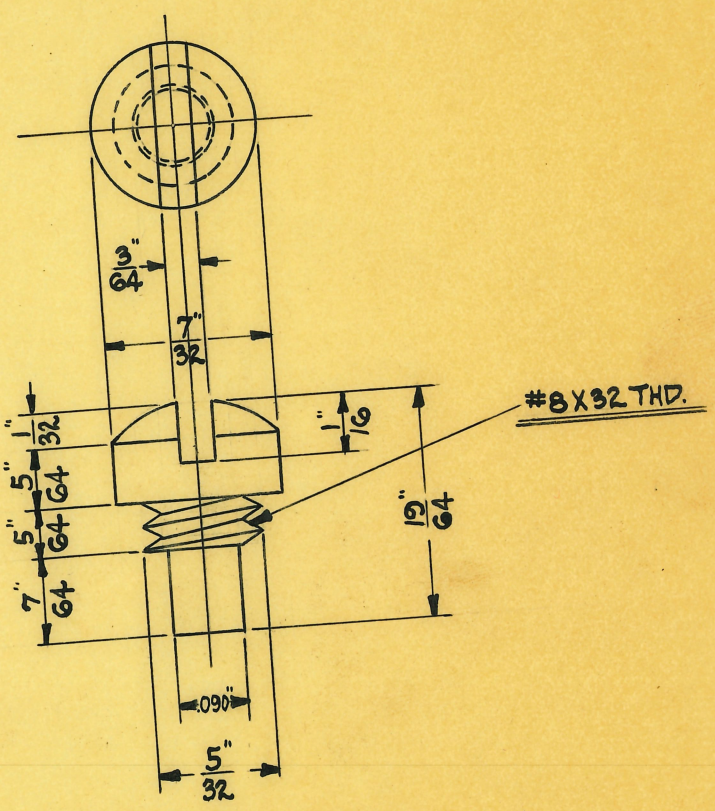

SCALE ÷ 4 DIAMETERS

OBSOLETE

SIZE	7/32"	ISSUE H.E.	3-24-30	TITLE: WAVE GEN. RHEOSTAT COUPLING GUIDE SCREW
KIND	SCR. STOCK	CHANGED		
SHAPE	ROUND	" "		
FINISH	CASE HARDEN	" "		
TEMP.		" "		
		" "		

H. G. FISCHER & CO.
2335 WABANSIA AVE.
CHICAGO, ILL.

CAT. NO.

PART NO. 5638

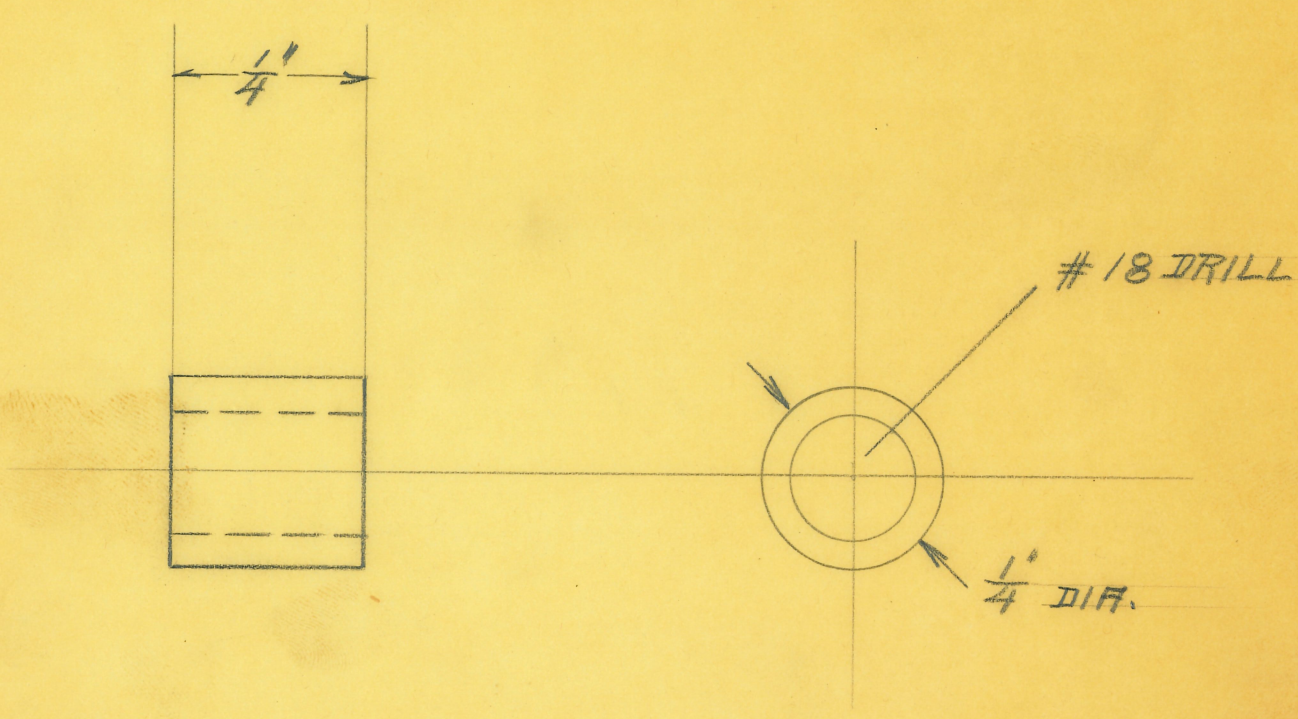

OBSOLETE

SIZE		ISSUE 4-23-26	C.	TITLE: BUSHING FOR WALL LAMP	
KIND	BRASS	CHANGED			
SHAPE		" "			
FINISH		" "			
TEMP.		" "			
PATT.		" "			
H. G. FISCHER & CO. 2335 WABANSIA AVE. CHICAGO, ILL.		CAT. NO.		PART NO.	5705

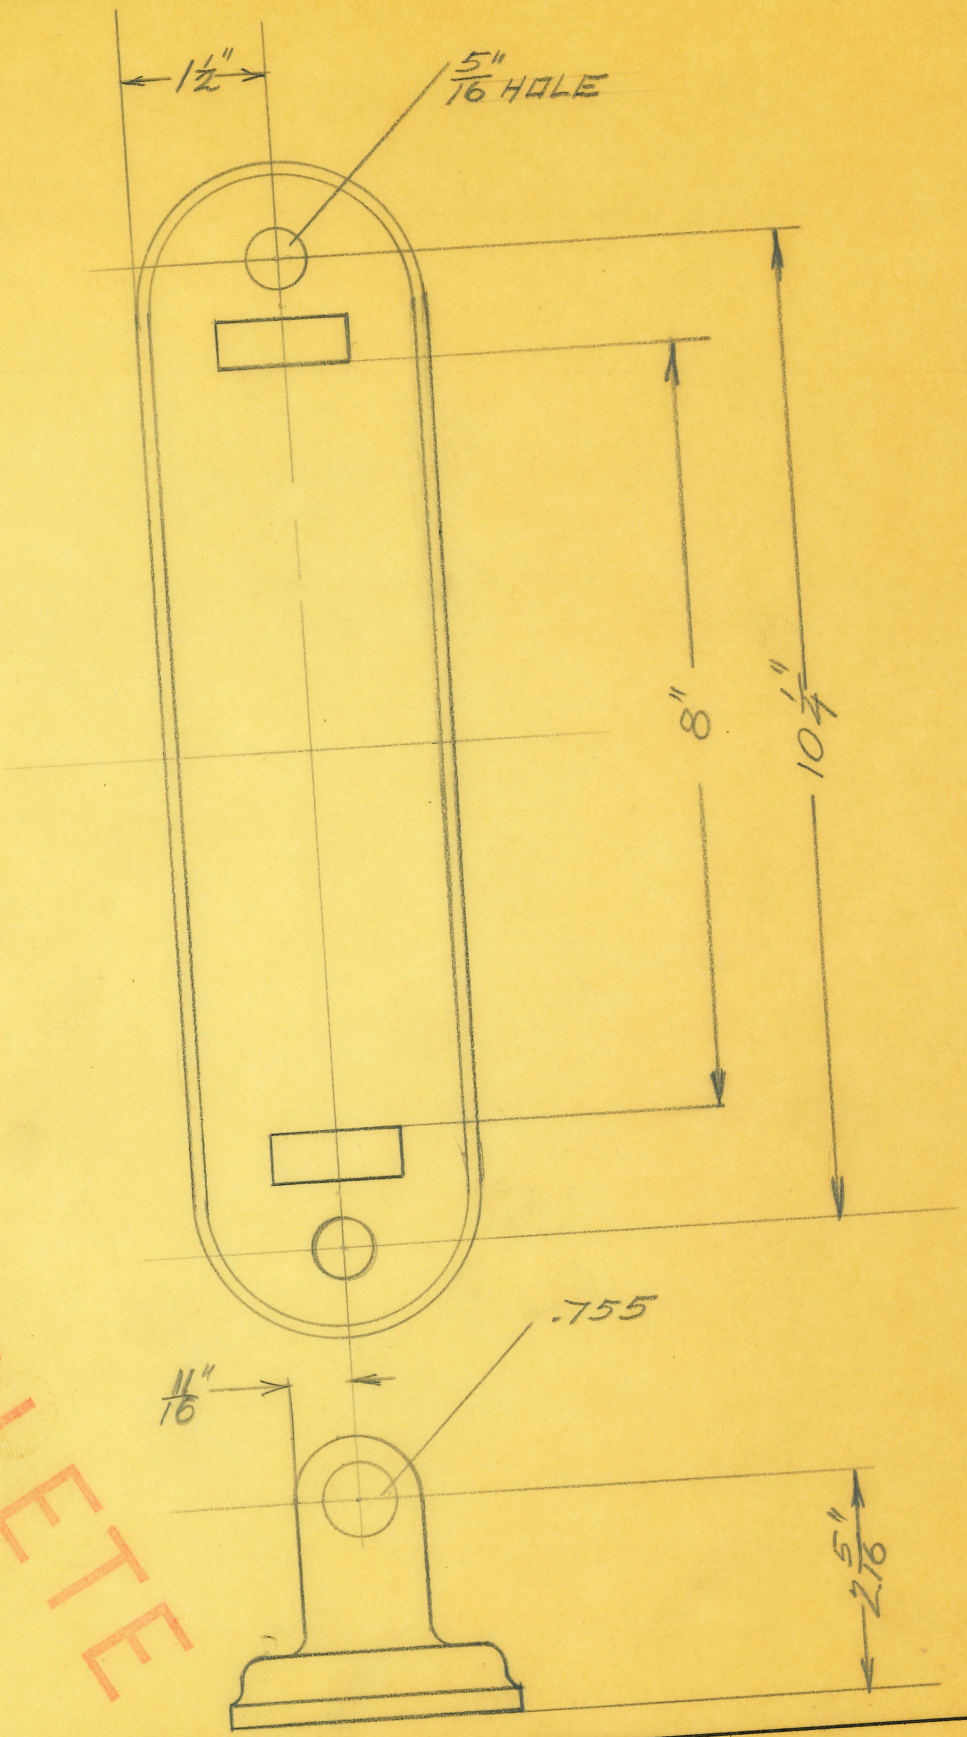

OBSOLETE

SIZE		ISSUE 4-23-26		TITLE: WALL LAMP.
KIND	ALUMINUM	CHANGED		
SHAPE		" "		
FINISH	CRYSTAL	" "		
TEMP.		" "		
		" "		

H. G. FISCHER & CO.
2335 WABANSIA AVE.
CHICAGO, ILL.

CAT. NO.

PART NO. 5706F

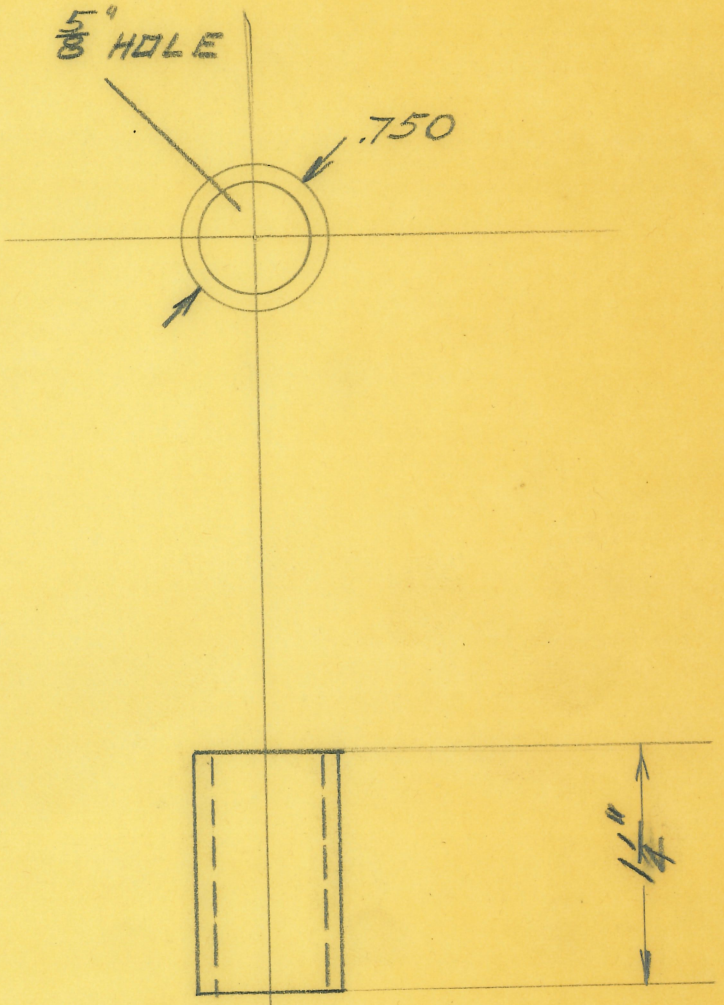

OBSOLETE

SIZE		ISSUE 4-23-26	W.	TITLE: WALL LAMP	
KIND		CHANGED			
SHAPE		" "			
FINISH		" "			
TEMP.		" "		H. G. FISCHER & CO. 2335 WABANSIA AVE. CHICAGO, ILL.	CAT. NO.
PATT.		" "			PART NO. 5707

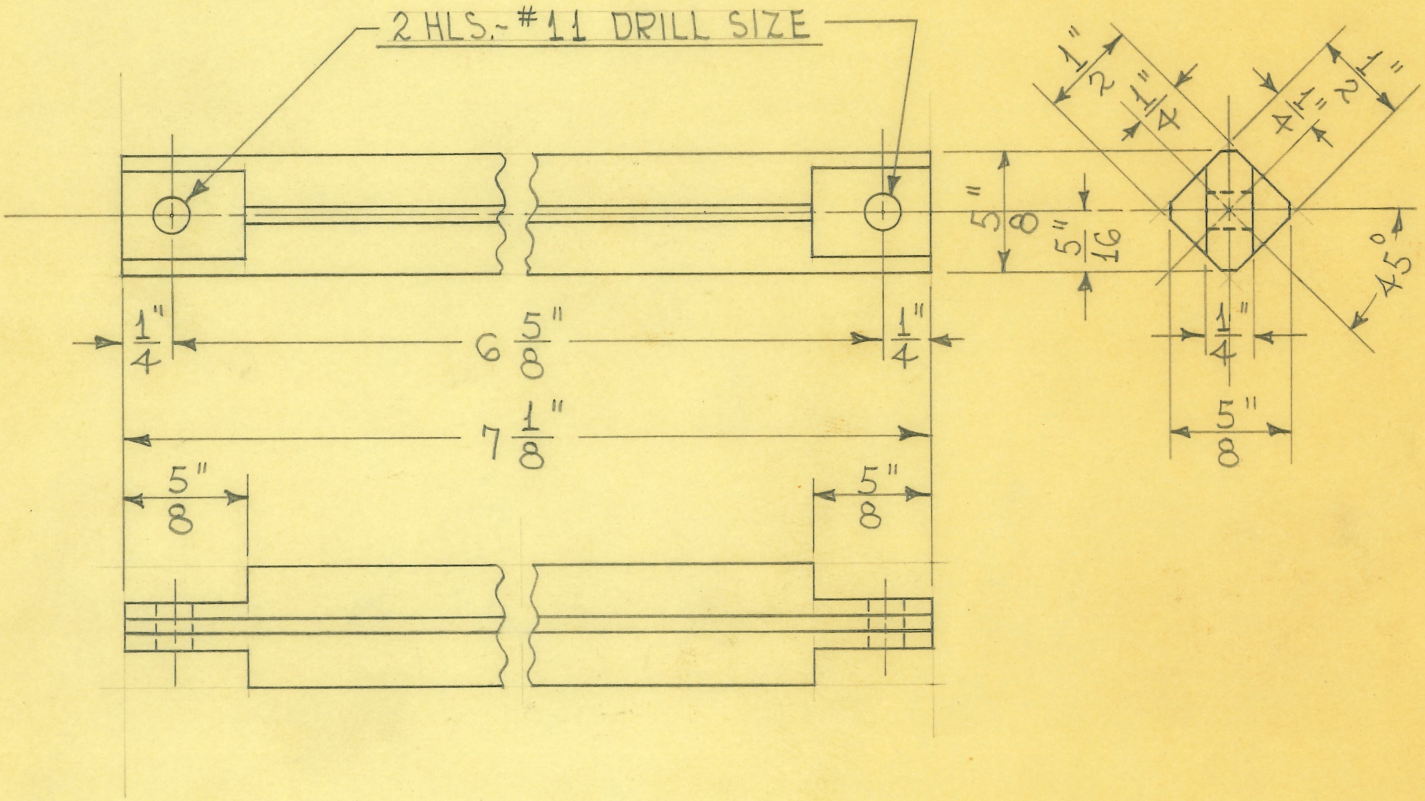

OBSOLETE

SIZE		ISSUE 6-21-45	HE.	**TITLE:** H.O. CARBON ARC LAMP ISOLANTITE ROD
KIND	ISOLANTITE	CHANGED		
SHAPE		"		
FINISH		"		
TEMP.		"		
PATT.		"		

H. G. FISCHER & CO. 2335 WABANSIA AVE. CHICAGO. ILL.	CAT. NO.	PART NO. 5713A

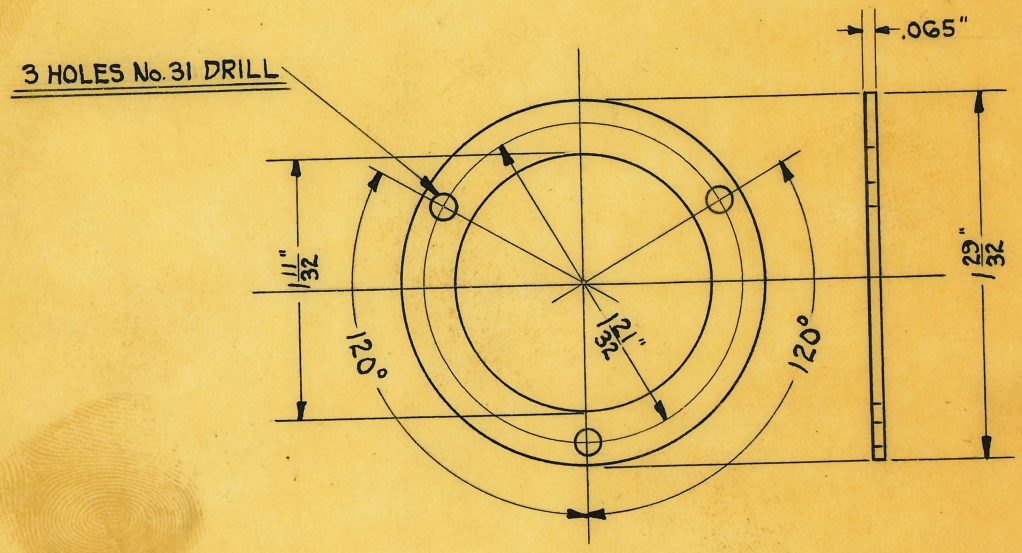

OBSOLETE

SIZE	.065" SHEET	ISSUE	11-6-29
KIND	C. R. STEEL	CHANGED	
SHAPE		" "	
FINISH	W.P.	" "	
TEMP.		" "	
PATT.		" "	

TITLE: ~~LAYMAN'S~~ INFRA RED RAY GENERATOR
~~HOOD SUPPORT TUBE CLAMP STUD~~
HOOD SOCKET RING

H. G. FISCHER & CO.
2335 WABANSIA AVE.
CHICAGO, ILL.

CAT. NO.

PART NO. 5782

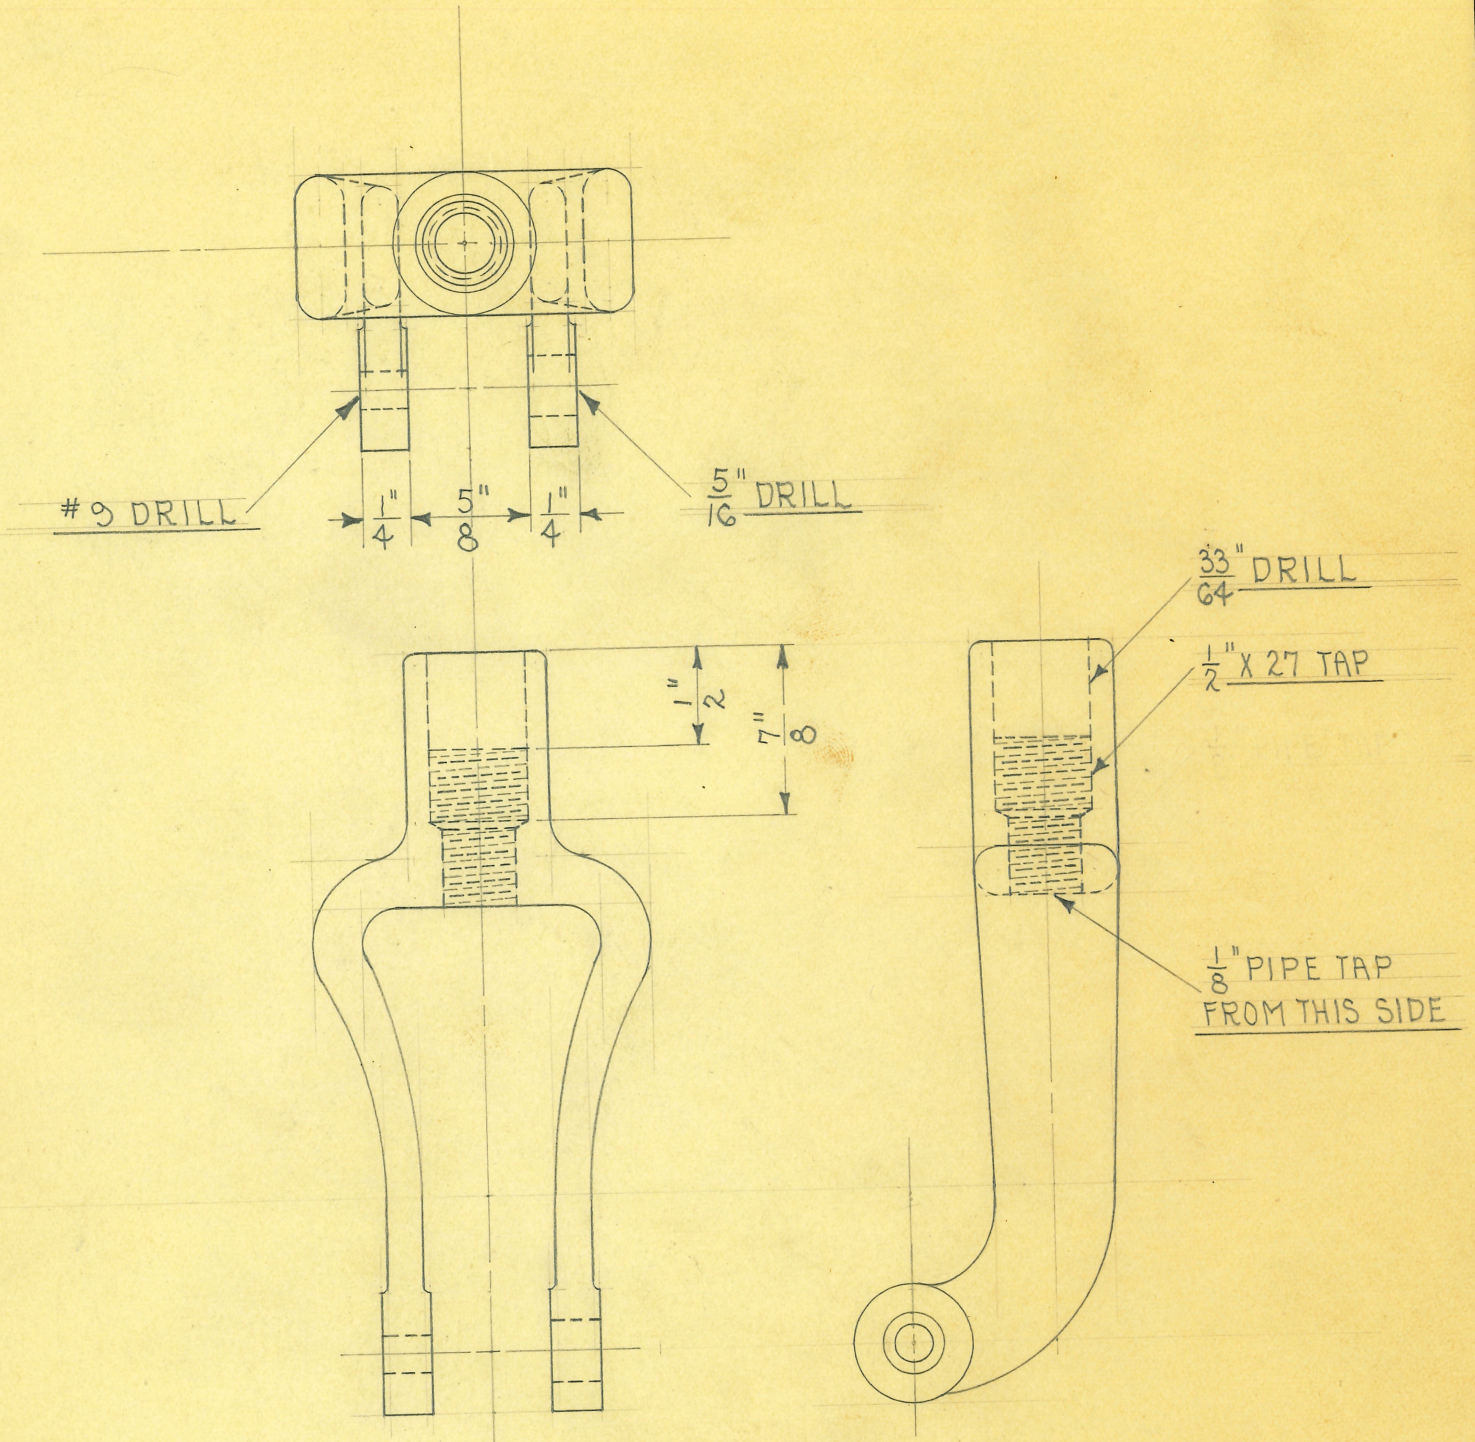

OBSOLETE

SIZE		ISSUE 3-12-35	A.E.	TITLE: PHYSICIANS MODEL INFRA RED GEN. SWIVEL
KIND	IRON CASTING	CHANGED		
SHAPE		"		
FINISH	ALUM. BRONZE	"		
TEMP.		"		
PATT.		"		

H. G. FISCHER & CO.
2335 WABANSIA AVE.
CHICAGO, ILL

CAT. NO.

PART NO. 5786 AF

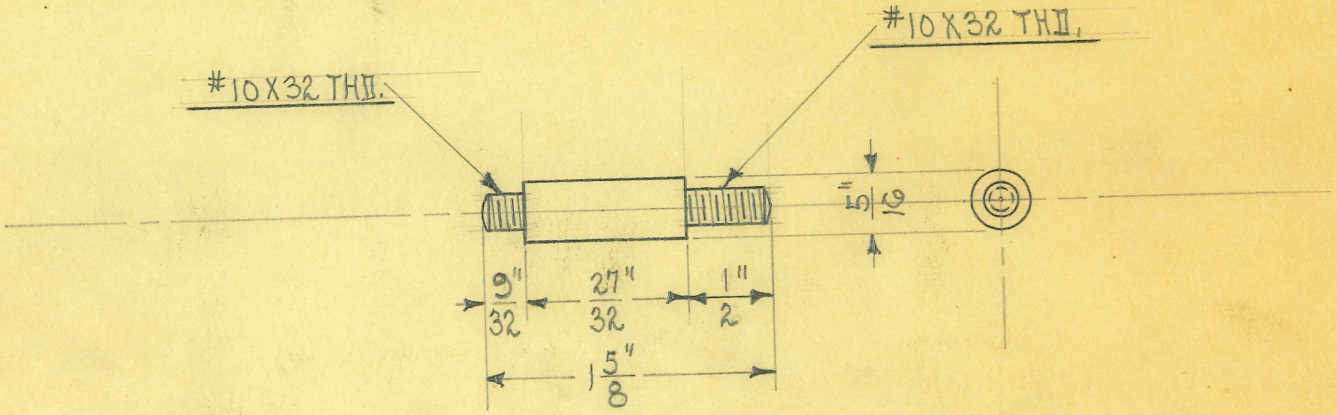

SCALE = FULL SIZE

OBSOLETE

SIZE	5/16"	ISSUE 1-25-32	A.E.	TITLE: INFRA RED RAY GEN. HOOD SWIVEL STUD
KIND	COLD ROLL	CHANGED		
SHAPE		" "		
FINISH		" "		
TEMP.		" "		
PATT.		" "		

H. G. FISCHER & CO.
2335 WABANSIA AVE.
CHICAGO, ILL.

CAT. NO.

PART NO. 5787

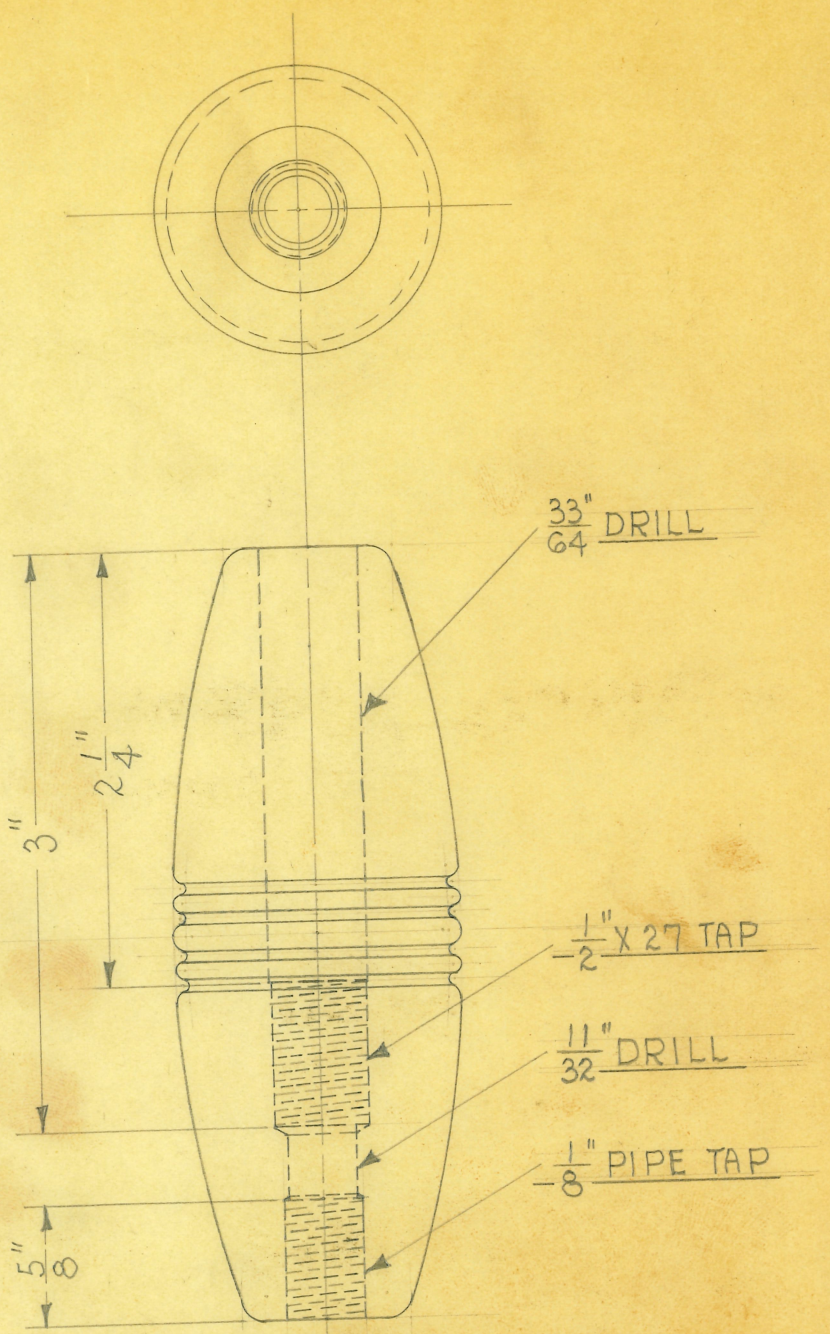

OBSOLETE

1 REQUIRED

SIZE		ISSUE 9-10-36	J.E.
KIND	IRON CASTING	CHANGED	
SHAPE		"	
FINISH	IVORY & BROWN	"	
TEMP.		"	
PATT.	2218-422	"	

TITLE: INFRA RED RAY GEN. HOOD SUPPORT TUBE HANDLE

H. G. FISCHER & CO.
2335 WABANSIA AVE.
CHICAGO, ILL.

CAT. NO.

PART NO. 5789F

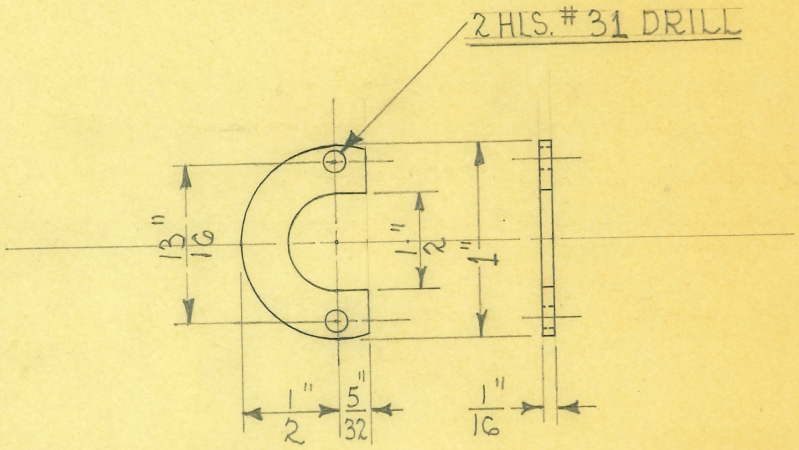

OBSOLETE

SIZE	1/16" SHEET	ISSUE 2-7-36	A.E.
KIND	C.R. STEEL	CHANGED	
SHAPE		"	
FINISH	W.P. #13	"	
TEMP.		"	
PATT.		"	

TITLE: INFRA RED RAY GEN. SOCKET SUPP. WASHER

H. G. FISCHER & CO.
2335 WABANSIA AVE.
CHICAGO, ILL.

CAT. NO.

PART NO. 5795

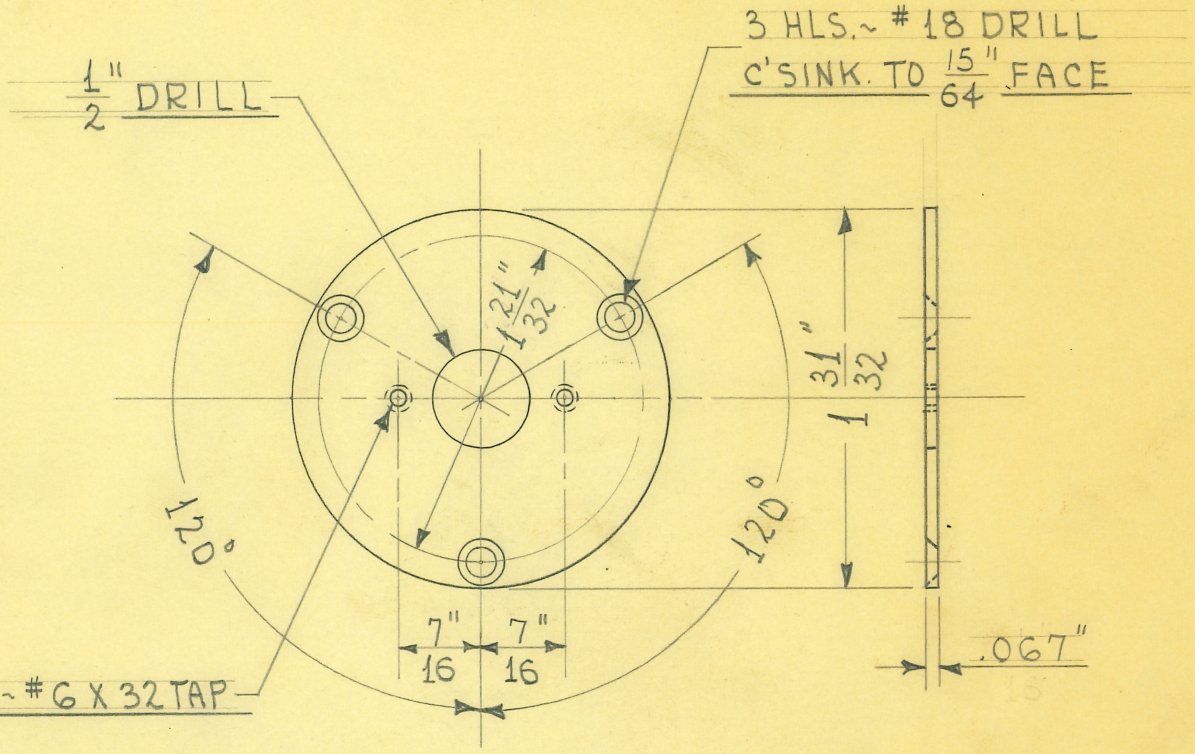

1 REQUIRED

OBSOLETE

SIZE	.067" SHEET	ISSUE 1-8-43	H.E.
KIND	C.R. STEEL	CHANGED	
SHAPE		"	
FINISH	ZINC #9	"	
TEMP.		"	
PATT.		"	

TITLE: INFRA RED RAY GENERATOR SOCKET MOUNTING PLATE

H. G. FISCHER & CO.
2335 WABANSIA AVE.
CHICAGO, ILL.

CAT. NO.

PART NO. 5815

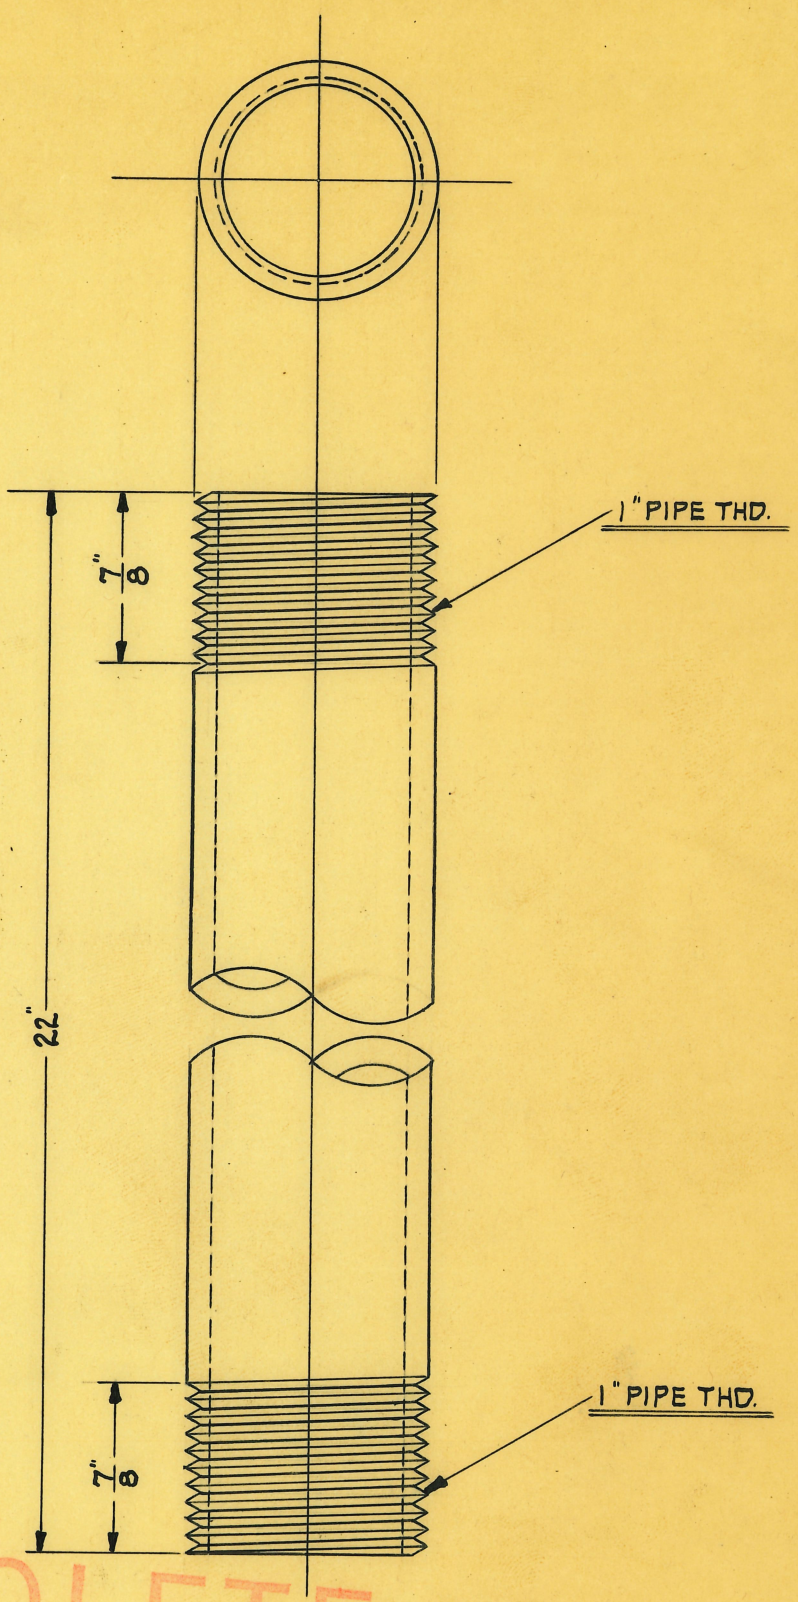

OBSOLETE

SIZE	1"X22"	ISSUE H.E.	4-1-30	TITLE: PHYSICIAN'S MODEL ARC-LAMP UPRIGHT TUBE
KIND	PIPE	CHANGED		
SHAPE	ROUND	" "		
FINISH		" "		
TEMP.		" "		H. G. FISCHER & CO. 2335 WABANSIA AVE. CHICAGO, ILL. — CAT. NO. — PART NO. 5822
PATT.		" "		

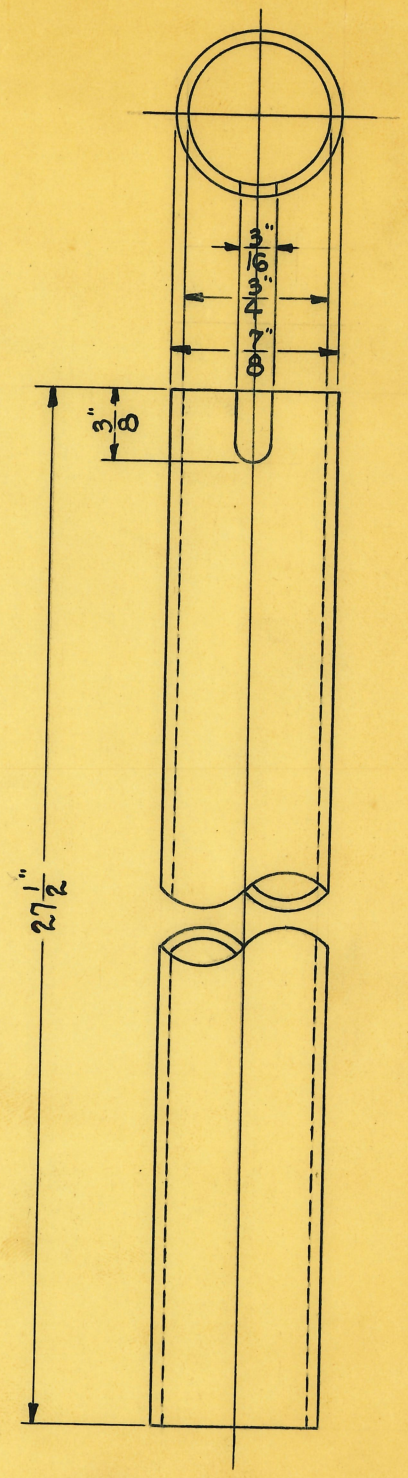

OBSOLETE

SIZE	7/8" O.D. X 1/16" WALL	ISSUE	H.E.	4-9-30
KIND	SEAMLESS STEEL TUBING	CHANGED		
SHAPE	ROUND	"	"	
FINISH	POL. & N.P.	"	"	
TEMP.		"	"	
PATT.		"	"	

TITLE: PHYSICIANS MODEL ARC LAMP ADJ. TUBE

H. G. FISCHER & CO.
2335 WABANSIA AVE.
CHICAGO, ILL.

CAT. NO.

PART NO. 5825F
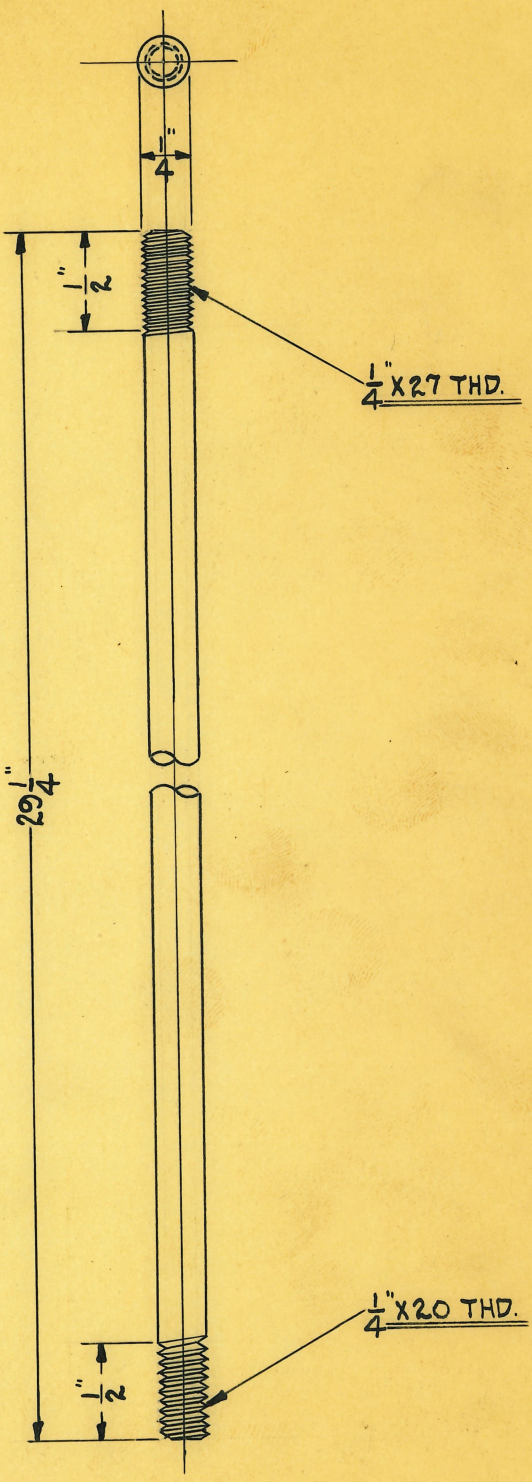
OBSOLETE

SIZE	1/4"	ISSUE H.E.	4-8-30	TITLE: PHYSICIANS MODEL ARC LAMP ADJ. TUBE TIE ROD
KIND	COLD ROLLED	CHANGED		
SHAPE	ROUND	" "		
FINISH		" "		
TEMP.		" "		
PATT.		" "		

H. G. FISCHER & CO.
2335 WABANSIA AVE.
CHICAGO, ILL.

CAT. NO.

PART NO. 5826

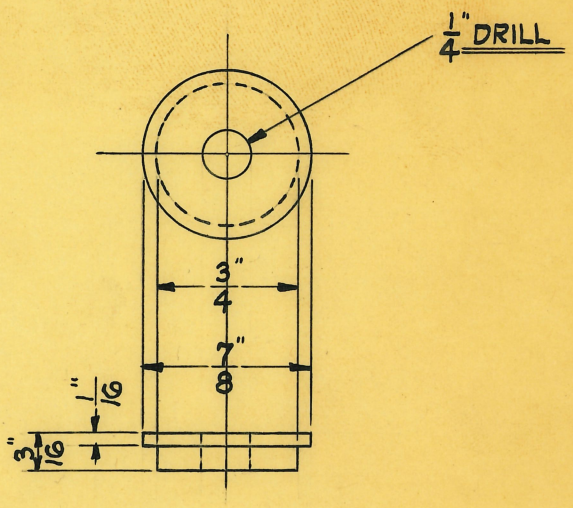

OBSOLETE

SIZE	15/16"	ISSUE H.E.	4-7-30	TITLE: PHYSICIANS MODEL ARC LAMP ADJ. TUBE WASHER		
KIND	COLD ROLLED	CHANGED				
SHAPE	ROUND	" "				
FINISH		" "				
TEMP.		" "		H. G. FISCHER & CO. 2335 WABANSIA AVE. CHICAGO, ILL.	CAT. NO.	PART NO. 5827
PATT.		" "				

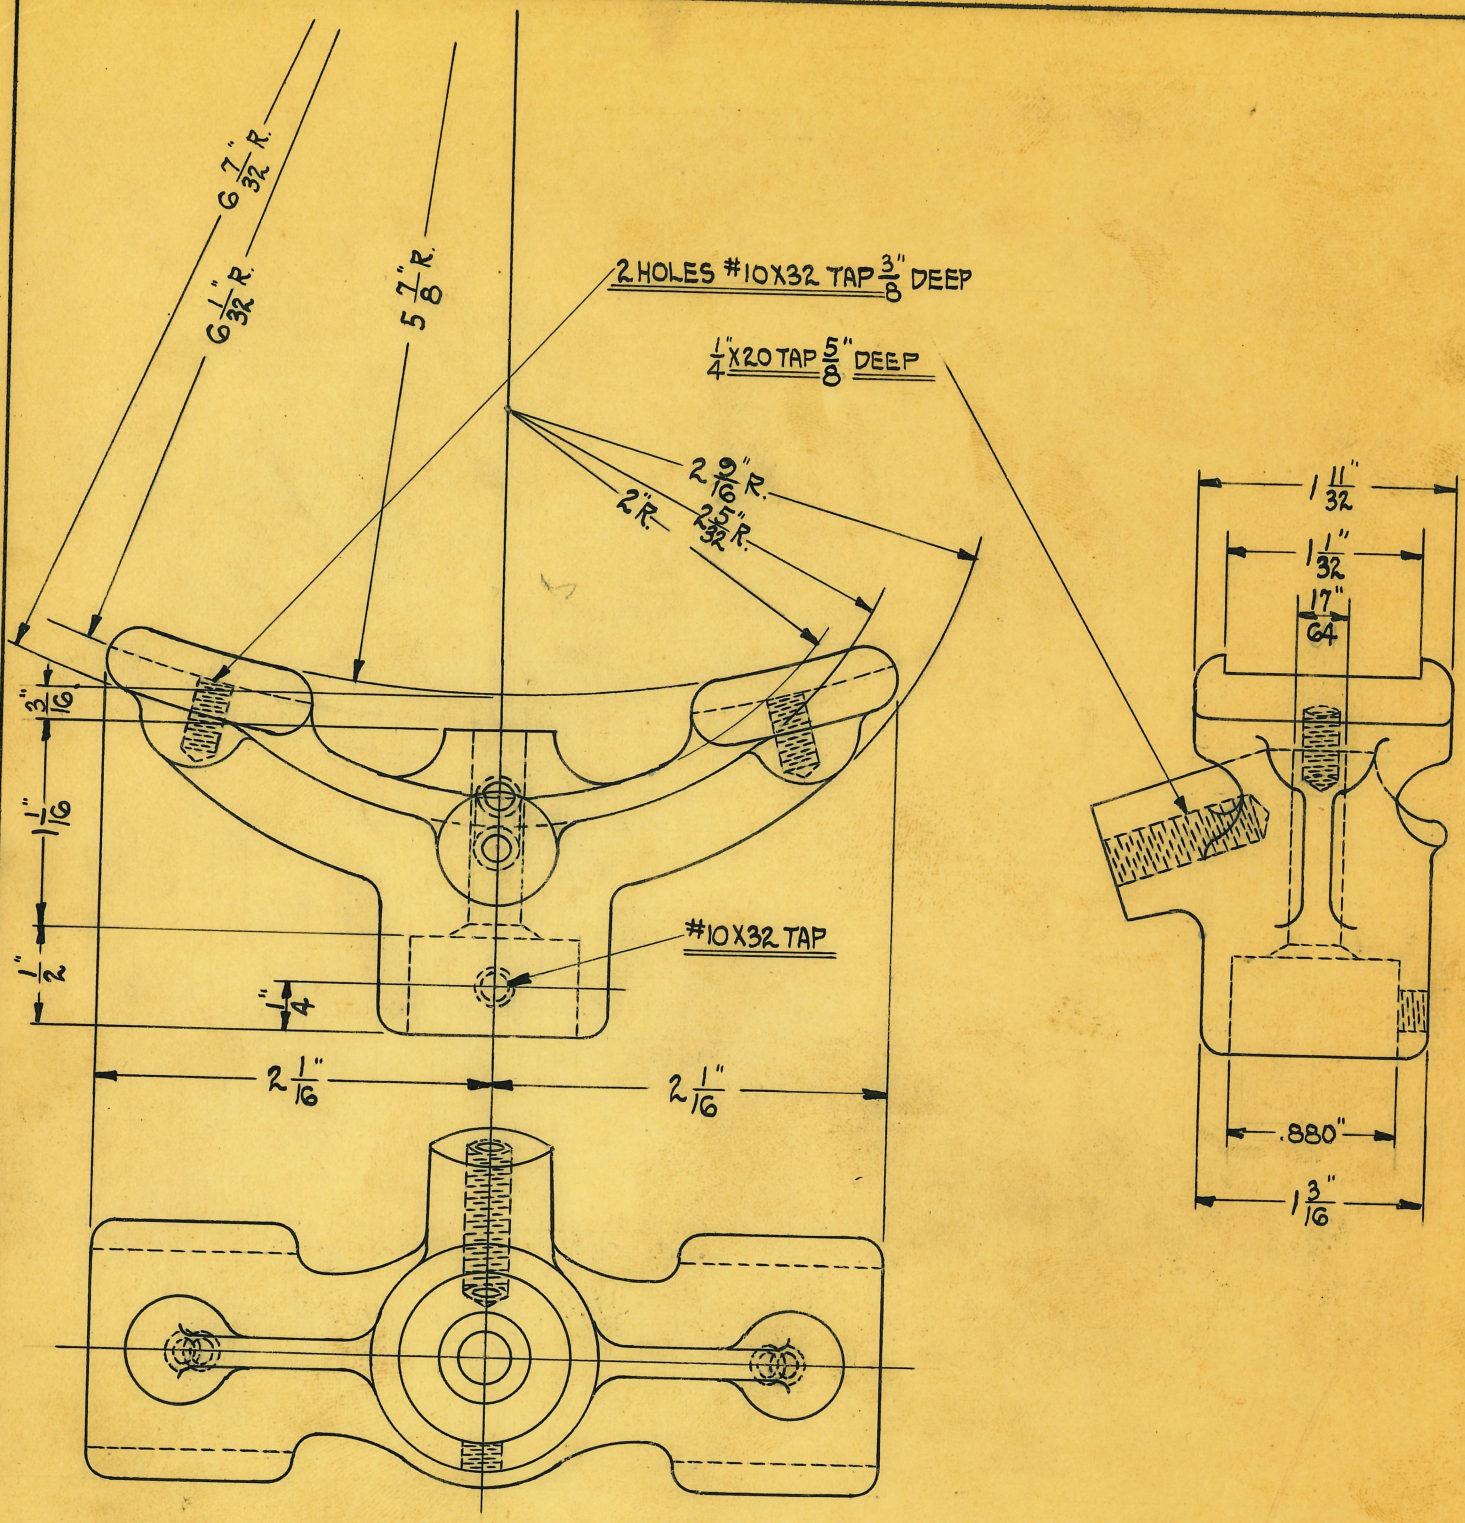

DRILL JIG. # 2931

OBSOLETE

SIZE		ISSUE H.E.	4-16-30
KIND	IRON CASTING	CHANGED	
SHAPE		" "	
FINISH	LACQUER	" "	
TEMP.		" "	
PATT.		" "	

TITLE: PHYSICIANS MODEL ARC LAMP FORK SUPPORT

H. G. FISCHER & CO.
2335 WABANSIA AVE.
CHICAGO, ILL.

CAT. NO.

PART NO. 5828F

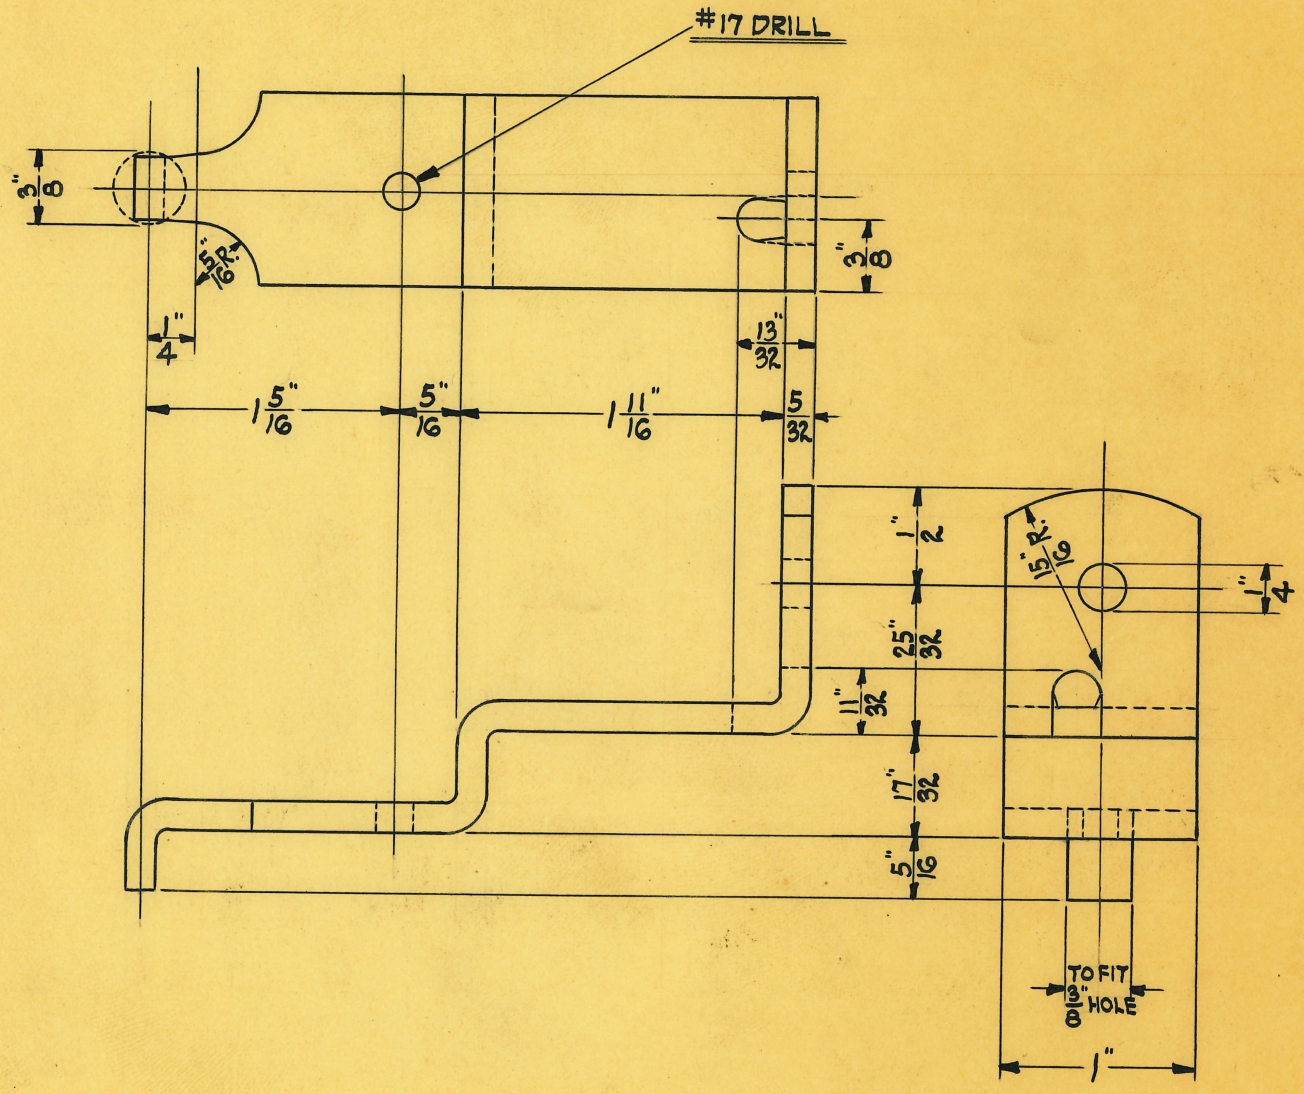

OBSOLETE

SIZE	5/32" X 1"	ISSUE H.E.	4-14-30	TITLE: PHYSICIANS MODEL ARC LAMP HOOD SUPPORT PIECE
KIND	R.E.C.R. STEEL	CHANGED		
SHAPE	STRIP	" "		
FINISH		" "		
TEMP.		" "		
PATT.		" "		

H. G. FISCHER & CO.
2335 WABANSIA AVE.
CHICAGO, ILL.

CAT. NO.

PART NO. 5833

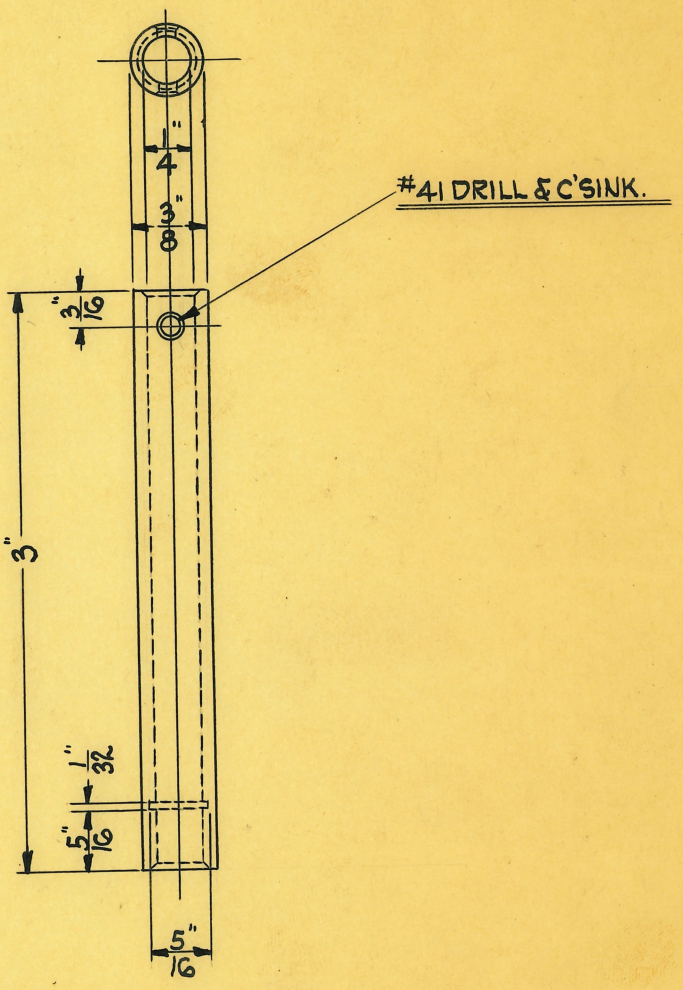

OBSOLETE

SIZE	1/4" I.D. X 3/8" O.D.	ISSUE	H.E.	4-10-30
KIND	BLACK FIBRE TUBE	CHANGED		
SHAPE	ROUND	"	"	
FINISH		"	"	
TEMP.		"	"	
PATT.		"	"	

TITLE: PHY. MODEL ARC LAMP PULL CORD INSULATOR

H. G. FISCHER & CO.
2335 WABANSIA AVE.
CHICAGO, ILL.

CAT. NO.

PART NO. 5835

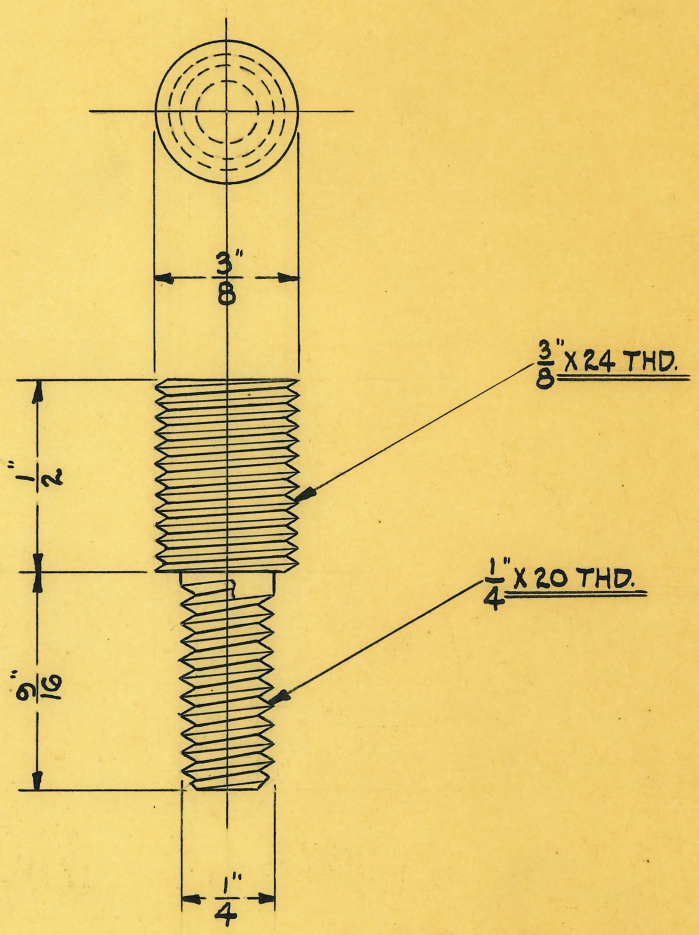

SCALE ~ 2 DIAMETERS

OBSOLETE

SIZE	3/8"	ISSUE H.E.	4-10-30	TITLE: PHY. MODEL ARC LAMP FORK SUPP. HANDLE STUD
KIND	SCR. STOCK	CHANGED		
SHAPE	ROUND	" "		
FINISH		" "		
TEMP.		" "		
PATT.		" "		

H. G. FISCHER & CO.
2335 WABANSIA AVE.
CHICAGO, ILL.

CAT. NO.

PART NO. 5839

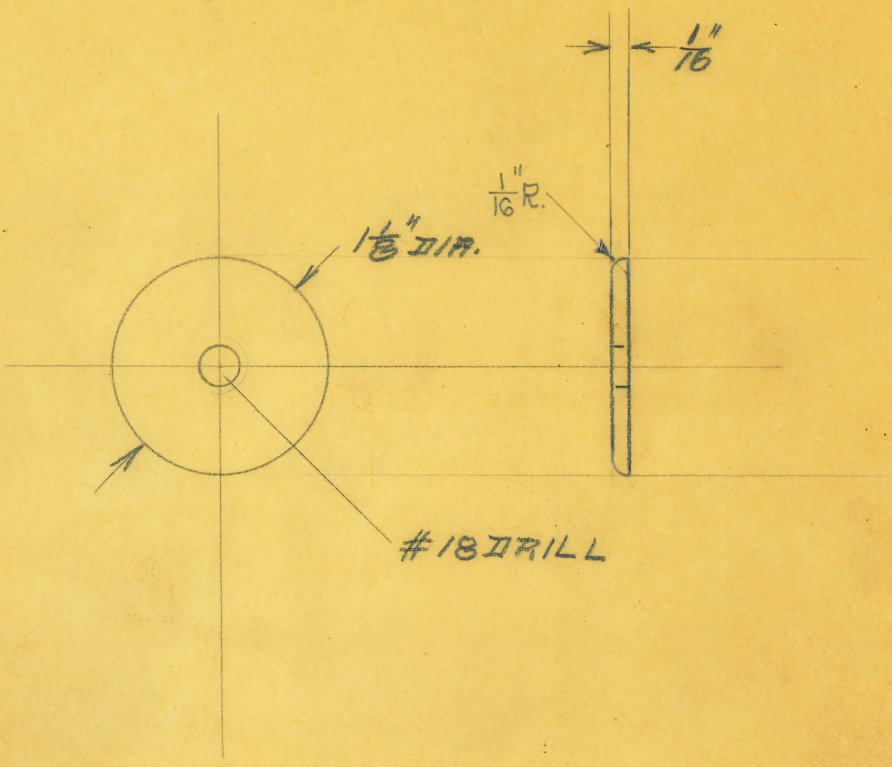

ECO-1711
OBSOLETE
P.P. 5/30/79

(2)

SIZE		ISSUE 6-8-26	Q.	TITLE: WASHER FOR PAD CORD CONNECTOR		
KIND	BRASS	CHANGED				
SHAPE		" "				
FINISH	W. P.	" "				
TEMP.		" "		H. G. FISCHER & CO. 2335 WABANSIA AVE. CHICAGO, ILL.	CAT. NO.	PART NO. 5843
PATT.		" "				

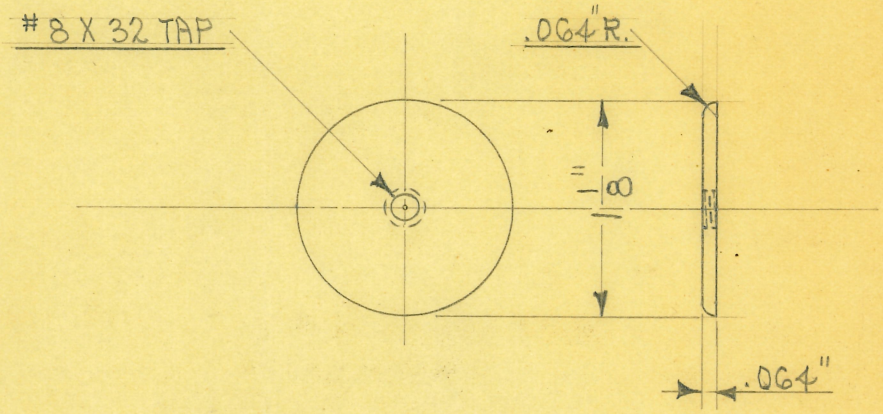

OBSOLETE

Obsolete

SIZE	#14 B.&S.GA.	ISSUE 6-25-34	A.E.	TITLE: WASHER FOR FLAT PAD ELECTRODE (THREADED)		
KIND	H.H. SHEET BRASS	CHANGED				
SHAPE		"				
FINISH	W.P.	"				
TEMP.		"		H. G. FISCHER & CO. 2335 WABANSIA AVE. CHICAGO, ILL.	CAT. NO.	PART NO. 5843 1/2
PATT.		"				

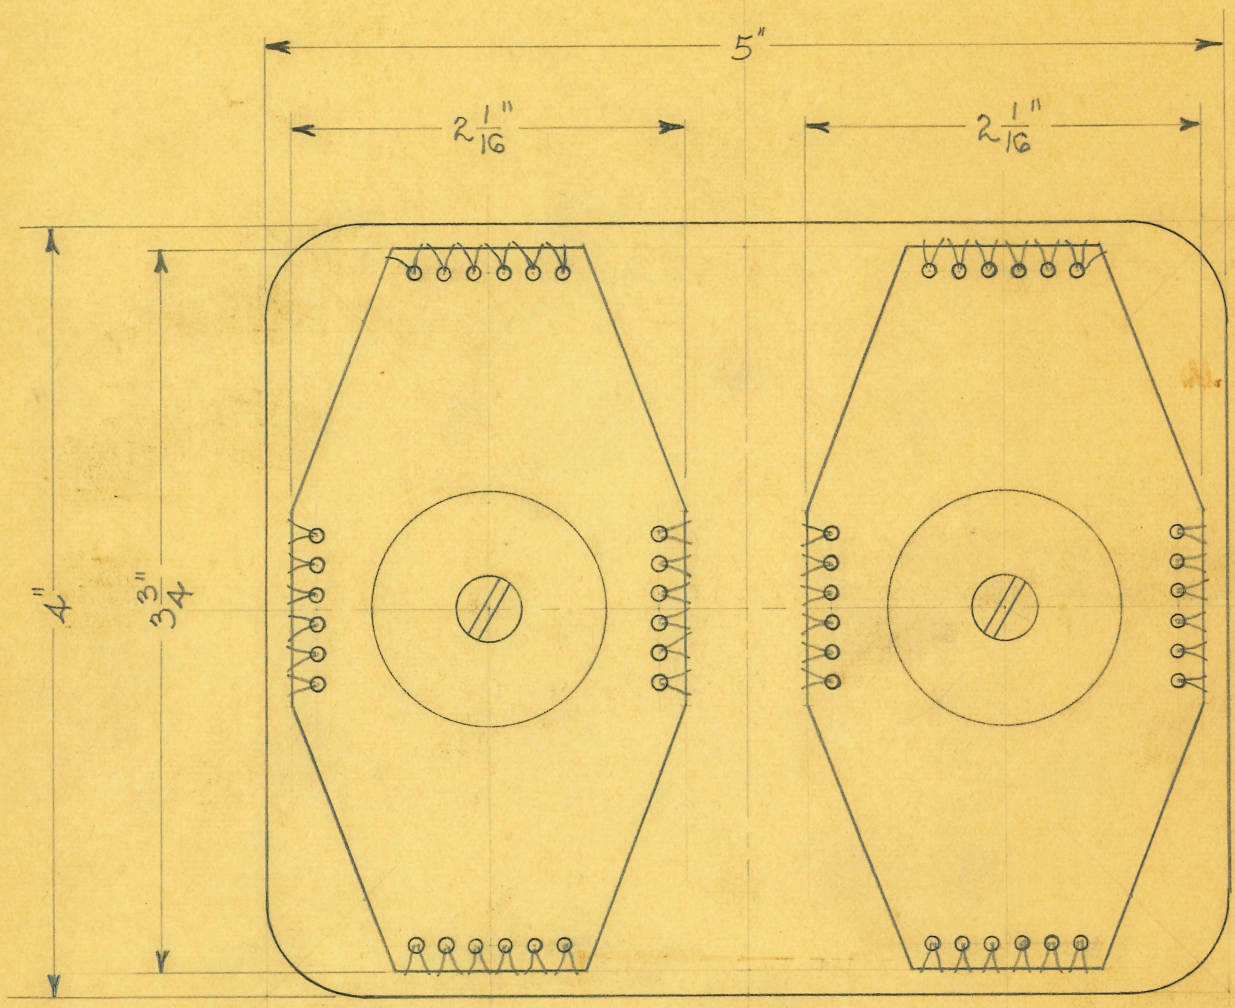

SCALE ~ FULL SIZE

OBSOLETE

SIZE		ISSUE 5-9-31	A.E.	TITLE: 4"X5" FLAT PAD ELECTRODE WITH DOUBLE CONNECTION	
KIND		CHANGED			
SHAPE		" "			
FINISH		" "			
TEMP.		" "		H. G. FISCHER & CO. 2335 WABANSIA AVE. CHICAGO, ILL.	CAT. NO.
PATT.		" "			PART NO. 5848 1/2 G

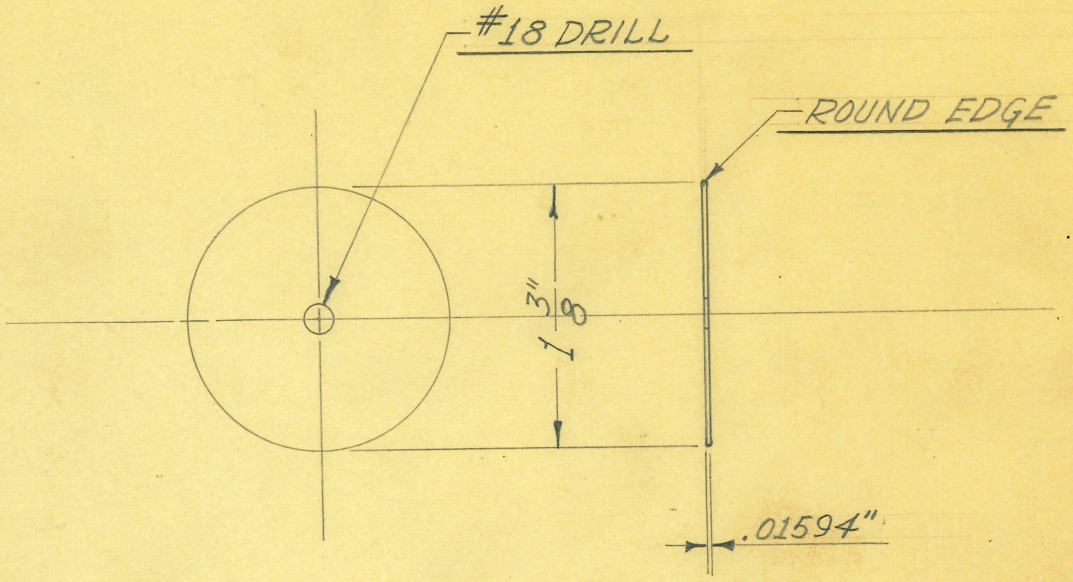

1 REQUIRED

ECO-1711
OBSOLETE
5/30/79

SIZE	#26 B&S. GA.	ISSUE 2-13-39	J.W.
KIND	SOFT BRASS	CHANGED	
SHAPE	SHEET	"	
FINISH	CAD. #23	"	
TEMP.		"	
PATT.		"	

TITLE: WAVE GEN. FLAT PAD ELECTRODE WASHER - SOFT

H. G. FISCHER & CO.
2335 WABANSIA AVE.
CHICAGO, ILL.

CAT. NO.

PART NO. 5857

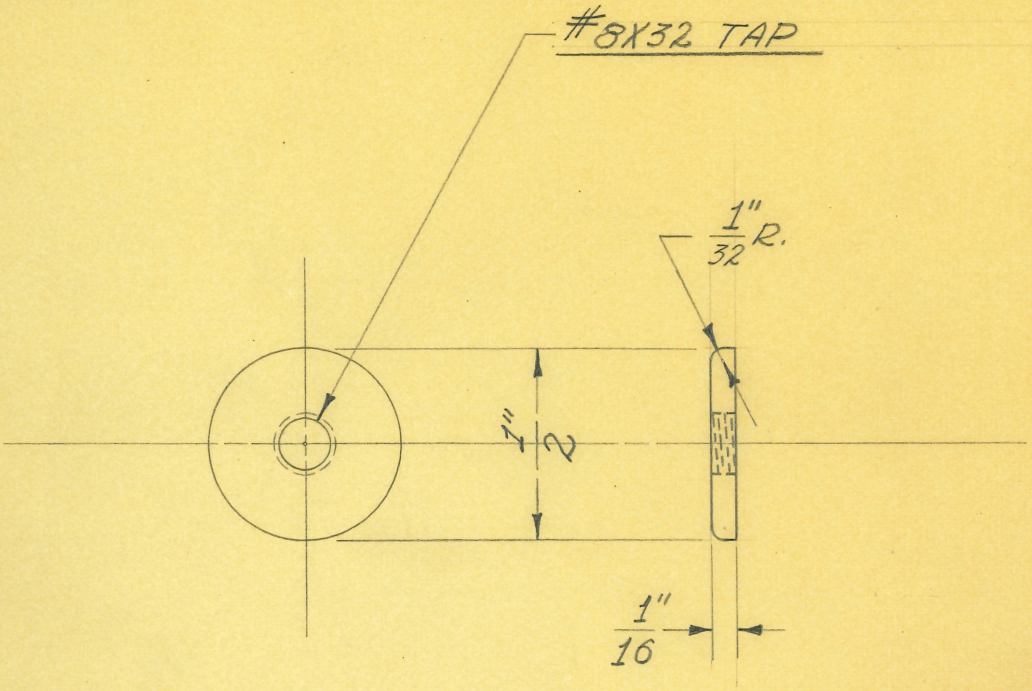

SCALE ÷ DOUBLE SIZE

1 REQUIRED

ECO-1711
OBSOLETE
P.P. 5/30/79

SIZE	1/2" DIAM.	ISSUE 2-14-39	J.W.
KIND	BRASS ROD	CHANGED	
SHAPE		"	
FINISH	CAD. #23	"	
TEMP.		"	
PATT.		"	

TITLE: WAVE GEN. FLAT PAD ELECTRODE WASHER (THREADED)

H. G. FISCHER & CO.
2335 WABANSIA AVE.
CHICAGO, ILL.

CAT. NO.

PART NO. 5858

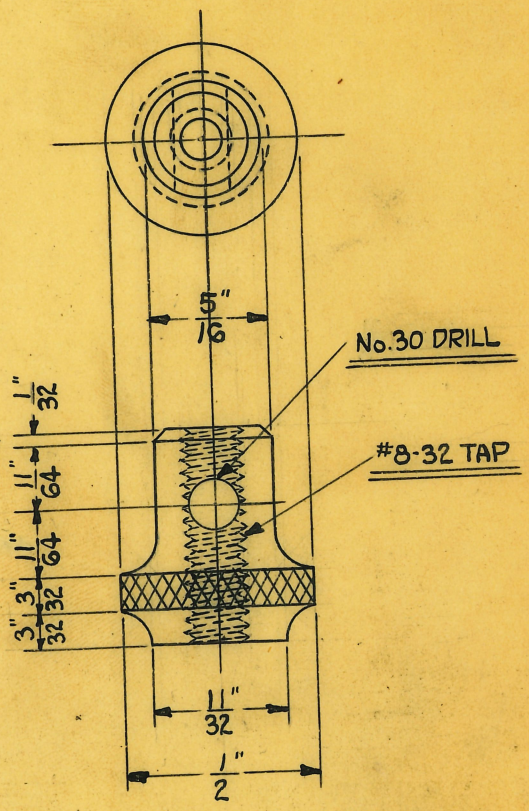

SCALE ~ 2 DIAMETERS

OBSOLETE

SIZE	1/2" X 9/16"	ISSUE	10-28-29	TITLE: BLOCK TIN ELECTRODE BINDING POST BINDING POST	
KIND	BRASS ROD	CHANGED			
SHAPE	ROUND	" "			
FINISH	~~POLISH AND NICKEL PLATE~~	" "			
~~TEMP.~~	W.P.	" "		H. G. FISCHER & CO. 2335 WABANSIA AVE. CHICAGO, ILL.	CAT. NO.
PATT.		" "			PART NO. 5861

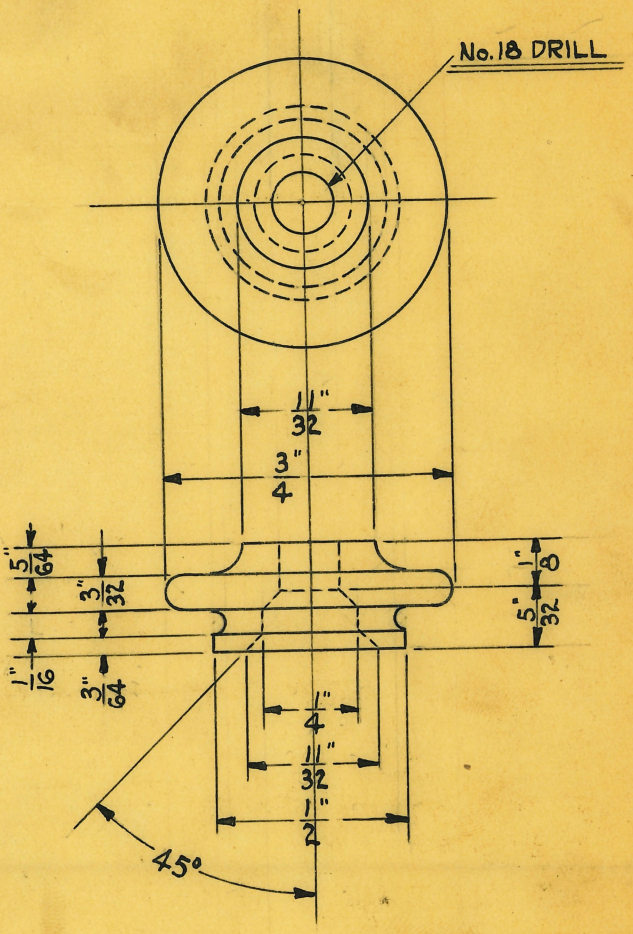

SCALE ~ 2 DIAMETERS

OBSOLETE

SIZE	3/4" X 9/32"	ISSUE	10-28-29	TITLE: BLOCK TIN ELECTRODE BINDING POST SCREW CLAMP	
KIND	BRASS ROD	CHANGED			
SHAPE	ROUND	" "			
FINISH	~~POLISH AND NICKEL PLATE~~	" "			
TEMP.	W.P.	" "		H. G. FISCHER & CO. 2335 WABANSIA AVE. CHICAGO, ILL.	CAT. NO.
PATT.		" "			PART NO. 5862

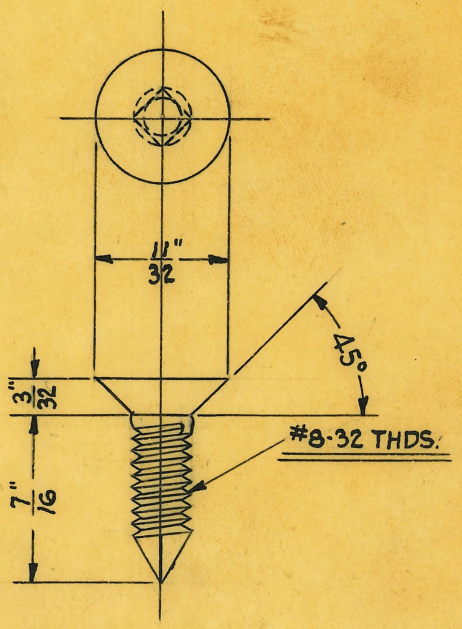

SCALE ~ 2 DIAMETERS

OBSOLETE

SIZE	11/32 X 17/32"	ISSUE	10-28-29
KIND	BRASS ROD	CHANGED	
SHAPE	ROUND	" "	
FINISH	~~POLISH AND NICKEL PLATE~~	" "	
TEMP.	W.P.	" "	
PATT.		" "	

TITLE: BLOCK TIN ELECTRODE BINDING POST SCREW

H. G. FISCHER & CO.
2335 WABANSIA AVE.
CHICAGO, ILL.

CAT. NO.

PART NO. 5863

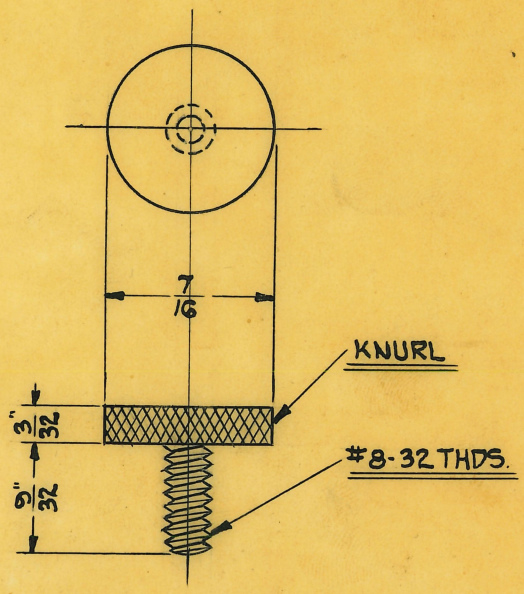

SCALE ~ 2 DIAMETERS

OBSOLETE

SIZE	7/16"	ISSUE	H.E.	12-12-29	TITLE: BLOCK TIN ELECTRODE BINDING POST THUMB SCREW
KIND	BRASS ROD	CHANGED			
SHAPE	ROUND	"	"		
FINISH	N.P.	"	"		
TEMP.		"	"		H. G. FISCHER & CO. 2335 WABANSIA AVE. CHICAGO, ILL.
PATT.		"	"		CAT. NO.
					PART NO. 5864

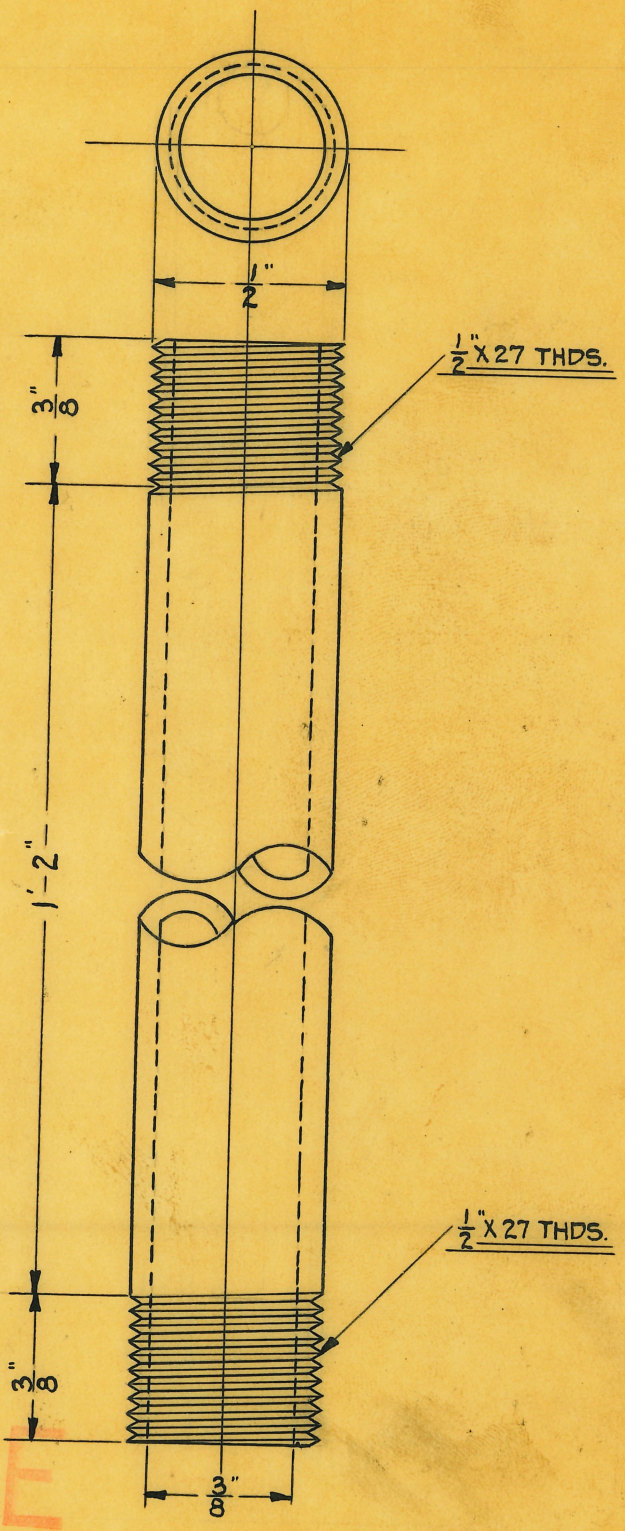

OBSOLETE

SCALE ~ 2 DIAMETERS

SIZE	3/8" I.D. X 1/2" O.D. X 14 3/4"	ISSUE	11-2-29
KIND	SEAMLESS BRASS TUBING	CHANGED	
SHAPE		" "	
FINISH	P. & P.	" "	
TEMP.		" "	
PATT.		" "	

TITLE: LAYMAN'S INFRA RED RAY GENERATOR HOOD SUPPORT TUBE

H. G. FISCHER & CO.
2335 WABANSIA AVE.
CHICAGO, ILL.

CAT. NO.

PART NO. 5902